

INDEX TO DRAWINGS	
SHEET NO.	DESCRIPTION
1	TITLE SHEET
2	TYPICAL SECTION
3	TYPICAL DETAILS
4-13	PLAN & PROFILE
14	DITCH COVER
15-18	MISCELLANEOUS DETAILS
19	DETOUR ROAD
20-78	CROSS SECTIONS

CONVENTIONAL SIGNS USED

Boundary Lines	-----
Bridge	=====
Centerline	----- 3.5 -----
Centerline Monument	----- 2 Mon. -----
Circular Pipe Culvert	-----
Electric Pole	-----
Existing Road	-----
Fences	-----
Telephone Pole	----- 0.75 -----
Warning & Regulatory Signs	----- 10' 10' (Type) -----
Reflectorized Delineators	----- • -----

STATE OF HAWAII
HAWAII STATE HIGHWAY DEPARTMENT
HONOLULU, HAWAII

AS BUILT PLANS OF KAUMALAPAU HIGHWAY FEDERAL AID SECONDARY PROJECT NO S-0440(1)

COUNTY OF MAUI
ISLAND OF LANAI

NOTE:

ALL CHANGES MADE DURING
CONSTRUCTION HAVE BEEN
NOTED IN THESE TRACINGS
IN RED AND CHECKED BY

SCALES


PLAN	-----	1 IN. = 100 FT.
PROFILE	HOR. -----	1 IN. = 100 FT.
	VER. -----	1 IN. = 10 FT.
CROSS SECTION	HOR. -----	1 IN. = 10 FT.
	VER. -----	1 IN. = 10 FT.

Harry W. Kuwahara
RESIDENT ENGINEER
Sept. 15, 1961
DATE

LOCATION MAP

STA. 310+73.91
END OF PROJECT

PROJECT NO S-0440(1)

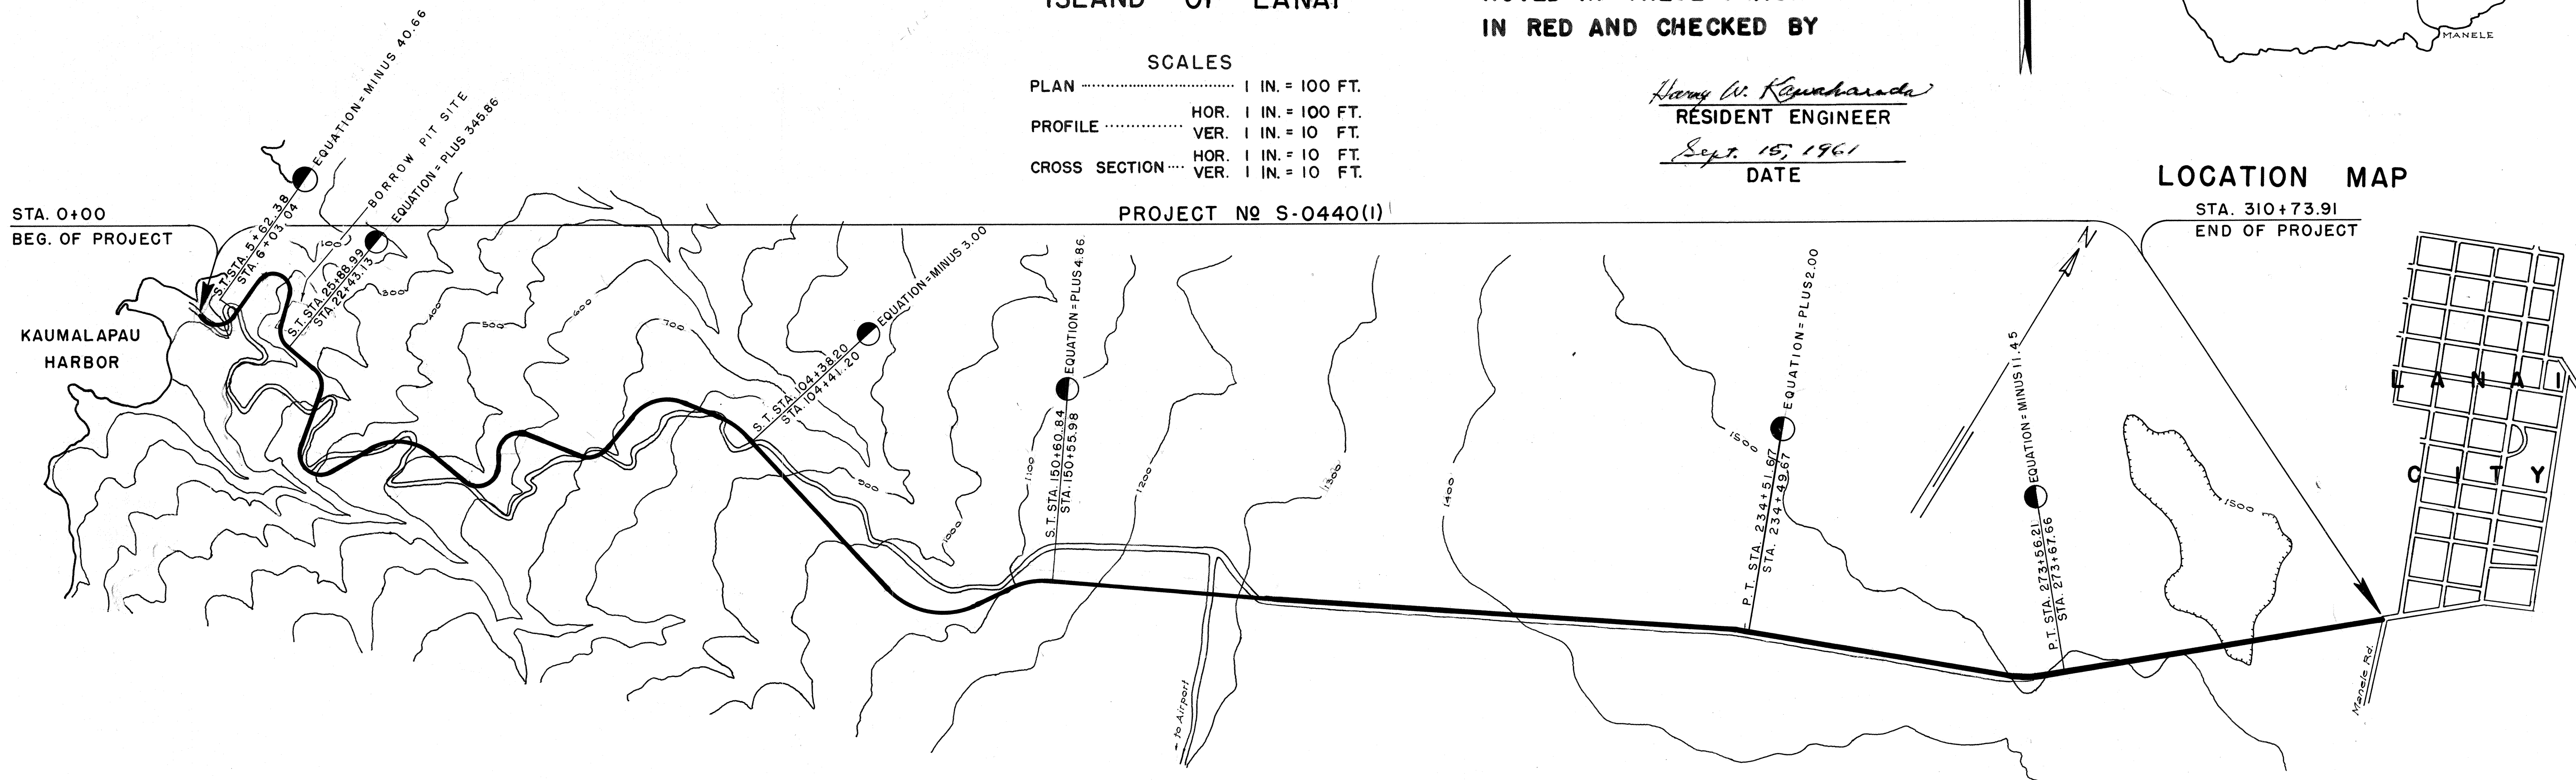

LAYOUT OF PROJECT

SCALE: 1" = 1000'

GROSS LENGTH OF PROJECT 5.942 MI.
BRIDGES OVER 20' SPAN 0.000
NET LENGTH OF ROADWAY 5.942 MI.

APPROVED: *[Signature]* DATE 10/2/59
STATE HIGHWAY ENGINEER

DEPARTMENT OF COMMERCE
BUREAU OF PUBLIC ROADS
APPROVED: _____
DIVISION ENGINEER DATE