

INDEX TO DRAWINGS	
SHEET NO	DESCRIPTION
1	TITLE SHEET
	PROJECT NO. 440A-02-72
2	TYP. SECTION, PLAN & PROFILE
3-6	CROSS SECTIONS
	PROJECT NO. 440A-01-73
7	TYPICAL SECTION
8-9	PLAN
10	STANDARD DETAILS

STATE OF HAWAII

DEPARTMENT OF TRANSPORTATION

HIGHWAYS DIVISION

HONOLULU, HAWAII

"AS - BUILT"

PLANS FOR

VARIOUS IMPROVEMENTS ON LANAI

LANAI AIRPORT ROAD

(IMPROVEMENTS TO AIRPORT RD. FROM KAUMALAPAU HWY.)


PROJECT NO. 440A-02-72

AND

KAUMALAPAU HIGHWAY RESURFACING

(AIRPORT ROAD TO MANELE ROAD)

PROJECT NO. 440A-01-73

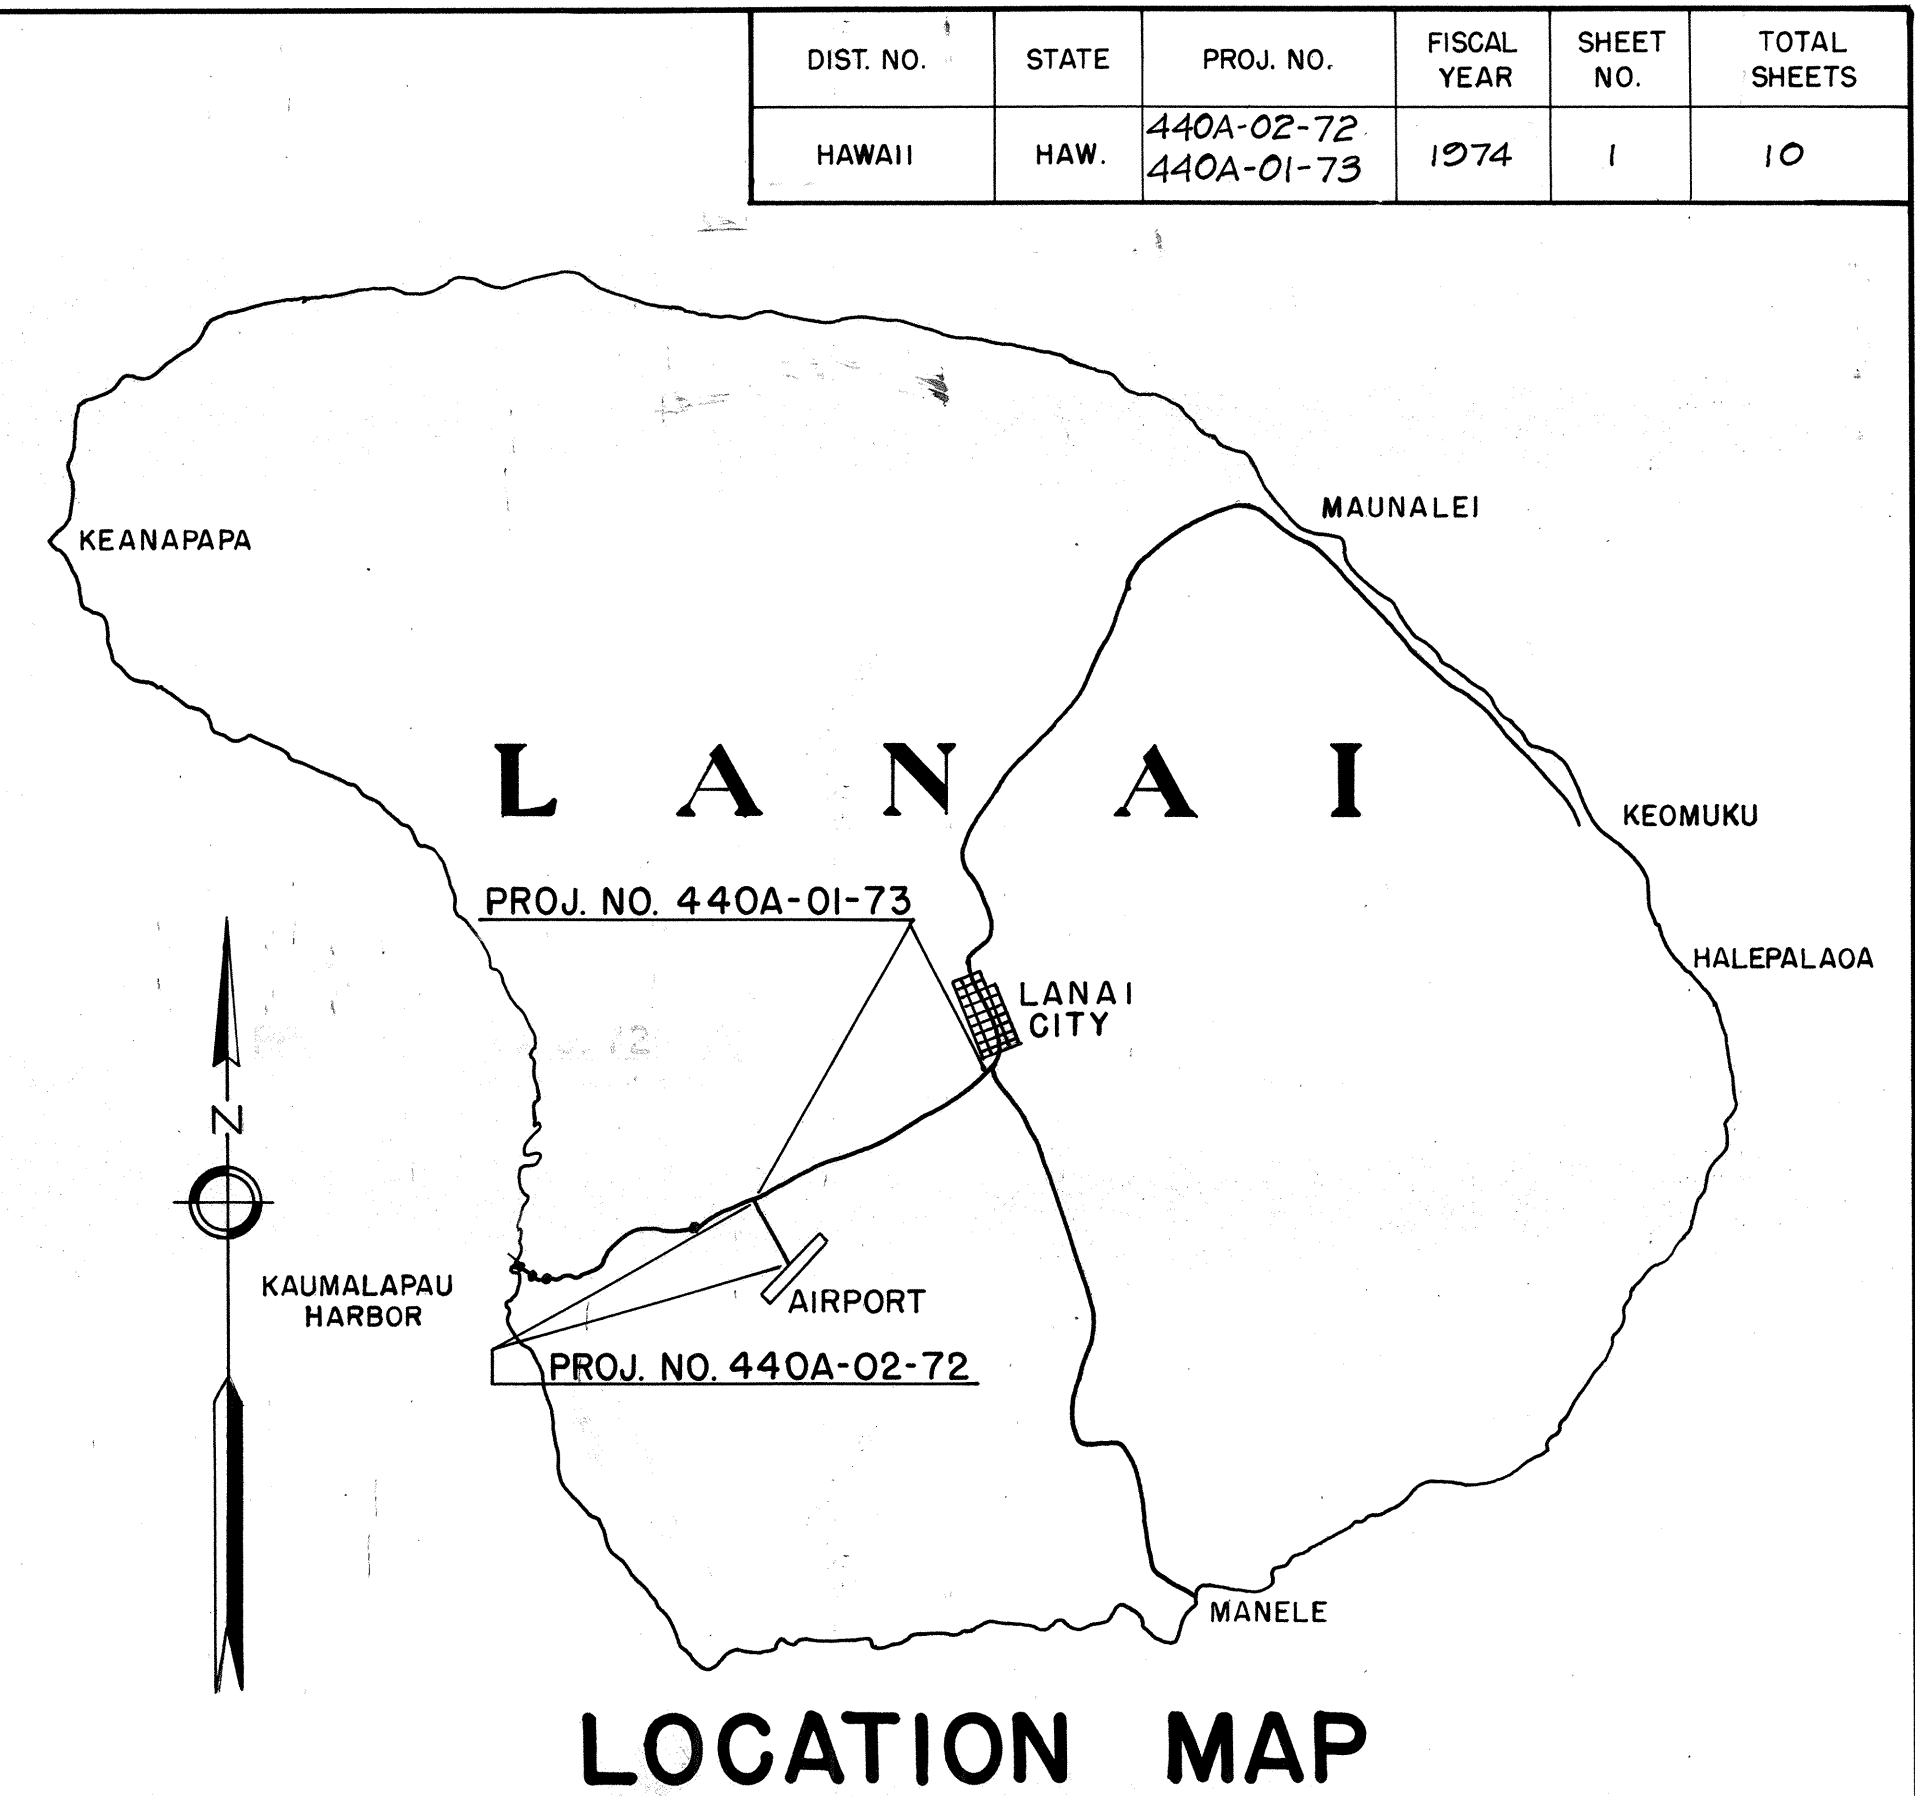

NO CHANGES WERE MADE DURING CONSTRUCTION ON THESE PLANS EXCEPT CHANGES IN THE ORIGINAL THEORETICAL QUANTITIES. FOR ACTUAL QUANTITIES, REFER TO PROJECT LEDGER AND/OR COMPUTATION BOOK.

Manuel J. Silva

RESIDENT ENGINEER.

17 Sept 81

DATE

DISTRICT OF LANAI

COUNTY OF MAUI

ISLAND OF LANAI

August, 1974

DATE

548-2456


PHONE

R. Tsuzuki

P.S. & E. BY

HWY - M

DESIGNED BY

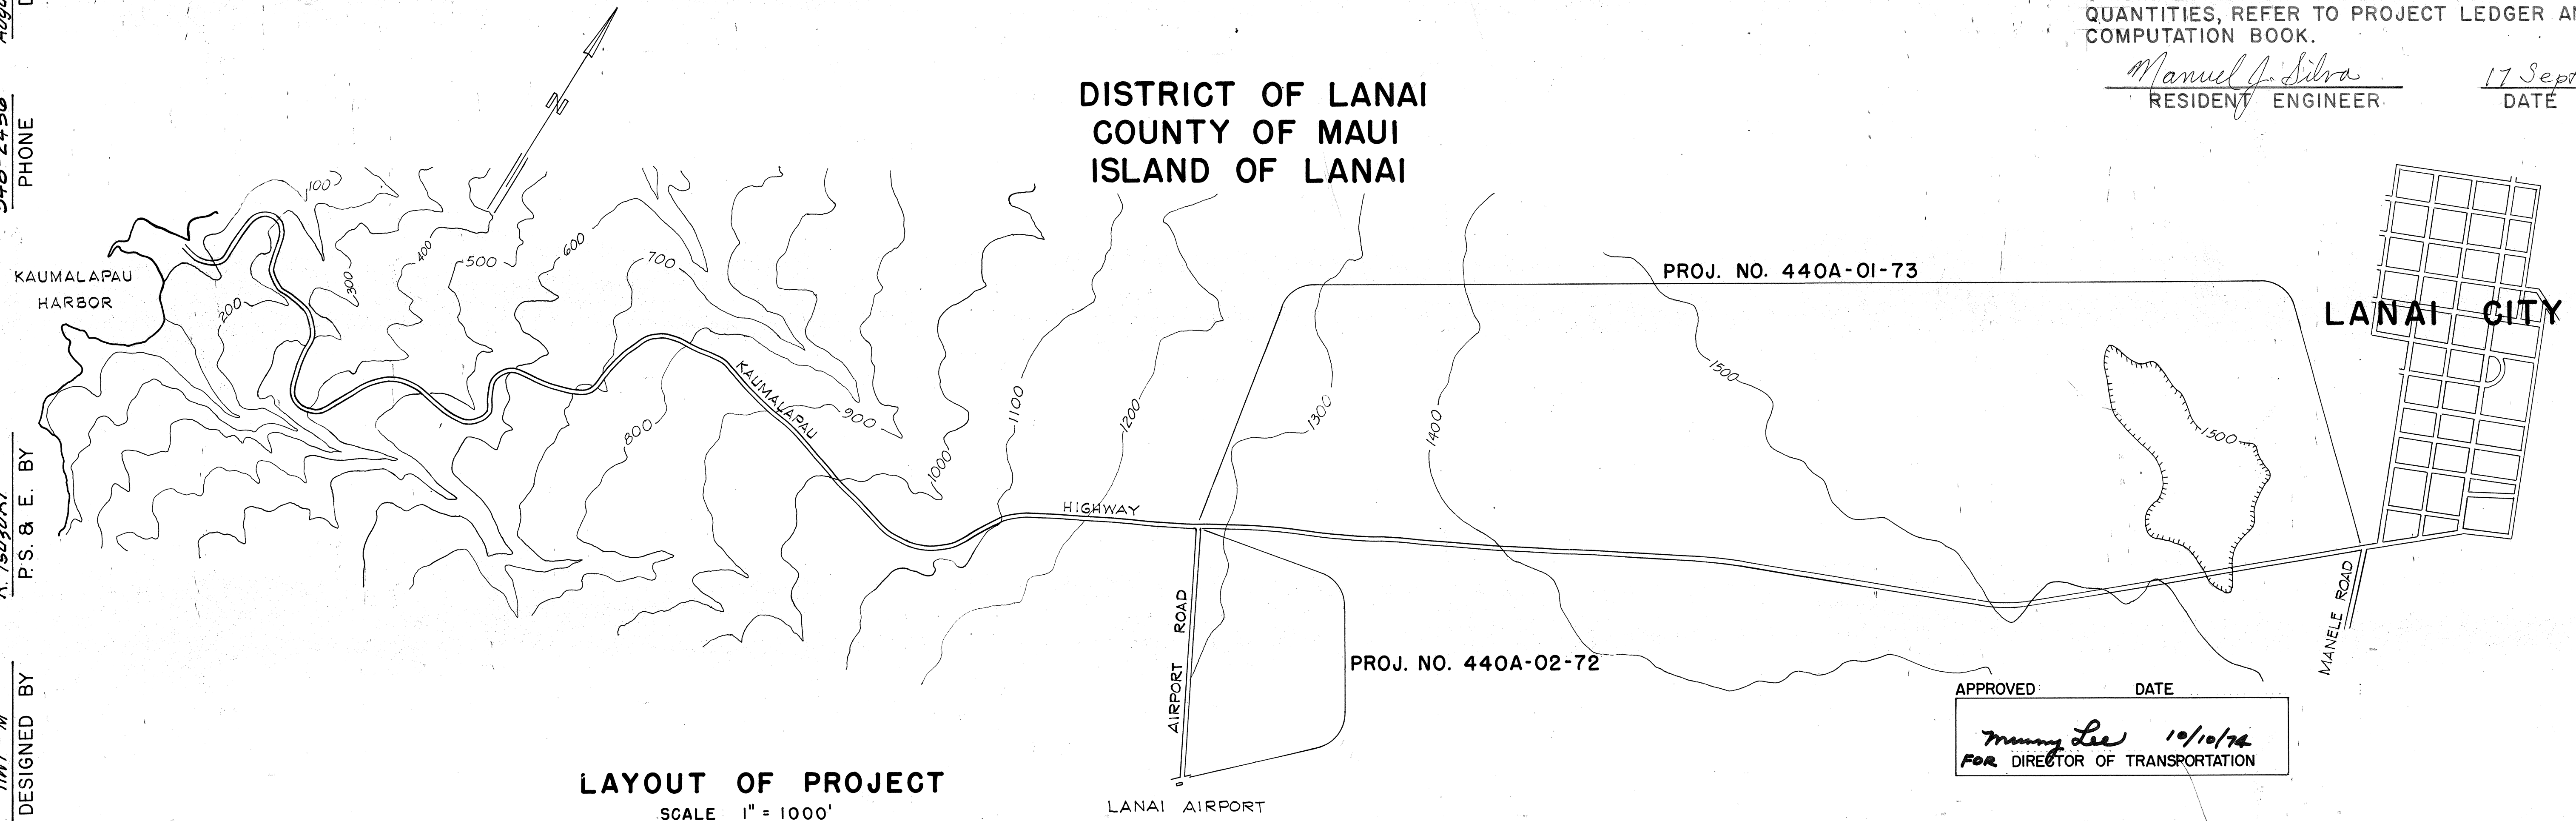

LAYOUT OF PROJECT

SCALE 1" = 1000'

APPROVED

DATE

Murray Lee

10/10/74

FOR DIRECTOR OF TRANSPORTATION