


| FED. ROAD DIST. NO. | STATE | PROJ. NO.   | FISCAL YEAR | SHEET NO. | TOTAL SHEETS |
|---------------------|-------|-------------|-------------|-----------|--------------|
| HAWAII              | HAW.  | 440A-01-80M | 1980        | 4         | 6            |

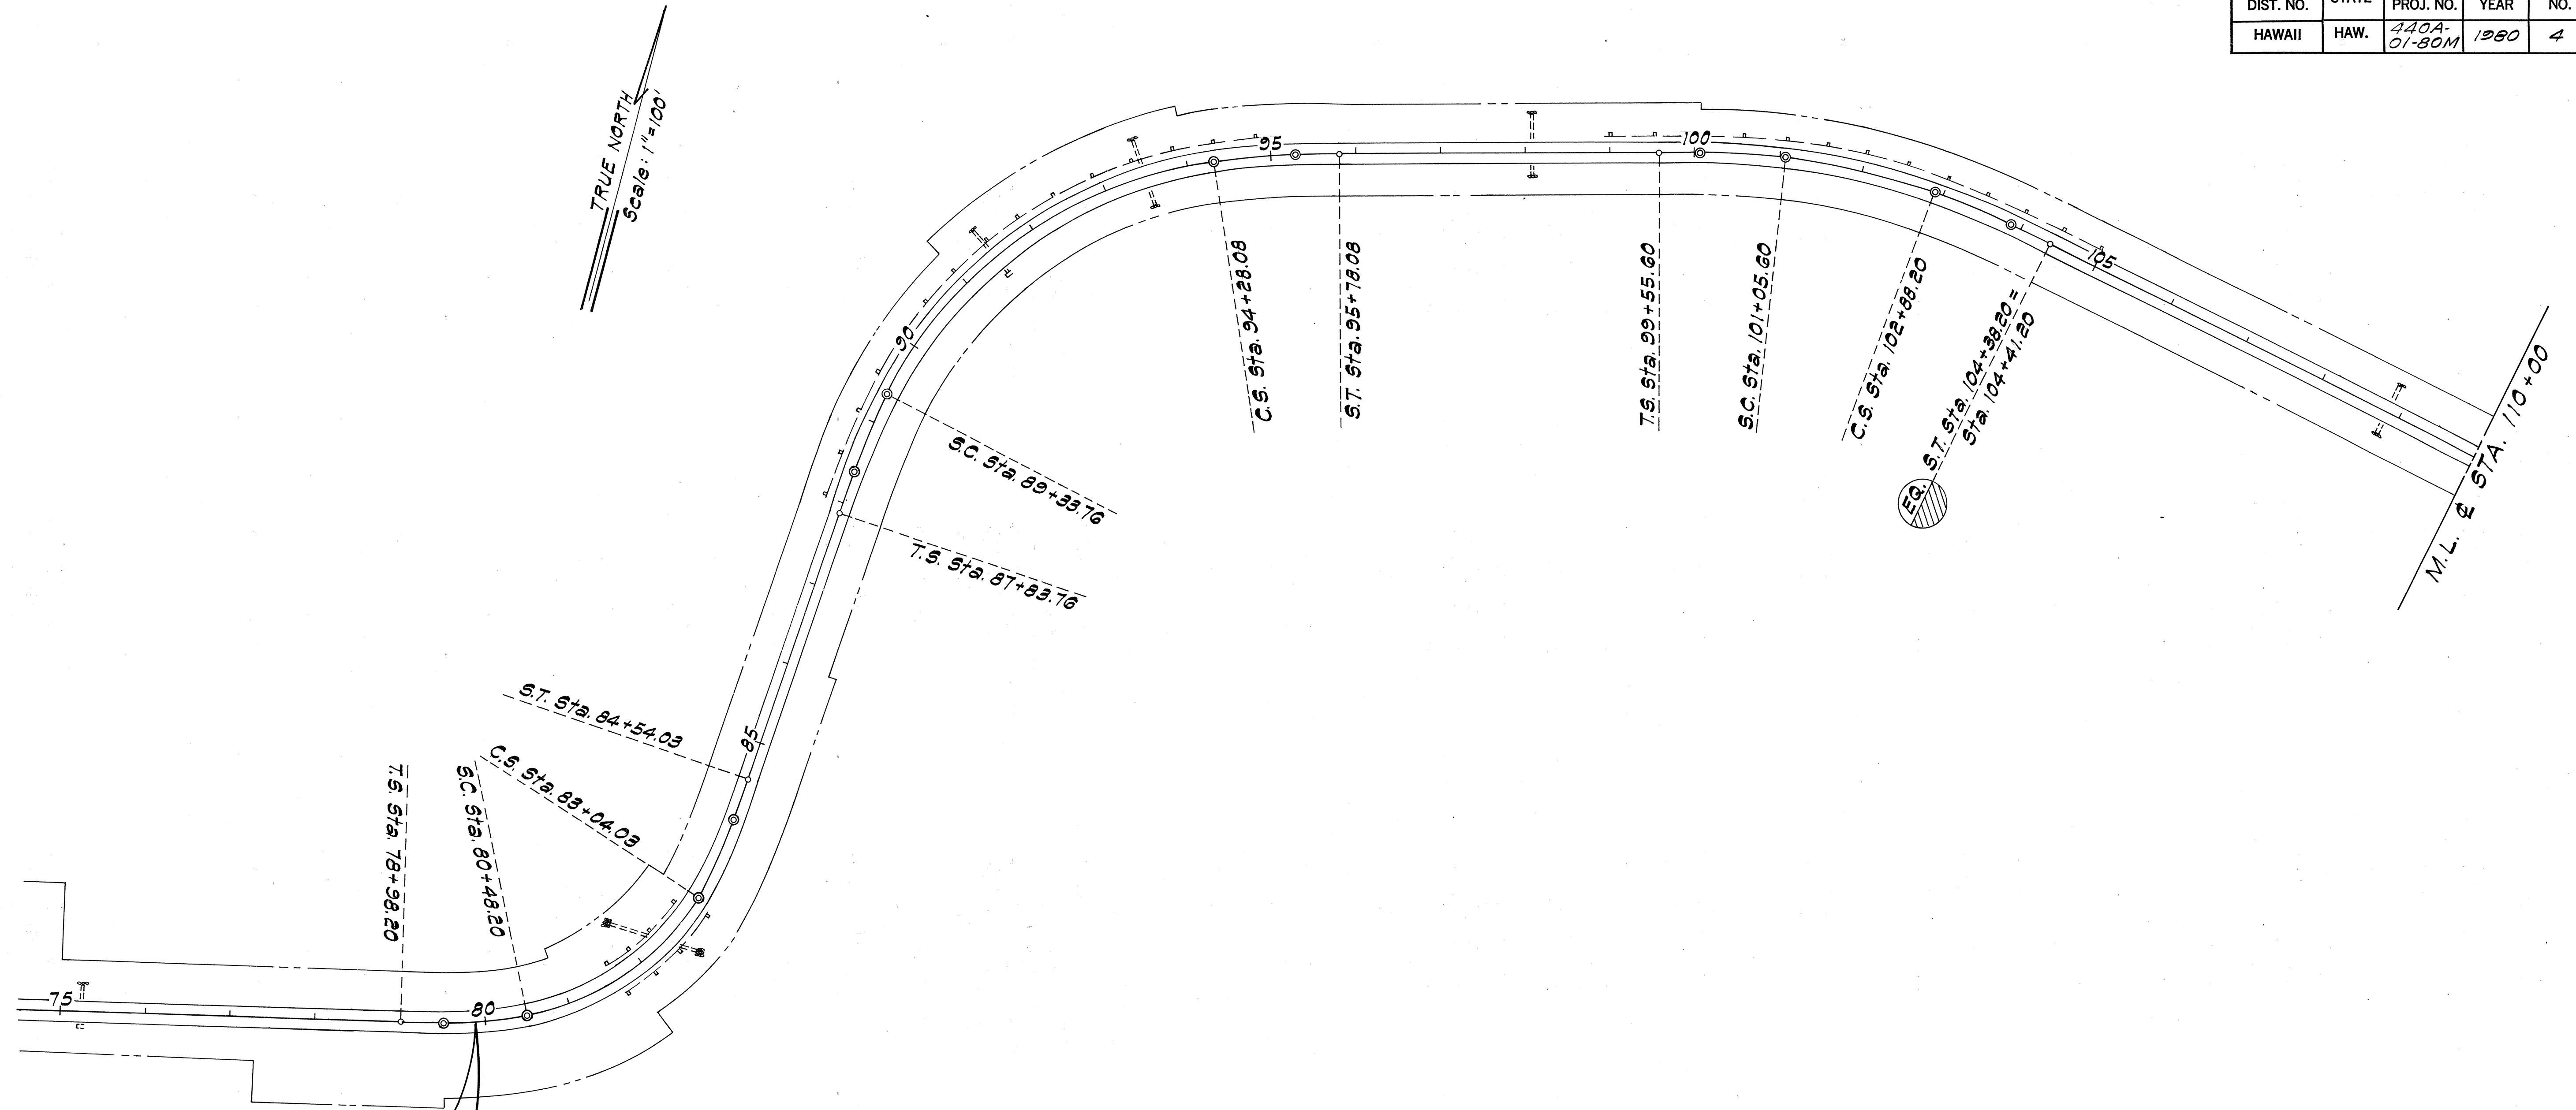

BEG. PROJ. NO. 440A-01-80M  
 @ STA. 79+86±

|               |                   |      |
|---------------|-------------------|------|
| ORIGINAL PLAN | SURVEY PLOTTED BY | DATE |
| NOTE BOOK     | DRAWN BY          | " "  |
| No.           | DESIGNED BY       | " "  |
|               | QUANTITIES BY     | " "  |
|               | CHECKED BY        | " "  |

STATE OF HAWAII  
 DEPARTMENT OF TRANSPORTATION  
 LAND TRANSPORTATION FACILITIES DIVISION

PLANS


KAUMALAPAI HWY. IMPROVEMENTS  
 PROJECT NO. 440A-01-80M

Scale: 1"=100' Date: May, 1980

SHEET NO. 1 OF 2 SHEETS


| FED. ROAD DIST. NO. | STATE | PROJ. NO.   | FISCAL YEAR | SHEET NO. | TOTAL SHEETS |
|---------------------|-------|-------------|-------------|-----------|--------------|
| HAWAII              | HAW.  | 440A-01-80M | 1980        | 3         | 6            |

TRUE NORTH  
Scale: 1" = 100'

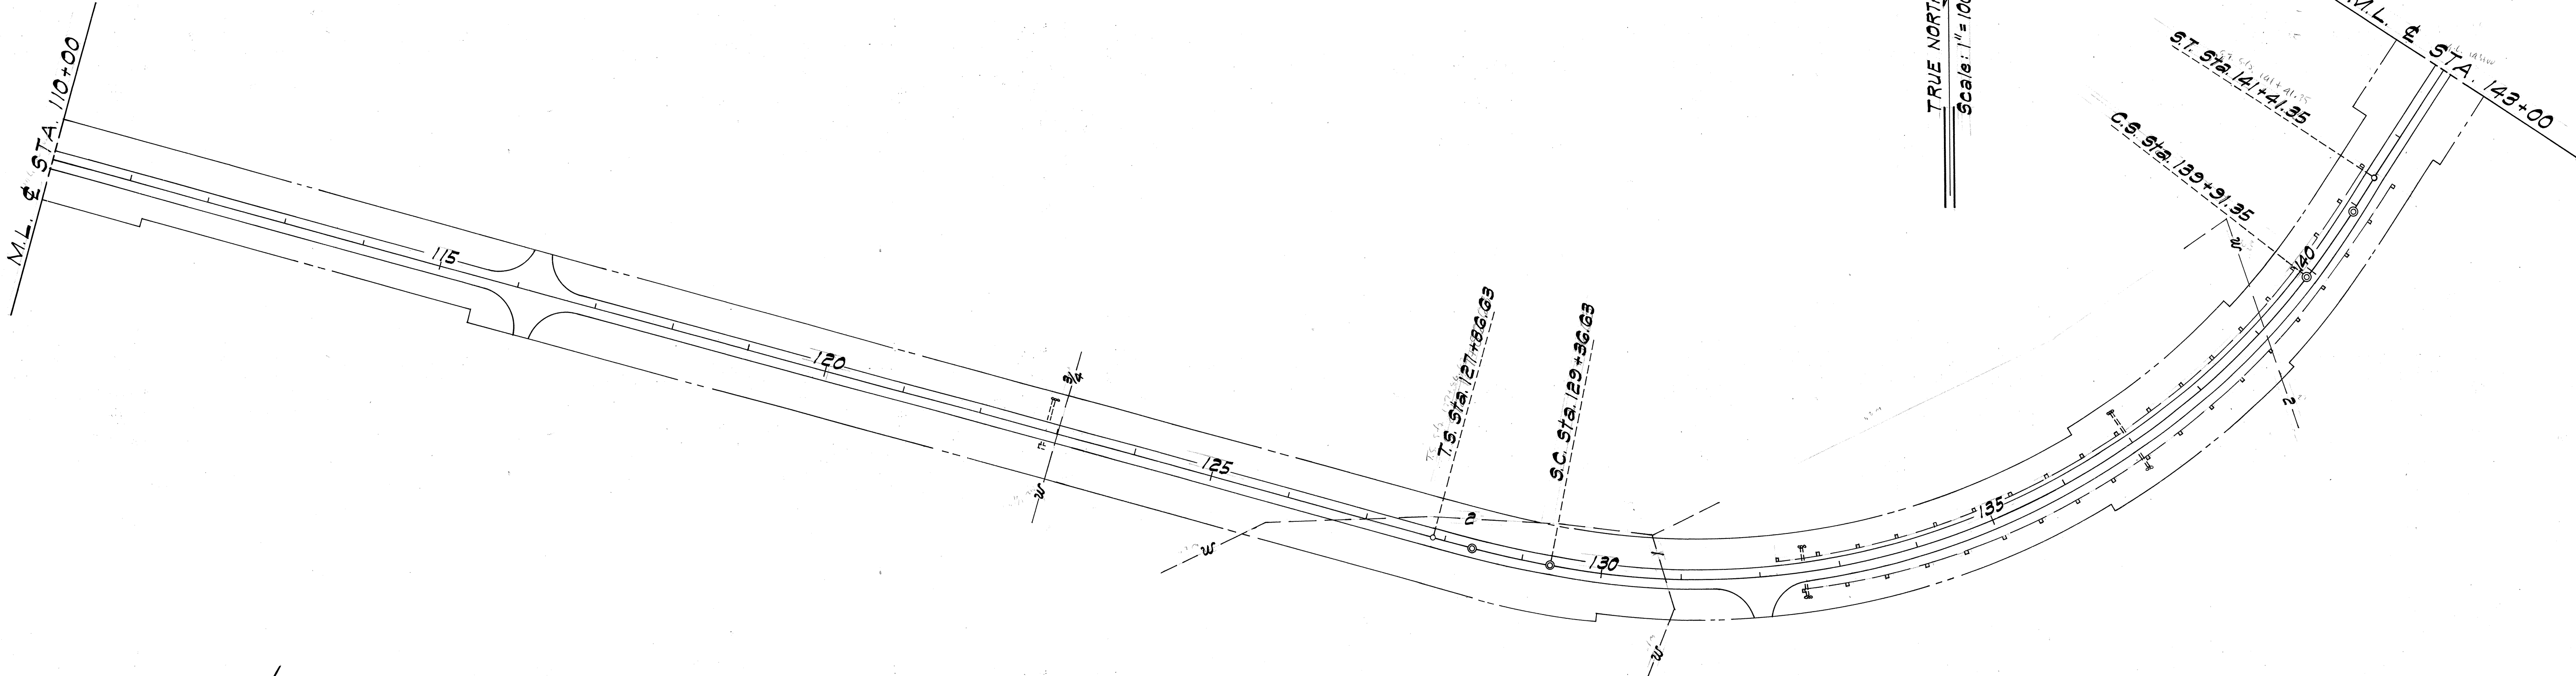

TRUE NORTH  
Scale: 1" = 100'

END PROJ. NO. 440A-01-80M  
± STA. 149+83 ± 57±

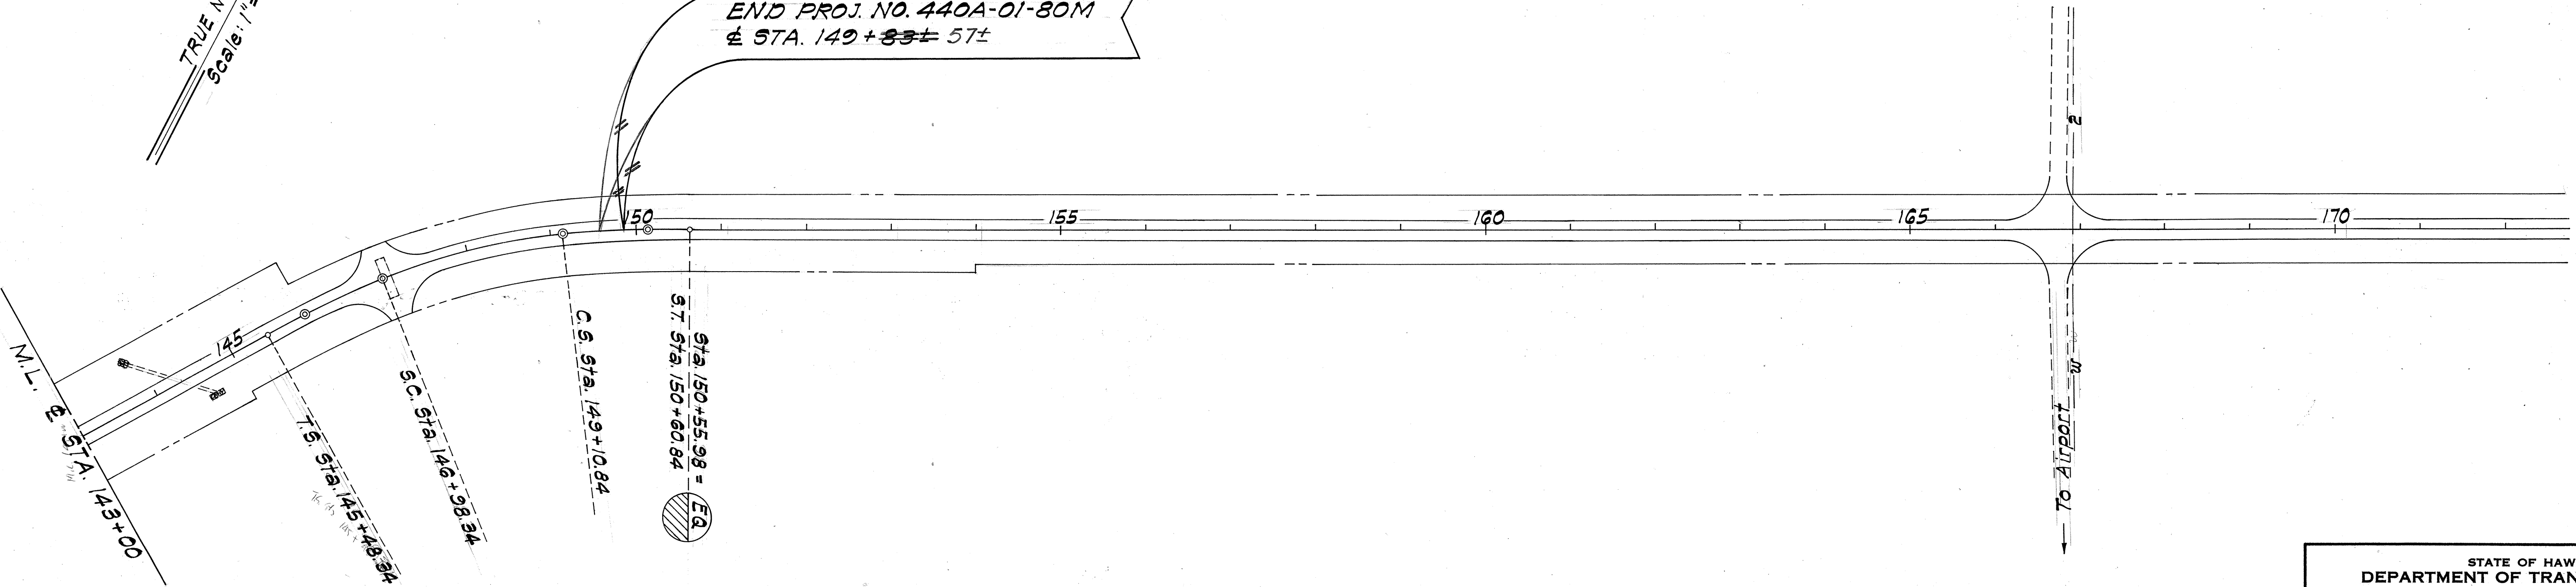

|               |      |
|---------------|------|
| ORIGINAL PLAN | DATE |
| DRAWN BY      |      |
| DESIGNED BY   |      |
| QUANTITIES BY |      |
| CHECKED BY    |      |

STATE OF HAWAII  
DEPARTMENT OF TRANSPORTATION  
LAND TRANSPORTATION FACILITIES DIVISION

PLANS

KAUMALAPAU HWY. IMPROVEMENTS  
PROJECT NO. 440A-01-80M

Scale: 1" = 100' Date: May, 1980

SHEET NO. 2 OF 2 SHEETS