

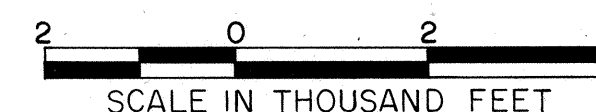
[illegible]

STATE OF HAWAII
DEPARTMENT OF TRANSPORTATION
HIGHWAYS DIVISION

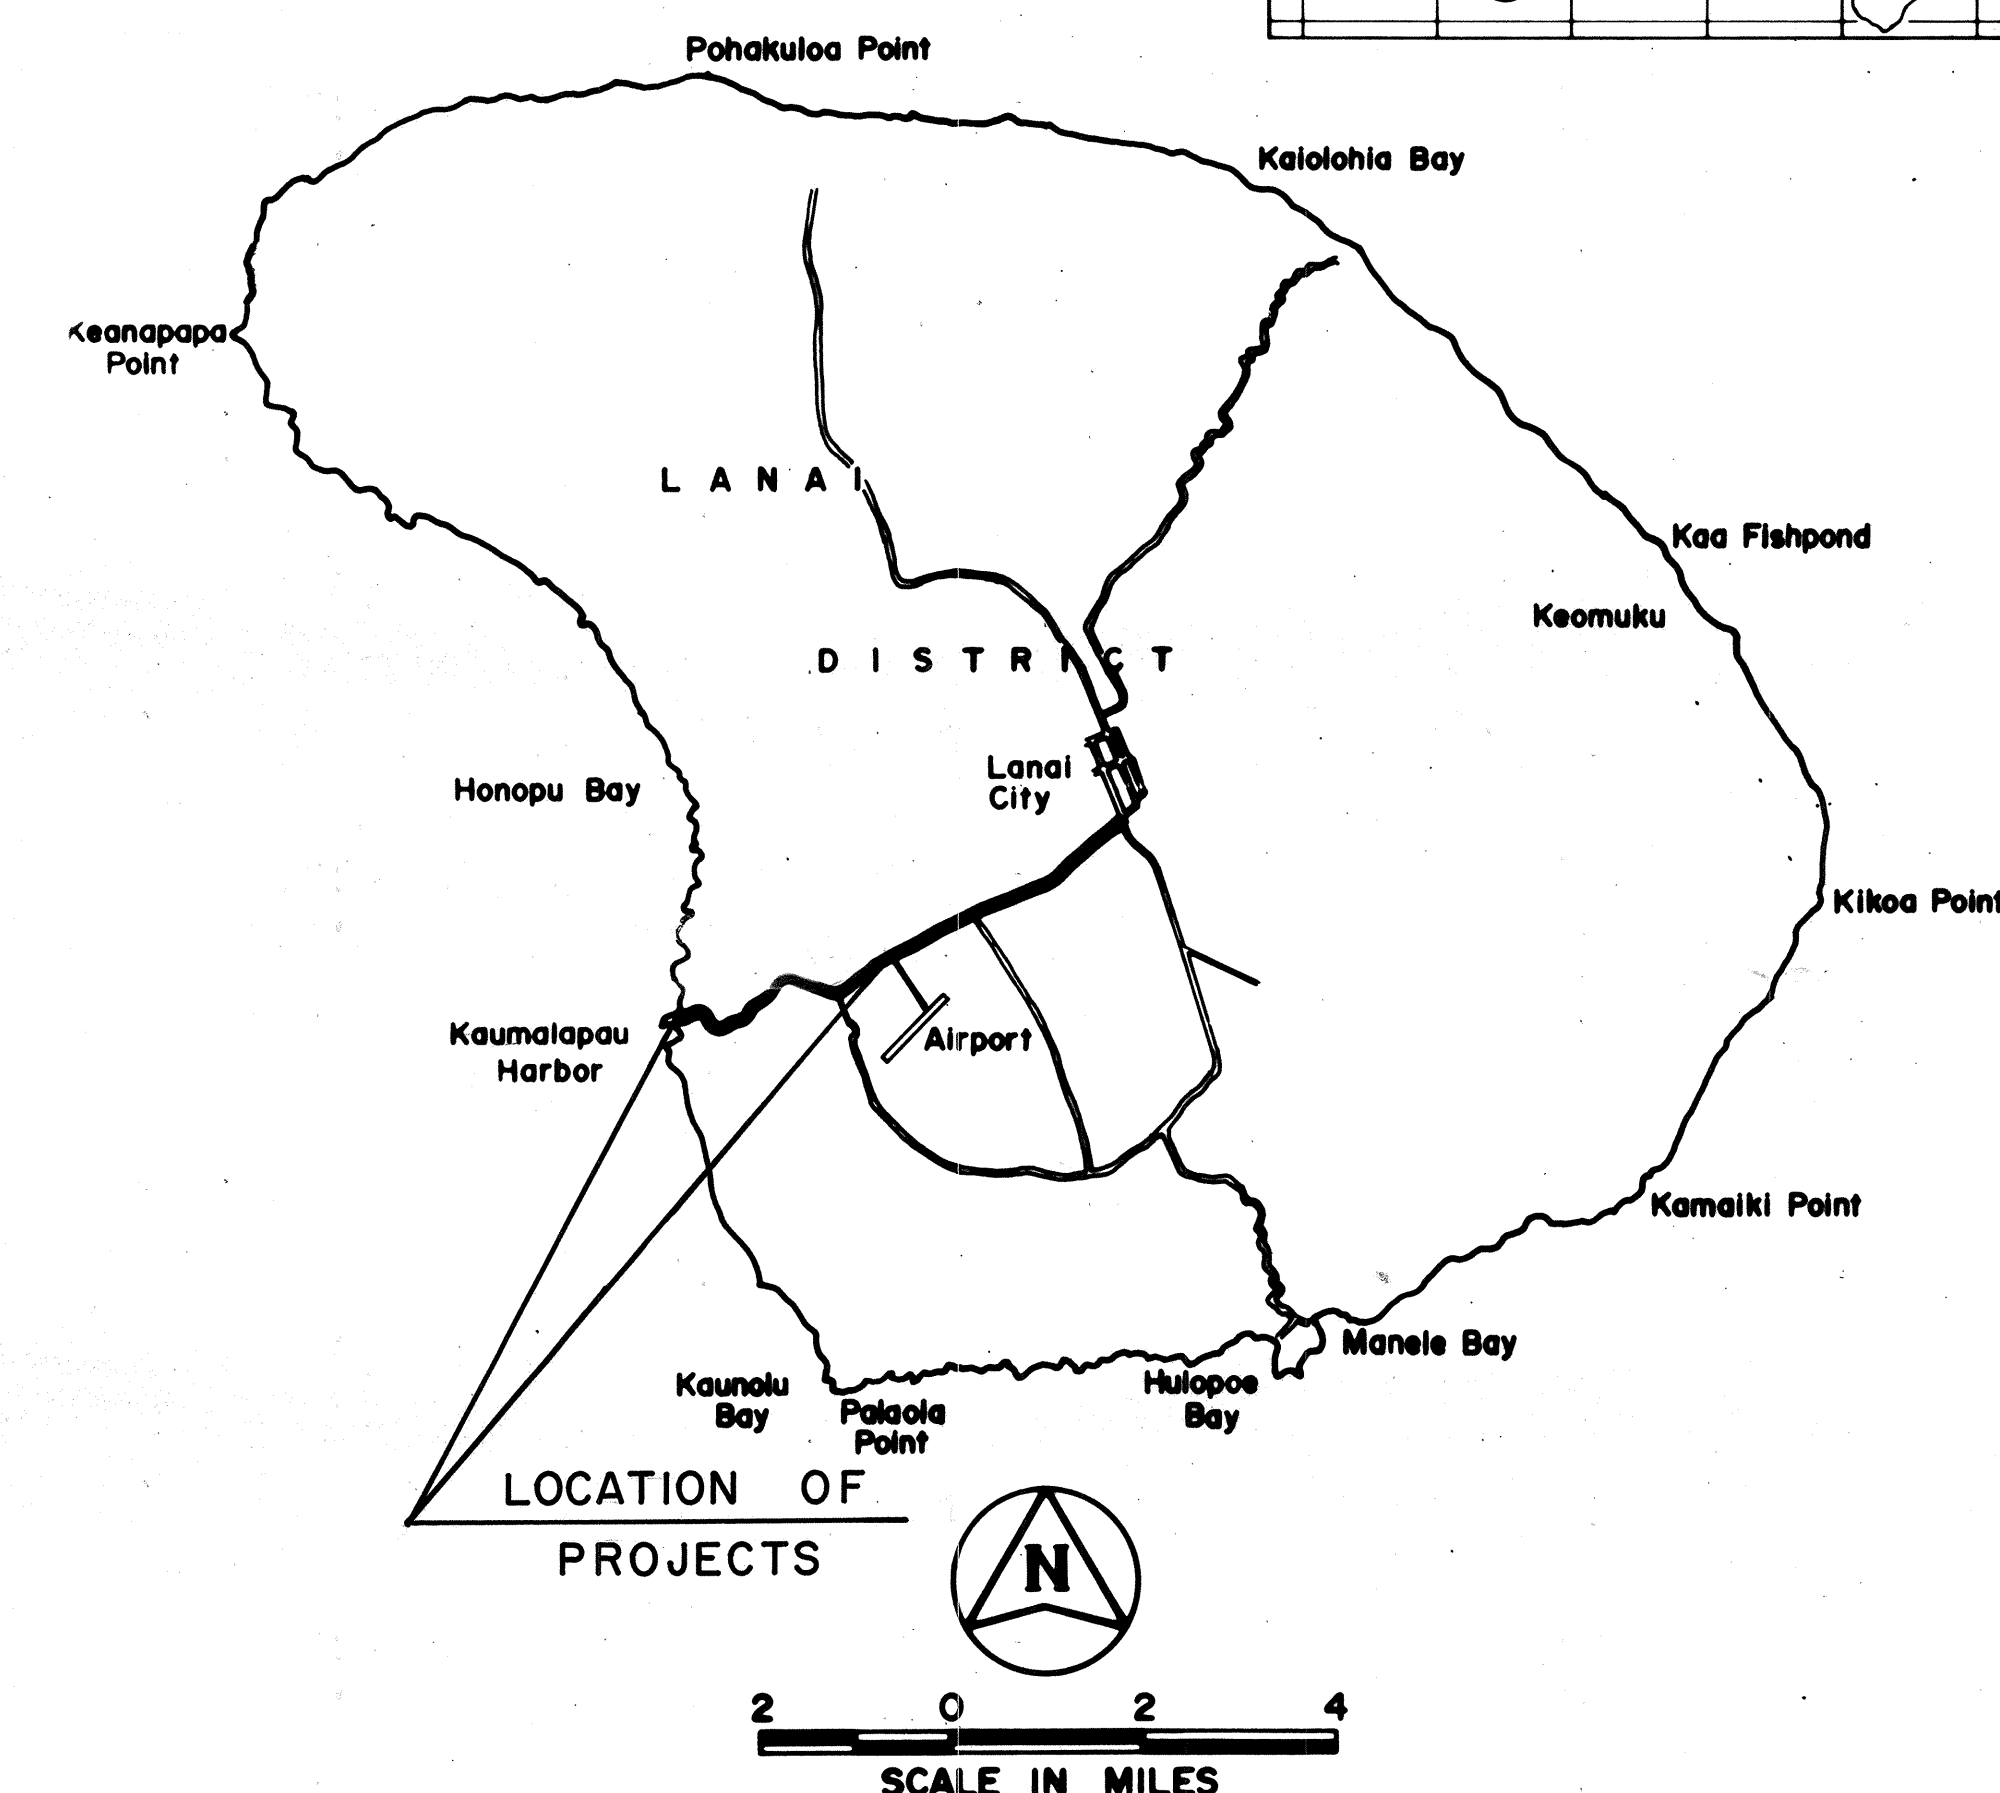
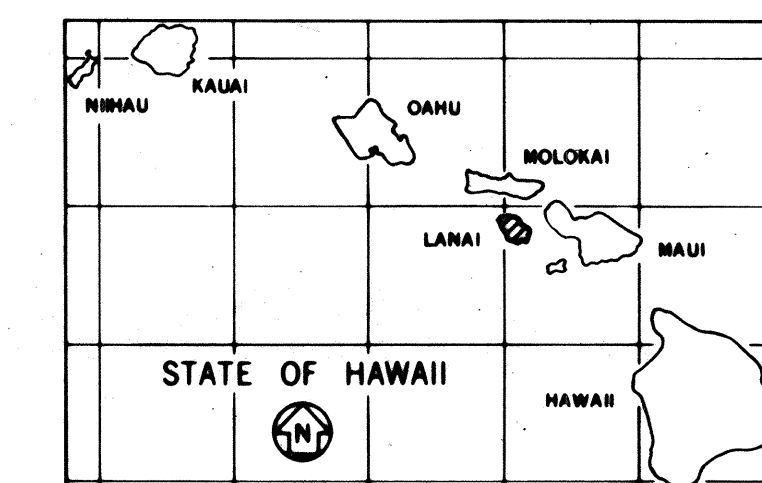
DISTRICT OF LANAI
ISLAND OF LANAI

PROJECT NO. 440A-02-81

GROSS LENGTH OF PROJECT....	0.796	Mi.
NET LENGTH OF PROJECT	0.796	Mi.



FED. ROAD DIST. NO.	STATE	PROJ. NO.	FISCAL YEAR	SHEET NO.	TOTAL SHEETS
HAWAII	HAW.	440A-01-81M 440A-02-81	1981	1	13

FEDERAL AID PROJECTS PREVIOUSLY CONSTRUCTED
OR UNDER CONSTRUCTION

IMPROVEMENTS CONSIST OF RECONSTRUCTION OF WEAKENED PAVEMENT AREA, AND INSTALLATION OF GUARDRAILS.

Stanley F. Kato
RESIDENT ENGINEER

DEPARTMENT OF TRANSPORTATION STATE OF HAWAII	
APPROVED: <i>James R. Carras 5/24</i>	
DIRECTOR OF TRANSPORTATION	DATE