

SHEET NO.	INDEX TO DRAWINGS  DESCRIPTION	THEOF HAMP
	TITLE SHEET	
2	TYPICAL SECTION & GENERAL NOTES	STATE OF HAWAII
3 -8	STANDARD DETAILS	of War
		DEPARTMENT OF TRANSPORTATION
		HIGHWAYS DIVISION
		HONOLULU, HAWAII
		"AS-BUILT"
		PLANS FOR
		MANELE ROAD
		GUARD RAIL IMPROVEMENTS
		PROJECT NO. 440B-02-82
		DISTRICT OF LANAI ISLAND OF LANAI
		ISLAND OF LANAI
		MANELE ROAD
		PROJ. NO. 440B-02-82
		A   A   A   A   A   A   A   A   A   A
en e		DECT PROPERTY OF THE COLUMN AND THE
982		PRO DE COMPANY DE COMP
		M. P. M. P. S. C.
APRII		
537 NE		Z Z
8-75 HONI		
54		Manele Bay
<b>→</b>		Pacific
iarot E E		Ocean
S. 8. 8.		
₾ .		
8		LAYOUT OF PROJECT
NED I		2000 0 2000 4000
Unit DESIGNE		SCALE IN FEET

FED. ROAD DIST. NO. STATE PROJ. NO. FISCAL SHEET TOTAL YEAR NO. SHEETS

HAWAII HAW. 4408-02-82 1982 1 8



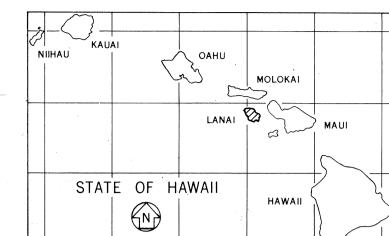

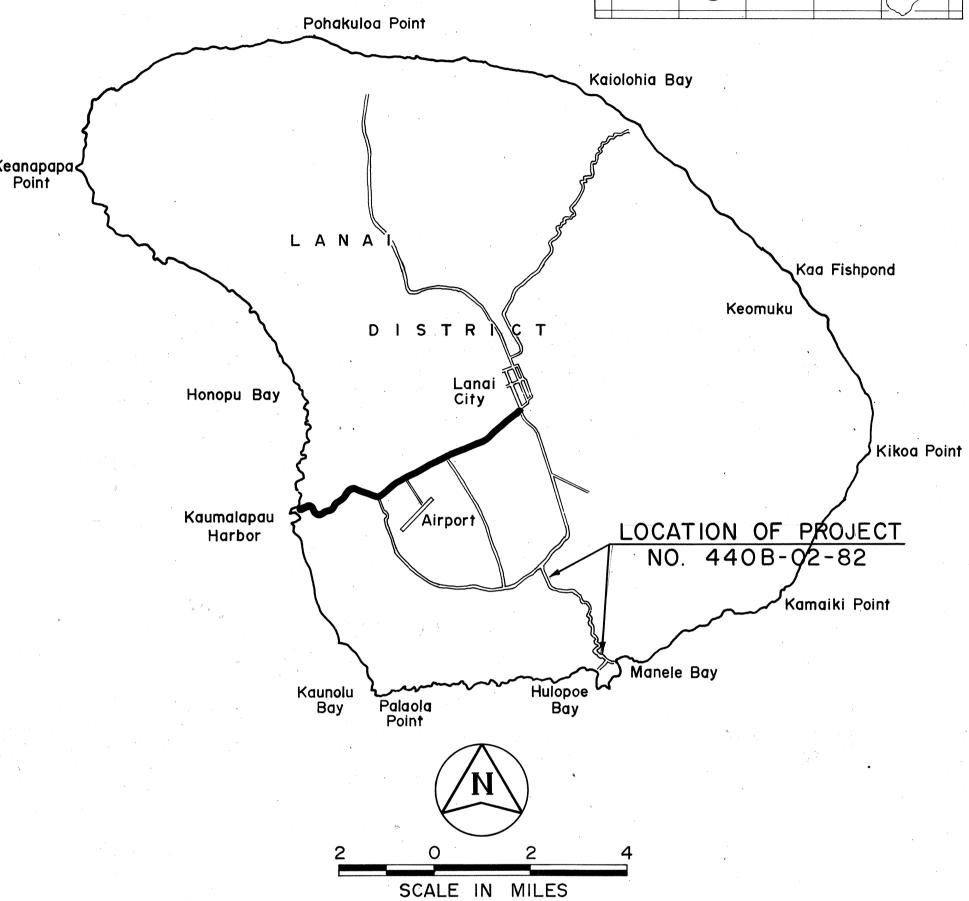

FEDERAL AID PROJECTS PREVIOUSLY CONSTRUCTED OR UNDER CONSTRUCTION

ALL CHANGES MADE DURING CONSTRUCTION HAVE BEEN INCORPORATED ON THESE PLANS IN RED EXCEPT CHANGES IN THE ORIGINAL THEORETICAL QUANTITIES. FOR ACTUAL QUANTITIES, REFER TO PROJECT LEDGER AND/OR COMPUTATION BOOK.

Cary Gamashita RESIDENT ENGINEER

5-17-83 DATE

DEPARTMENT OF TRANSPORTATION
STATE OF HAWAII

APPROVED:

LDIR. OF TRANSPORTATION

DATE