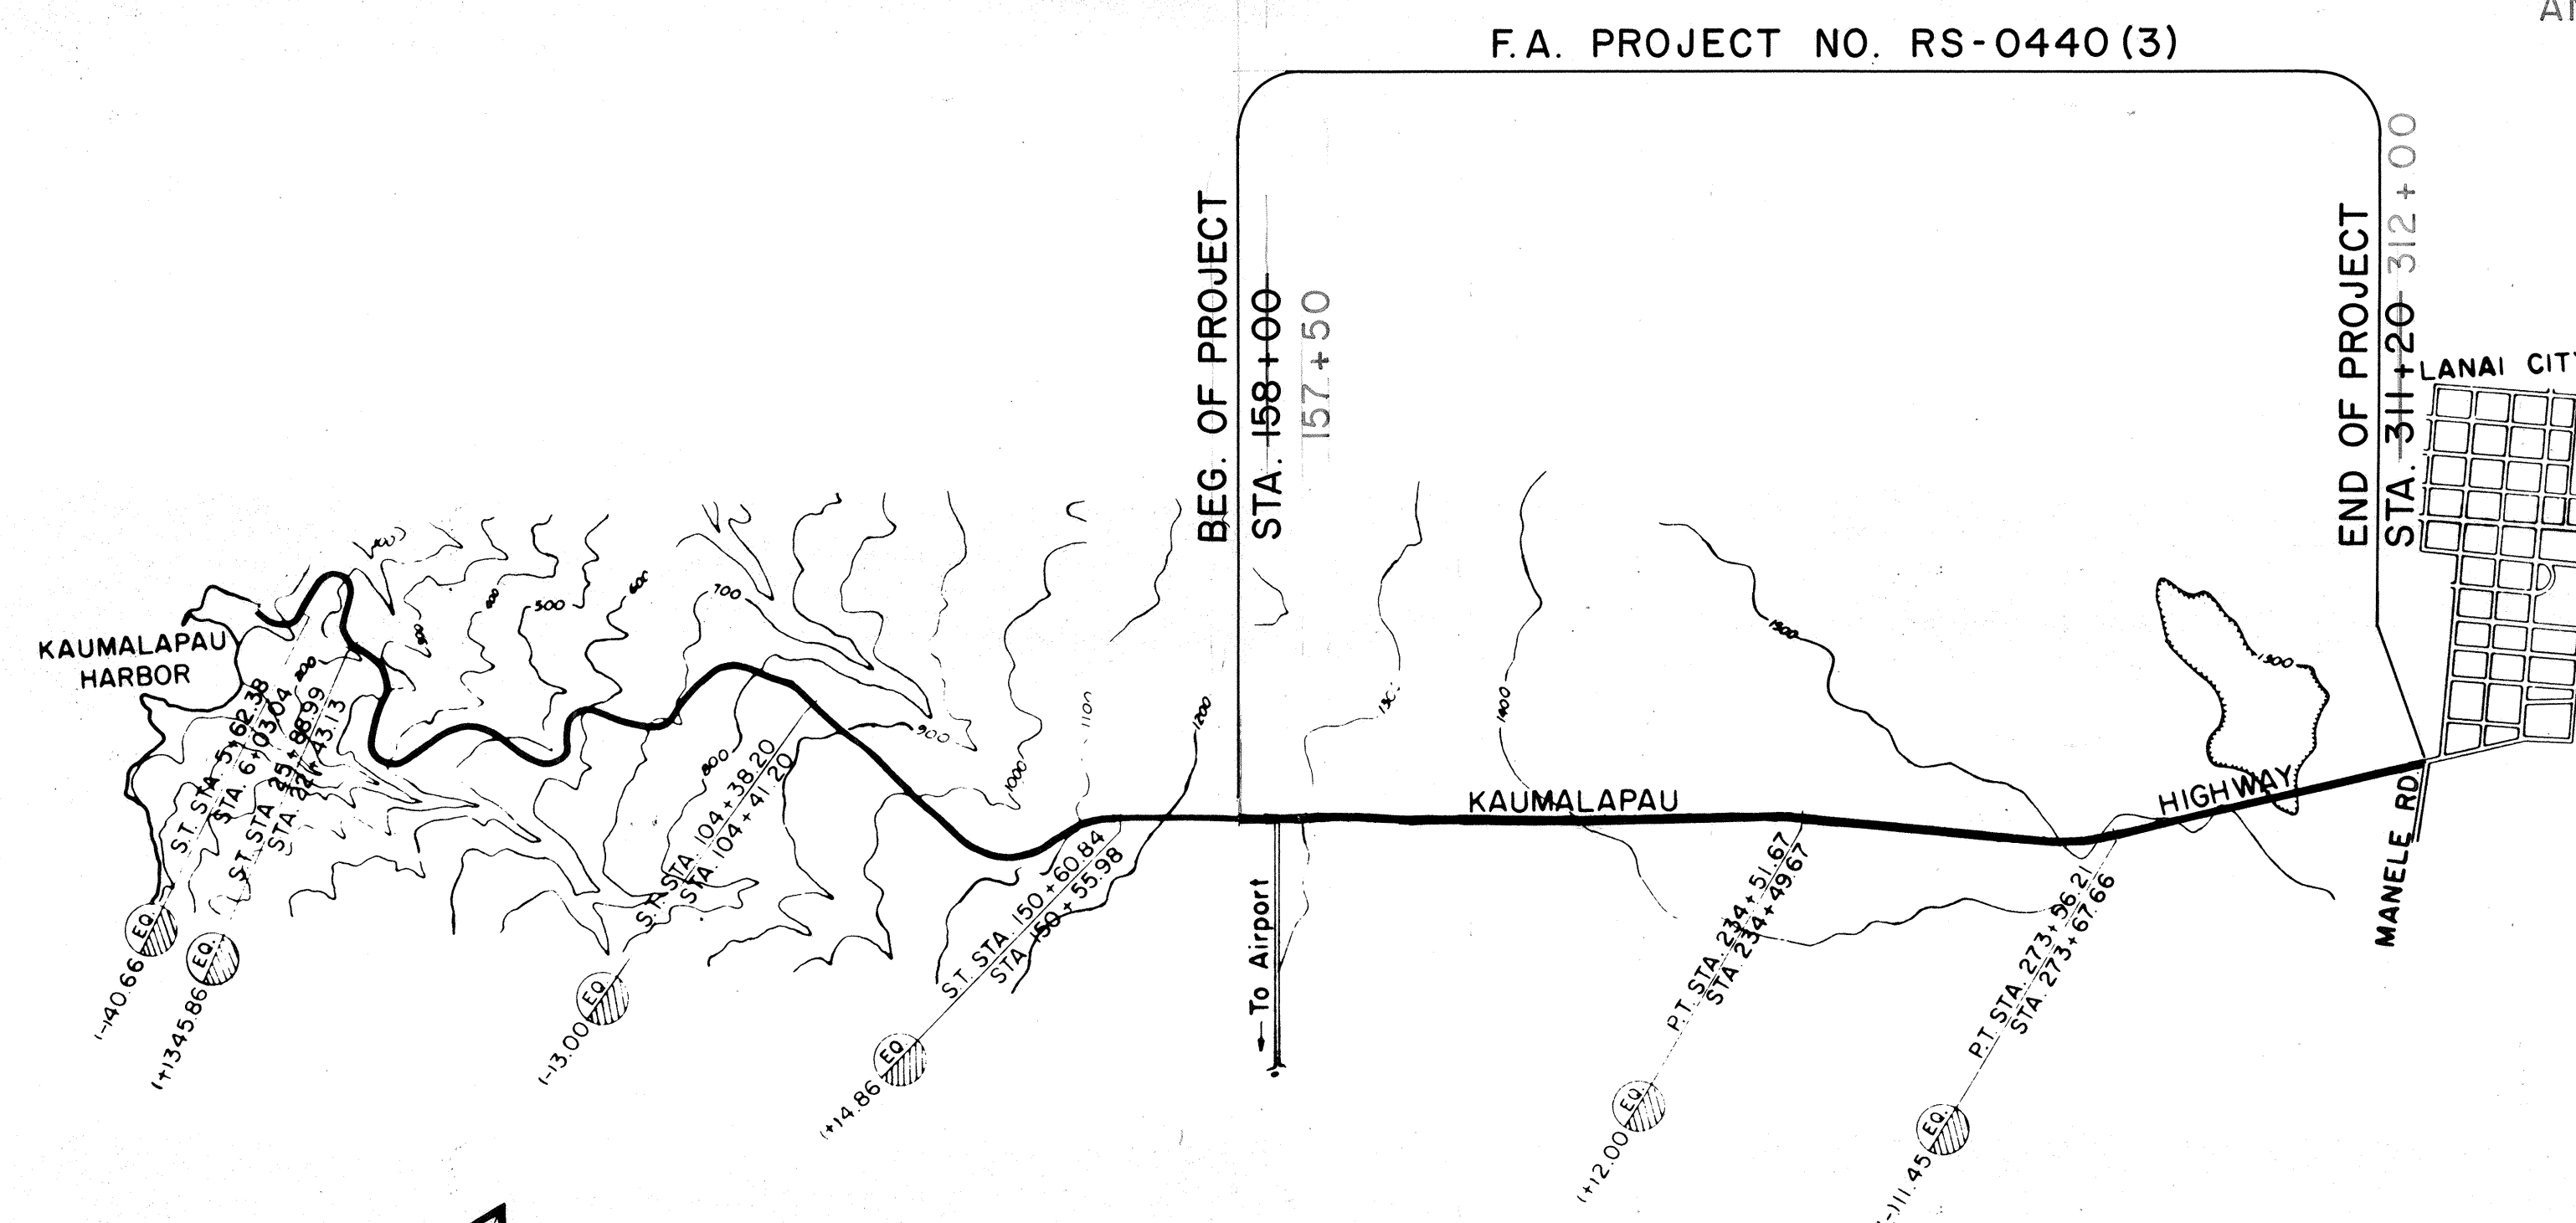


[illegible]

* TOTAL = 4

DISTRICT OF LANAI
ISLAND OF LANAI


RESIDENT ENGINEER

FEDERAL AID PROJECTS PREVIOUSLY CONSTRUCTED
OR UNDER CONSTRUCTION

DESIGN DESIGNATION

LAYOUT OF PROJECT

FED. ROAD DIST. NO.	STATE	FED. AID PROJ. NO.	FISCAL YEAR	SHEET NO.	TOTAL SHEETS
HAWAII	HAW.	RS-0440 (3)	1987	1	3

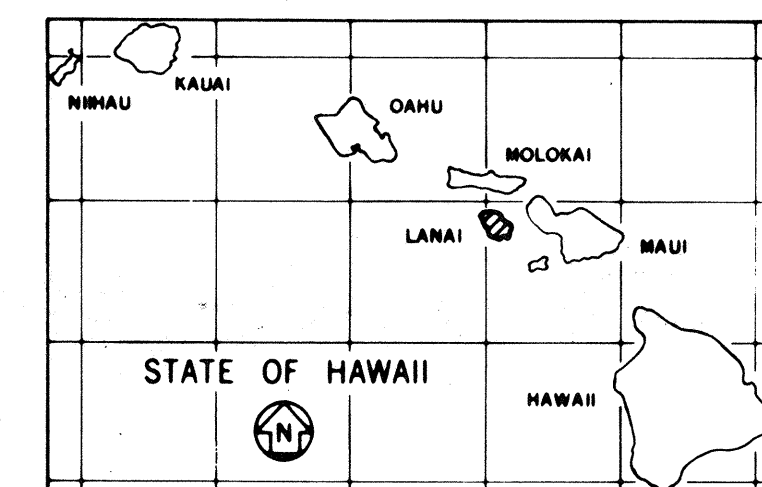

DEPARTMENT OF TRANSPORTATION
STATE OF HAWAII

APPROVED:

for Cheryl D. Poorn 9/2/88
DIR. OF TRANSPORTATION DAT