
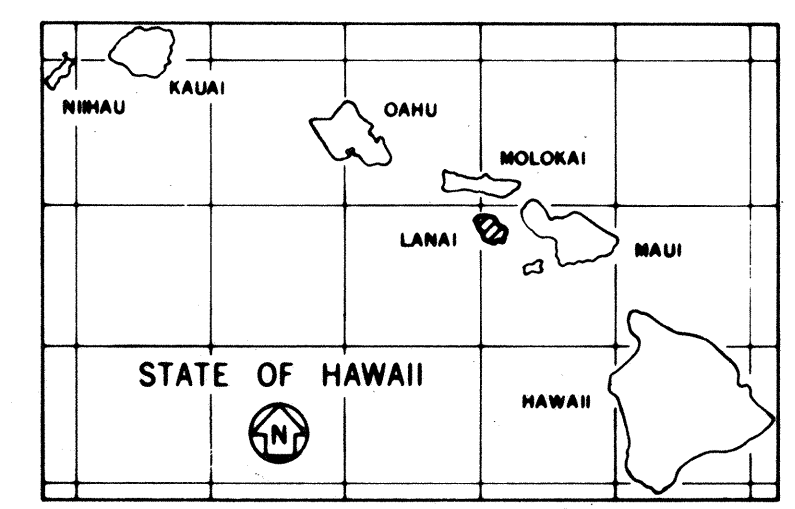


INDEX TO DRAWINGS	
SHEET NO.	DESCRIPTION
1	TITLE SHEET
2	STANDARD PLANS SUMMARY
3	TYPICAL SECTION AND GENERAL NOTES



FED. ROAD DIST. NO.	STATE	PROJ. NO.	FISCAL YEAR	SHEET NO.	TOTAL SHEETS
HAWAII	HAW.	440A-02-88	1988	1	3

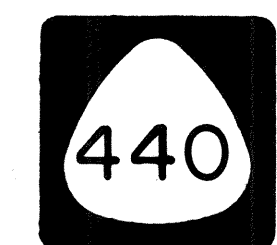

STATE OF HAWAII
DEPARTMENT OF TRANSPORTATION
HIGHWAYS DIVISION
"AS-BUILT"
PLANS FOR

KAUMALAPAU HIGHWAY SHOULDER IMPROVEMENTS
Kaumalapau Harbor towards Lanai City
PROJECT NO. 440A-02-88

DISTRICT OF LANAI
ISLAND OF LANAI

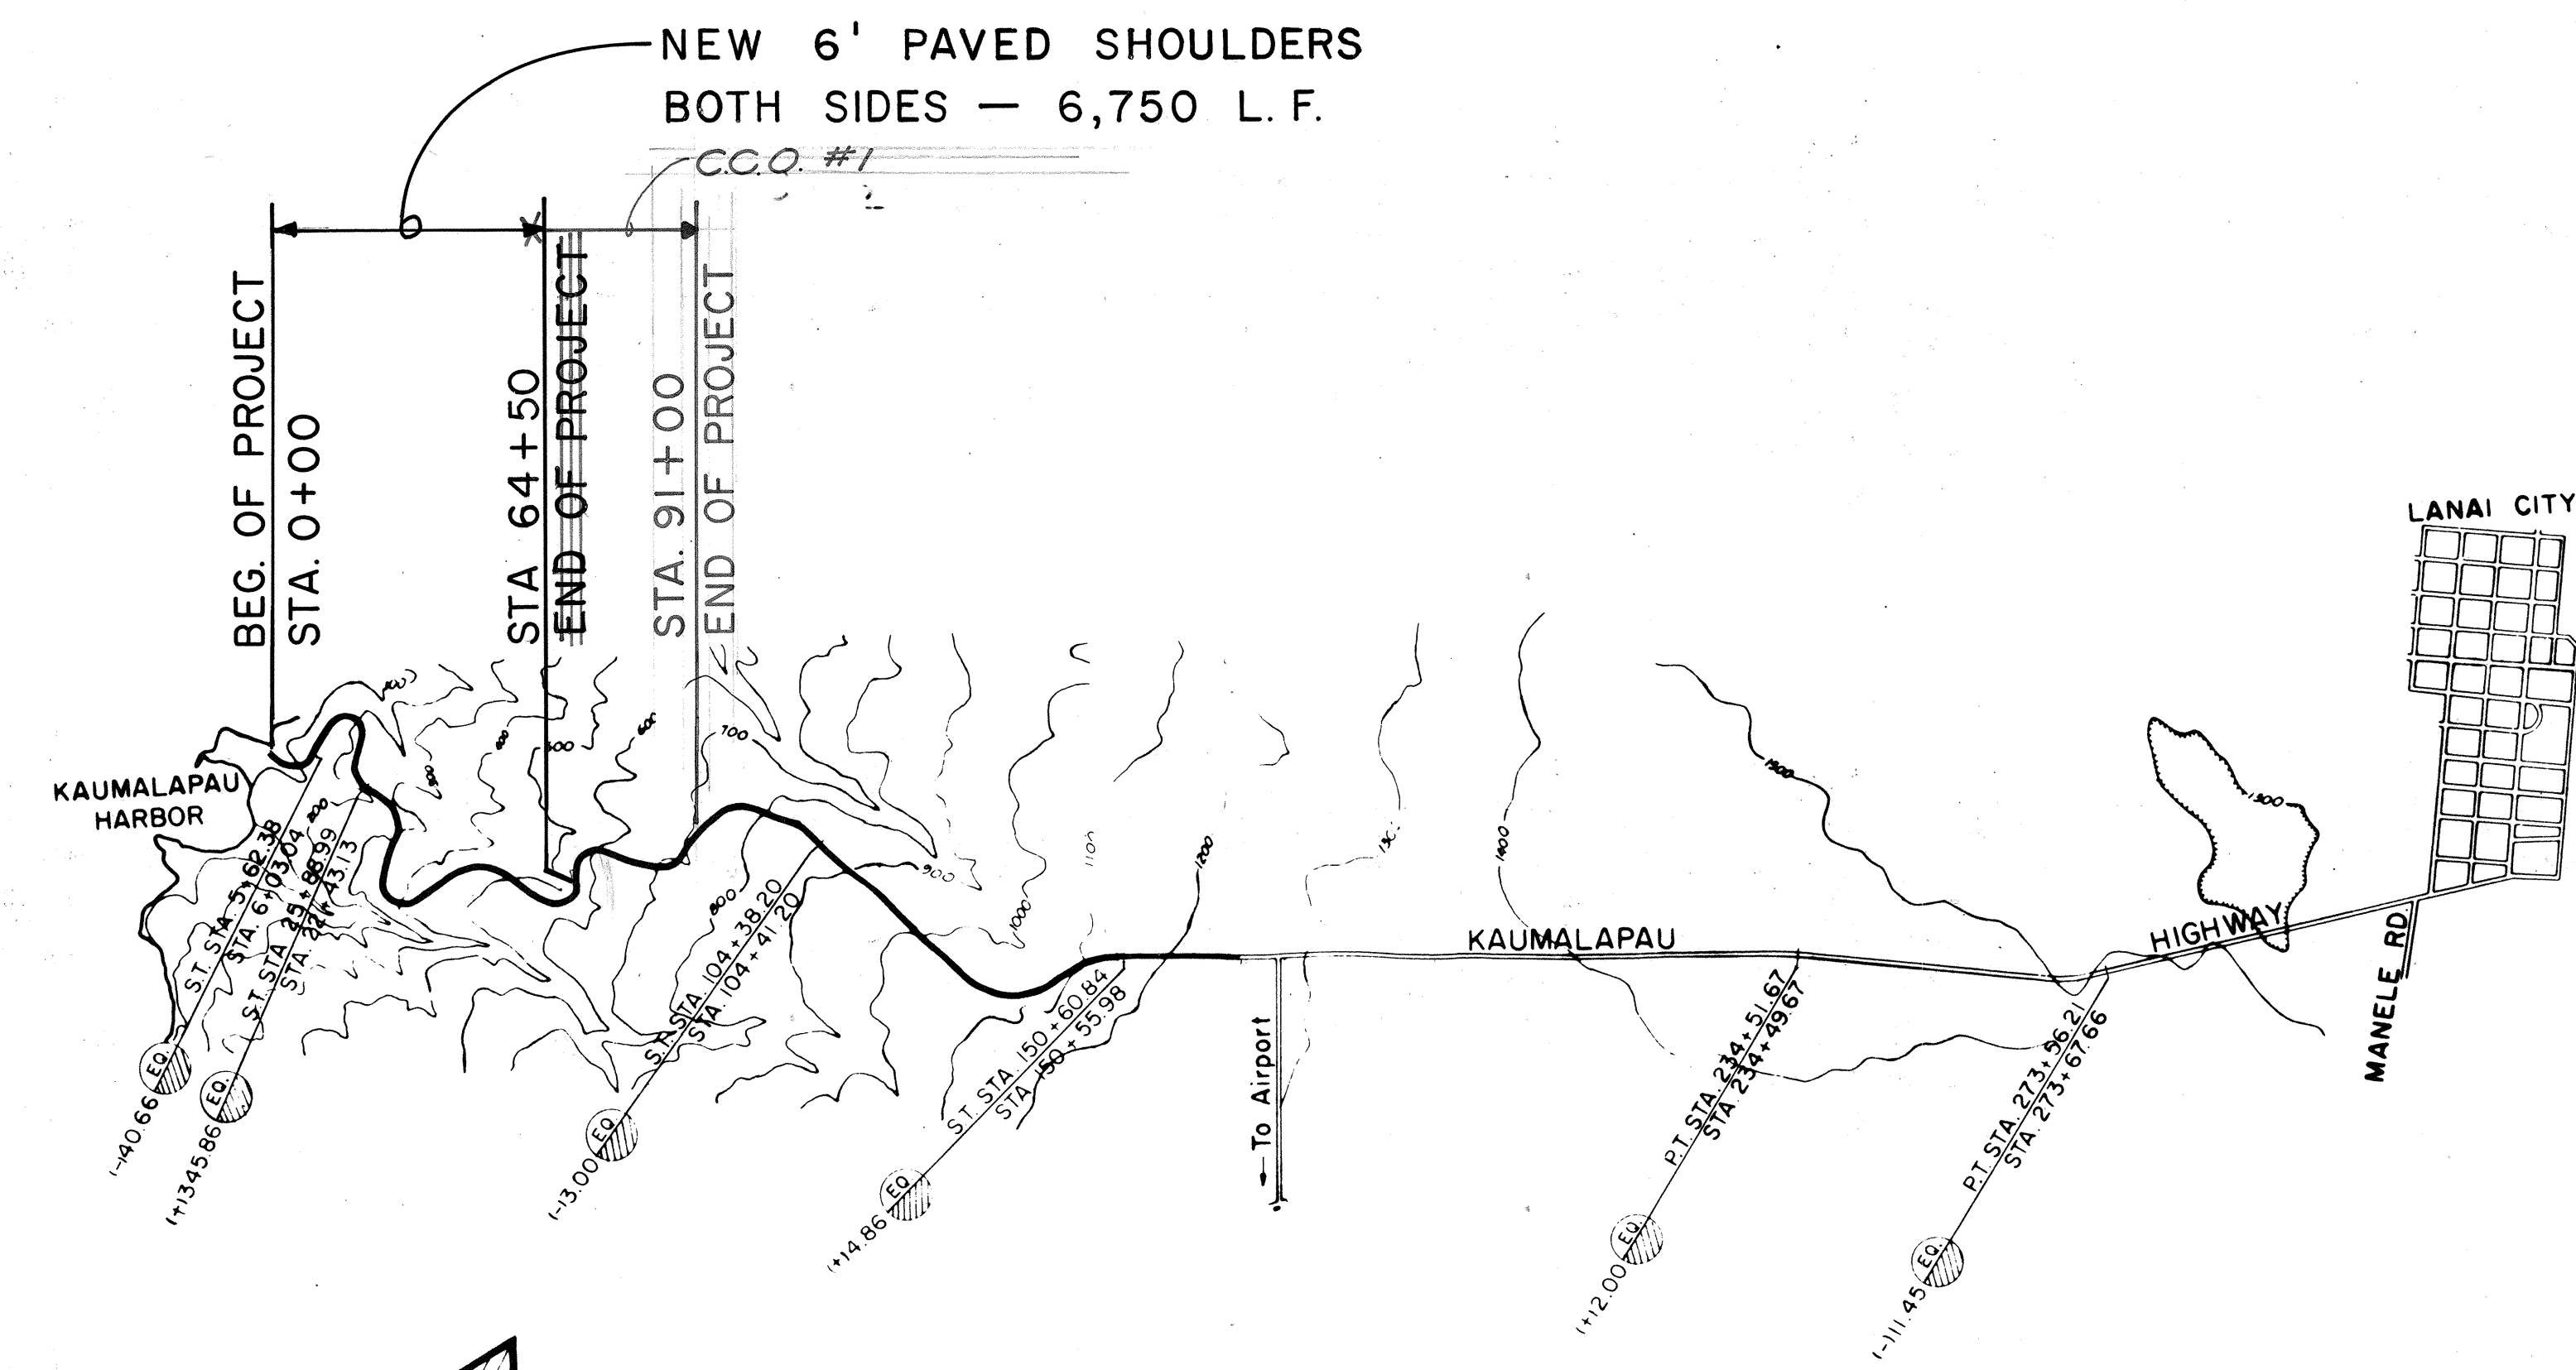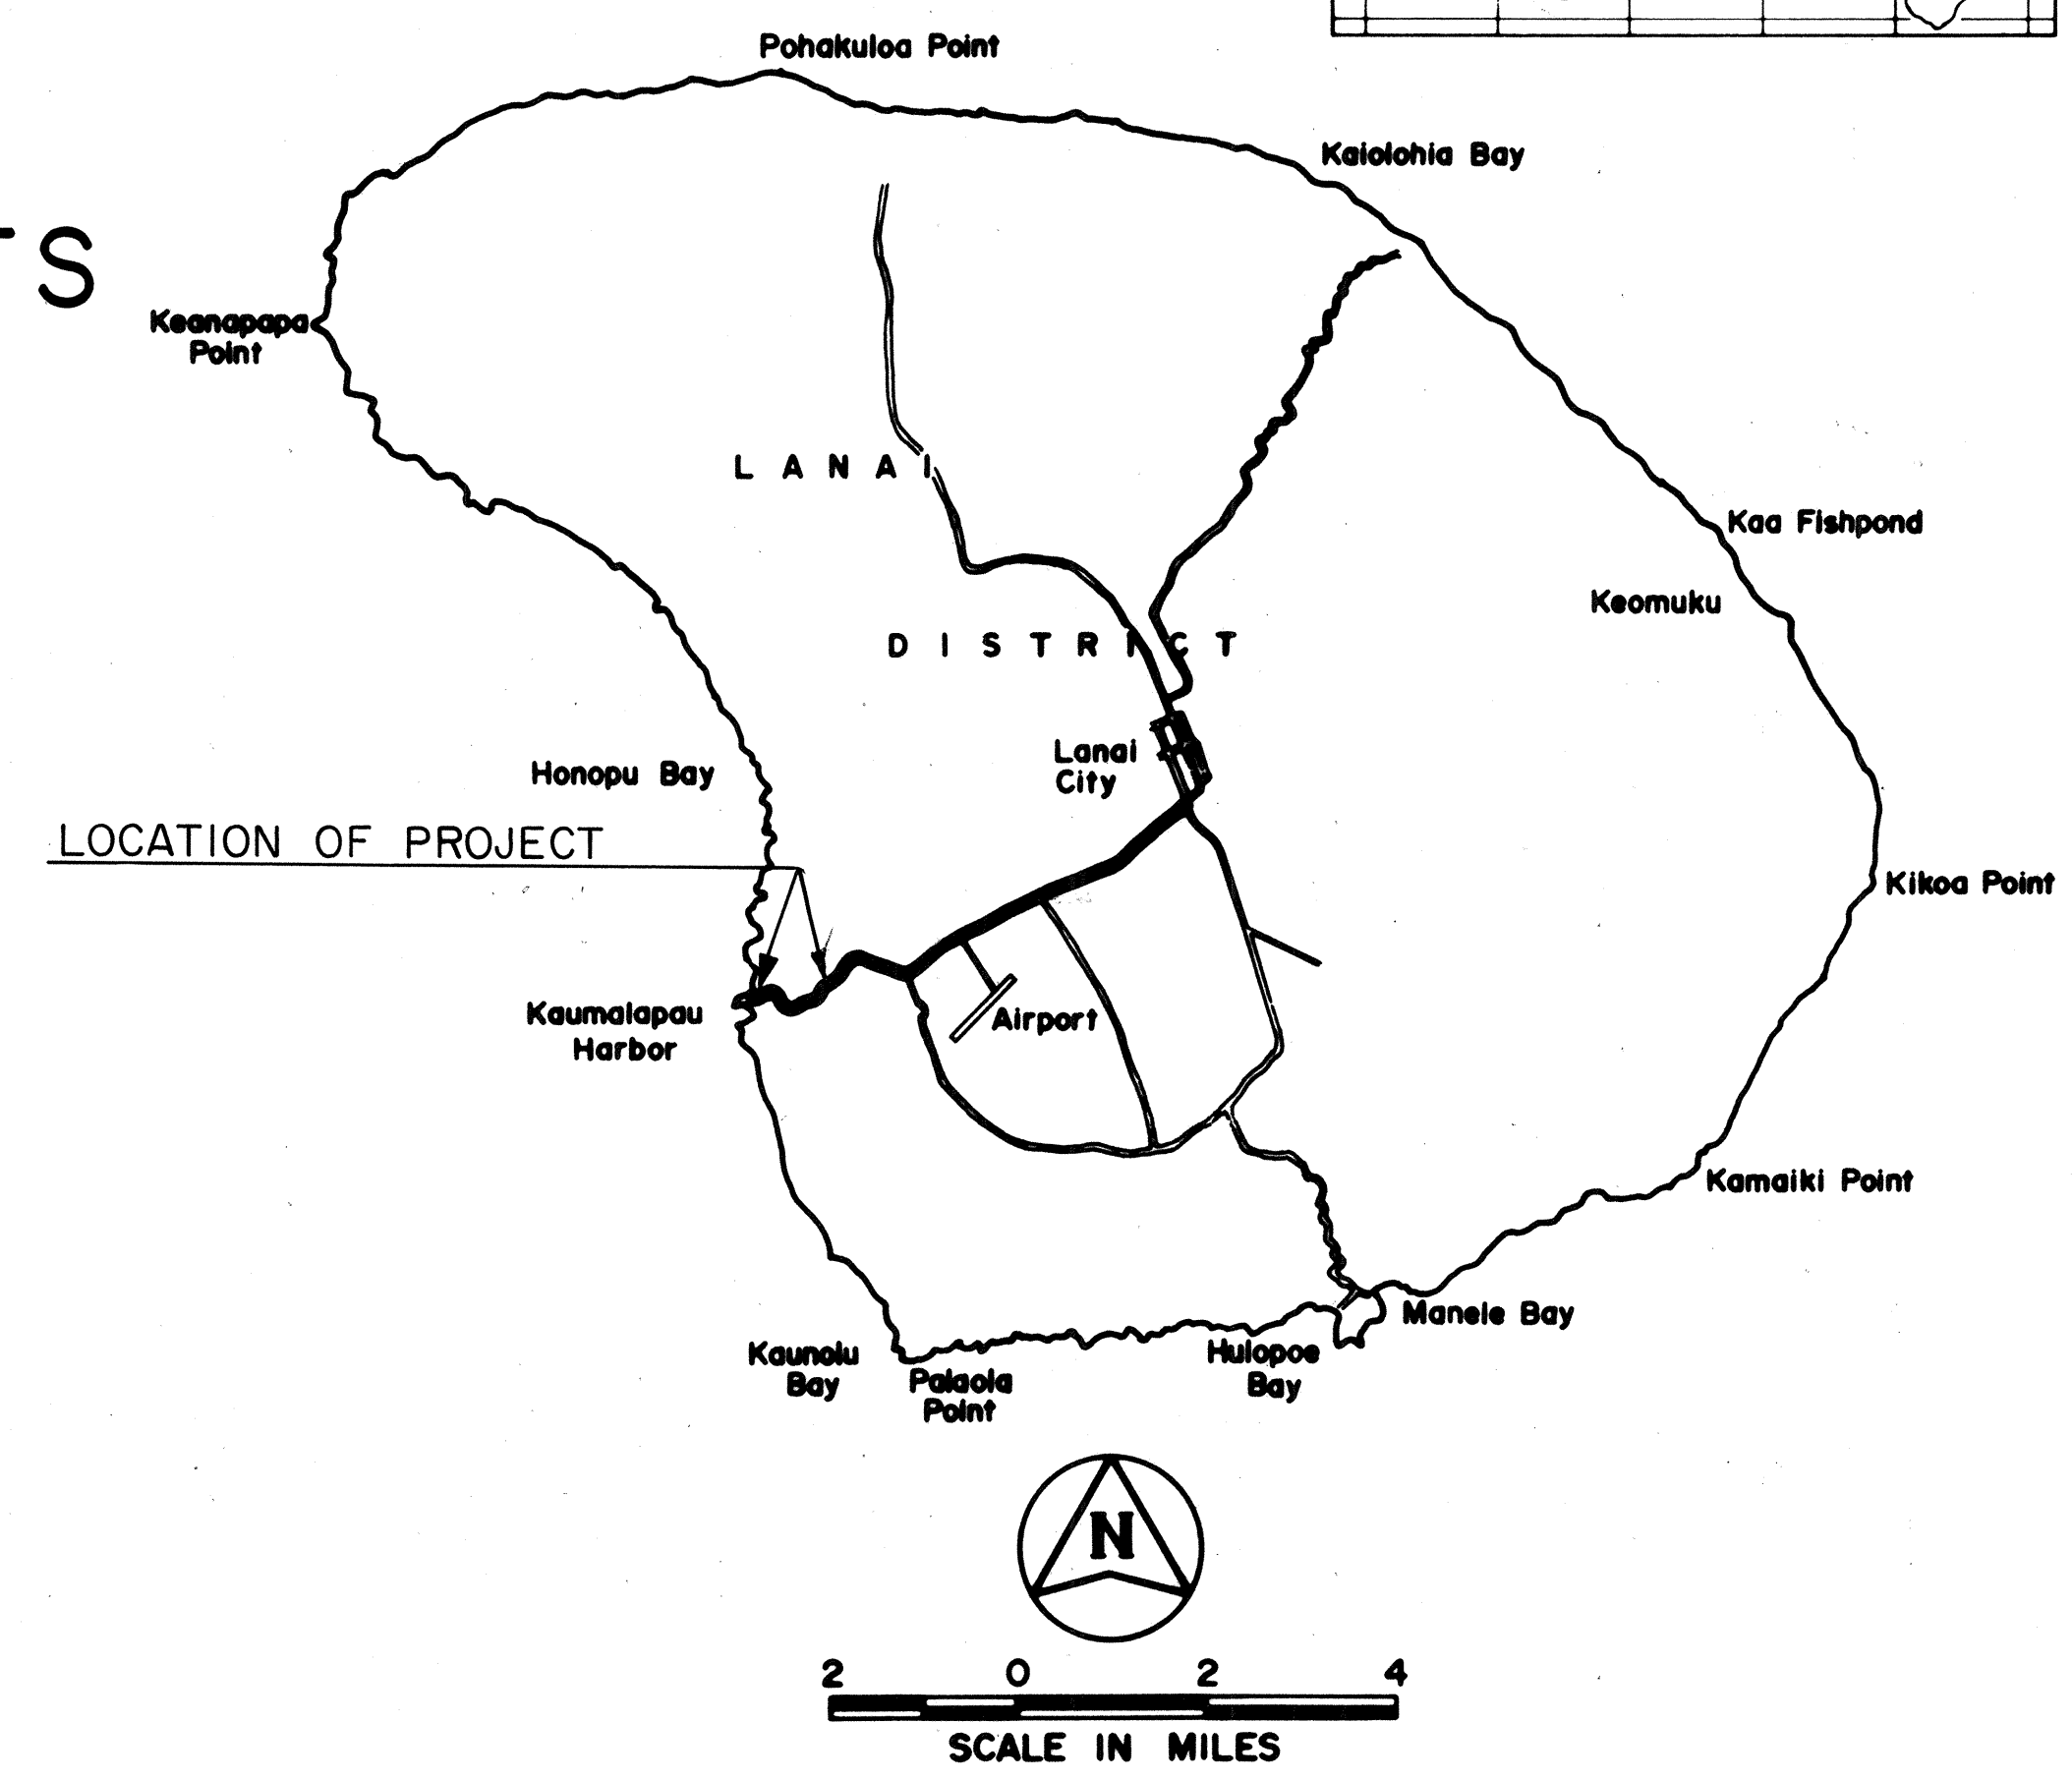

LAYOUT OF PROJECT
SCALE IN THOUSAND FEET
LENGTH OF PROJECT 3.278 MI.

CHANGES MADE DURING CONSTRUCTION HAVE BEEN INCORPORATED ON THESE PLANS EXCEPT CHANGES IN THE ORIGINAL THEORETICAL QUANTITIES. FOR ACTUAL QUANTITIES, REFER TO PROJECT LEDGER AND/OR COMPUTATION BOOK.

Joe Kamea
RESIDENT ENGINEER
2/16/89
DATE

DEPARTMENT OF TRANSPORTATION
STATE OF HAWAII
APPROVED:
Edmund J. Smith 5/6/88
DIRECTOR OF TRANSPORTATION DATE

DESIGNED BY A. YAMAGUCHI 548-7534 4-27-88
P. S. & E. BY PHONE DATE

00-C-4-3