


FED. ROAD DIST. NO.	STATE	PROJ. NO.	FISCAL YEAR	SHEET NO.	TOTAL SHEETS
HAWAII	HAW.	440A-01-90M	1990	4	5

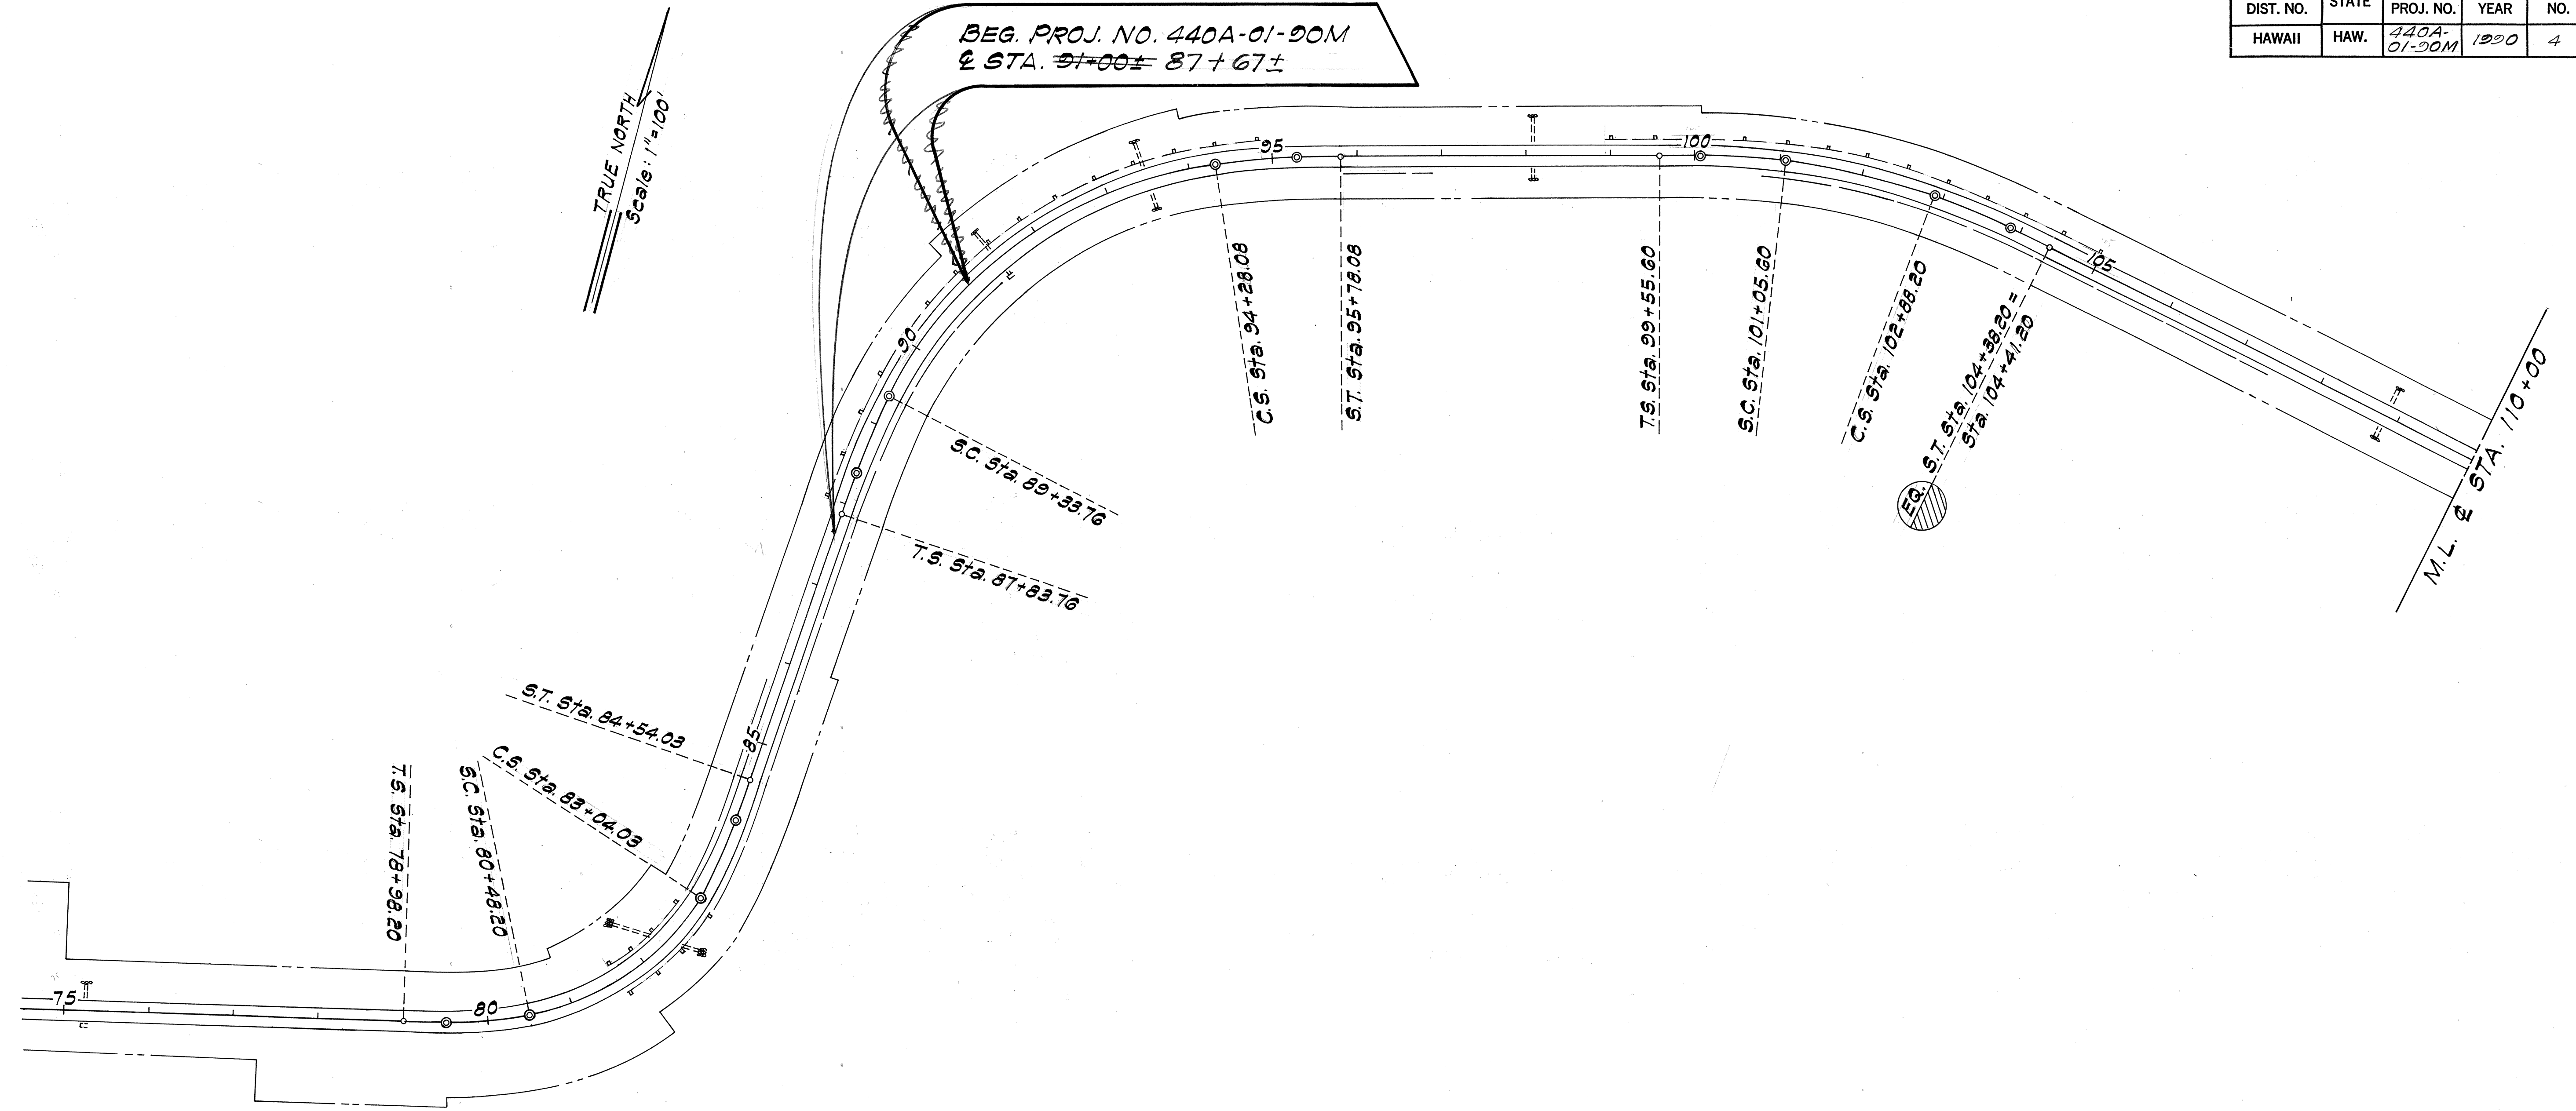

ORIGINAL PLAN	SURVEY PLOTTED BY	DATE
NOTE BOOK	DRAWN BY	
No.	TRACED BY	
	DESIGNED BY	
	QUANTITIES BY	
	CHECKED BY	

STATE OF HAWAII
DEPARTMENT OF TRANSPORTATION
LAND TRANSPORTATION FACILITIES DIVISION

PLANS


KAUMALAPALI HWY. SHOULDER PAVING
PROJECT NO. 440A-01-90M

Scale: 1"=100' Date: May, 1990

SHEET NO. 1 OF 2 SHEETS

FED. ROAD DIST. NO.	STATE	PROJ. NO.	FISCAL YEAR	SHEET NO.	TOTAL SHEETS
HAWAII	HAW.	440A-01-90M	1990	5	5

TRUE NORTH
Scale: 1"=100'

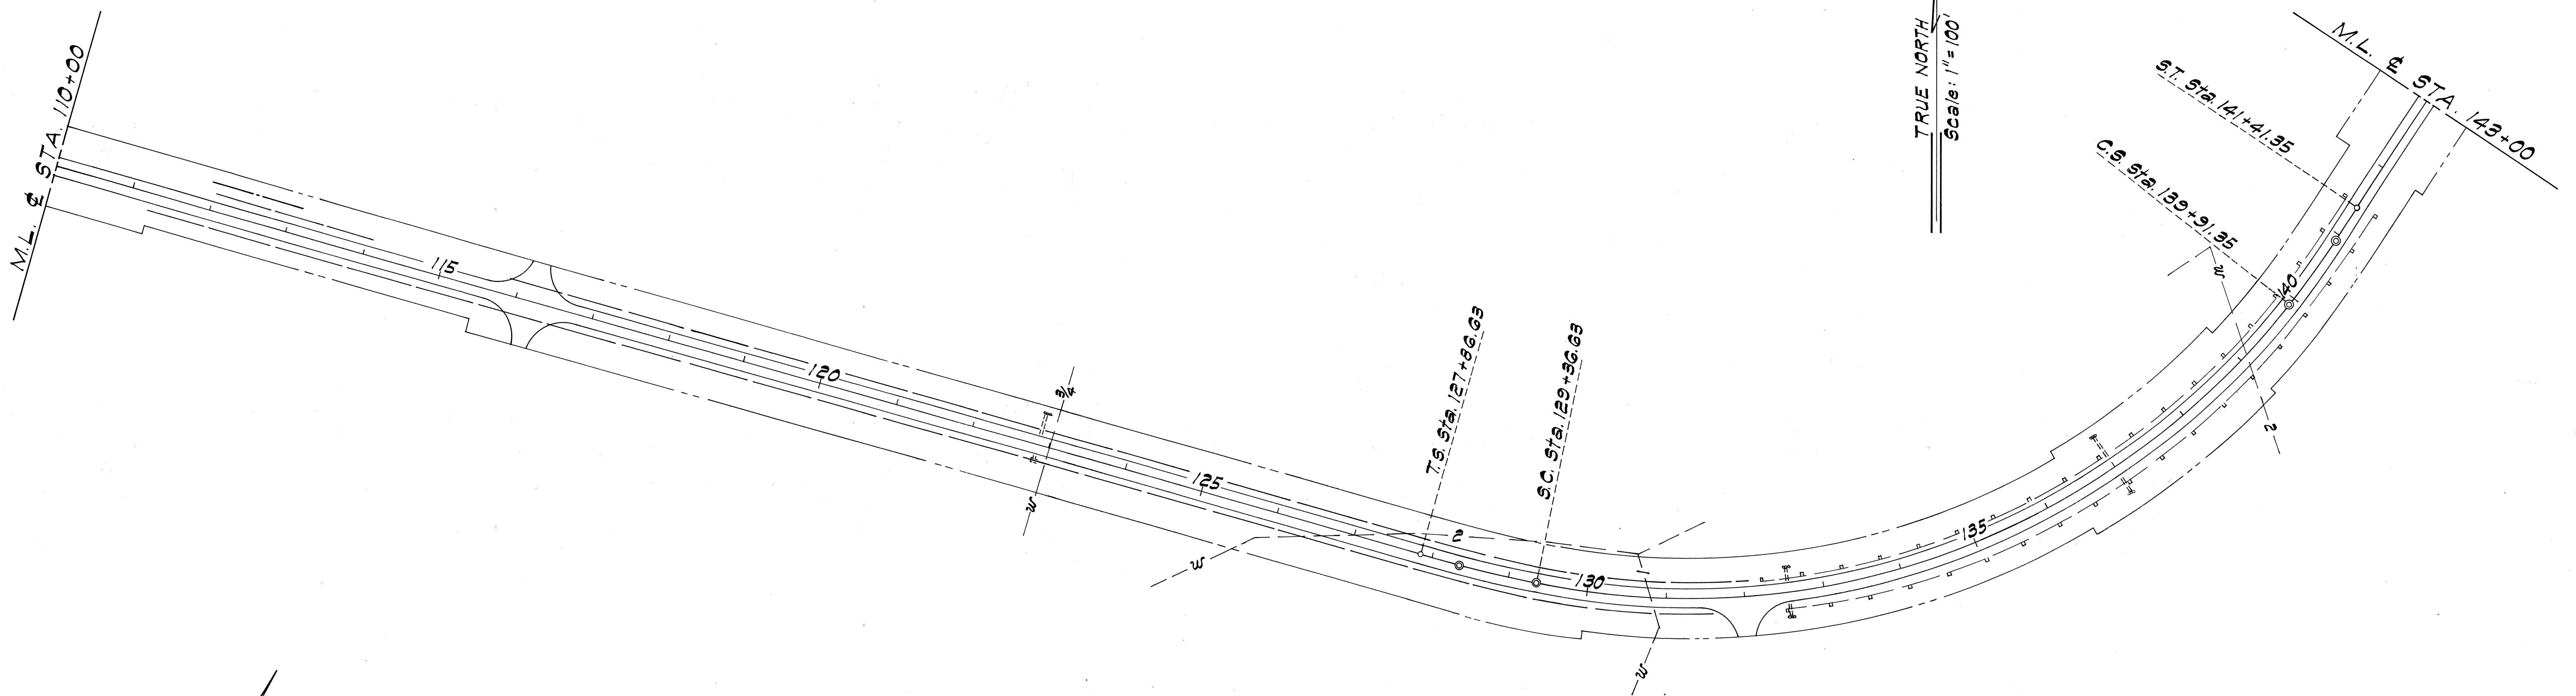


TRUE NORTH
Scale: 1"=100'

END PROJ. NO. 440A-01-90M
@ STA. 183+50

END PROJ. NO. 440A-01-90M
@ STA. 165+00±

To Airport

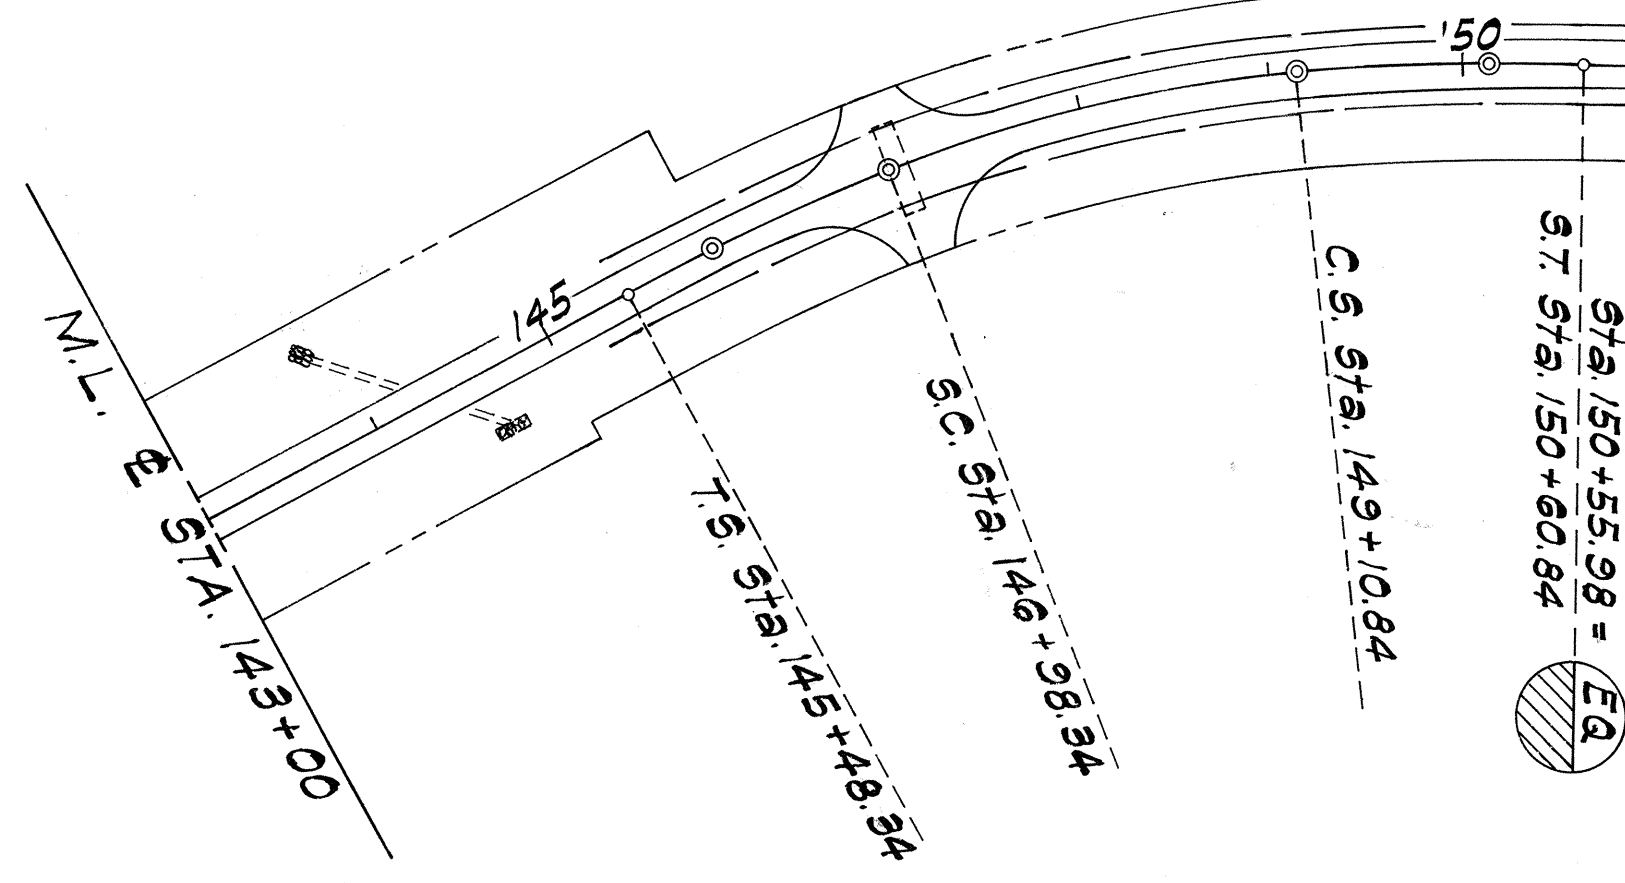

ORIGINAL PLAN	SURVEY PLOTTED BY	DATE
NOTE BOOK	DRAWN BY	"
No.	DESIGNED BY	"
	QUANTITIES BY	"
	CHECKED BY	"

STATE OF HAWAII
DEPARTMENT OF TRANSPORTATION
LAND TRANSPORTATION FACILITIES DIVISION

PLANS

KAUMALAPAU HWY. SHOULDER PAVING
PROJECT NO. 440A-01-90M
Scale: 1"=100' Date: May, 1990
SHEET NO. 2 OF 2 SHEETS