


FED. ROAD DIST. NO.	STATE	FED. AID PROJ. NO.	FISCAL YEAR	SHEET NO.	TOTAL SHEETS
HAWAII	HAW.	STP-0440(5)	1994	ADD. 14S-1	23

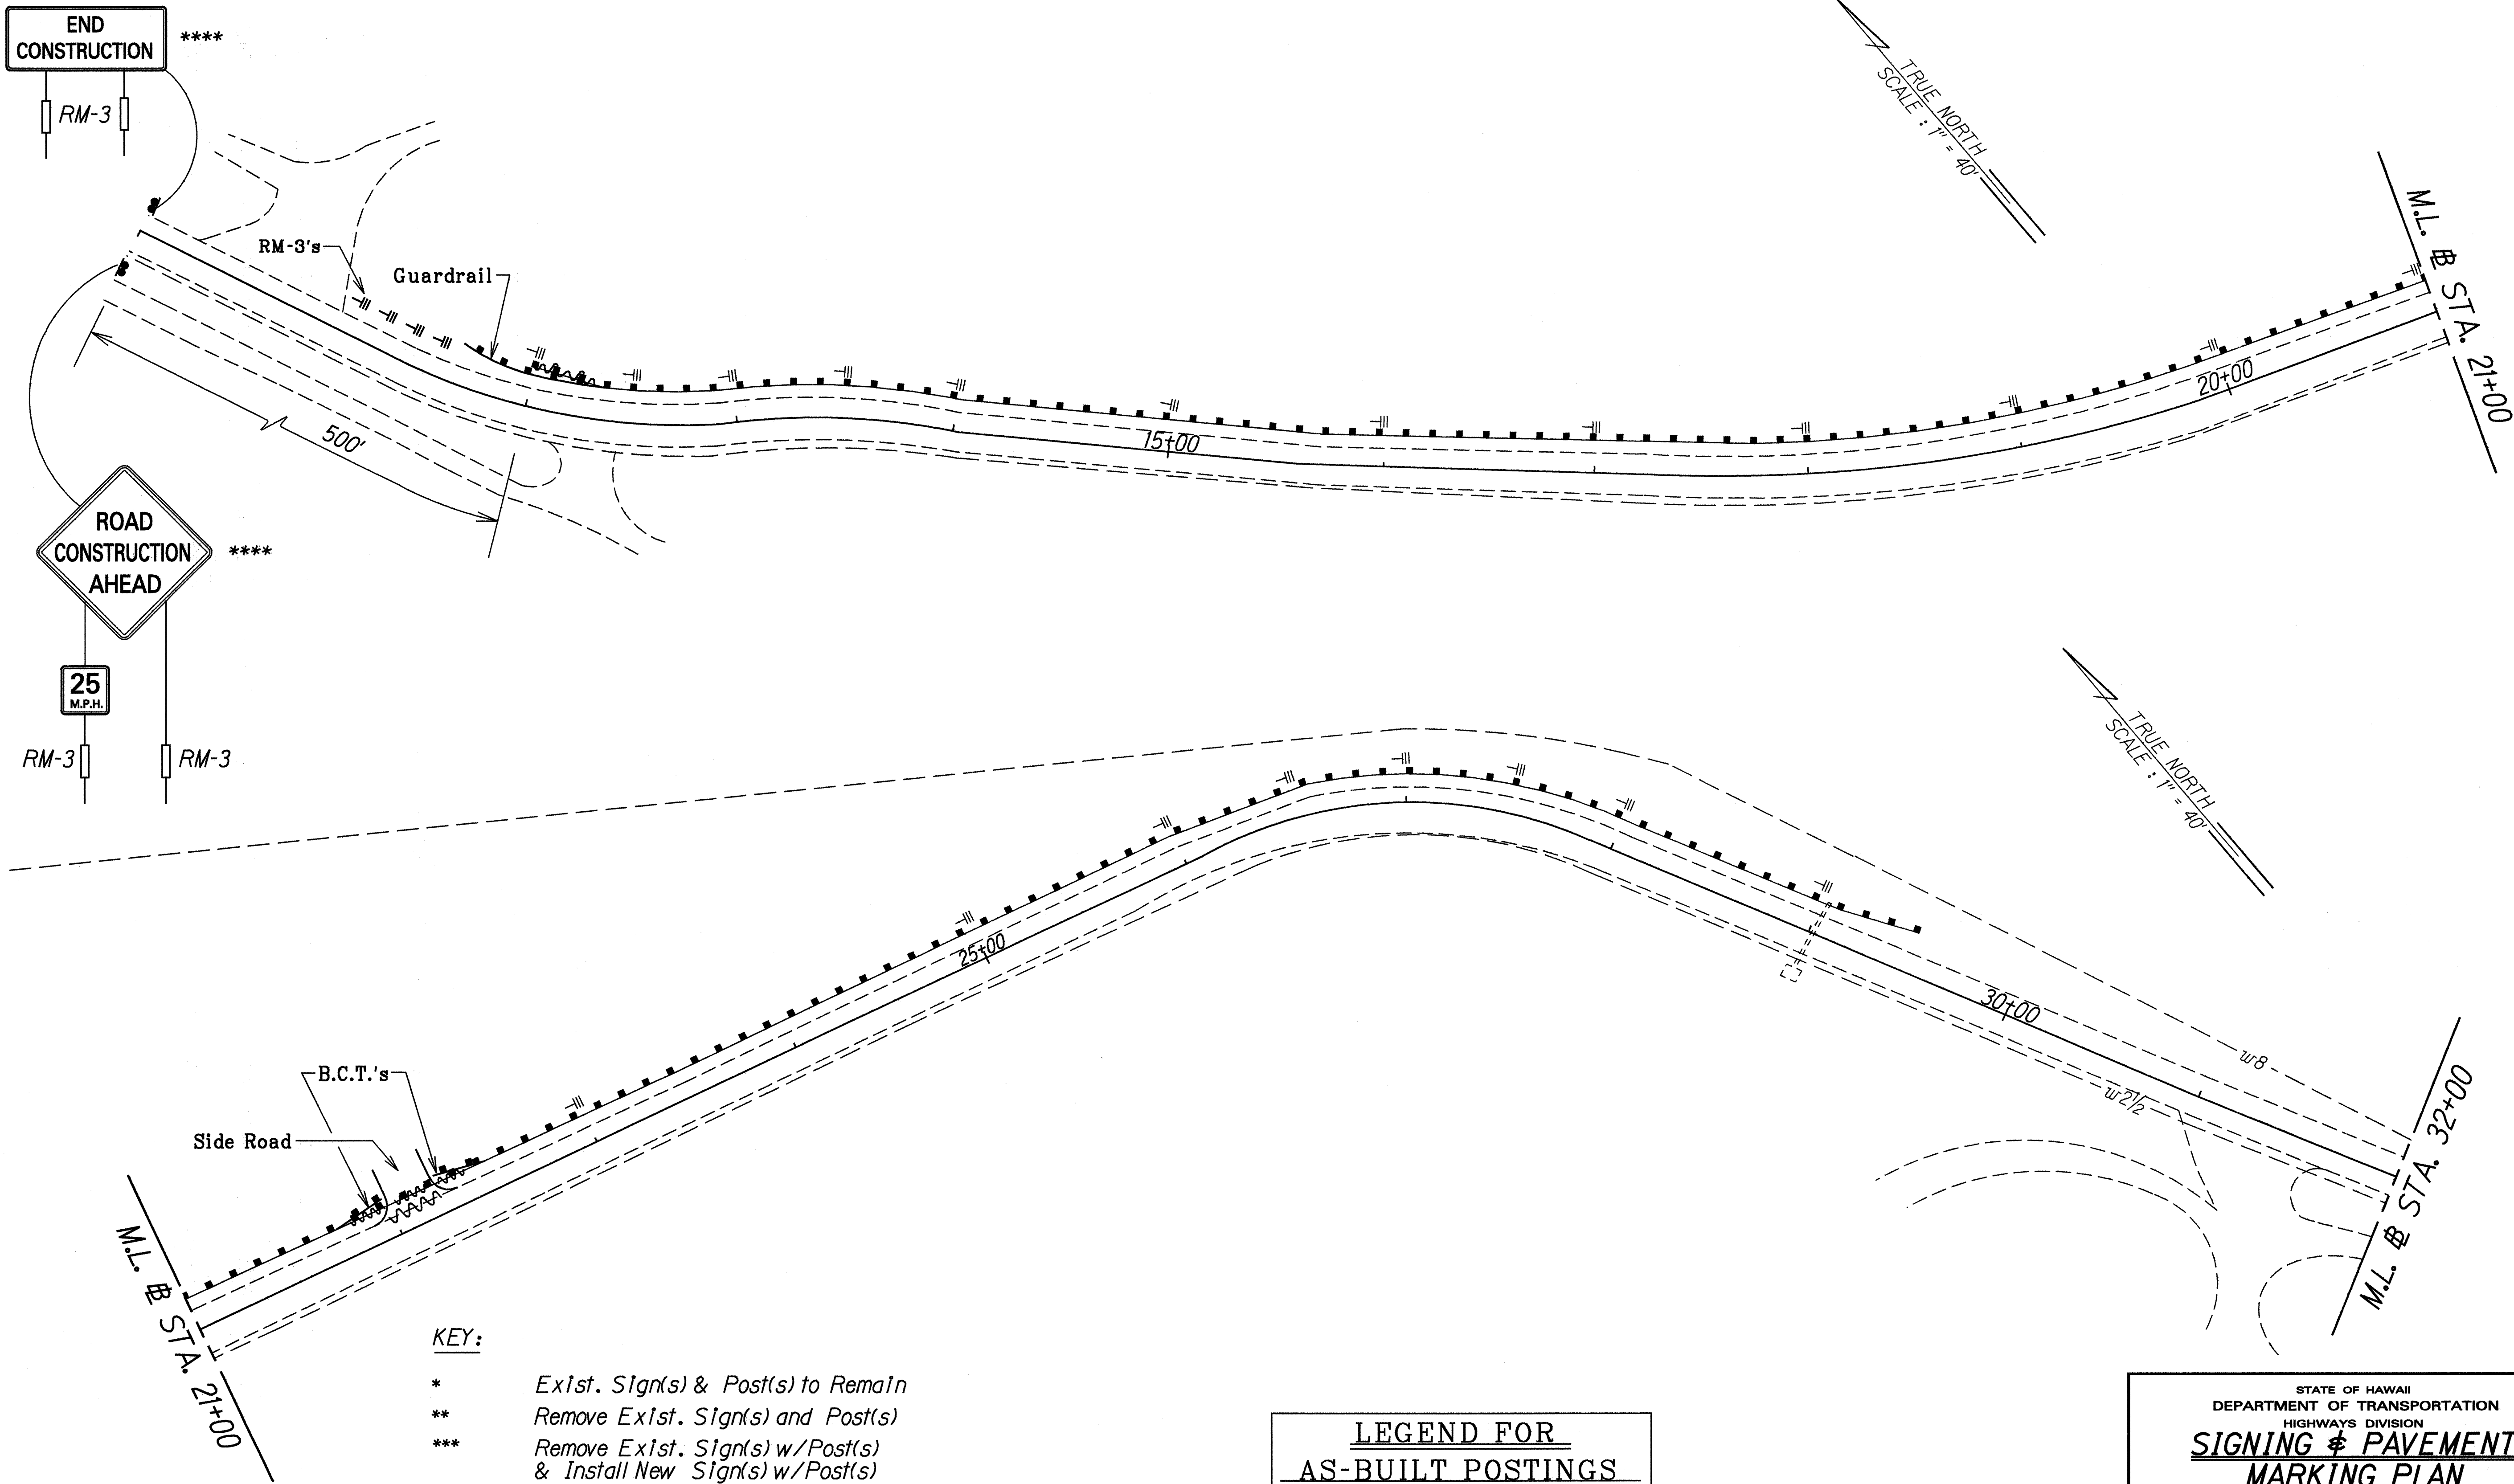

- KEY:**
- * Exist. Sign(s) & Post(s) to Remain
 - ** Remove Exlst. Sign(s) and Post(s)
 - *** Remove Exlst. Sign(s) w/Post(s) & Install New Sign(s) w/Post(s)
 - **** Install New Sign(s) & Post(s)
 - Install RM-1 Markers w/Post
 - ||- Install RM-3 Markers w/Post

**LEGEND FOR
AS-BUILT POSTINGS**

- Squiggly line for as-built deletion
- Double line for as-built deletion
- Roadway Text for as-built posting

6/13/94 Sheet Added To Contract Plans
per Addendum No. 1

DATE REVISION

STATE OF HAWAII
DEPARTMENT OF TRANSPORTATION
HIGHWAYS DIVISION
**SIGNING & PAVEMENT
MARKING PLAN**
MANELE ROAD RESURFACING
Vicinity of Lanai City towards Manele Bay
Fed. Aid. Project No. STP-0440(5)

Scale: 1" = 40' Date: June, 1994


SHEET No. 1A OF 8 SHEETS

"AS-BUILT"

ADD. 14S-1

ORIGINAL PLAN	DATE
SURVEY PLOTTED BY	6/13/94
DRAWN BY	C. Hagasa, J. Guzman
TRACED BY	
DESIGNED BY	C. Hagasa
QUANTITIES BY	
CHECKED BY	
INCHES	
FEET	

FED. ROAD DIST. NO.	STATE	FED. AID PROJ. NO.	FISCAL YEAR	SHEET NO.	TOTAL SHEETS
HAWAII	HAW.	STP-0440(5)	1994	15	23

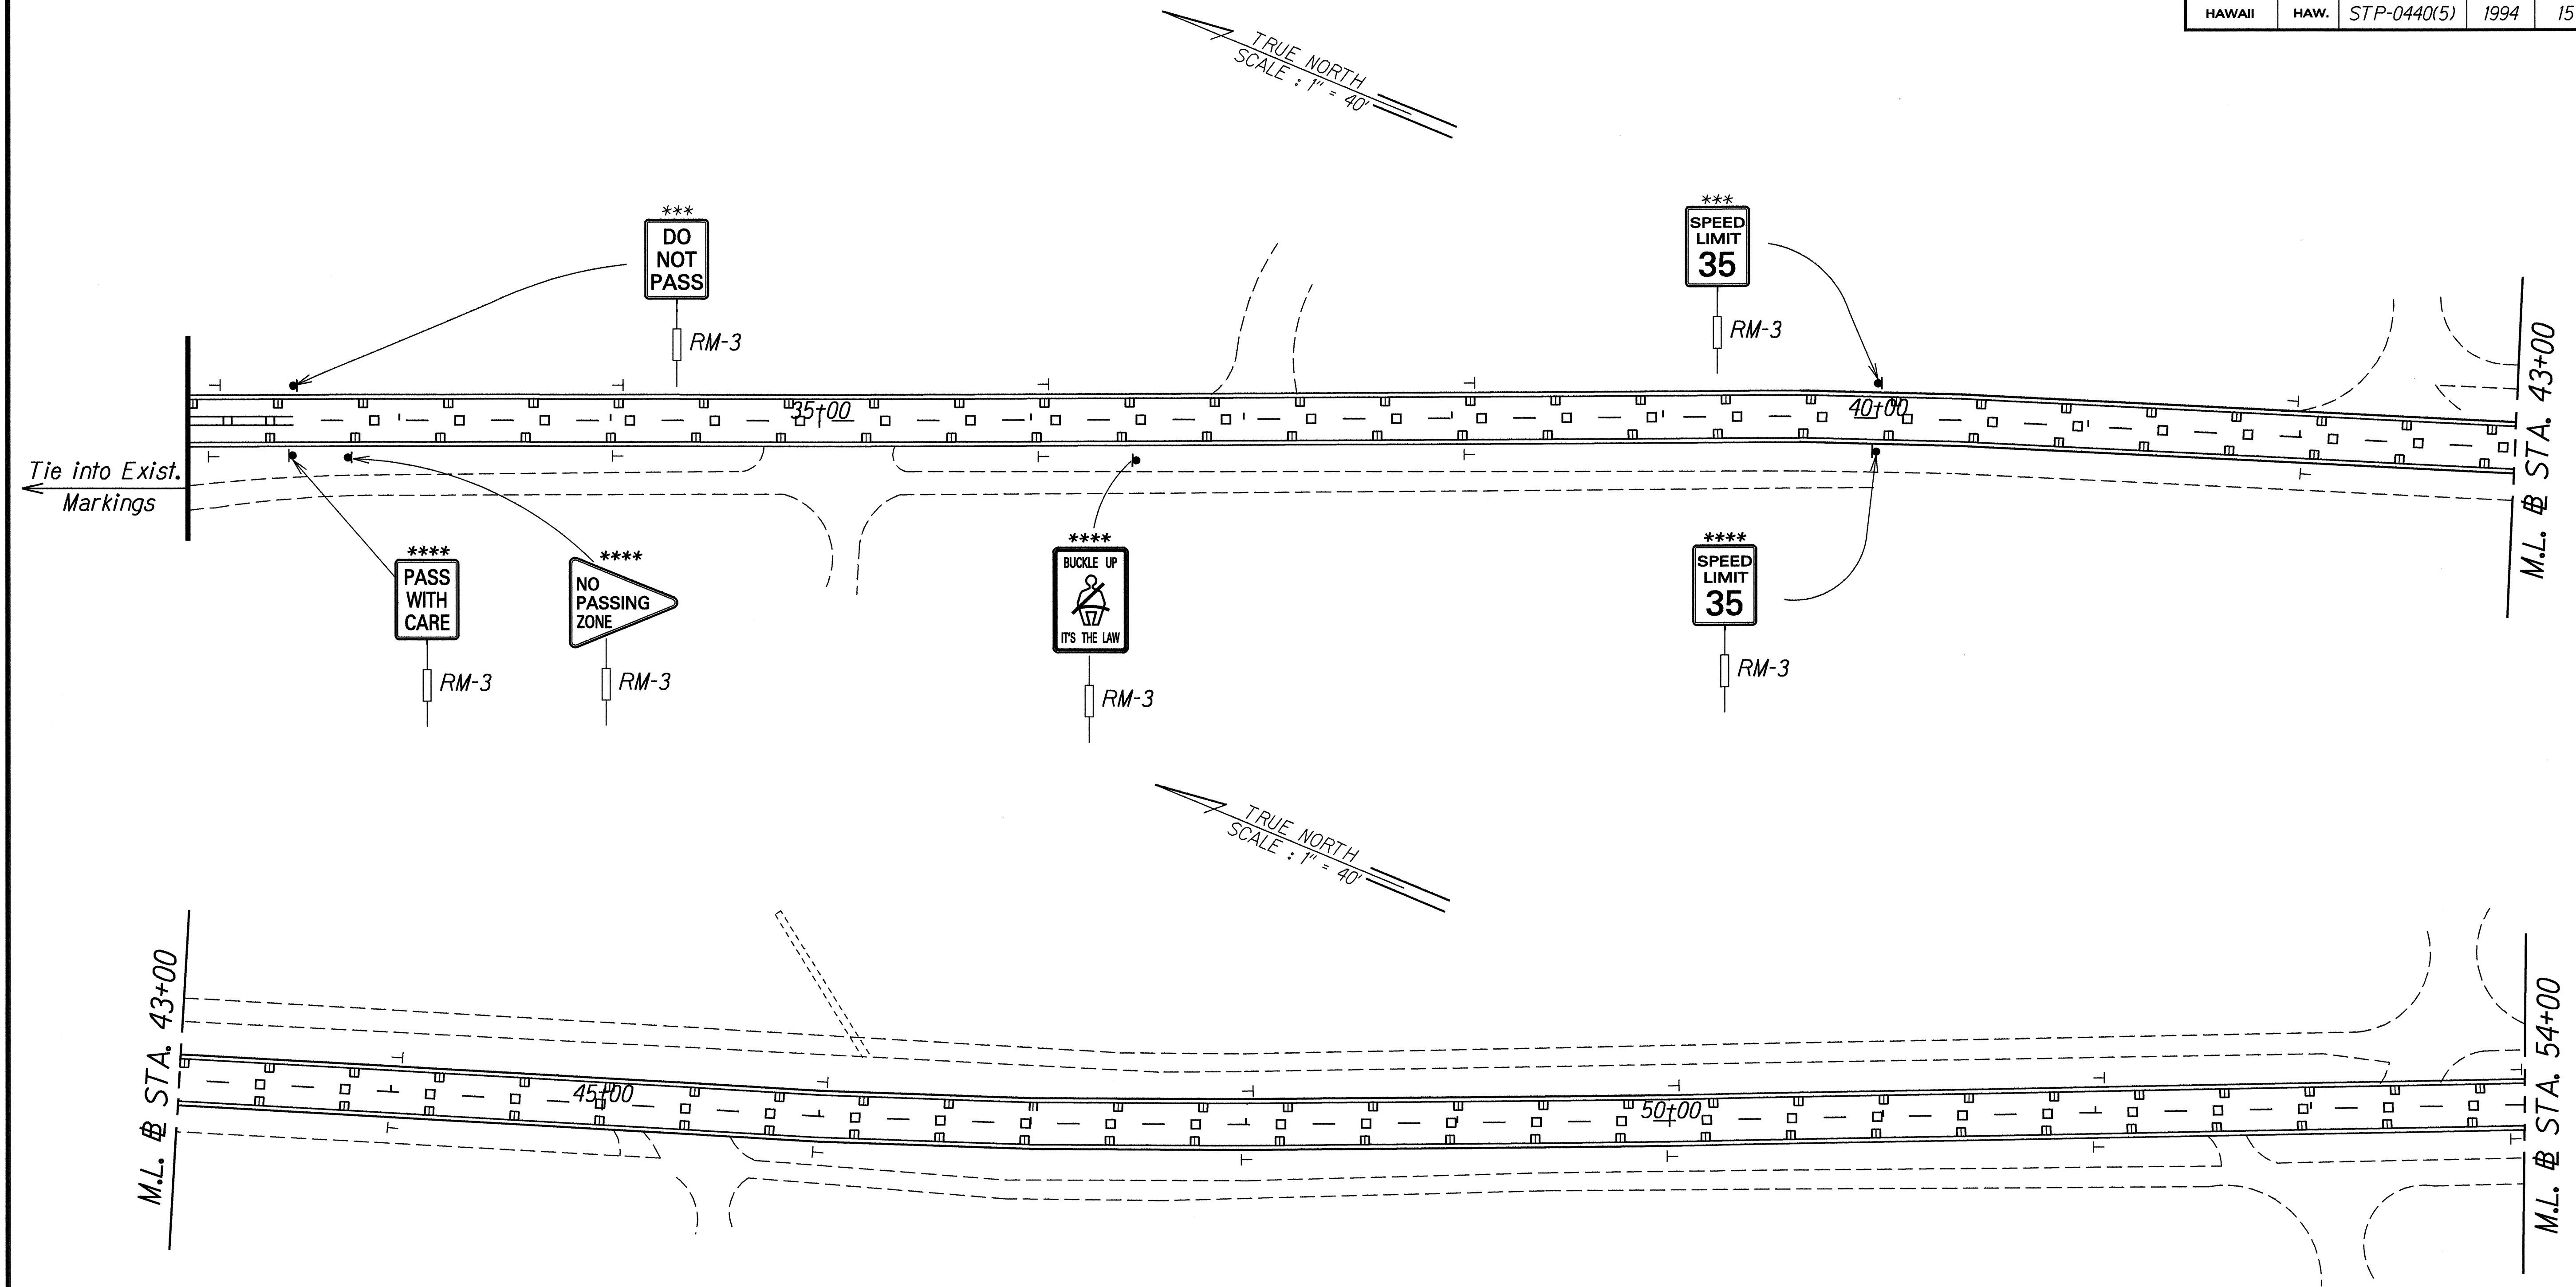

- KEY:**
- * Exist. Sign(s) & Post(s) to Remain
 - ** Remove Exist. Sign(s) & Post(s)
 - *** Remove Exist. Sign(s) w/Post(s) & Install New Sign(s) w/Post(s)
 - **** Install New Sign(s) & Post(s)
 - + Install RM-1 Markers w/Post
 - ||| Install RM-3 Markers w/Post

5/23/94	Added "NO PASSING ZONE" & "BUCKLE UP" Signs, RM-1 Markers and Revised Construction Sign locations per Addendum No. 1.
DATE	REVISION

STATE OF HAWAII
DEPARTMENT OF TRANSPORTATION
HIGHWAYS DIVISION

SIGNING & PAVEMENT MARKING PLAN

MANELE ROAD RESURFACING

Vicinity of Lanai City towards Manele Bay


Fed. Aid Proj. No. STP-0440(5)

Scale: 1" = 40' Date: March, 1994

SHEET No. 1 OF 8 SHEETS

ORIGINAL PLAN	DATE
SURVEY PLOTTED BY	5/7/94
DRAWN BY	G. Unabia
TRACED BY	
NOTE BOOK	
DESIGNED BY	C. Barbosa
QUANTITIES BY	
CHECKED BY	

FED. ROAD DIST. NO.	STATE	FED. AID PROJ. NO.	FISCAL YEAR	SHEET NO.	TOTAL SHEETS
HAWAII	HAW.	STP-0440(5)	1994	16	23

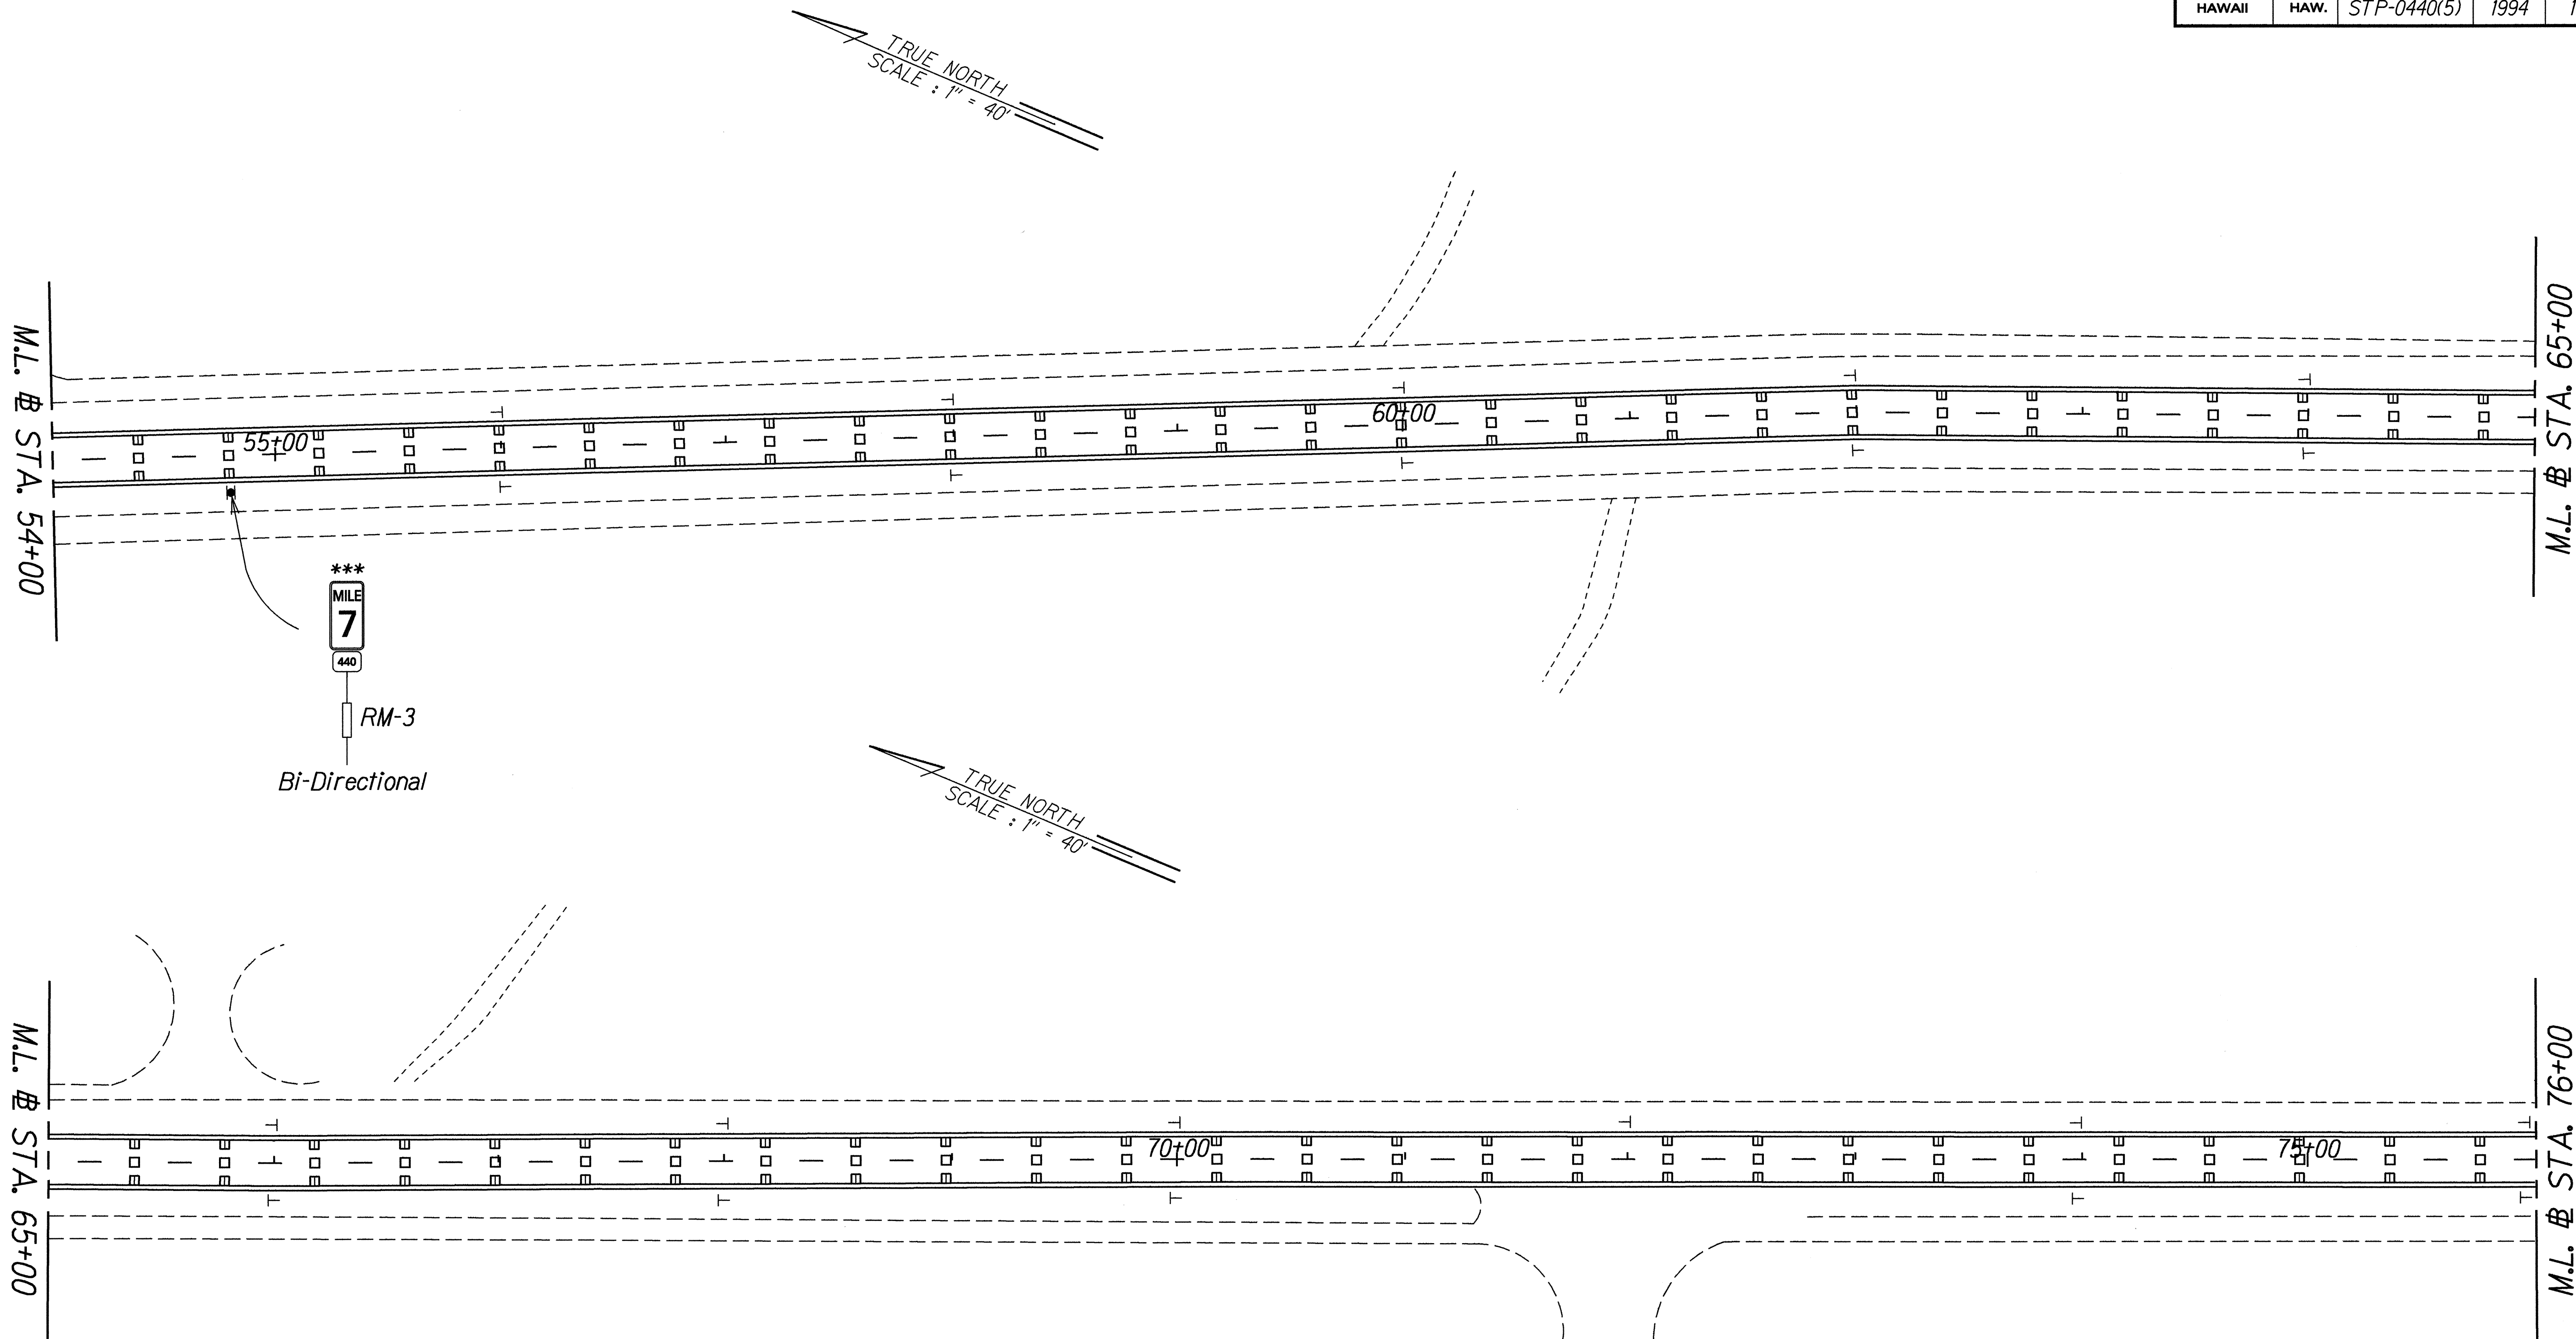

KEY:

- * Exist. Sign(s) & Post(s) to Remain
- ** Remove Exist. Sign(s) & Post(s)
- *** Remove Exist. Sign(s) w/Post(s) & Install New Sign(s) w/Post(s)
- **** Install New Sign(s) & Post(s)
- + Install RM-1 Markers w/Post


5/23/94	Deleted "PASS WITH CARE" Signs & Added Note to Mile Post Sign and RM-1 Markers per Addendum No. 1.
DATE	REVISION

STATE OF HAWAII
DEPARTMENT OF TRANSPORTATION
HIGHWAYS DIVISION
SIGNING & PAVEMENT MARKING PLAN
MANELE ROAD RESURFACING
Vicinity of Lanai City towards Manele Bay
Fed. Aid Proj. No. STP-0440(5)
Scale: 1"=40' Date: March, 1994

SHEET No. 2 OF 8 SHEETS

ORIGINAL PLAN	SURVEY PLOTTED BY	DATE
NOTE BOOK	DRAWN BY G. Uehara	5/17/94
DESIGNED BY C. DeGisi		
QUANTITIES BY		
CHECKED BY		

FED. ROAD DIST. NO.	STATE	FED. AID PROJ. NO.	FISCAL YEAR	SHEET NO.	TOTAL SHEETS
HAWAII	HAW.	STP-0440(5)	1994	17	23

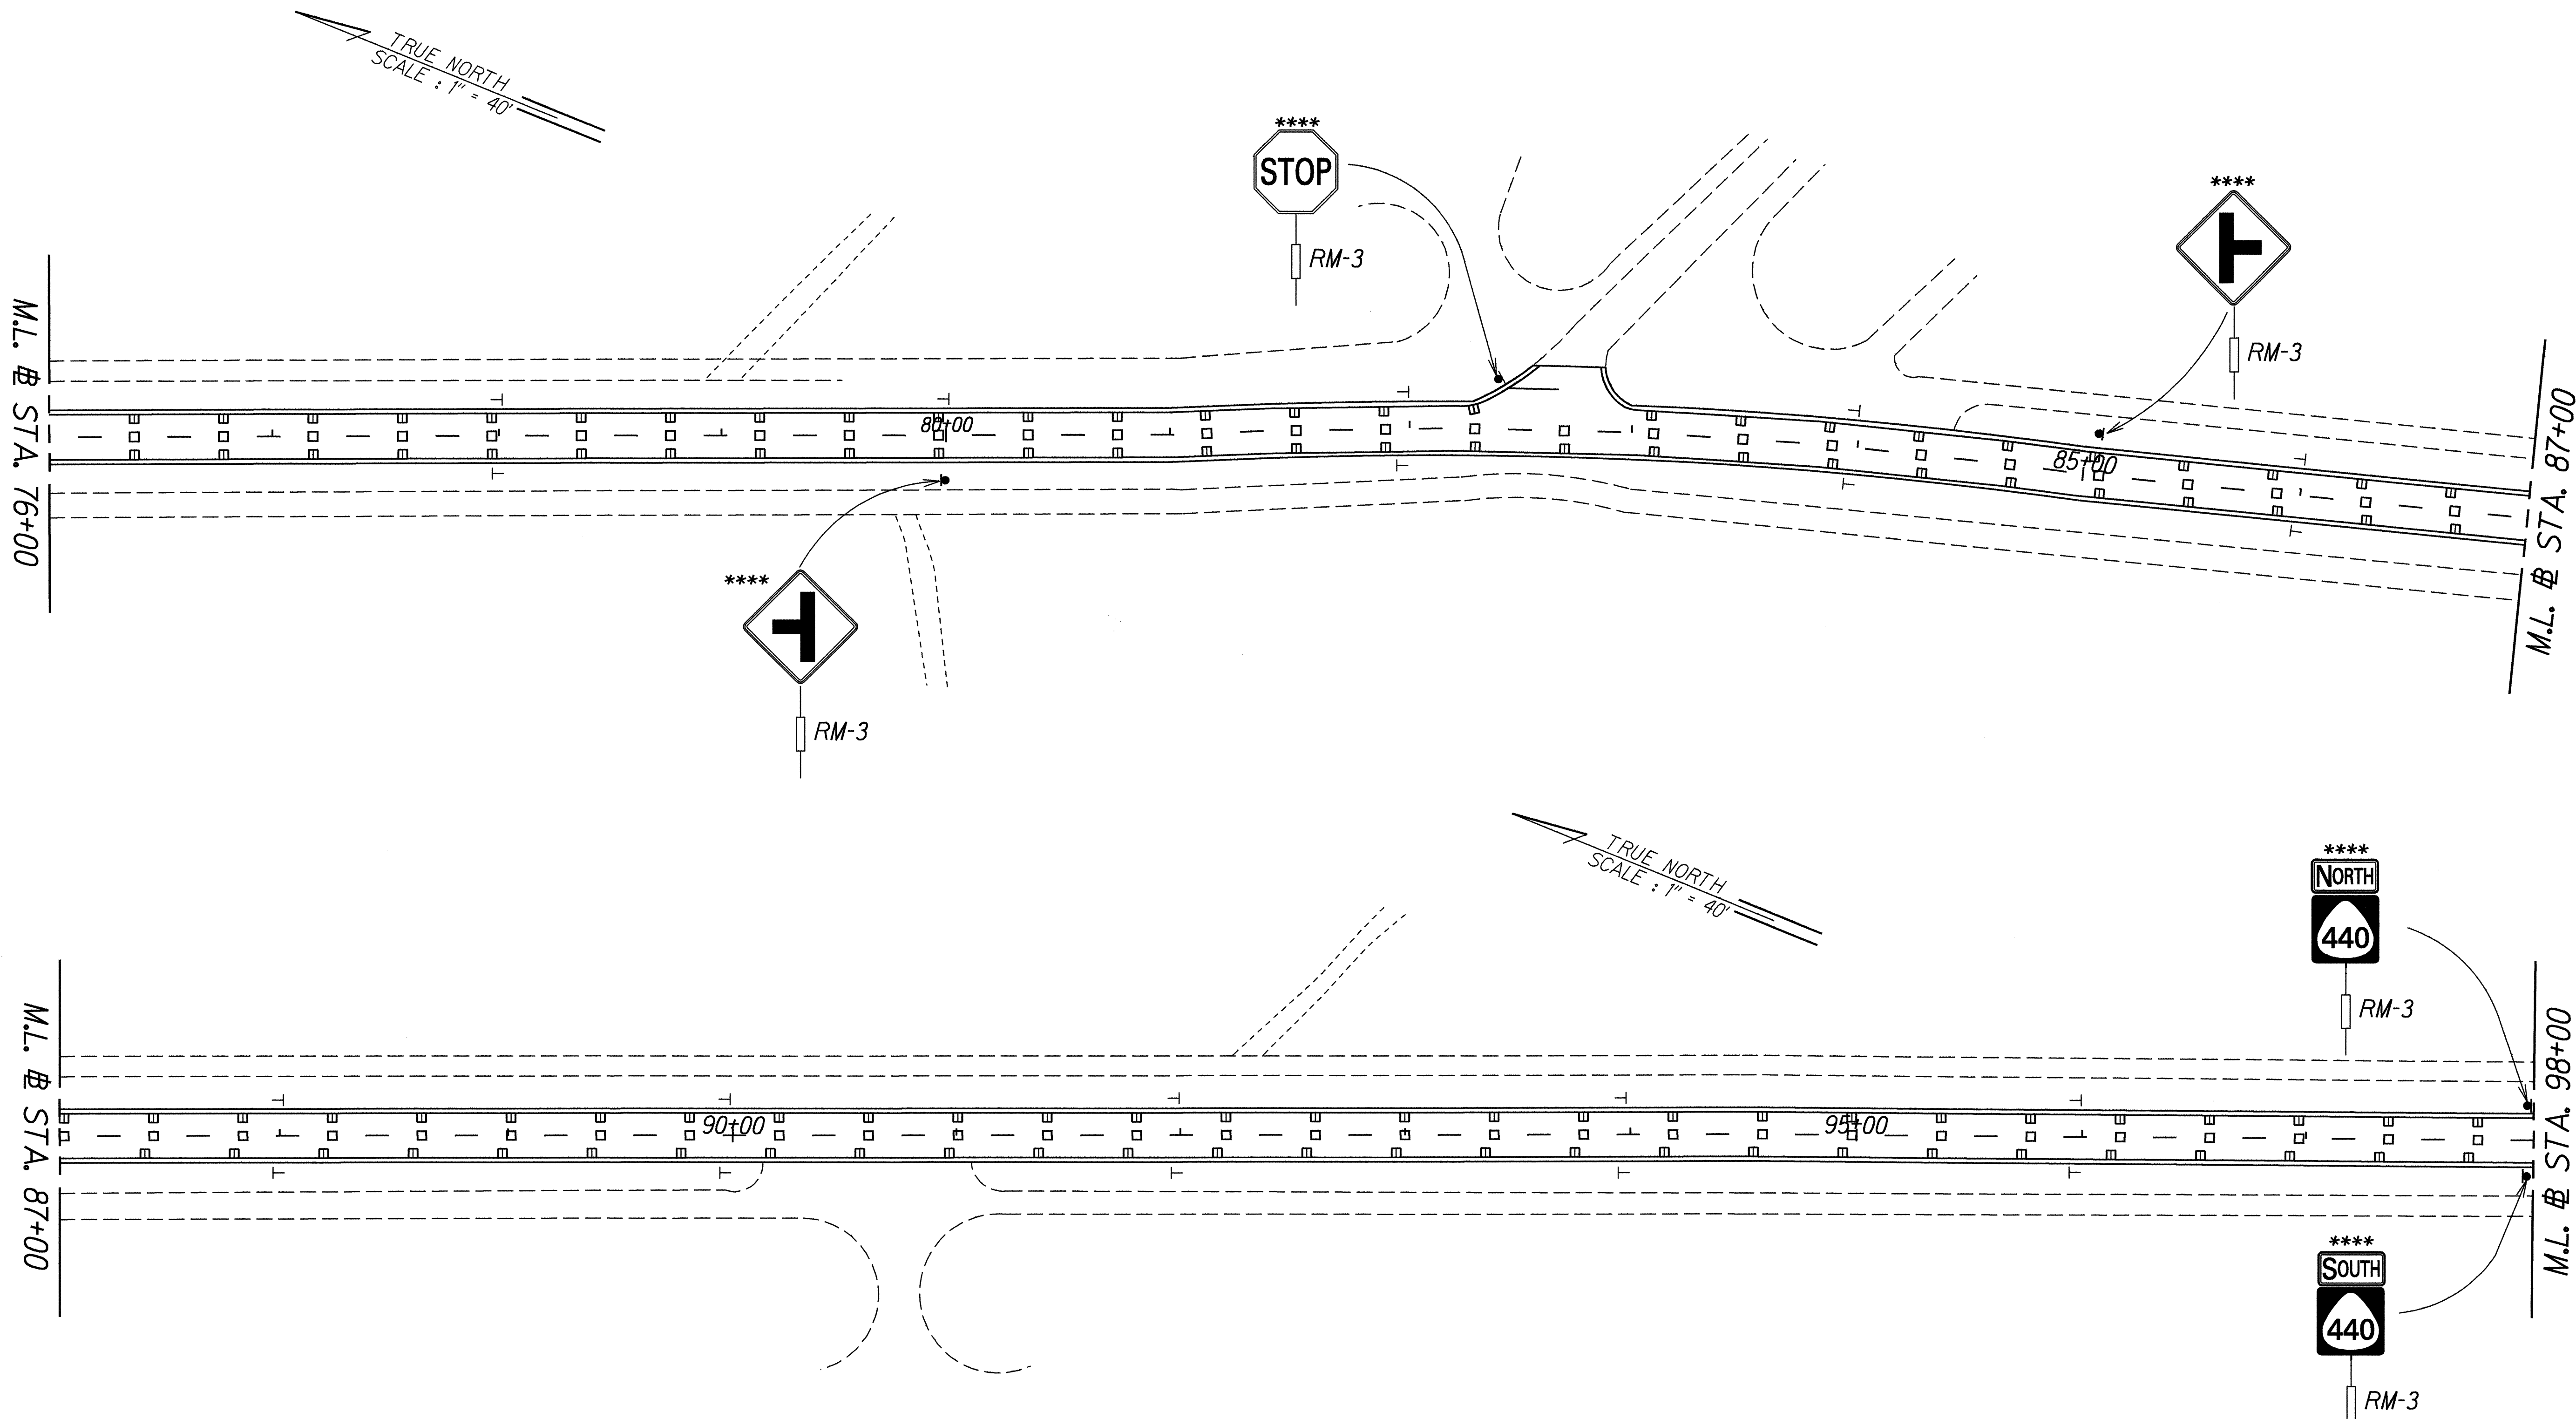


- KEY:**
- * Exist. Sign(s) & Post(s) to Remain
 - ** Remove Exist. Sign(s) & Post(s)
 - *** Remove Exist. Sign(s) w/Post(s) & Install New Sign(s) w/Post(s)
 - **** Install New Sign(s) & Post(s)
 - ┘ Install RM-1 Markers w/Post

5/23/94	Added "Side Road" Signs and RM-1 Markers. Revised Striping at Sta. 82+50± Lt. and Signs "NORTH" & "SOUTH" Per Addendum No. 1
DATE	REVISION

STATE OF HAWAII
DEPARTMENT OF TRANSPORTATION
HIGHWAYS DIVISION
SIGNING & PAVEMENT MARKING PLAN
MANELE ROAD RESURFACING
Vicinity of Lanai City towards Manele Bay
Fed. Aid Proj. No. STP-0440(5)
Scale: 1" = 40' Date: March, 1994
SHEET No. 3 OF 8 SHEETS

ORIGINAL PLAN	DATE
DRAWN BY G. Unahia	5/1/94
DESIGNED BY C. Pappas	
CHECKED BY	
IN CHARGE	

FED. ROAD DIST. NO.	STATE	FED. AID PROJ. NO.	FISCAL YEAR	SHEET NO.	TOTAL SHEETS
HAWAII	HAW.	STP-0440(5)	1994	18	23

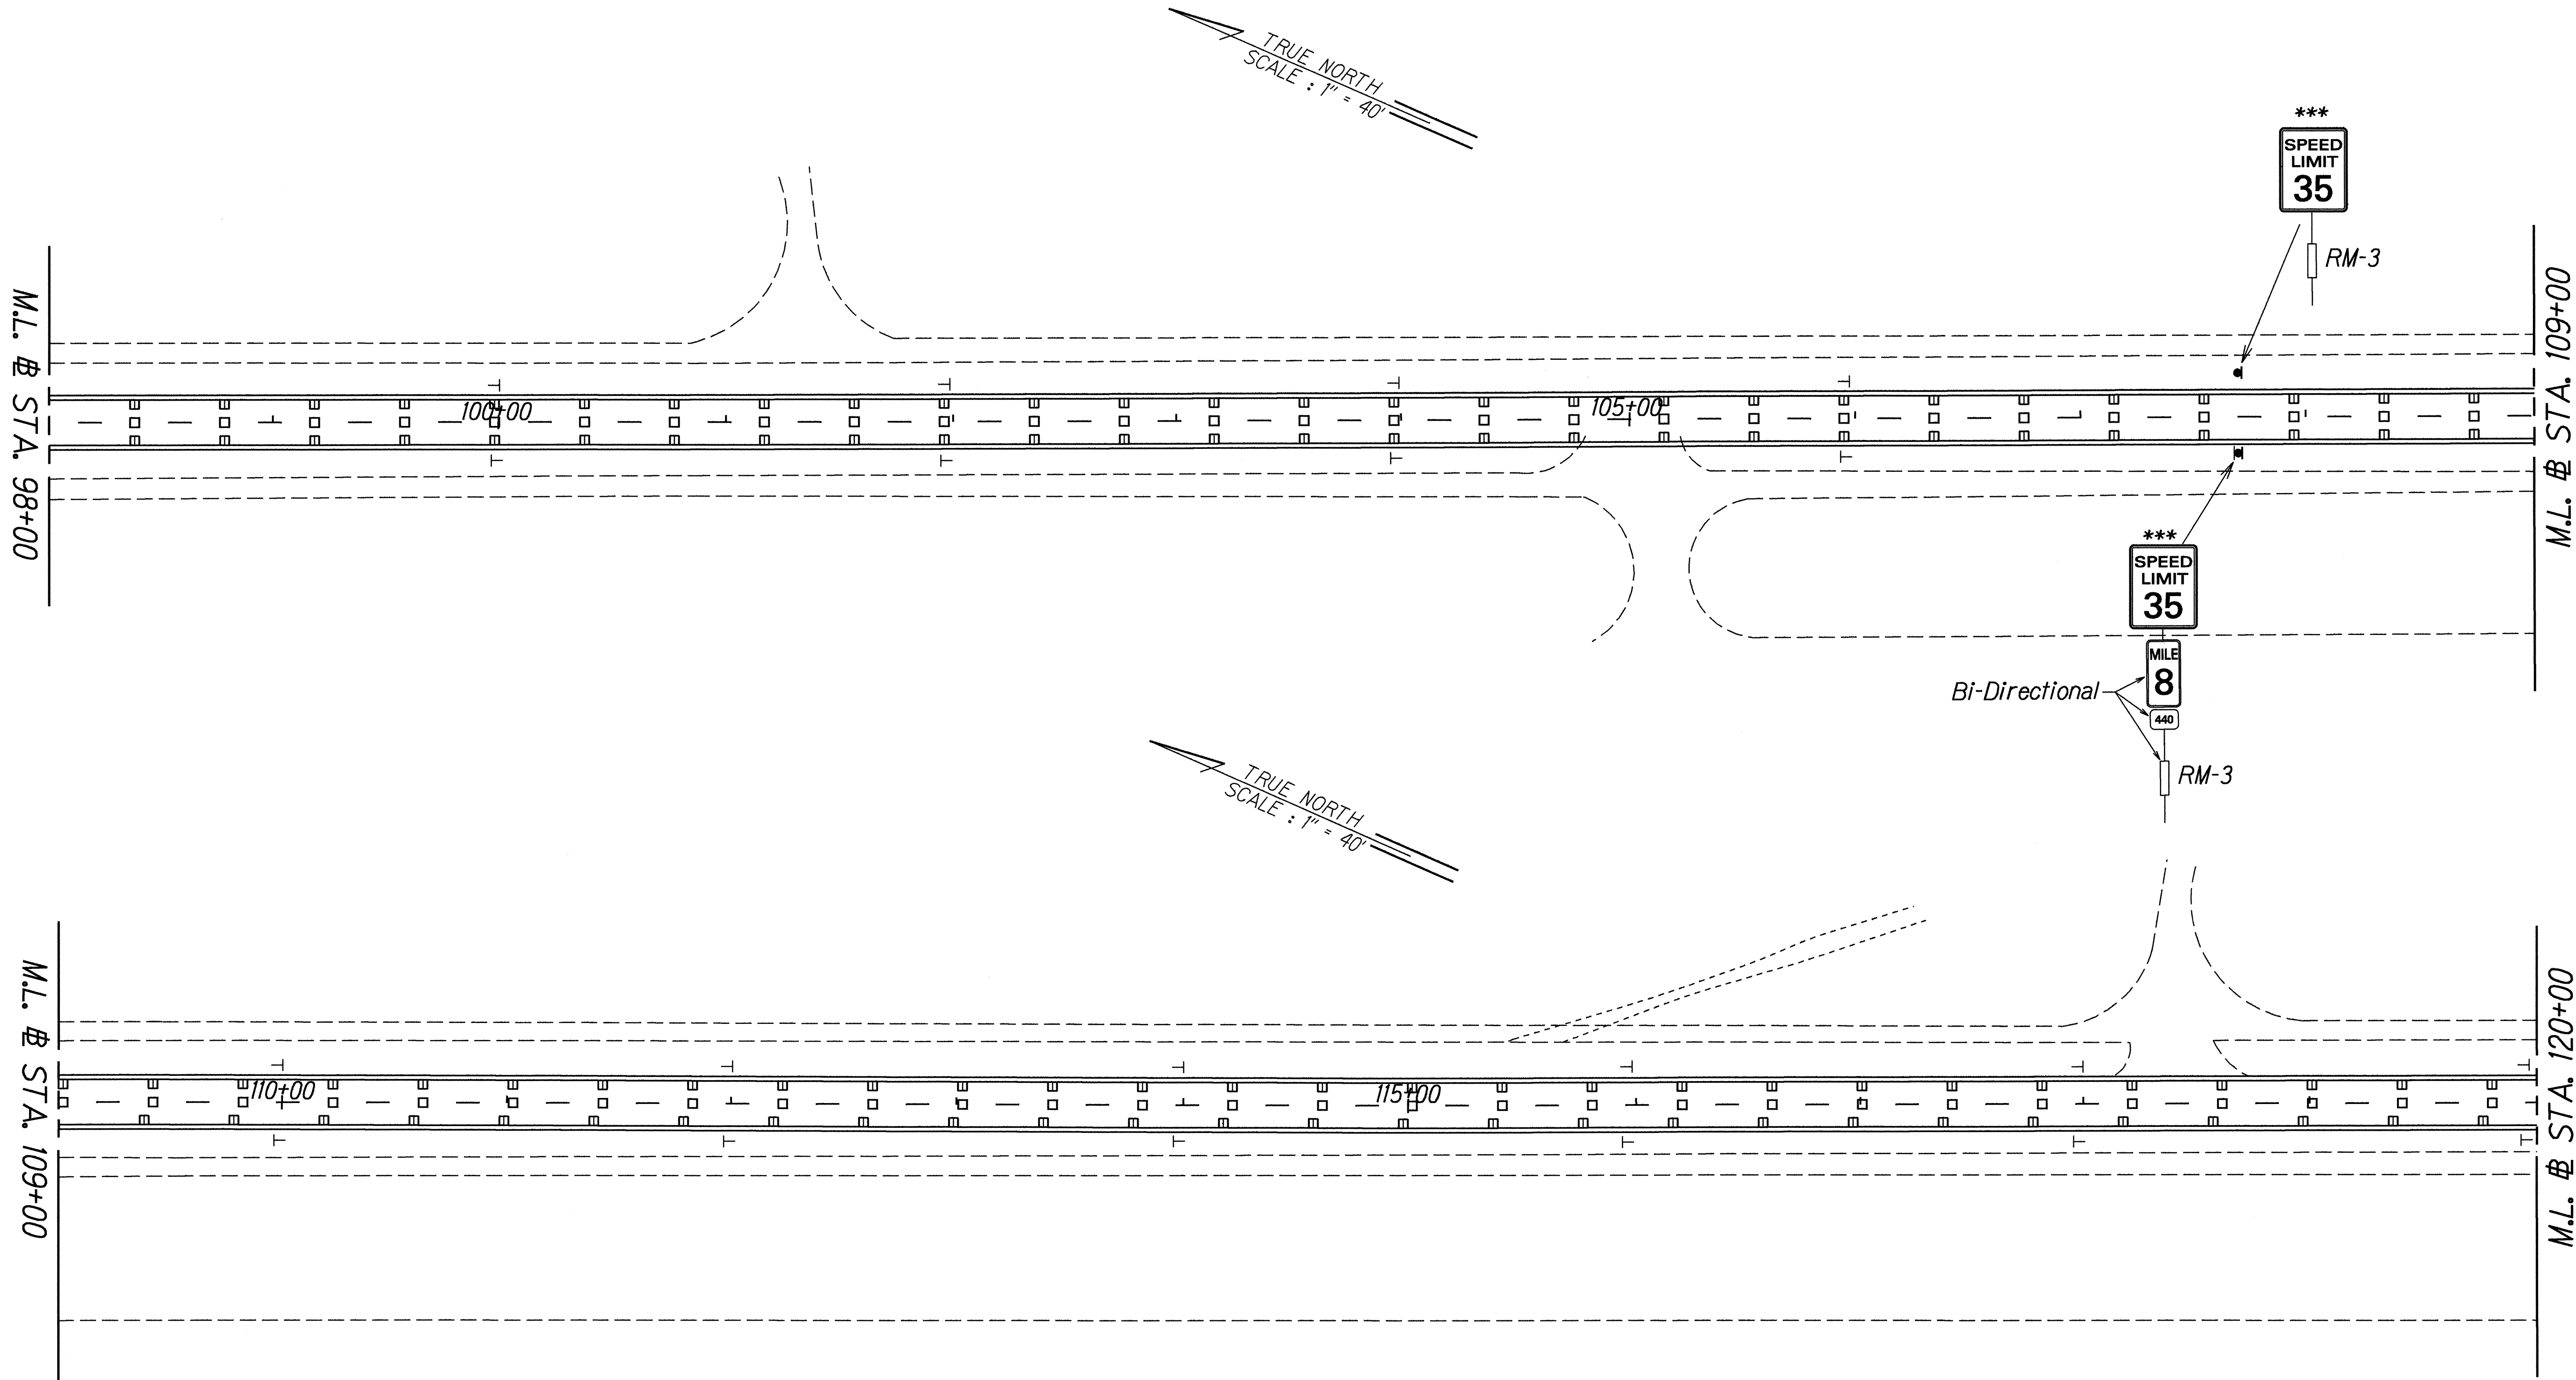

ORIGINAL PLAN	SURVEY PLOTTED BY J. J. J. J.	DATE 5/7/94
NOTE BOOK	DESIGNED BY C. J. J. J.	
INSTRUMENTAL SIGN	CHECKED BY N. J. J. J.	


KEY:

- * Exist. Sign(s) & Post(s) to Remain
- ** Remove Exist. Sign(s) & Post(s)
- *** Remove Exist. Sign(s) w/Post(s)
& Install New Sign(s) w/Post(s)
- **** Install New Sign(s) & Post(s)
- ┴ Install RM-1 Markers w/Post

5/23/94	Remove and Install New Speed Limit Sign at St. 107+70± Rt. & Lt. and Added RM-1 Markers per Addendum No. 1.
DATE	REVISION

STATE OF HAWAII
DEPARTMENT OF TRANSPORTATION
HIGHWAYS DIVISION
**SIGNING & PAVEMENT
MARKING PLAN**
MANELE ROAD RESURFACING
Vicinity of Lanai City towards Manele Bay
Fed. Aid Proj. No. STP-0440(5)
Scale: 1" = 40' Date: March, 1994
SHEET No. 4 OF 8 SHEETS

FED. ROAD DIST. NO.	STATE	FED. AID PROJ. NO.	FISCAL YEAR	SHEET NO.	TOTAL SHEETS
HAWAII	HAW.	STP-0440(5)	1994	19	23

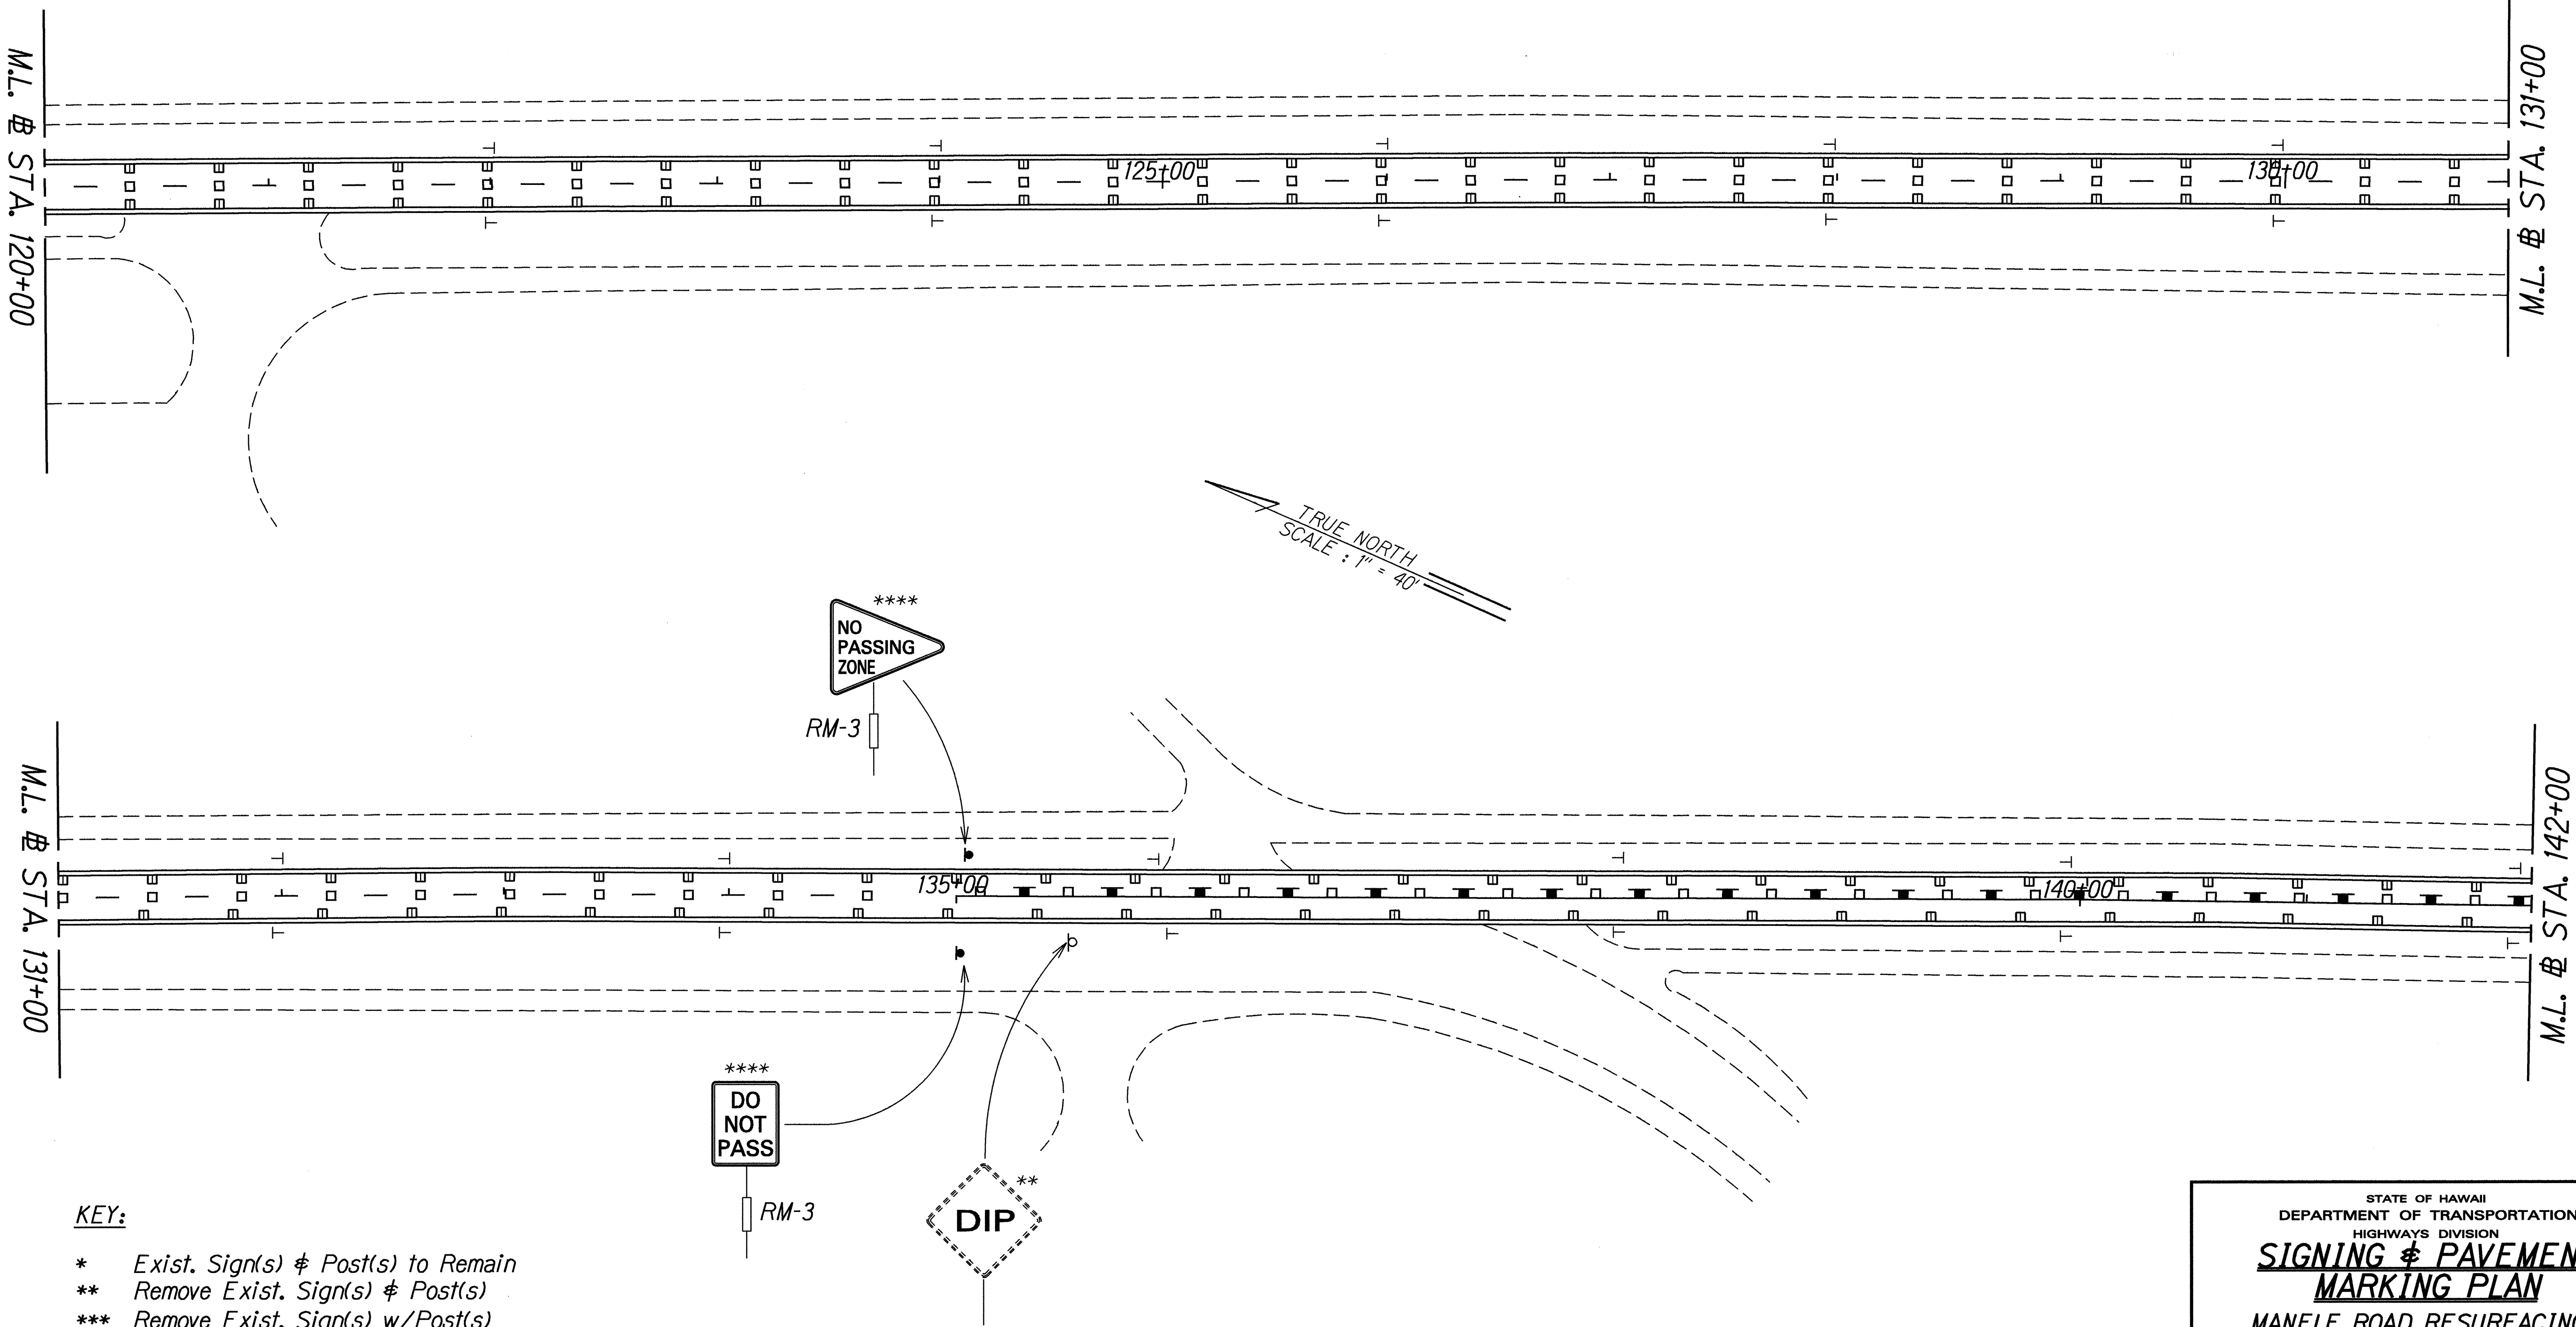

- KEY:**
- * Exist. Sign(s) & Post(s) to Remain
 - ** Remove Exist. Sign(s) & Post(s)
 - *** Remove Exist. Sign(s) w/Post(s)
 - **** Install New Sign(s) & Post(s)
 - ┊ Install RM-1 Markers w/Post


ORIGINAL PLAN	SURVEY PLOTTED BY	DATE
NOTE BOOK	DRAWN BY G. Unabia	5/7/94
DESIGNED BY C. Barbosa		
QUANTITIES BY		
Checked BY		

5/23/94	Added "NO PASSING ZONE" Sign and RM-1 Markers and Existing "DIP" Sign to be removed per Addendum No. 1.
DATE	REVISION

STATE OF HAWAII
DEPARTMENT OF TRANSPORTATION
HIGHWAYS DIVISION
SIGNING & PAVEMENT MARKING PLAN
MANELE ROAD RESURFACING
Vicinity of Lanai City towards Manele Bay
Fed. Aid Proj. No. STP-0440(5)
Scale: 1" = 40' Date: March, 1994

SHEET No. 5 OF 8 SHEETS

FED. ROAD DIST. NO.	STATE	FED. AID PROJ. NO.	FISCAL YEAR	SHEET NO.	TOTAL SHEETS
HAWAII	HAW.	STP-0440(5)	1994	20	23

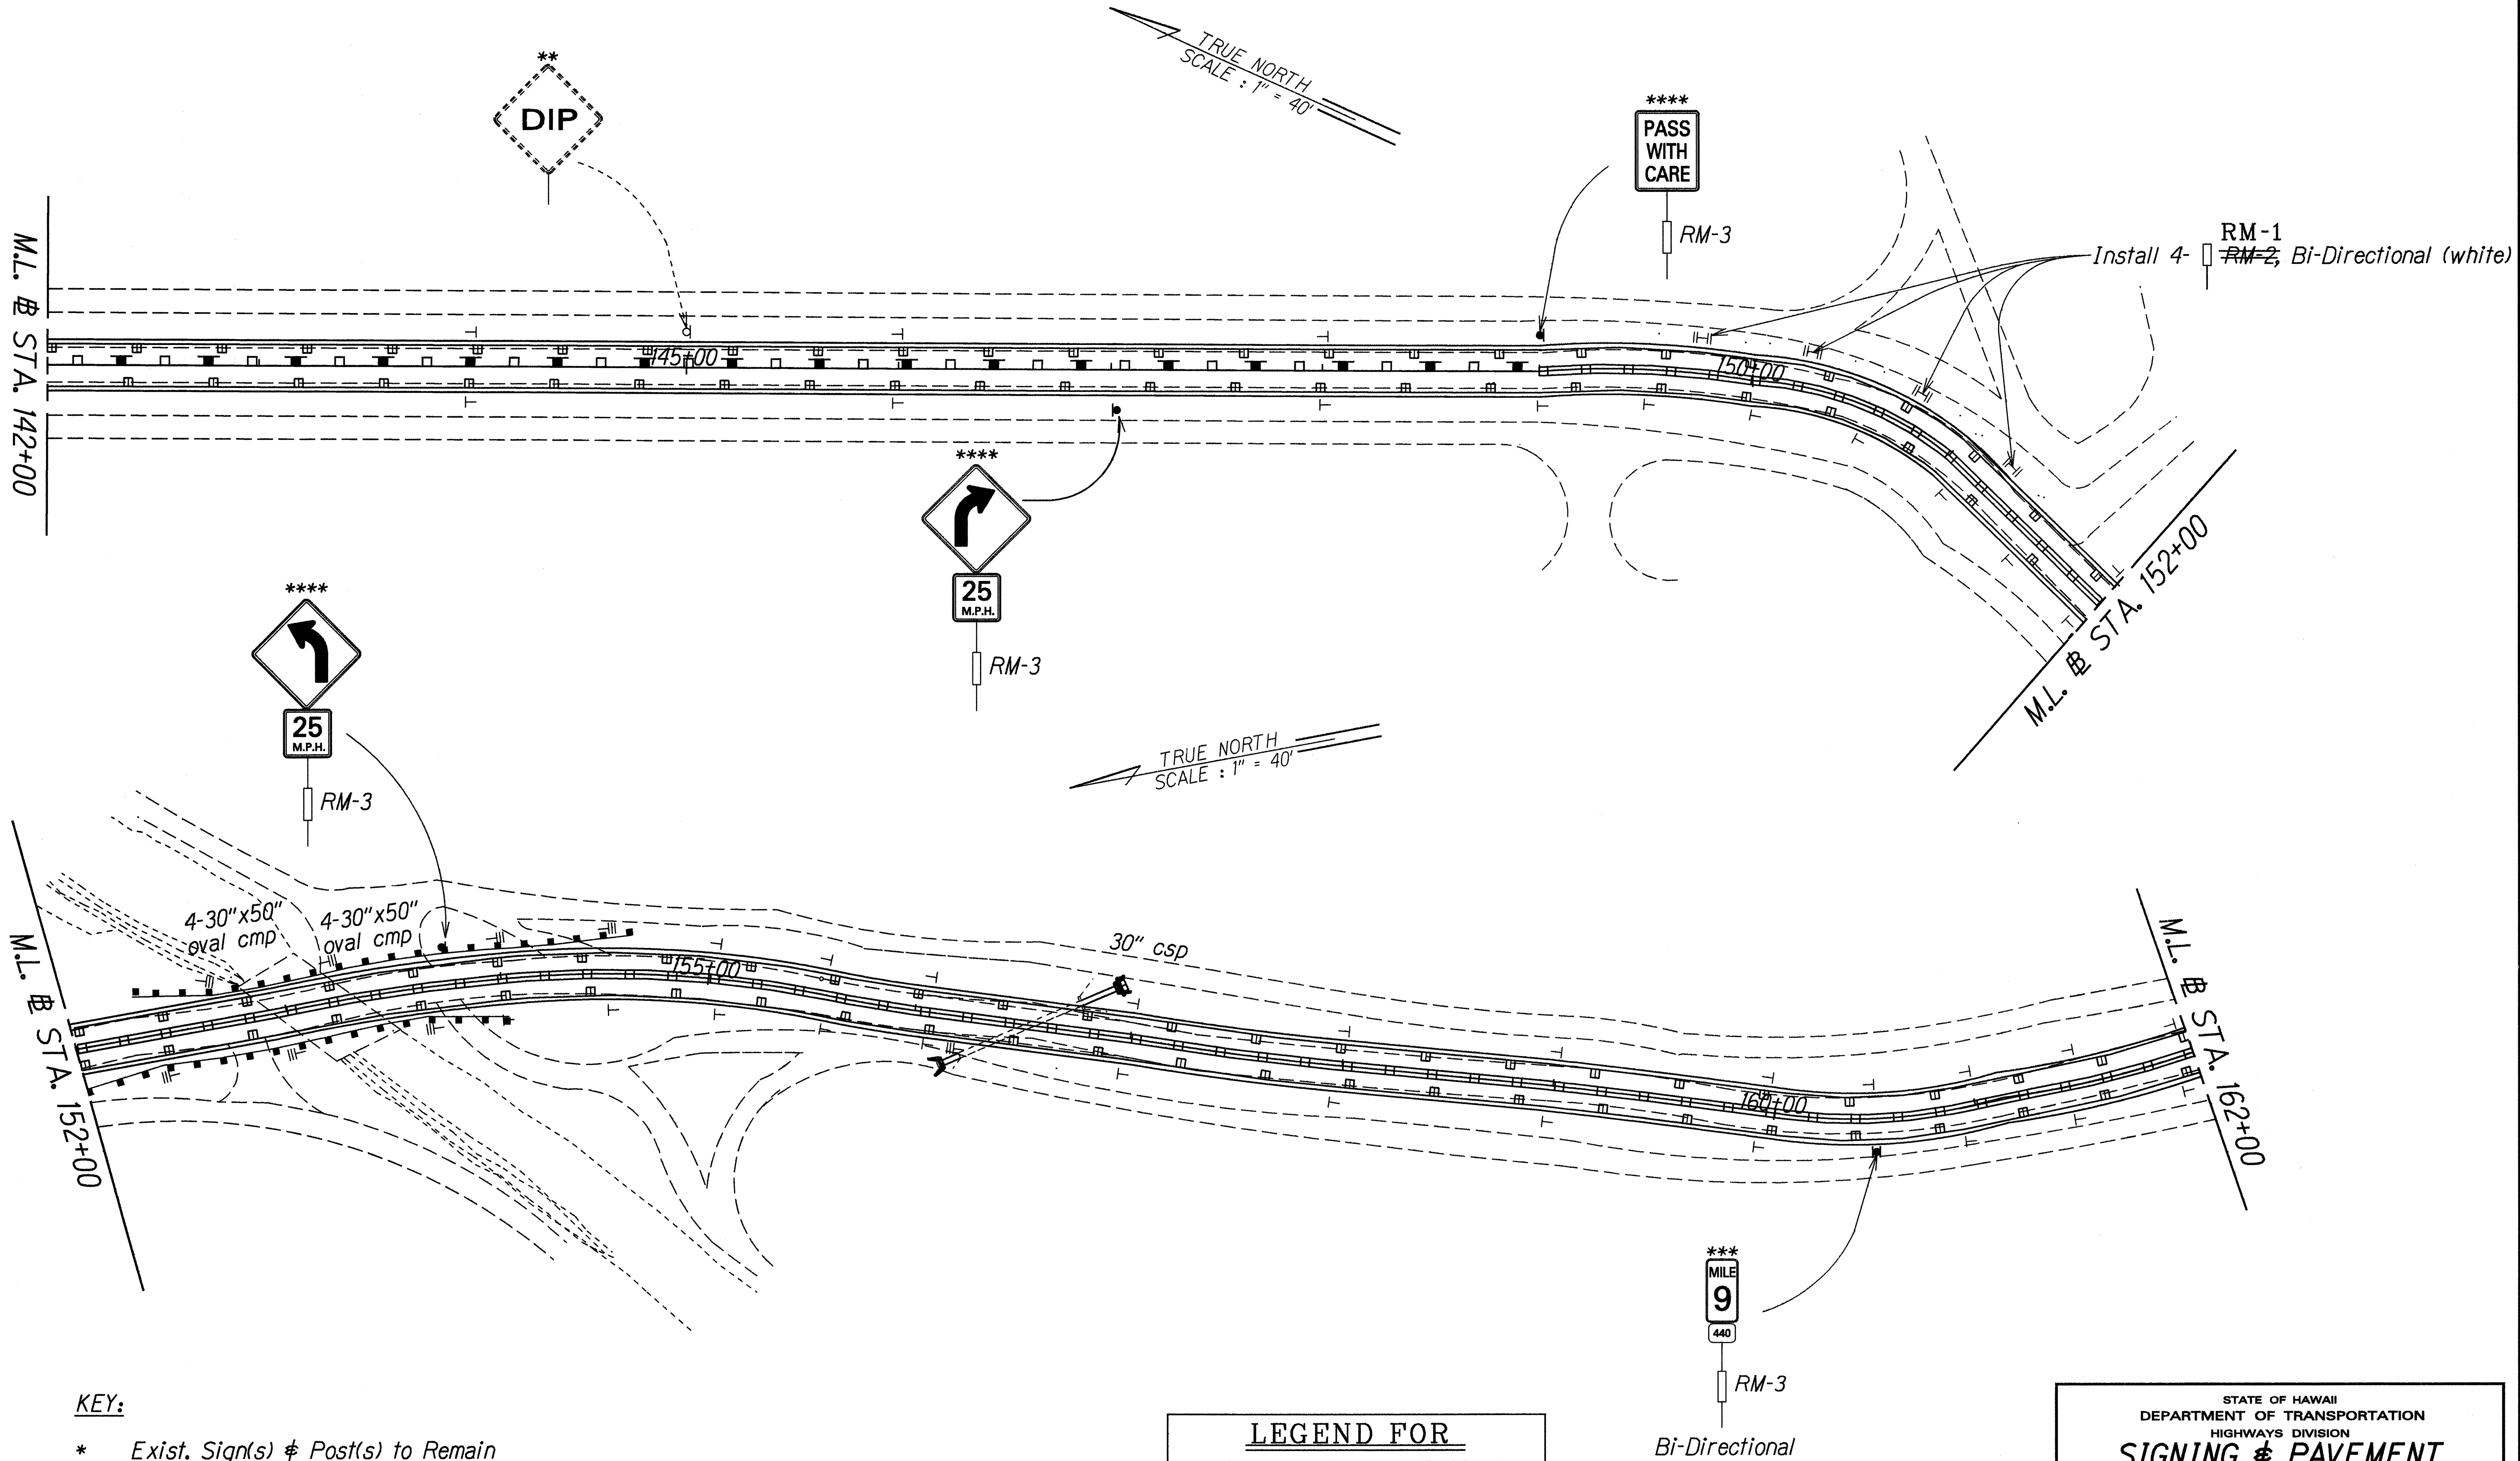

- KEY:**
- * Exist. Sign(s) & Post(s) to Remain
 - ** Remove Exist. Sign(s) & Post(s)
 - *** Remove Exist. Sign(s) w/Post(s) & Install New Sign(s) w/Post(s)
 - **** Install New Sign(s) & Post(s)
 - ┴ Install RM-1 Markers w/Post
 - ≡ Install RM-3 Markers w/Post

LEGEND FOR AS-BUILT POSTINGS	
	Squiggly line for as-built deletion
	Double line for as-built deletion
Roadway	Text for as-built posting



5/23/94	Added Notes and Asterisks to clarify plan and Added RM-1 & RM-3 Markers per Addendum No. 1.
DATE	REVISION

STATE OF HAWAII
DEPARTMENT OF TRANSPORTATION
HIGHWAYS DIVISION
SIGNING & PAVEMENT MARKING PLAN
MANELE ROAD RESURFACING
Vicinity of Lanai City towards Manele Bay
Fed. Aid Proj. No. STP-0440(5)
Scale: 1" = 40'

Date: March, 1994
SHEET No. 6 OF 8 SHEETS

ORIGINAL PLAN	DATE
SURVEY PLOTTED BY	5/7/94
DRAWN BY	G. Ullrich
DESIGNED BY	C. Pagan
CHECKED BY	
NOTE BOOK	
INITIALS	

FED. ROAD DIST. NO.	STATE	FED. AID PROJ. NO.	FISCAL YEAR	SHEET NO.	TOTAL SHEETS
HAWAII	HAW.	STP-0440(5)	1994	21	23

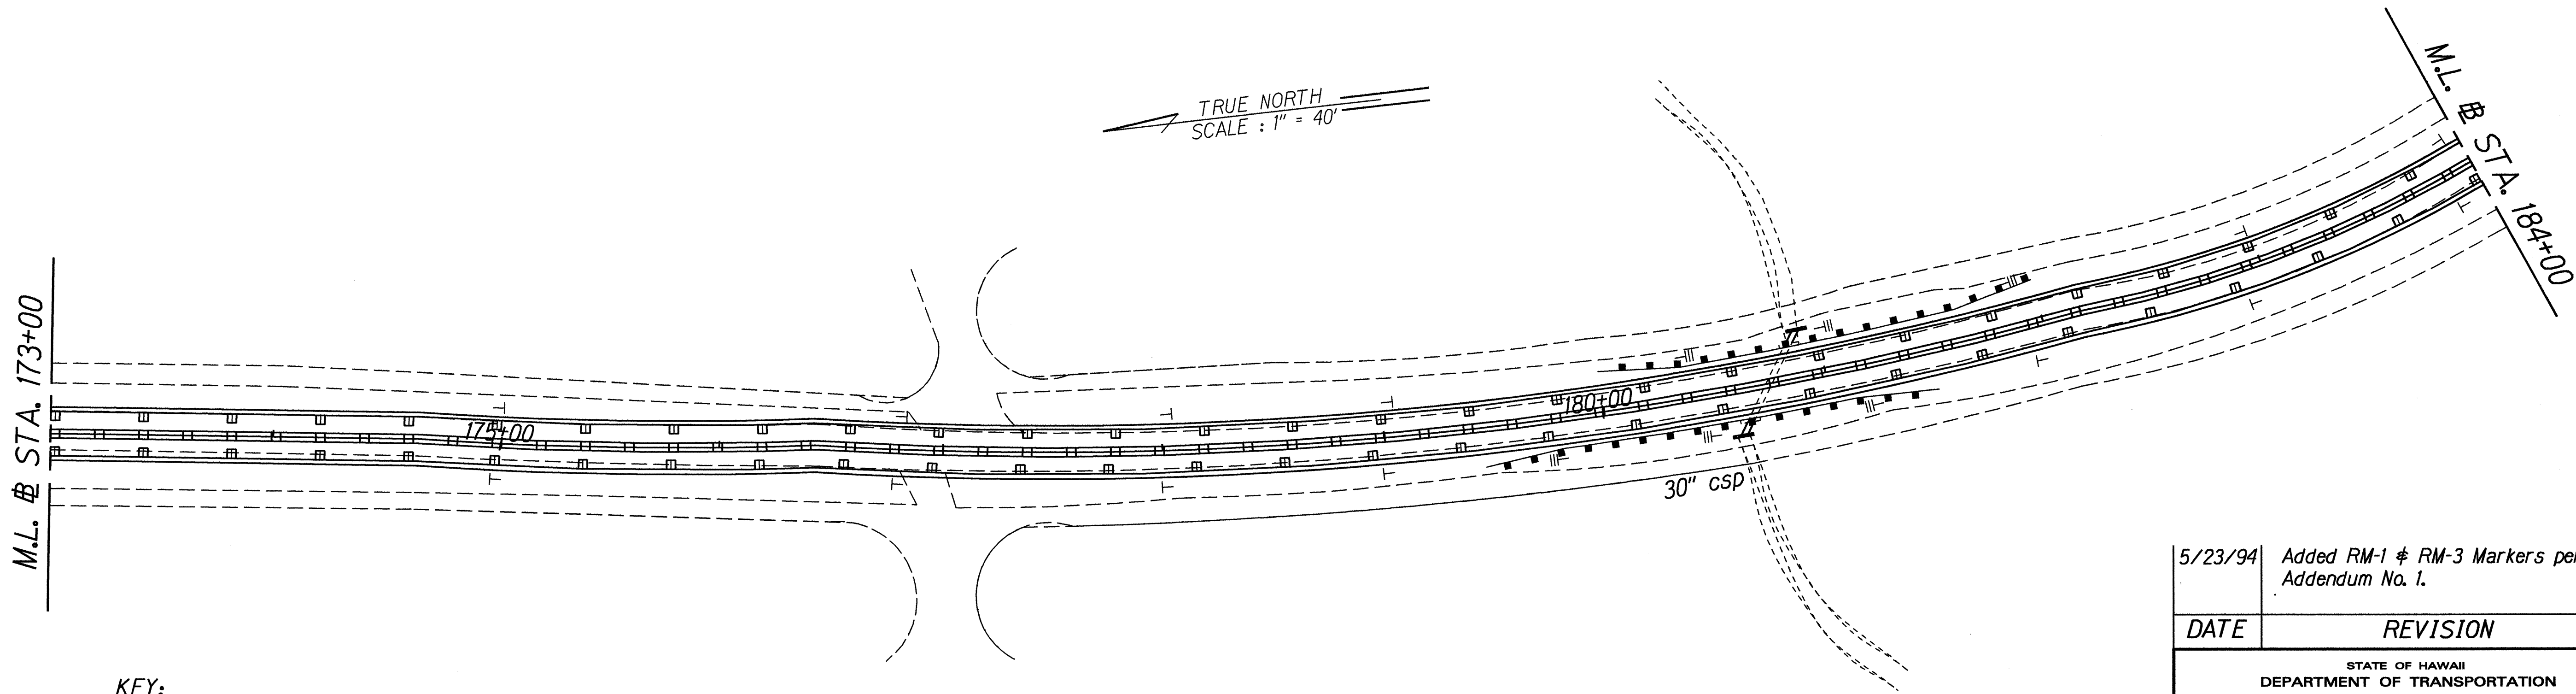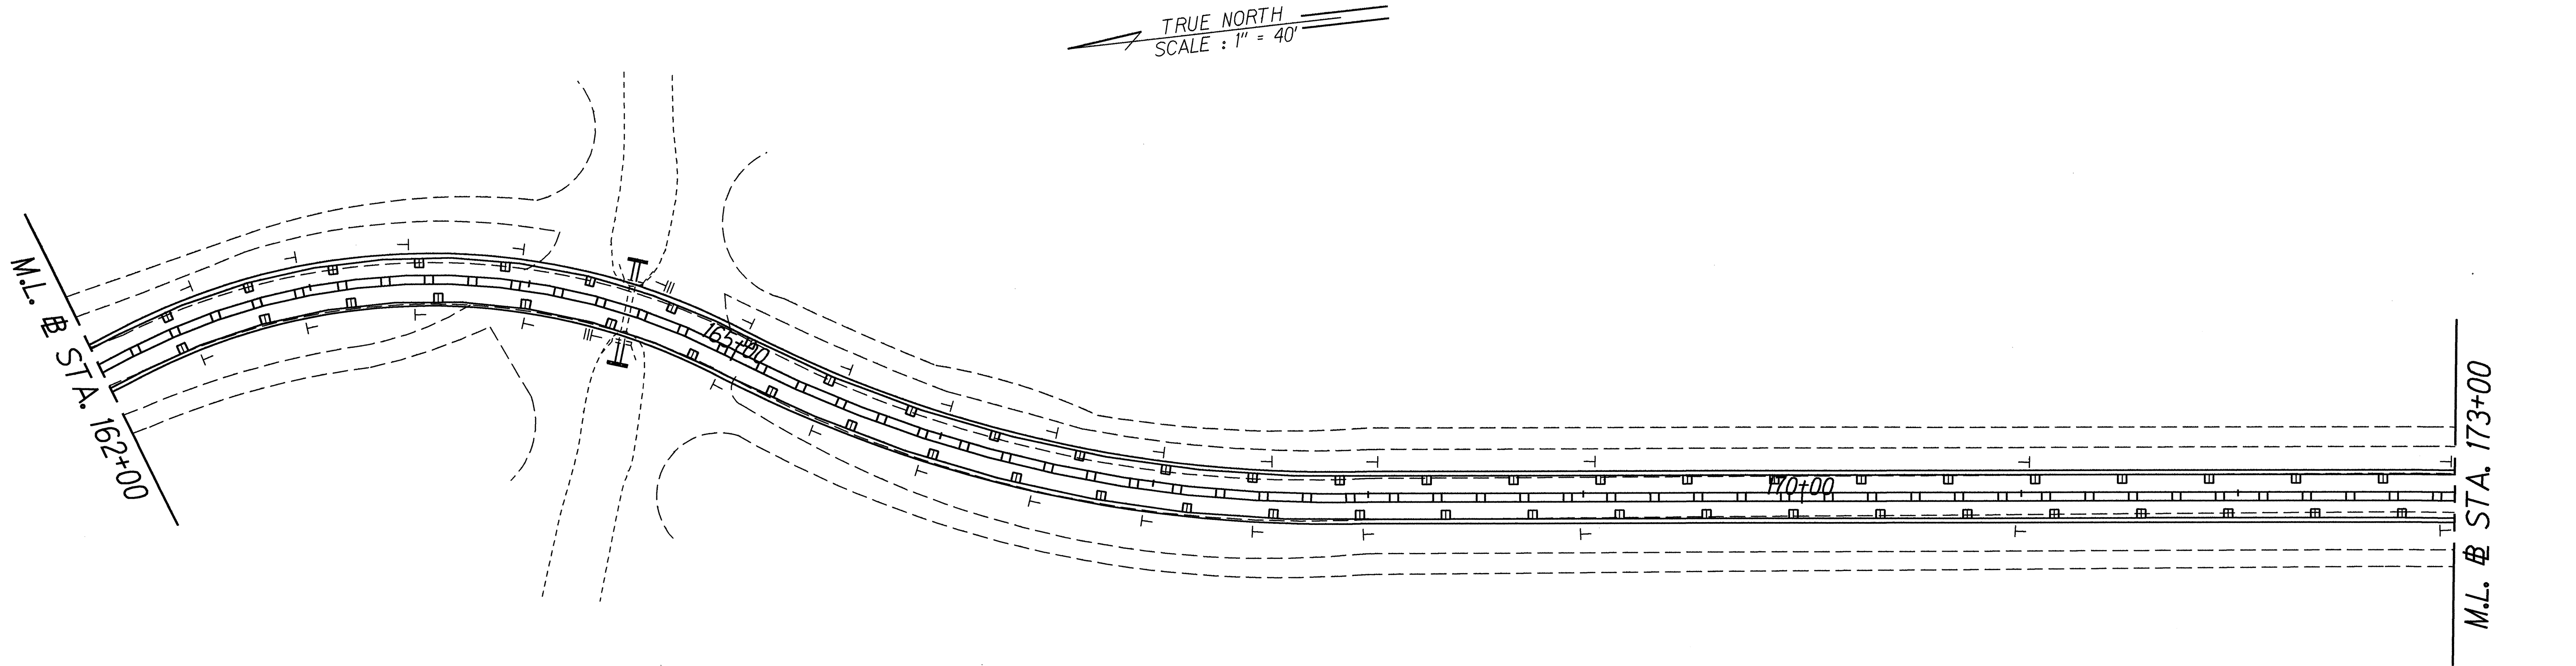


KEY:

- * Exist. Sign(s) & Post(s) to Remain
- ** Remove Exist. Sign(s) & Post(s)
- *** Remove Exist. Sign(s) w/Post(s)
& Install New Sign(s) w/Post(s)
- **** Install New Sign(s) & Post(s)
- + Install RM-1 Markers w/Post
- ||| Install RM-3 Markers w/Post

ORIGINAL PLAN	SURVEY PLOTTED BY DATE
NOTE BOOK	DRAWN BY 5/7/94
DESIGNED BY C. Hasegawa	CHECKED BY
QUANTITIES BY	
Revised	

5/23/94	Added RM-1 & RM-3 Markers per Addendum No. 1.
DATE	REVISION
STATE OF HAWAII DEPARTMENT OF TRANSPORTATION HIGHWAYS DIVISION SIGNING & PAVEMENT MARKING PLAN MANELE ROAD RESURFACING Vicinity of Lanai City towards Manele Bay Fed. Aid Proj. No. STP-0440(5) Scale: 1" = 40' Date: March, 1994	
SHEET No. 7 OF 8 SHEETS	

FED. ROAD DIST. NO.	STATE	FED. AID PROJ. NO.	FISCAL YEAR	SHEET NO.	TOTAL SHEETS
HAWAII	HAW.	STP-0440(5)	1994	22	23

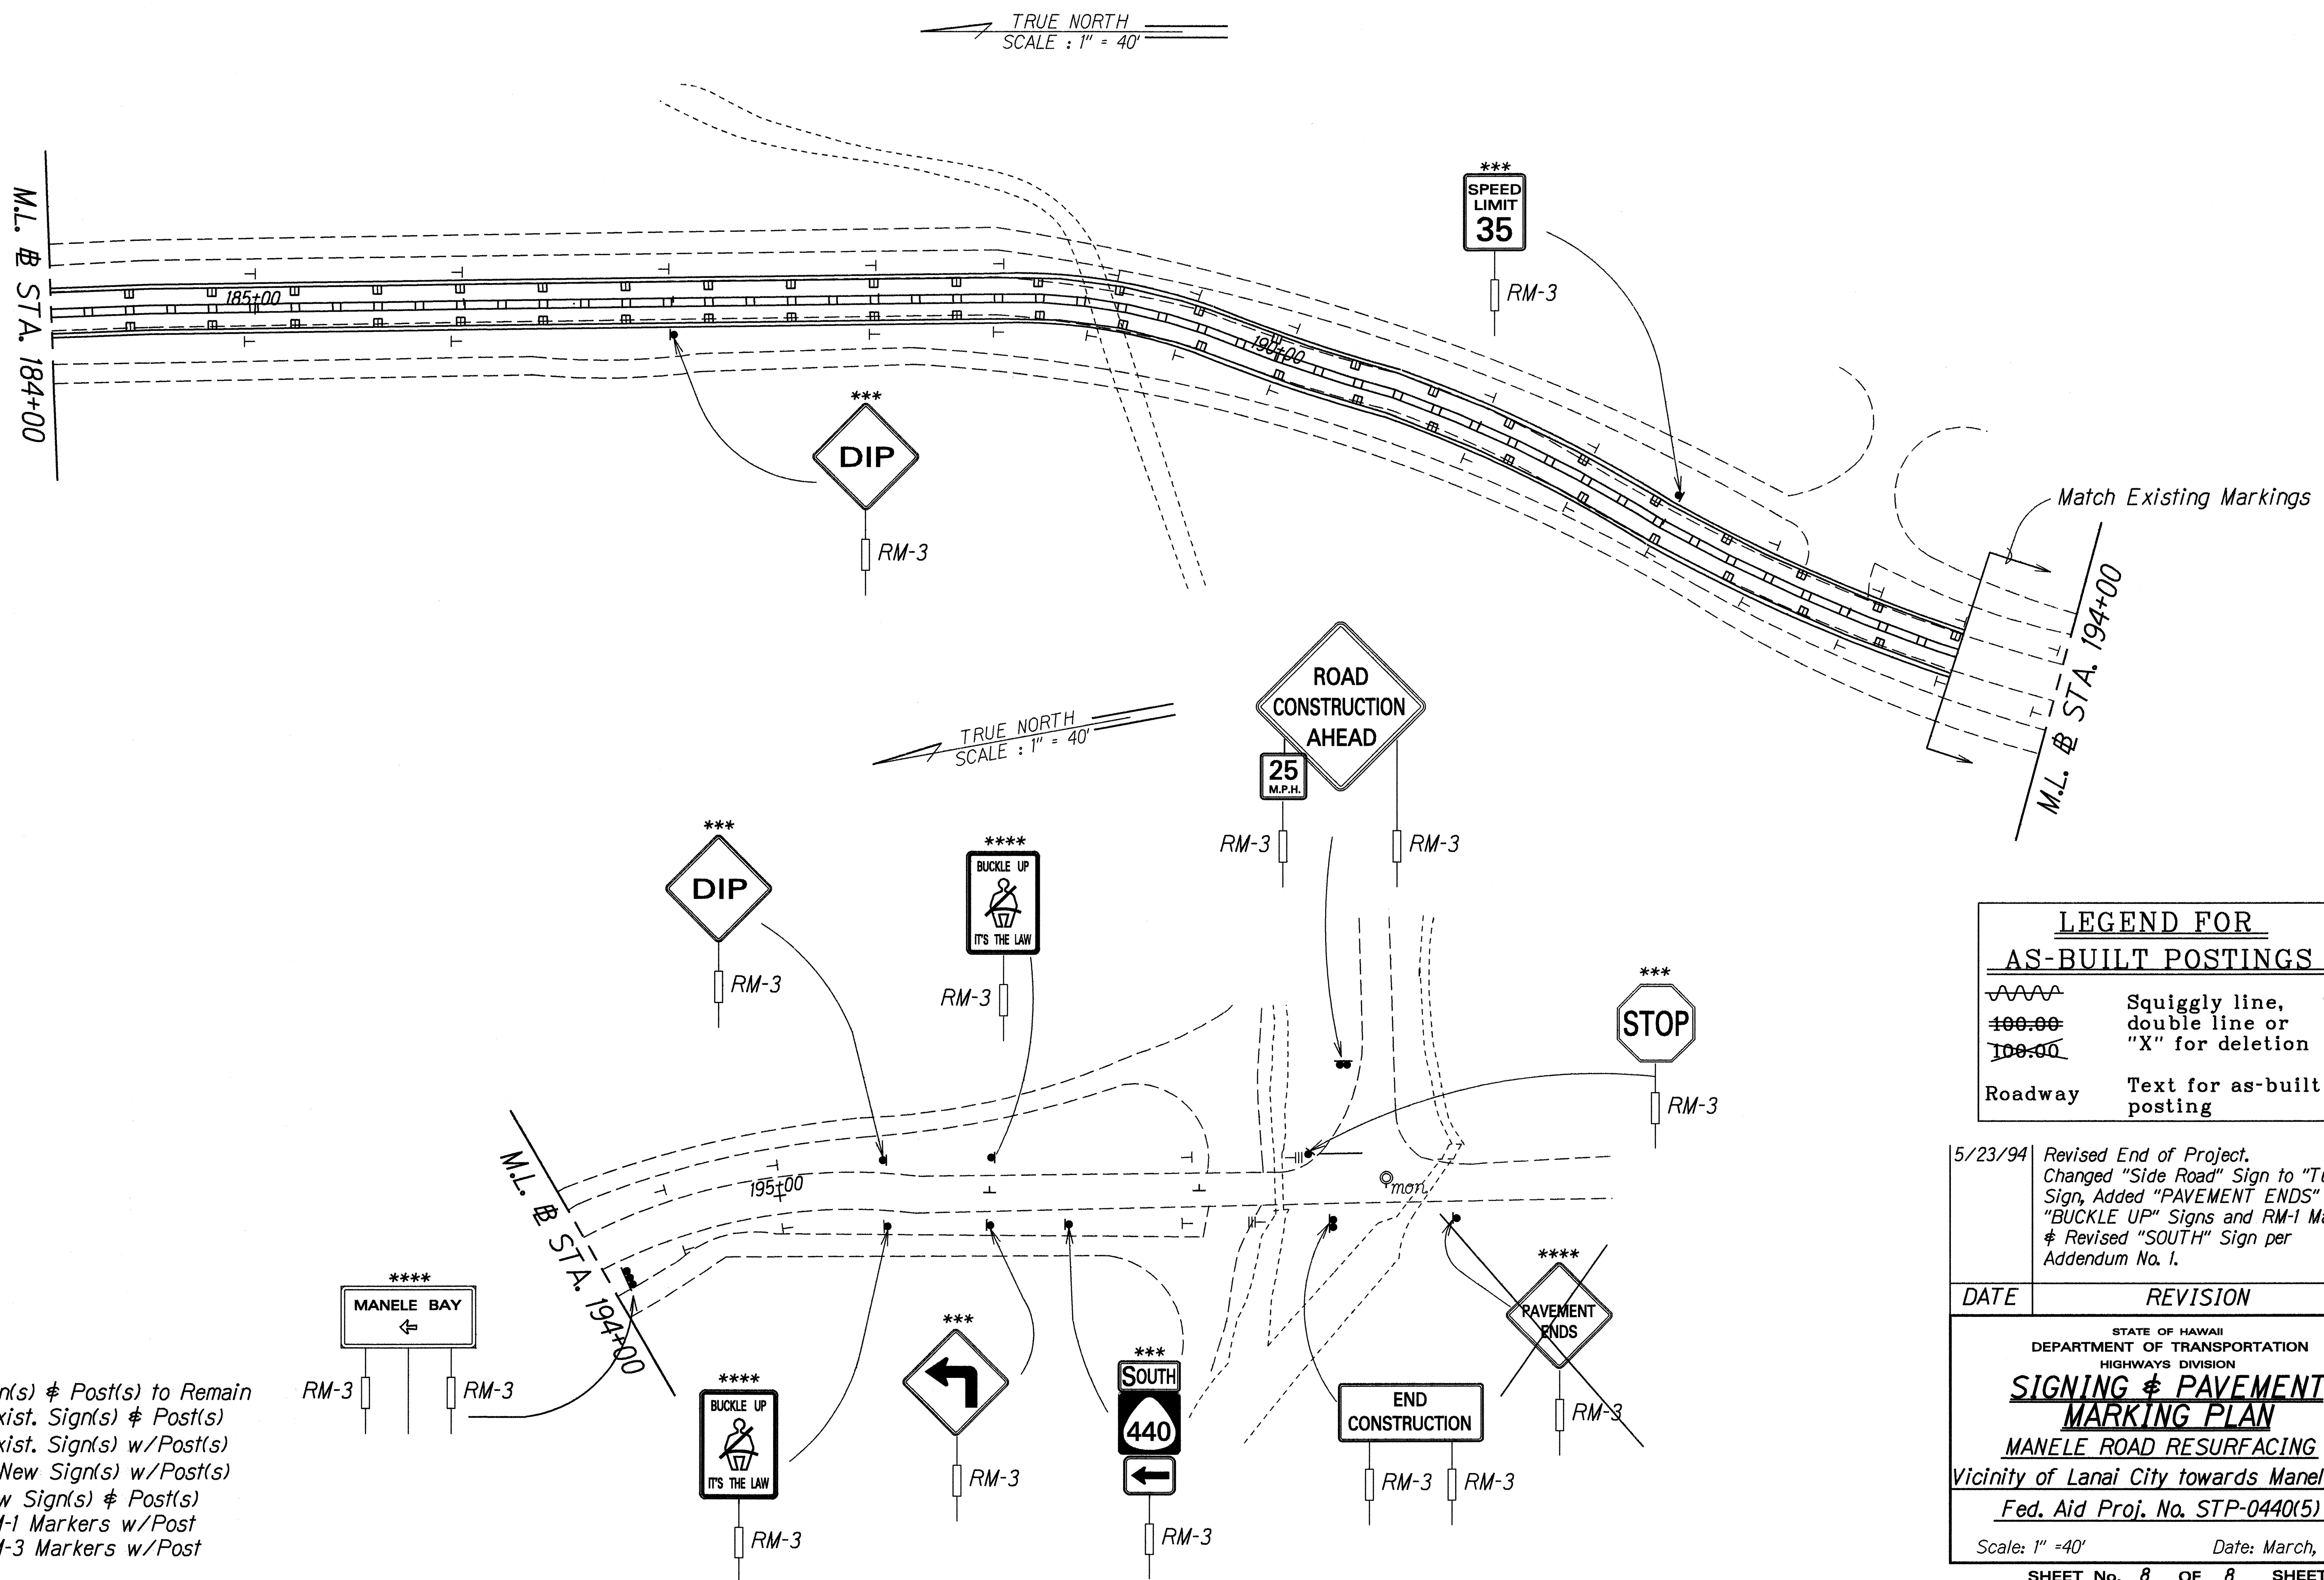

ORIGINAL PLAN	DATE
SURVEY PLOTTED BY	5/7/94
DRAWN BY	G. Unabia
DESIGNED BY	C. Pazaga
CHECKED BY	
NOTE BOOK	
REVISIONS	

5/23/94	Revised End of Project. Changed "Side Road" Sign to "Turn" Sign, Added "PAVEMENT ENDS" & "BUCKLE UP" Signs and RM-1 Markers & Revised "SOUTH" Sign per Addendum No. 1.
DATE	REVISION
STATE OF HAWAII DEPARTMENT OF TRANSPORTATION HIGHWAYS DIVISION SIGNING & PAVEMENT MARKING PLAN MANELE ROAD RESURFACING Vicinity of Lanai City towards Manele Bay Fed. Aid Proj. No. STP-0440(5) Scale: 1" = 40' Date: March, 1994 SHEET No. 8 OF 8 SHEETS	