




FED. ROAD DIST. NO.	STATE	FED. AID PROJ. NO.	FISCAL YEAR	SHEET NO.	TOTAL SHEETS
HAWAII	HAW.	STP-0440(5)	1994	4	23

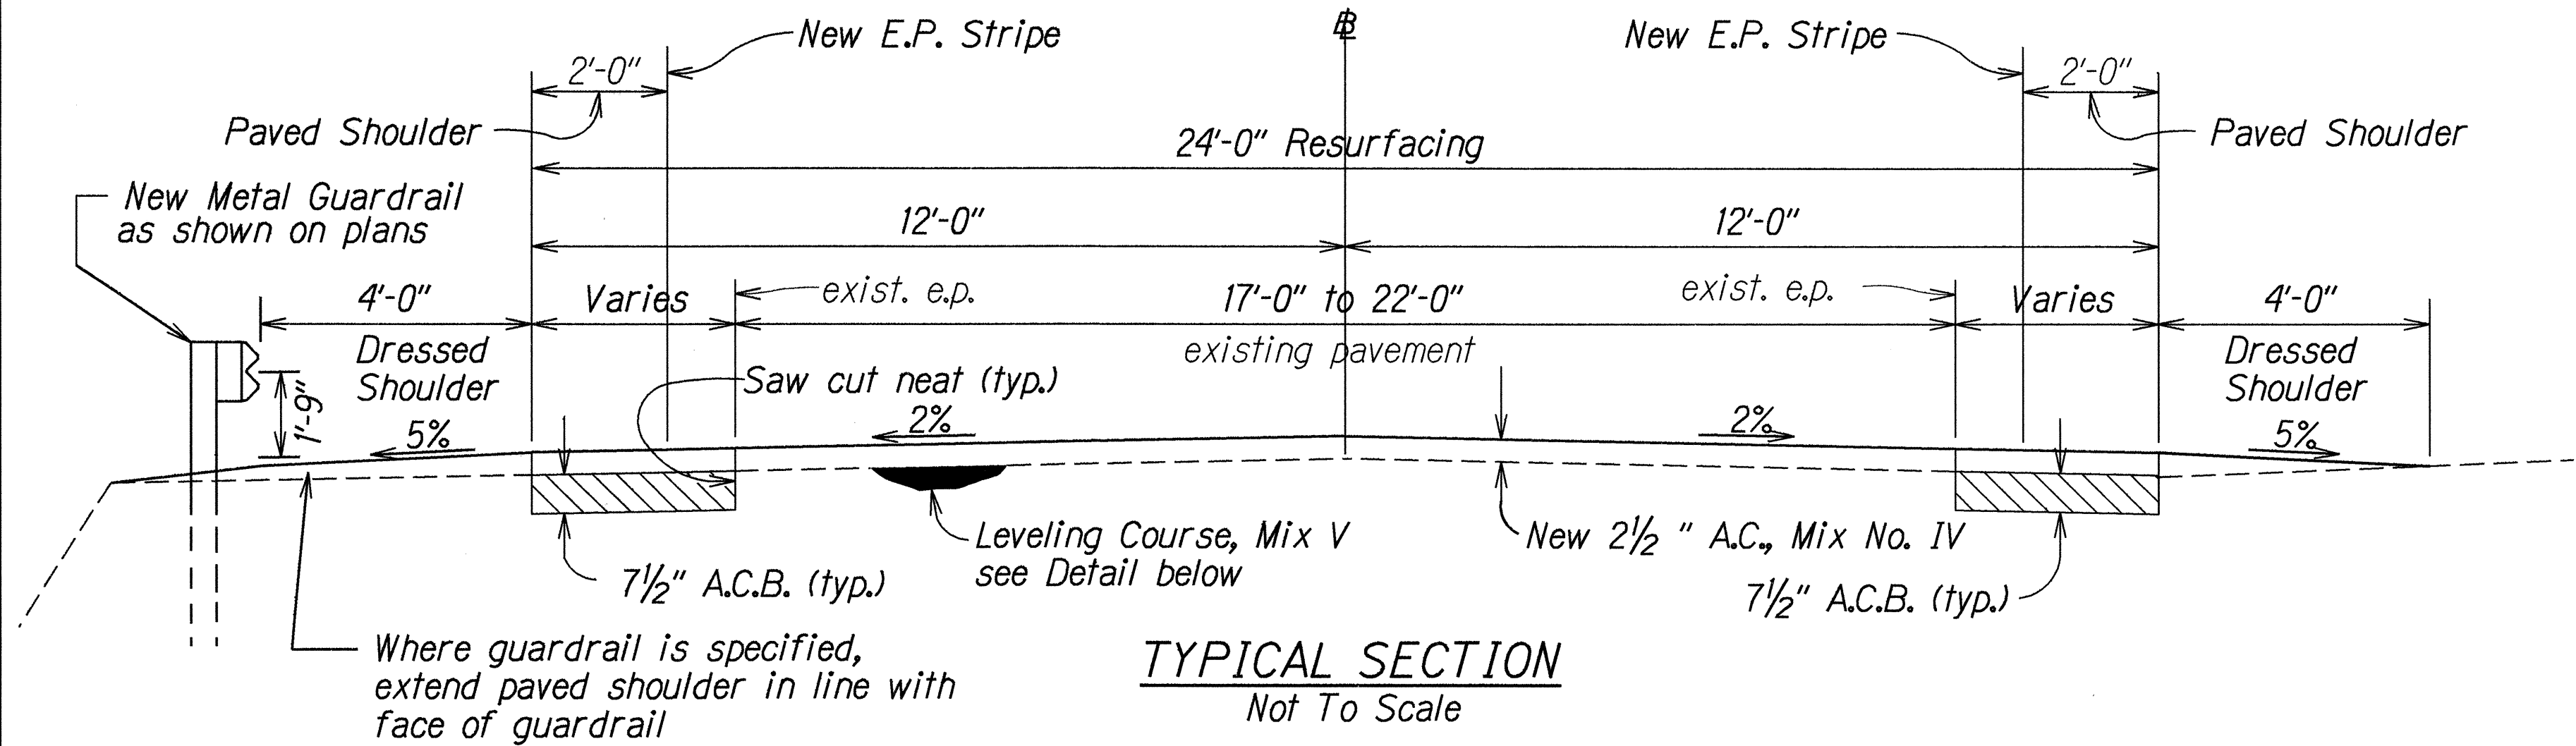


TYPICAL SECTION
Not To Scale

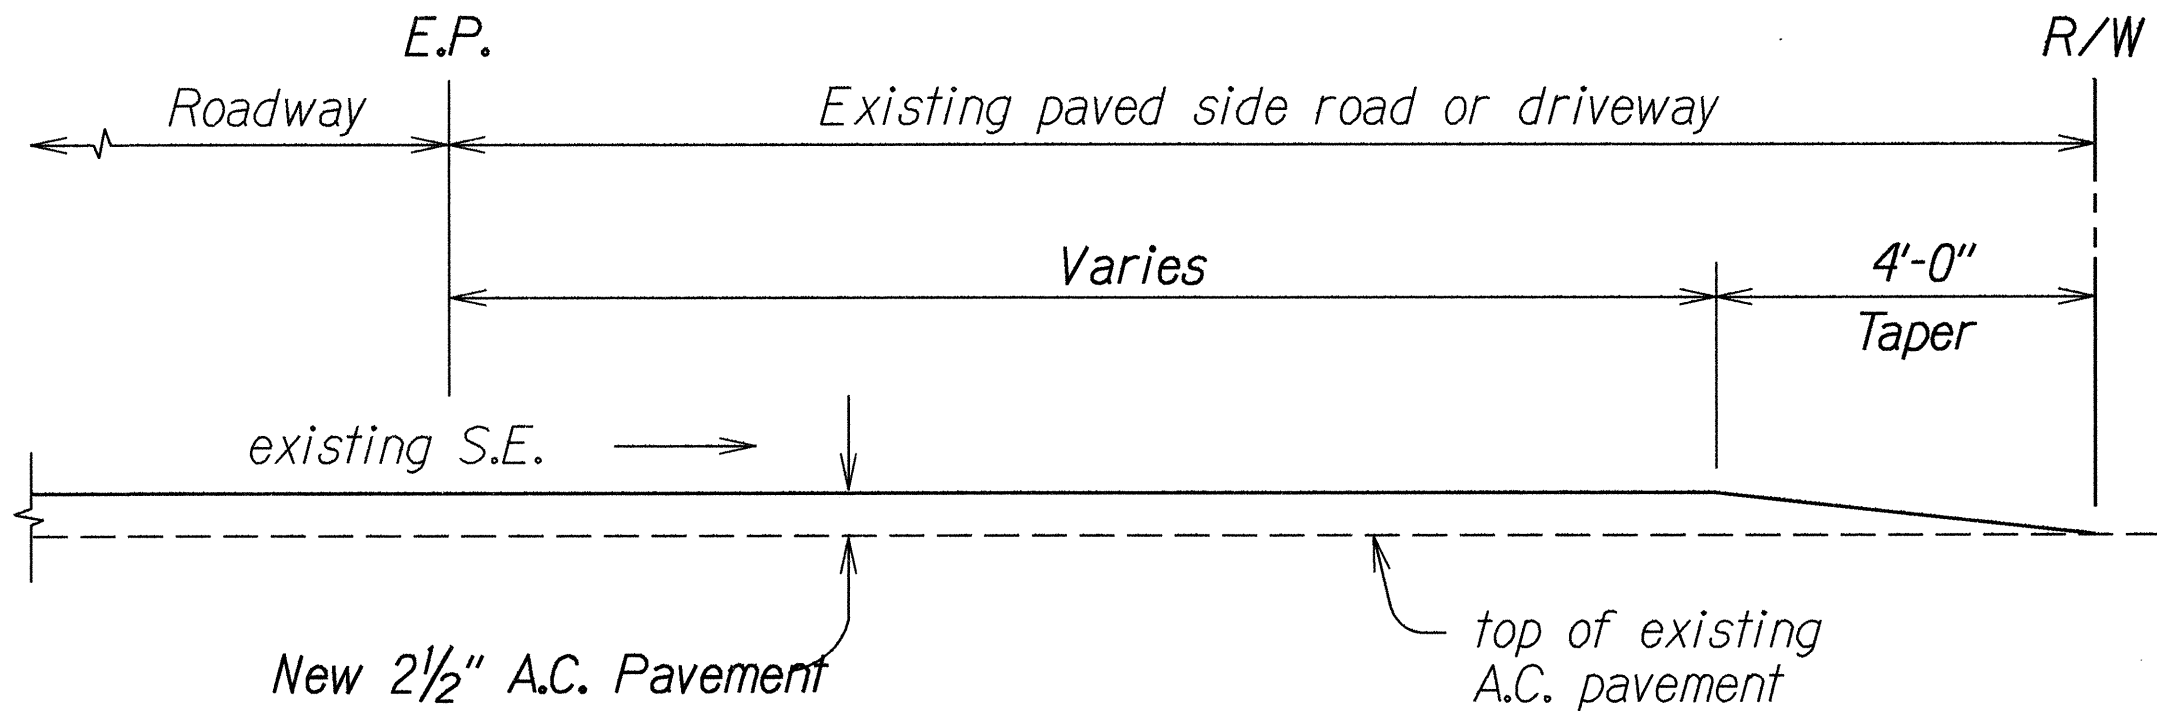

A. C. RESURFACING AT PAVED SIDEROAD OR PAVED DRIVEWAY DETAIL
Not To Scale

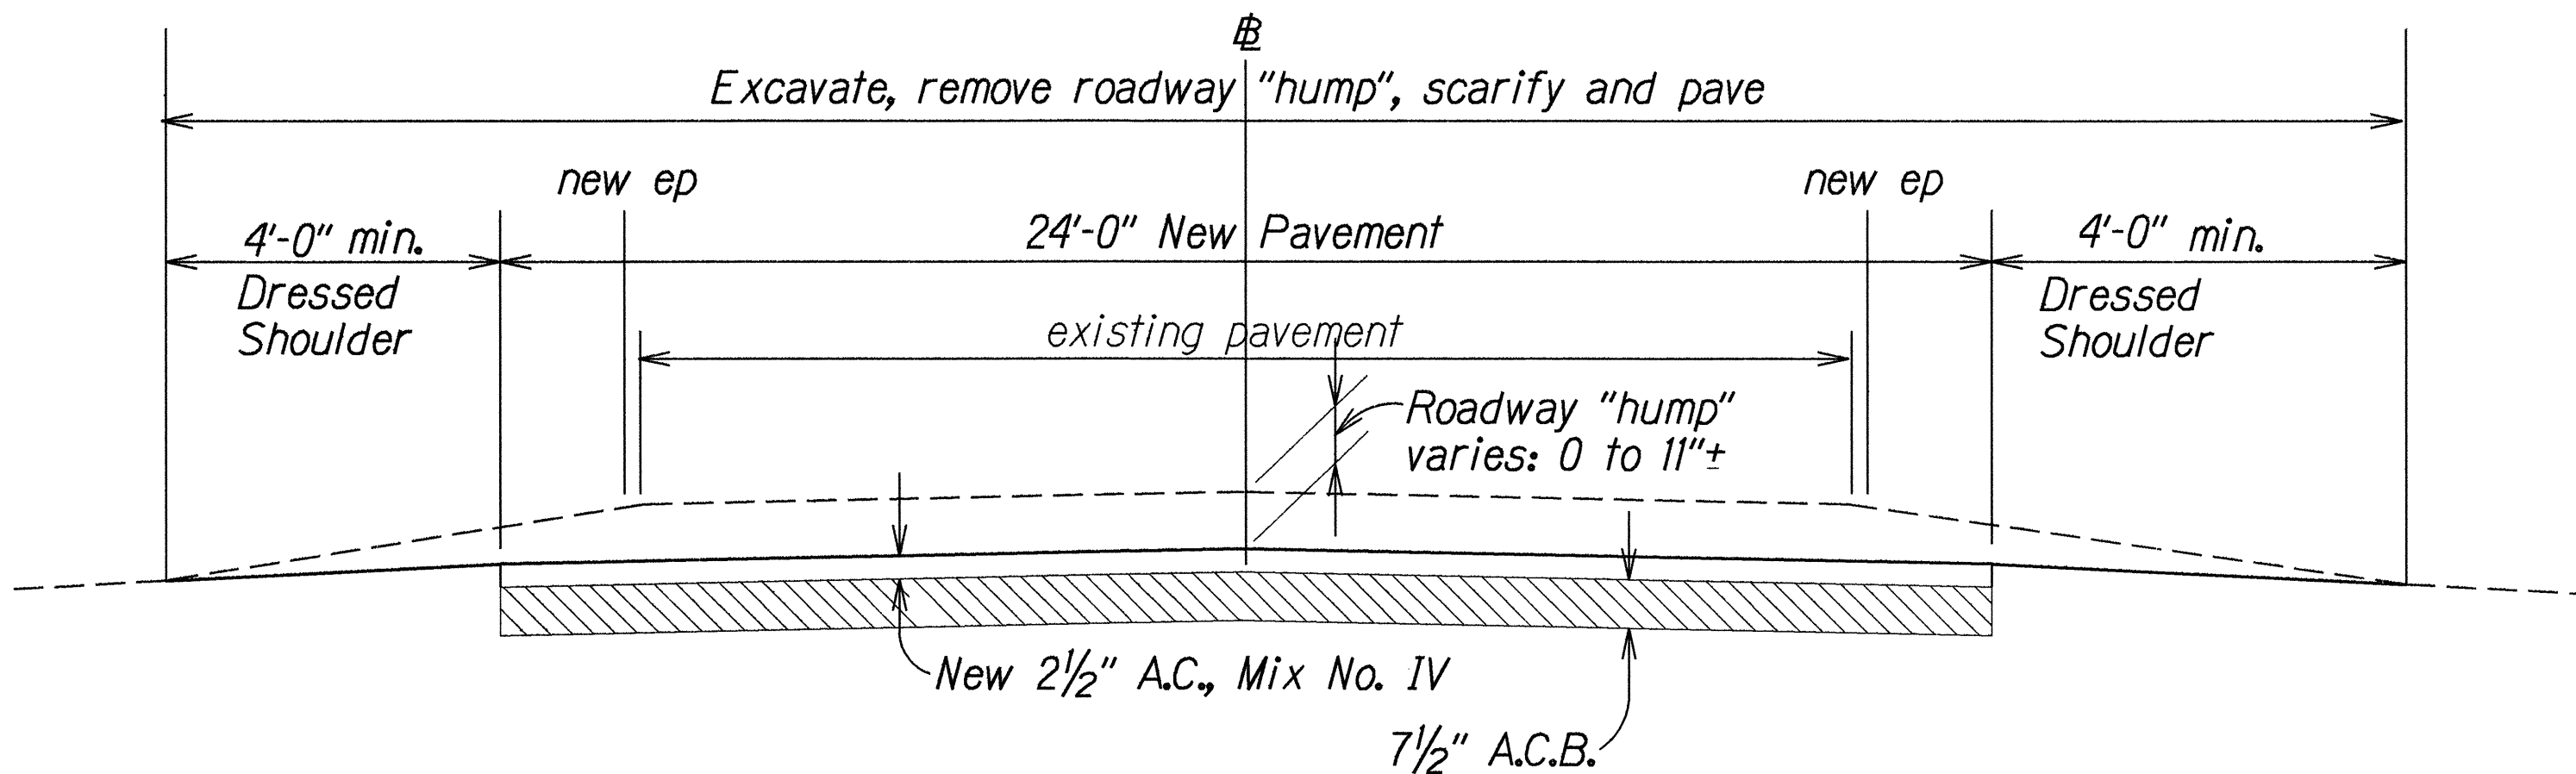


ROADWAY "HUMP" REMOVAL DETAIL
STA. 136+50 TO STA. 137+50
Not To Scale
STA. 135+50 LT./RT. TO STA. 137+50 LT./RT.

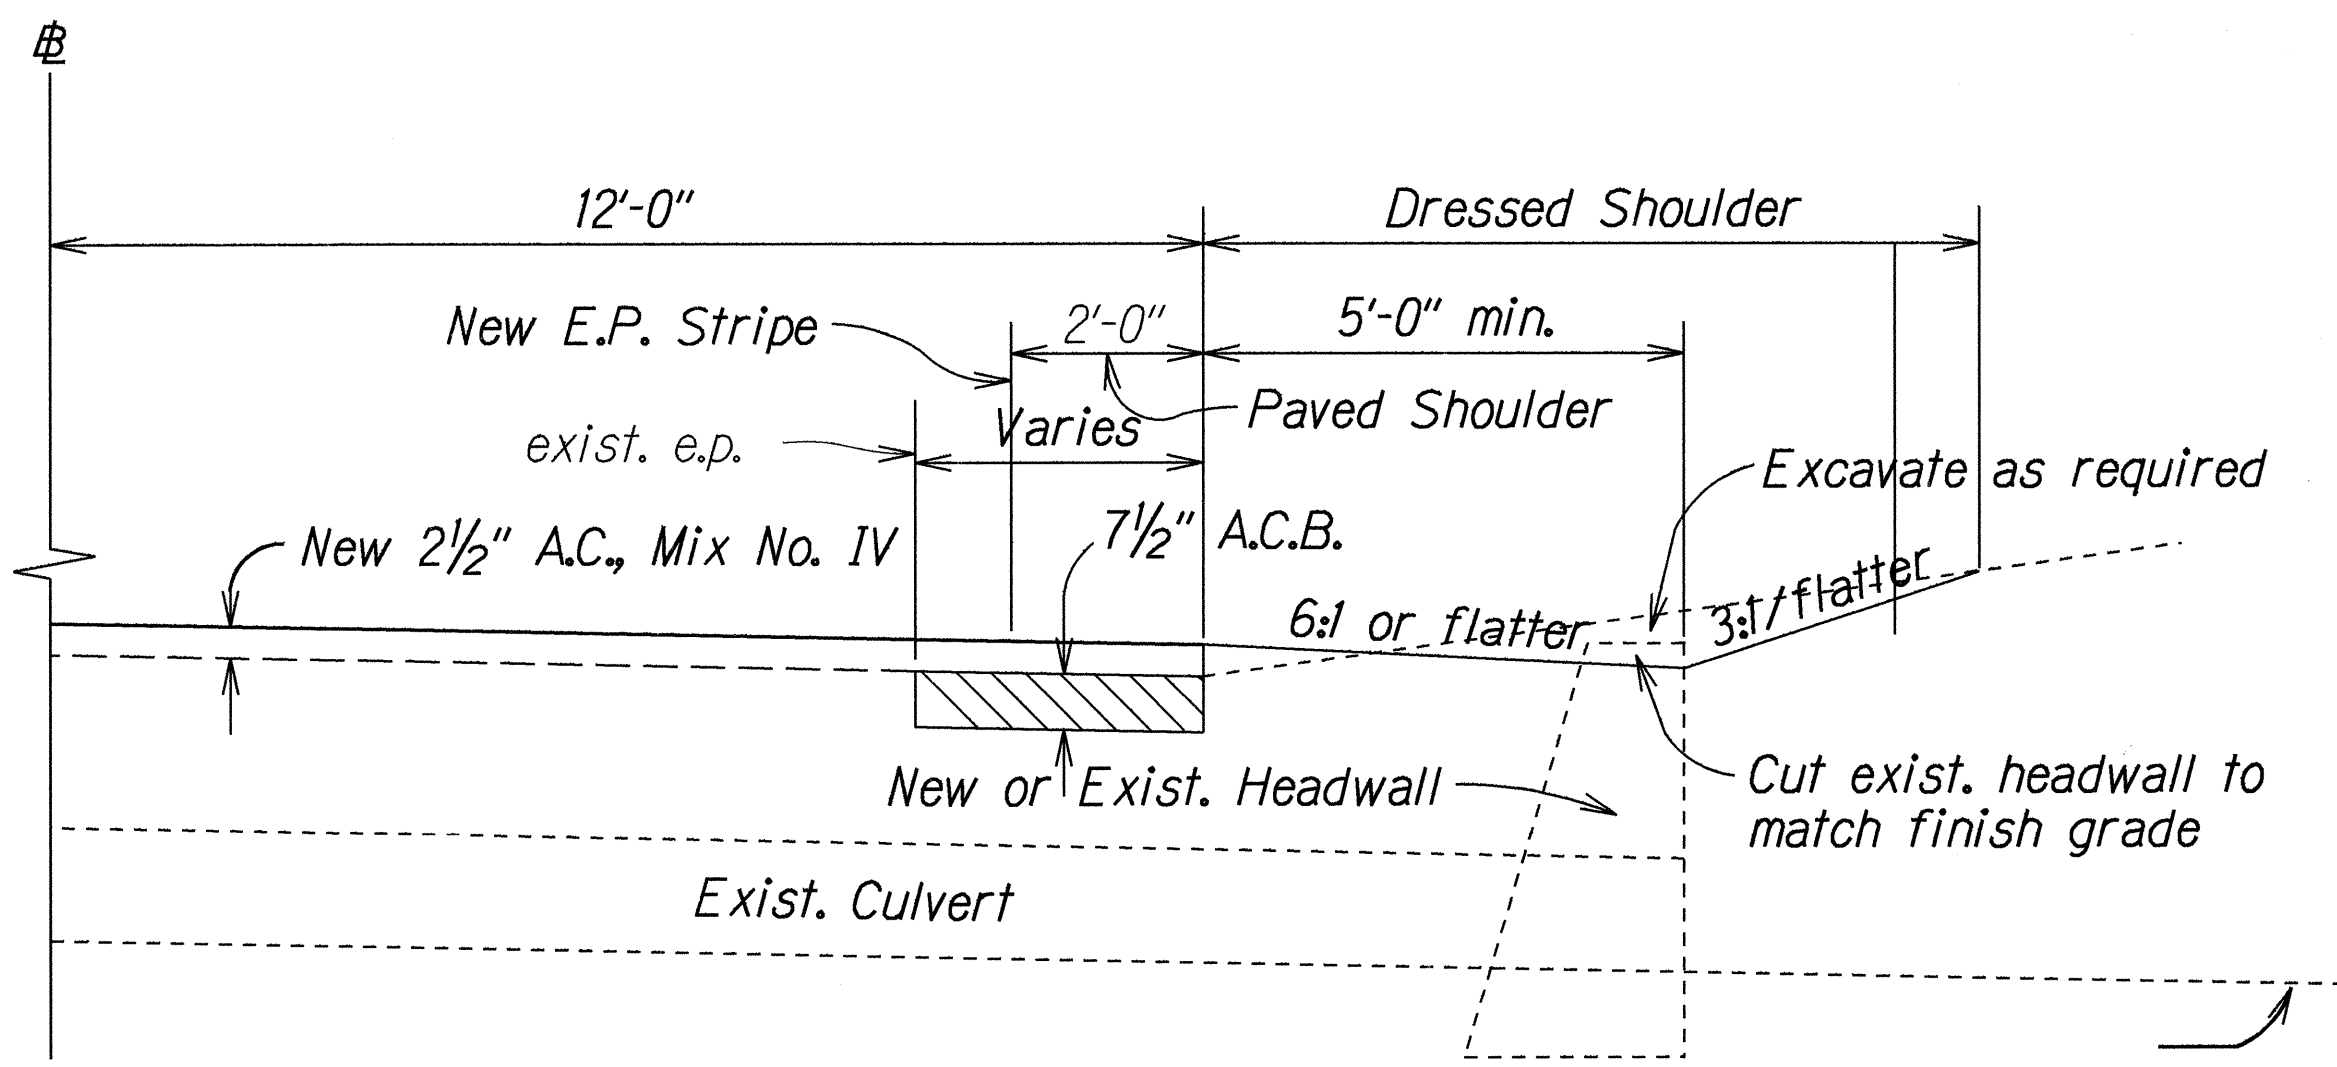


SHOULDER TREATMENT DETAIL
STA. 155+00 TO STA. 193+50
Not To Scale


LEGEND FOR AS-BUILT POSTINGS	
	Squiggly line for as-built deletion
	Double line for as-built deletion
Roadway	Text for as-built posting

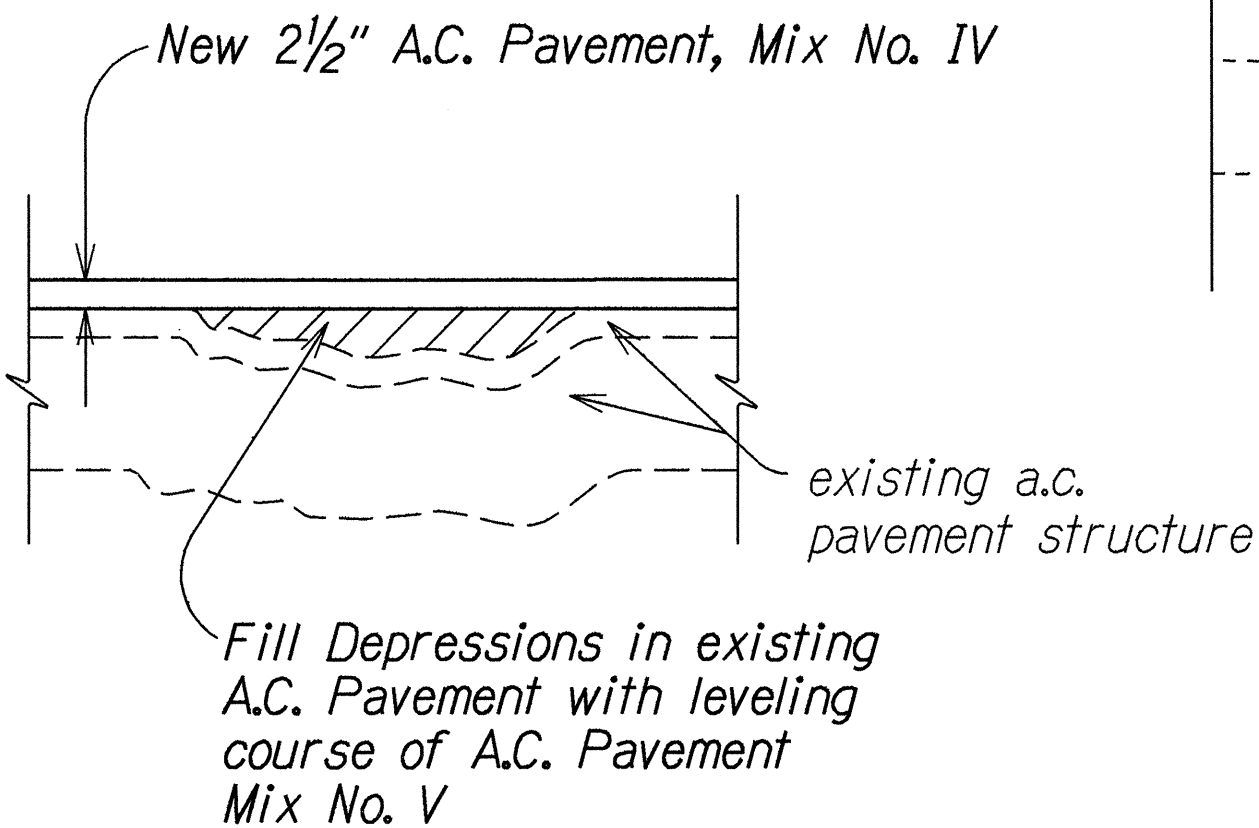

LEVELING COURSE DETAIL
Not To Scale

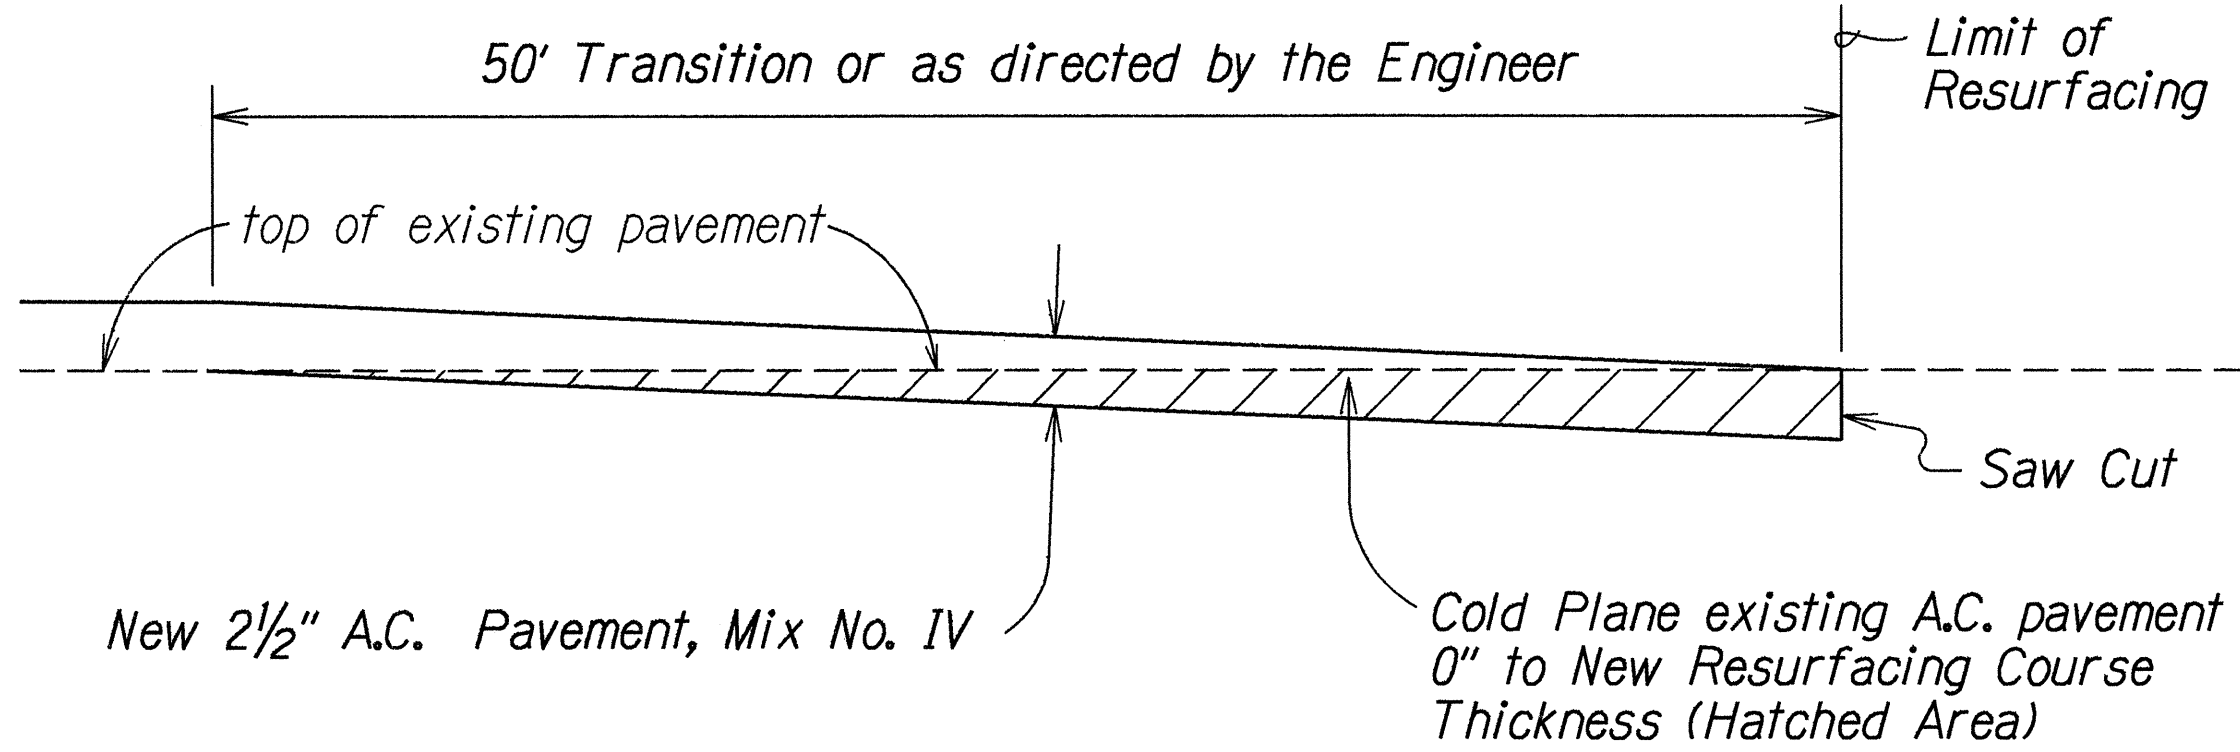

COLD PLANED TRANSITION TO EXISTING A.C. PAVEMENT
Not To Scale

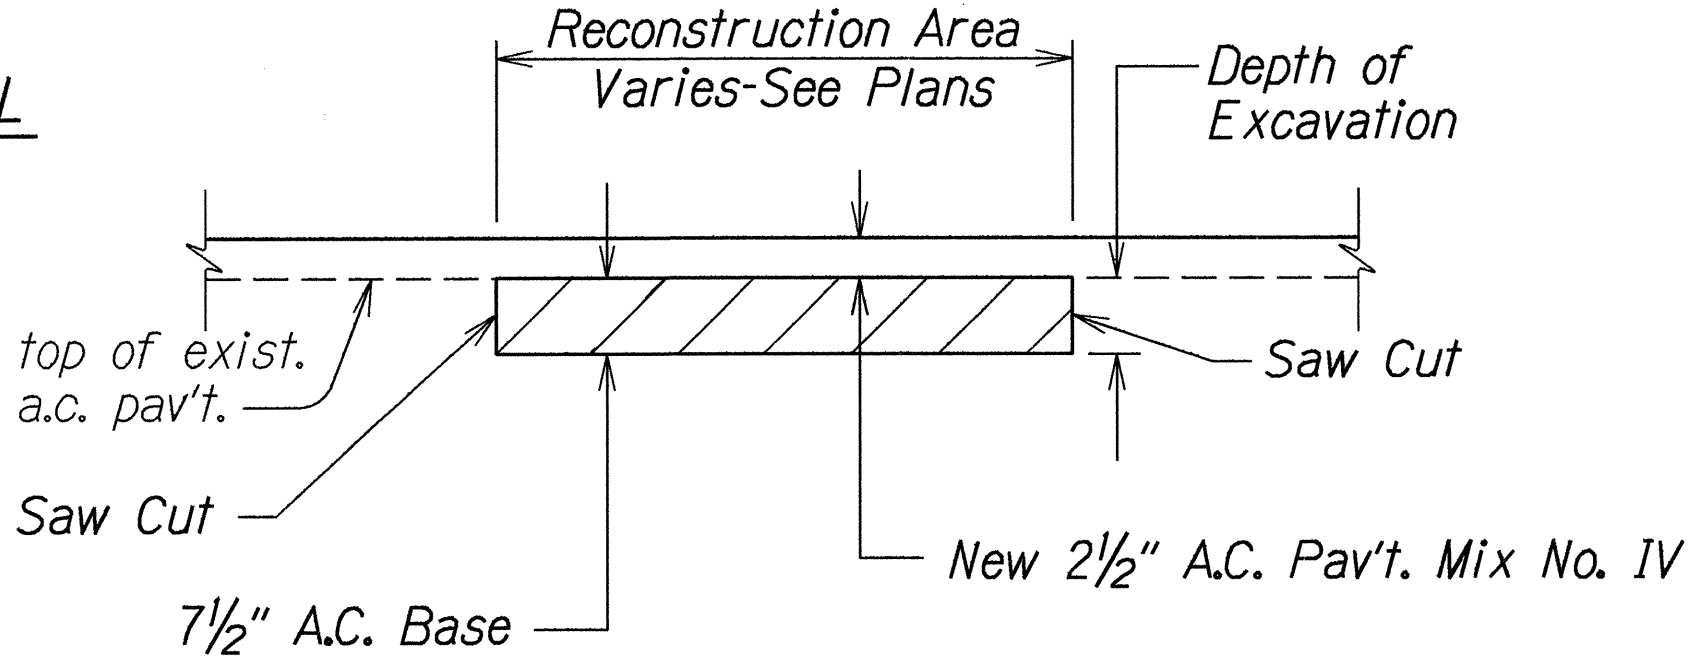

A.C. PAVEMENT RECONSTRUCTION DETAIL
Not To Scale

6/13/94	Revised Typical Sections and Other Details per Addendum No. 1
DATE	REVISION
STATE OF HAWAII DEPARTMENT OF TRANSPORTATION HIGHWAYS DIVISION	
TYPICAL SECTION & DETAILS	
MANELE ROAD RESURFACING Vicinity of Lanai City towards Manele Bay Project No. STP-0440(5)	
Scale: As Shown	Date: March, 1994
SHEET No. 1 OF 1 SHEETS	