


FED. ROAD DIST. NO.	STATE	PROJ. NO.	FISCAL YEAR	SHEET NO.	TOTAL SHEETS
HAWAII	HAW.	440A-01-99M	1999	5	11

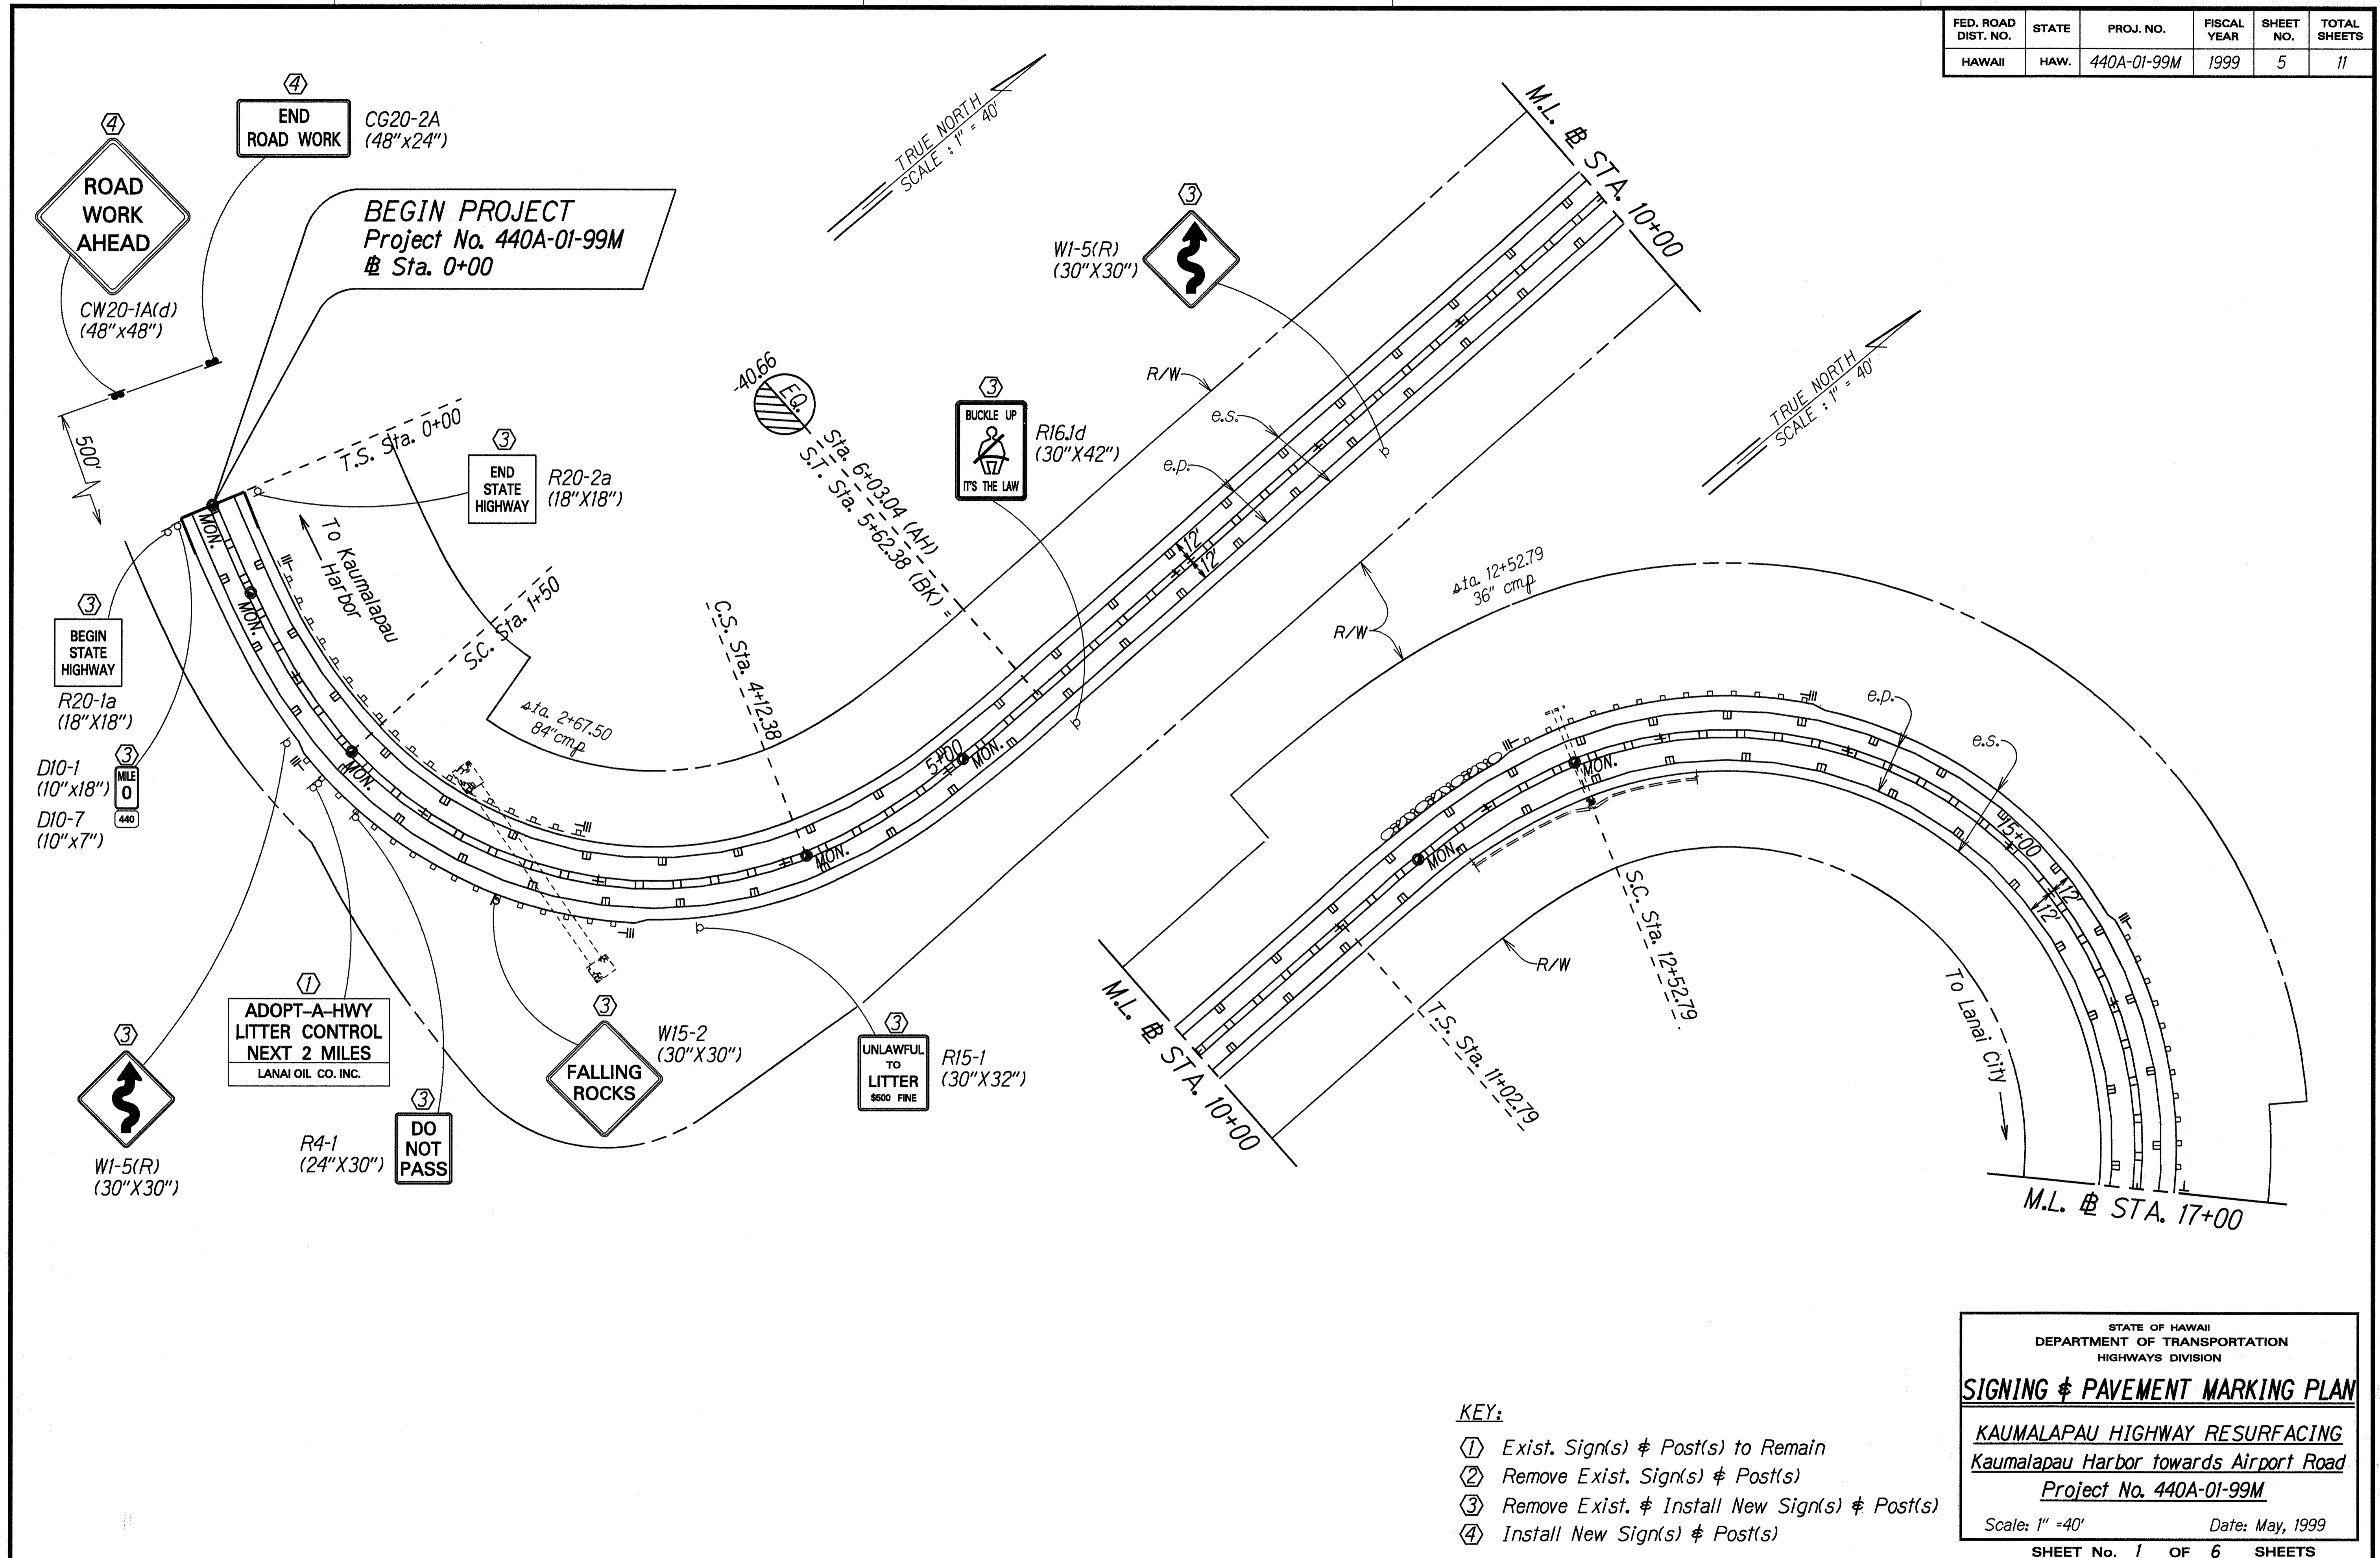

SURVEY PLOTTED BY	DATE	10/1/99
DRAWN BY		
DESIGNED BY		
QUANTITIES BY		
CHECKED BY		

- KEY:**
- ① Exist. Sign(s) & Post(s) to Remain
 - ② Remove Exist. Sign(s) & Post(s)
 - ③ Remove Exist. & Install New Sign(s) & Post(s)
 - ④ Install New Sign(s) & Post(s)

STATE OF HAWAII
DEPARTMENT OF TRANSPORTATION
HIGHWAYS DIVISION


SIGNING & PAVEMENT MARKING PLAN

*Kaunalapau Highway Resurfacing
Kaunalapau Harbor towards Airport Road
Project No. 440A-01-99M*

Scale: 1" = 40' Date: May, 1999

SHEET No. 1 OF 6 SHEETS

FED. ROAD DIST. NO.	STATE	PROJ. NO.	FISCAL YEAR	SHEET NO.	TOTAL SHEETS
HAWAII	HAW.	440A-01-99M	1999	6	11

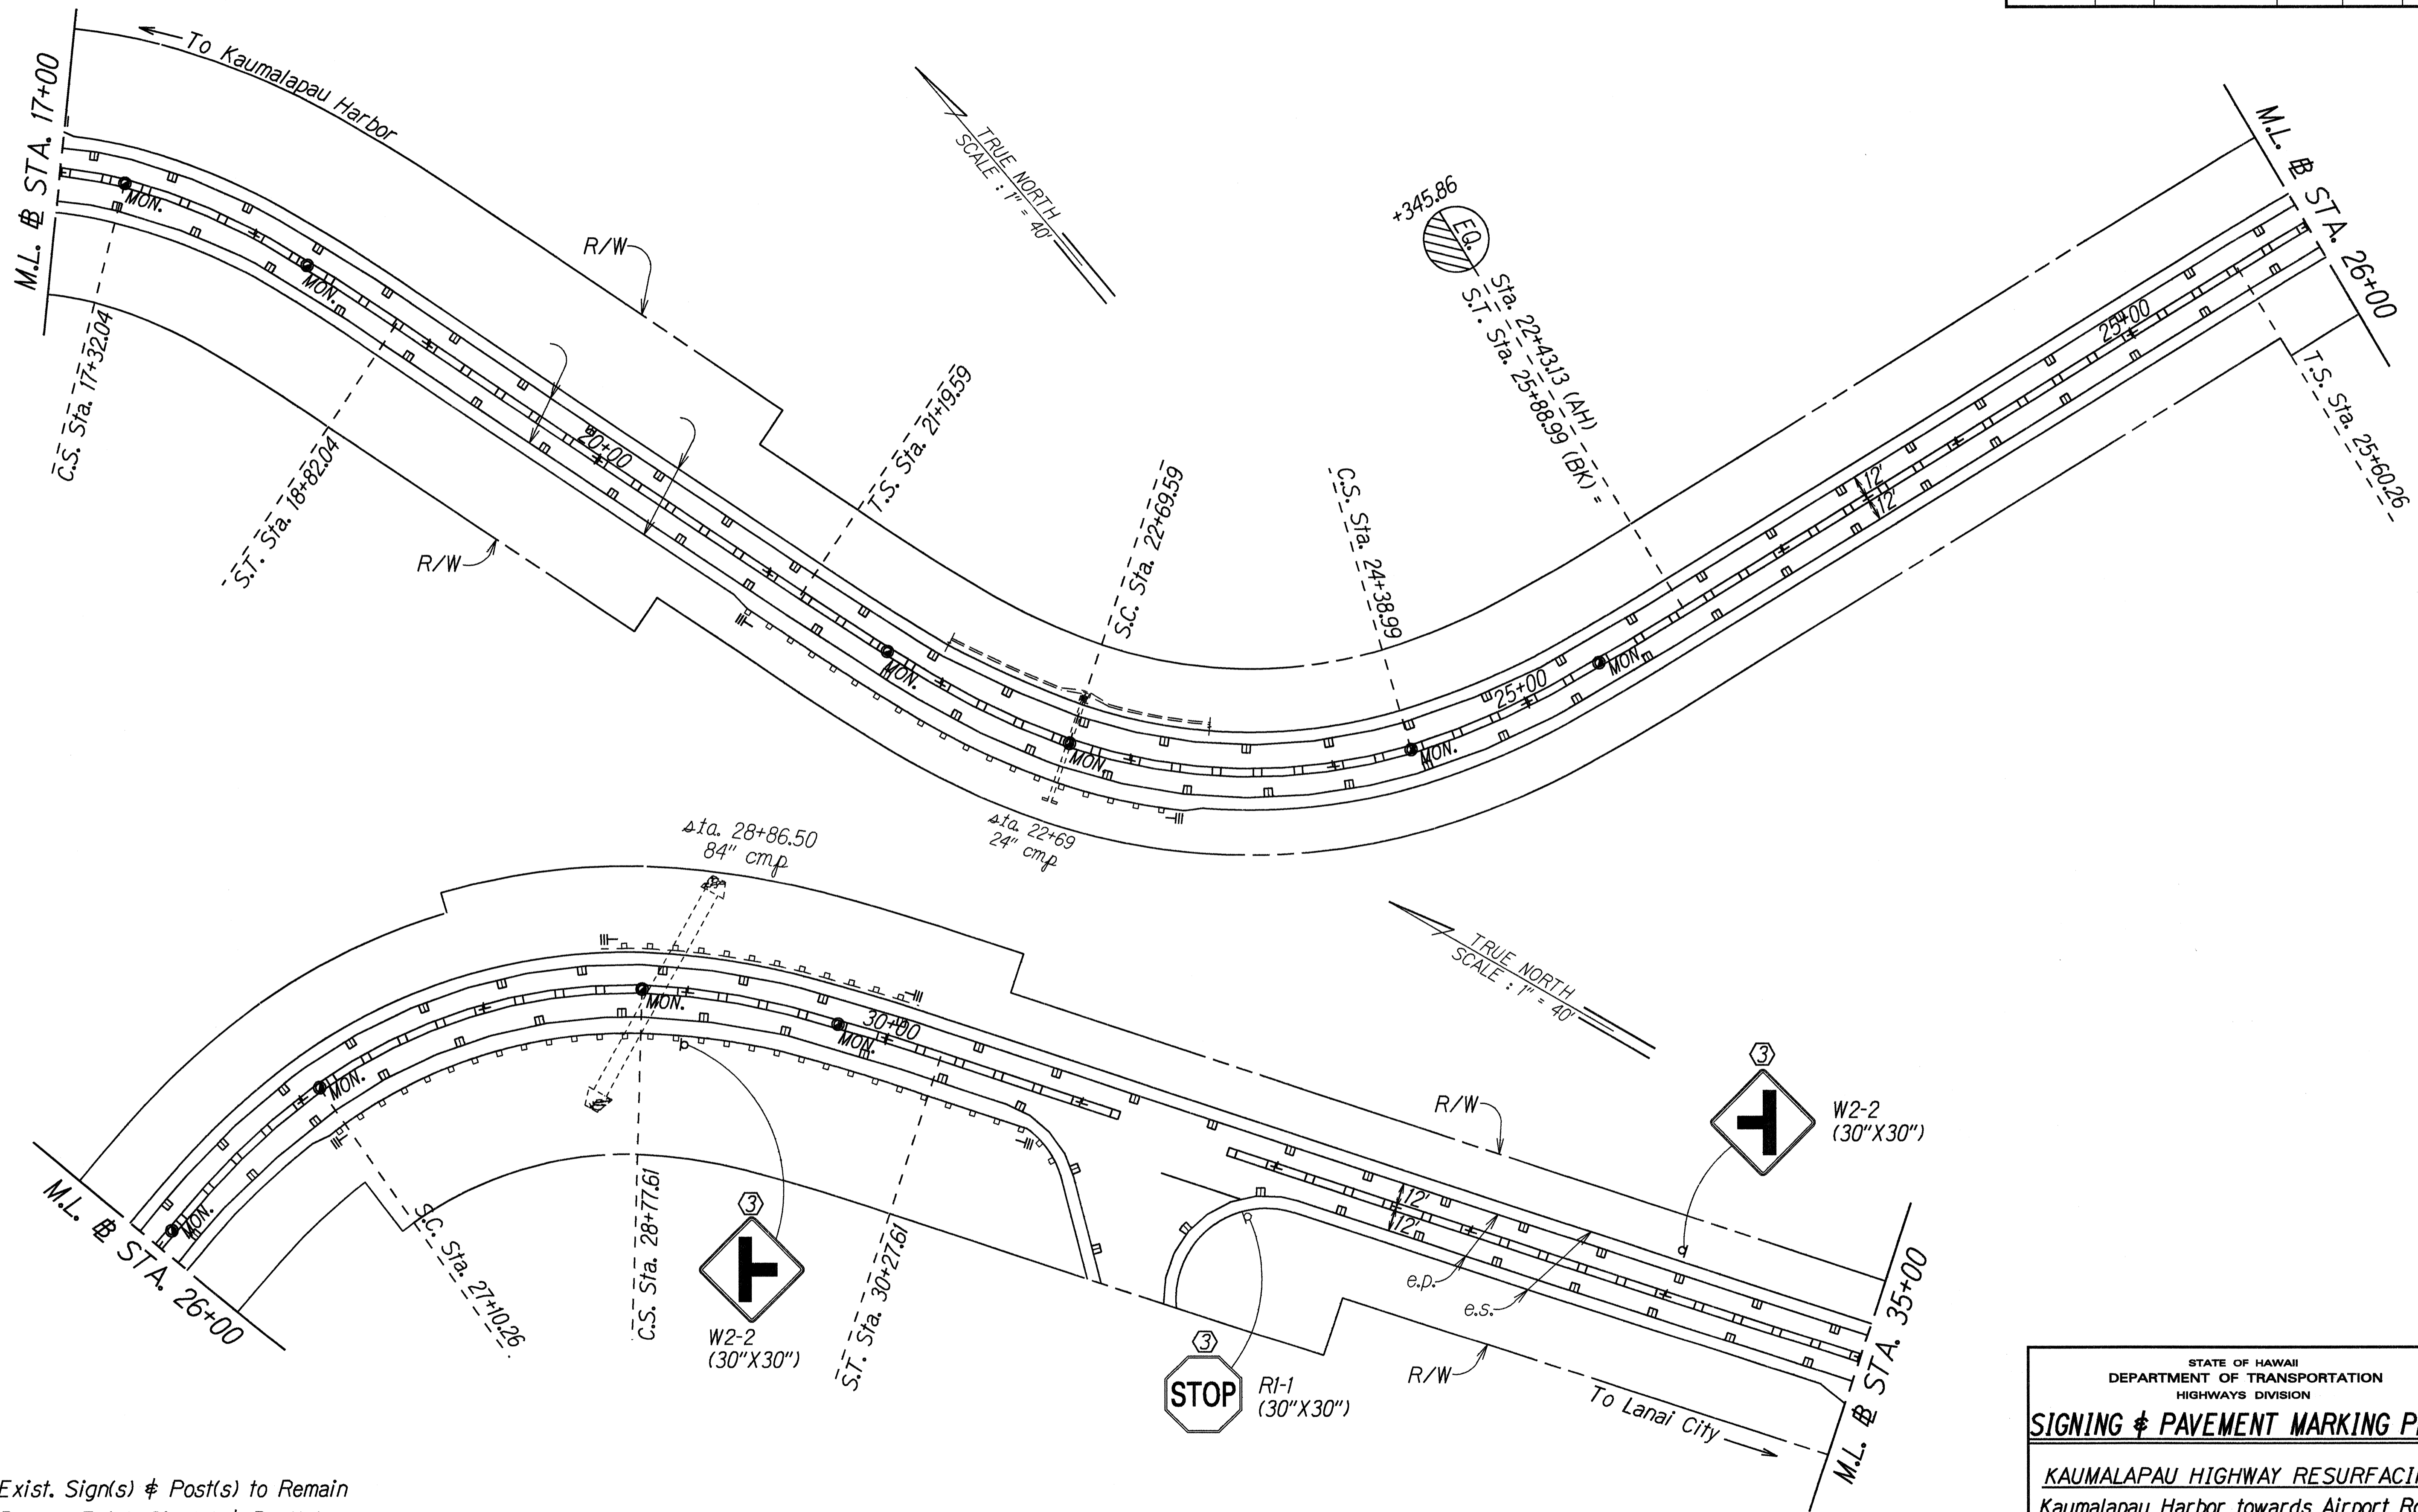

SURVEY PLOTTED BY	DATE	1999
DRAWN BY		
DESIGNED BY		
QUANTITIES BY		
CHECKED BY		
ORIGINAL PLAN		
NOTE BOOK		
10/11/98 CRIS		
5/11/1999		

KEY:

- ① Exist. Sign(s) & Post(s) to Remain
- ② Remove Exist. Sign(s) & Post(s)
- ③ Remove Exist. & Install New Sign(s) & Post(s)
- ④ Install New Sign(s) & Post(s)


STATE OF HAWAII
DEPARTMENT OF TRANSPORTATION
HIGHWAYS DIVISION

SIGNING & PAVEMENT MARKING PLAN


*KAUMALAPAU HIGHWAY RESURFACING
Kaumalapau Harbor towards Airport Road
Project No. 440A-01-99M*

Scale: 1" = 40' Date: May, 1999

FED. ROAD DIST. NO.	STATE	PROJ. NO.	FISCAL YEAR	SHEET NO.	TOTAL SHEETS
HAWAII	HAW.	440A-01-99M	1999	7	11

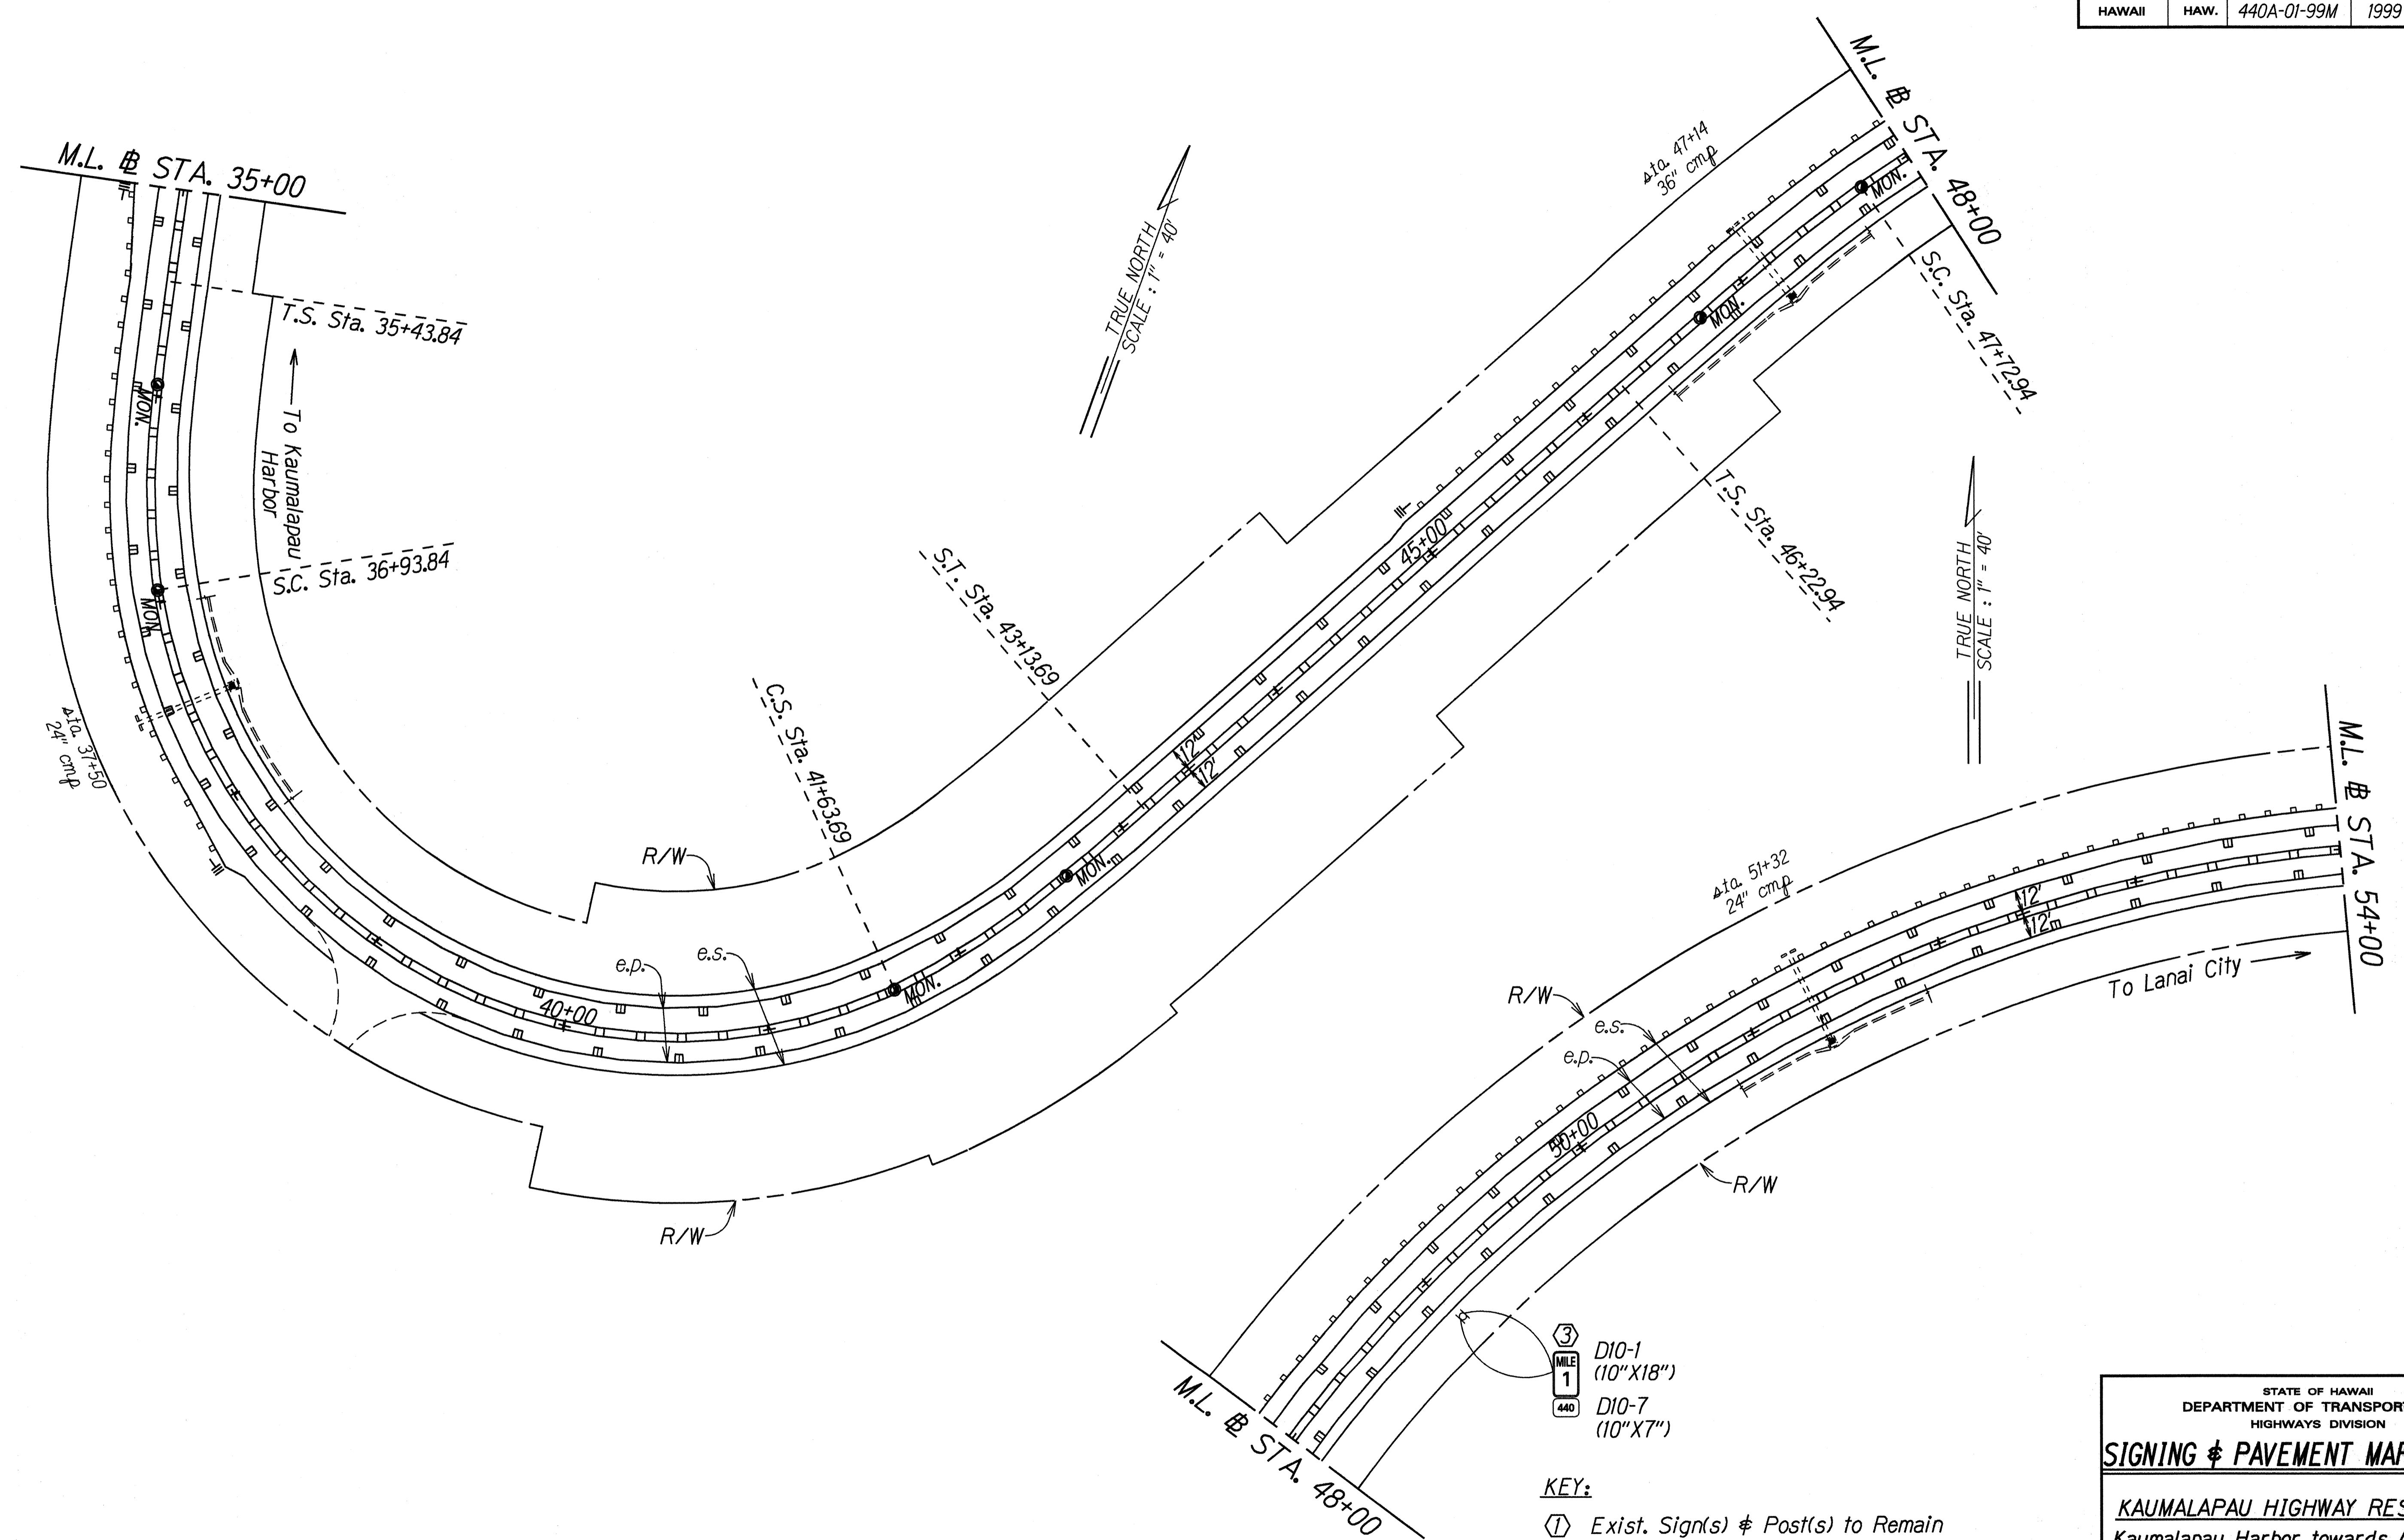

SURVEY PLATTED BY	DATE	10/1/97
DESIGNED BY		
NOTED BY		
QUANTITIES BY		
CHECKED BY		

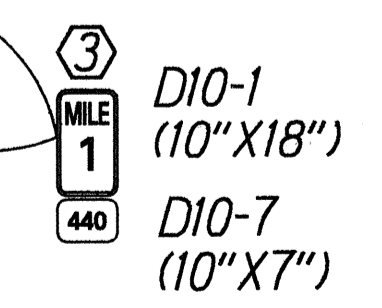

- KEY:**
- ① Exist. Sign(s) & Post(s) to Remain
 - ② Remove Exist. Sign(s) & Post(s)
 - ③ Remove Exist. & Install New Sign(s) & Post(s)
 - ④ Install New Sign(s) & Post(s)

STATE OF HAWAII
DEPARTMENT OF TRANSPORTATION
HIGHWAYS DIVISION


SIGNING & PAVEMENT MARKING PLAN

KAUMALAPAU HIGHWAY RESURFACING
Kaumalapau Harbor towards Airport Road
Project No. 440A-01-99M

Scale: 1" = 40' Date: May, 1999

SHEET No. 3 OF 6 SHEETS

FED. ROAD DIST. NO.	STATE	PROJ. NO.	FISCAL YEAR	SHEET NO.	TOTAL SHEETS
HAWAII	HAW.	440A-01-99M	1999	8	11

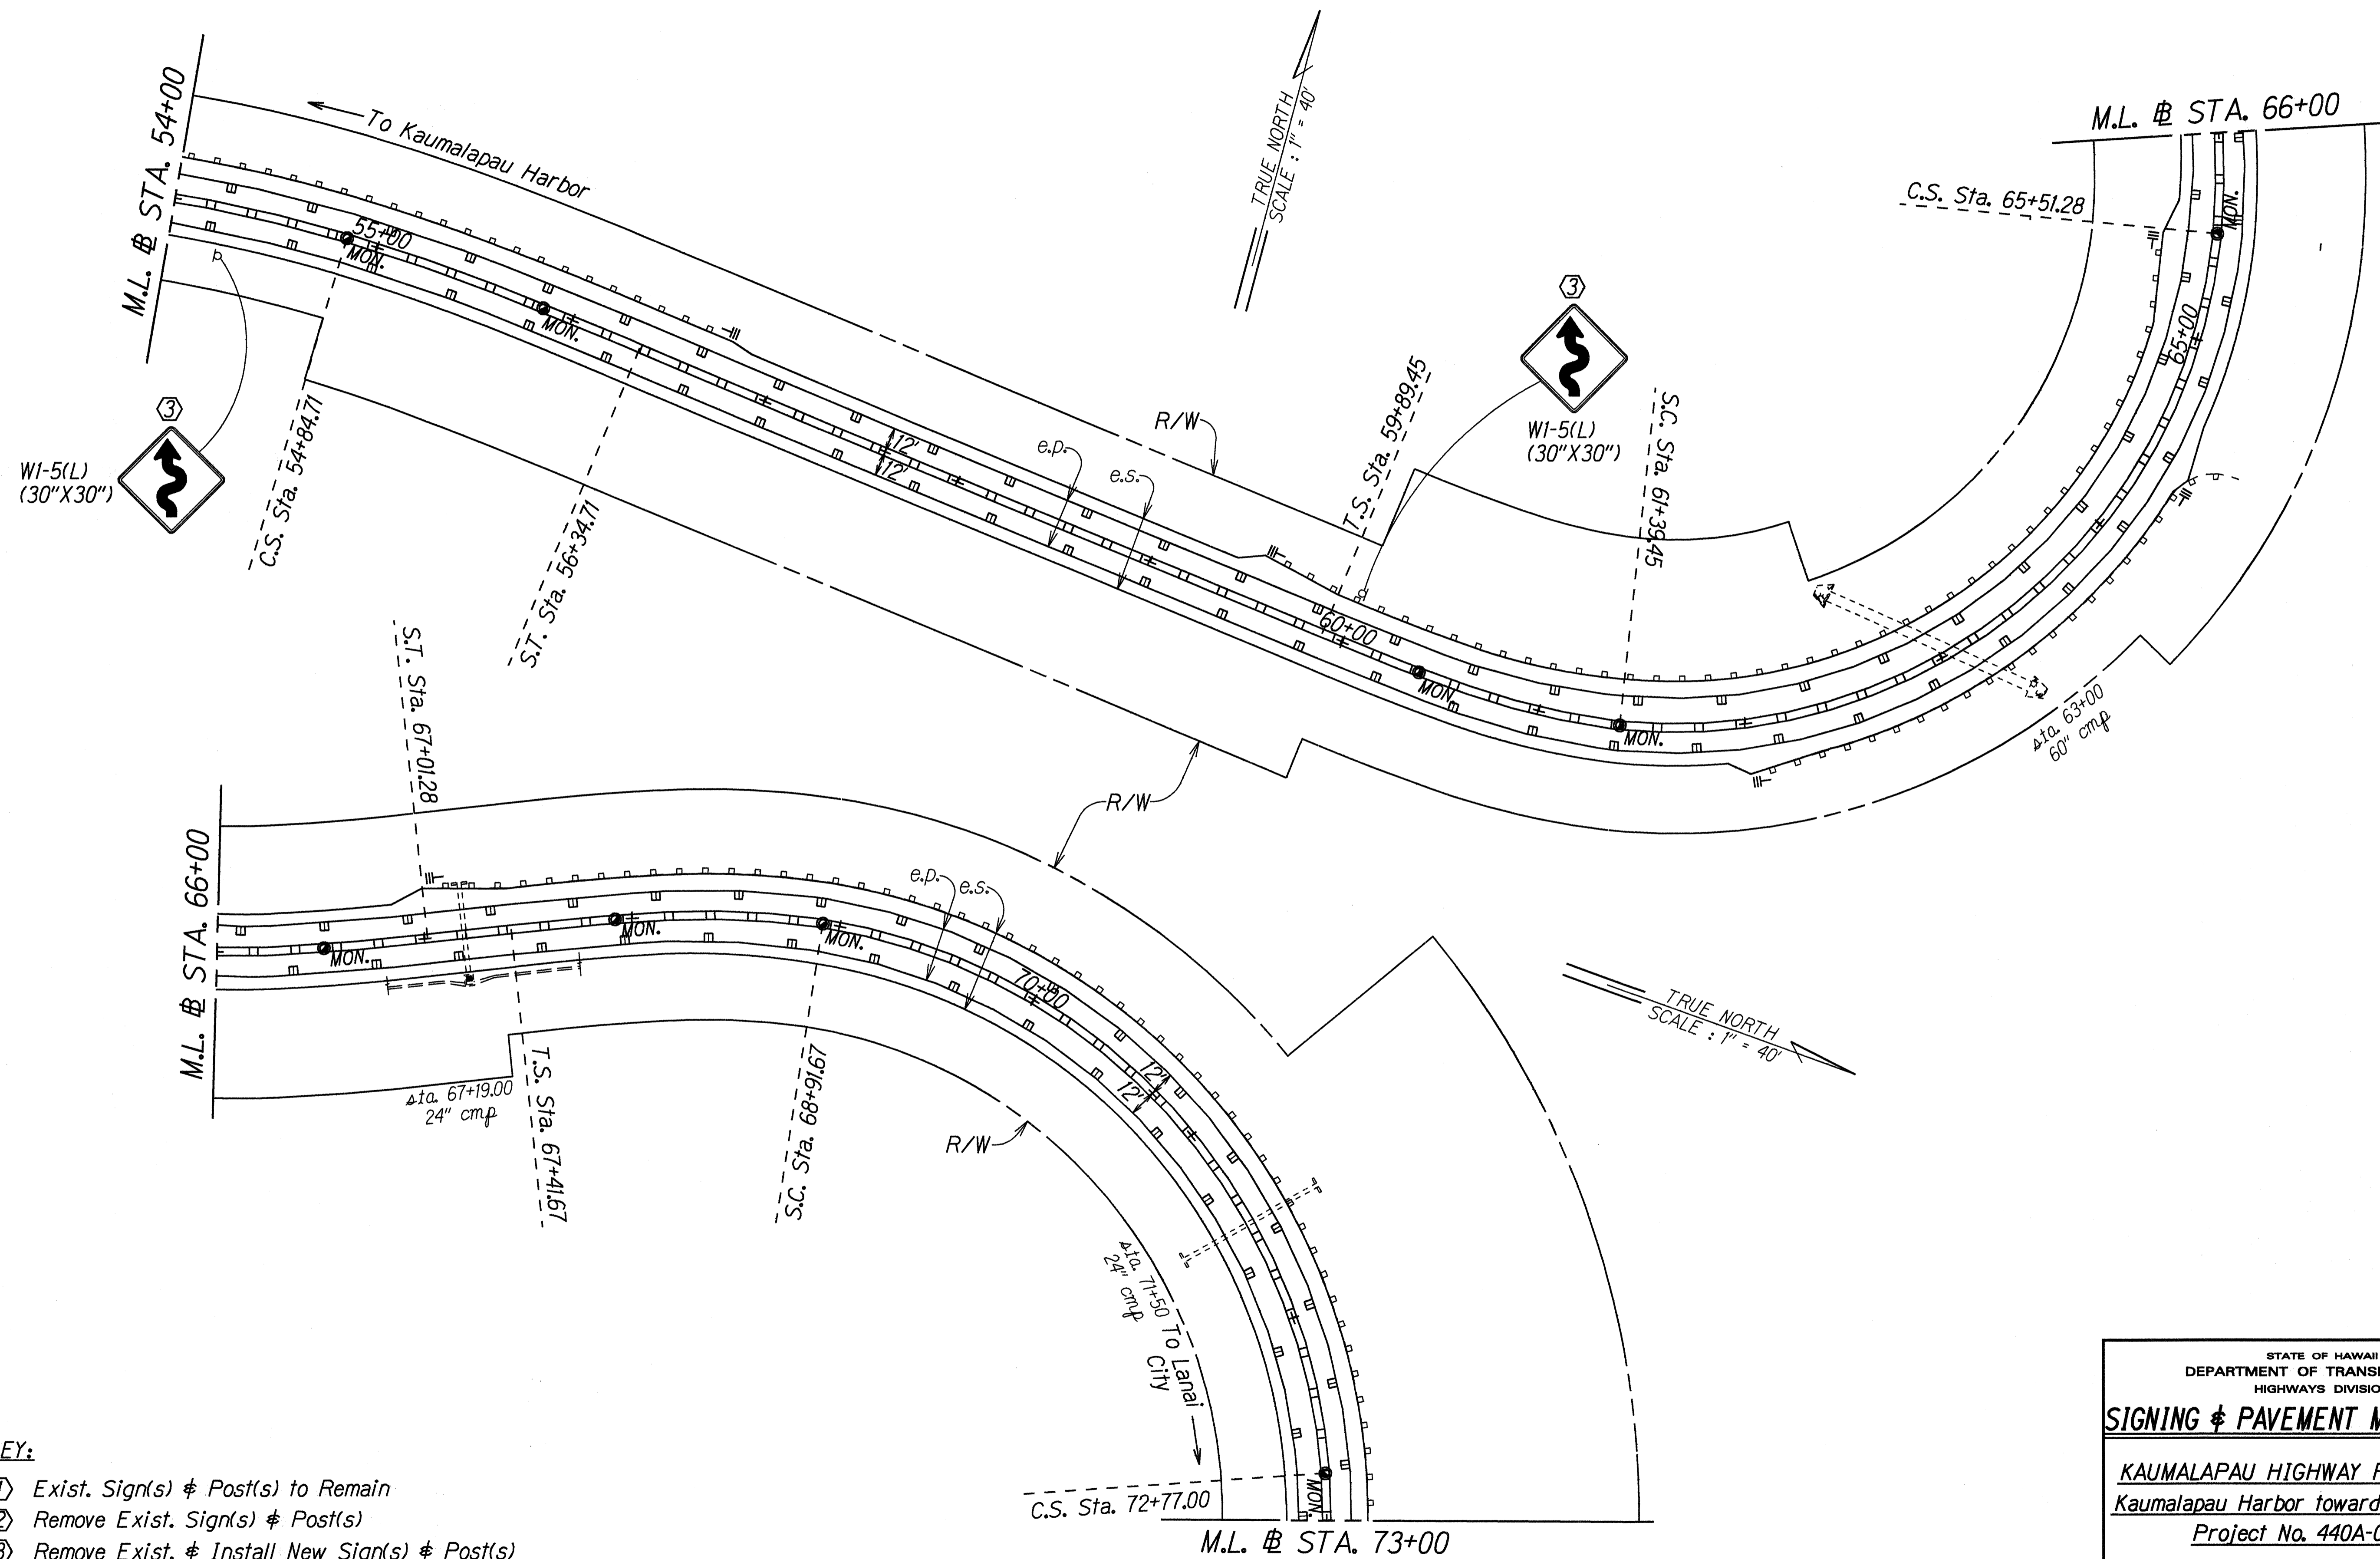

DATE	10/1/99
SURVEY PLOTTED BY	
DESIGNED BY	
CHECKED BY	
NOTED BY	
QUANTITIES BY	
DESIGNED BY	
CHECKED BY	

KEY:

- ① Exist. Sign(s) & Post(s) to Remain
- ② Remove Exist. Sign(s) & Post(s)
- ③ Remove Exist. & Install New Sign(s) & Post(s)
- ④ Install New Sign(s) & Post(s)

STATE OF HAWAII
DEPARTMENT OF TRANSPORTATION
HIGHWAYS DIVISION


SIGNING & PAVEMENT MARKING PLAN

*KAUNALAPAU HIGHWAY RESURFACING
Kaunapau Harbor towards Airport Road
Project No. 440A-01-99M*

Scale: 1" = 40' Date: May, 1999

SHEET No. 4 OF 6 SHEETS

FED. ROAD DIST. NO.	STATE	PROJ. NO.	FISCAL YEAR	SHEET NO.	TOTAL SHEETS
HAWAII	HAW.	440A-01-99M	1999	9	11

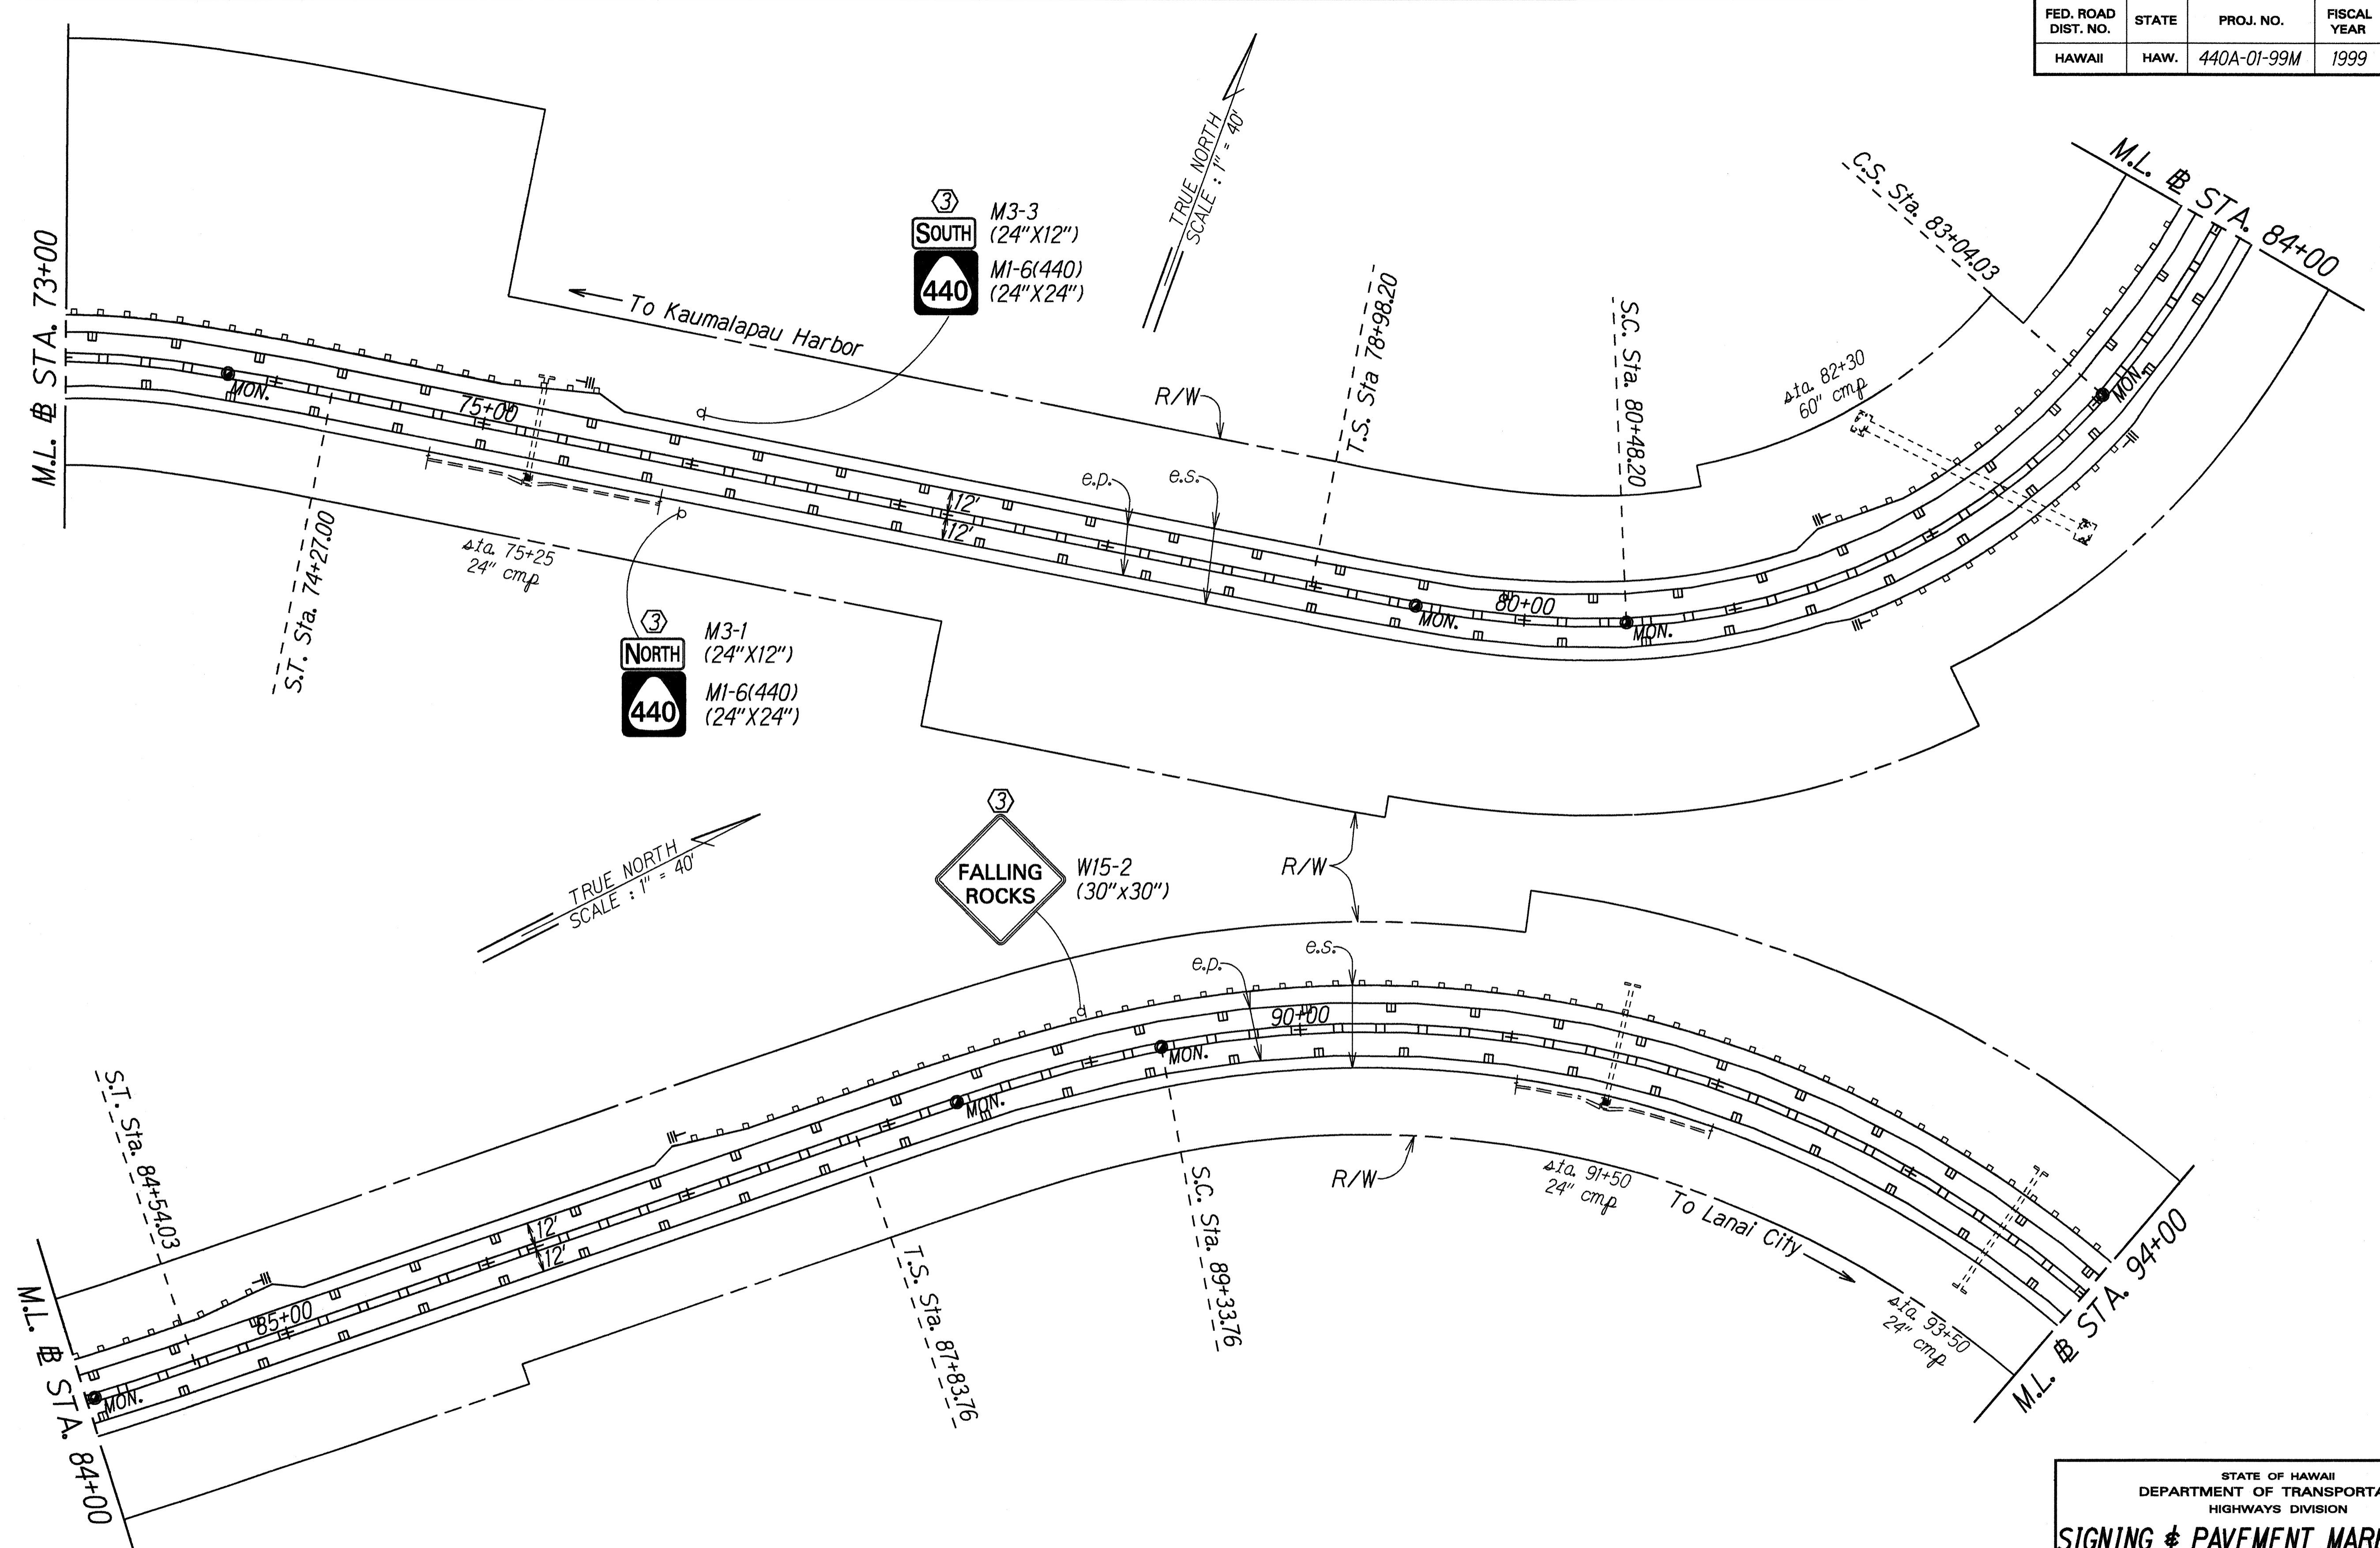

DATE	Mar. 1997
SURVEY PLOTTED BY	
DRAWN BY	JG
DESIGNED BY	CR
QUANTITIES BY	
CHECKED BY	
ORIGINAL PLAN	
NOTE BOOK	
100% OF	
50% OF	
25% OF	

- KEY:**
- ① Exist. Sign(s) & Post(s) to Remain
 - ② Remove Exist. Sign(s) & Post(s)
 - ③ Remove Exist. & Install New Sign(s) & Post(s)
 - ④ Install New Sign(s) & Post(s)

STATE OF HAWAII
DEPARTMENT OF TRANSPORTATION
HIGHWAYS DIVISION



SIGNING & PAVEMENT MARKING PLAN

*KAUMALAPAU HIGHWAY RESURFACING
Kaumalapau Harbor towards Airport Road
Project No. 440A-01-99M*


Scale: 1" = 40' Date: May, 1999

SHEET No. 5 OF 6 SHEETS

FED. ROAD DIST. NO.	STATE	PROJ. NO.	FISCAL YEAR	SHEET NO.	TOTAL SHEETS
HAWAII	HAW.	440A-01-99M	1999	10	11

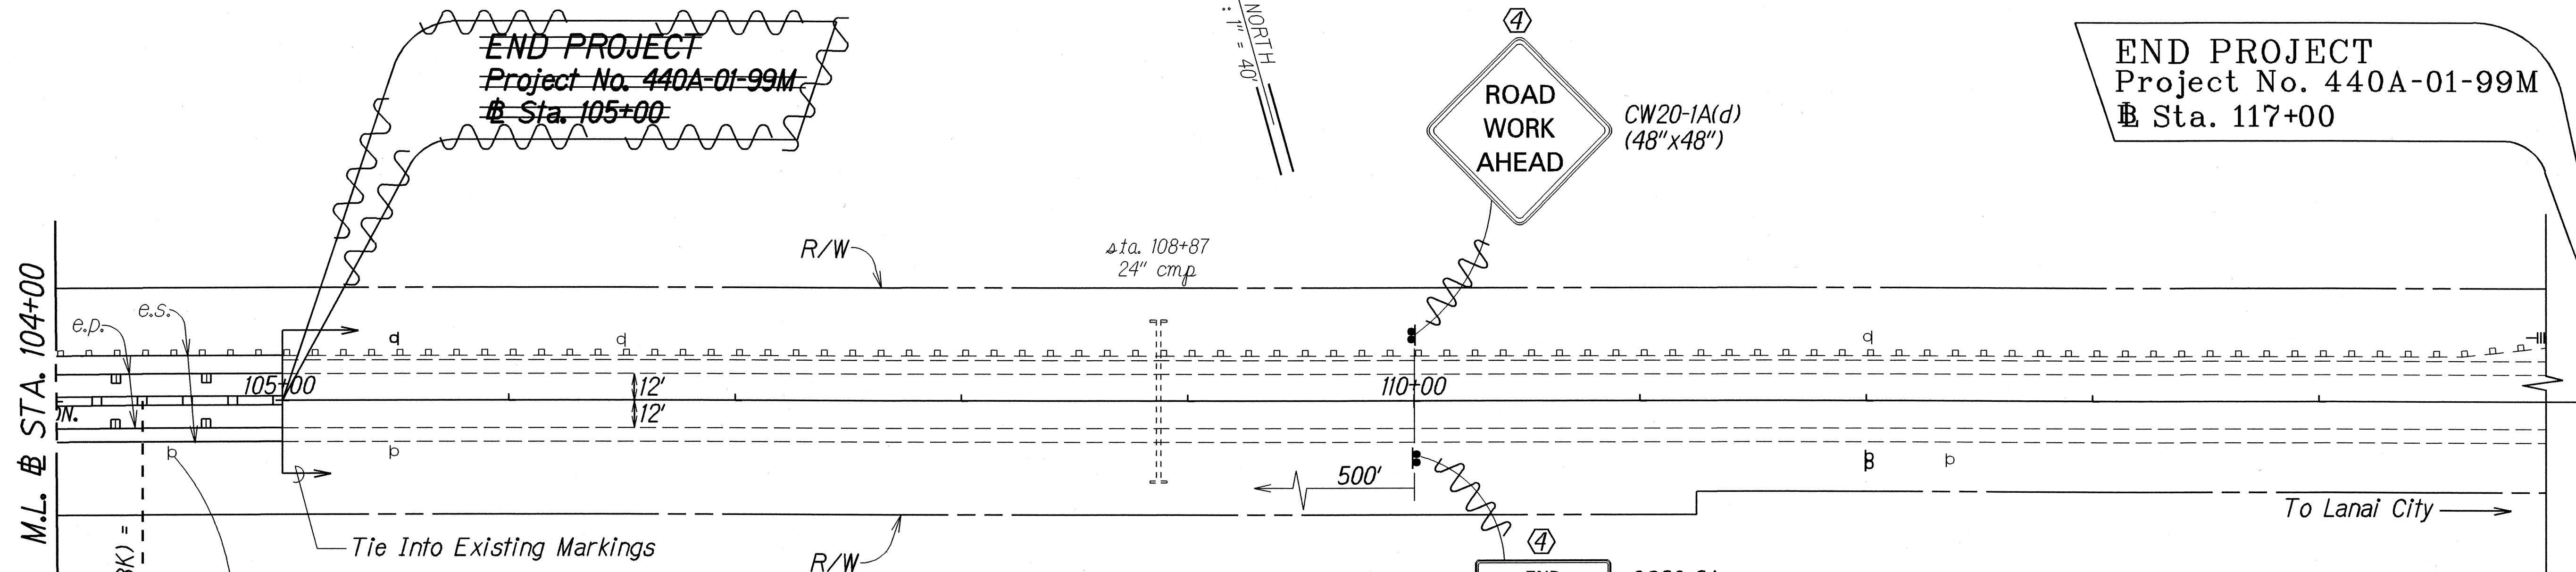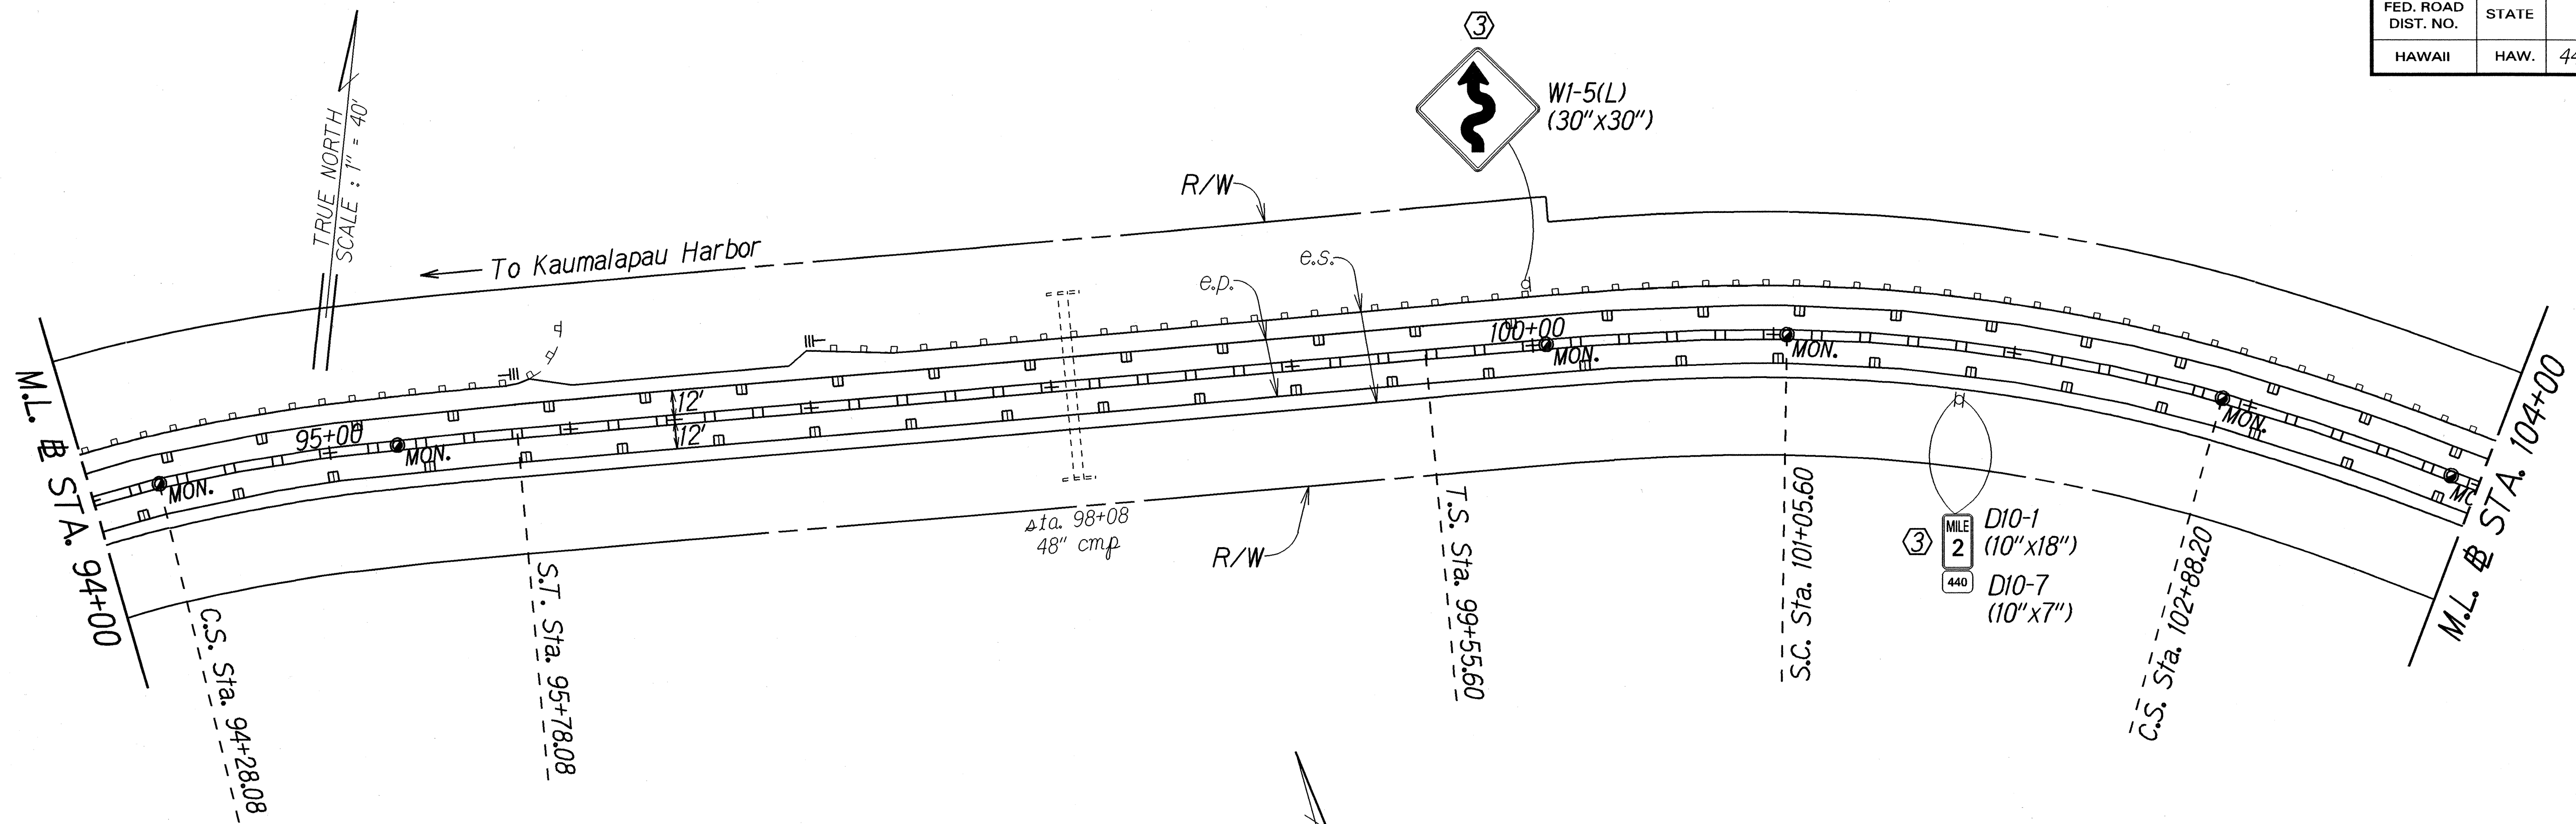

ORIGINAL PLAN	SURVEY PLOTTED BY	DATE
NOTE BOOK	DRAWN BY	10/1/99
QUANTITIES BY	DESIGNED BY	
CHECKED BY		

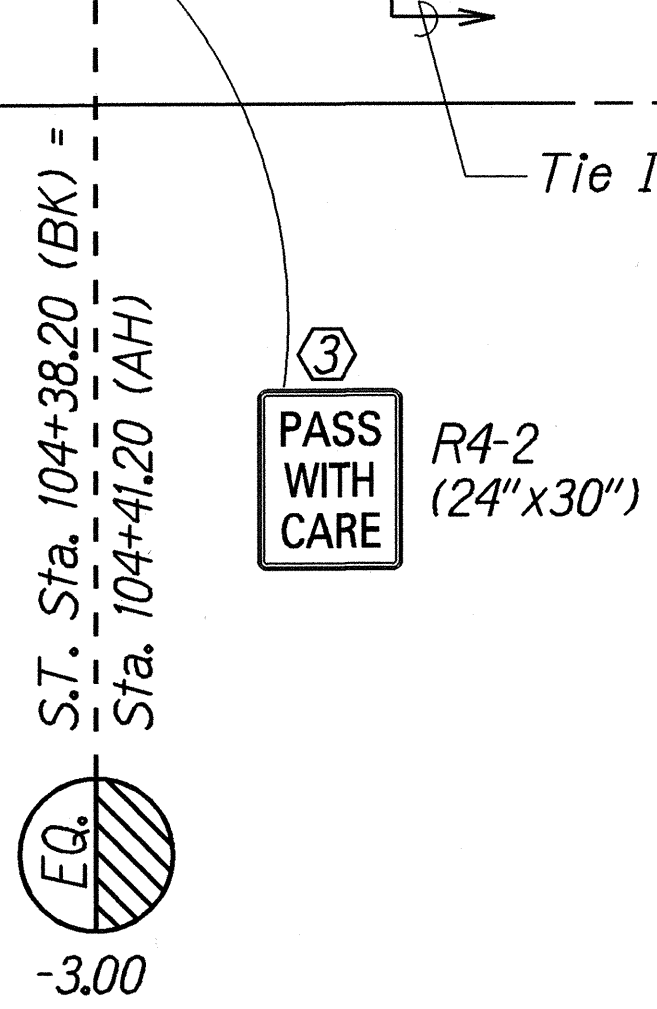

- KEY:**
- ① Exist. Sign(s) & Post(s) to Remain
 - ② Remove Exist. Sign(s) & Post(s)
 - ③ Remove Exist. & Install New Sign(s) & Post(s)
 - ④ Install New Sign(s) & Post(s)

LEGEND FOR AS-BUILT POSTINGS

	Squiggly line for as-built deletion
	Double line for as-built deletion
Roadway	Text for as-built posting

STATE OF HAWAII
DEPARTMENT OF TRANSPORTATION
HIGHWAYS DIVISION

SIGNING & PAVEMENT MARKING PLAN

KAUNALAPAU HIGHWAY RESURFACING
Kaunapala Harbor towards Airport Road
Project No. 440A-01-99M

Scale: 1" = 40' Date: May, 1999

SHEET No. 6 OF 6 SHEETS

"AS-BUILT"