
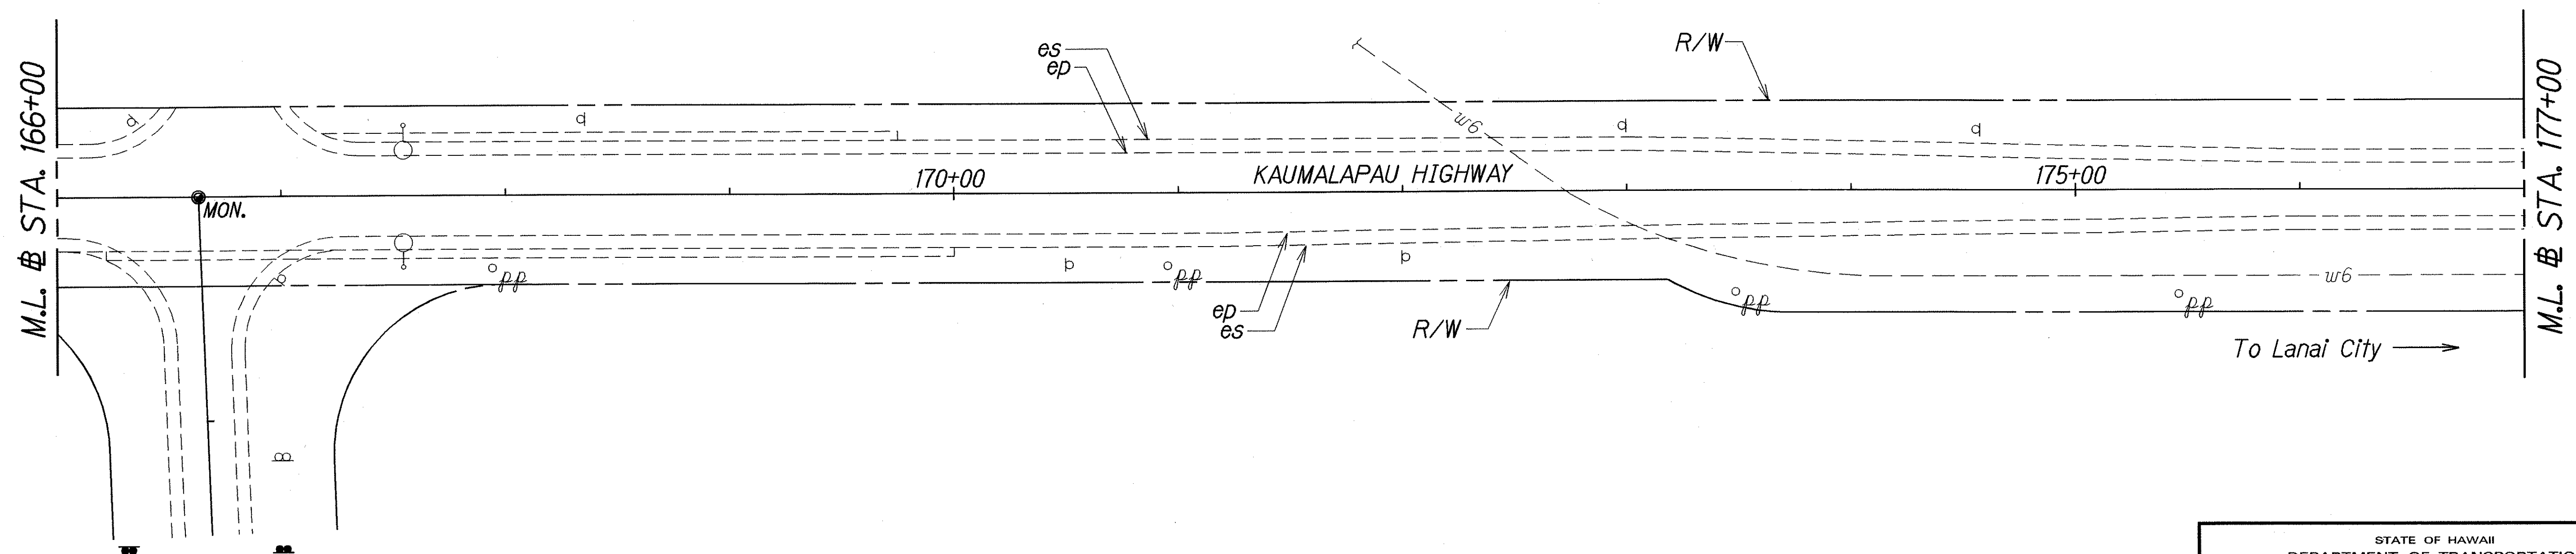


FED. ROAD DIST. NO.	STATE	PROJ. NO.	FISCAL YEAR	SHEET NO.	TOTAL SHEETS
HAWAII	HAW.	440A-01-02M	2002	6	13

BEGIN PROJECT
Project No. 440A-01-02M
@ Sta. 157+00

~~# STA. 158+50+ LT. TO # STA. 161+50+ LT.~~
~~Fill up slope behind guardrail~~
~~See Plan Sheet 3 for detail.~~

~~Approx. Quantities:~~
~~Borrow Excavation = 200 C.Y.~~
~~Hydromulch Seeding = 2,670 Sq. Yd.~~

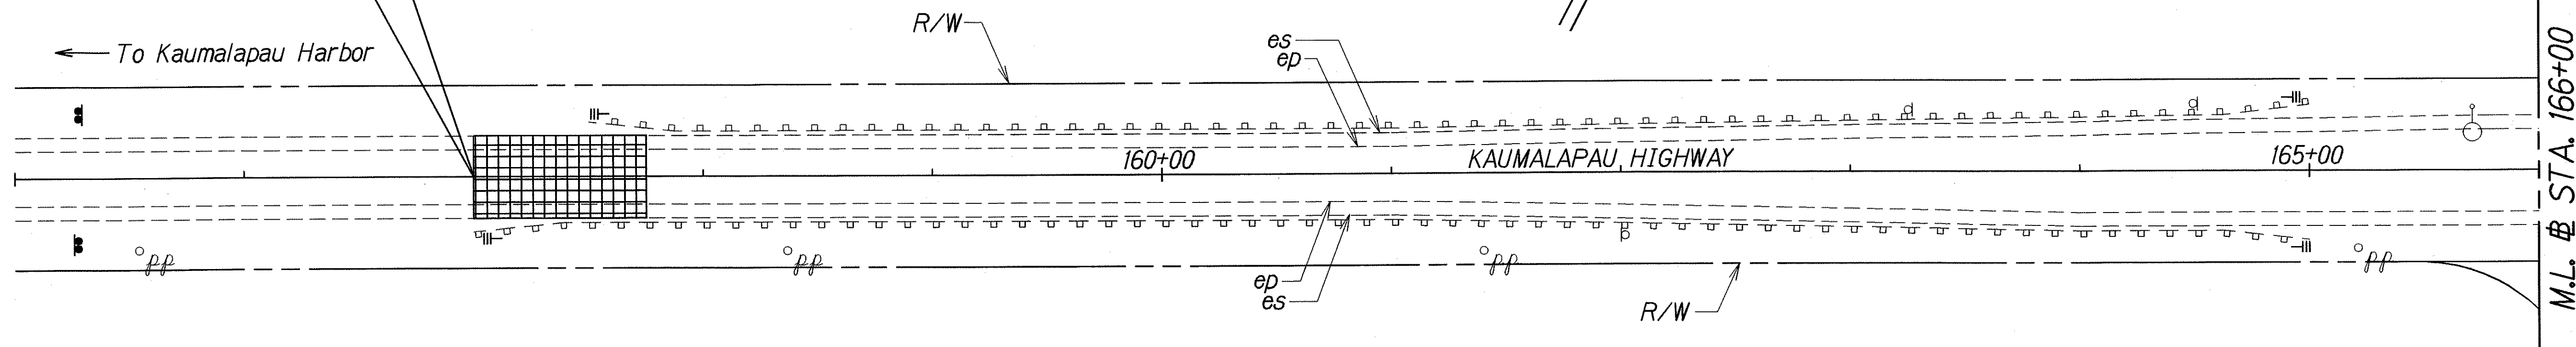

ORIGINAL PLAN	SURVEY PLOTTED BY	DATE
NOTE BOOK	DRAWN BY	Aug. 01
DESIGNED BY	IN CHARGE	
QUANTITIES BY	CHECKED BY	
APPROVED BY		

STATE OF HAWAII
DEPARTMENT OF TRANSPORTATION
HIGHWAYS DIVISION

ROADWAY PLANS


KAUMALAPAU HIGHWAY RESURFACING
Vicinity of Airport Rd. Towards Miki Rd.
Project No. 440A-01-02M

Scale: 1" = 40' Date: August, 2001

SHEET No. 1 OF 3 SHEETS

"AS-BUILT"

FED. ROAD DIST. NO.	STATE	PROJ. NO.	FISCAL YEAR	SHEET NO.	TOTAL SHEETS
HAWAII	HAW.	440A-01-02M	2002	7	13

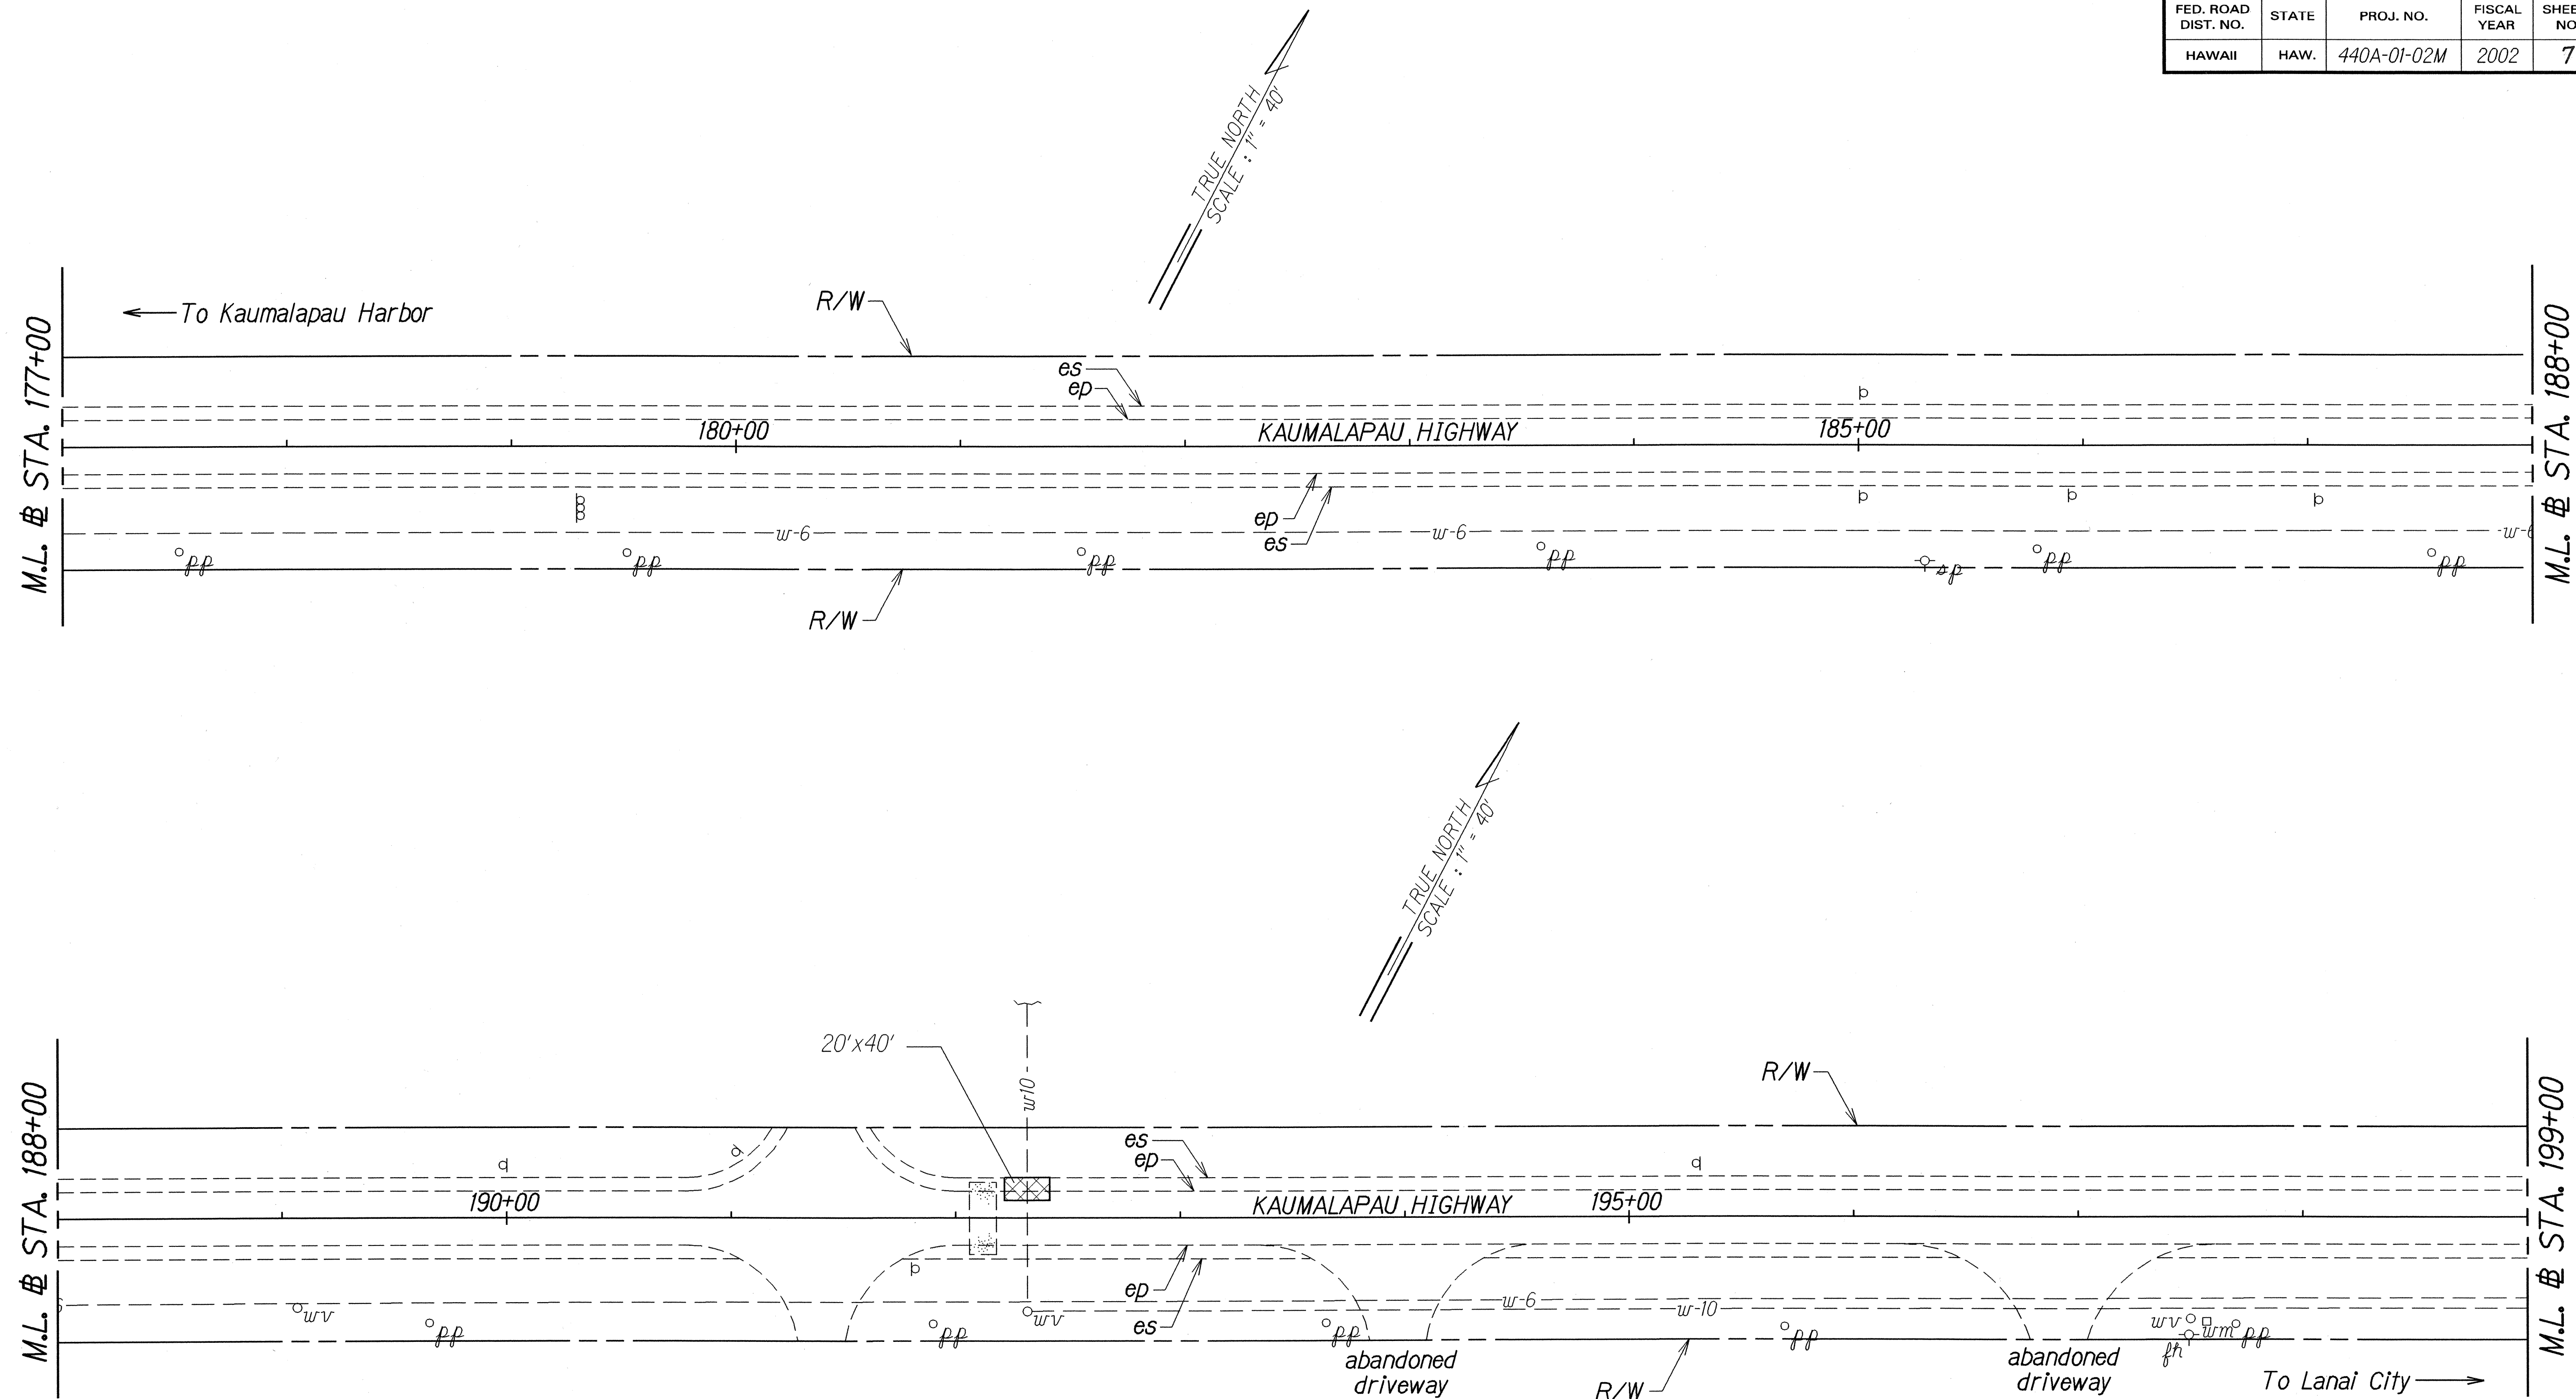

ORIGINAL PLAN	SURVEY PLOTTED BY	DATE
NOTE BOOK	DRAWN BY	2001
DESIGNED BY	CHECKED BY	
CHECKED BY		

STATE OF HAWAII
DEPARTMENT OF TRANSPORTATION
HIGHWAYS DIVISION


ROADWAY PLANS

KAUMALAPAU HIGHWAY RESURFACING
Vicinity of Airport Rd. Towards Miki Rd.
Project No. 440A-01-02M

Scale: 1" = 40' Date: August, 2001

SHEET No. 2 OF 3 SHEETS

FED. ROAD DIST. NO.	STATE	PROJ. NO.	FISCAL YEAR	SHEET NO.	TOTAL SHEETS
HAWAII	HAW.	440A-01-02M	2002	8	13

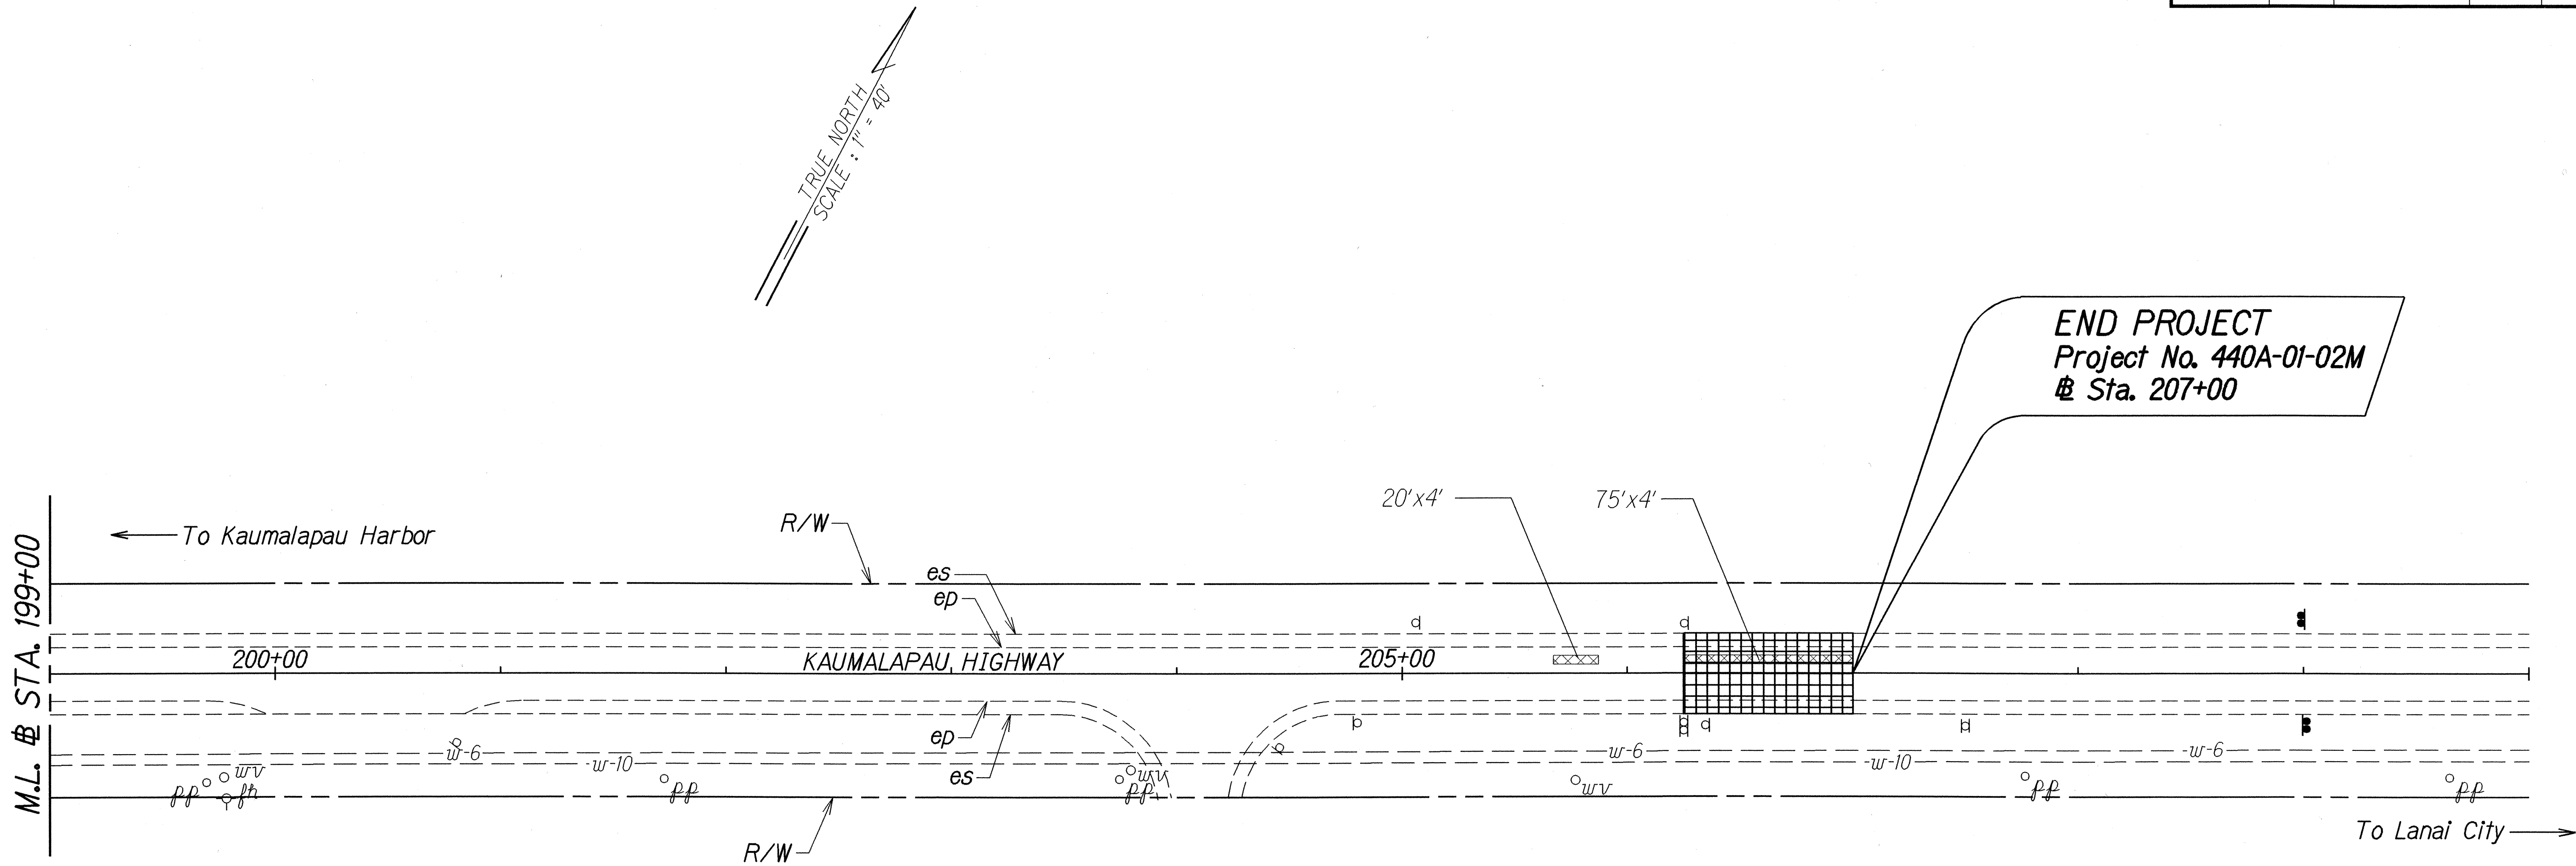

ORIGINAL PLAN	SURVEY PLOTTED BY	DATE
NOTE BOOK	DRAWN BY	10/01/01
DESIGNED BY	TRACED BY	
CHECKED BY	DESIGNED BY	
	CHECKED BY	

STATE OF HAWAII
DEPARTMENT OF TRANSPORTATION
HIGHWAYS DIVISION

ROADWAY PLANS
KAUMALAPAU HIGHWAY RESURFACING
Vicinity of Airport Rd. Towards Miki Rd.
Project No. 440A-01-02M
Scale: 1" = 40' Date: August, 2001
SHEET No. 3 OF 3 SHEETS