	INDEX TO DRAWINGS
SHEET NO.	DESCRIPTION
1	TITLE SHEET
2	STANDARD PLANS SUMMARY
3	GENERAL NOTES, LEGEND
	AND TYPICAL SECTIONS
4 – 5	WATER POLLUTION AND EROSION
	CONTROL NOTES
6 – 8	ROADWAY PLANS
9	PAVEMENT MARKING LEGEND,
	DETAILS AND NOTES
10 – 12	PAVEMENT MARKING AND
	SIGNING PLANS
13	MISCELLANEOUS SUMMARIES
	·

STATE OF HAWAII

DEPARTMENT OF TRANSPORTATION


DIVISION HIGHWAYS HONOLULU, HAWAII "AS-BULT"

PLANS FOR

KAUMALAPAU HIGHWAY RESURFACING


VICINITY OF AIRPORT ROAD TOWARDS MIKI ROAD PROJECT NO. 440A-01-02M


> DISTRICT OF LANAI ISLAND OF LANAI

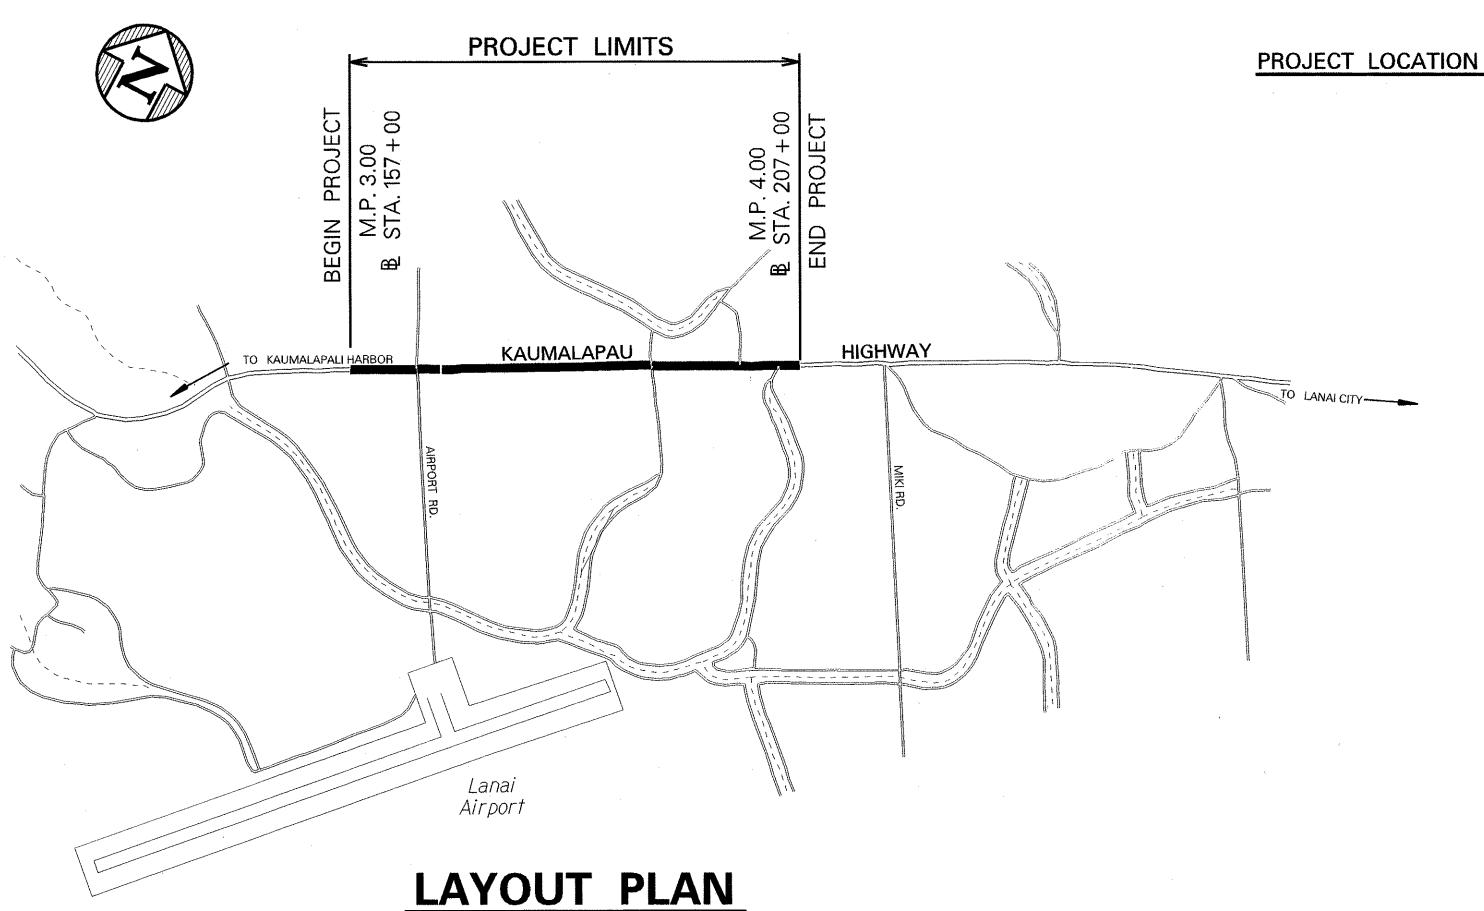

FED. ROAD DIST. NO. FISCAL SHEET YEAR NO. PROJ. NO. SHEETS 440A-01-02M 13



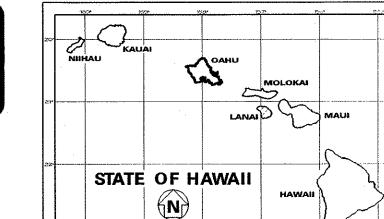

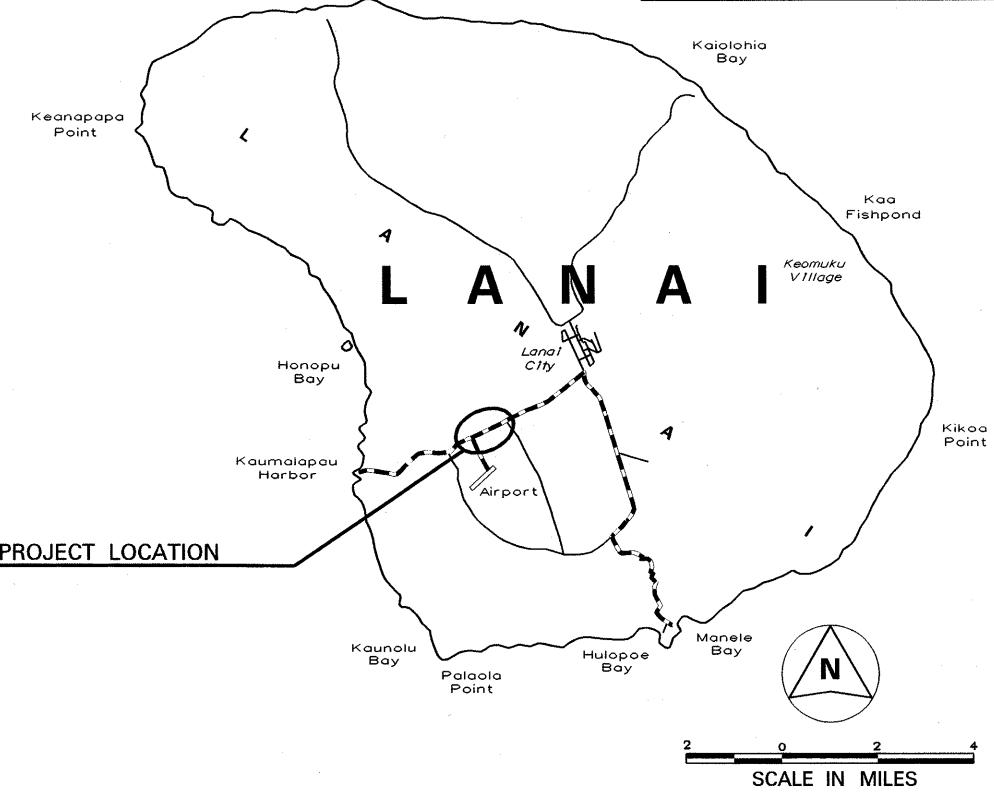

Pohakuloa Point

FEDERAL AID PROJECTS PREVIOUSLY CONSTRUCTED OR UNDER CONSTRUCTION

MILE POST 3.00 TO MILE POST 4.00

NO SIGNIFICANT CHANGES WERE MADE DURING CONSTRUCTION ON THE HEAVIS EXCEPT CHANGES IN THE ORIGINAL THEORETICAL QUANTITIES. FUR ACTUAL QUANTITIES, REFER TO PROJECT LEGISLANDOR COMPUTATION SOOK.

DEPARTMENT OF TRANSPORTATION STATE OF HAWAII APPROVED:

ADIR. OF TRANSPORTATION

10-01-01 DATE

GROSS LENGTH OF PROJECT.....1.0 MILES NET LENGTH OF PROJECT.....1.0 MILES