


FED. ROAD DIST. NO.	STATE	PROJ. NO.	FISCAL YEAR	SHEET NO.	TOTAL SHEETS
HAWAII	HAW.	440A-01-07M	2007	7	14

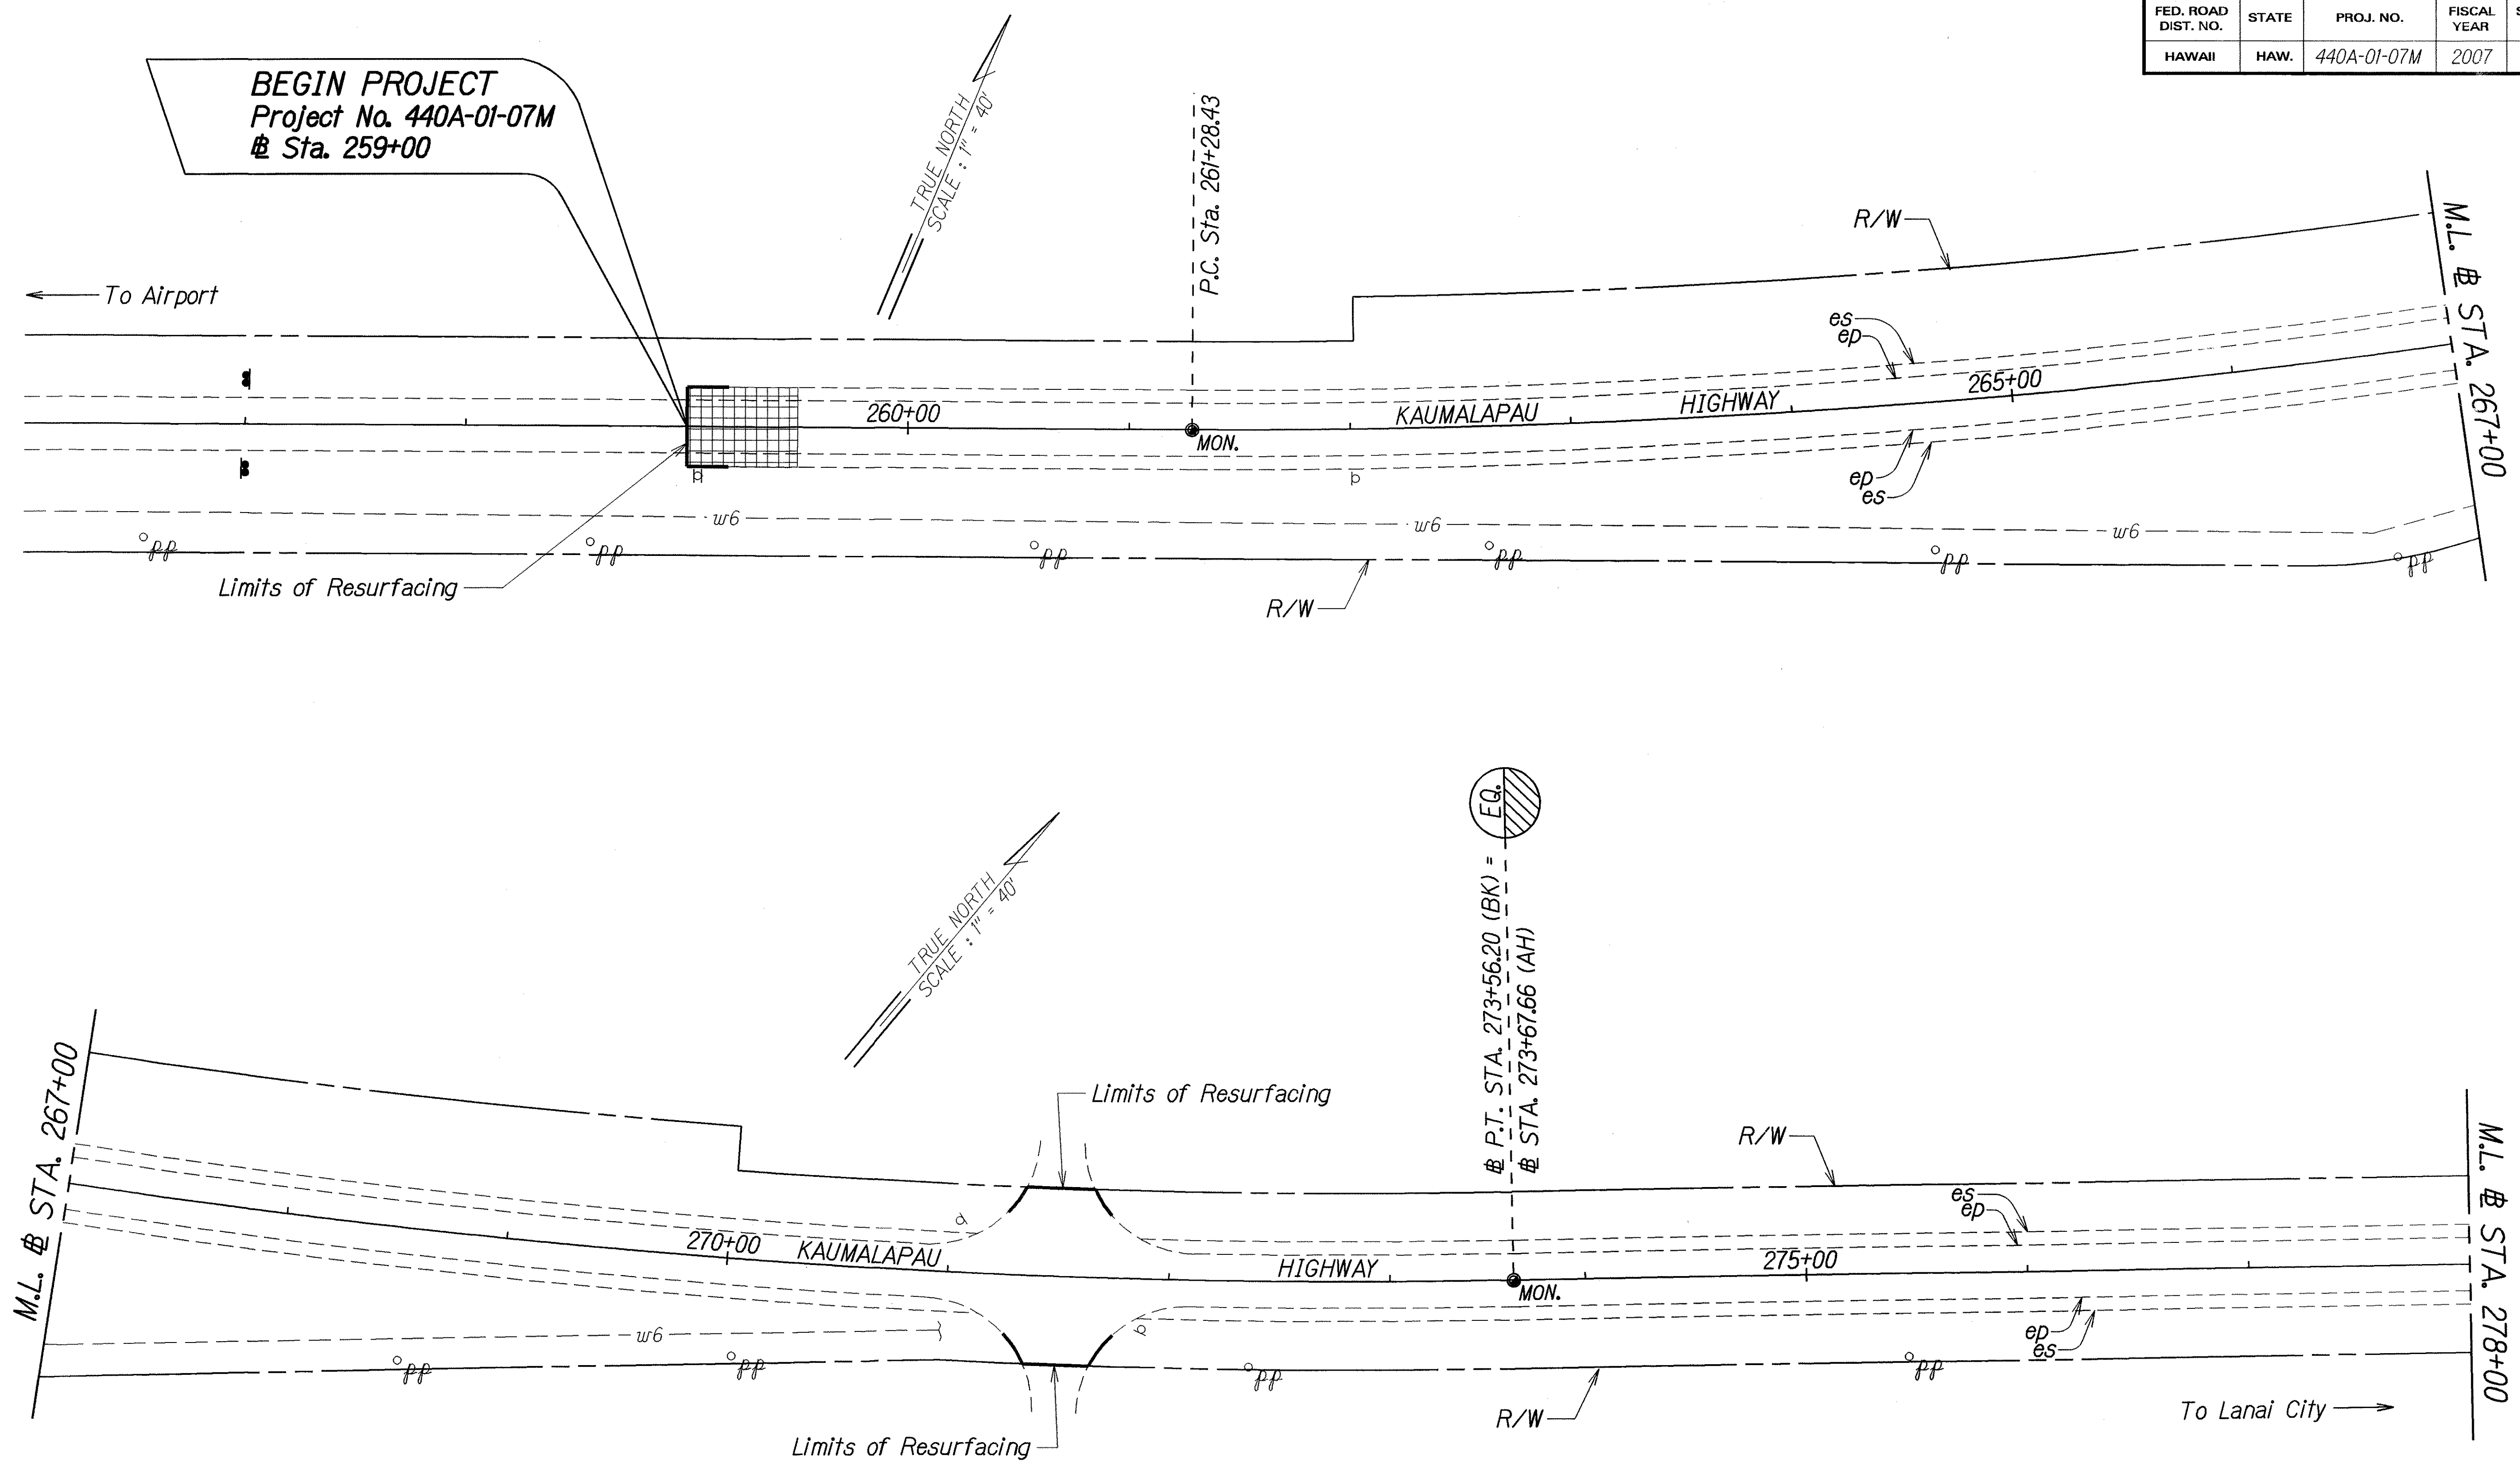

ORIGINAL PLAN	SURVEY PLOTTED BY	DATE
NOTE BOOK	DRAWN BY	1/07
DESIGNED BY	TRACED BY	
CHECKED BY	DESIGNED BY	
	CHECKED BY	

STATE OF HAWAII
DEPARTMENT OF TRANSPORTATION
HIGHWAYS DIVISION



ROADWAY PLAN

KAUMALAPAU HIGHWAY RESURFACING
M.P. 5.0 to End of Lanai City Spur
Project No. 440A-01-07M

Scale: 1" = 40' Date: January, 2007

SHEET No. 1 OF 3 SHEETS

FED. ROAD DIST. NO.	STATE	PROJ. NO.	FISCAL YEAR	SHEET NO.	TOTAL SHEETS
HAWAII	HAW.	440A-01-07M	2007	8	14

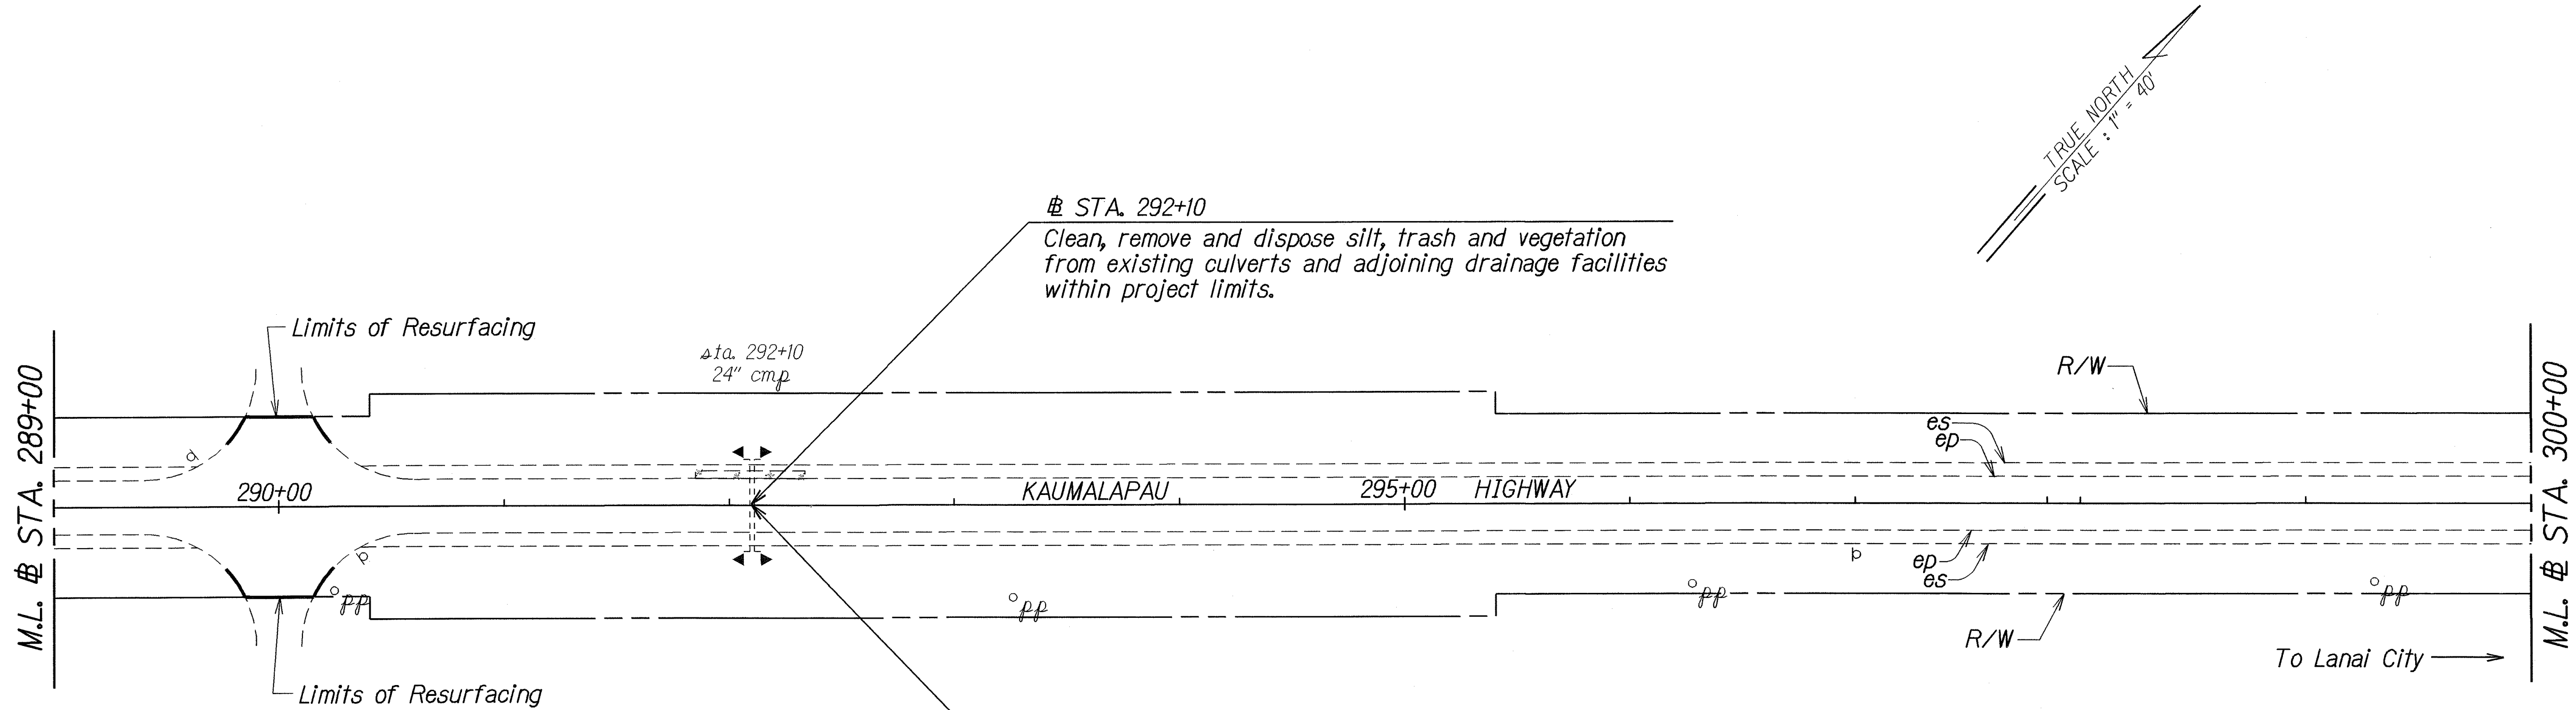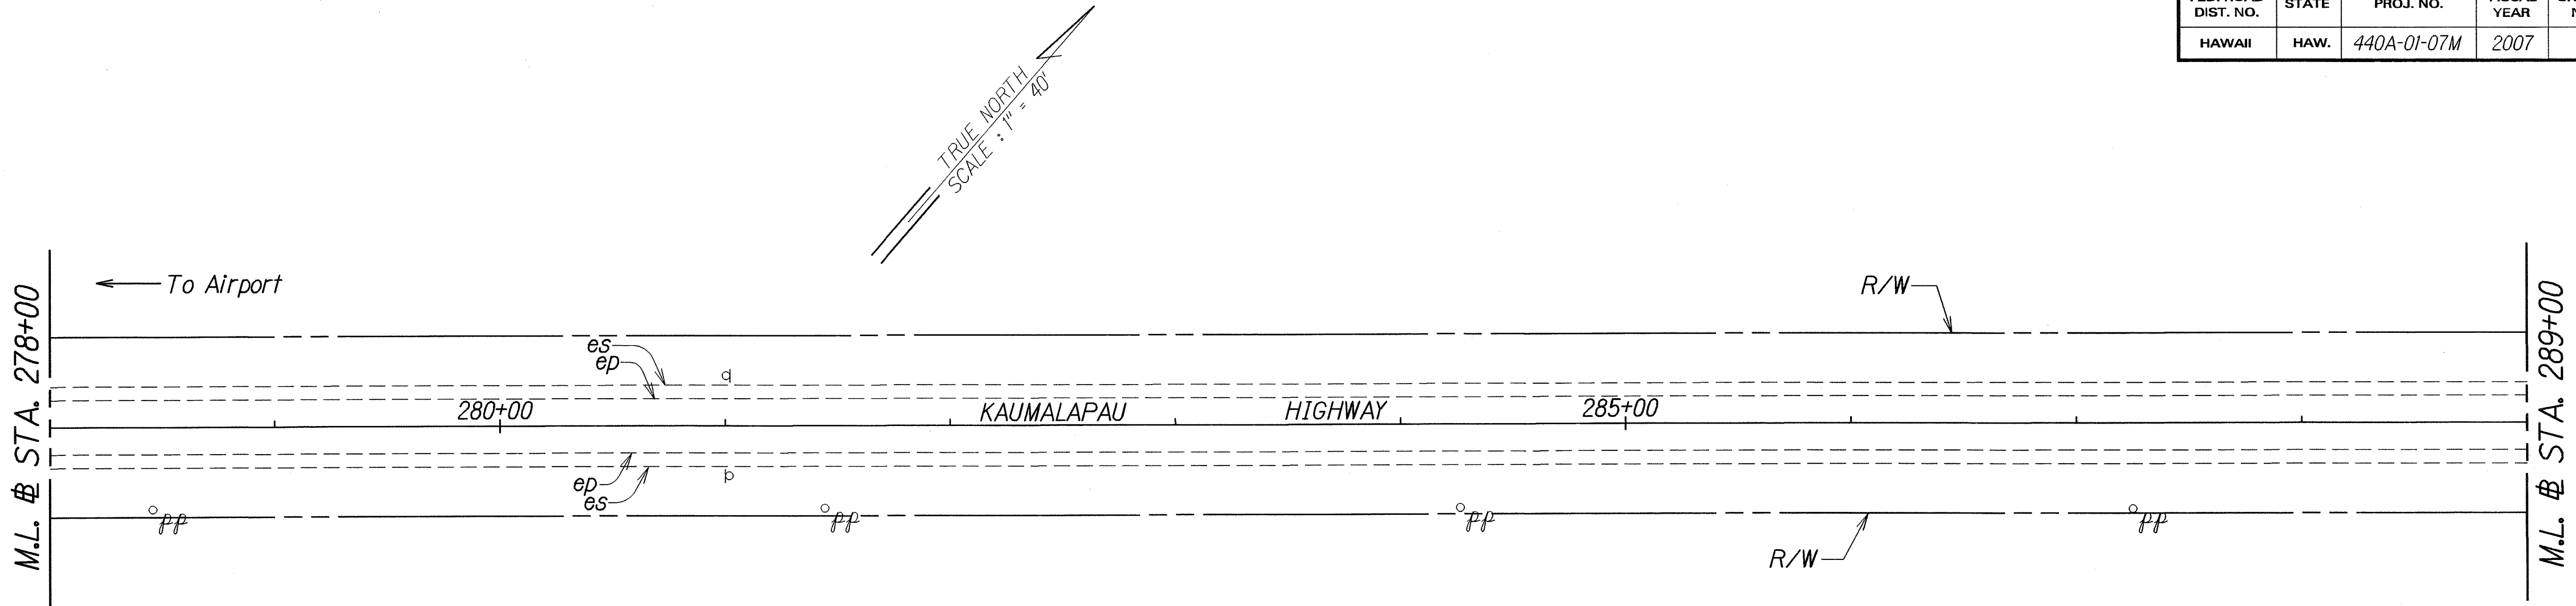

ORIGINAL PLAN	SURVEY PLOTTED BY	DATE
NOVE BOOK	DRAWN BY	1/07
BY	TRACED BY	
BY	QUANTITIES BY	
BY	CHECKED BY	

LEGEND FOR AS-BUILT POSTINGS	
	Squiggly line for as-built deletion
	Double line for as-built deletion
Roadway	Text for as-built posting

STATE OF HAWAII
DEPARTMENT OF TRANSPORTATION
HIGHWAYS DIVISION

ROADWAY PLAN

KAUMALAPAU HIGHWAY RESURFACING


M.P. 5.0 to End of Lanai City Spur

Project No. 440A-01-07M


Scale: 1" = 40' Date: January, 2007

SHEET No. 2 OF 3 SHEETS

FED. ROAD DIST. NO.	STATE	PROJ. NO.	FISCAL YEAR	SHEET NO.	TOTAL SHEETS
HAWAII	HAW.	440A-01-07M	2007	9	14

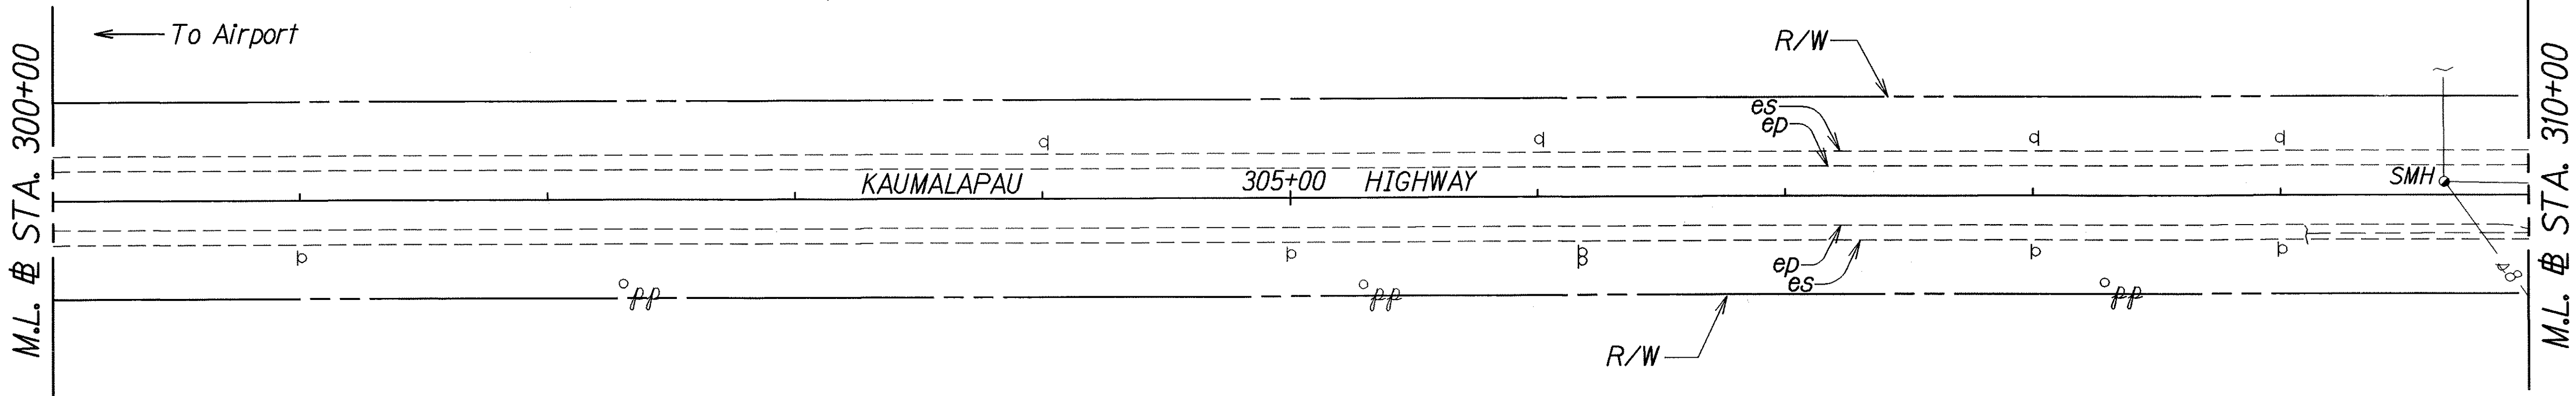

END PROJECT
Project No. 440A-01-07M
Sta. 312+24

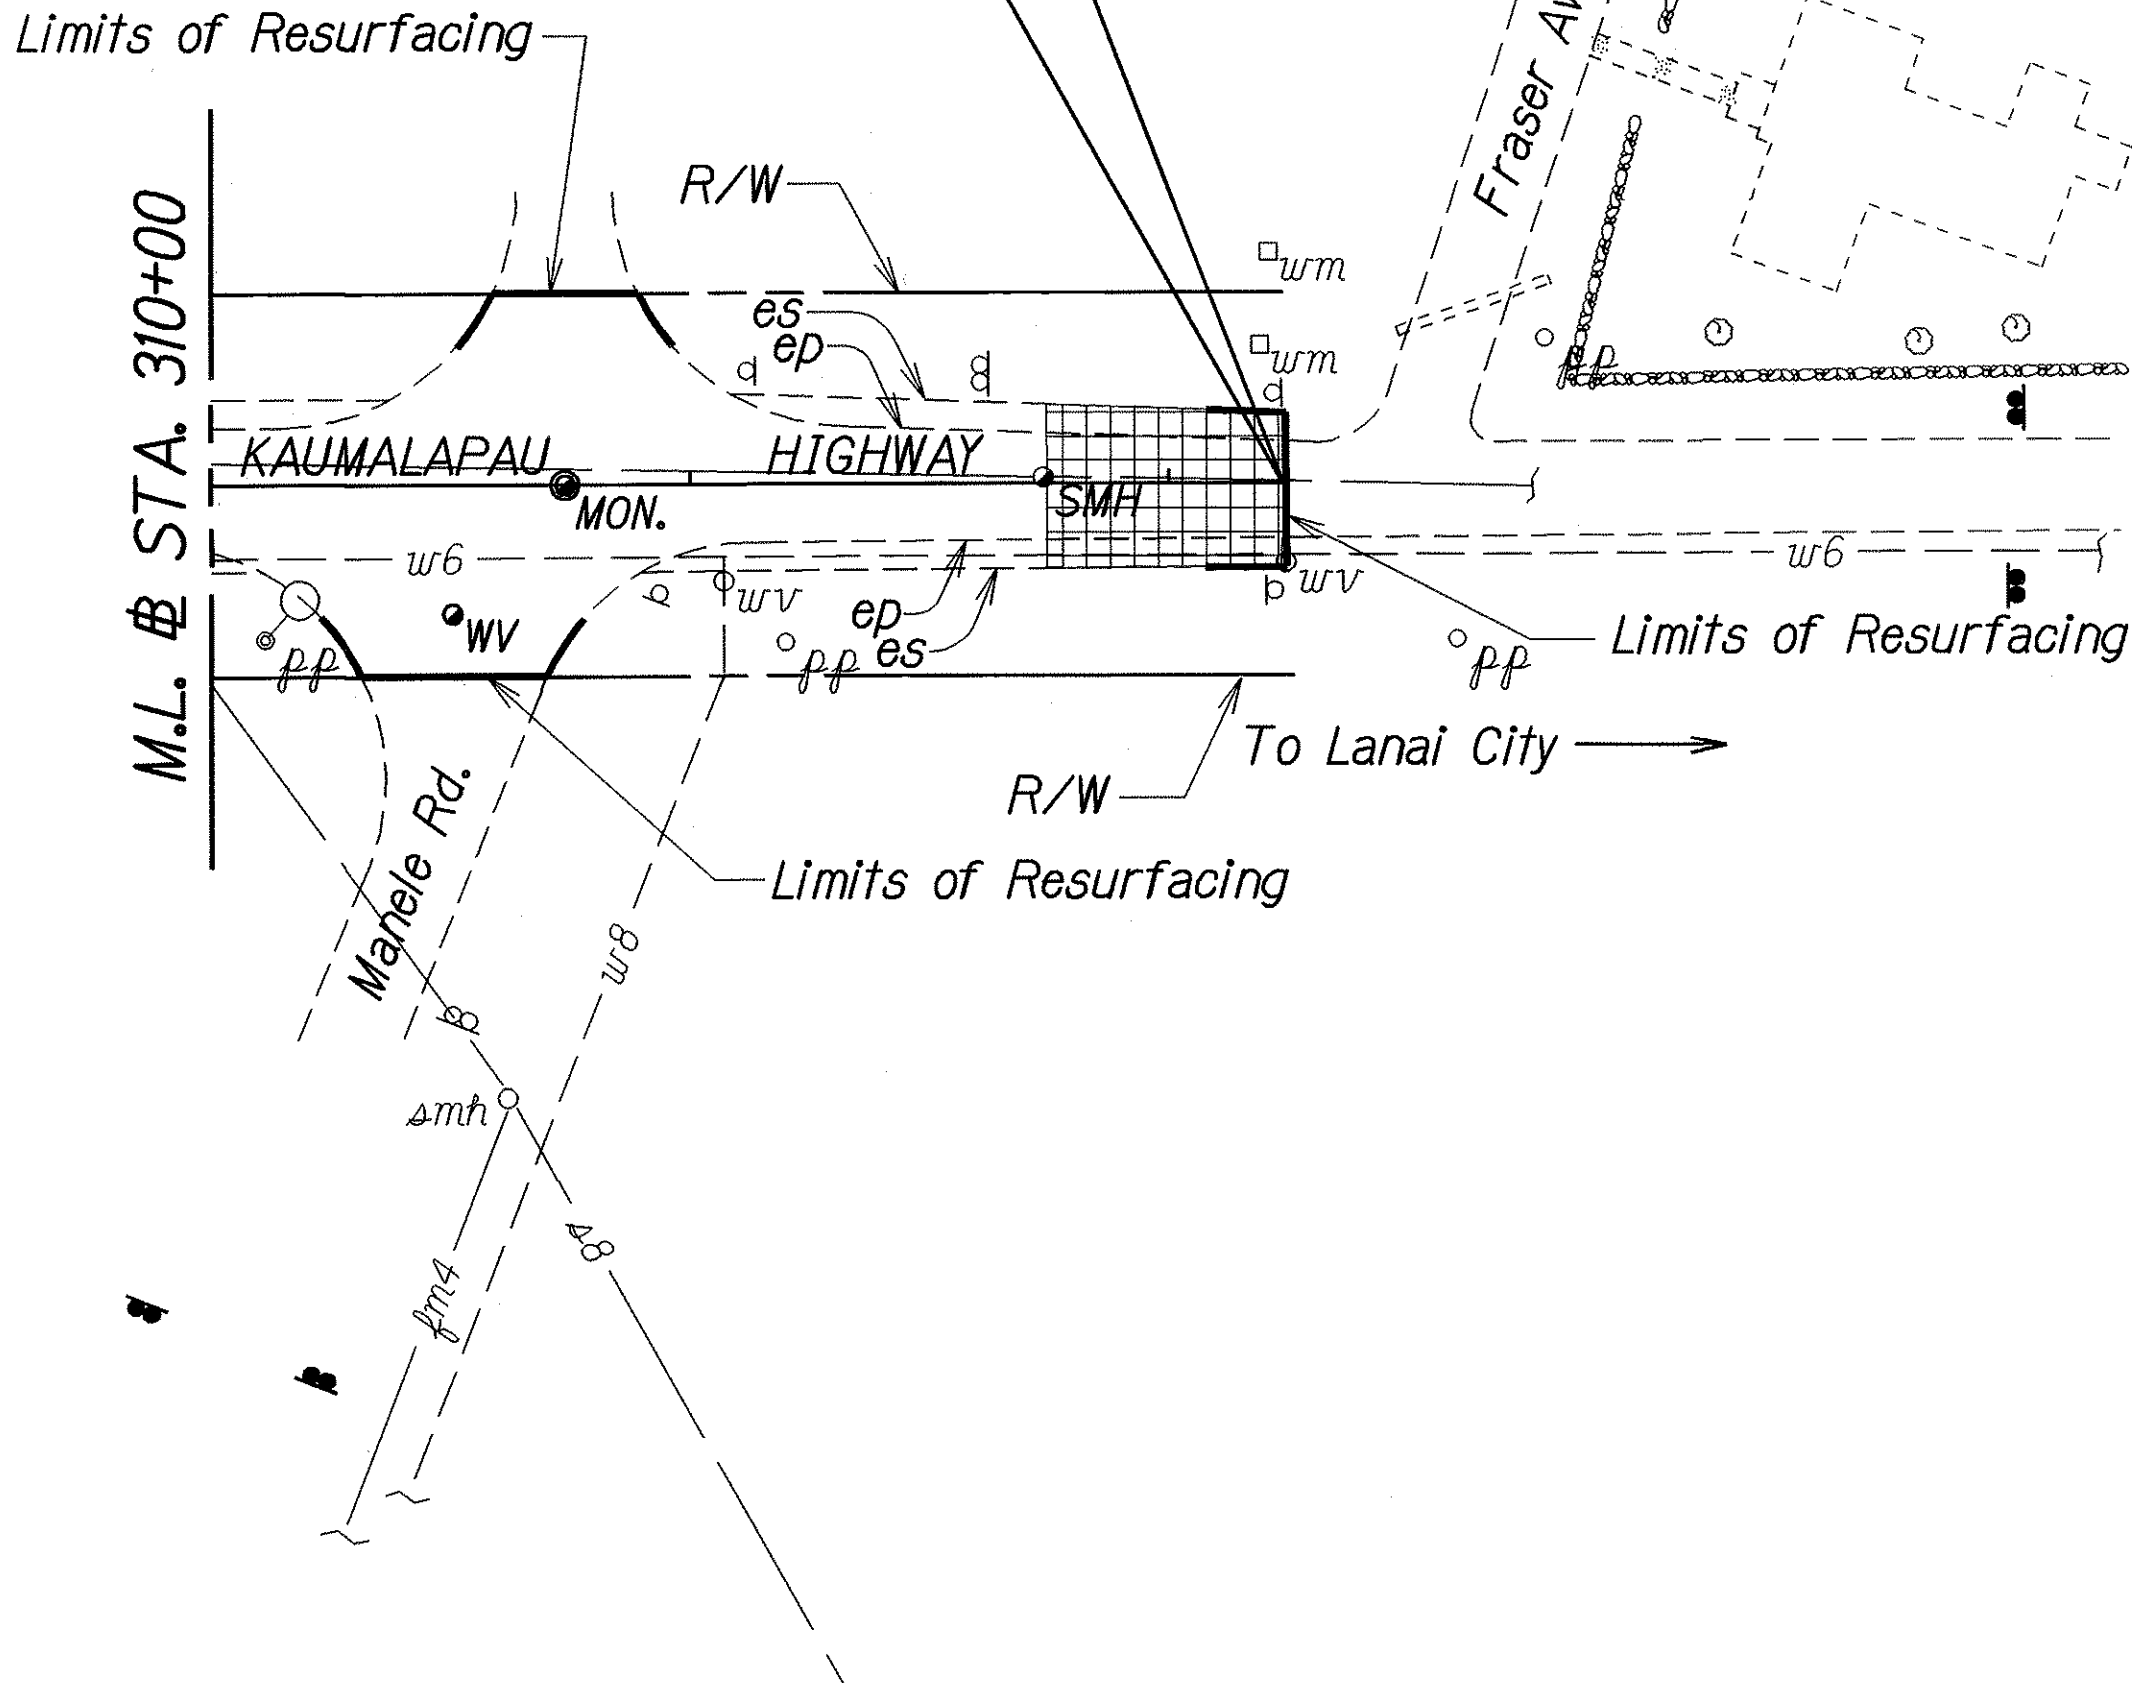

ORIGINAL PLAN	SURVEY PLOTTED BY _____	DATE <u>1-67</u>
NOTE BOOK	DRAWN BY <u>JP</u>	_____
<u>mel, Jay</u>	TRACED BY _____	_____
<u>96mpm32dgn</u>	DESIGNED BY <u>LS</u>	_____
N_____	QUANTITIES BY _____	_____
	CHECKED BY _____	_____

STATE OF HAWAII
DEPARTMENT OF TRANSPORTATION
HIGHWAYS DIVISION

ROADWAY PLAN

KAUMALAPAU HIGHWAY RESURFACING
M.P. 5.0 to End of Lanai City Spur
Project No. 440A-01-07M

Scale: 1" = 40' Date: January, 2007