


FED. ROAD DIST. NO.	STATE	PROJ. NO.	FISCAL YEAR	SHEET NO.	TOTAL SHEETS
HAWAII	HAW.	440A-01-07M	2007	11	14

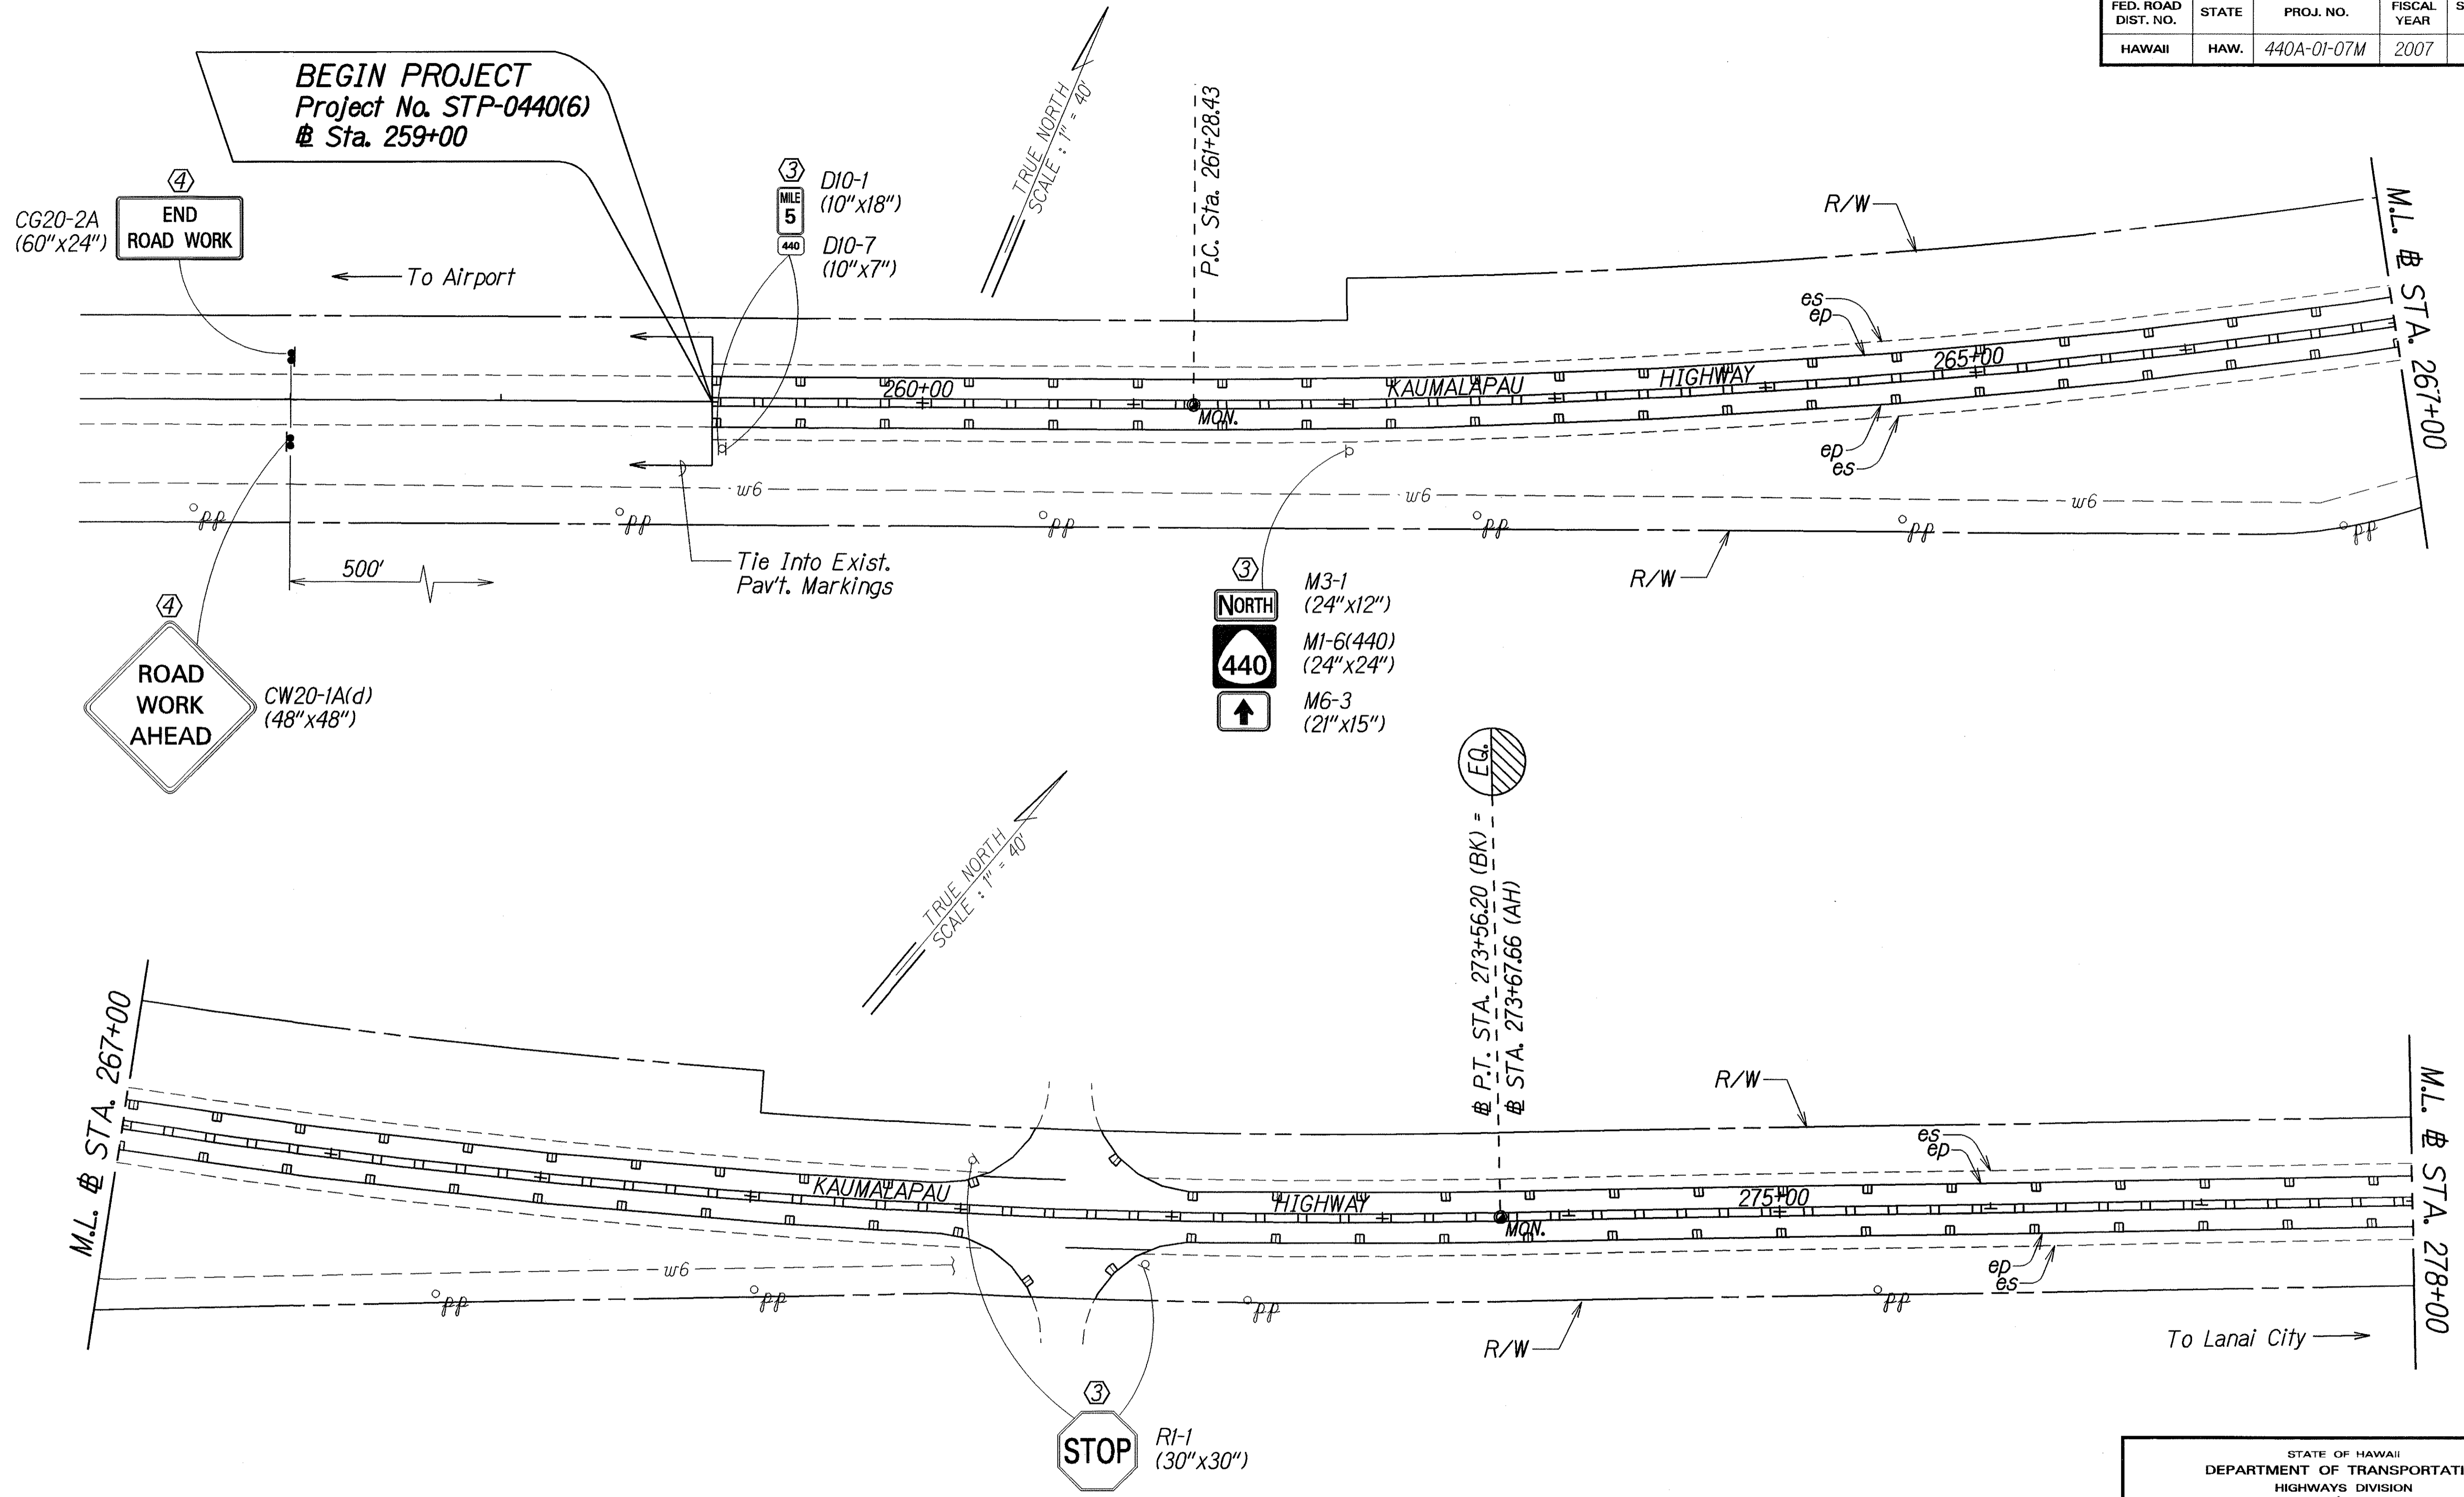

SURVEY PLOTTED BY	DATE
DRAWN BY	EGZ
FRACED BY	
QUANTITIES BY	
CHECKED BY	
ORIGINAL PLAN	
NOTE BOOK	
DATE	
CHECKED BY	

- KEY:**
- ① Exist. Sign(s) & Post(s) to Remain
 - ② Remove Exist. Sign(s) & Post(s)
 - ③ Remove Exist. & Install New Sign(s) & Post(s)
 - ④ Install New Sign(s) & Post(s)

STATE OF HAWAII
DEPARTMENT OF TRANSPORTATION
HIGHWAYS DIVISION


**SIGNING & PAVEMENT
MARKING PLAN**

KAUMALAPAU HIGHWAY RESURFACING
M.P. 5.0 to End of Lanai City Spur
Project No. 440A-01-07M

Scale: 1" = 40' Date: January, 2007

SHEET No. 1 OF 3 SHEETS

FED. ROAD DIST. NO.	STATE	PROJ. NO.	FISCAL YEAR	SHEET NO.	TOTAL SHEETS
HAWAII	HAW.	440A-01-07M	2007	12	14

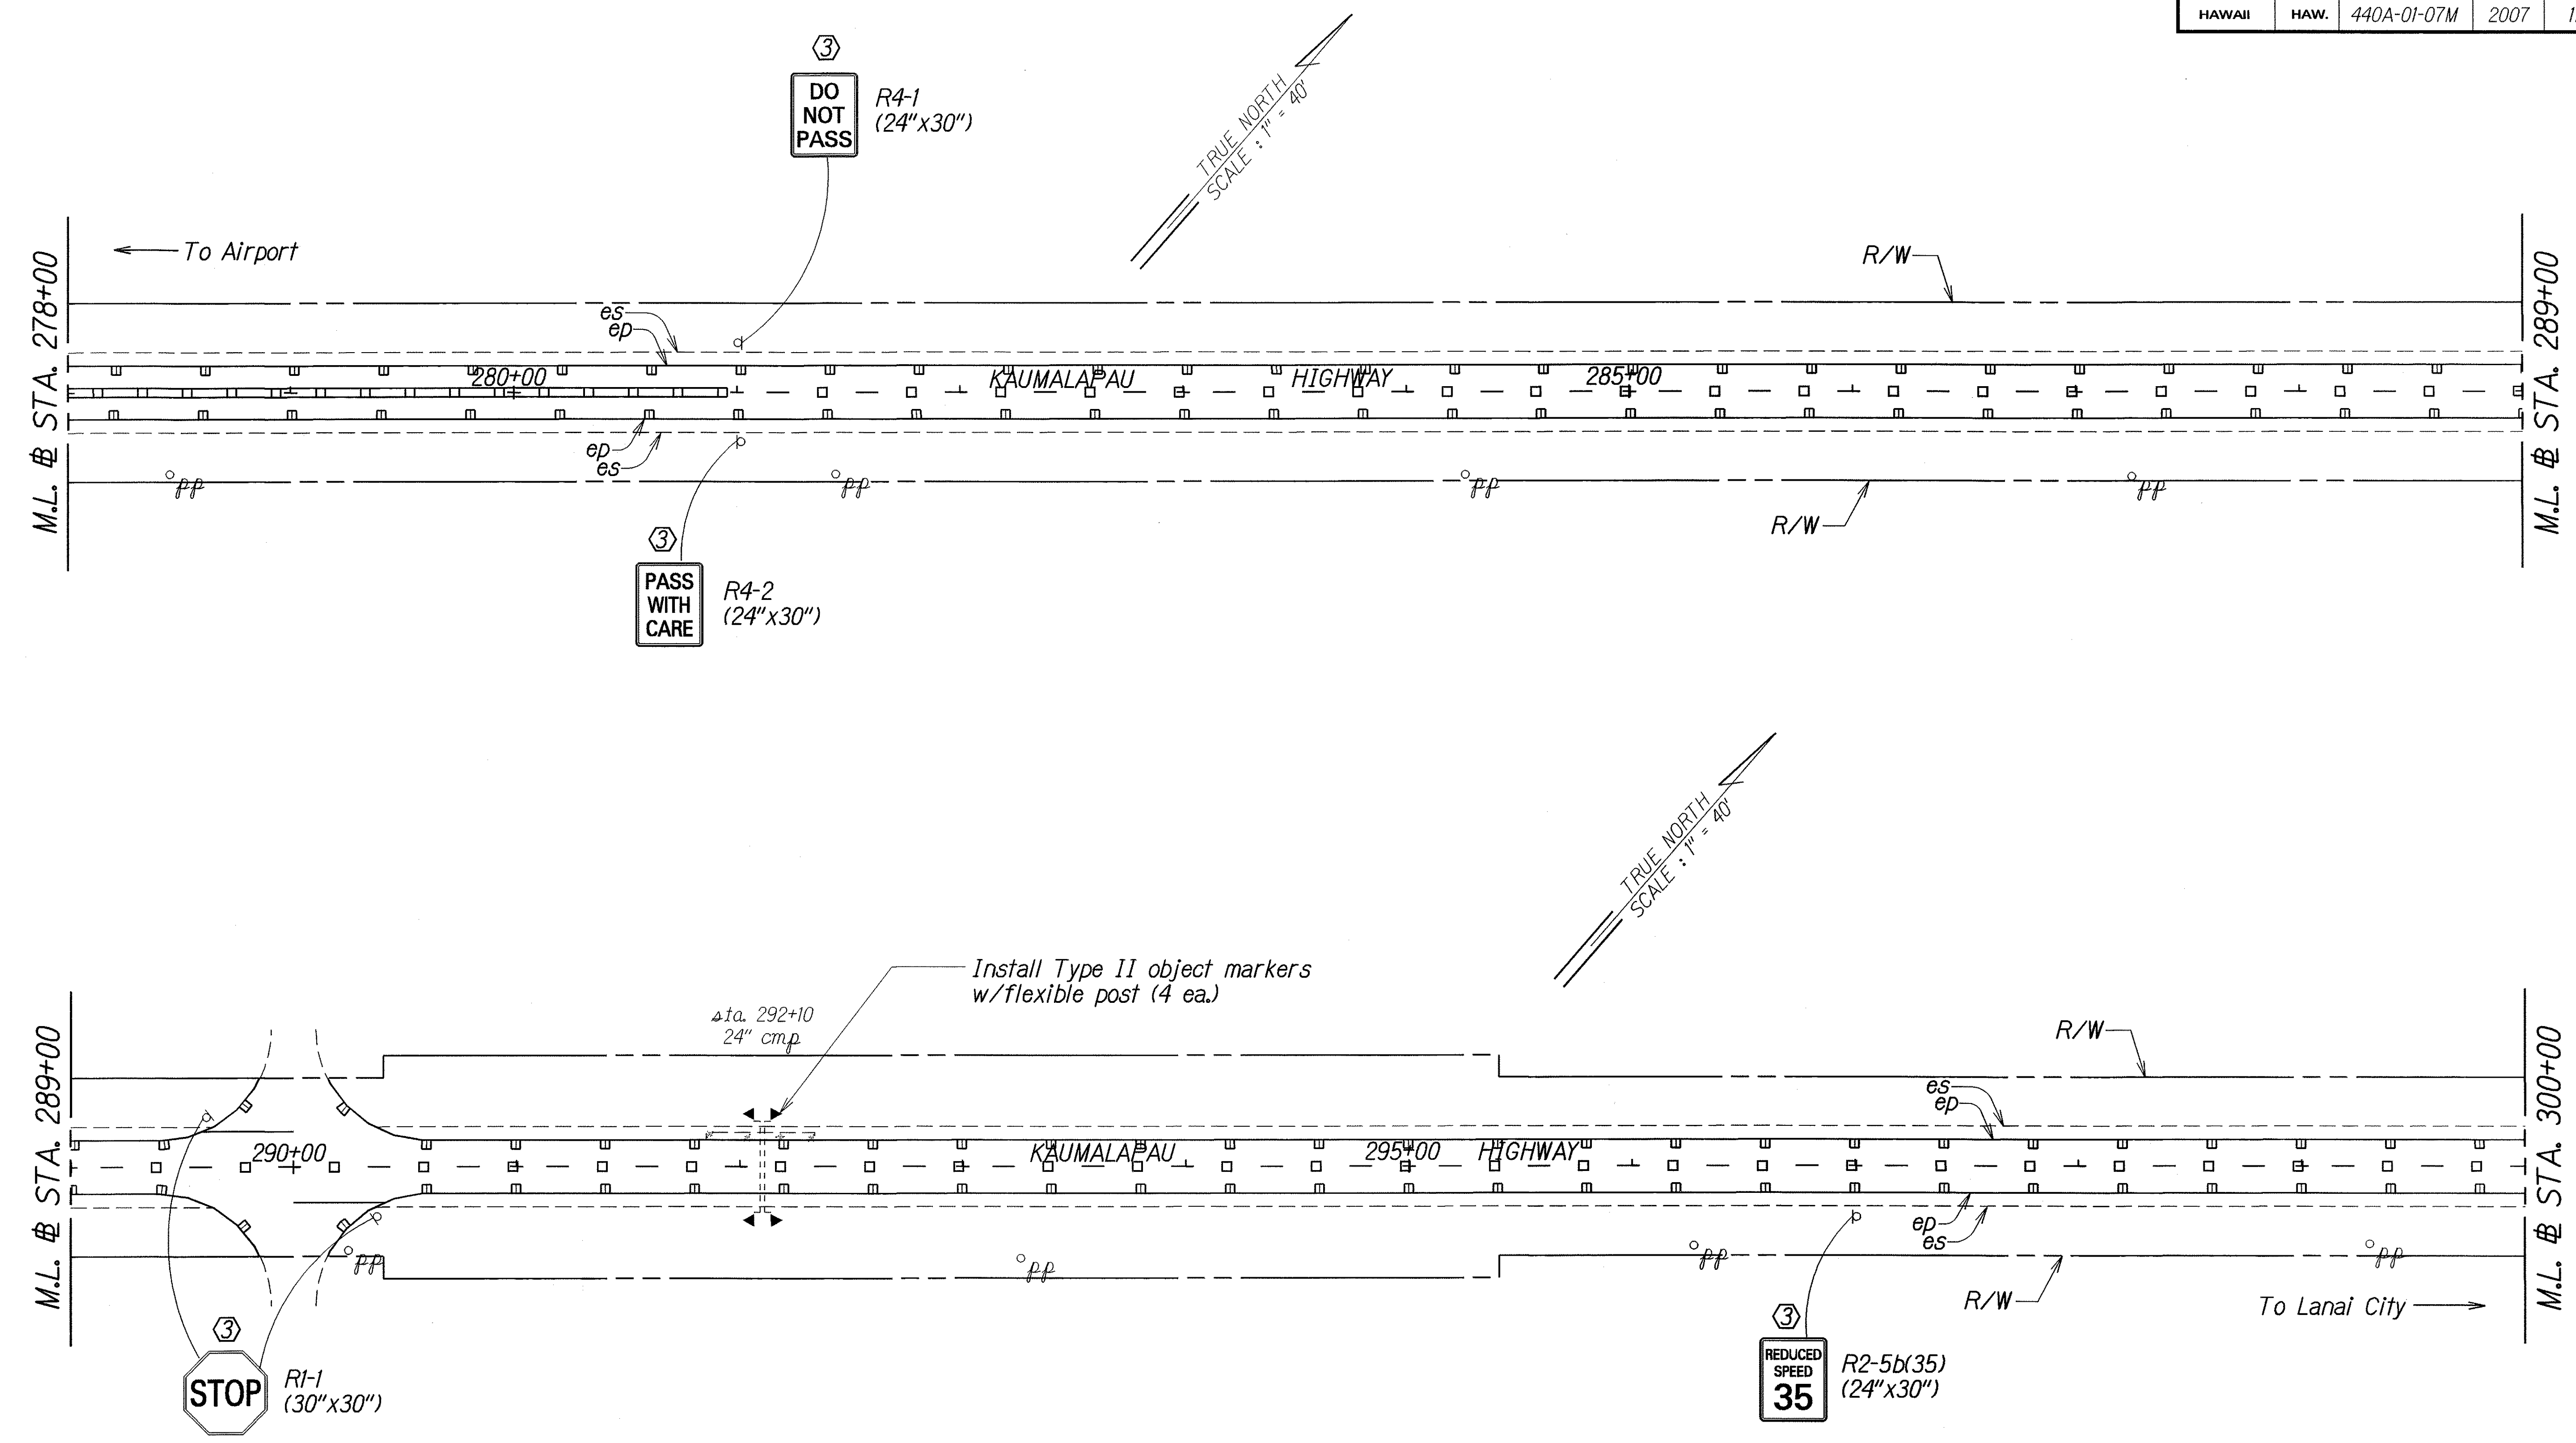

SURVEY PLOTTED BY	DATE
DRAWN BY	
TRACED BY	
NOTED BY	
CHECKED BY	

- KEY:**
- ① Exist. Sign(s) & Post(s) to Remain
 - ② Remove Exist. Sign(s) & Post(s)
 - ③ Remove Exist. & Install New Sign(s) & Post(s)
 - ④ Install New Sign(s) & Post(s)


STATE OF HAWAII
DEPARTMENT OF TRANSPORTATION
HIGHWAYS DIVISION

**SIGNING & PAVEMENT
MARKING PLAN**

KAUMALAPAU HIGHWAY RESURFACING
M.P. 5.0 to End of Lanai City Spur
Project No. 440A-01-07M

Scale: 1" = 40' Date: January, 2007

FED. ROAD DIST. NO.	STATE	PROJ. NO.	FISCAL YEAR	SHEET NO.	TOTAL SHEETS
HAWAII	HAW.	440A-01-07M	2007	13	14

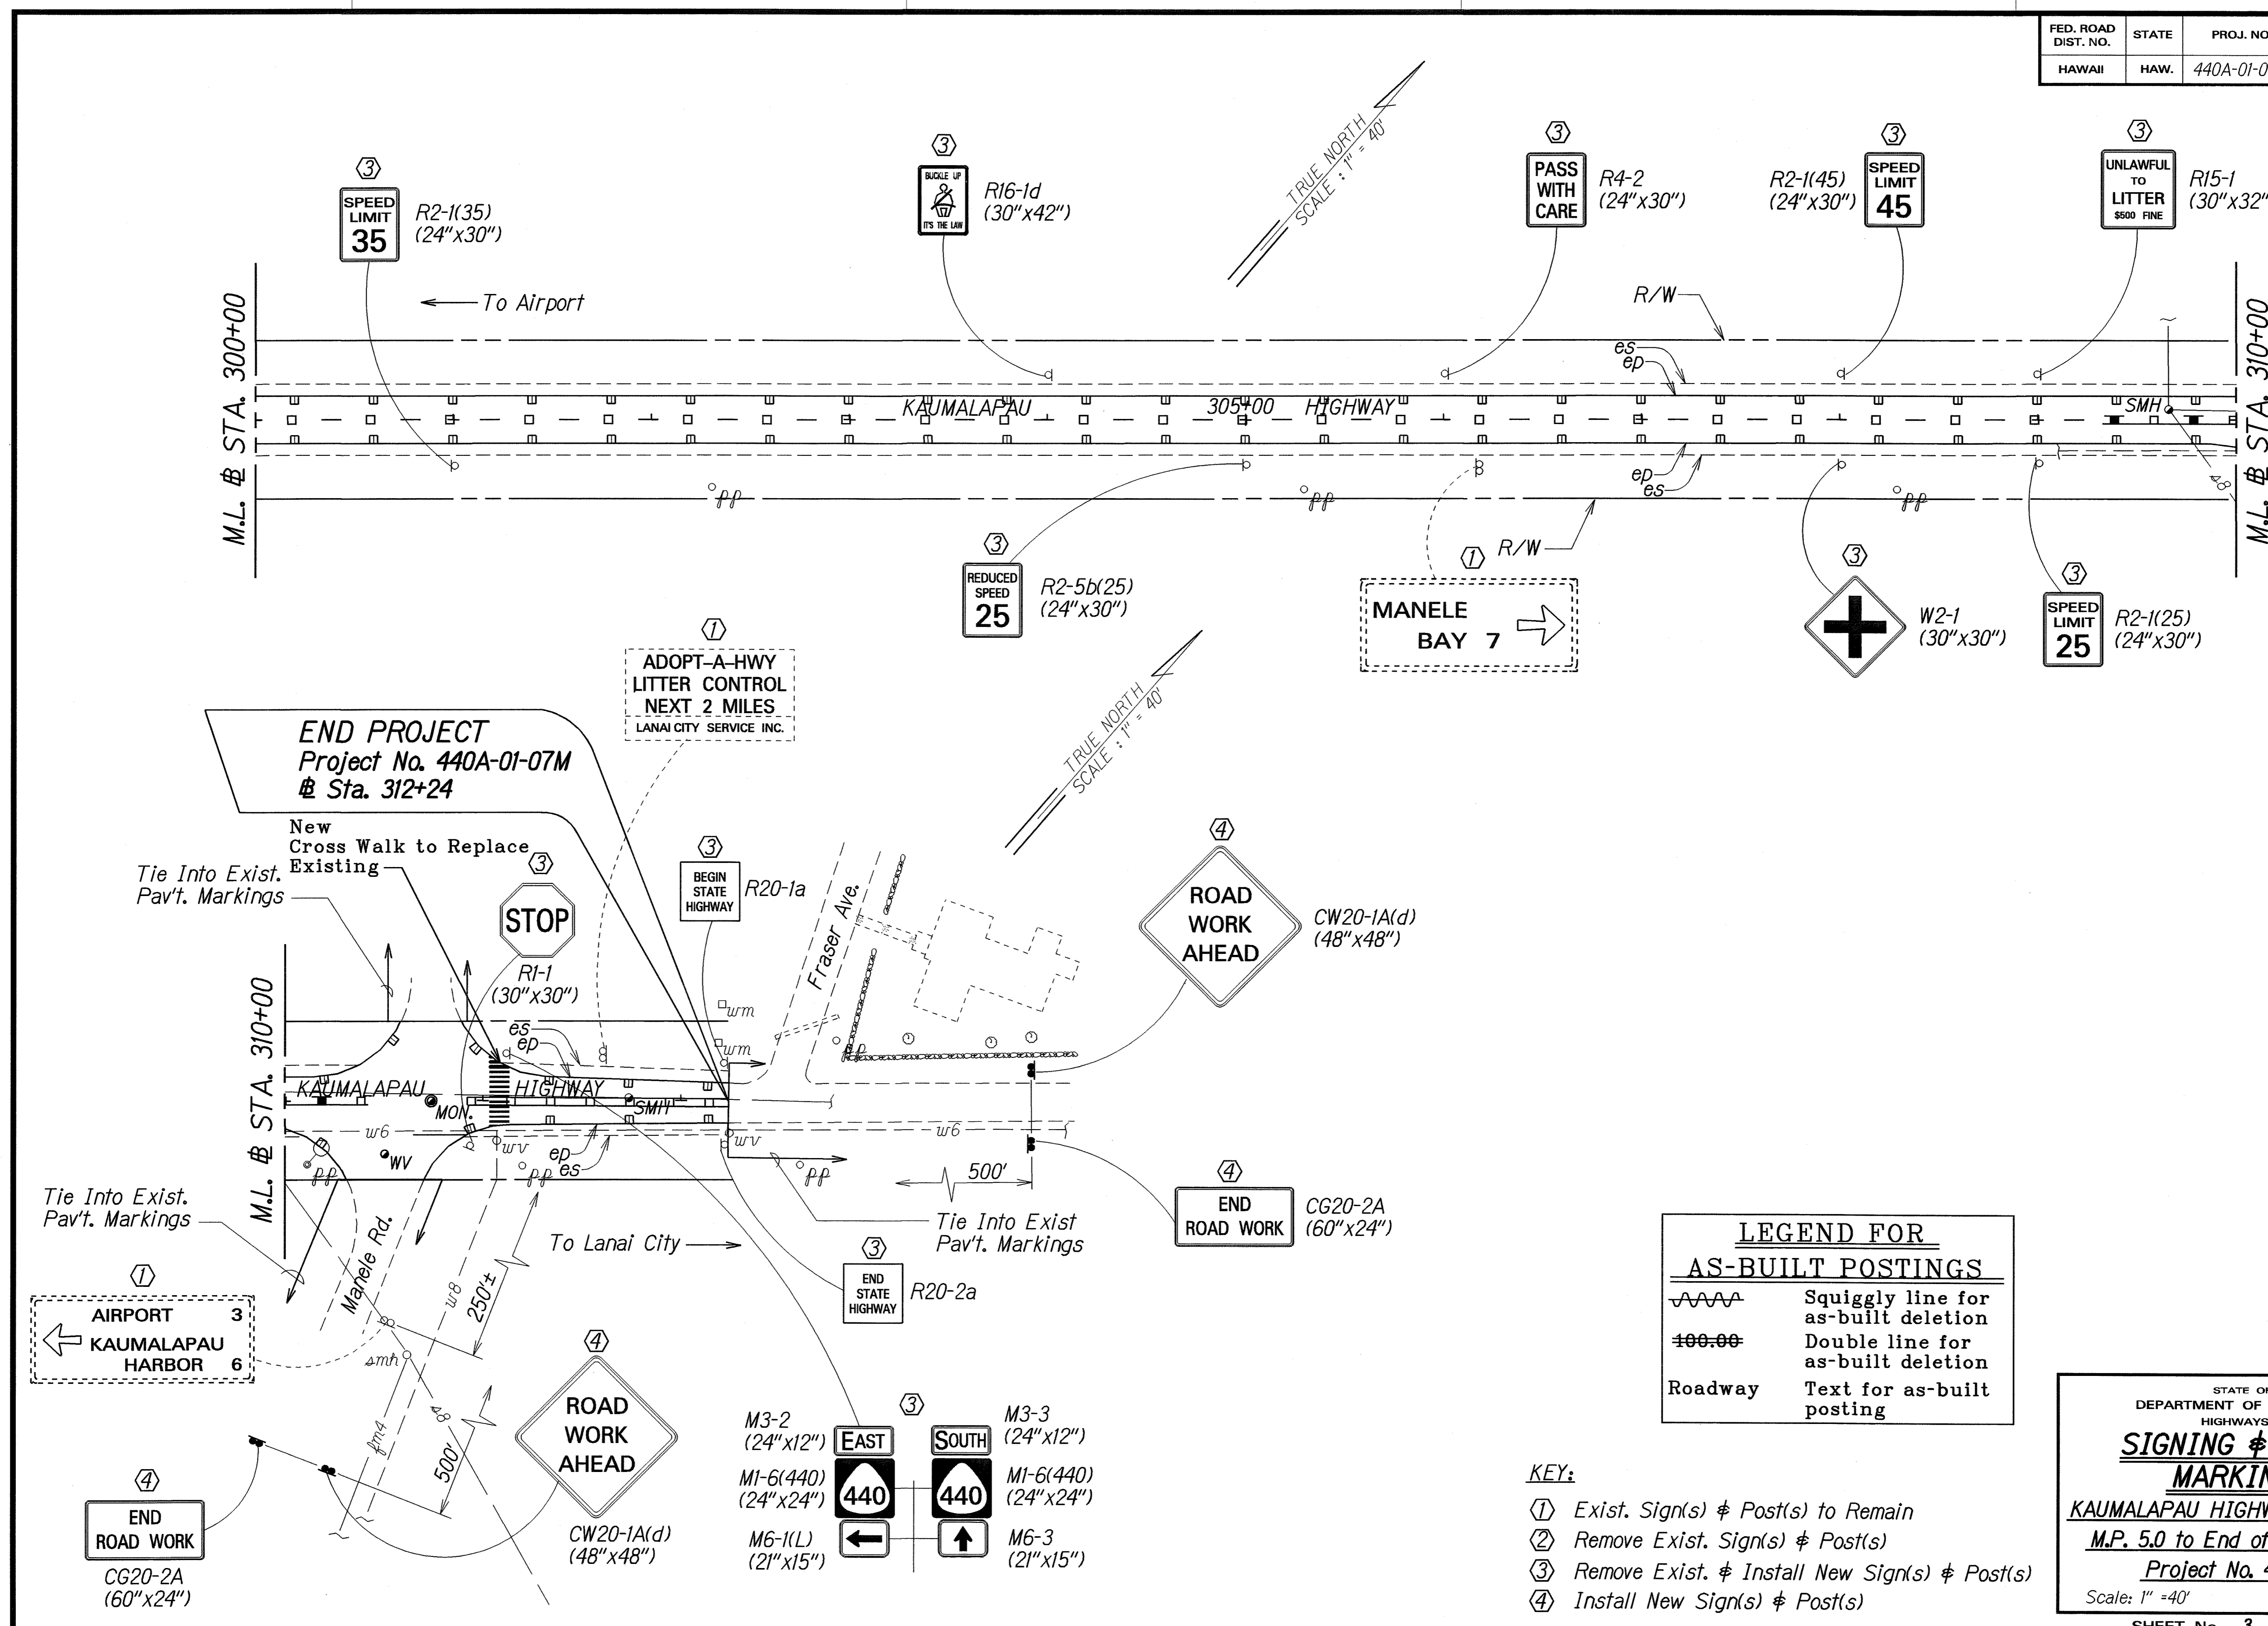

DATE	1-10-07
SURVEY PLANNED BY	
PLAN DRAWN BY	JL
NOTES WORK DESIGNED BY	LS
QUANTITIES BY	me, jby
CHECKED BY	Shirley P. Design
ORIGINAL PLAN	

LEGEND FOR AS-BUILT POSTINGS

	Squiggly line for as-built deletion
	Double line for as-built deletion
Roadway	Text for as-built posting

- KEY:**
- ① Exist. Sign(s) & Post(s) to Remain
 - ② Remove Exist. Sign(s) & Post(s)
 - ③ Remove Exist. & Install New Sign(s) & Post(s)
 - ④ Install New Sign(s) & Post(s)

STATE OF HAWAII
DEPARTMENT OF TRANSPORTATION
HIGHWAYS DIVISION

SIGNING & PAVEMENT MARKING PLAN

KAUMALAPAU HIGHWAY RESURFACING
M.P. 5.0 to End of Lanai City Spur
Project No. 440A-01-07M

Scale: 1" = 40' Date: January, 2007

SHEET No. 3 OF 3 SHEETS

"AS-BUILT"