

INDEX TO DRAWINGS	
SHEET NO.	DESCRIPTION
1	TITLE SHEET
2	STANDARD PLANS SUMMARY
3	GENERAL NOTES AND LEGEND
4	TYPICAL SECTIONS AND DETAILS
5 - 6	WATER POLLUTION & EROSION CONTROL NOTES
7 - 9	ROADWAY PLANS
10	PAVEMENT MARKINGS LEGEND, DETAILS AND NOTES
11 - 13	SIGNING AND PAVEMENT MARKING PLAN
14	MISCELLANEOUS SUMMARIES

STATE OF HAWAII

DEPARTMENT OF TRANSPORTATION

HIGHWAYS DIVISION

HONOLULU, HAWAII

"AS-BUILT"

PLANS FOR

KAUMALAPAU HIGHWAY RESURFACING




M.P. 5.0 TO END OF LANAI CITY SPUR

PROJECT NO. 440A-01-07M

DISTRICT OF LANAI

ISLAND OF LANAI

FED. ROAD DIST. NO.	STATE	PROJ. NO.	FISCAL YEAR	SHEET NO.	TOTAL SHEETS
HAWAII	HAW.	440A-01-07M	2007	1	14

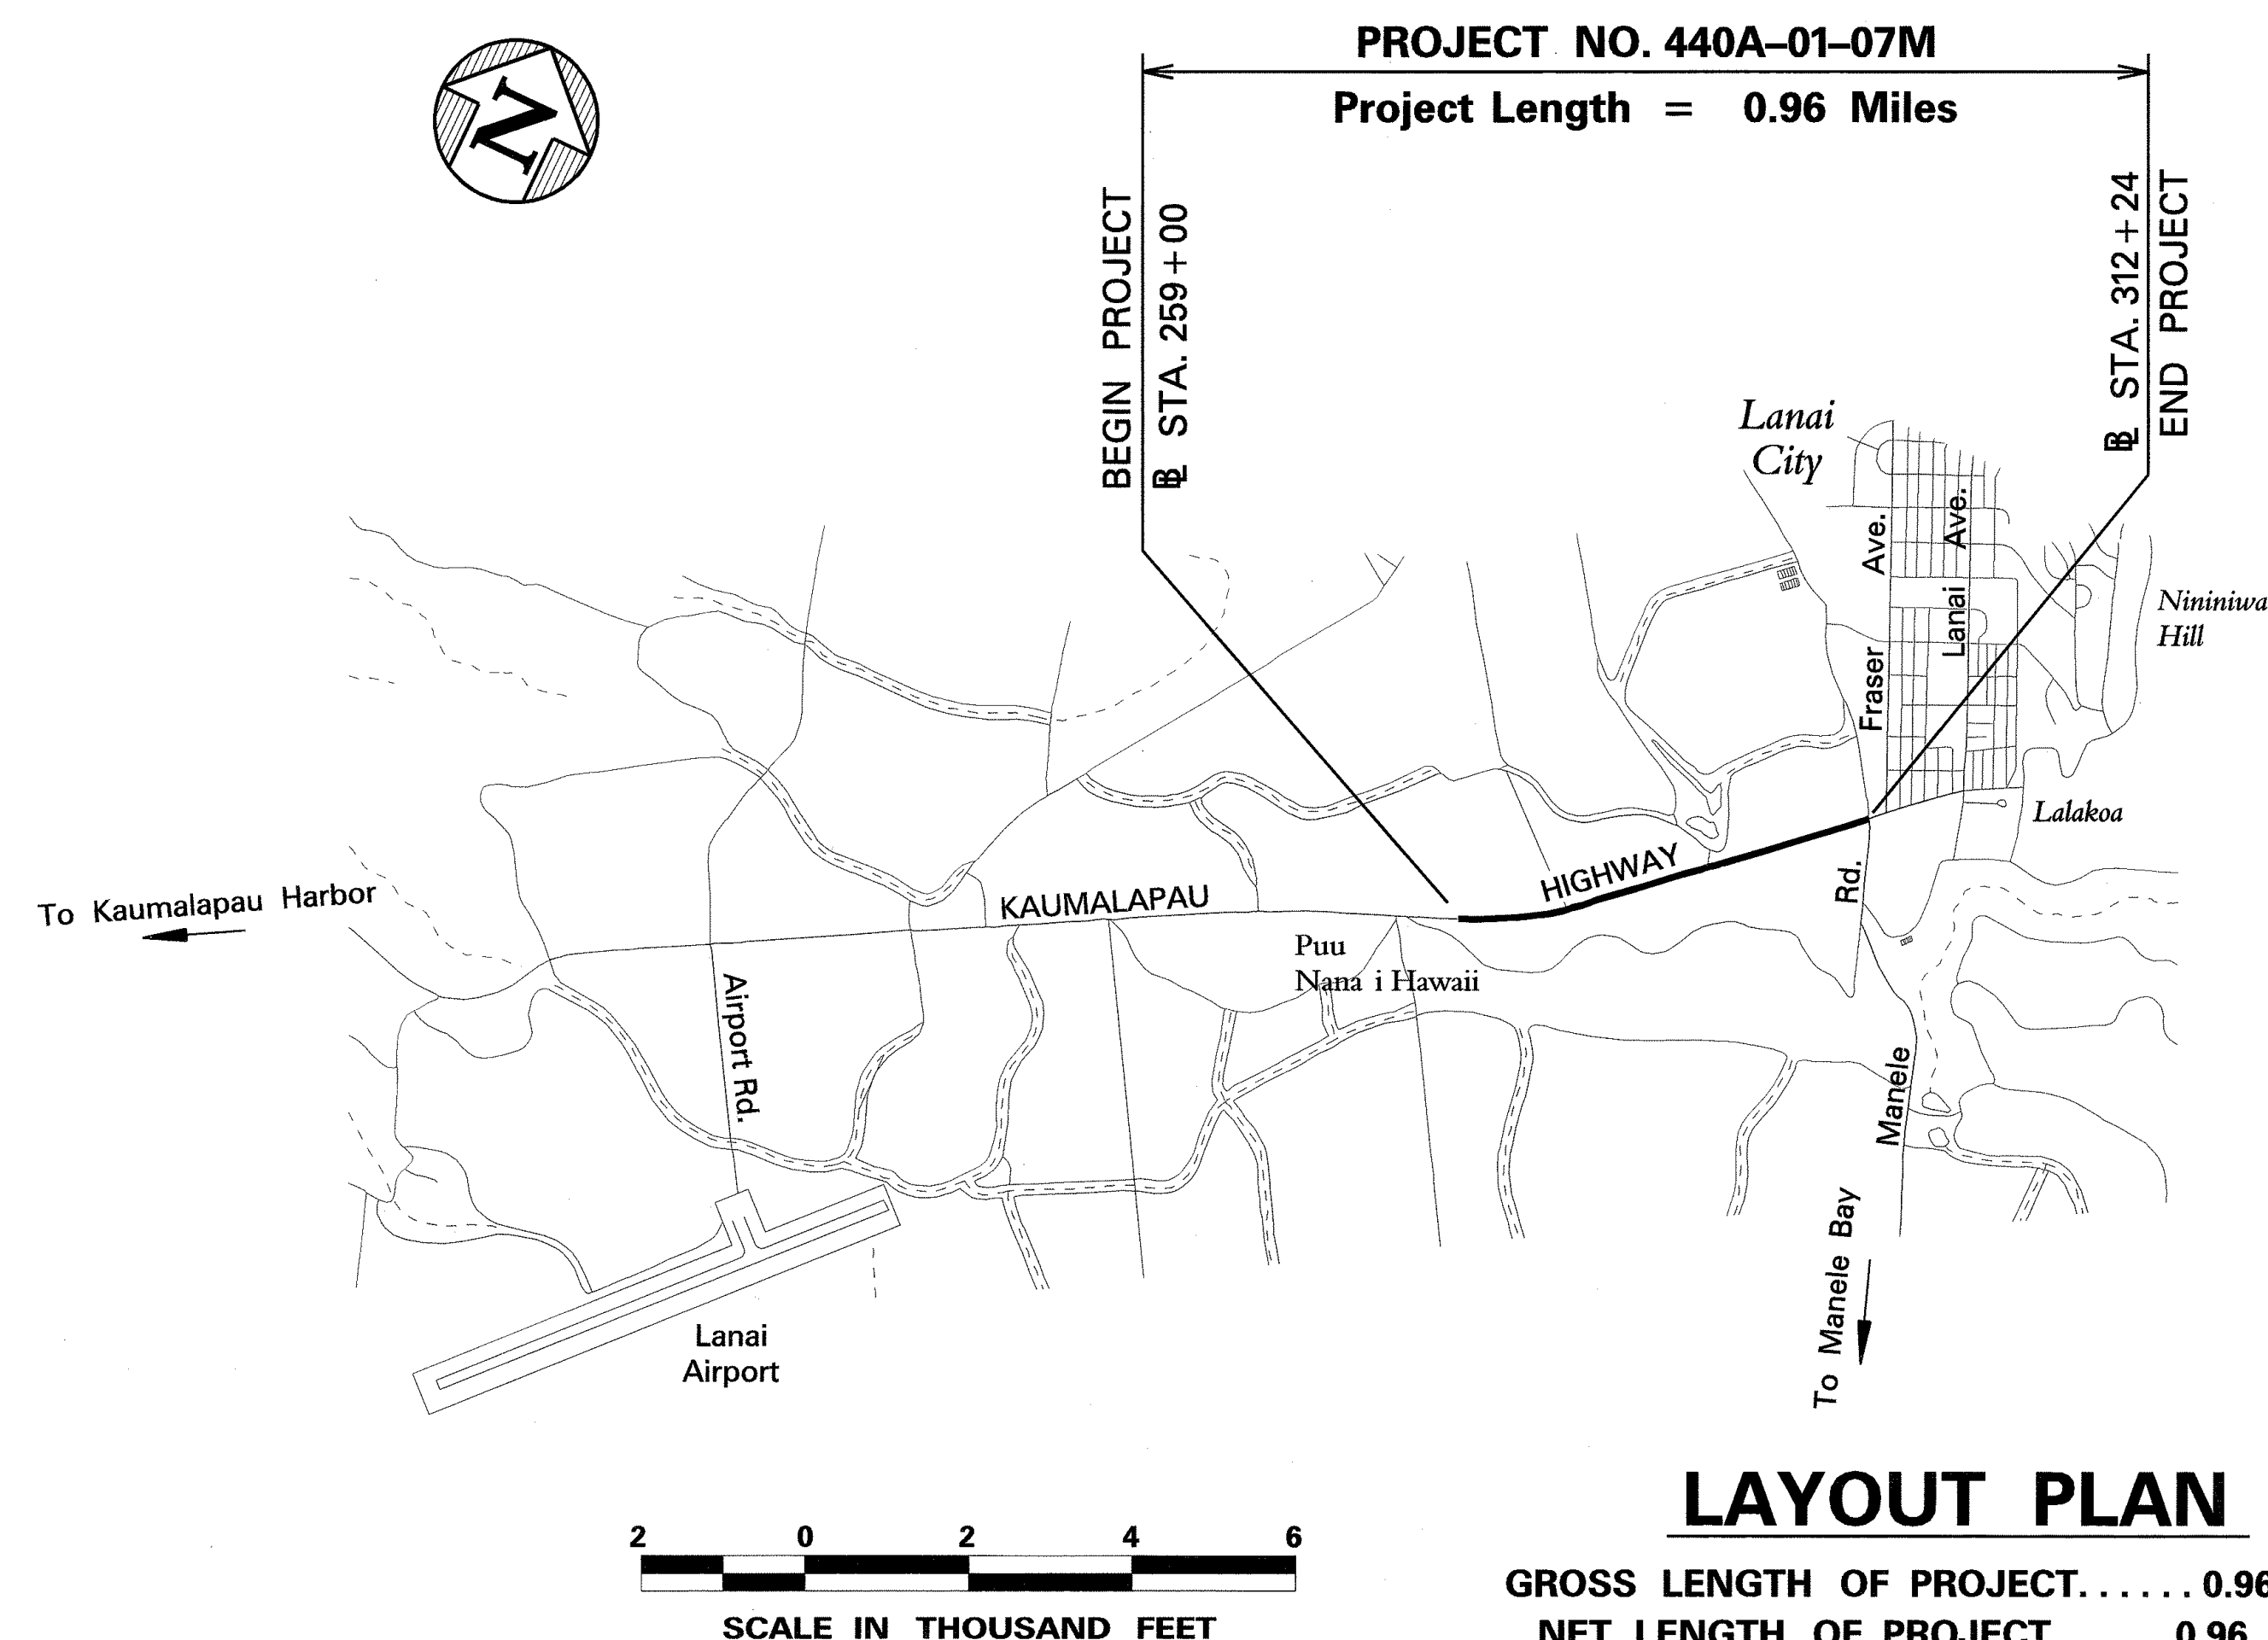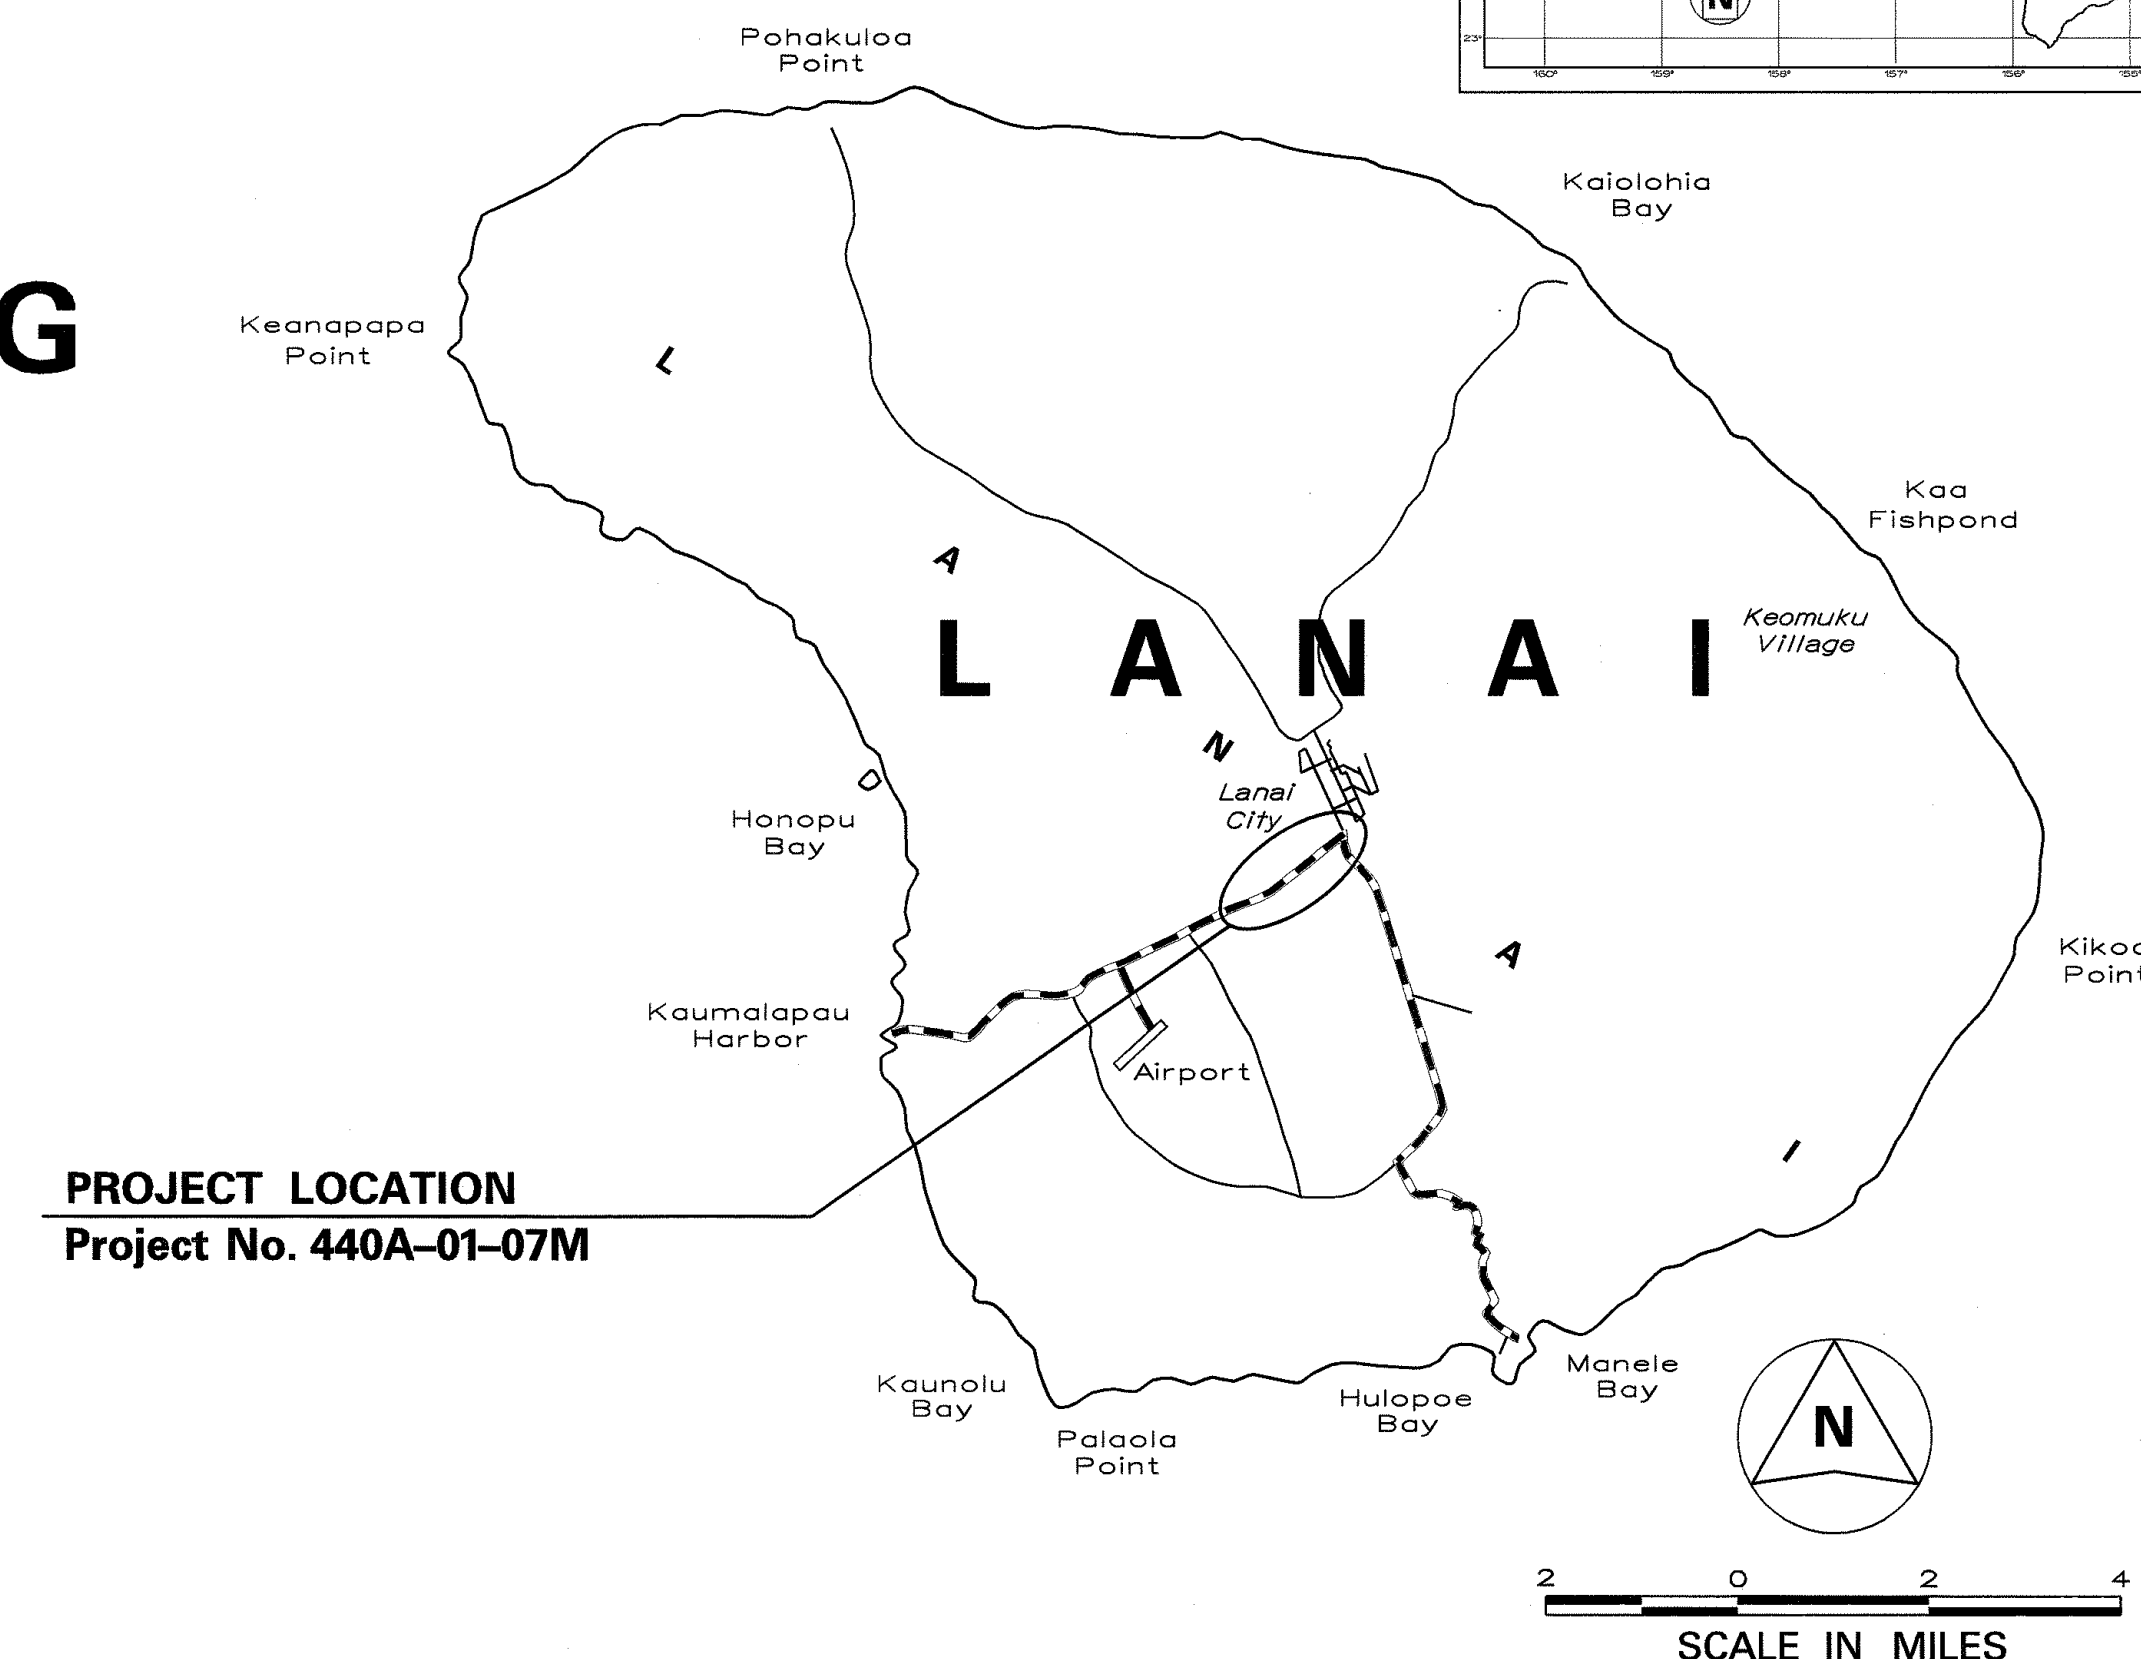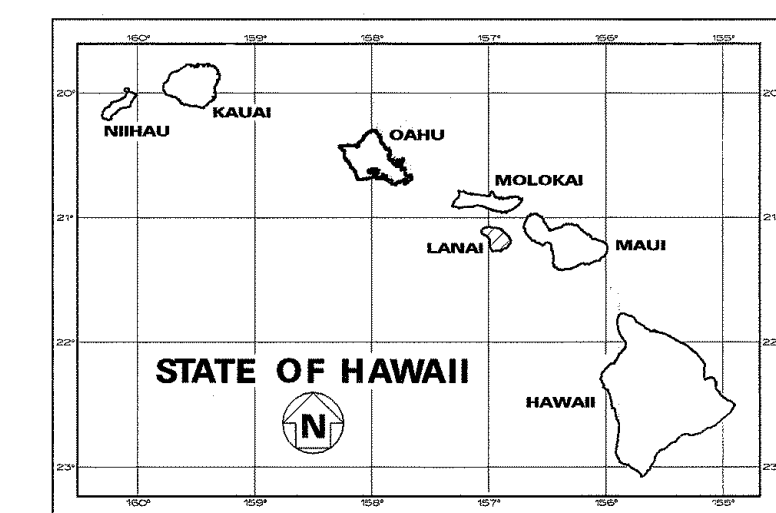

--- FEDERAL AID PROJECTS PREVIOUSLY CONSTRUCTED OR UNDER CONSTRUCTION

MILE POST 5.00 TO MILE POST 5.96

CHANGES MADE DURING CONSTRUCTION HAVE BEEN INCORPORATED ON THESE PLANS EXCEPT CHANGES IN THE ORIGINAL THEORETICAL QUANTITIES. FOR ACTUAL QUANTITIES, REFER TO PROJECT LEDGER AND/OR CONSTRUCTION BOOK.

RESIDENT ENGINEER DATE

DEPARTMENT OF TRANSPORTATION STATE OF HAWAII	
APPROVED:	
DIR. OF TRANSPORTATION	DATE

DESIGNED BY  
PAUL CHUNG  
MANAGED BY  
PAUL CHUNG  
DATE  
FEB., 2007  
PHONE  
873-3535