

[illegible]

STATE OF HAWAII

DEPARTMENT OF TRANSPORTATION

HIGHWAYS DIVISION

HONOLULU, HAWAII

"AS-BUILT"

PLANS FOR

**KAUMALAPAU HIGHWAY PAVEMENT
PREVENTIVE MAINTENANCE**



KAUMALAPAU HARBOR TO LANDFILL ACCESS ROAD

PROJECT NO. 440A-01-10M

DISTRICT OF LANAI

ISLAND OF LANAI

FED. ROAD DIST. NO.	STATE	PROJ. NO.	FISCAL YEAR	SHEET NO.	TOTAL SHEETS
HAWAII	HAW.	440A-01-10M	2010	1	15

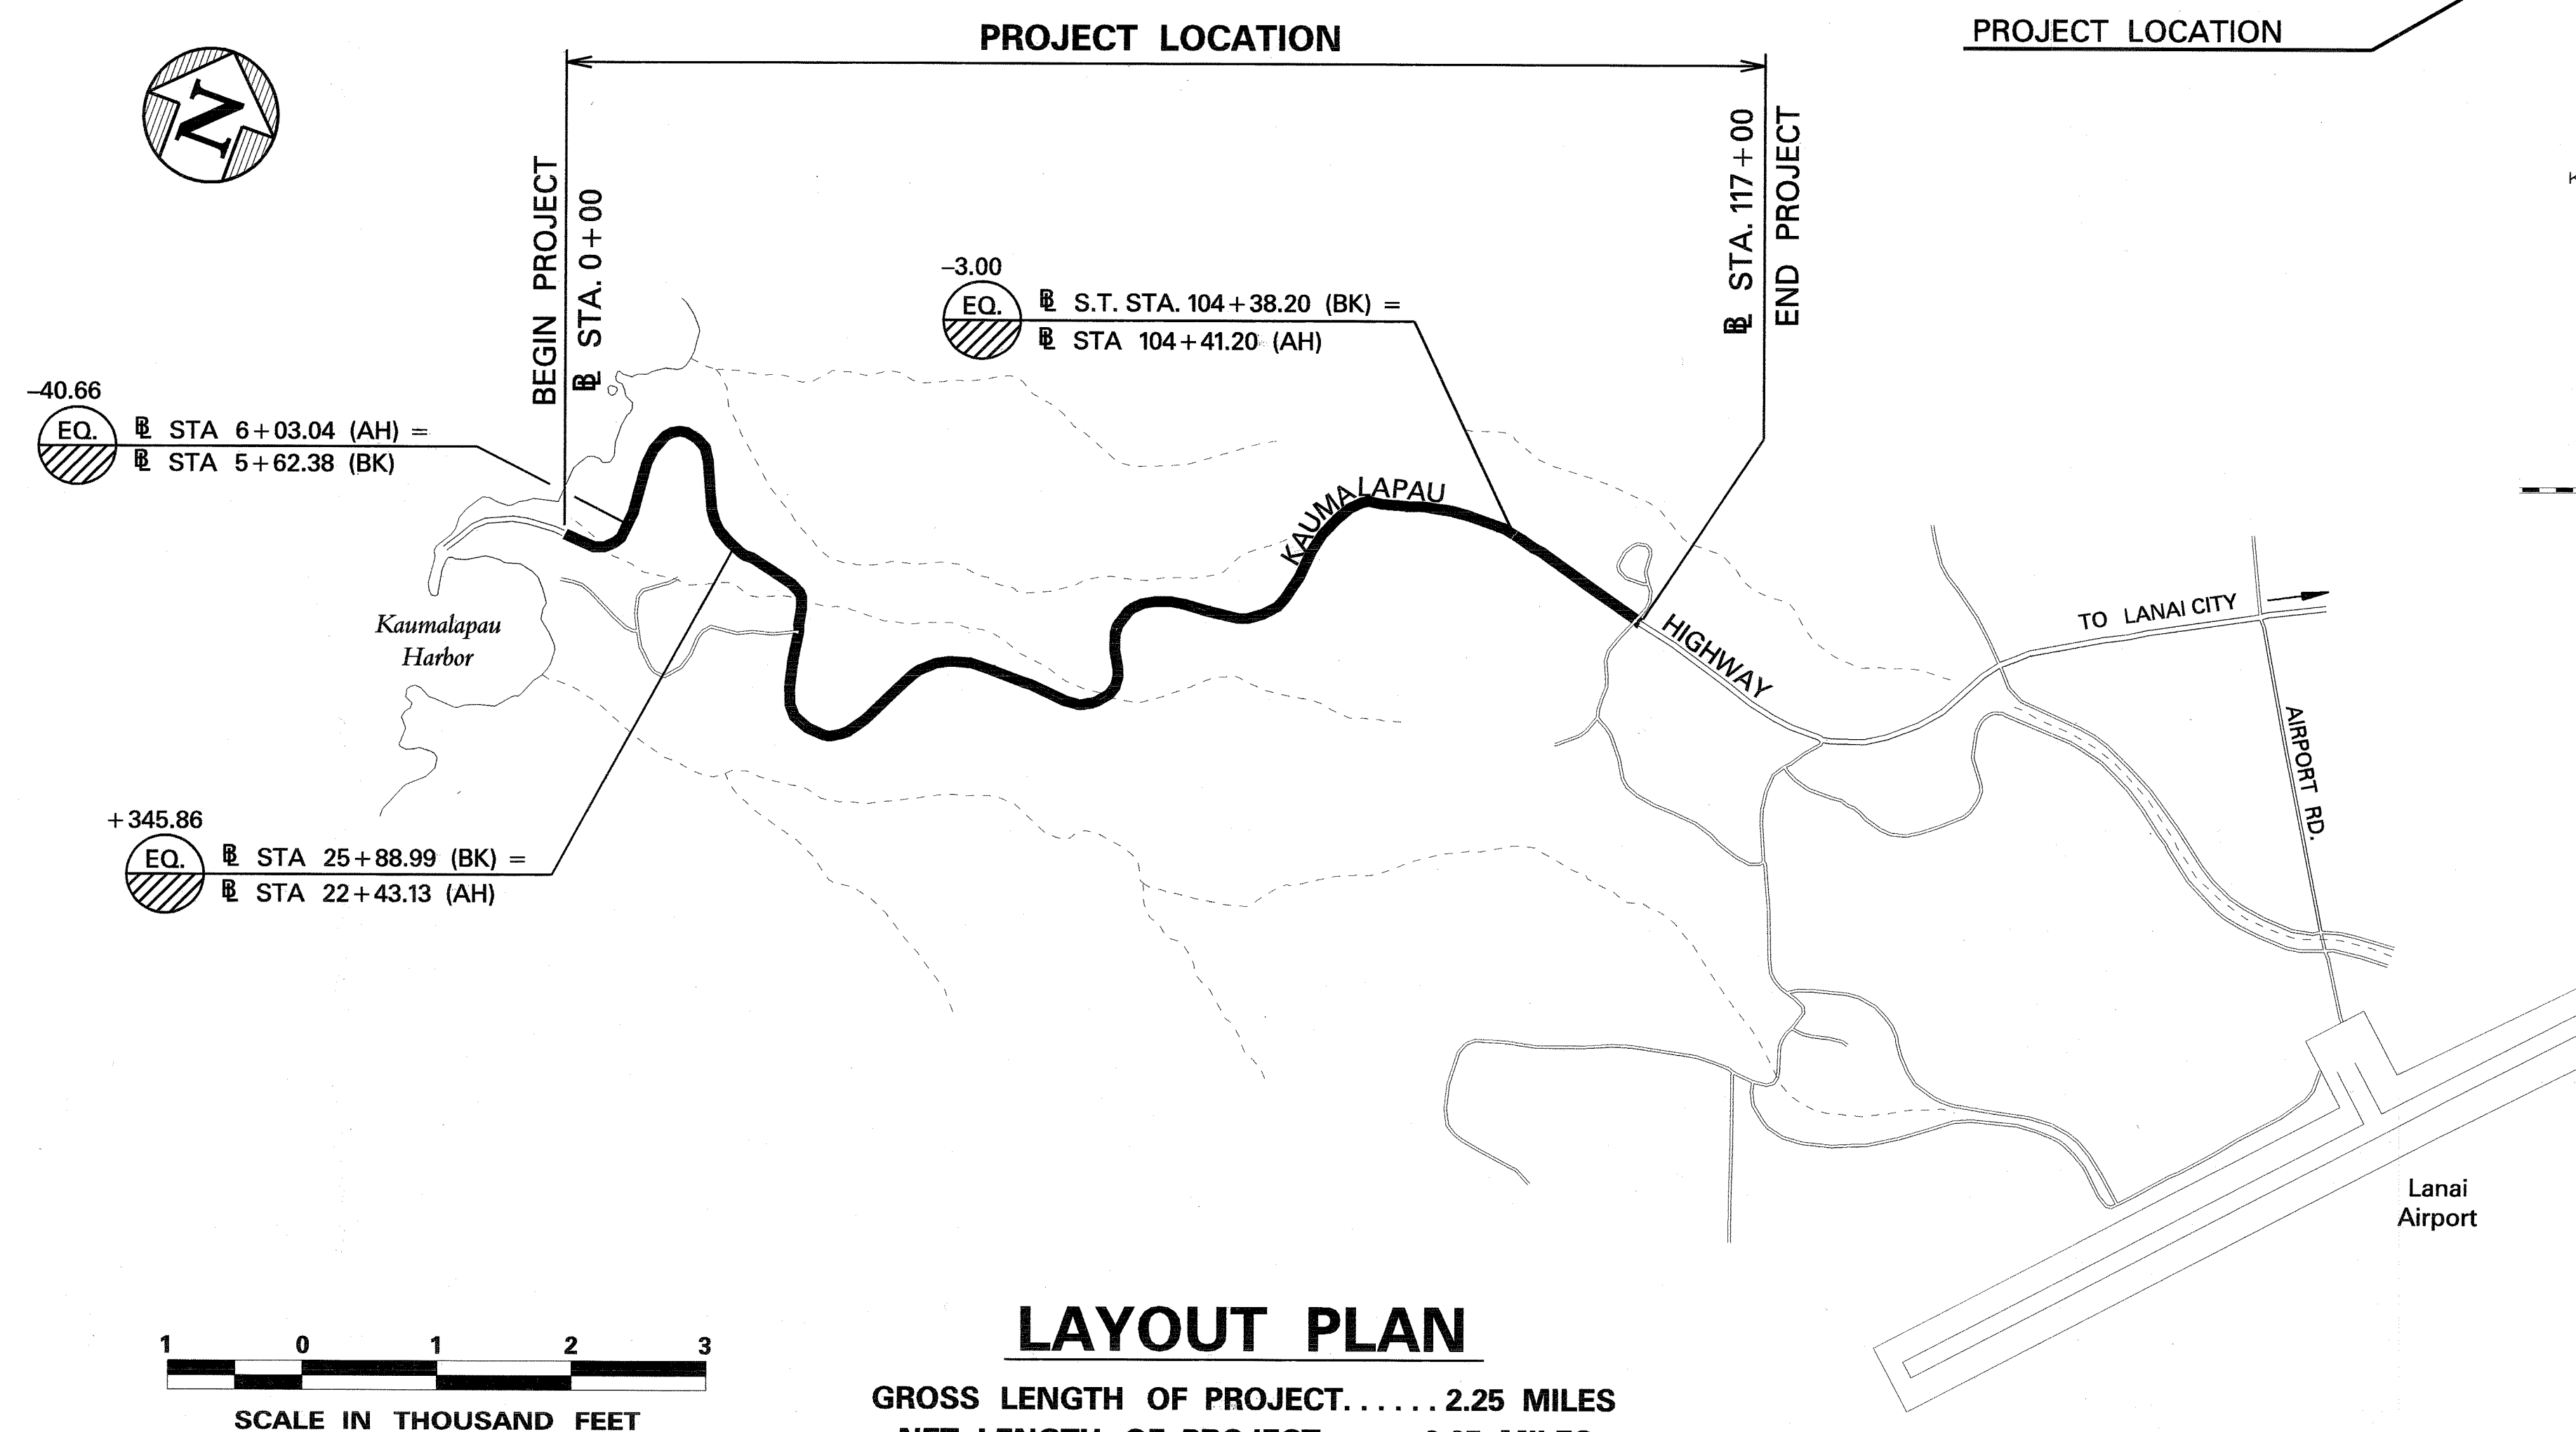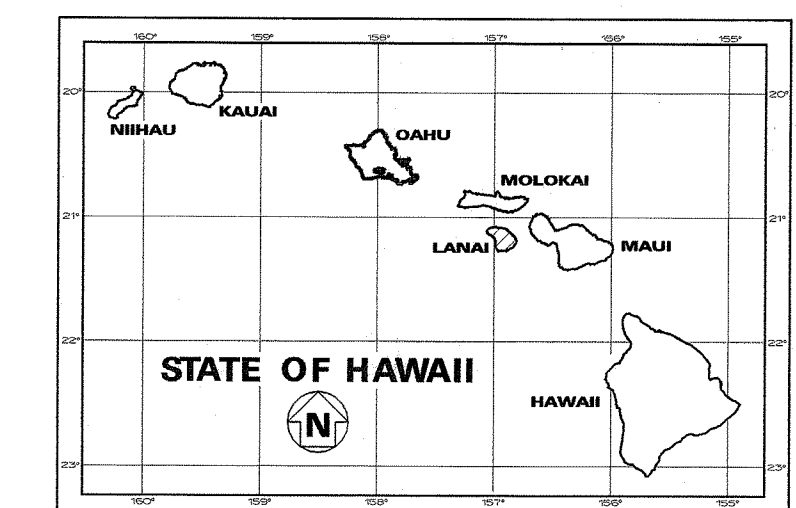



 FEDERAL AID PROJECTS PREVIOUSLY CONSTRUCTED
OR UNDER CONSTRUCTION

MILE POST 0.00 TO MILE POST 2.25

CHANGES MADE DURING CONSTRUCTION HAVE BEEN INCORPORATED ON THESE PLANS EXCEPT CHANGES IN THE ORIGINAL THEORETICAL QUANTITIES. FOR ACTUAL QUANTITIES, REFER TO PROJECT LEDGER AND/OR COMPUTATION BOOK.

RESIDENT ENGINEER 3/6/12
DATE

DEPARTMENT OF TRANSPORTATION STATE OF HAWAII	
APPROVED:	
	
<u>DIR. OF TRANSPORTATION</u>	<u>DATE</u>