




FED. ROAD DIST. NO.	STATE	PROJ. NO.	FISCAL YEAR	SHEET NO.	TOTAL SHEETS
HAWAII	HAW.	440B-01-11M	2011	6	16

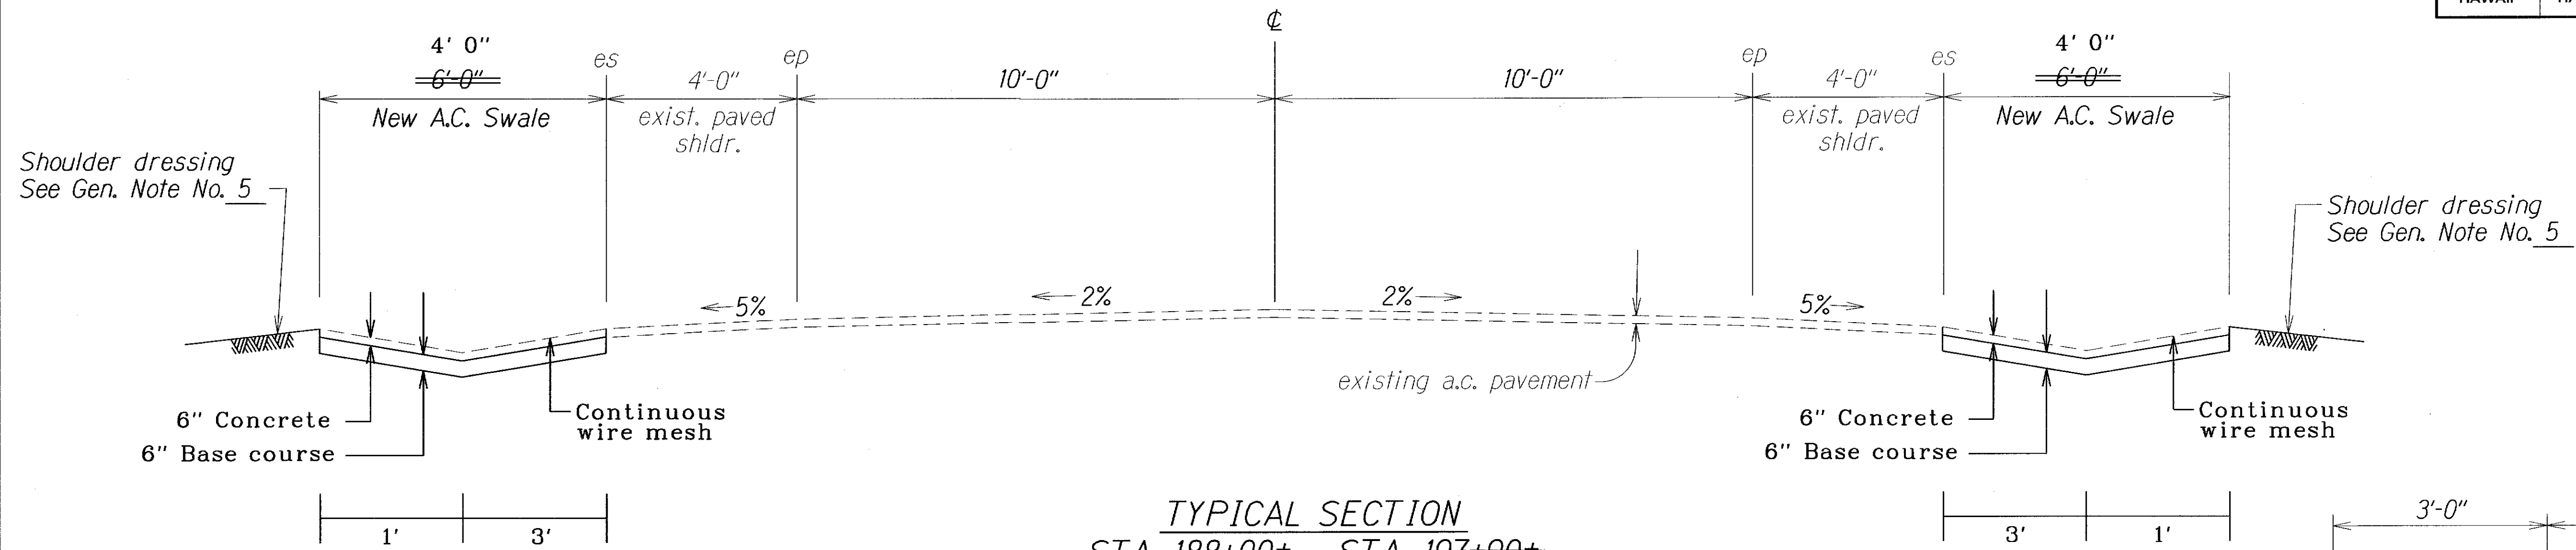


**TYPICAL SECTION**  
~~STA. 188+00± - STA. 197+90±~~  
~~STA. 0+00± - STA. 11+00± (EQ. STA.)~~ Sta. 7+87  
 Scale: 1/2" = 1'-0"

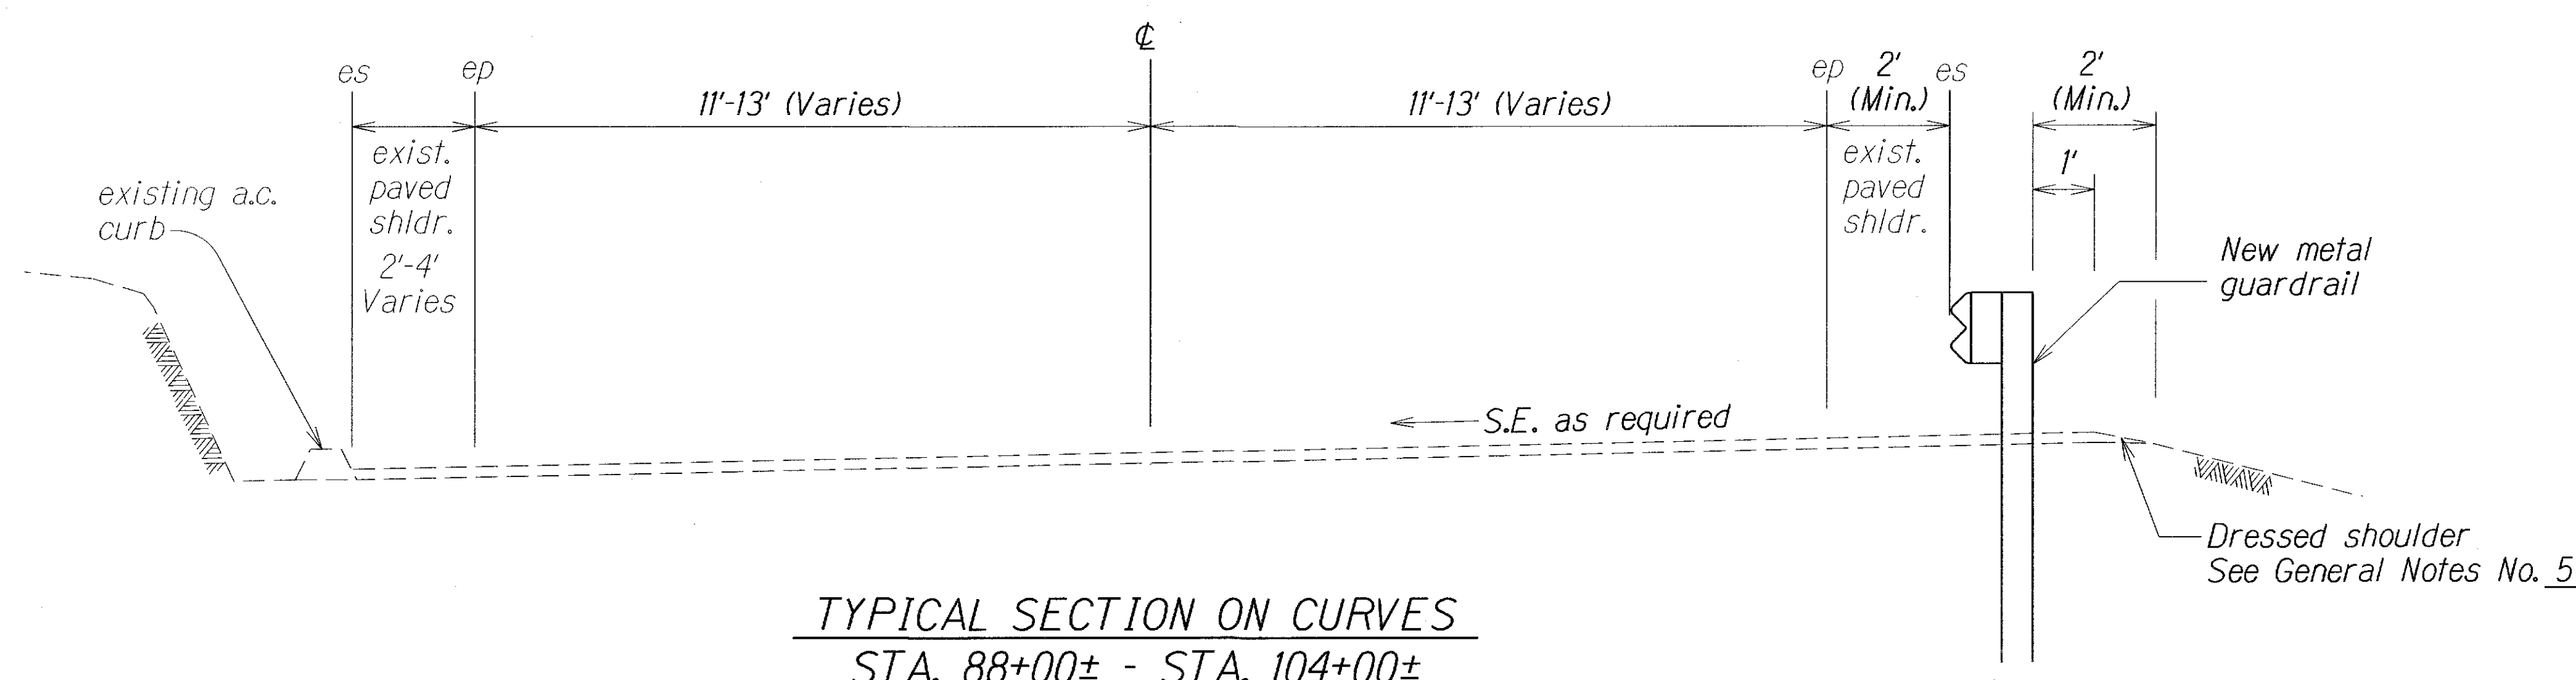

**TYPICAL SECTION ON CURVES**  
 STA. 88+00± - STA. 104+00±  
 Scale: 1/2" = 1'-0"

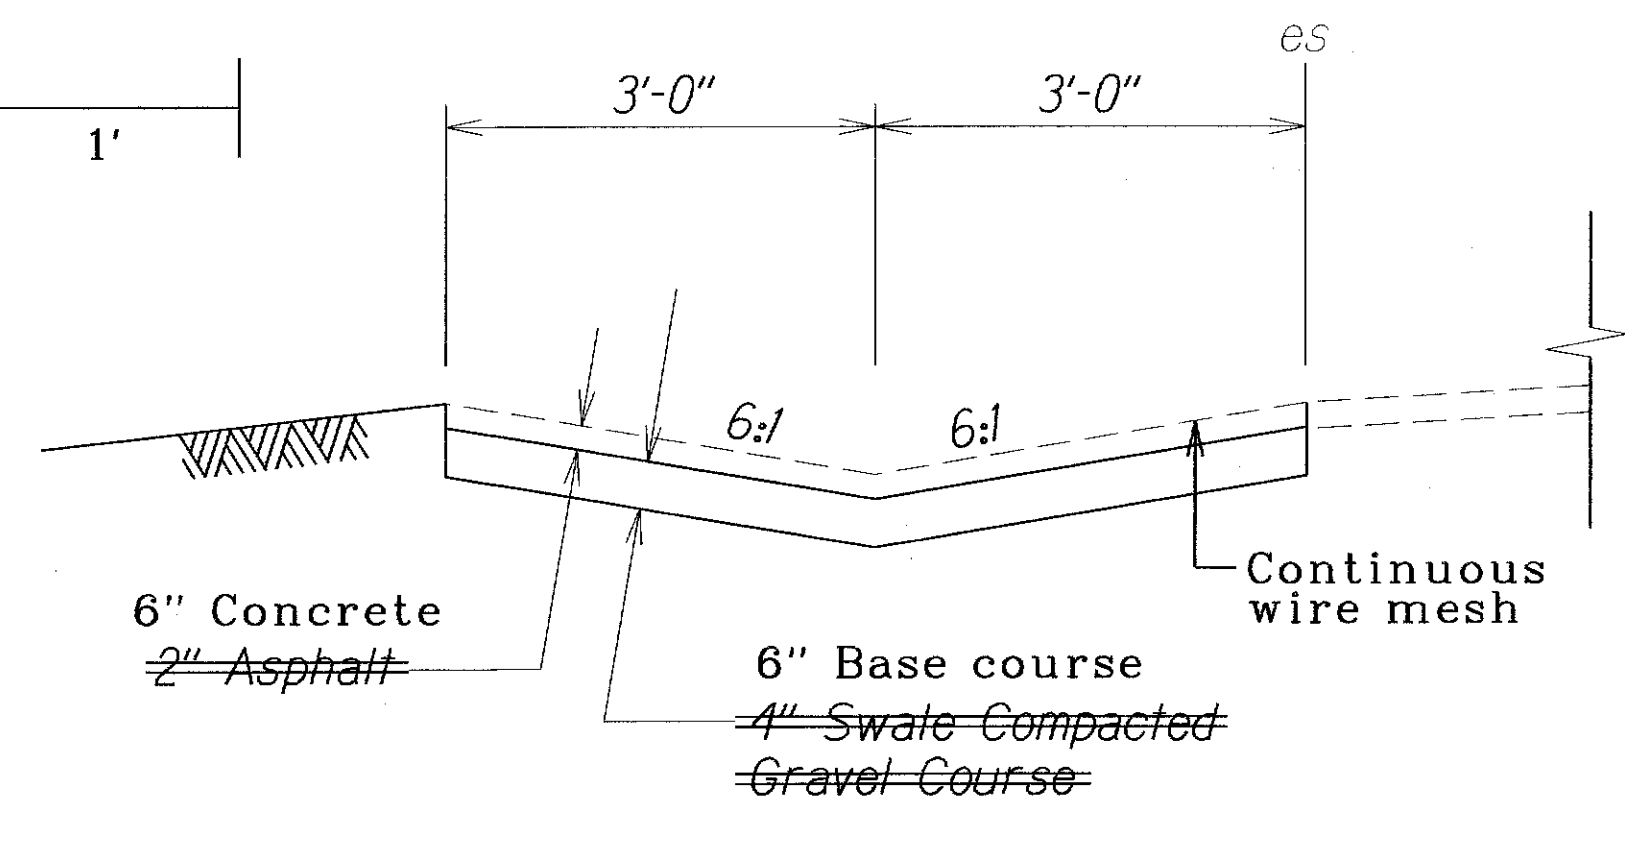

**DETAIL**  
 Scale: 3/4" = 1'-0"  
 Sta. 181+00 - Sta. 188+00

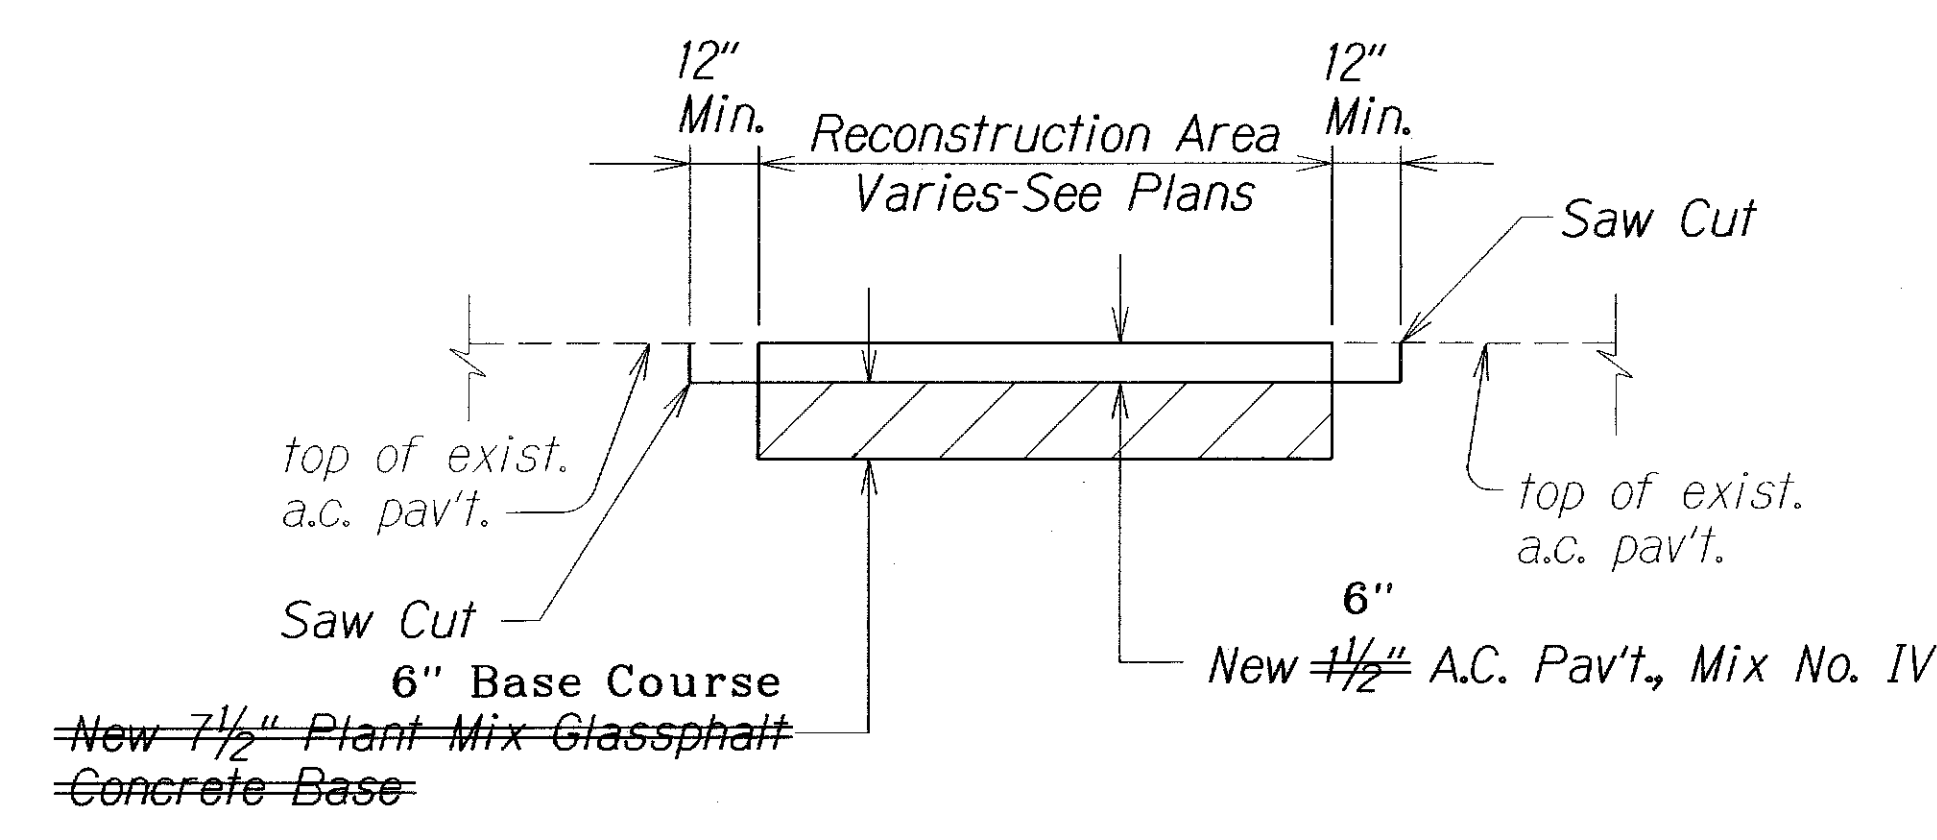

**A.C. PAVEMENT RECONSTRUCTION DETAIL**  
 Not To Scale

LEGEND FOR AS-BUILT POSTINGS	
	Squiggly line for as-built deletion
	Double line for as-built deletion
Roadway	Text for as-built posting

STATE OF HAWAII  
 DEPARTMENT OF TRANSPORTATION  
 HIGHWAYS DIVISION

**TYPICAL SECTIONS & DETAILS**

**MANELE ROAD REPAIR & MAINTENANCE**

*At Various Locations*  
 Project No. 440B-01-11M

Scale: As Shown Date: June, 2011

SHEET No. 1 OF 1 SHEETS