

Airports Division



DEPARTMENT OF TRANSPORTATION
STATE OF HAWAII

PLANS FOR

RESURFACE RUNWAY 2-20

AT

KAHULUI AIRPORT KAHULUI, MAUI, HAWAII PROJECT NO. AM1022-21

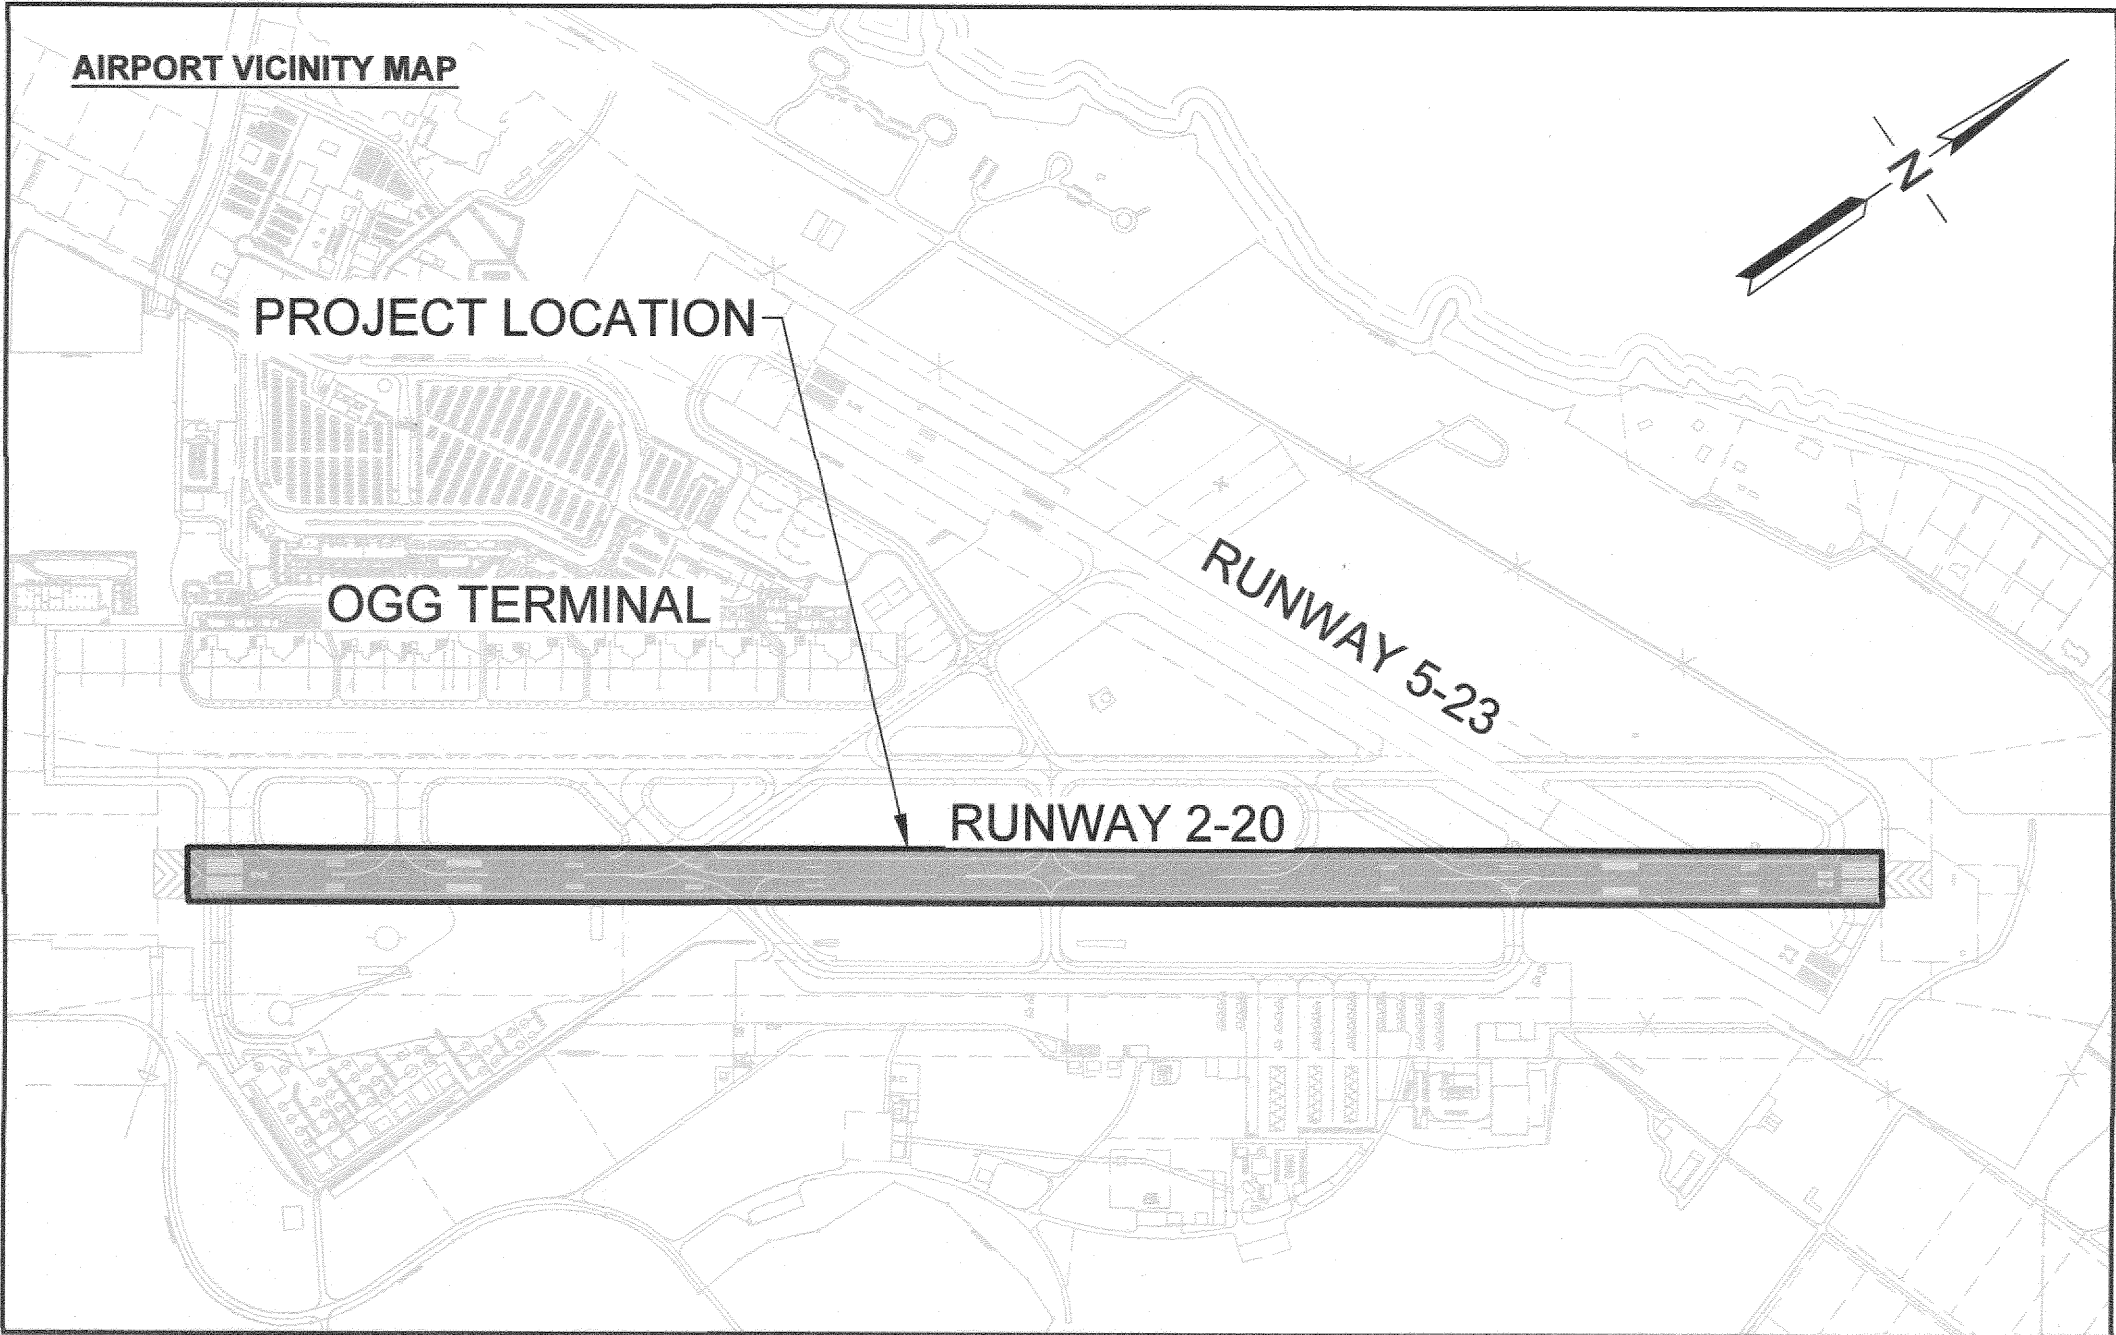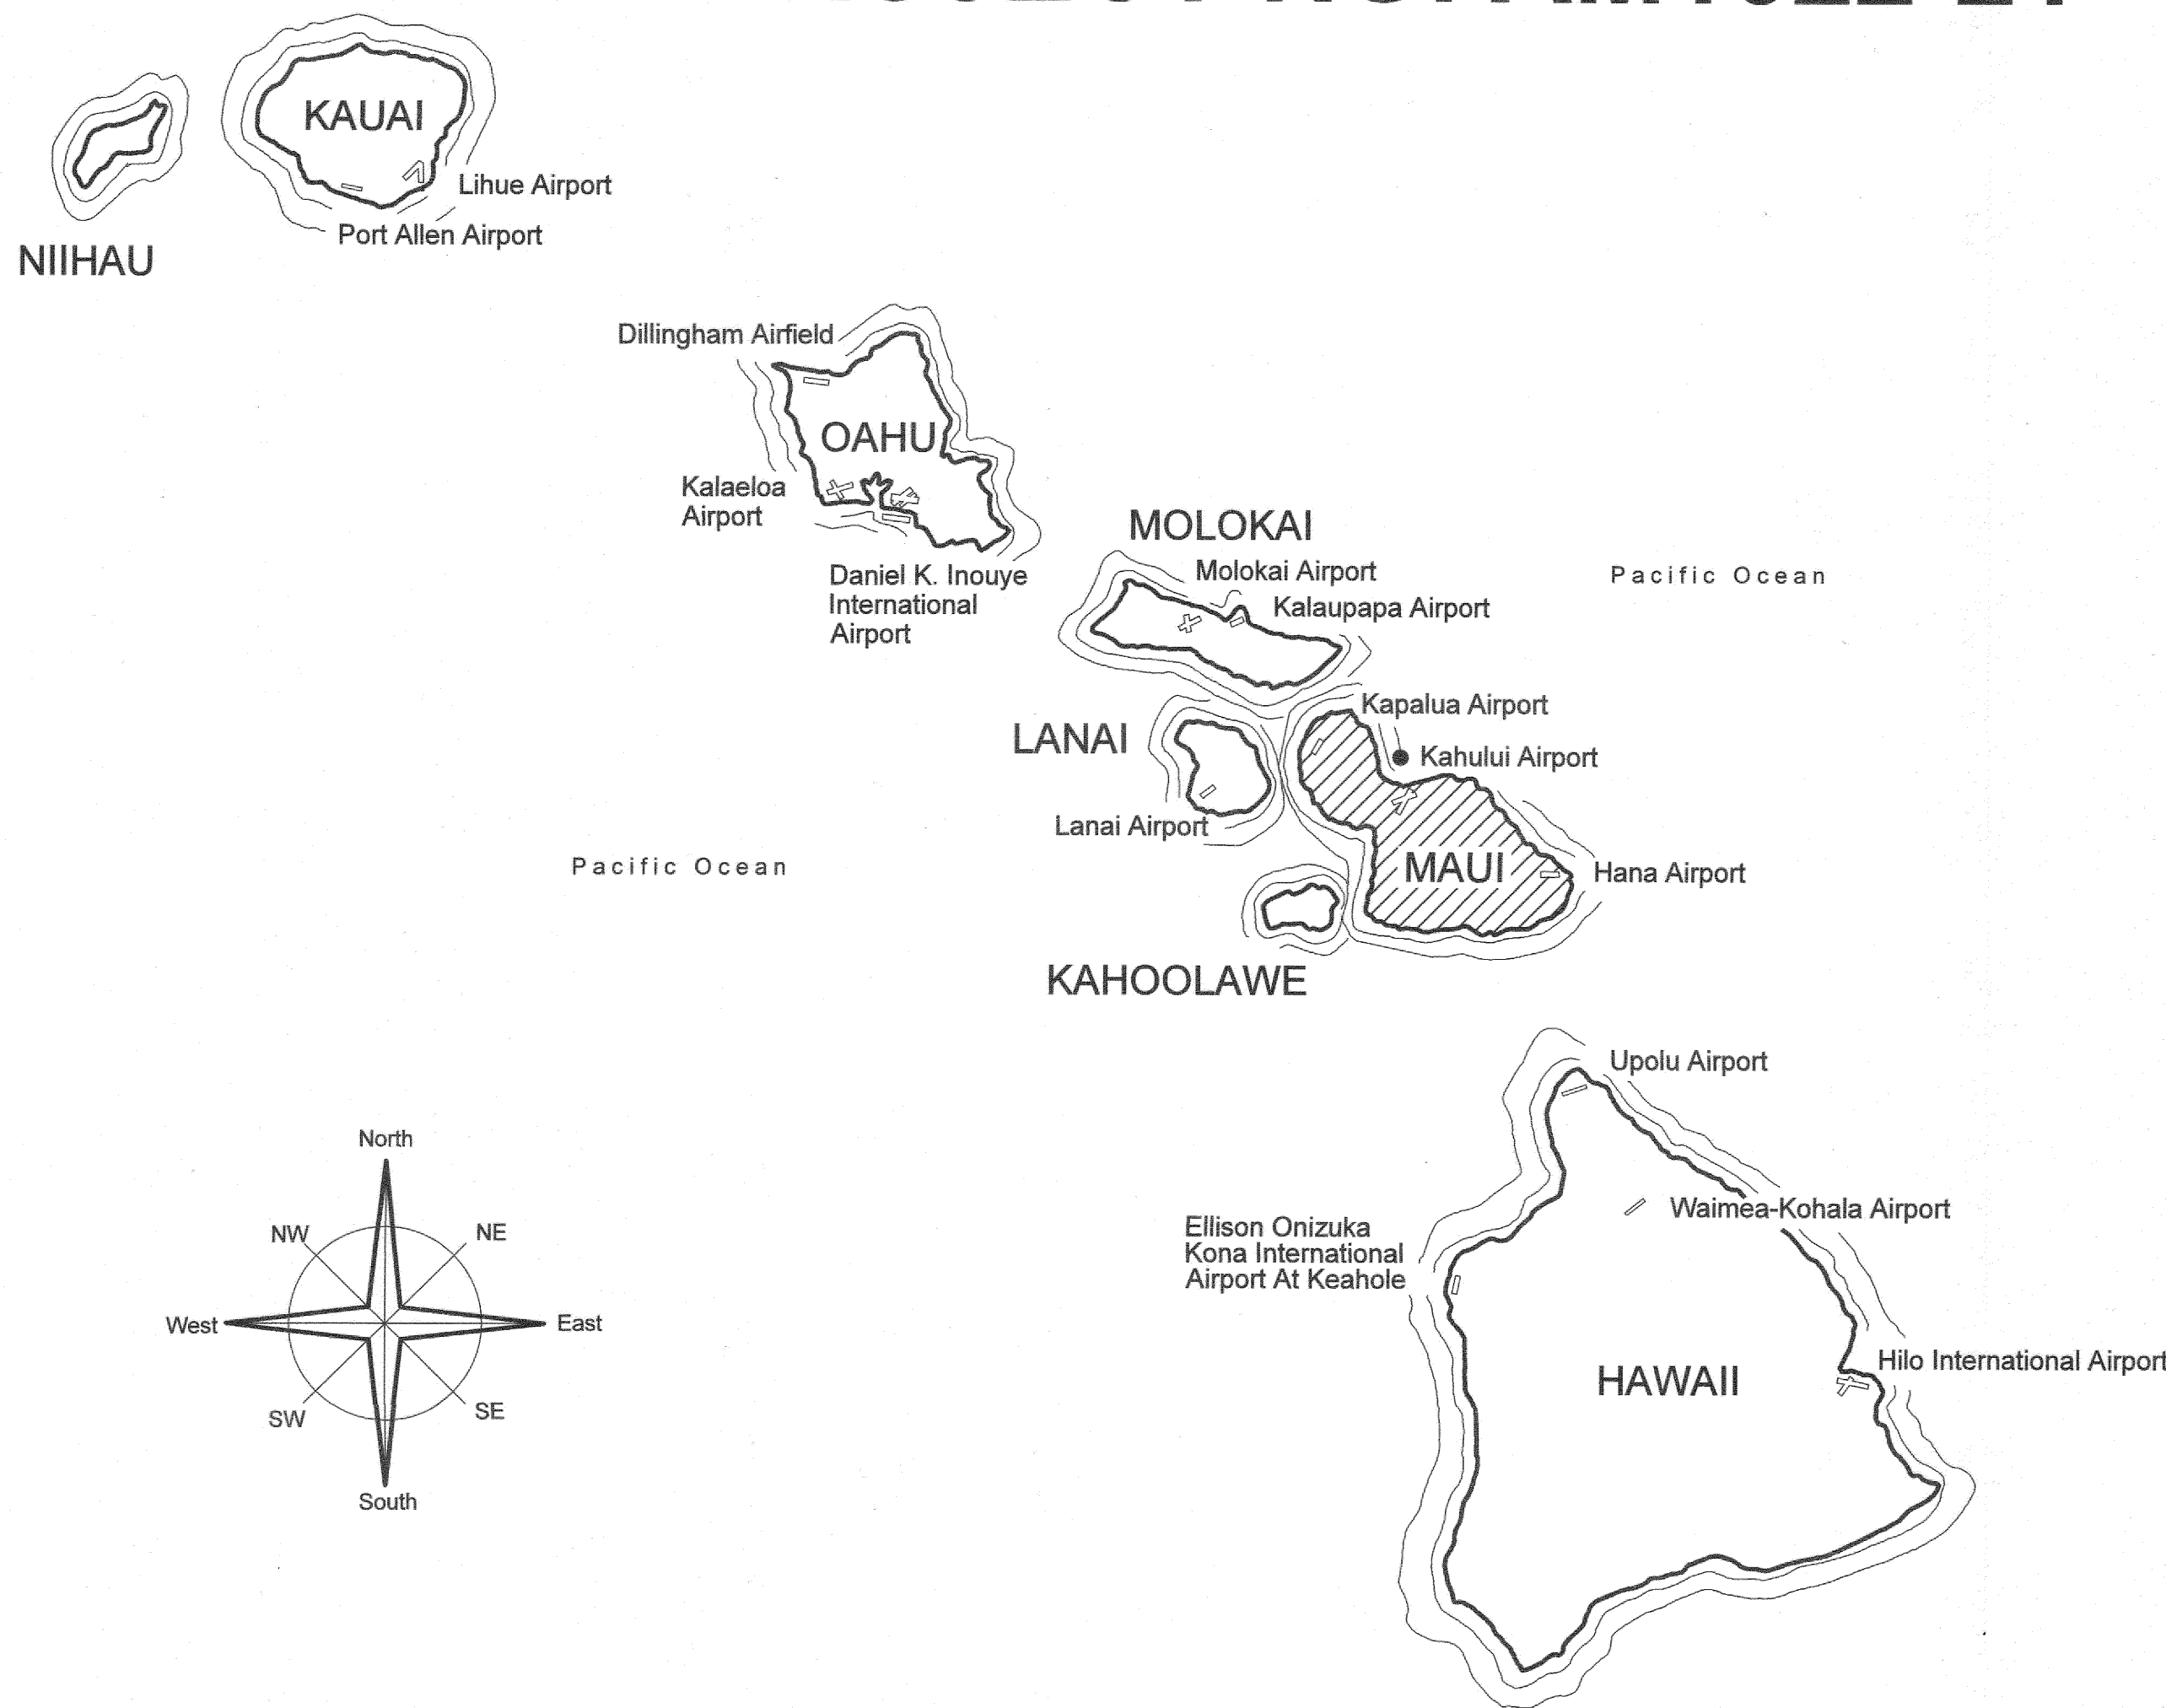

CHANGES MADE DURING CONSTRUCTION THAT WERE PROVIDED TO THE DESIGNER HAVE BEEN INCORPORATED ON THESE PLANS

SUBMITTED BY: _____ DATE _____
COMPANY NAME _____

DEPARTMENT OF TRANSPORTATION
STATE OF HAWAII

APPROVED: _____
DIRECTOR OF TRANSPORTATION

7/8/22
DATE

PROJECT TEAM

CIVIL:
ORION ENGINEERS & ASSOC
1003 BISHOP STREET, STE 2020
HONOLULU HI 96813
(808) 282-7986




I HEREBY CERTIFY THAT THIS WORK WAS PREPARED BY ME OR UNDER MY SUPERVISION

SHANNON HOLMAN
CIVIL ENGINEER

04/30/24
EXPIRATION DATE


SURVEYOR:
R.M. TOWILL CORPORATION
2024 NORTH KING STREET, SUITE 200
HONOLULU, HAWAII 96819
808-842-1133

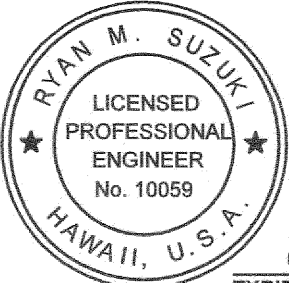

I HEREBY CERTIFY THAT THIS WORK WAS PREPARED BY ME OR UNDER MY SUPERVISION

RYAN M. SUZUKI
SURVEYOR

04/30/24
EXPIRATION DATE

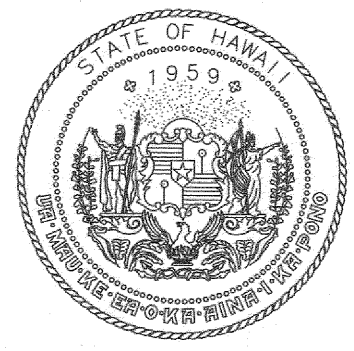

Airports Division
DEPARTMENT OF TRANSPORTATION
STATE OF HAWAII



I HEREBY CERTIFY THAT THIS WORK WAS PREPARED BY ME OR UNDER MY SUPERVISION

04/30/2024
Expiration Date

DSGN.	DRWN.	CHKD.	APPD.
TR	NM	AC	SH

KEY PLAN / NOTES:

NO.	DATE	REVISIONS
-----	------	-----------

CONSTRUCTION DOCUMENTS

JULY 11, 2022
DATE

PROJECT TITLE :

RESURFACE RUNWAY 2-20

AT
KAHULUI AIRPORT
KAHULUI, MAUI, HAWAII

PROJECT NO.:

AM1022-21

SHEET TITLE:

TITLE SHEET, PROJECT
LOCATION, & AIRPORT
VICINITY MAP

DATE :	DWG. NO.
07/11/2022	G-101
SHEET :	
1 OF 46 SHEETS	