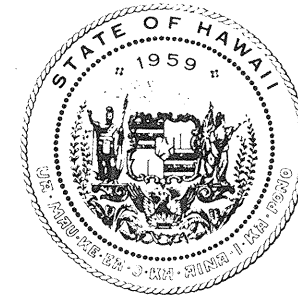


[illegible]


STATE OF HAWAII

DEPARTMENT OF TRANSPORTATION

HIGHWAYS DIVISION

DISTRICT OF MOLOKAI
ISLAND OF MOLOKAI


LAYOUT PLAN

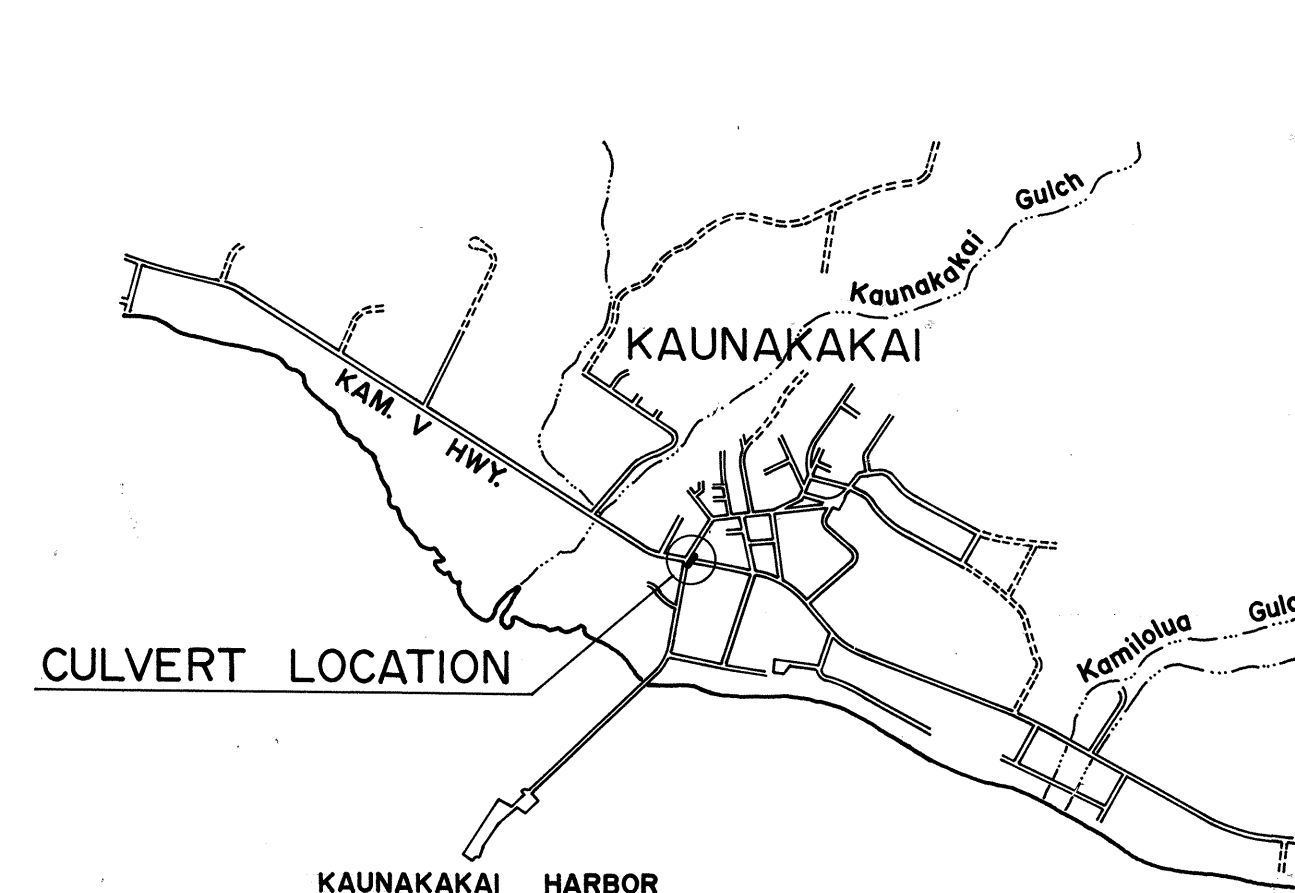

2 0 2 4

SCALE IN THOUSAND FEET

FED. ROAD DIST. NO.	STATE	FED. AID PROJ. NO.	FISCAL YEAR	SHEET NO.	TOTAL SHEETS
HAWAII	HAW.	RS-0900(14)	1981	1	1011

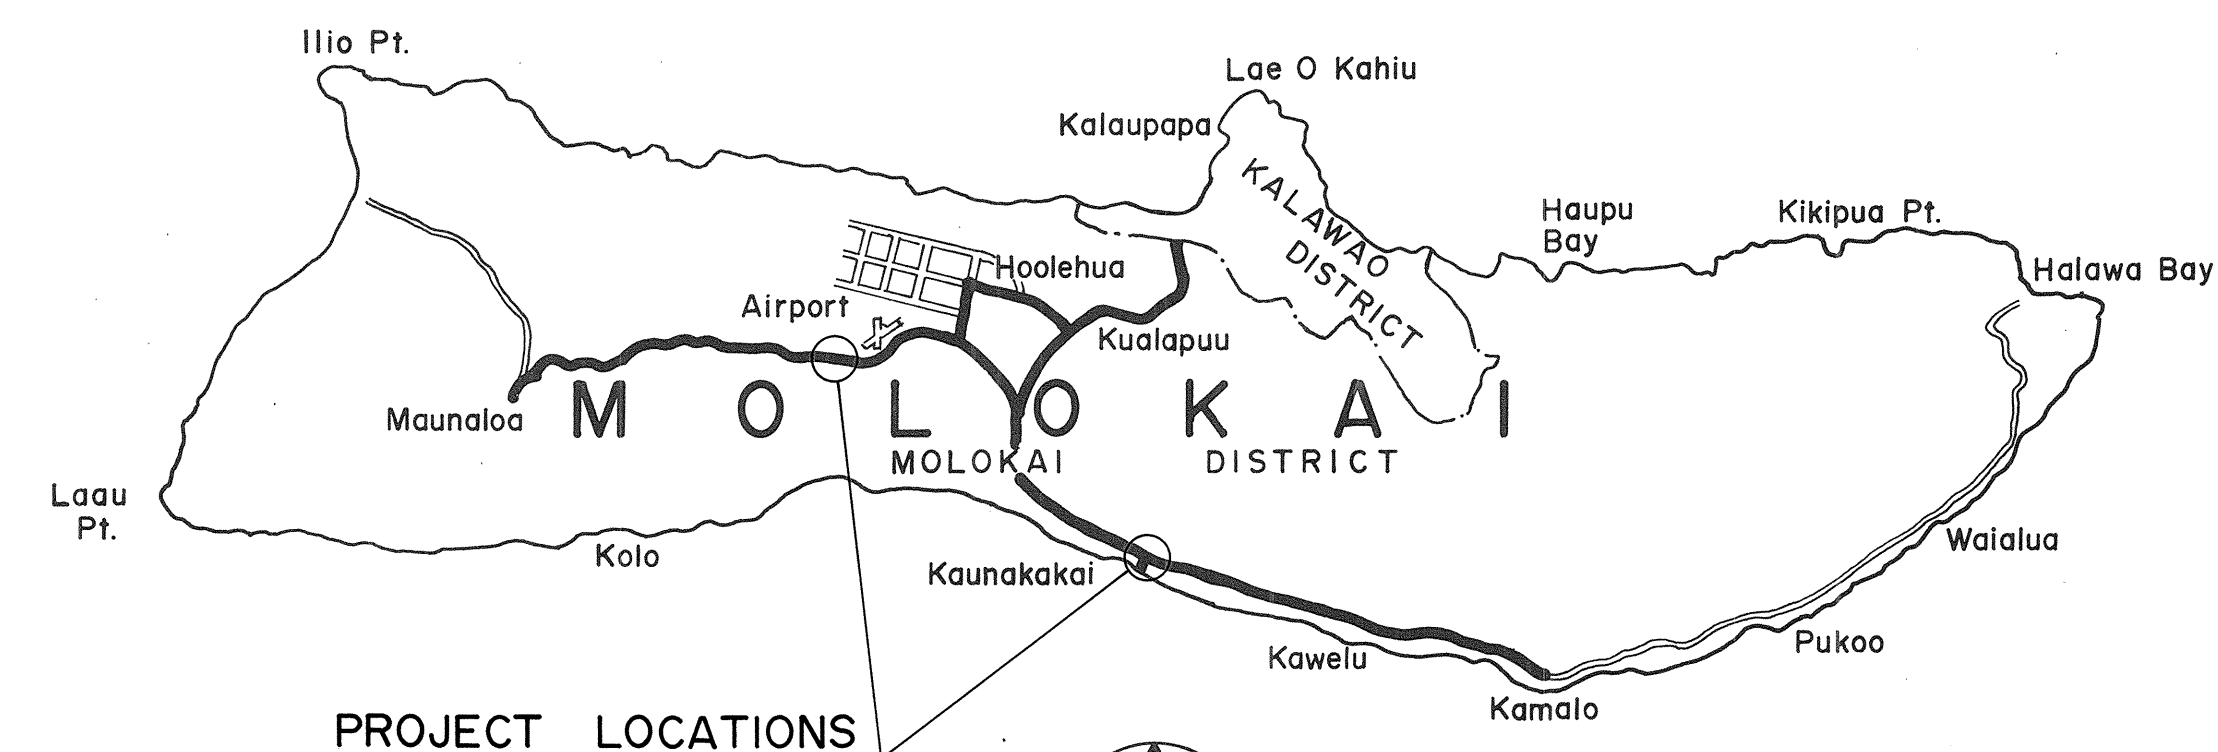

FEDERAL AID PROJECTS PREVIOUSLY CONSTRUCTED
OR UNDER CONSTRUCTION

	MAUNALO A HIGHWAY	KAMEHAMEHA V HIGHWAY
CURRENT ADT (1980)	1,570	1,290
DESIGN ADT (2000)	3,470	2,230
DHV	370	250
D	65/35	65/35
T	13.5%	7.0%
T24	14.0%	4.5%
K	10.5%	11.0%

ALL CHANGES MADE DURING CONSTRUCTION HAVE
BEEN INCORPORATED ON THESE PLANS IN RED
EXCEPT CHANGES IN THE ORIGINAL THEORETICAL
QUANTITIES. FOR ACTUAL QUANTITIES, REFER TO
PROJECT LEDGER AND/OR COMPUTATION BOOK.

Manuel J. Silva
RESIDENT ENGINEER

23 Aug. 82
DATE

DEPARTMENT OF TRANSPORTATION
STATE OF HAWAII

APPROVED:
James R. Carras 2/13/88

DIR. OF TRANSPORTATION DATE