
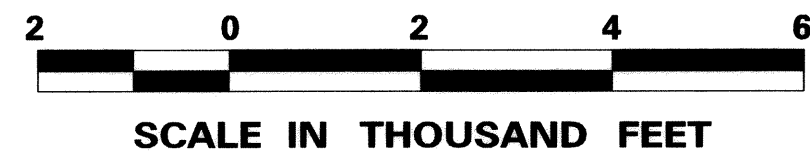
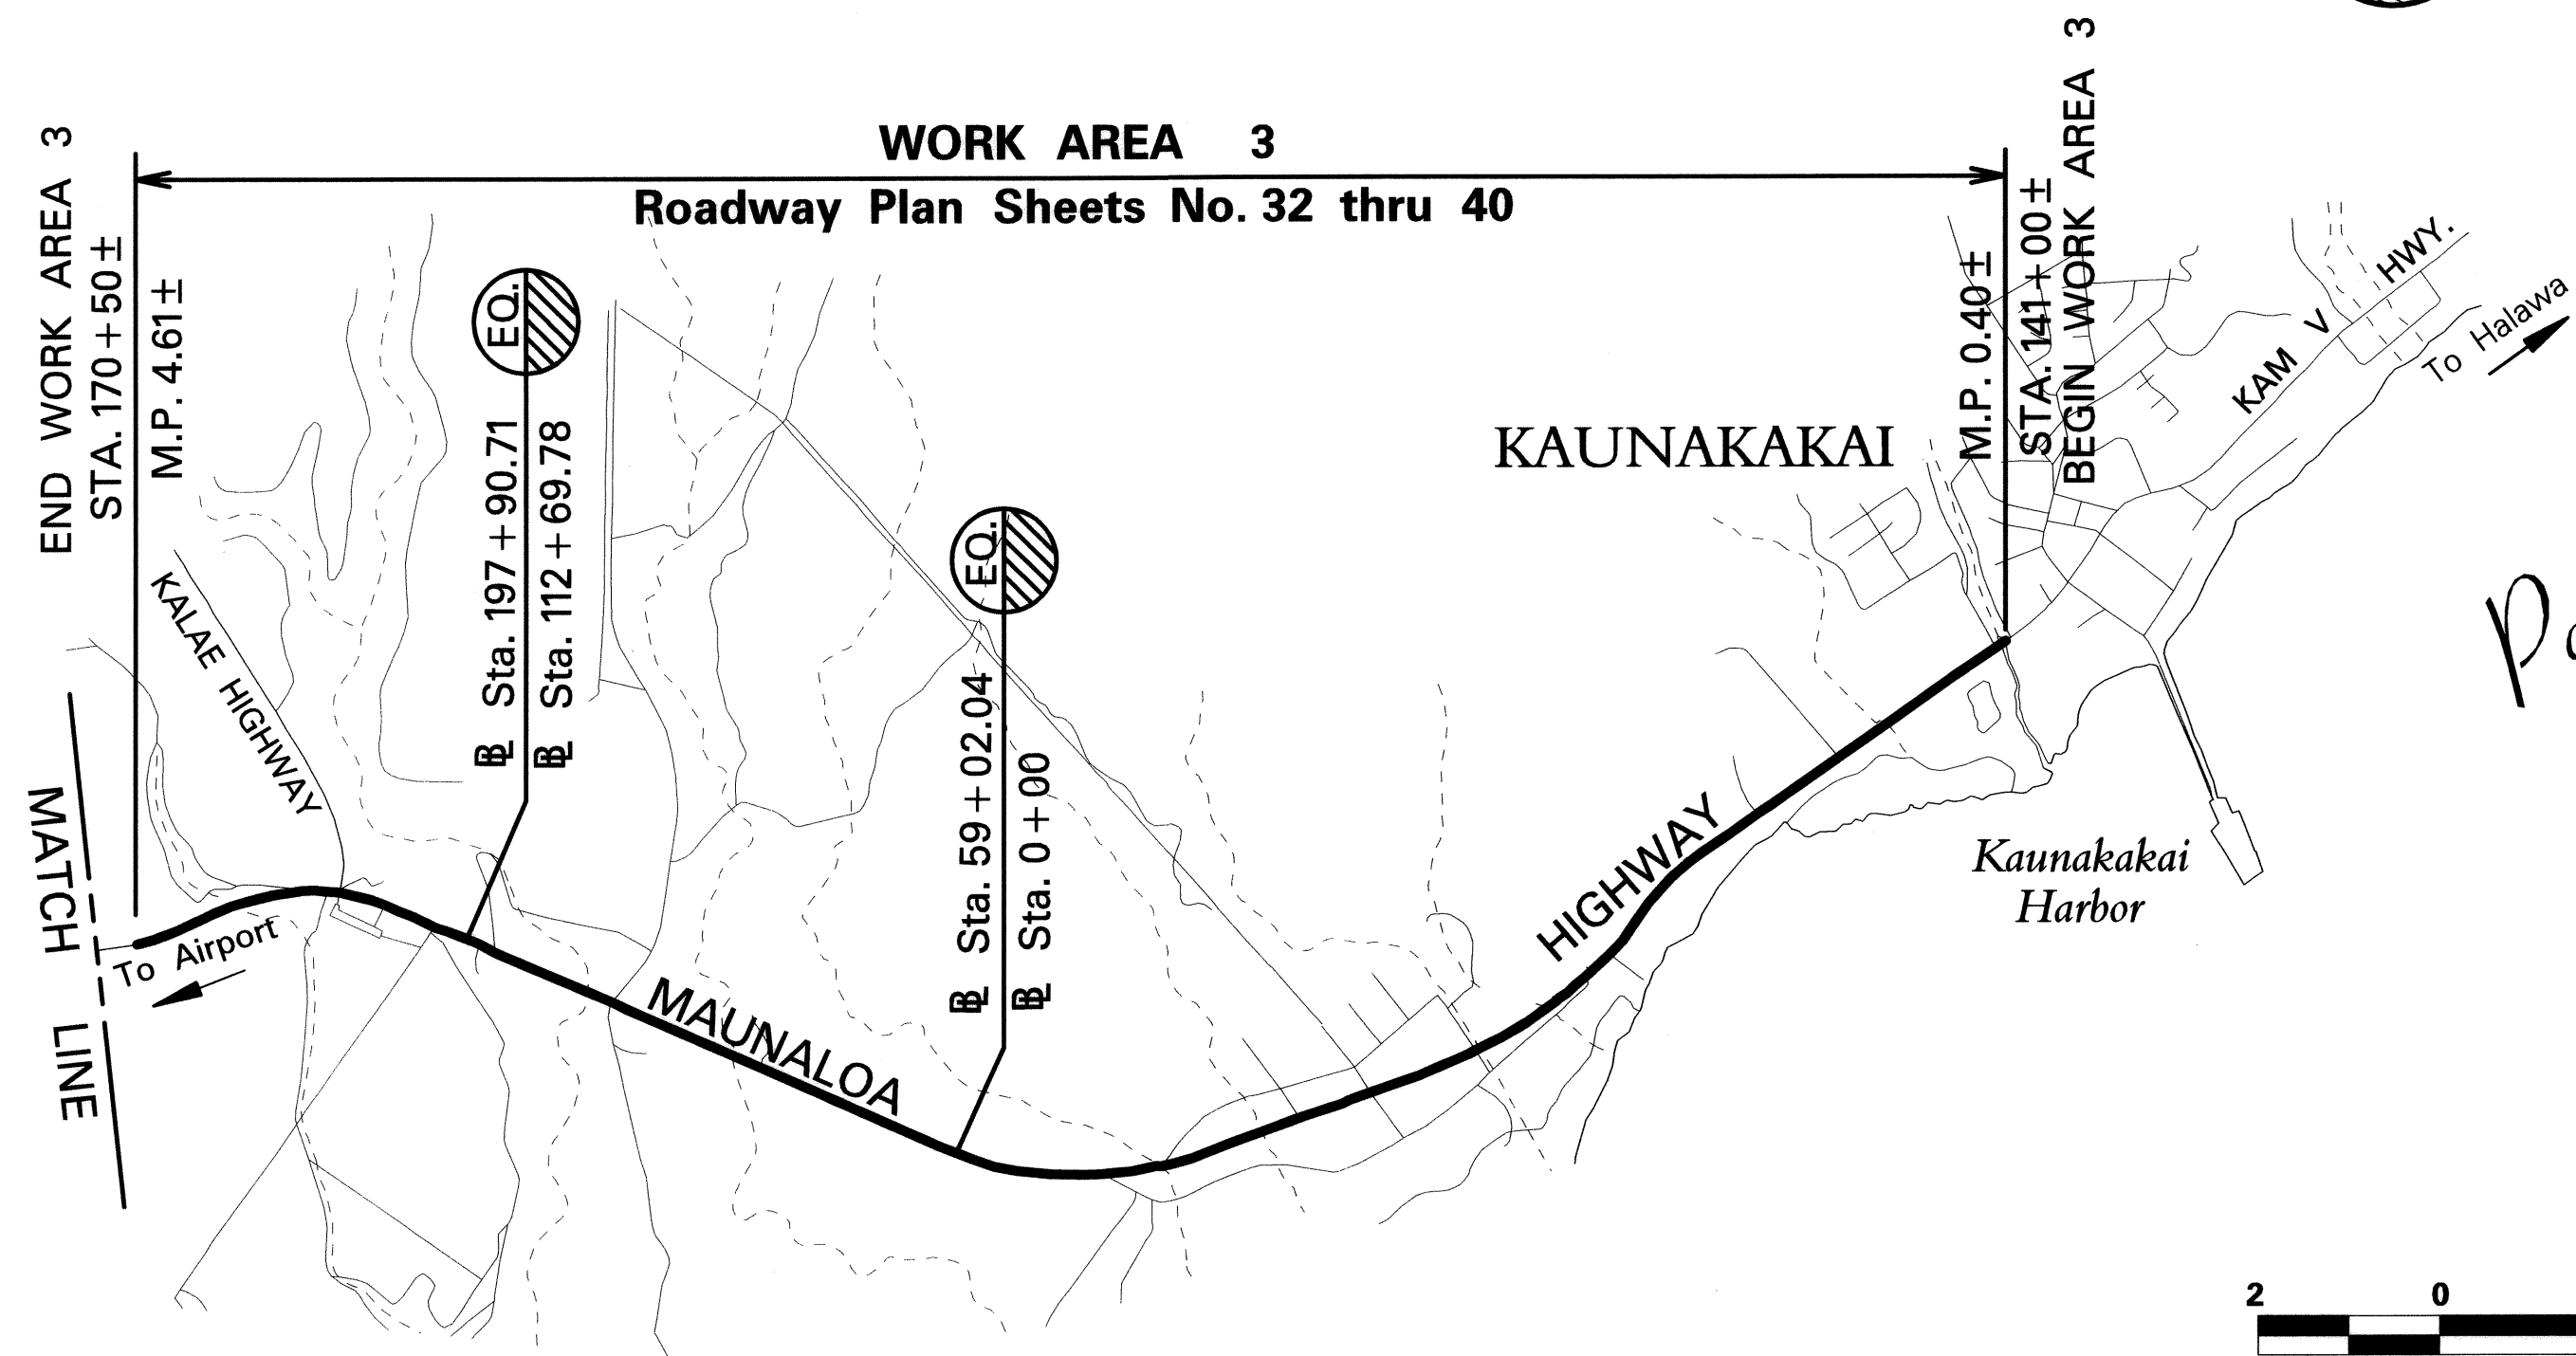


FED. ROAD DIST. NO.	STATE	FED. AID PROJ. NO.	FISCAL YEAR	SHEET NO.	TOTAL SHEETS
HAWAII	HAW.	STP-0900(076)	2012	21	47

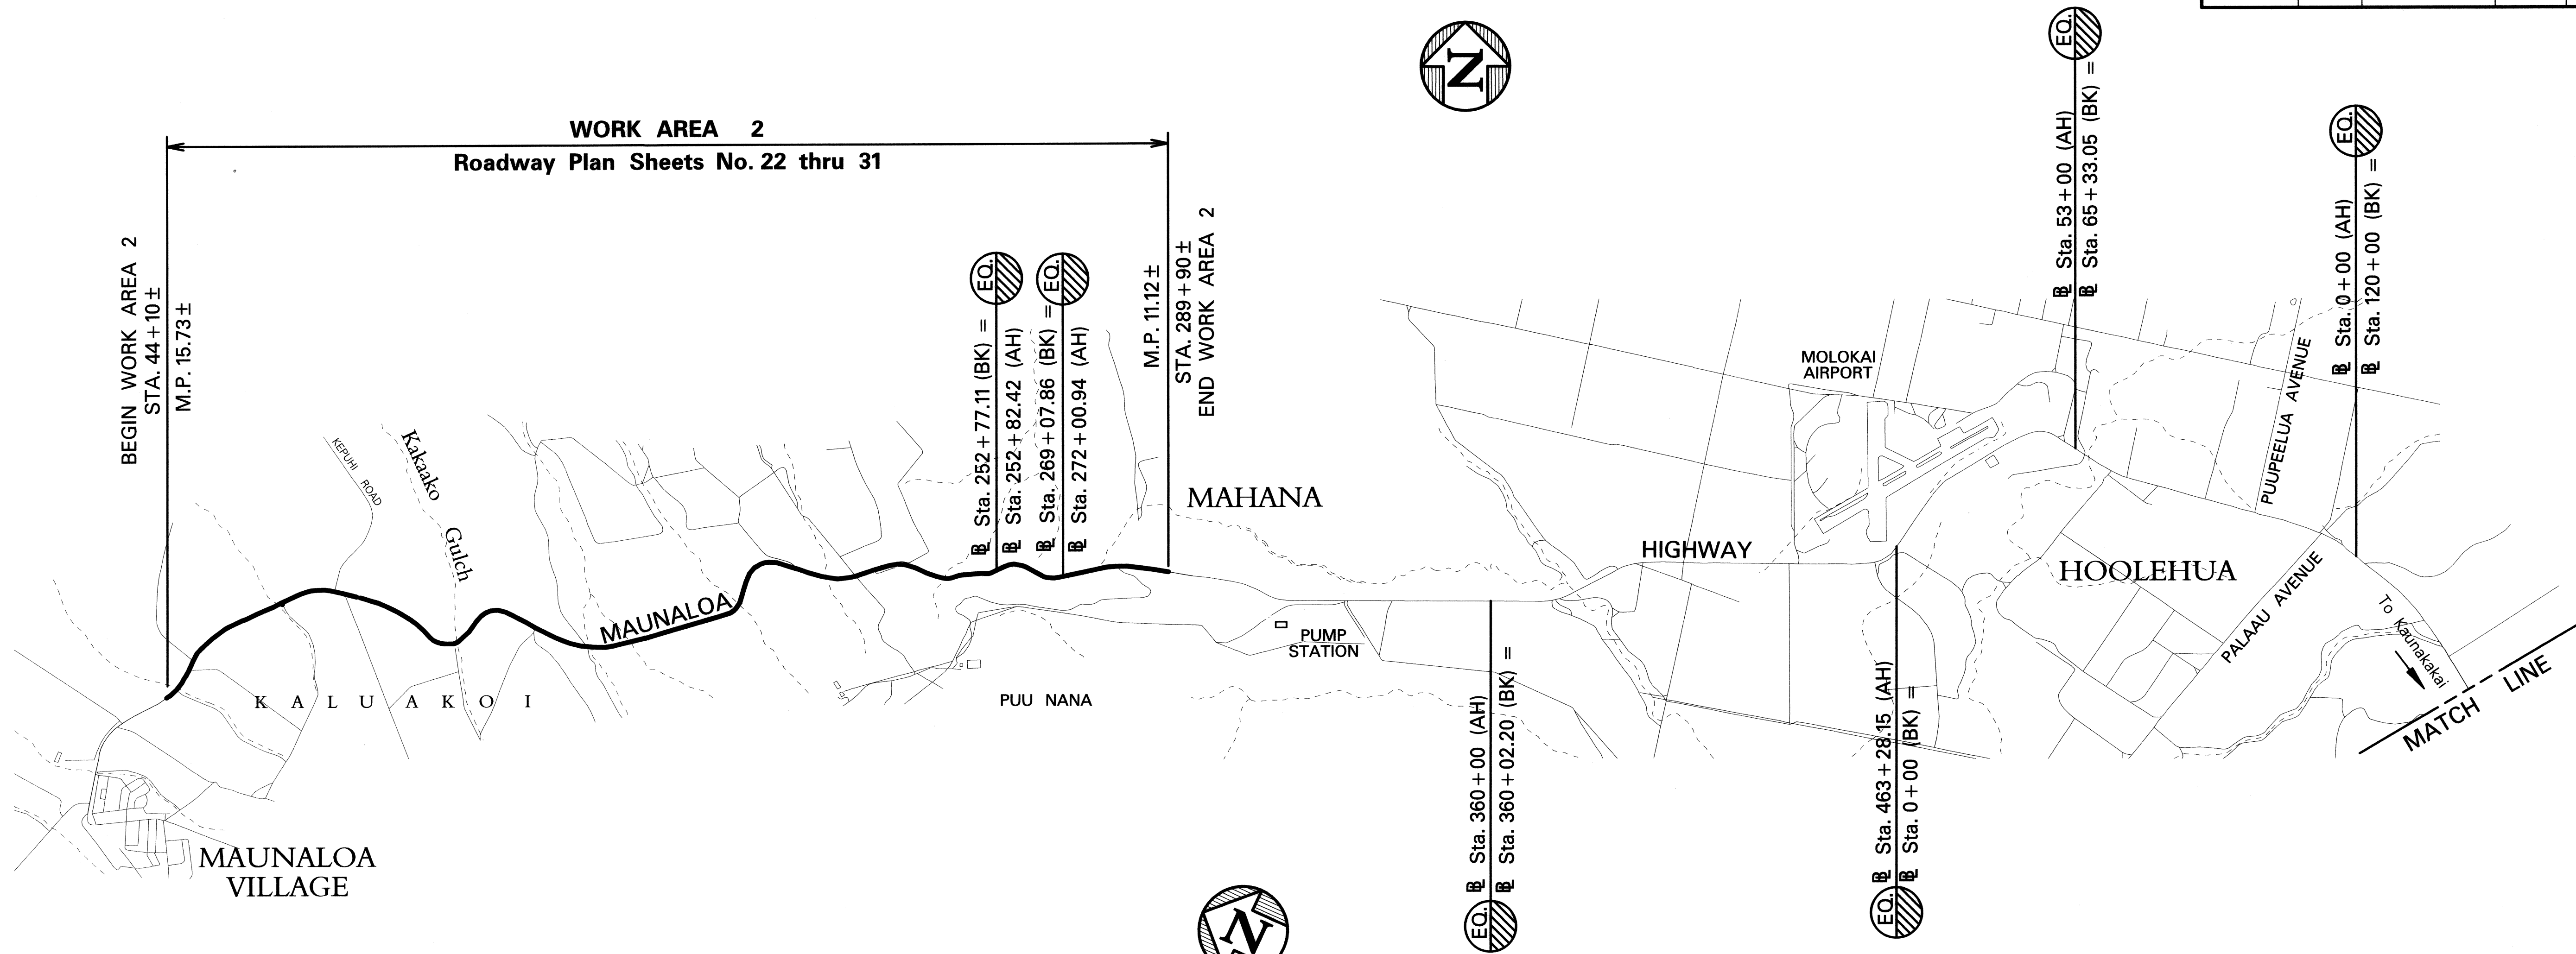

LAYOUT PLAN

GROSS LENGTH OF PROJECT.....X MILES

NET LENGTH OF PROJECT.....X MILES

STATE OF HAWAII
DEPARTMENT OF TRANSPORTATION
HIGHWAYS DIVISION

LAYOUT PLANS NO. 2 & 3

GUARDRAIL & SHOULDER IMPROVEMENT

At Various Locations, Molokai

Federal-Aid Project No. STP-0900(076)

Scale: As Shown Date: July, 2011

SHEET No. 1 OF 1 SHEETS

ORIGINAL PLAN	SURVEY PLOTTED BY	DATE
NOTE BOOK	DRAWN BY	
	DESIGNED BY	
	CHECKED BY	