
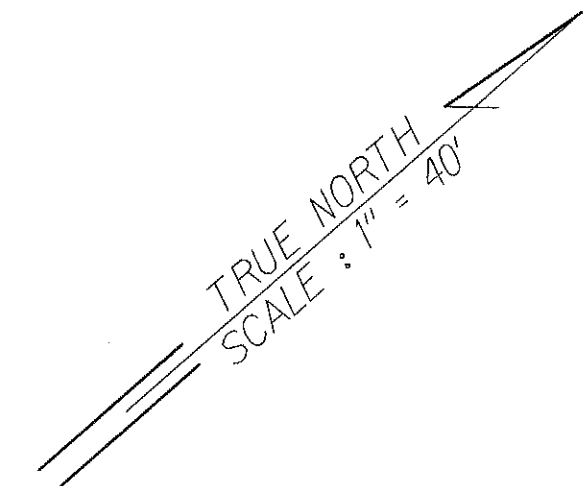


FED. ROAD DIST. NO.	STATE	FED. AID PROJ. NO.	FISCAL YEAR	SHEET NO.	TOTAL SHEETS
HAWAII	HAW.	STP-0900(076)	2012	42	47

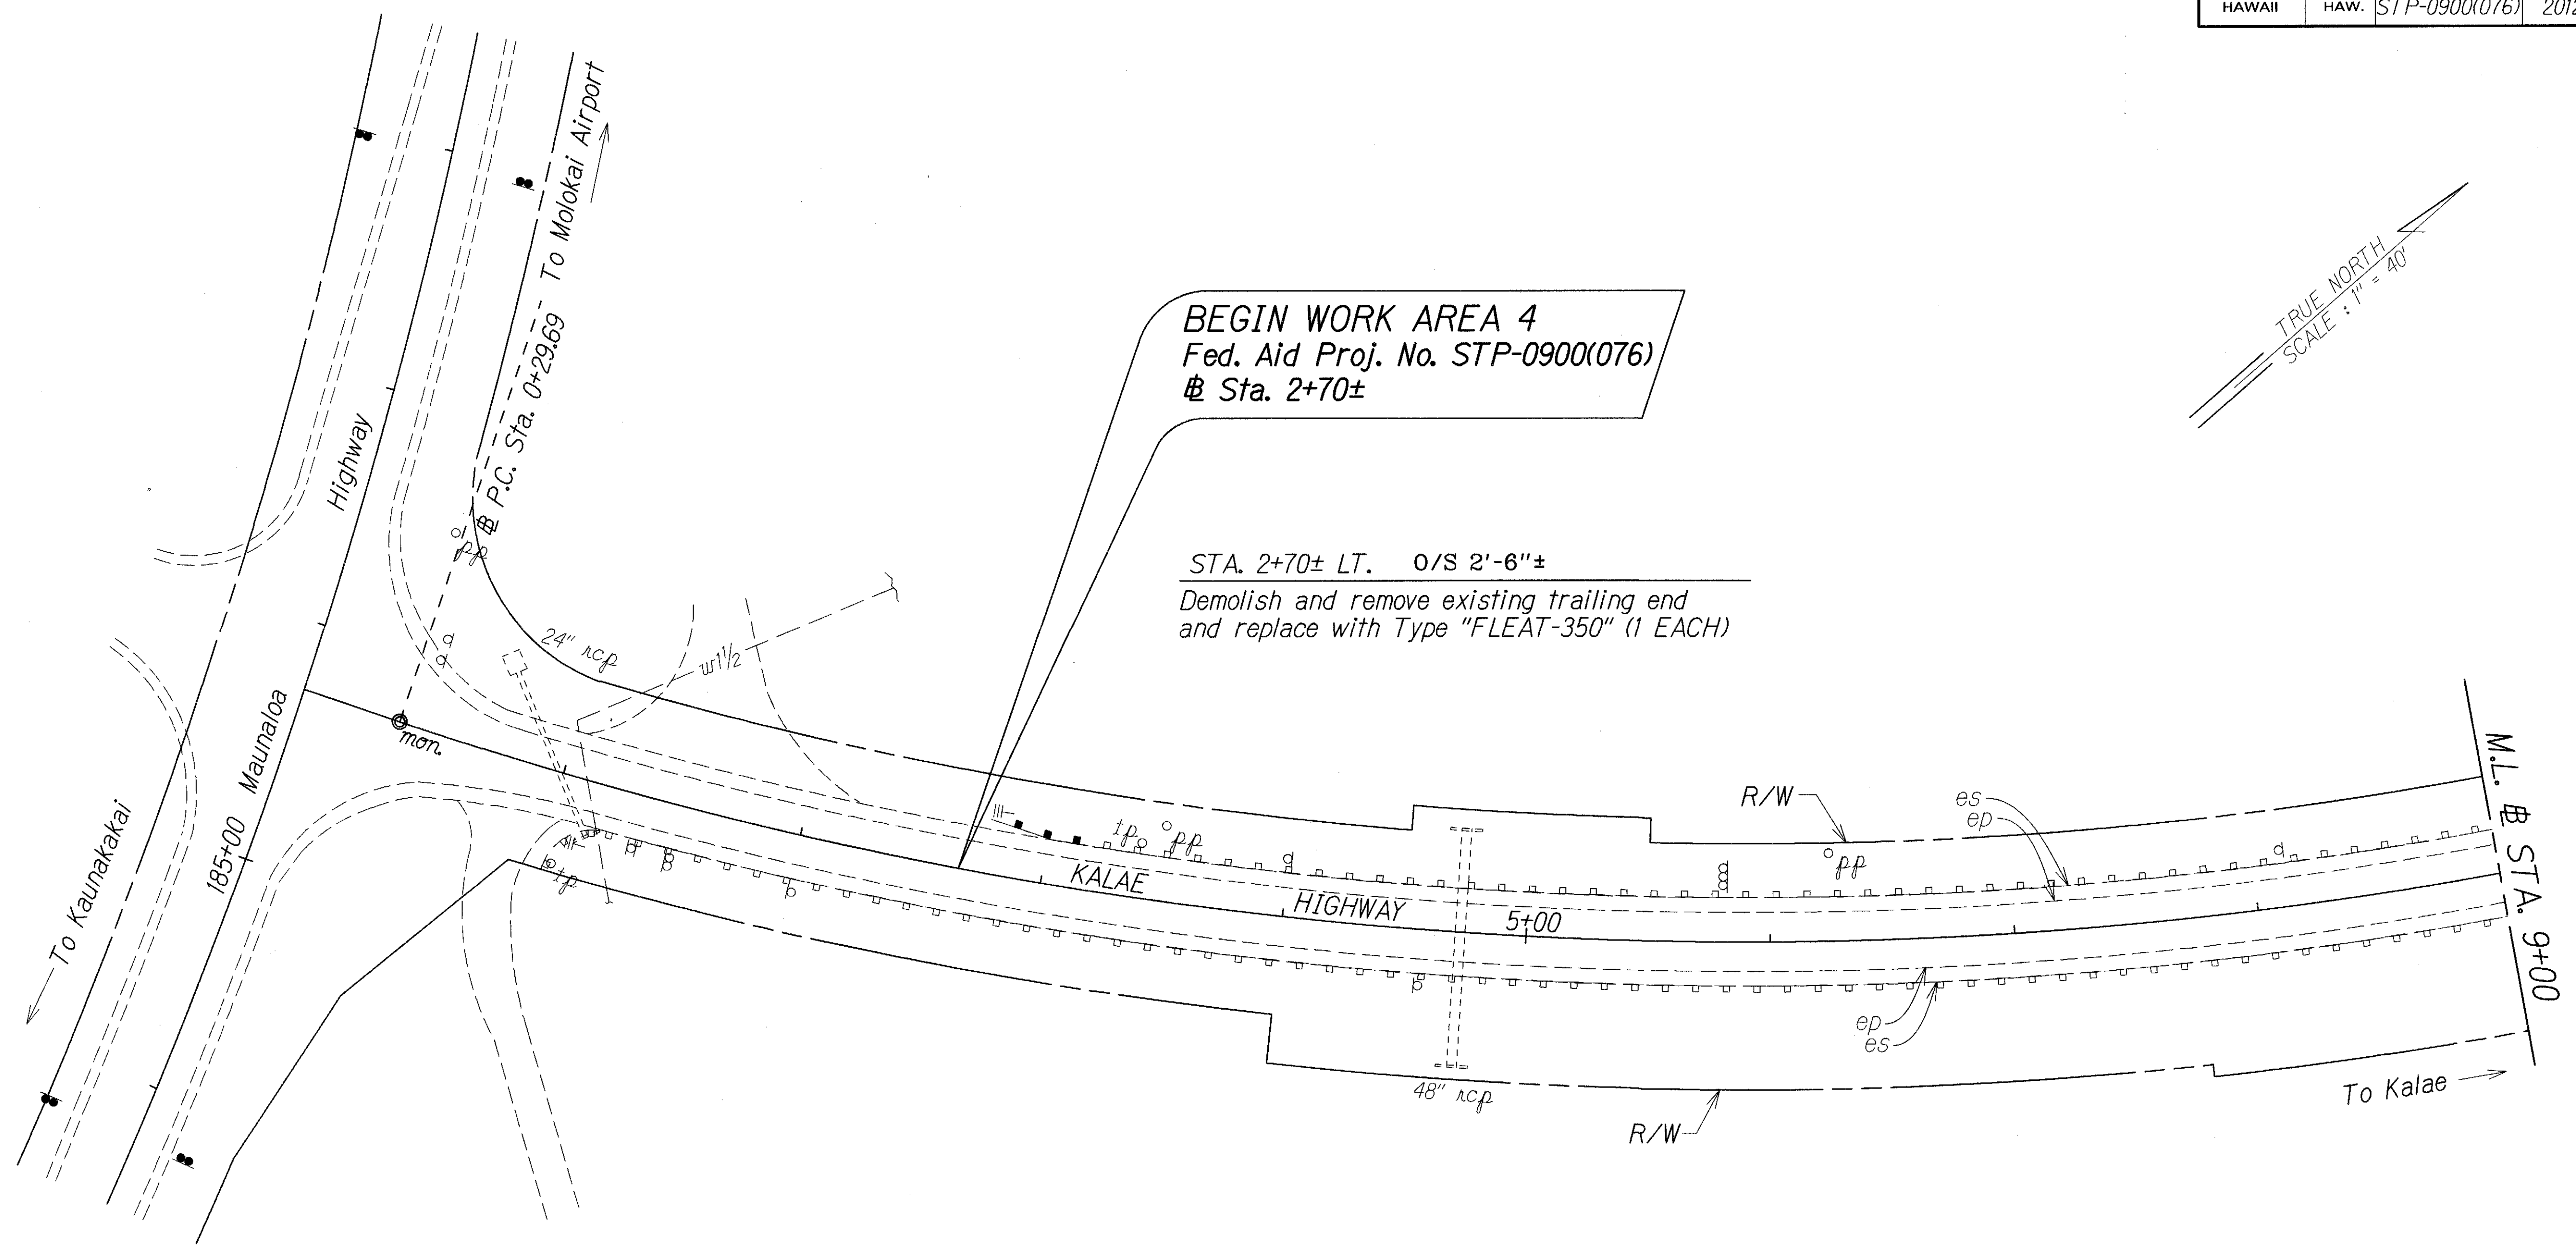

SURVEY PLOTTED BY	DATE
DRAWN BY	
DESIGNED BY	
QUANTITIES BY	
CHECKED BY	

LEGEND FOR AS-BUILT POSTINGS	
	Squiggly line for as-built deletion
	Double line for as-built deletion
Roadway	Text for as-built posting

STATE OF HAWAII
DEPARTMENT OF TRANSPORTATION
HIGHWAYS DIVISION



ROADWAY PLAN

GUARDRAIL & SHOULDER IMPROVEMENT
At Various Locations, Molokai
Federal-Aid Project No. STP-0900(076)

Scale: 1" = 40' Date: July, 2011

SHEET No. 1 OF 6 SHEETS

FED. ROAD DIST. NO.	STATE	FED. AID PROJ. NO.	FISCAL YEAR	SHEET NO.	TOTAL SHEETS
HAWAII	HAW.	STP-0900(076)	2012	43	47

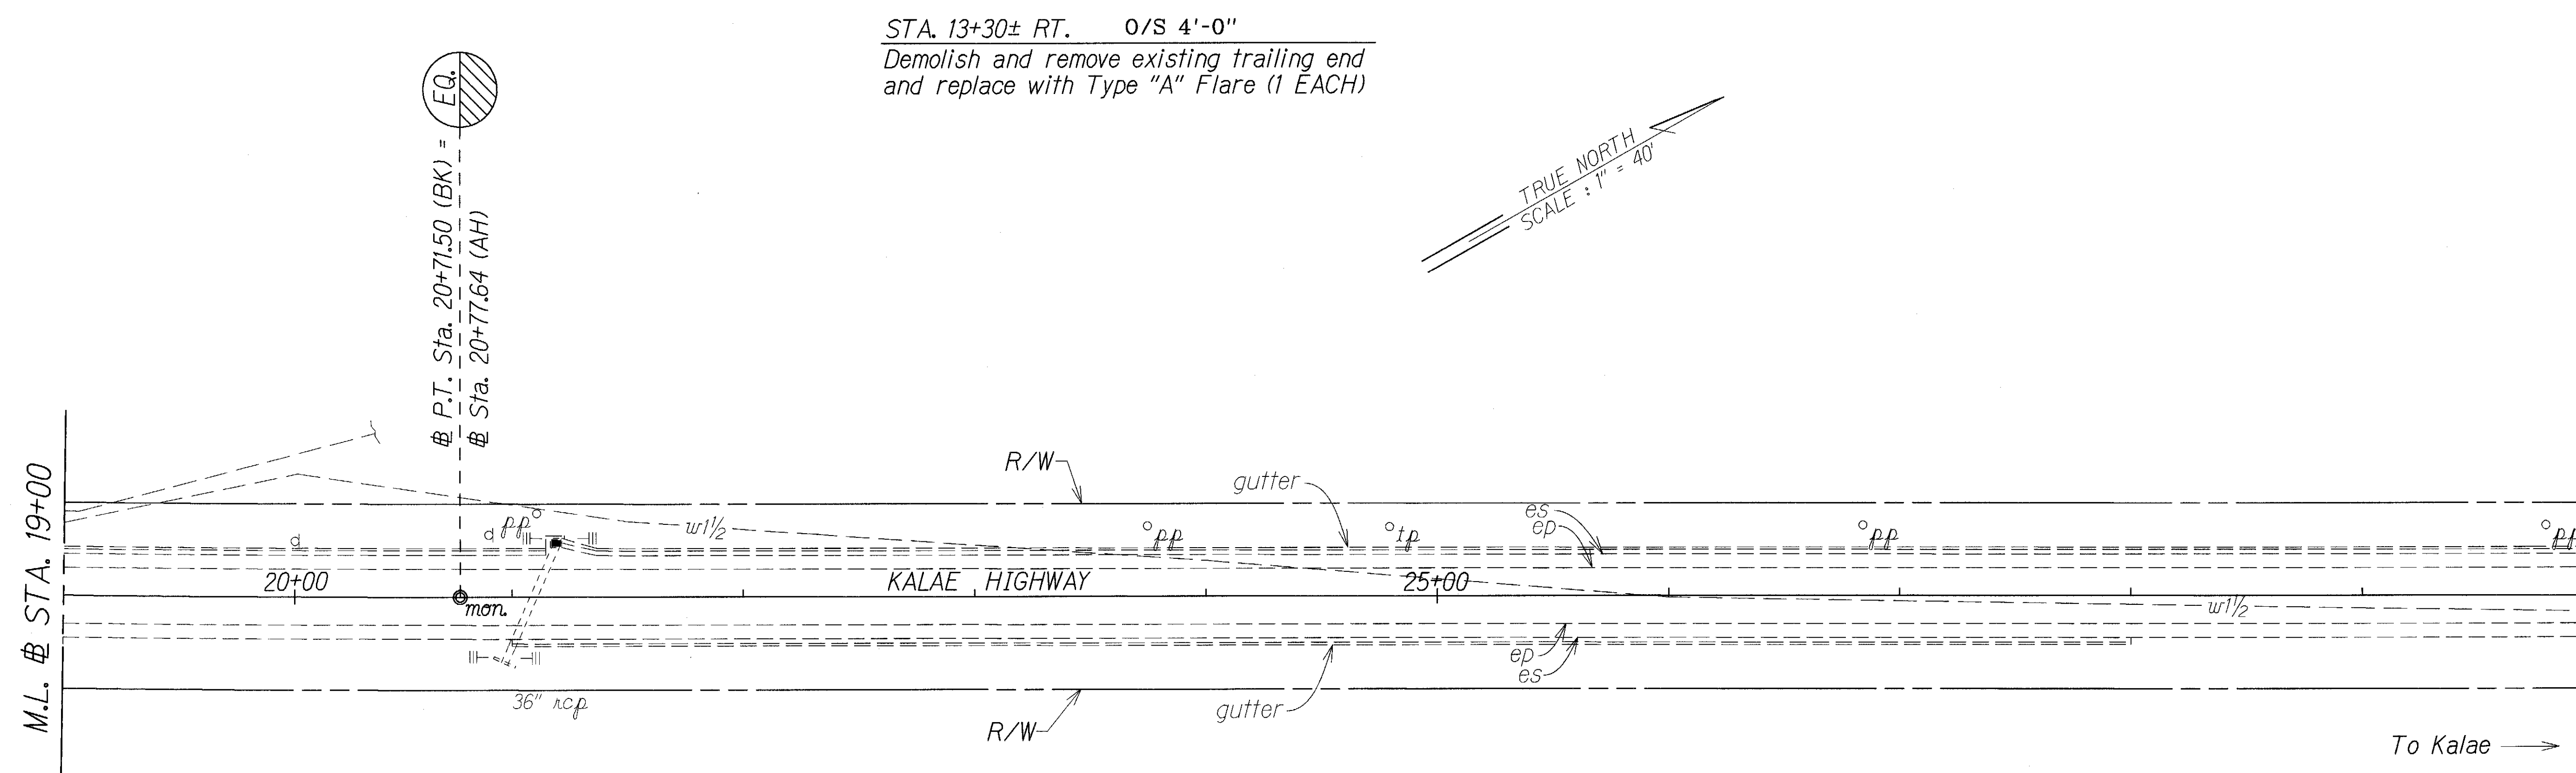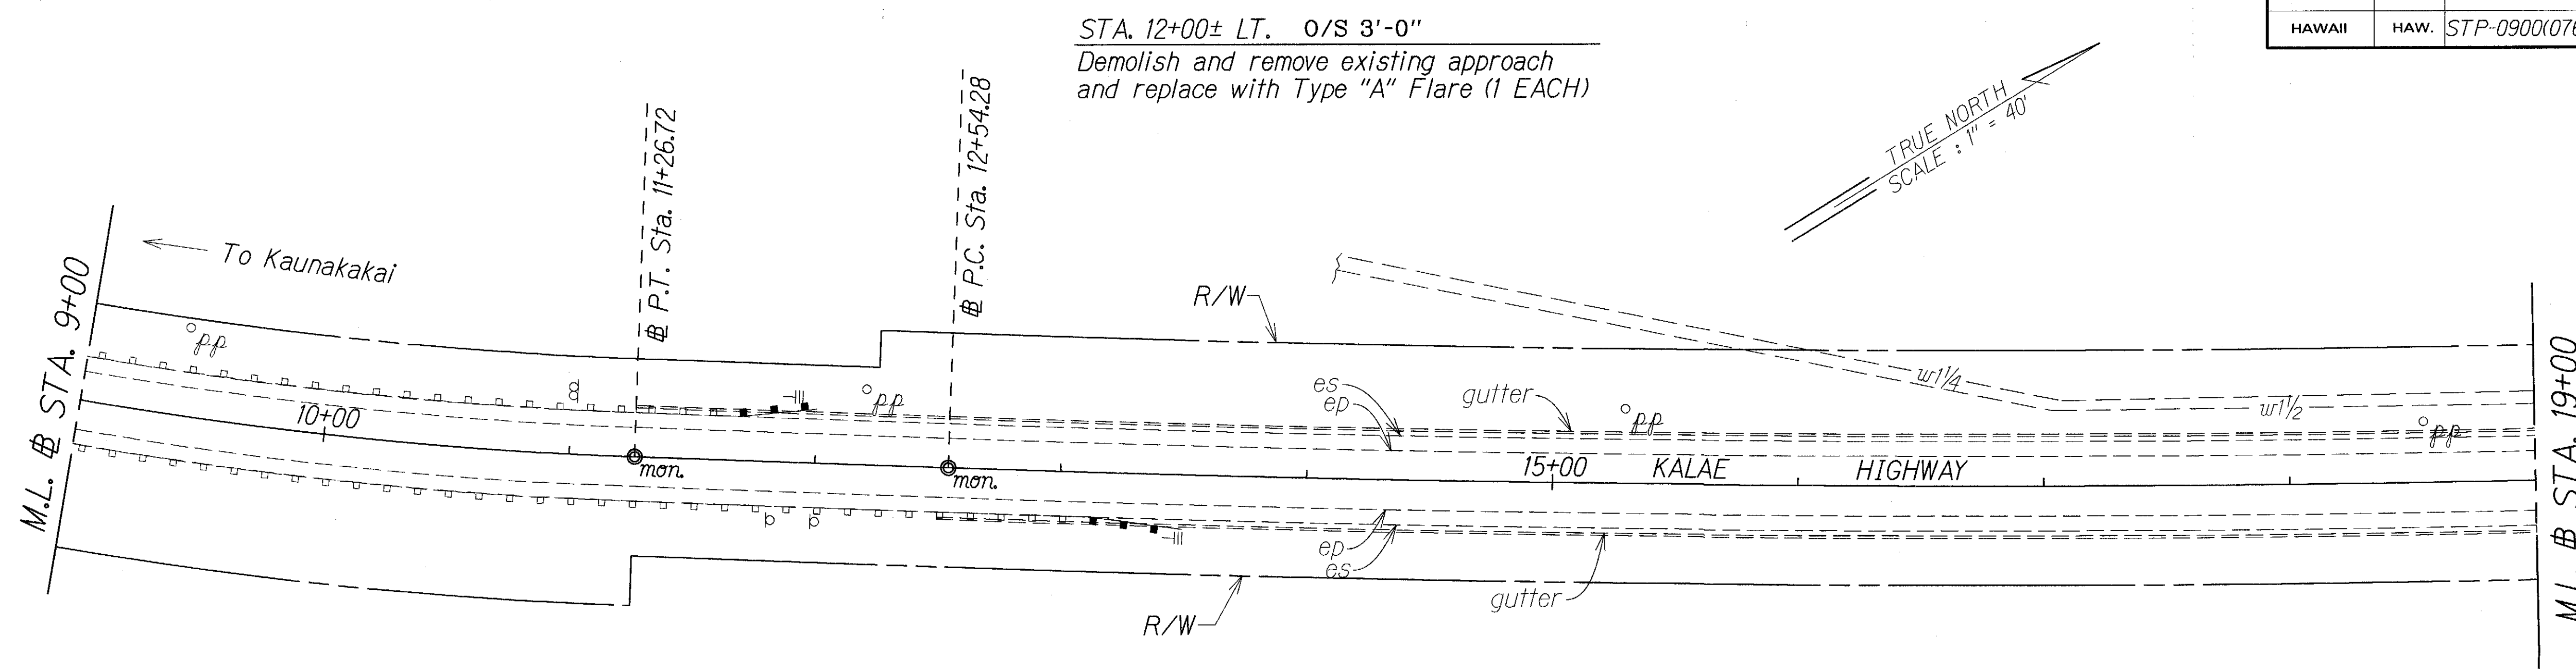

ORIGINAL PLAN	SURVEY PLOTTED BY _____ DATE _____
NOTE BOOK	DRAWN BY <i>A</i> _____ * <i>X</i> _____
<i>add.x</i>	TRACED BY _____ * _____
<i>legn</i>	DESIGNED BY <i>X</i> _____ * _____
<i>N.</i>	QUANTITIES BY _____ * _____
	CHECKED BY _____ * _____

LEGEND FOR AS-BUILT POSTINGS	
	Squiggly line for as-built deletion
400-00	Double line for as-built deletion
Roadway	Text for as-built posting

STATE OF HAWAII
DEPARTMENT OF TRANSPORTATION
HIGHWAYS DIVISION

ROADWAY PLAN

GUARDRAIL & SHOULDER IMPROVEMENT


At Various Locations, Molokai

Federal-Aid Project No. STP-0900(076)


Scale: 1" = 40' Date: July, 2011

SHEET No. 2 OF 6 SHEETS

FED. ROAD DIST. NO.	STATE	FED. AID PROJ. NO.	FISCAL YEAR	SHEET NO.	TOTAL SHEETS
HAWAII	HAW.	STP-0900(076)	2012	44	47

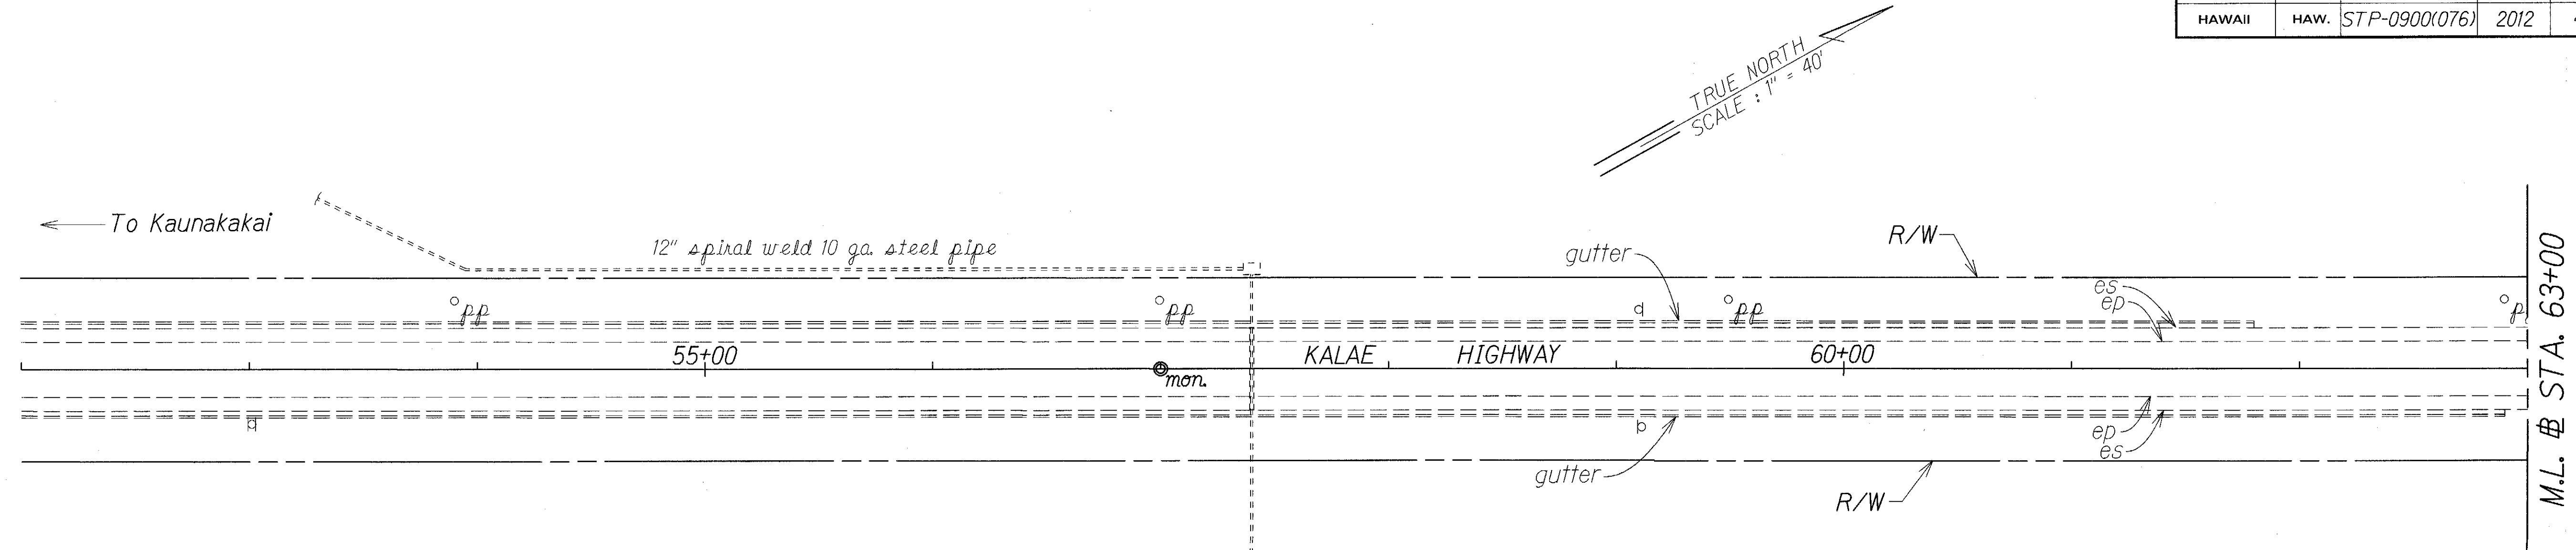

STA. 63+80± LT. 0/S 2'-6"±
Demolish and remove existing trailing end and replace with Type "FLEAT-350" (1 EACH)

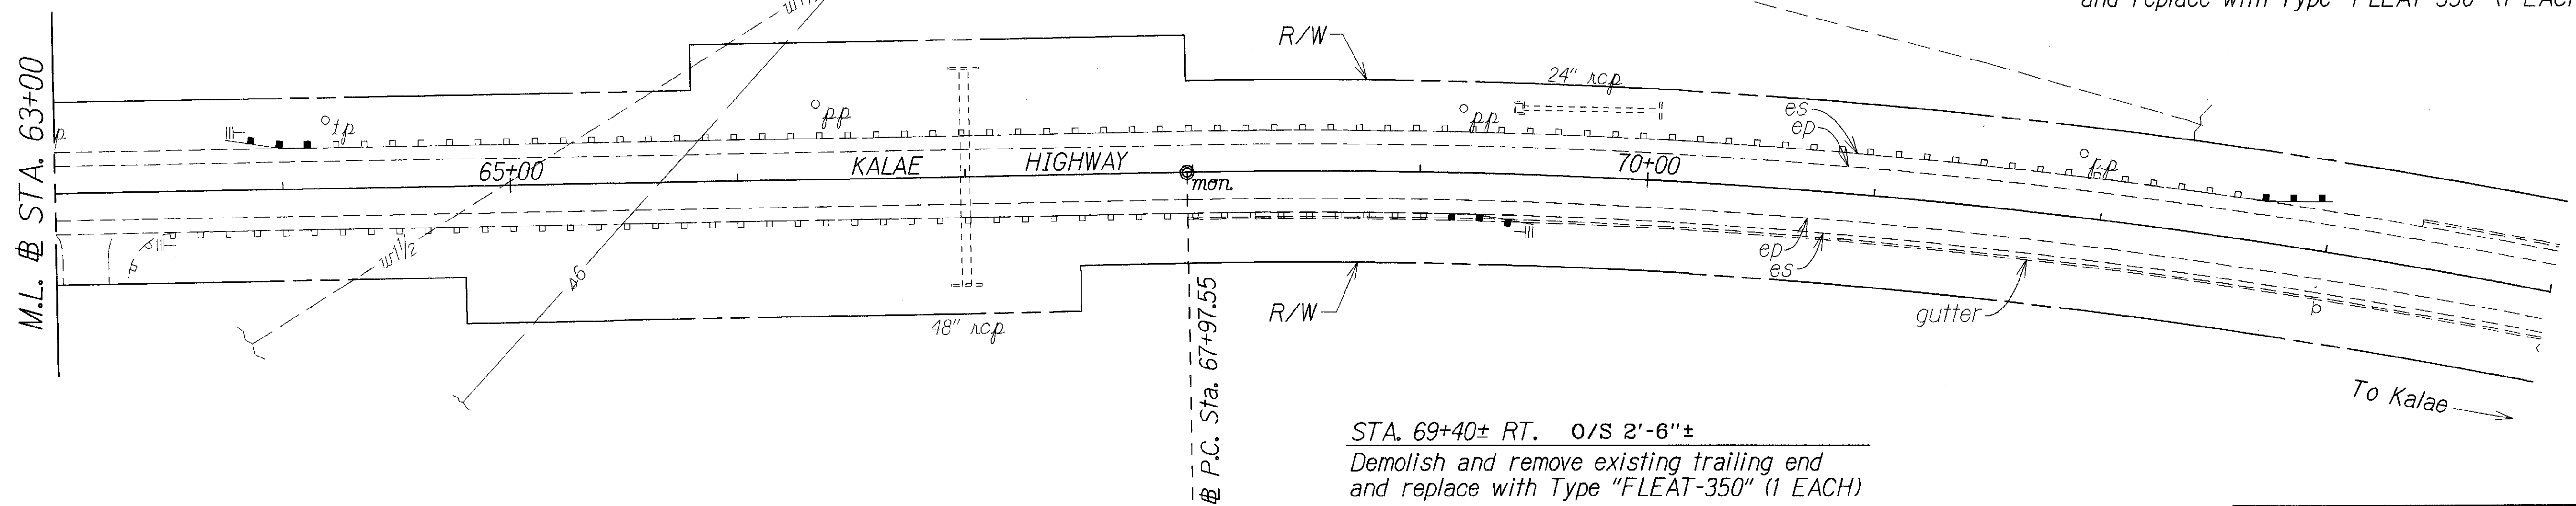

STA. 73+00± LT. 0/S 2'-5"
Demolish and remove existing approach and replace with Type "FLEAT-350" (1 EACH)


STA. 69+40± RT. 0/S 2'-6"±
Demolish and remove existing trailing end and replace with Type "FLEAT-350" (1 EACH)

ORIGINAL PLAN	SURVEY PLOTTED BY	DATE
NOTE BOOK	DRAWN BY	
DESIGNED BY	CHECKED BY	
QUANTITIES BY		

LEGEND FOR AS-BUILT POSTINGS	
	Squiggly line for as-built deletion
	Double line for as-built deletion
Roadway	Text for as-built posting

STATE OF HAWAII
DEPARTMENT OF TRANSPORTATION
HIGHWAYS DIVISION
ROADWAY PLAN
GUARDRAIL & SHOULDER IMPROVEMENT
At Various Locations, Molokai
Federal-Aid Project No. STP-0900(076)
Scale: 1" = 40' Date: July, 2011
SHEET No. 3 OF 6 SHEETS

FED. ROAD DIST. NO.	STATE	FED. AID PROJ. NO.	FISCAL YEAR	SHEET NO.	TOTAL SHEETS
HAWAII	HAW.	STP-0900(076)	2012	45	47

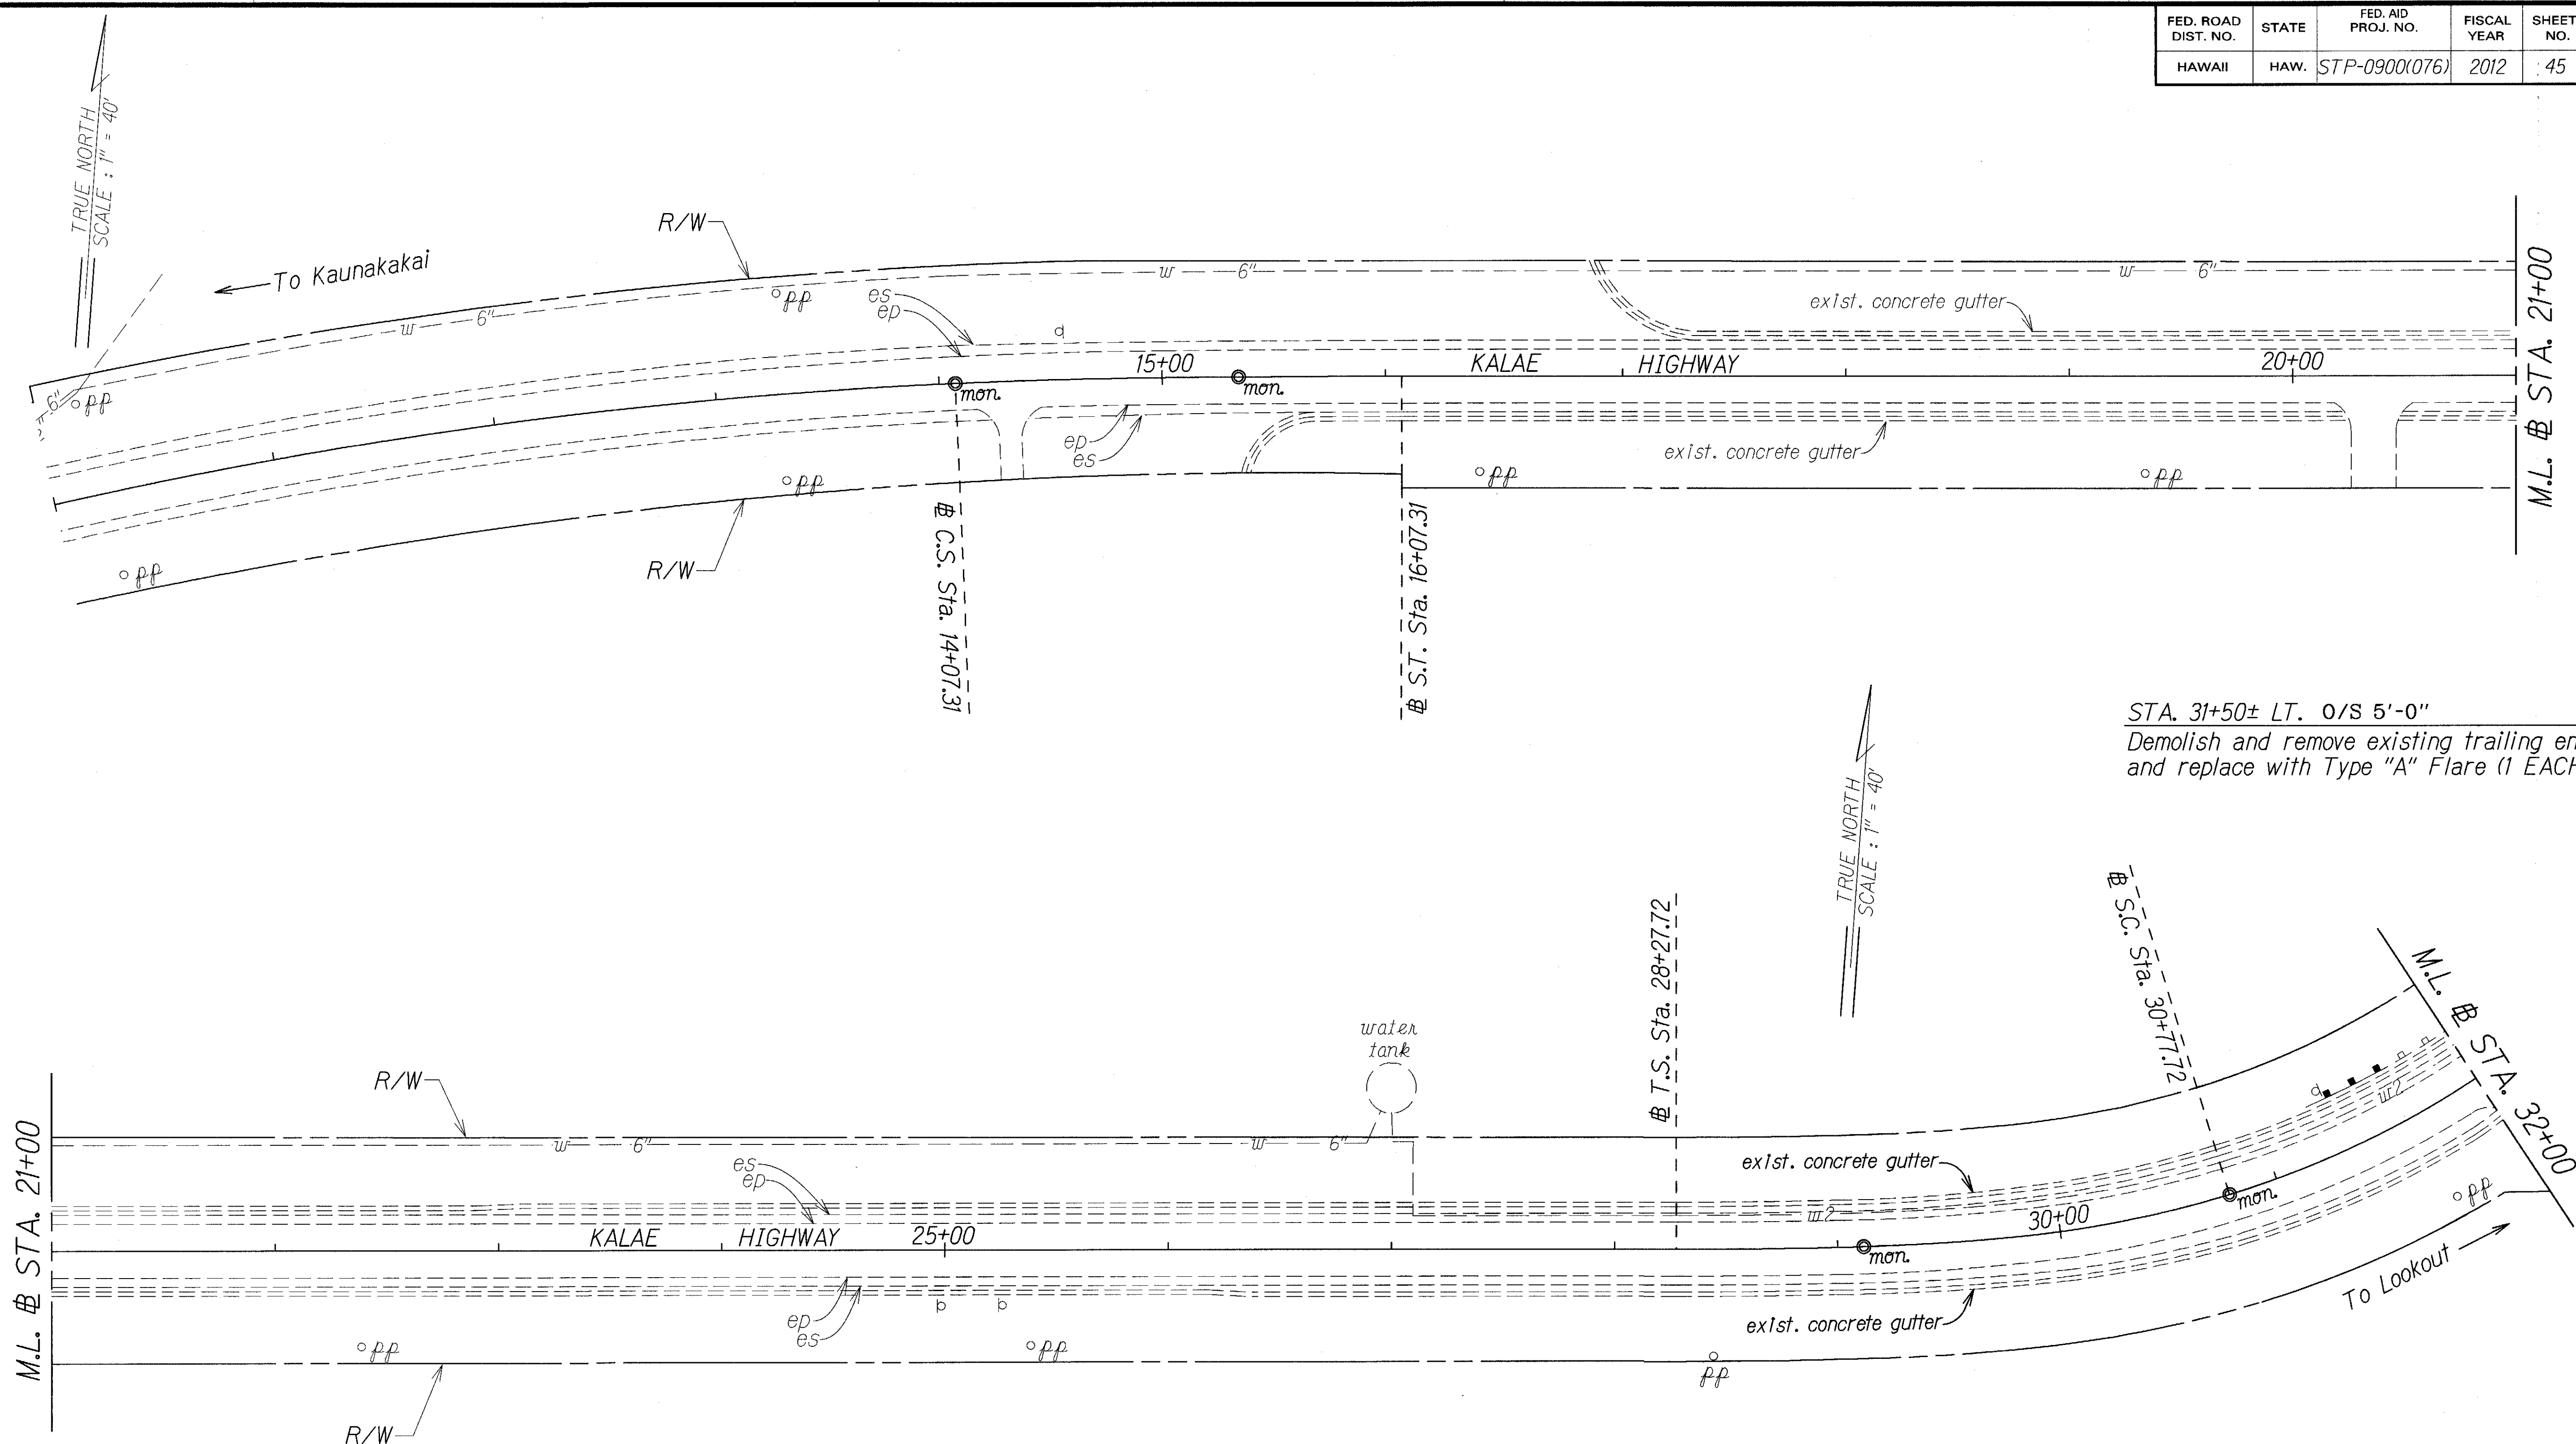

ORIGINAL PLAN	DATE
SURVEY PLOTTED BY	
DRAWN BY	
DESIGNED BY	
QUANTITIES BY	
CHECKED BY	
NOTE BOOK	
501A	
N. 1.55p	

LEGEND FOR AS-BUILT POSTINGS	
	Squiggly line for as-built deletion
	Double line for as-built deletion
Roadway	Text for as-built posting

STATE OF HAWAII
DEPARTMENT OF TRANSPORTATION
HIGHWAYS DIVISION

ROADWAY PLAN

GUARDRAIL & SHOULDER IMPROVEMENT

At Various Locations, Molokai


Federal-Aid Project No. STP-0900(076)

Scale: 1" = 40' Date: July, 2011

SHEET No. 4 OF 6 SHEETS


"AS-BUILT"

FED. ROAD DIST. NO.	STATE	FED. AID PROJ. NO.	FISCAL YEAR	SHEET NO.	TOTAL SHEETS
HAWAII	HAW.	STP-0900(076)	2012	46	47

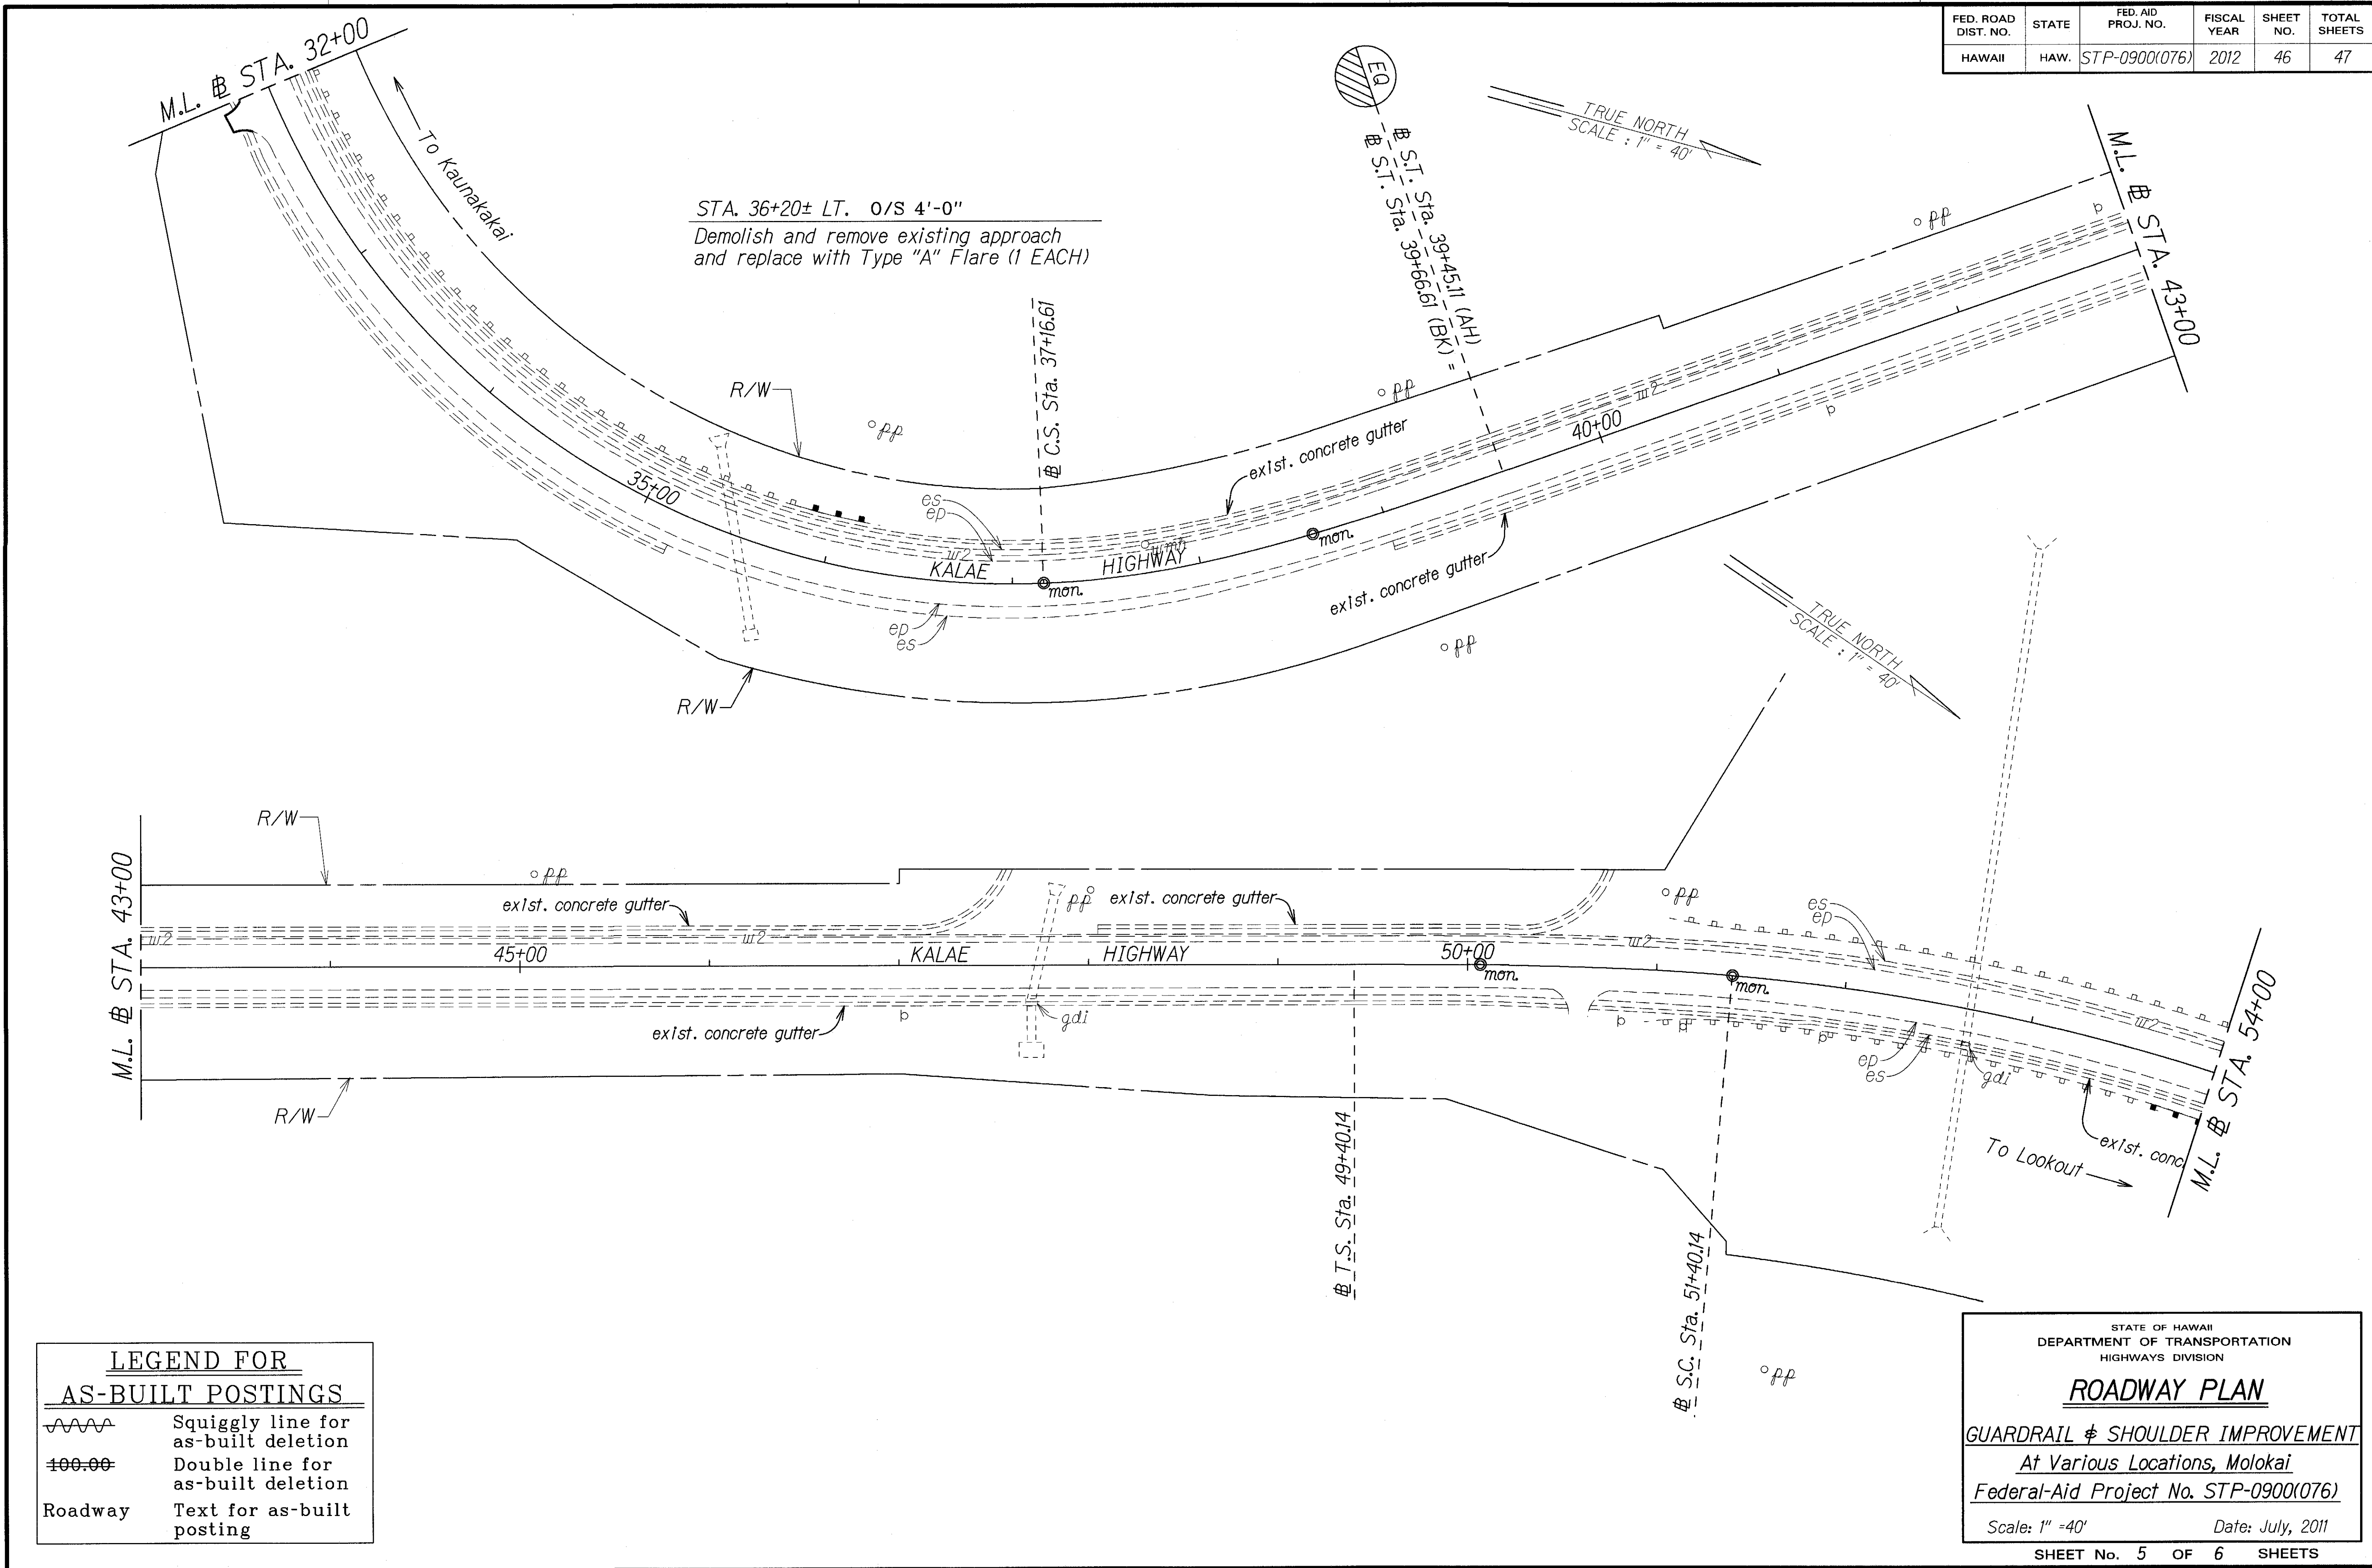

"AS-BUILT"

FED. ROAD DIST. NO.	STATE	FED. AID PROJ. NO.	FISCAL YEAR	SHEET NO.	TOTAL SHEETS
HAWAII	HAW.	STP-0900(076)	2012	47	47

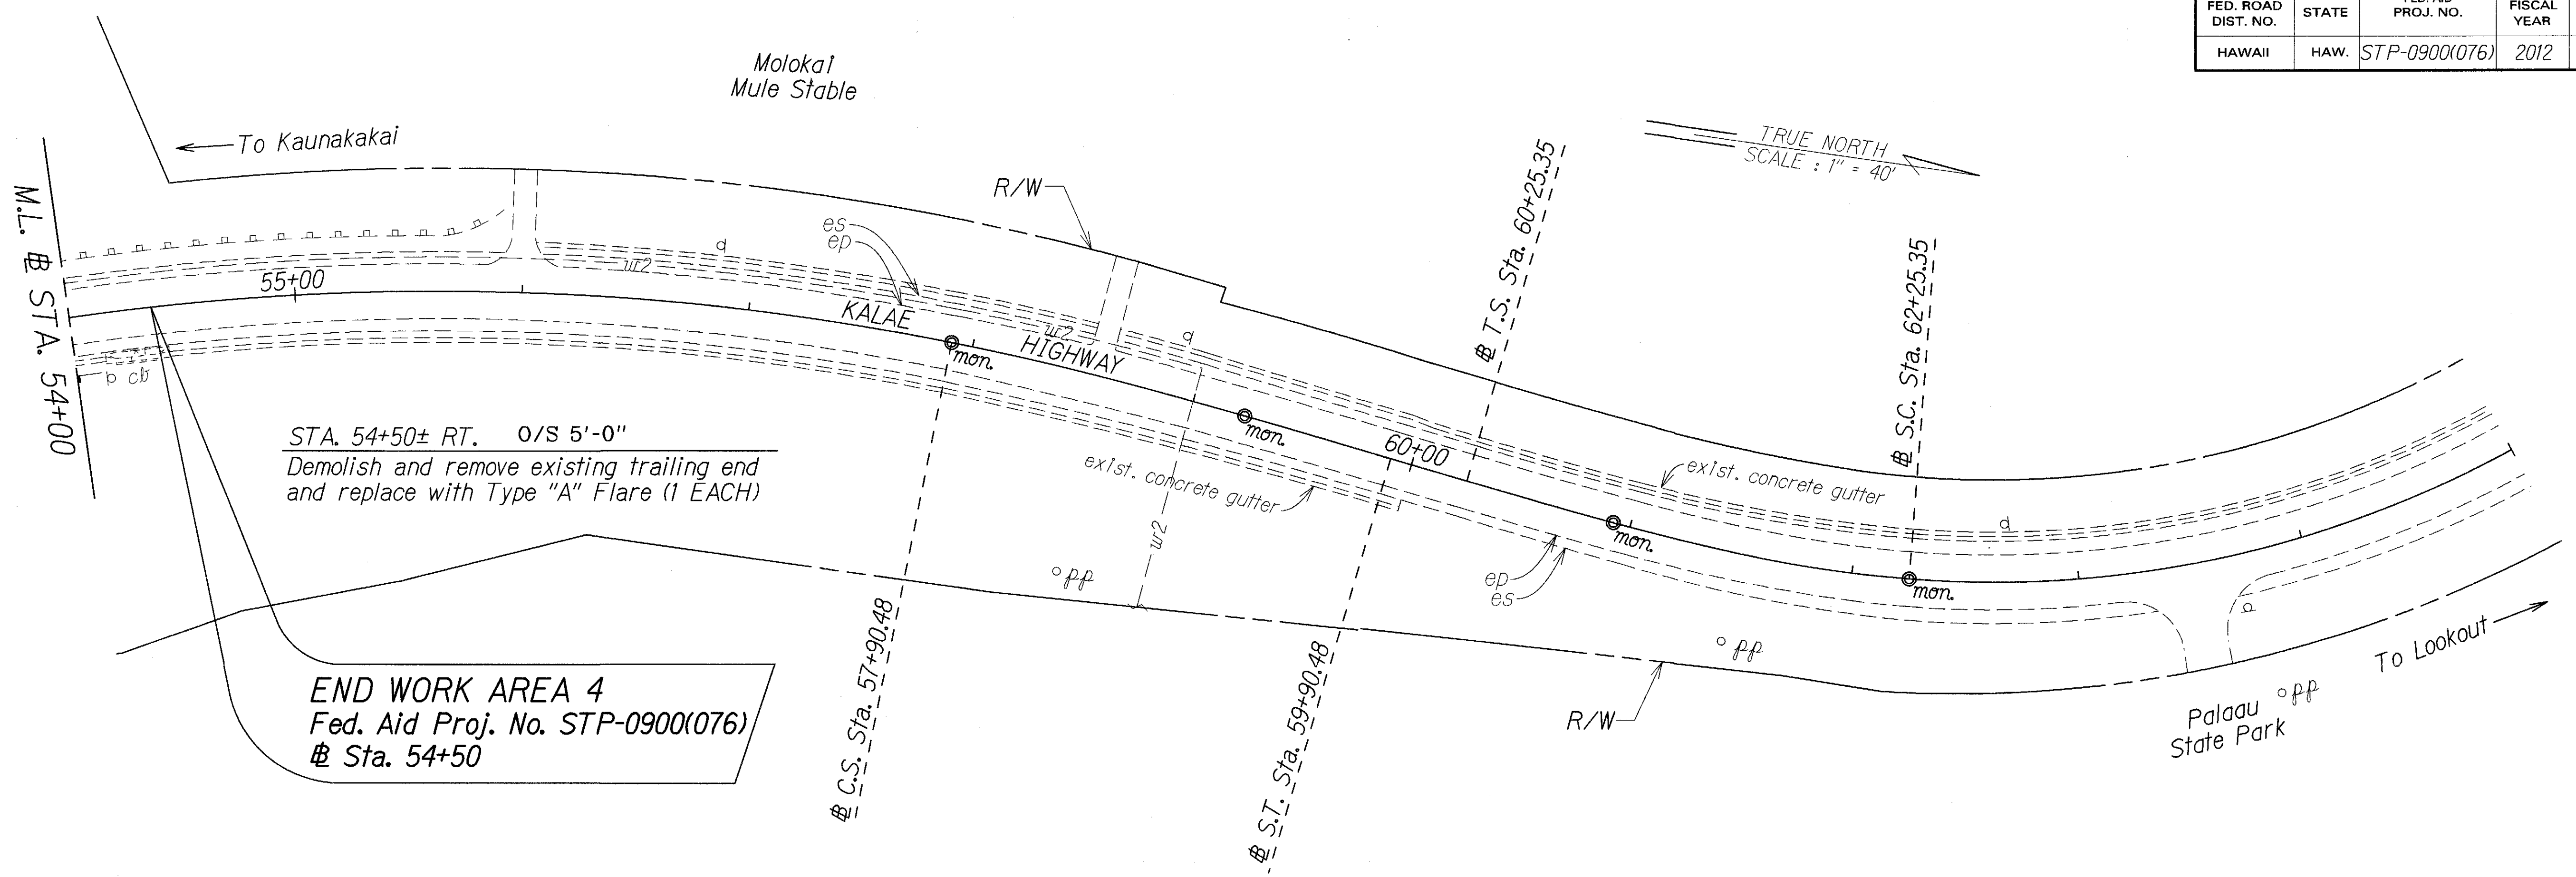

ORIGINAL PLAN	SURVEY DATED BY	DATE
TRACED BY	DRIVEN BY	
NOTED BY	QUANTITIES BY	
CHECKED BY		

LEGEND FOR AS-BUILT POSTINGS	
	Squiggly line for as-built deletion
	Double line for as-built deletion
Roadway	Text for as-built posting

STATE OF HAWAII DEPARTMENT OF TRANSPORTATION HIGHWAYS DIVISION
ROADWAY PLAN
GUARDRAIL & SHOULDER IMPROVEMENT
At Various Locations, Molokai
Federal-Aid Project No. STP-0900(076)
Scale: 1" = 40' Date: July, 2011
SHEET No. 6 OF 6 SHEETS

"AS-BUILT"