

INDEX TO DRAWINGS	
SHEET NO.	DESCRIPTION
1	TITLE SHEET
2	TYPICAL SECTION
2A	LOCATIONS OF BORROW PITS
3 - 8	PLAN AND PROFILE
9 - 10	STANDARD DETAILS
11 - 12	8'x8' BOX CULVERT DETAILS
13 - 20	CROSS SECTIONS

CONVENTIONAL SIGNS USED	
Boundary Lines	 or
Centerline	 35
Centerline Monument	 35
Circular Pipe Culvert	 35
Electric Pole	 35
Existing Road	 35
Fences	 35
Telephone Pole	 35
Warning & Regulatory Signs	 35
Water Main	 35
Water Meter	 35

TERRITORY OF HAWAII

TERRITORIAL HIGHWAY DEPARTMENT

HONOLULU, T. H.

PLANS OF

FARRINGTON AVENUE



FEDERAL AID SECONDARY PROJECT NO. S 242(2)

DISTRICT OF MOLOKAI

COUNTY OF MAUI

ISLAND OF MOLOKAI

SCALES	
PLAN	1 IN. = 100 FT.
PROFILE	HOR. 1 IN. = 100 FT.
	VER. 1 IN. = 10 FT.
CROSS-SECTION	HOR. 1 IN. = 10 FT.
	VER. 1 IN. = 10 FT.

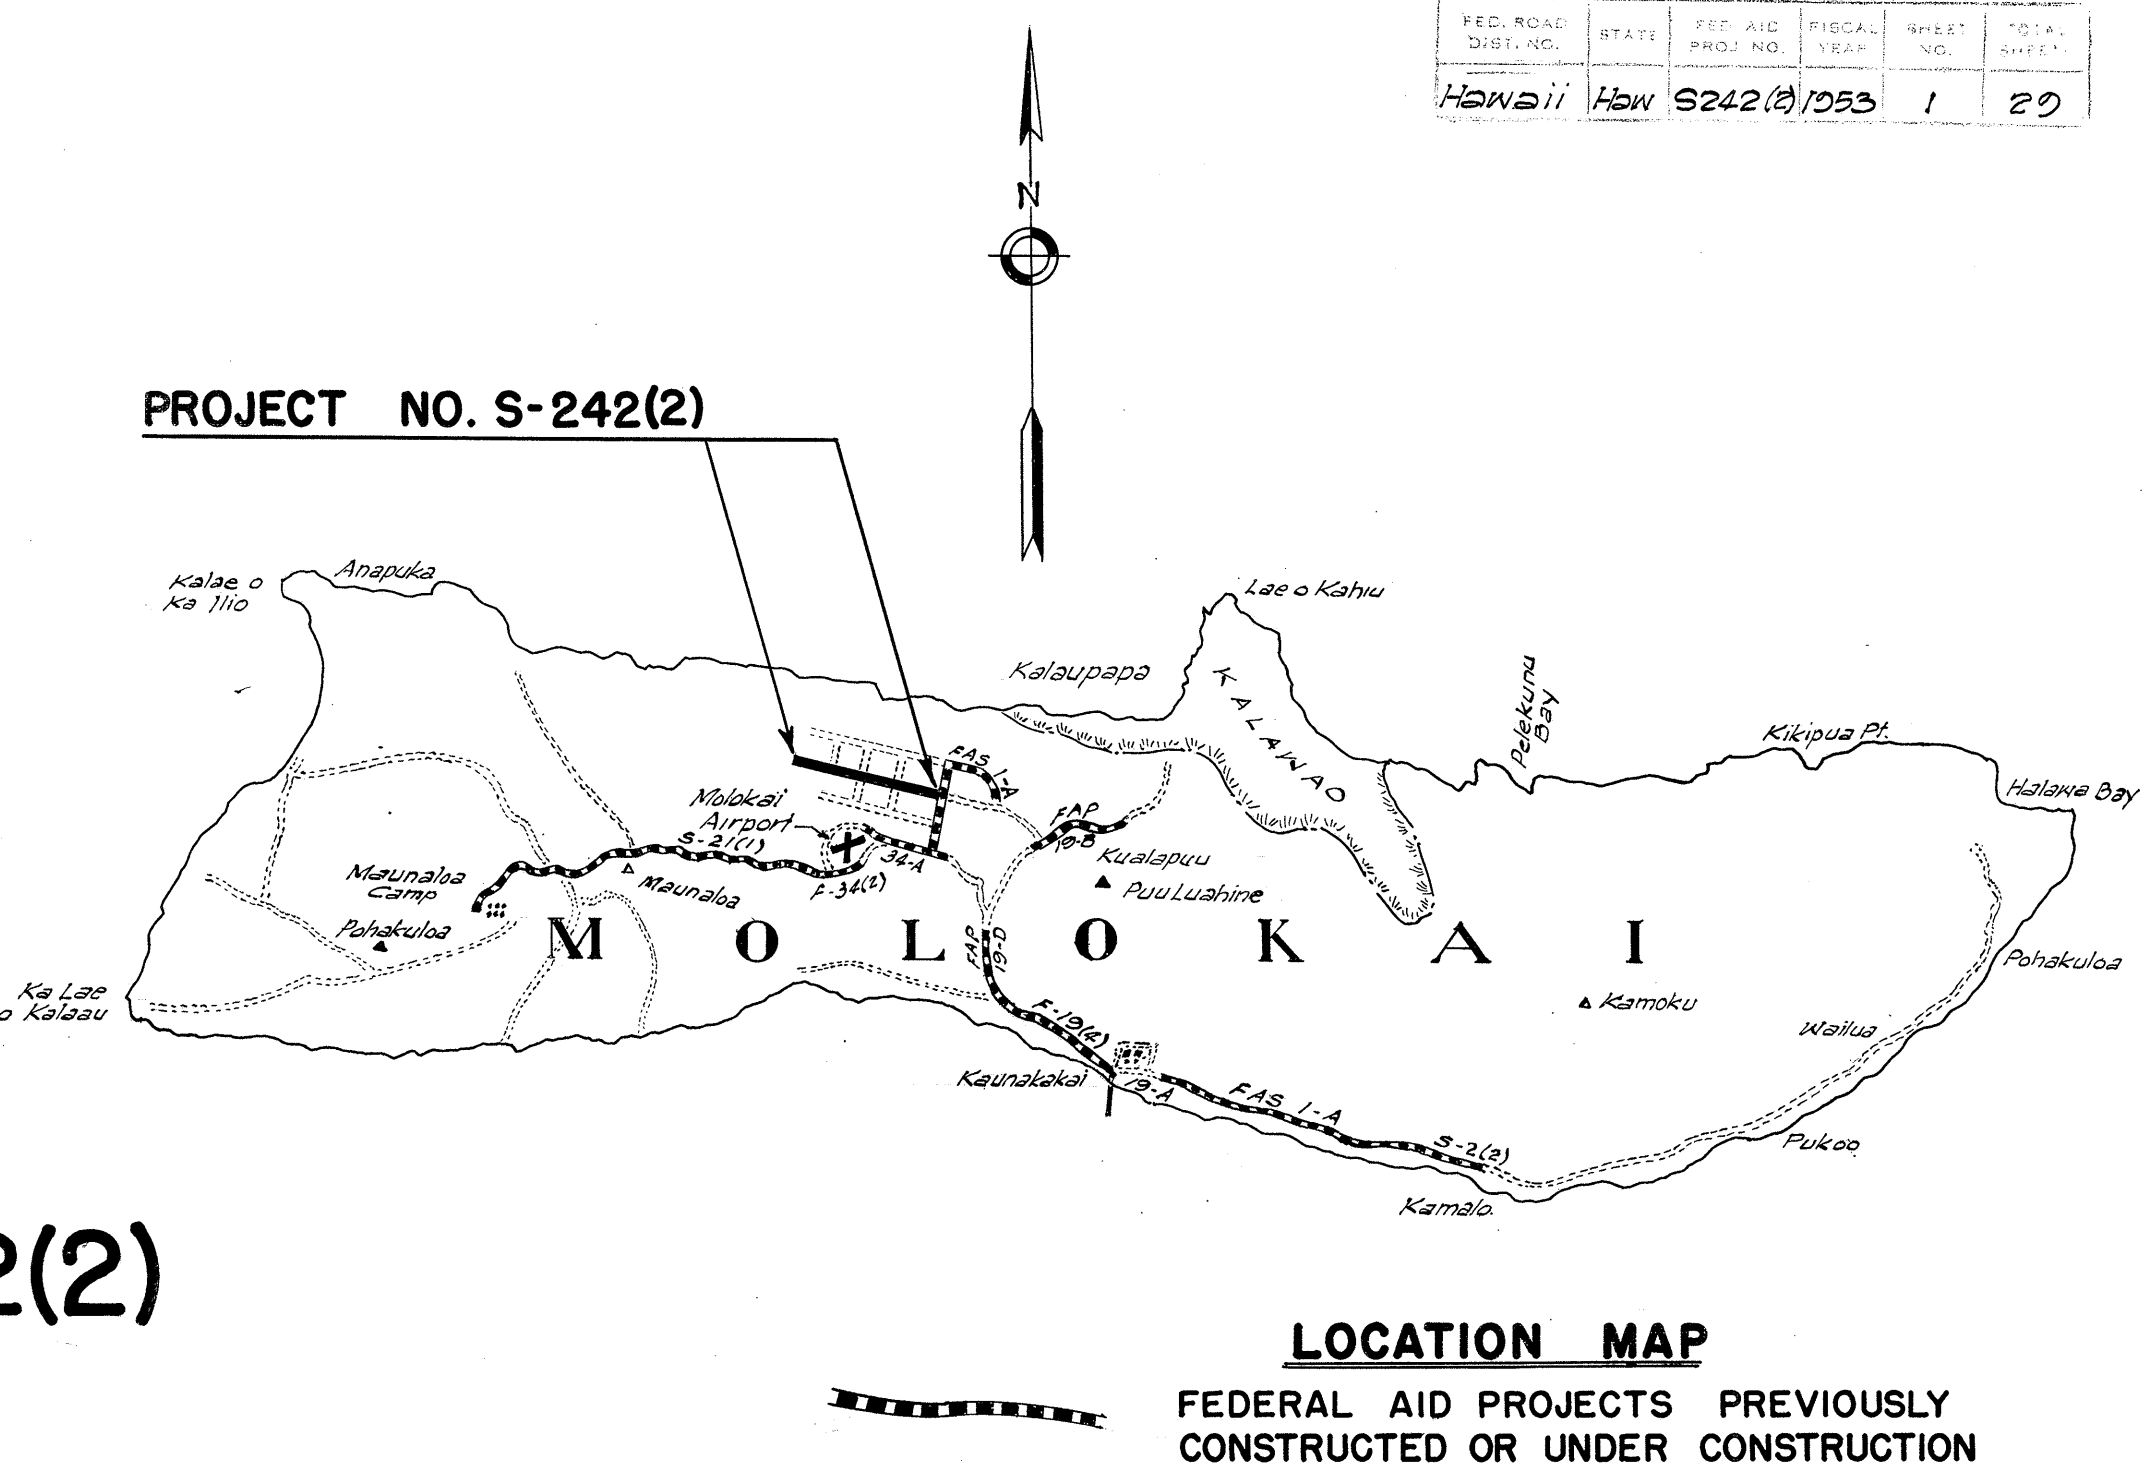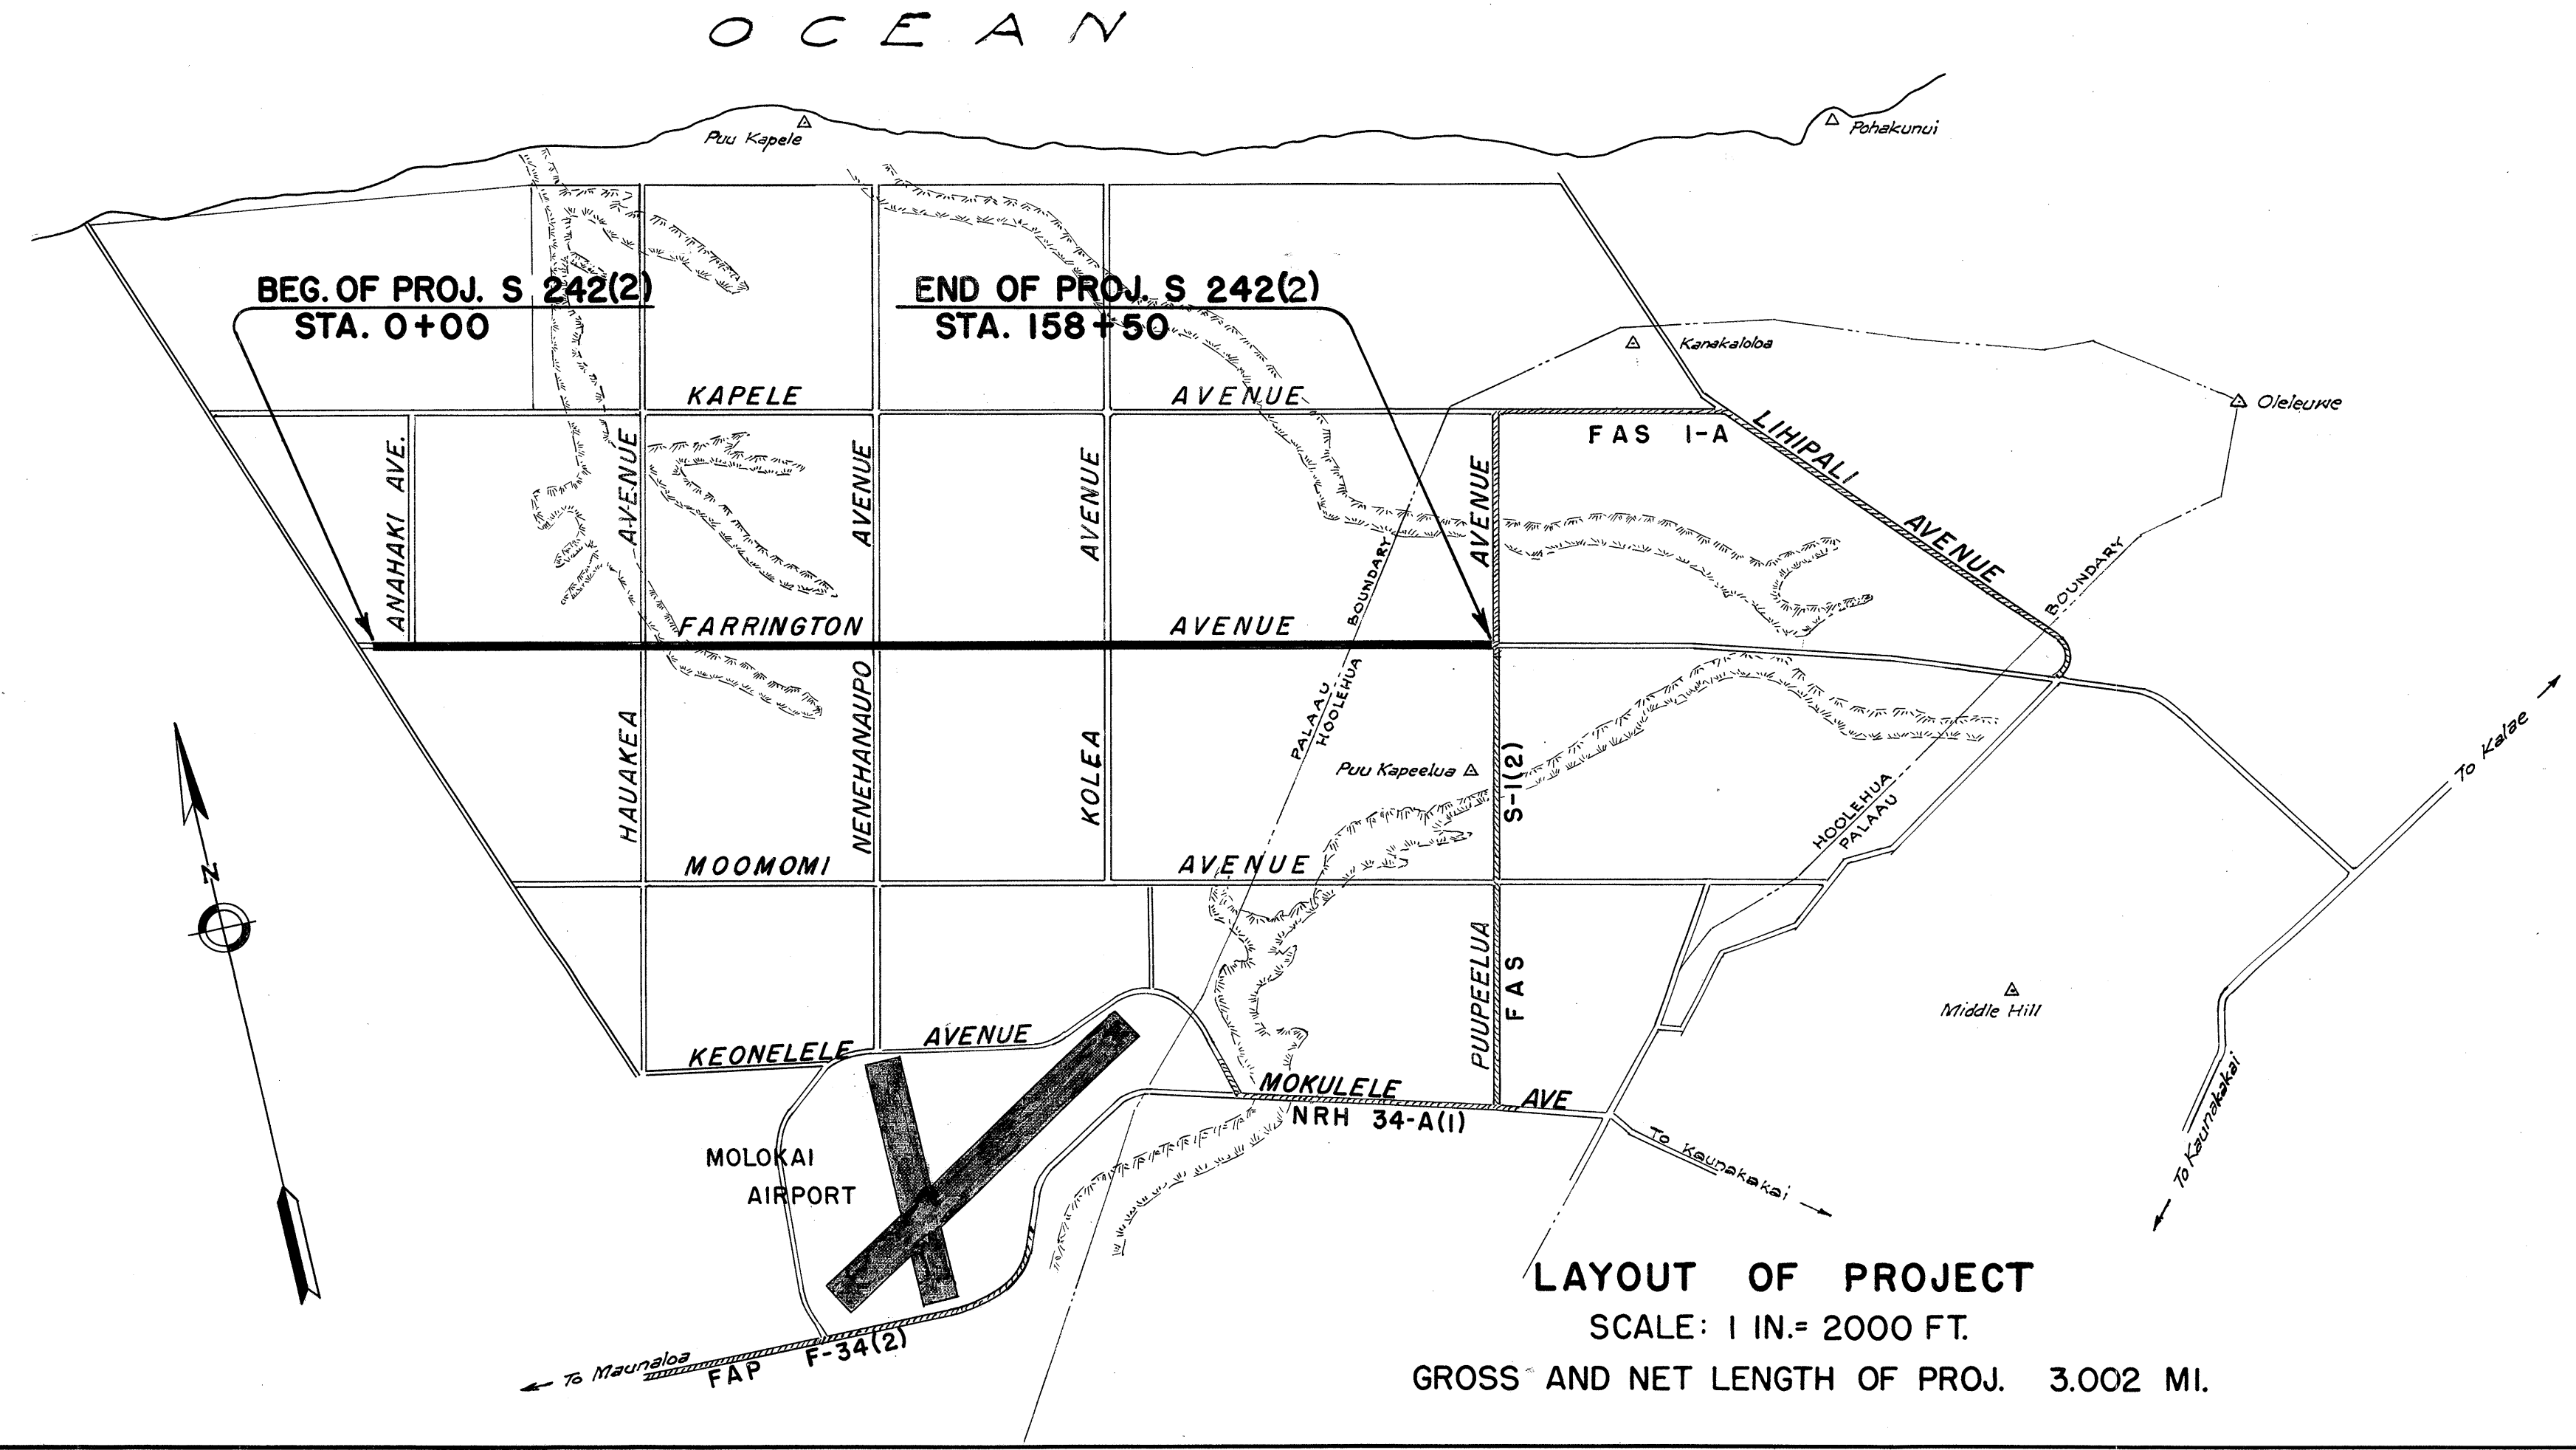

NOTE

ALL CHANGES MADE DURING CONSTRUCTION

HAVE BEEN NOTED IN RED ON THESE

SHEETS AND CHECKED BY

[Signature]

DISTRICT ENGINEER

1/10/55

DATE

APPROVED:

[Signature]

TERRITORIAL HIGHWAY ENGINEER

DEPARTMENT OF COMMERCE

BUREAU OF PUBLIC ROADS

APPROVED:

DISTRICT ENGINEER

DATE