

INDEX	TO DRAWINGS
SHEET NO.	DESCRIPTION
1	Title Sheet
2	Typical Road Sections
3-14	Plan & Profile
15-16	Standard Details
17-24	Culvert Details
25-30	Bridge Details
31-38	Cross Sections


TERRITORY OF HAWAII
TERRITORIAL HIGHWAY DEPARTMENT
HONOLULU, T. H.

PLANS OF
EAST MOLOKAI ROAD
KAUNAKAKAI TOWARD KAMALO SECTION
FEDERAL AID SECONDARY PROJECT NO. F.A.S. 2-A(1).
ISLAND OF MOLOKAI

CONVENTIONAL SIGNS


Present Road	
Existing Fence	
Center Line	
Bridges	
Culverts	

SCALE	
PLAN	1 IN. = 100 FT.
PROFILE	HOR. 1 IN. = 100 FT. VER. 1 IN. = 10 FT.
CROSS SECTION	1 IN. = 10 FT.

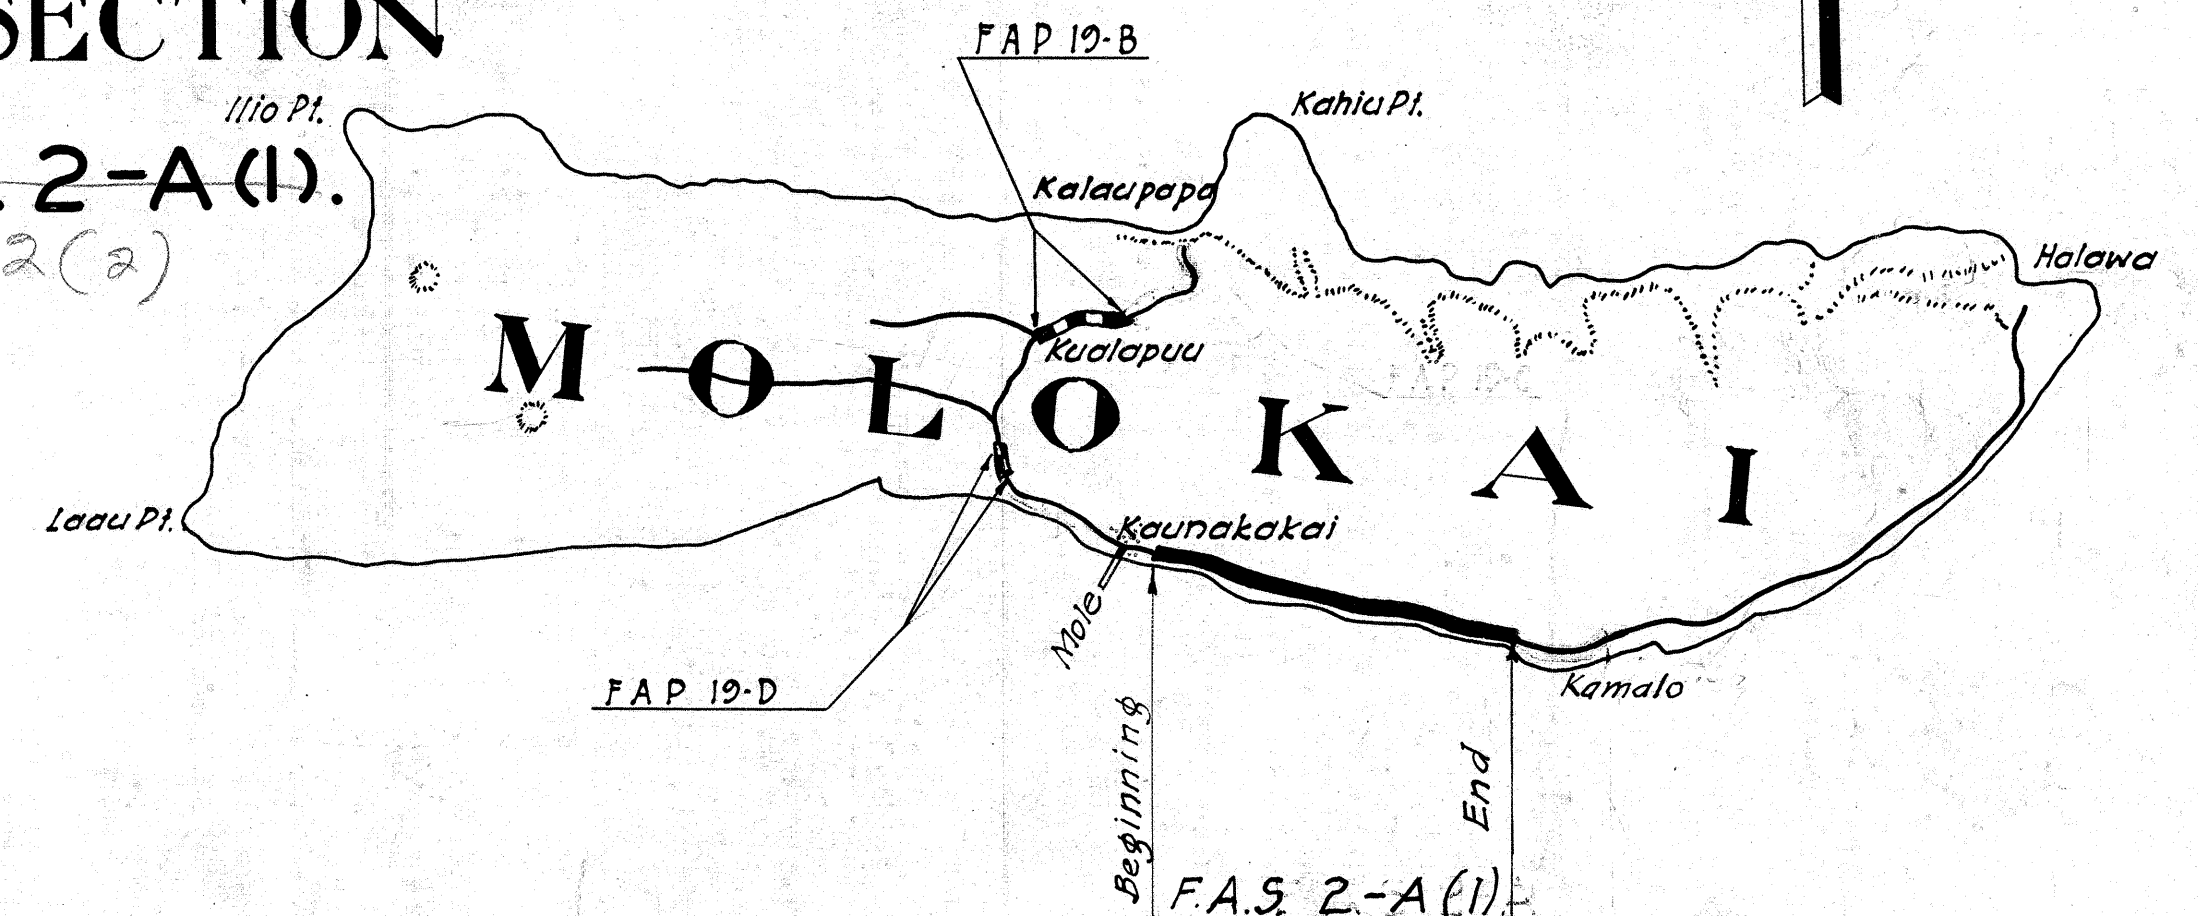

LAYOUT OF PROJECT

GROSS LENGTH	6.391 MILES
BRIDGES OVER 20' SPAN	0.017 "
NET LENGTH ROADWAY	6.372 "

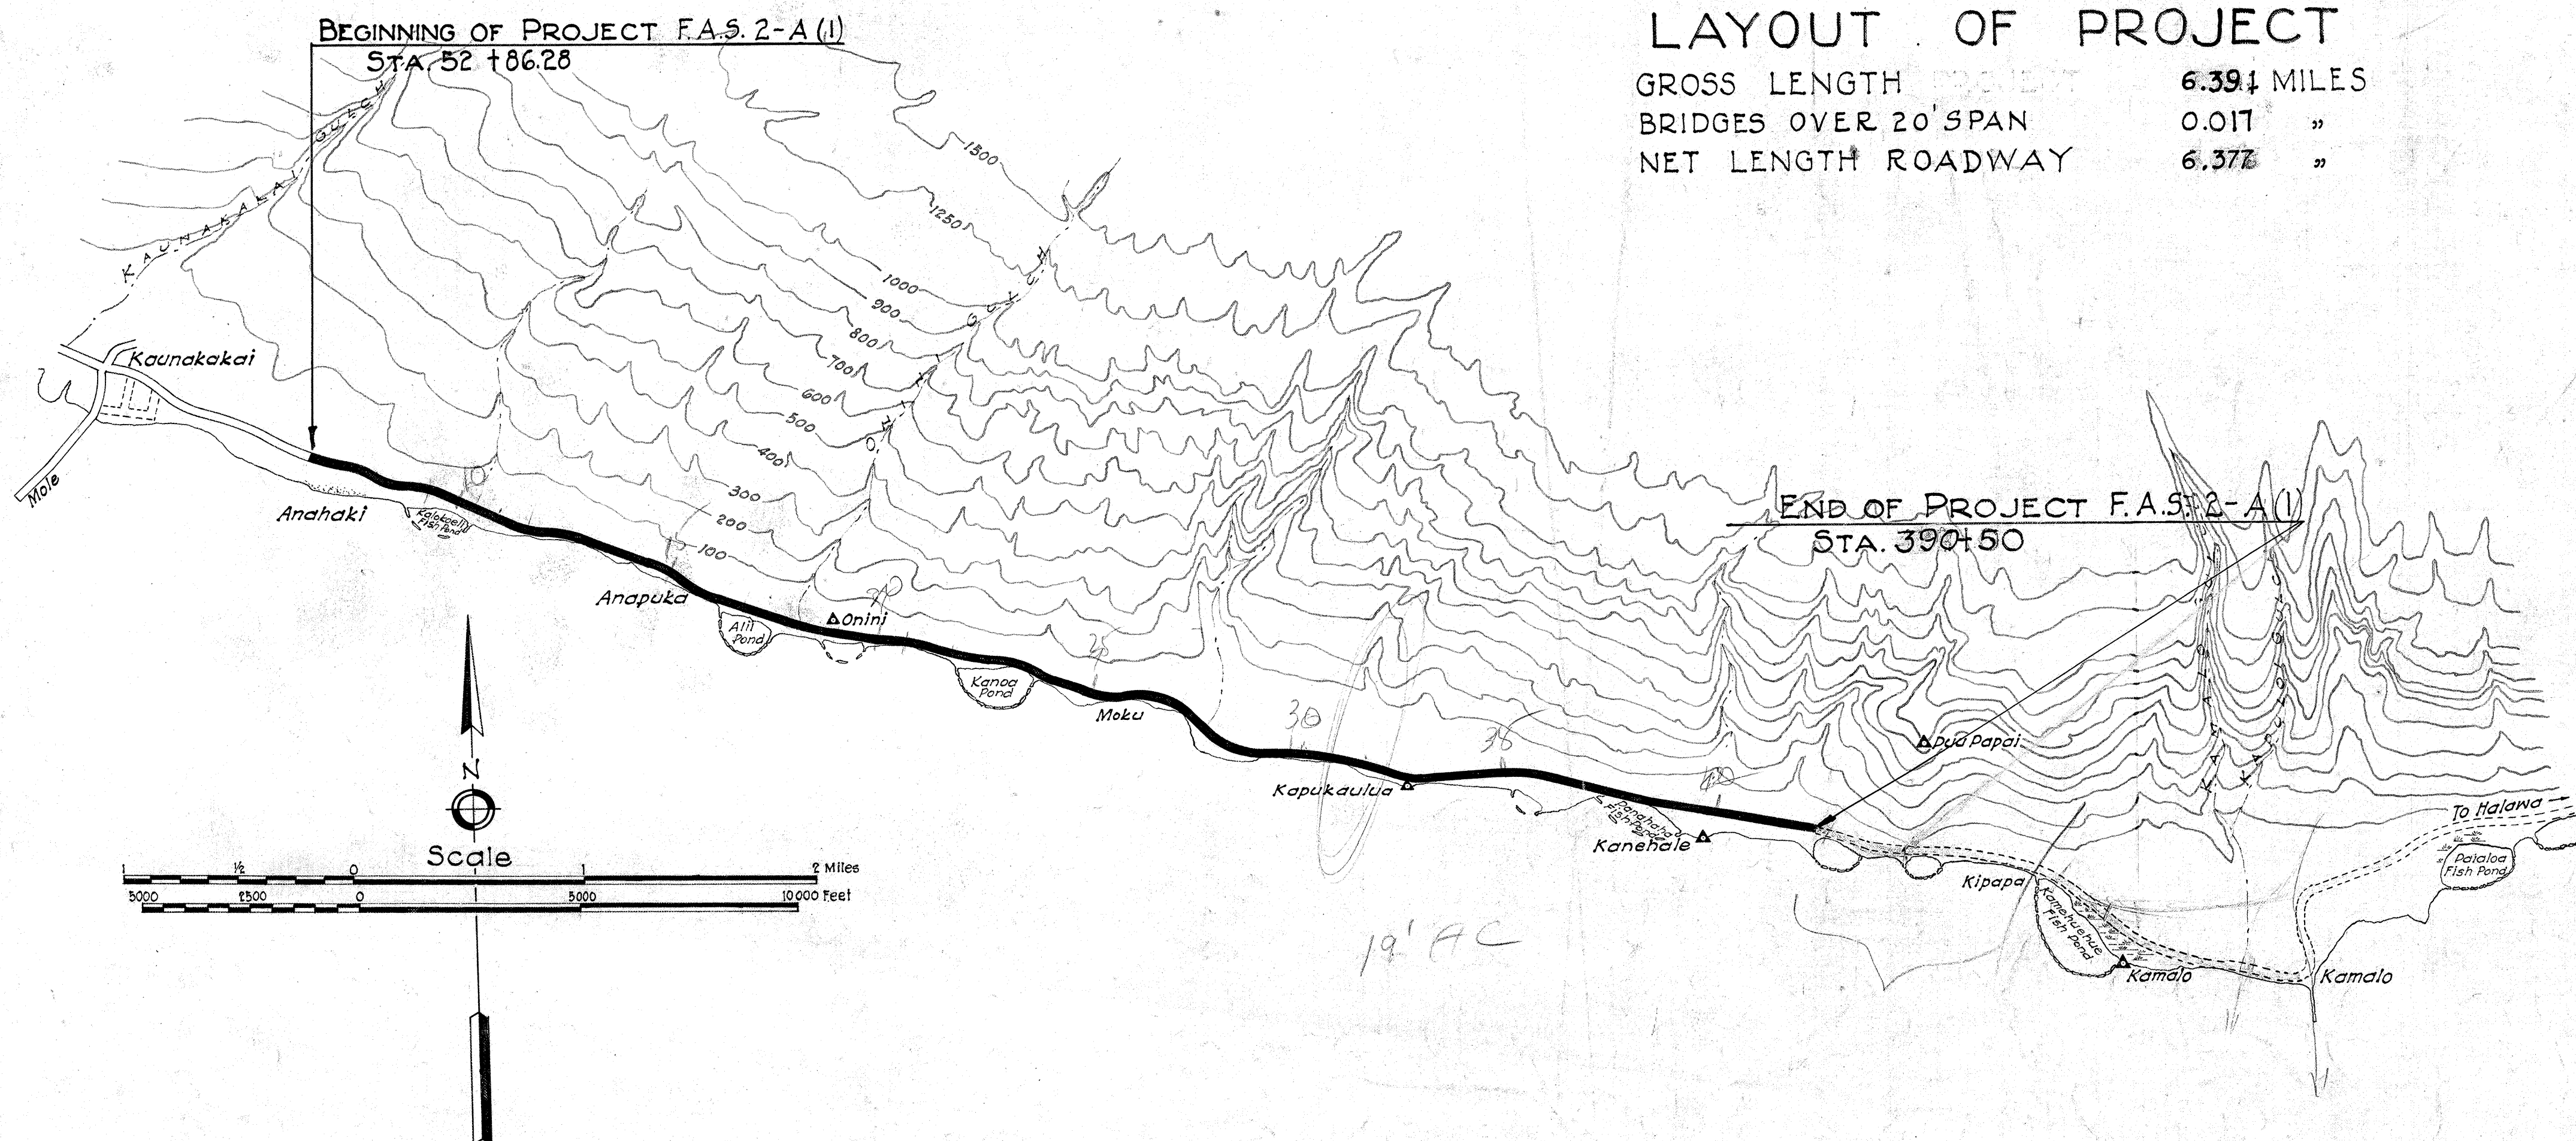

APPROVED
Louis Blain
TERRITORIAL HIGHWAY ENGINEER

RECOMMENDED FOR APPROVAL

DISTRICT ENGINEER
PUBLIC ROADS ADMINISTRATION
FEDERAL WORKS AGENCY

RECOMMENDED FOR APPROVAL

CHIEF WESTERN DIVISION
PUBLIC ROADS ADMINISTRATION
FEDERAL WORKS AGENCY

APPROVED

COMMISSIONER
PUBLIC ROADS ADMINISTRATION
FEDERAL WORKS AGENCY

PROJECT APPROVED FOR CONSTRUCTION

4475.1