


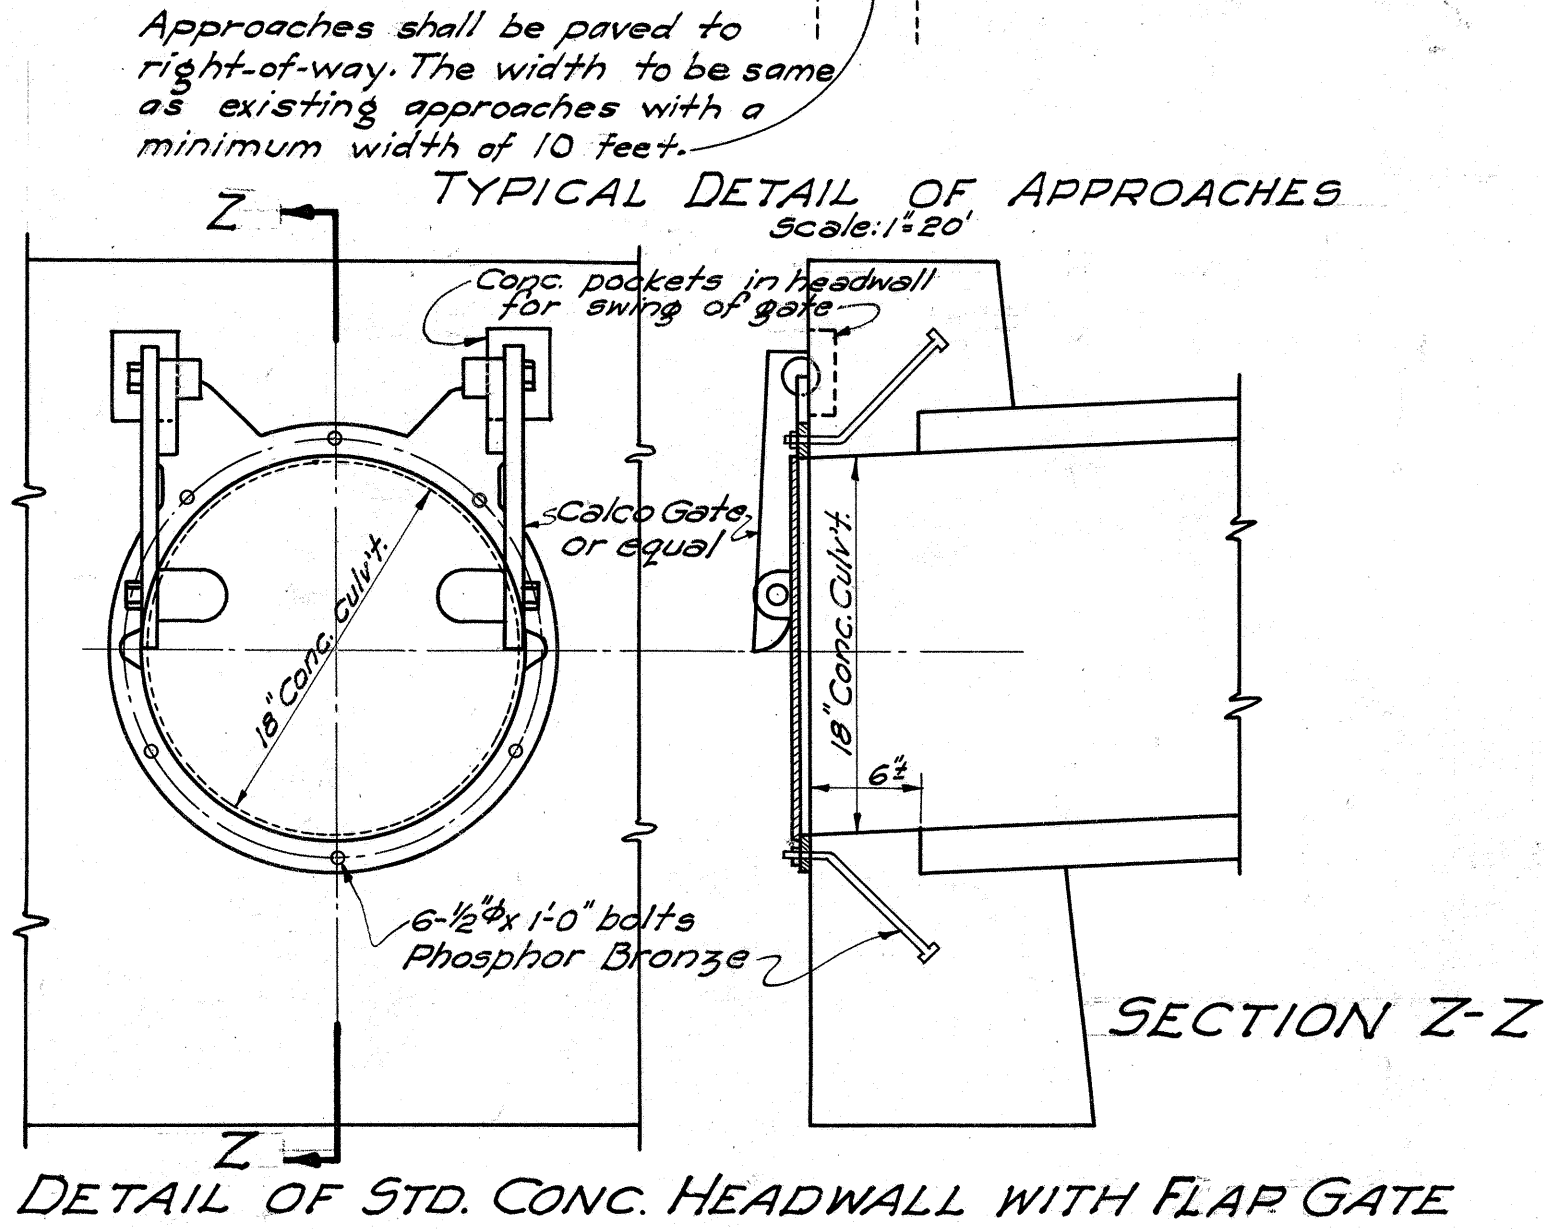


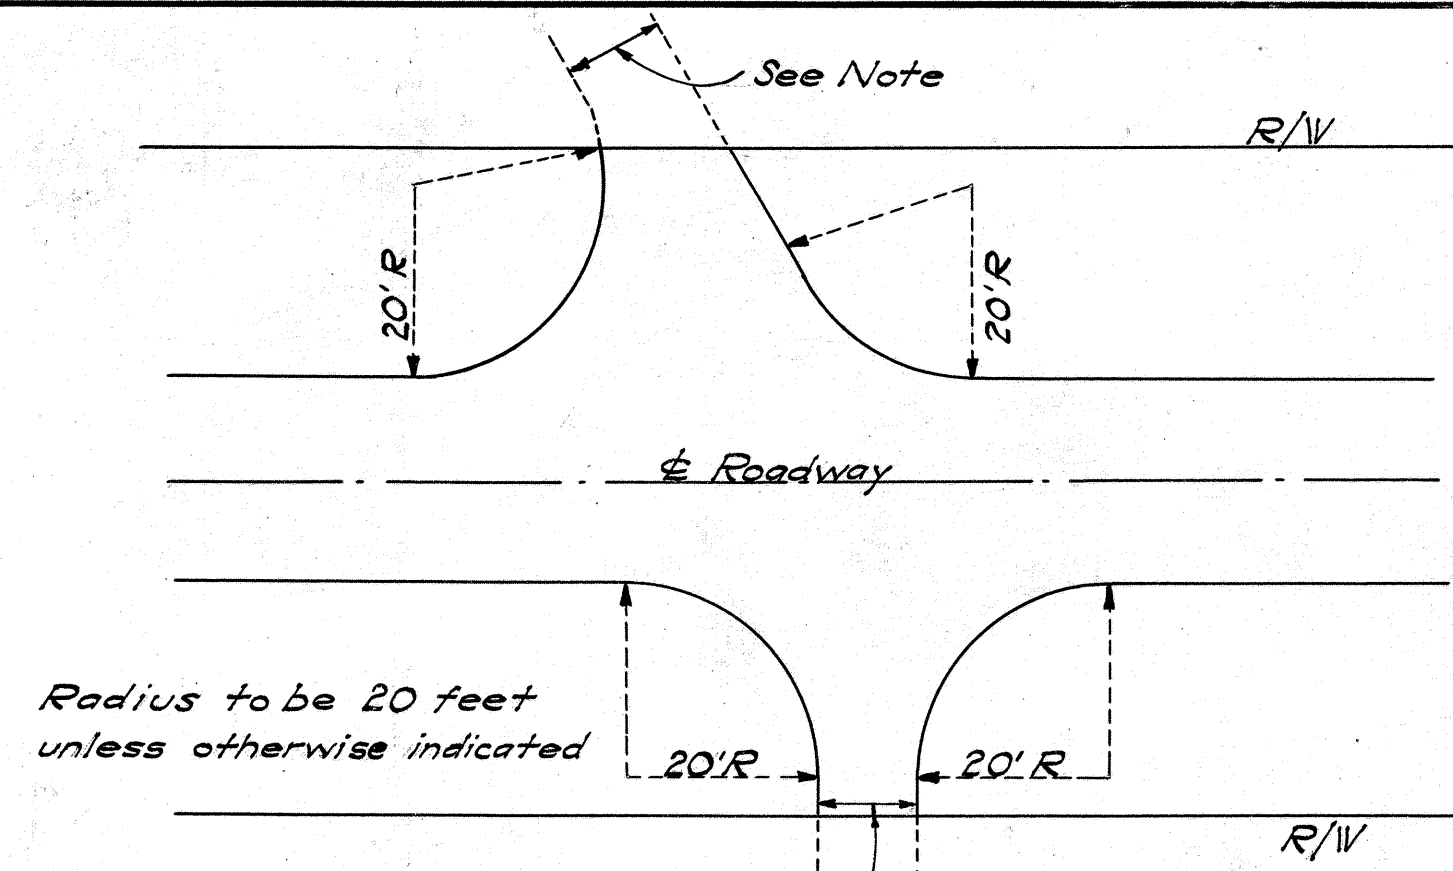

NOTE:
Tops of cut slopes are to be rounded as shown at places indicated by the Engineer. Where cut slopes measure less than 5 ft. the 5 ft. tangent shown with the rounding of cuts shall be changed to correspond with depth of cut. Rounded tops of cuts are paid for by their length as per specifications. Materials excavated in this shaded area shall not be included for payment under the items of Excavation and Overhaul.

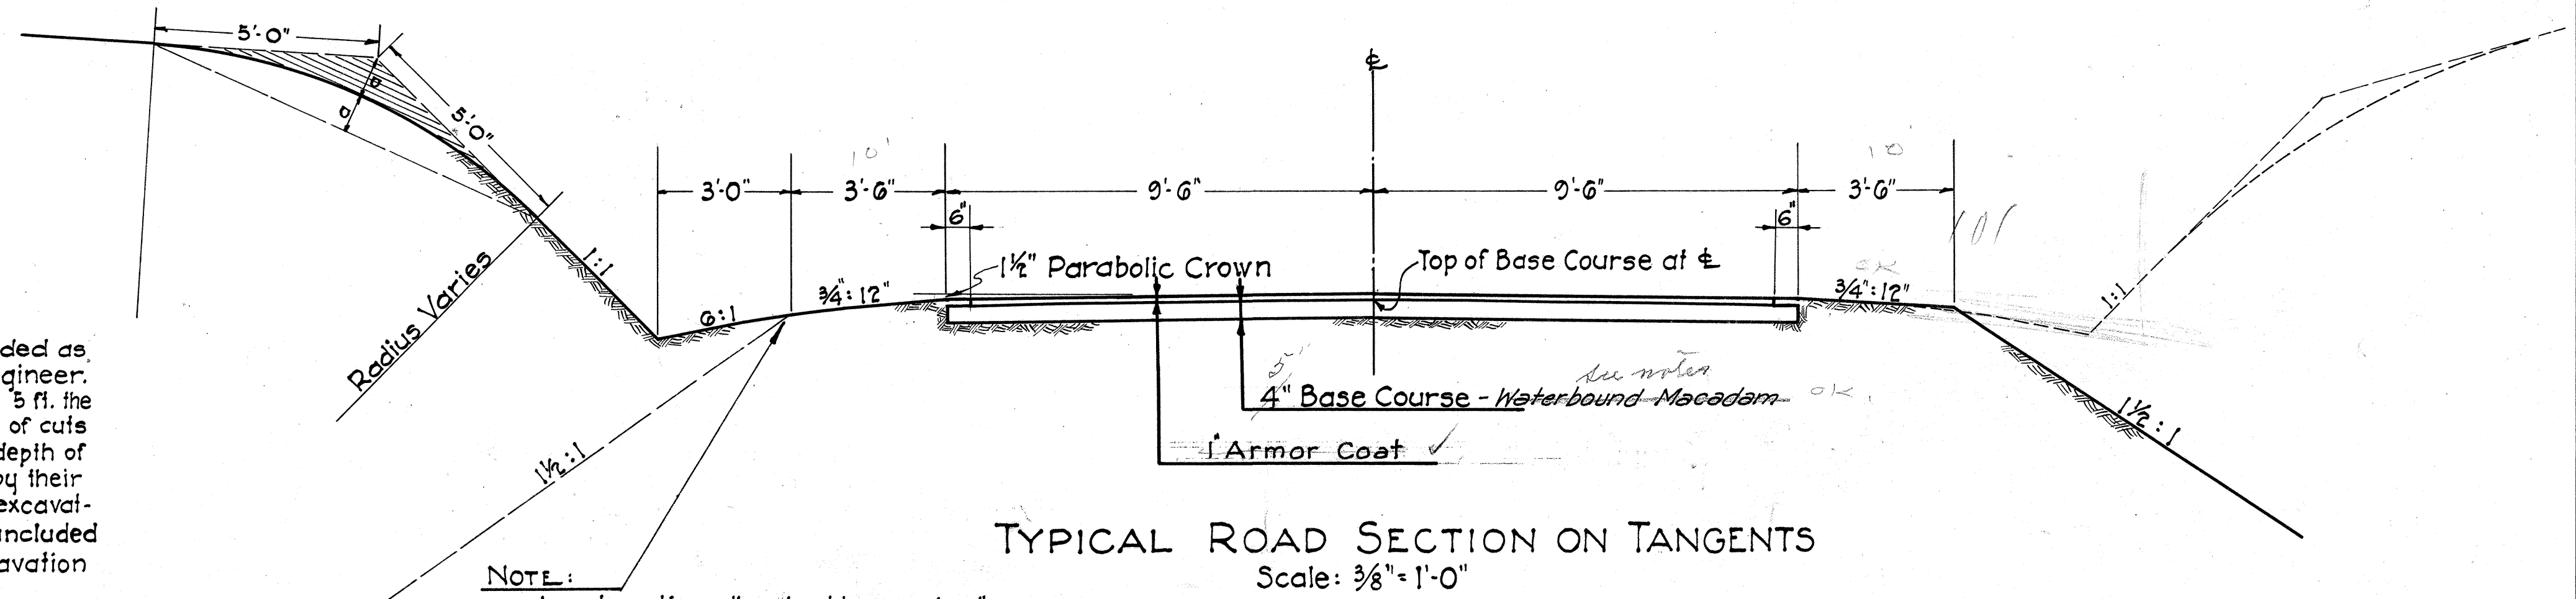

NOTE:
In cut sections the shoulders and gutters shall be formed to the dimensions and slopes required and then the edge of shoulders rounded off evenly at no particular radius.

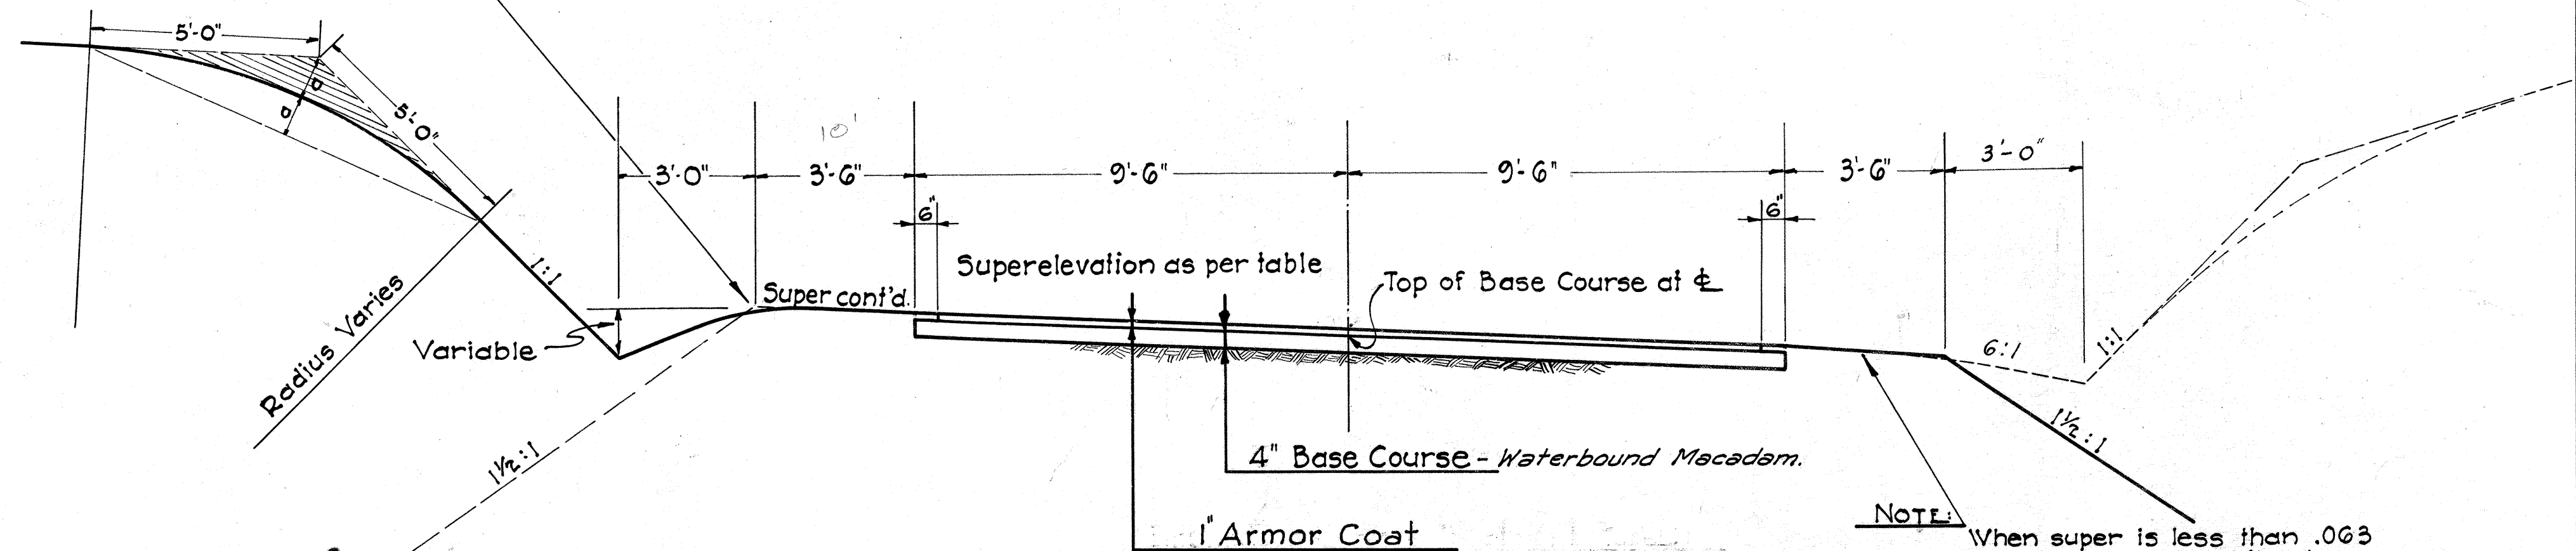

NOTE:
When super is less than .003 ft. per ft. shoulder slope is 3/4:1. When super is equal to or greater than .003 ft. per ft. shoulder slope is the same as the rate of super. This note applies only to the shoulder on the lower side of the super.

