

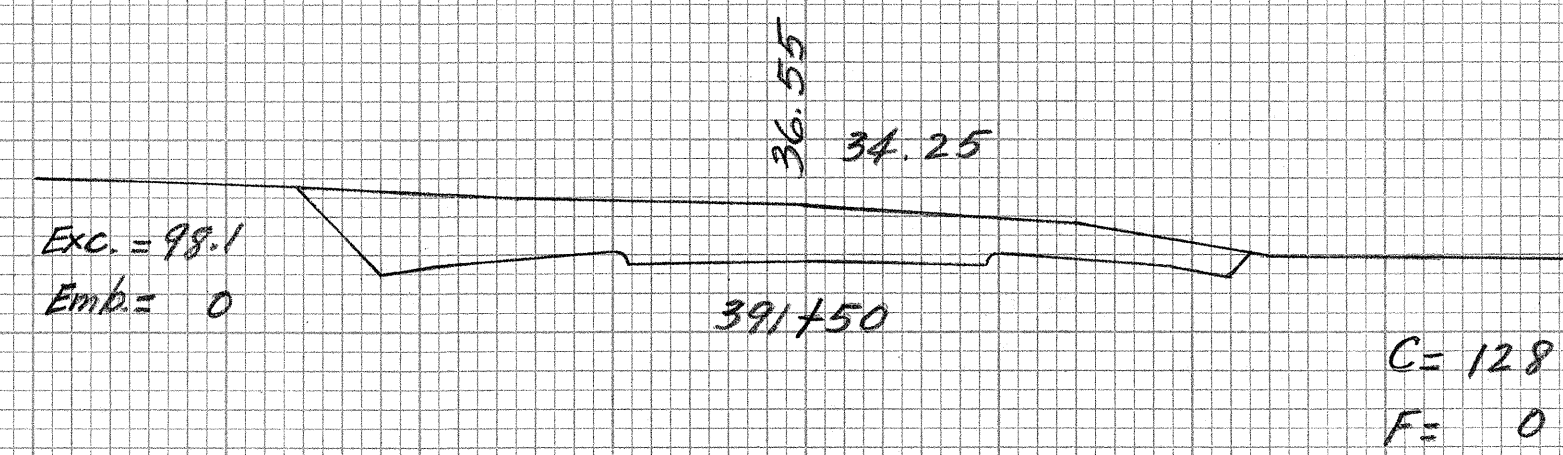
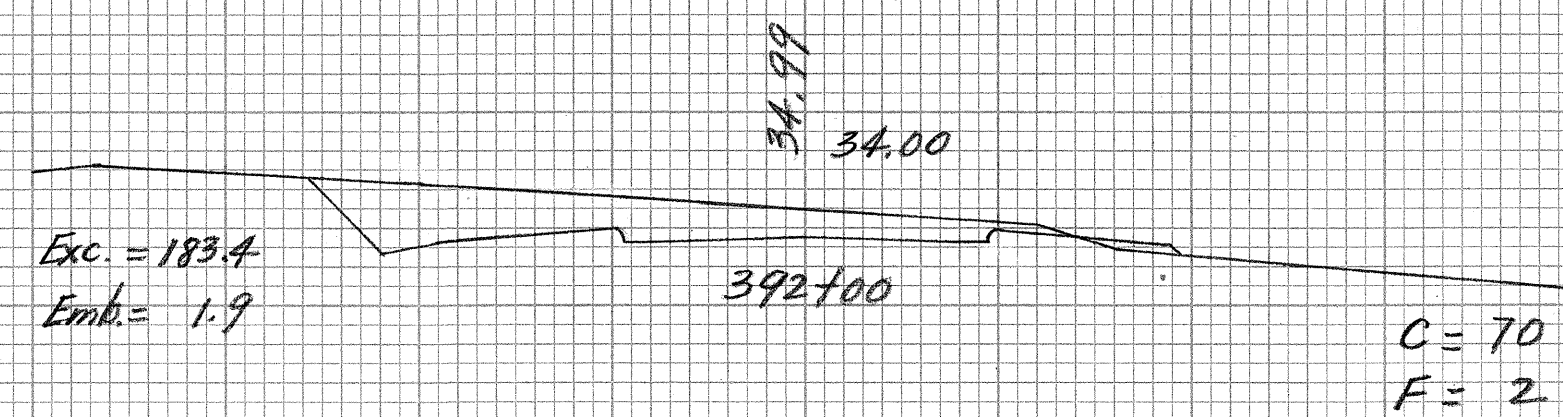
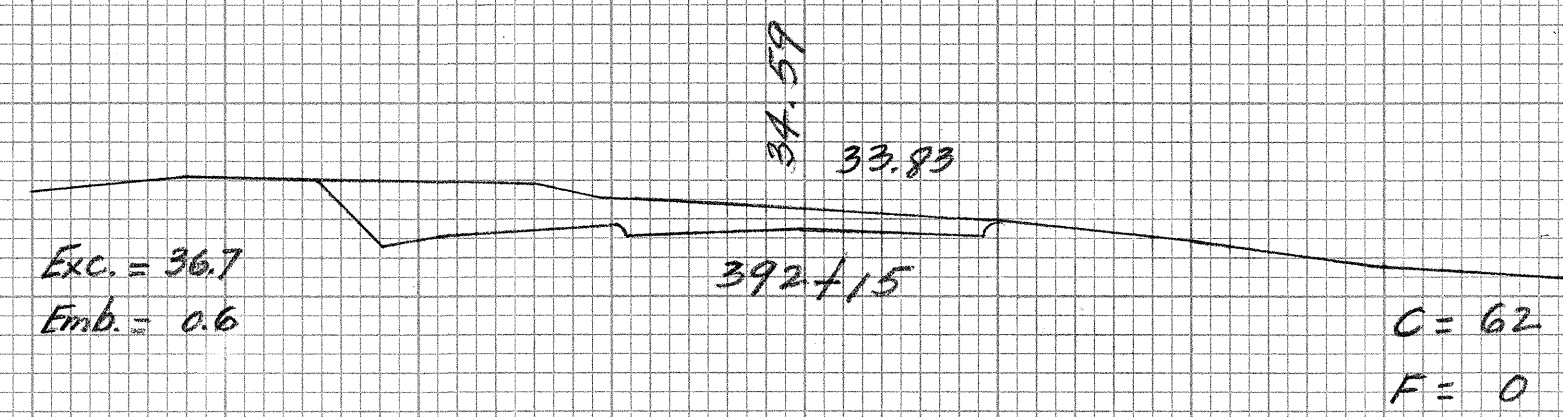
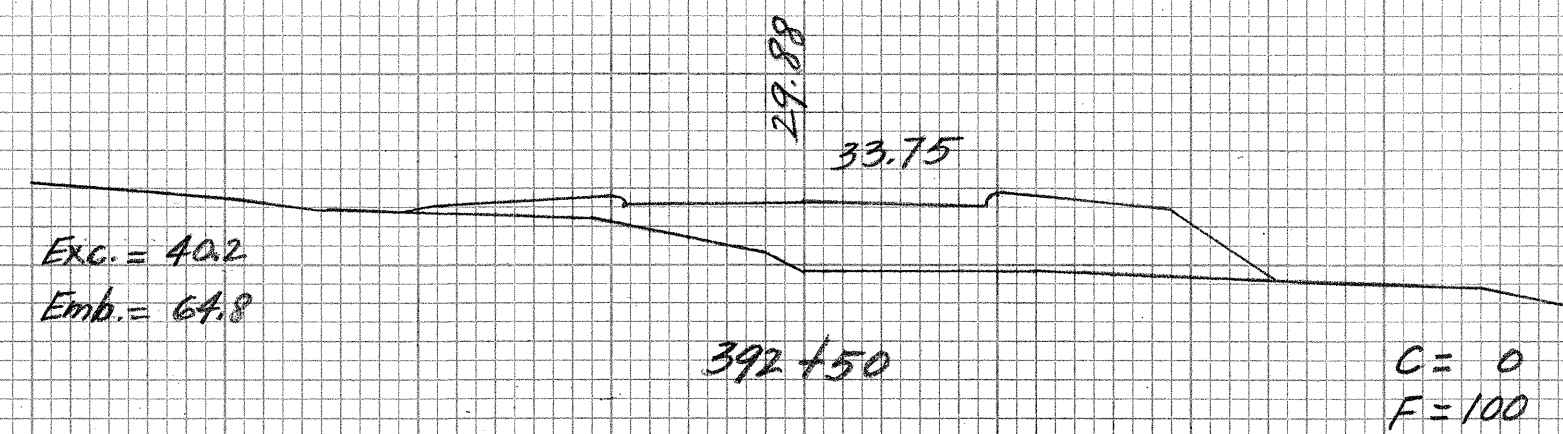
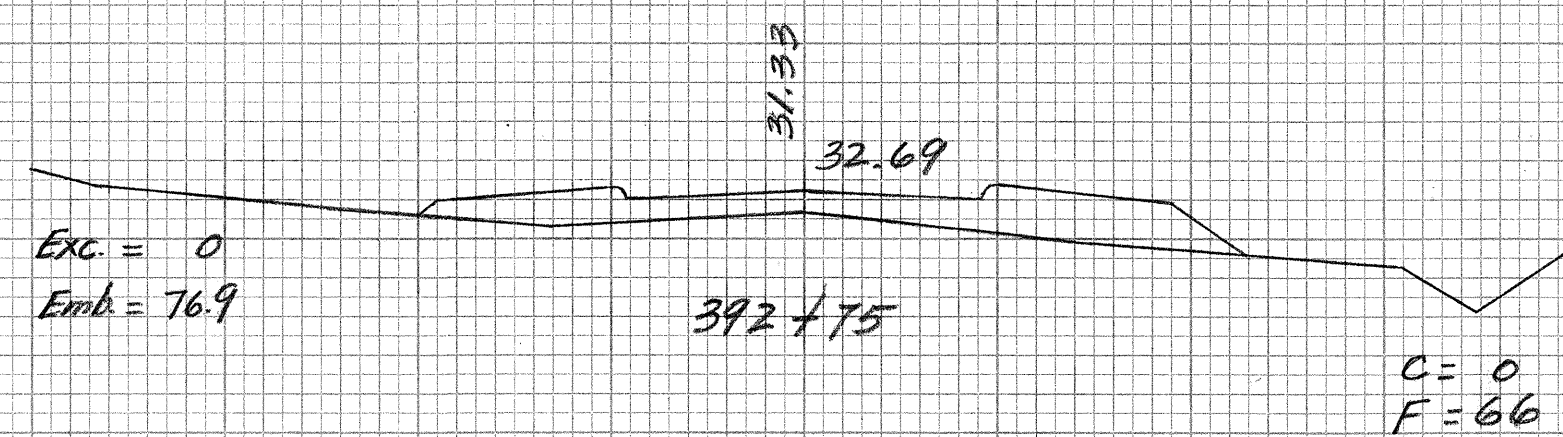
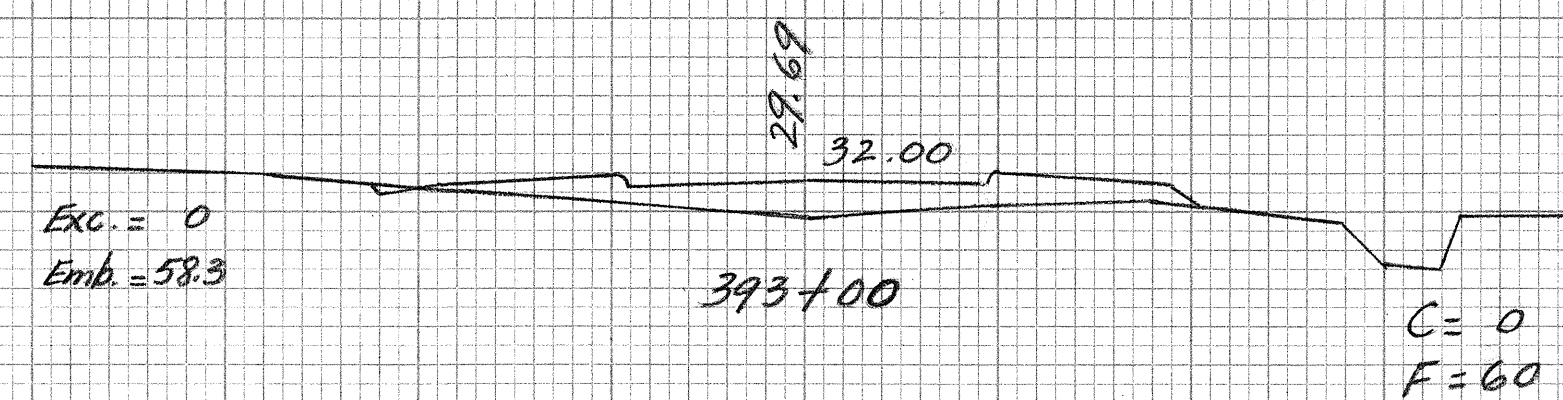
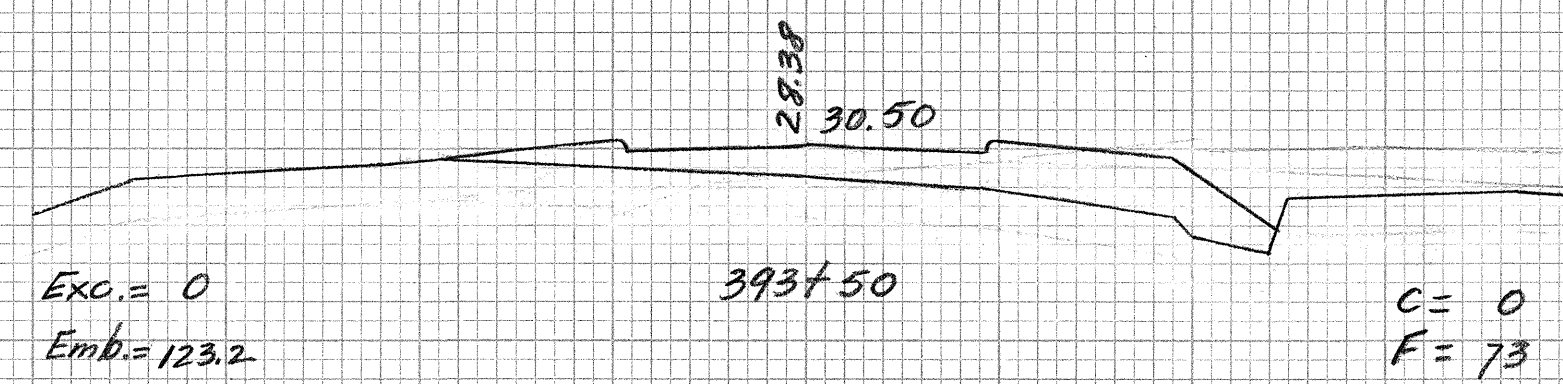
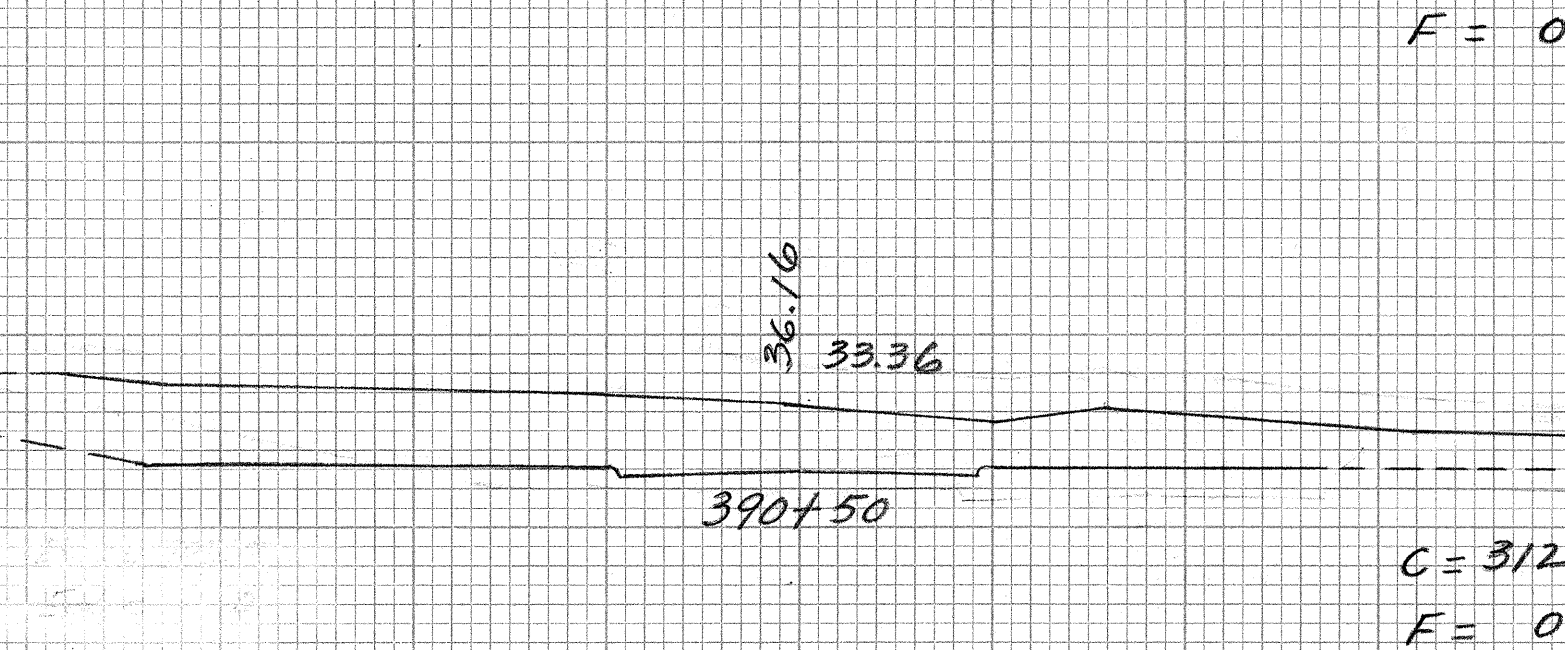
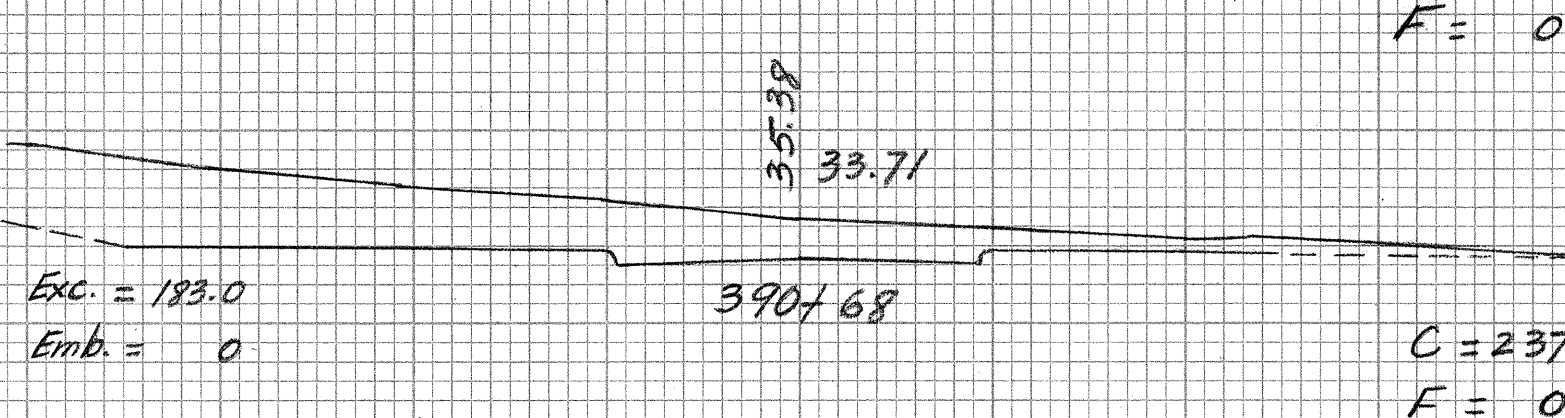
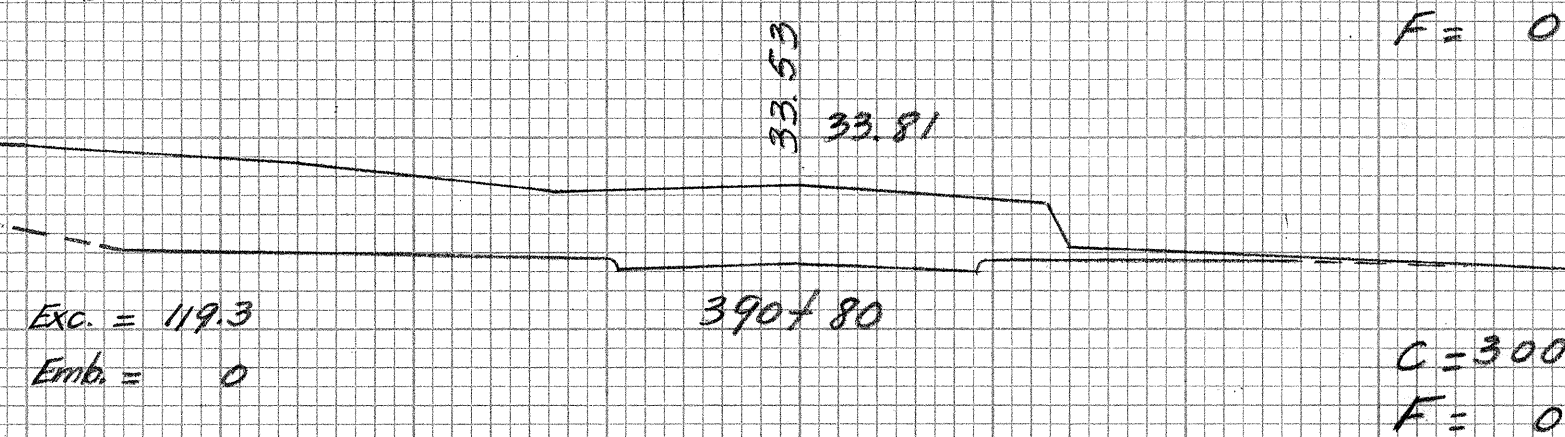
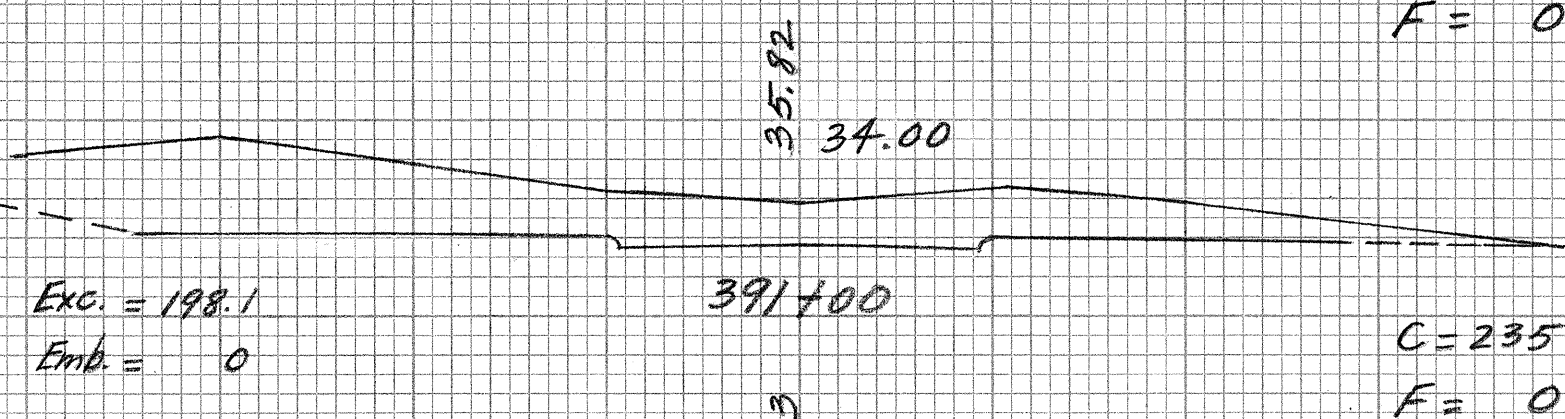
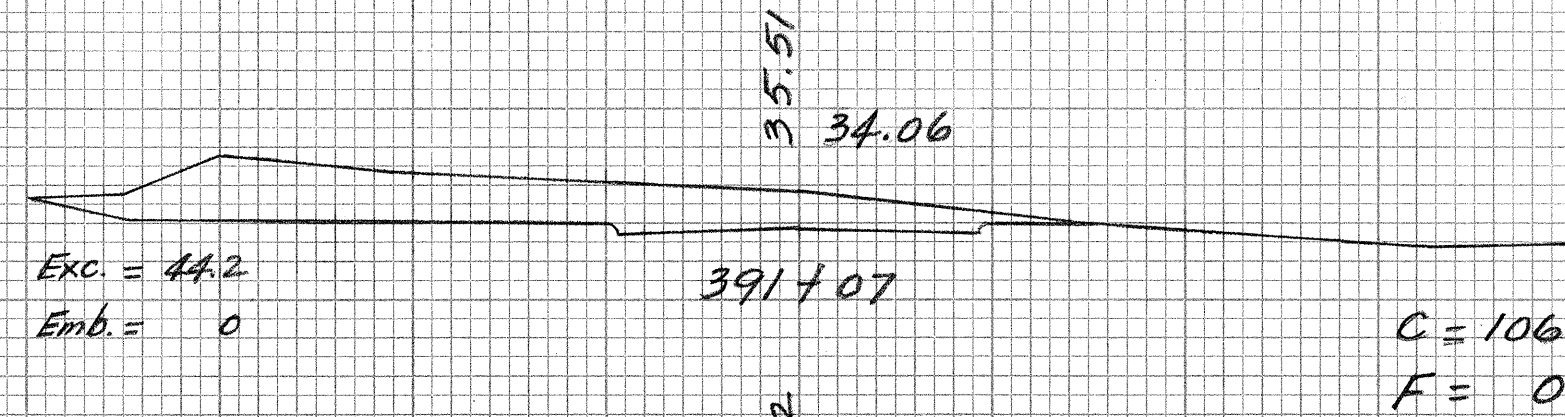
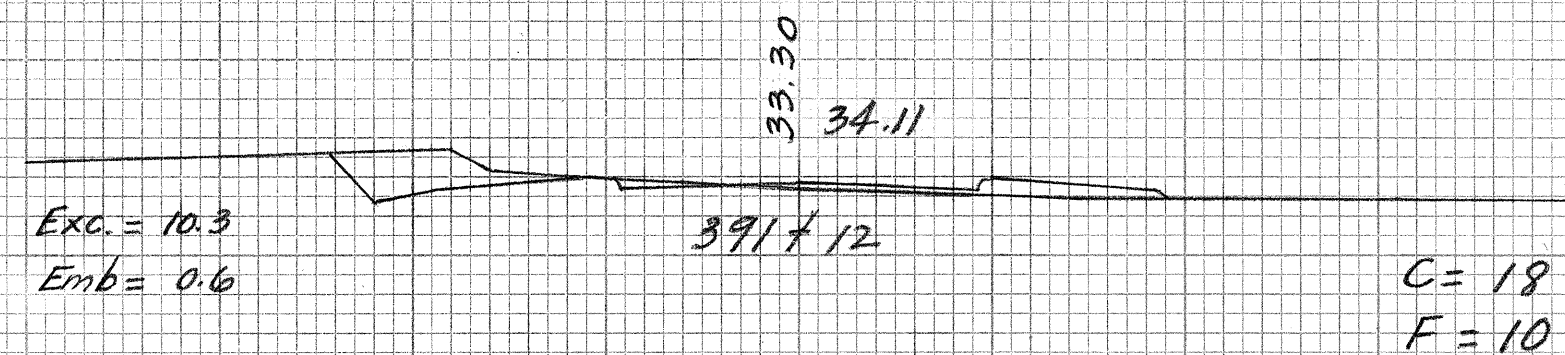
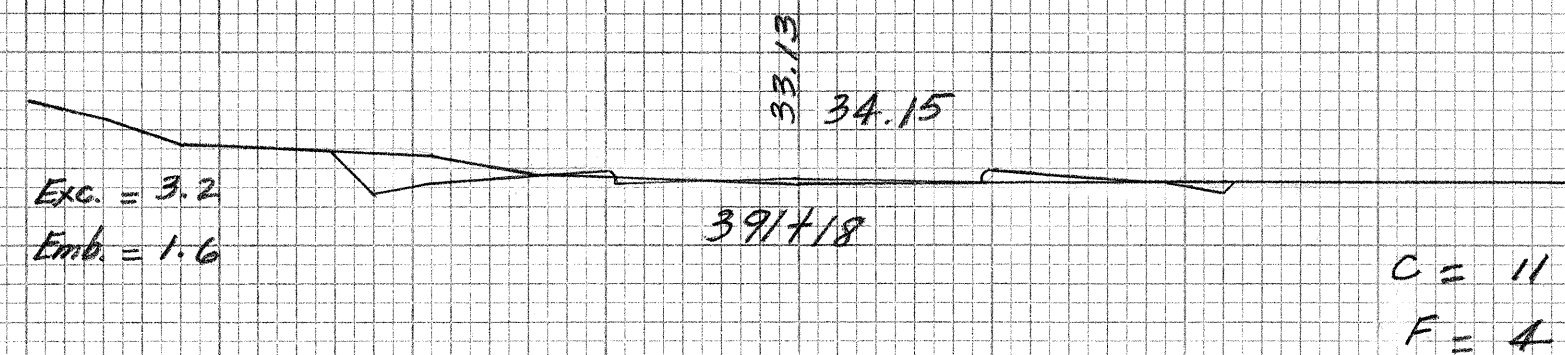
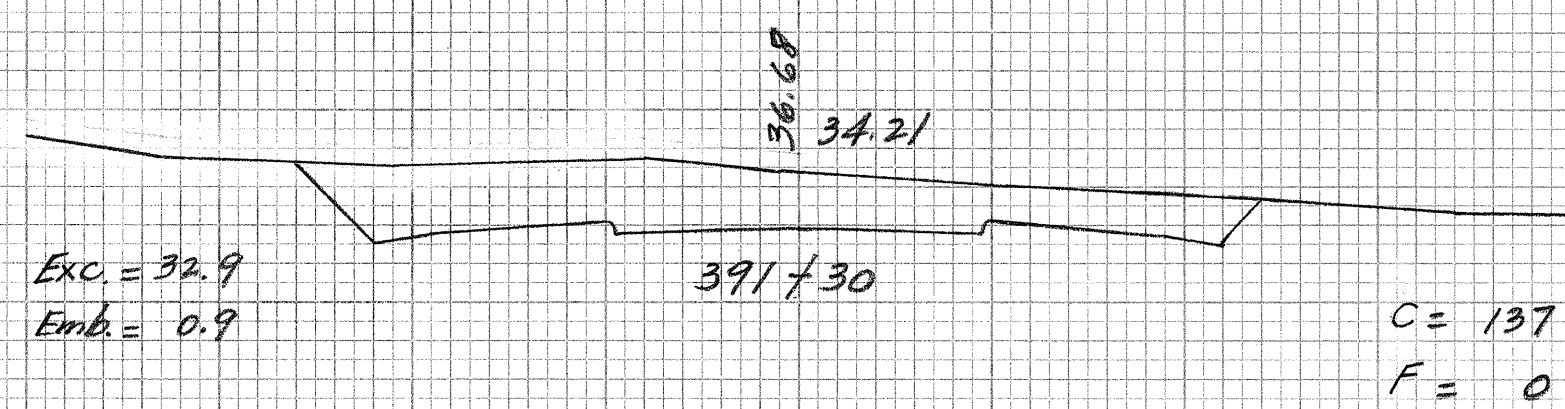
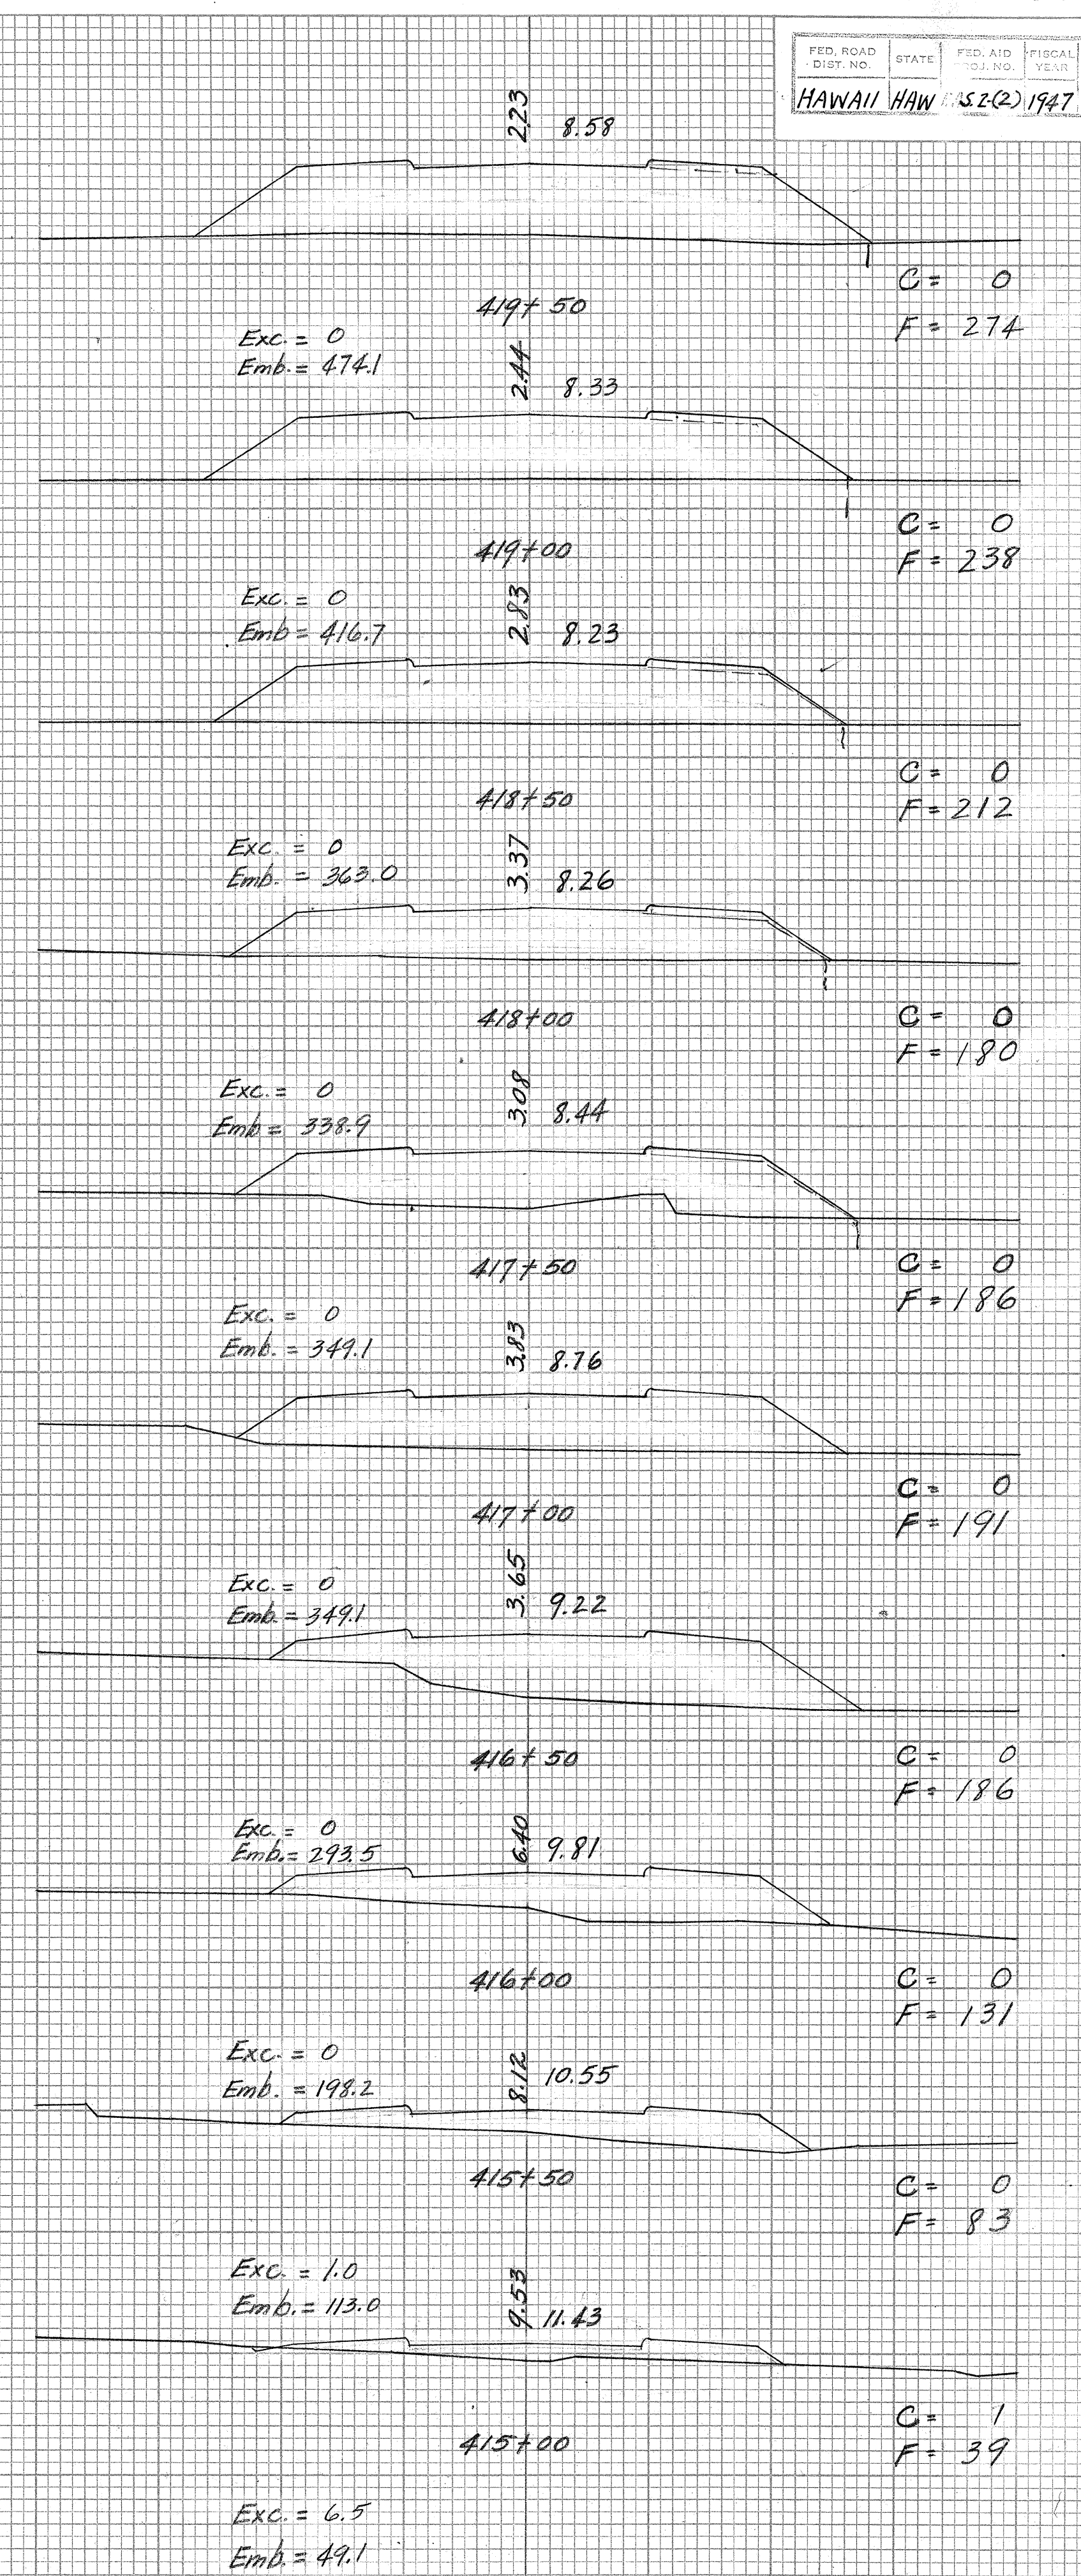


FED. ROAD DIST. NO.	STATE	FED. AID PROJ. NO.	FISCAL YEAR	SHEET NO.	TOTAL SHEETS
HAWAII	HAW.	520	1947	11	15

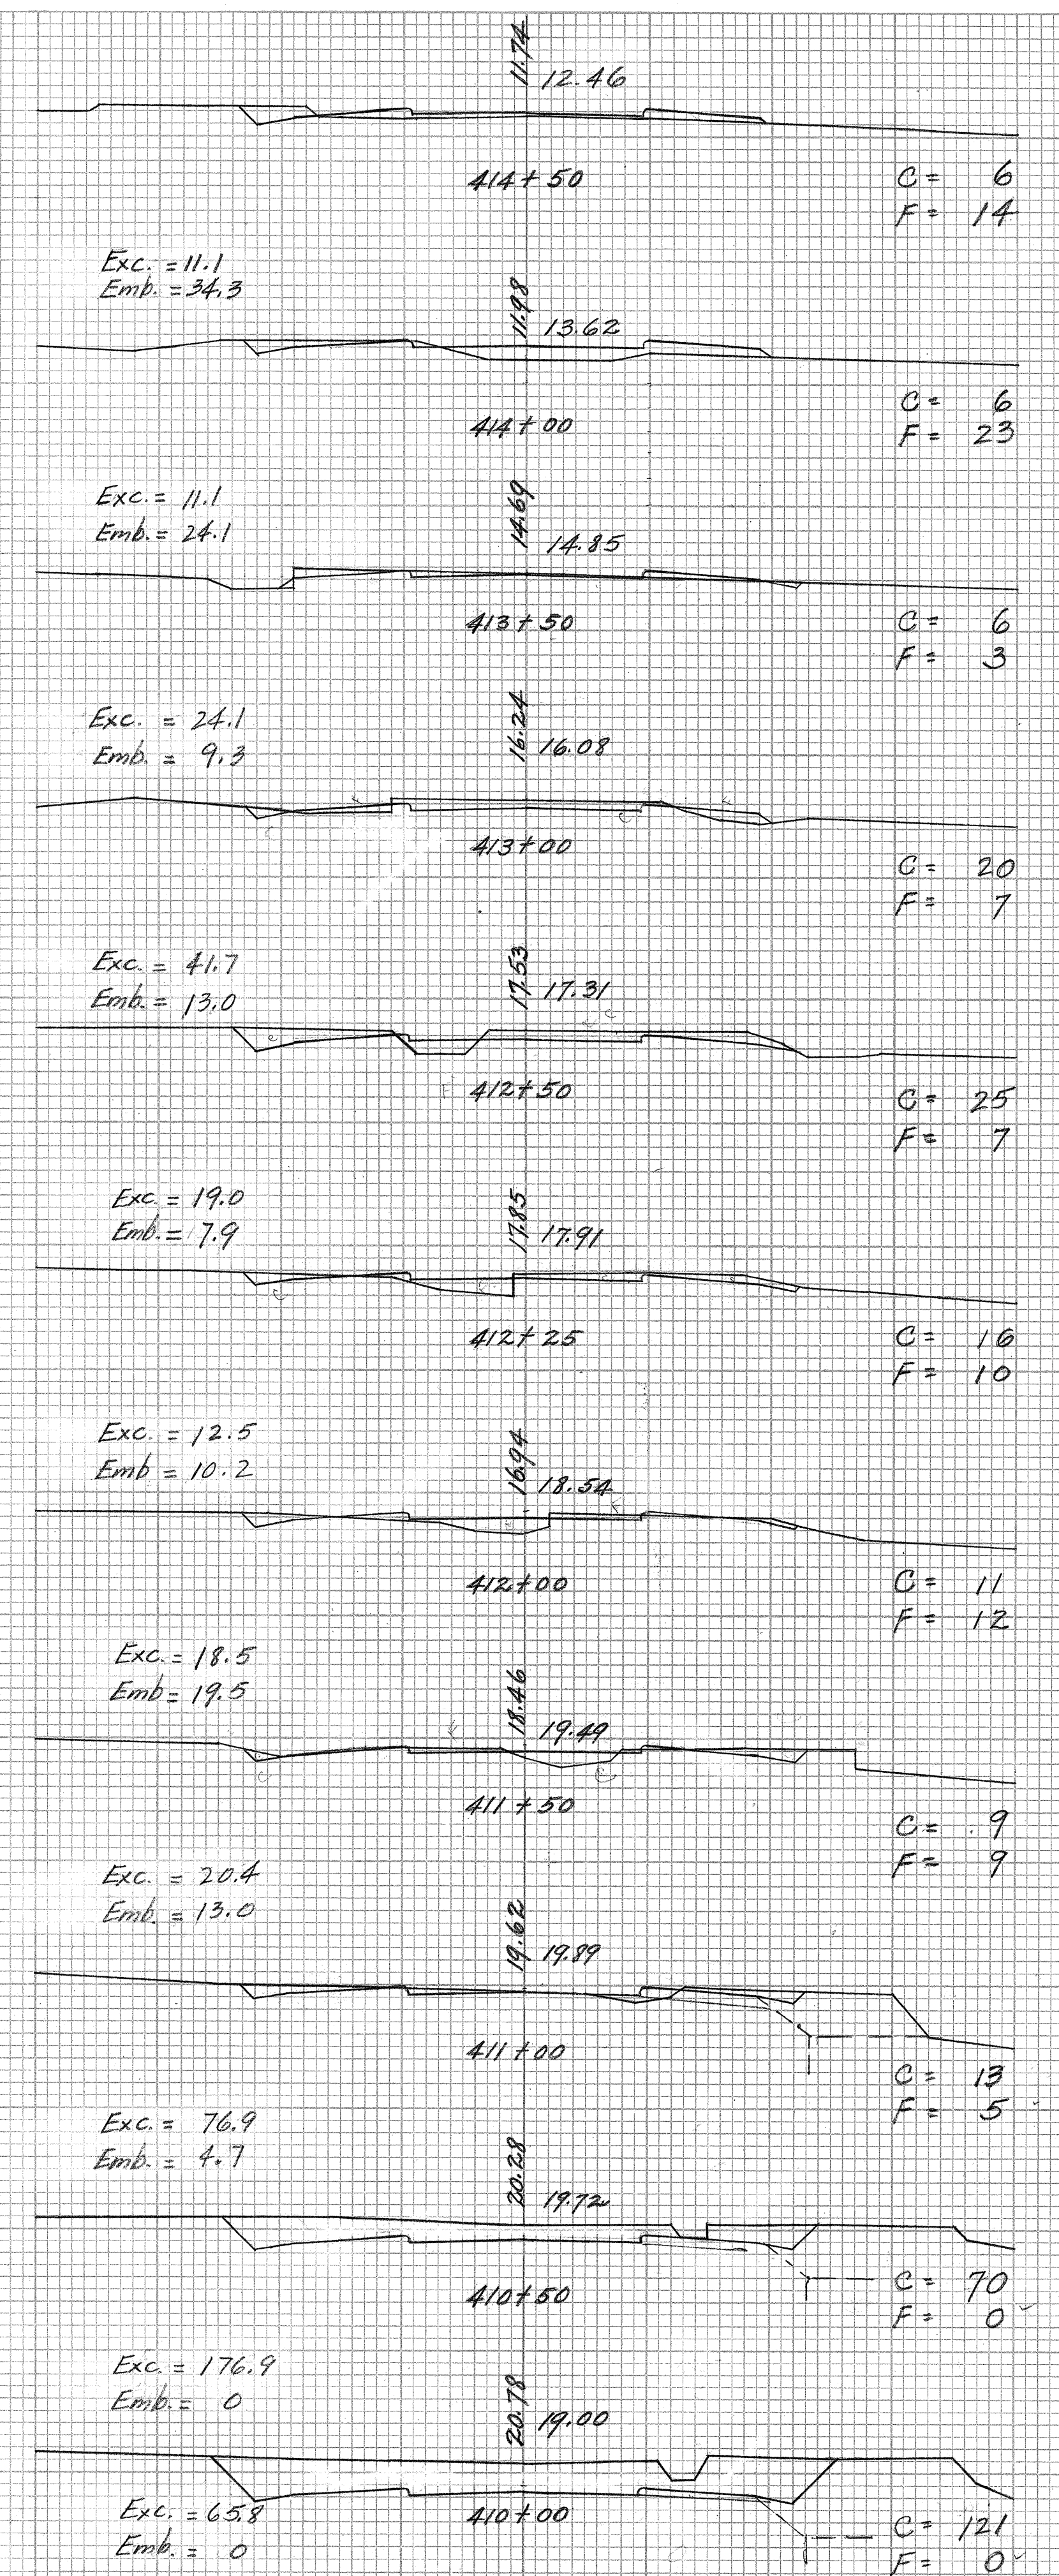

DATE: 11/1/50
BY: J. H. HANSEN
FINAL SURVEY PLOTTED
NOTE BOOK NO. 100
AREAS CHECKED

DATE: 11/1/50
BY: J. H. HANSEN
ORIGINAL SURVEY PLOTTED
NOTE BOOK NO. 100
AREAS CHECKED



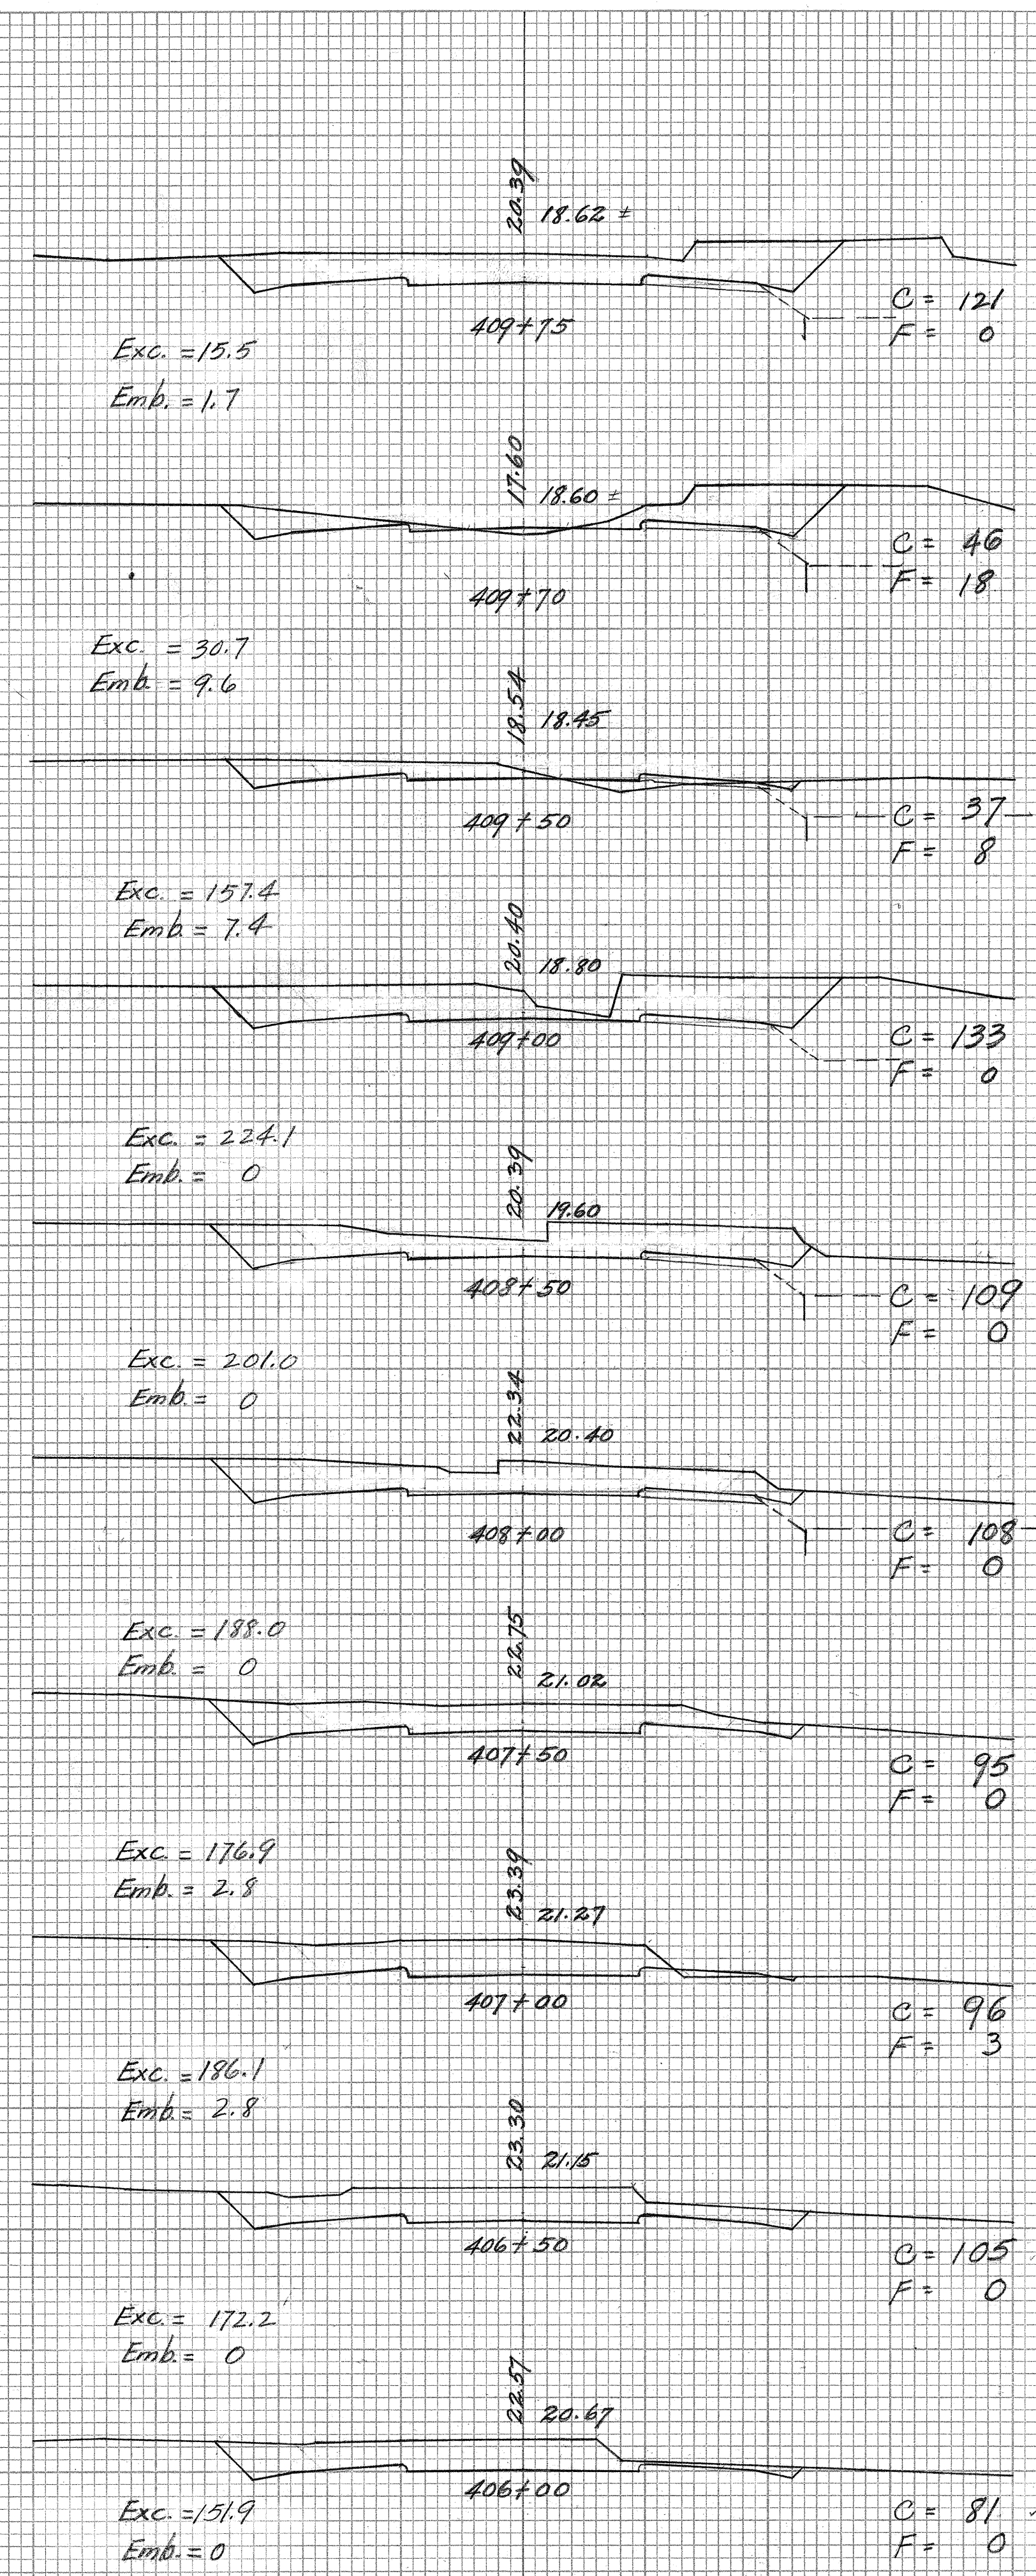


DATE	BY	REVISION
7/1/58	H. HAYASHI	
7/2/58	H. HAYASHI	

FINAL SURVEY	NO. 1
NOTE BOOK	NO. 1
AREAS CHECKED	AREAS CHECKED




DATE	BY	REVISION

ORIGINAL SURVEY	NO. 1
NOTE BOOK	NO. 1
AREAS CHECKED	AREAS CHECKED

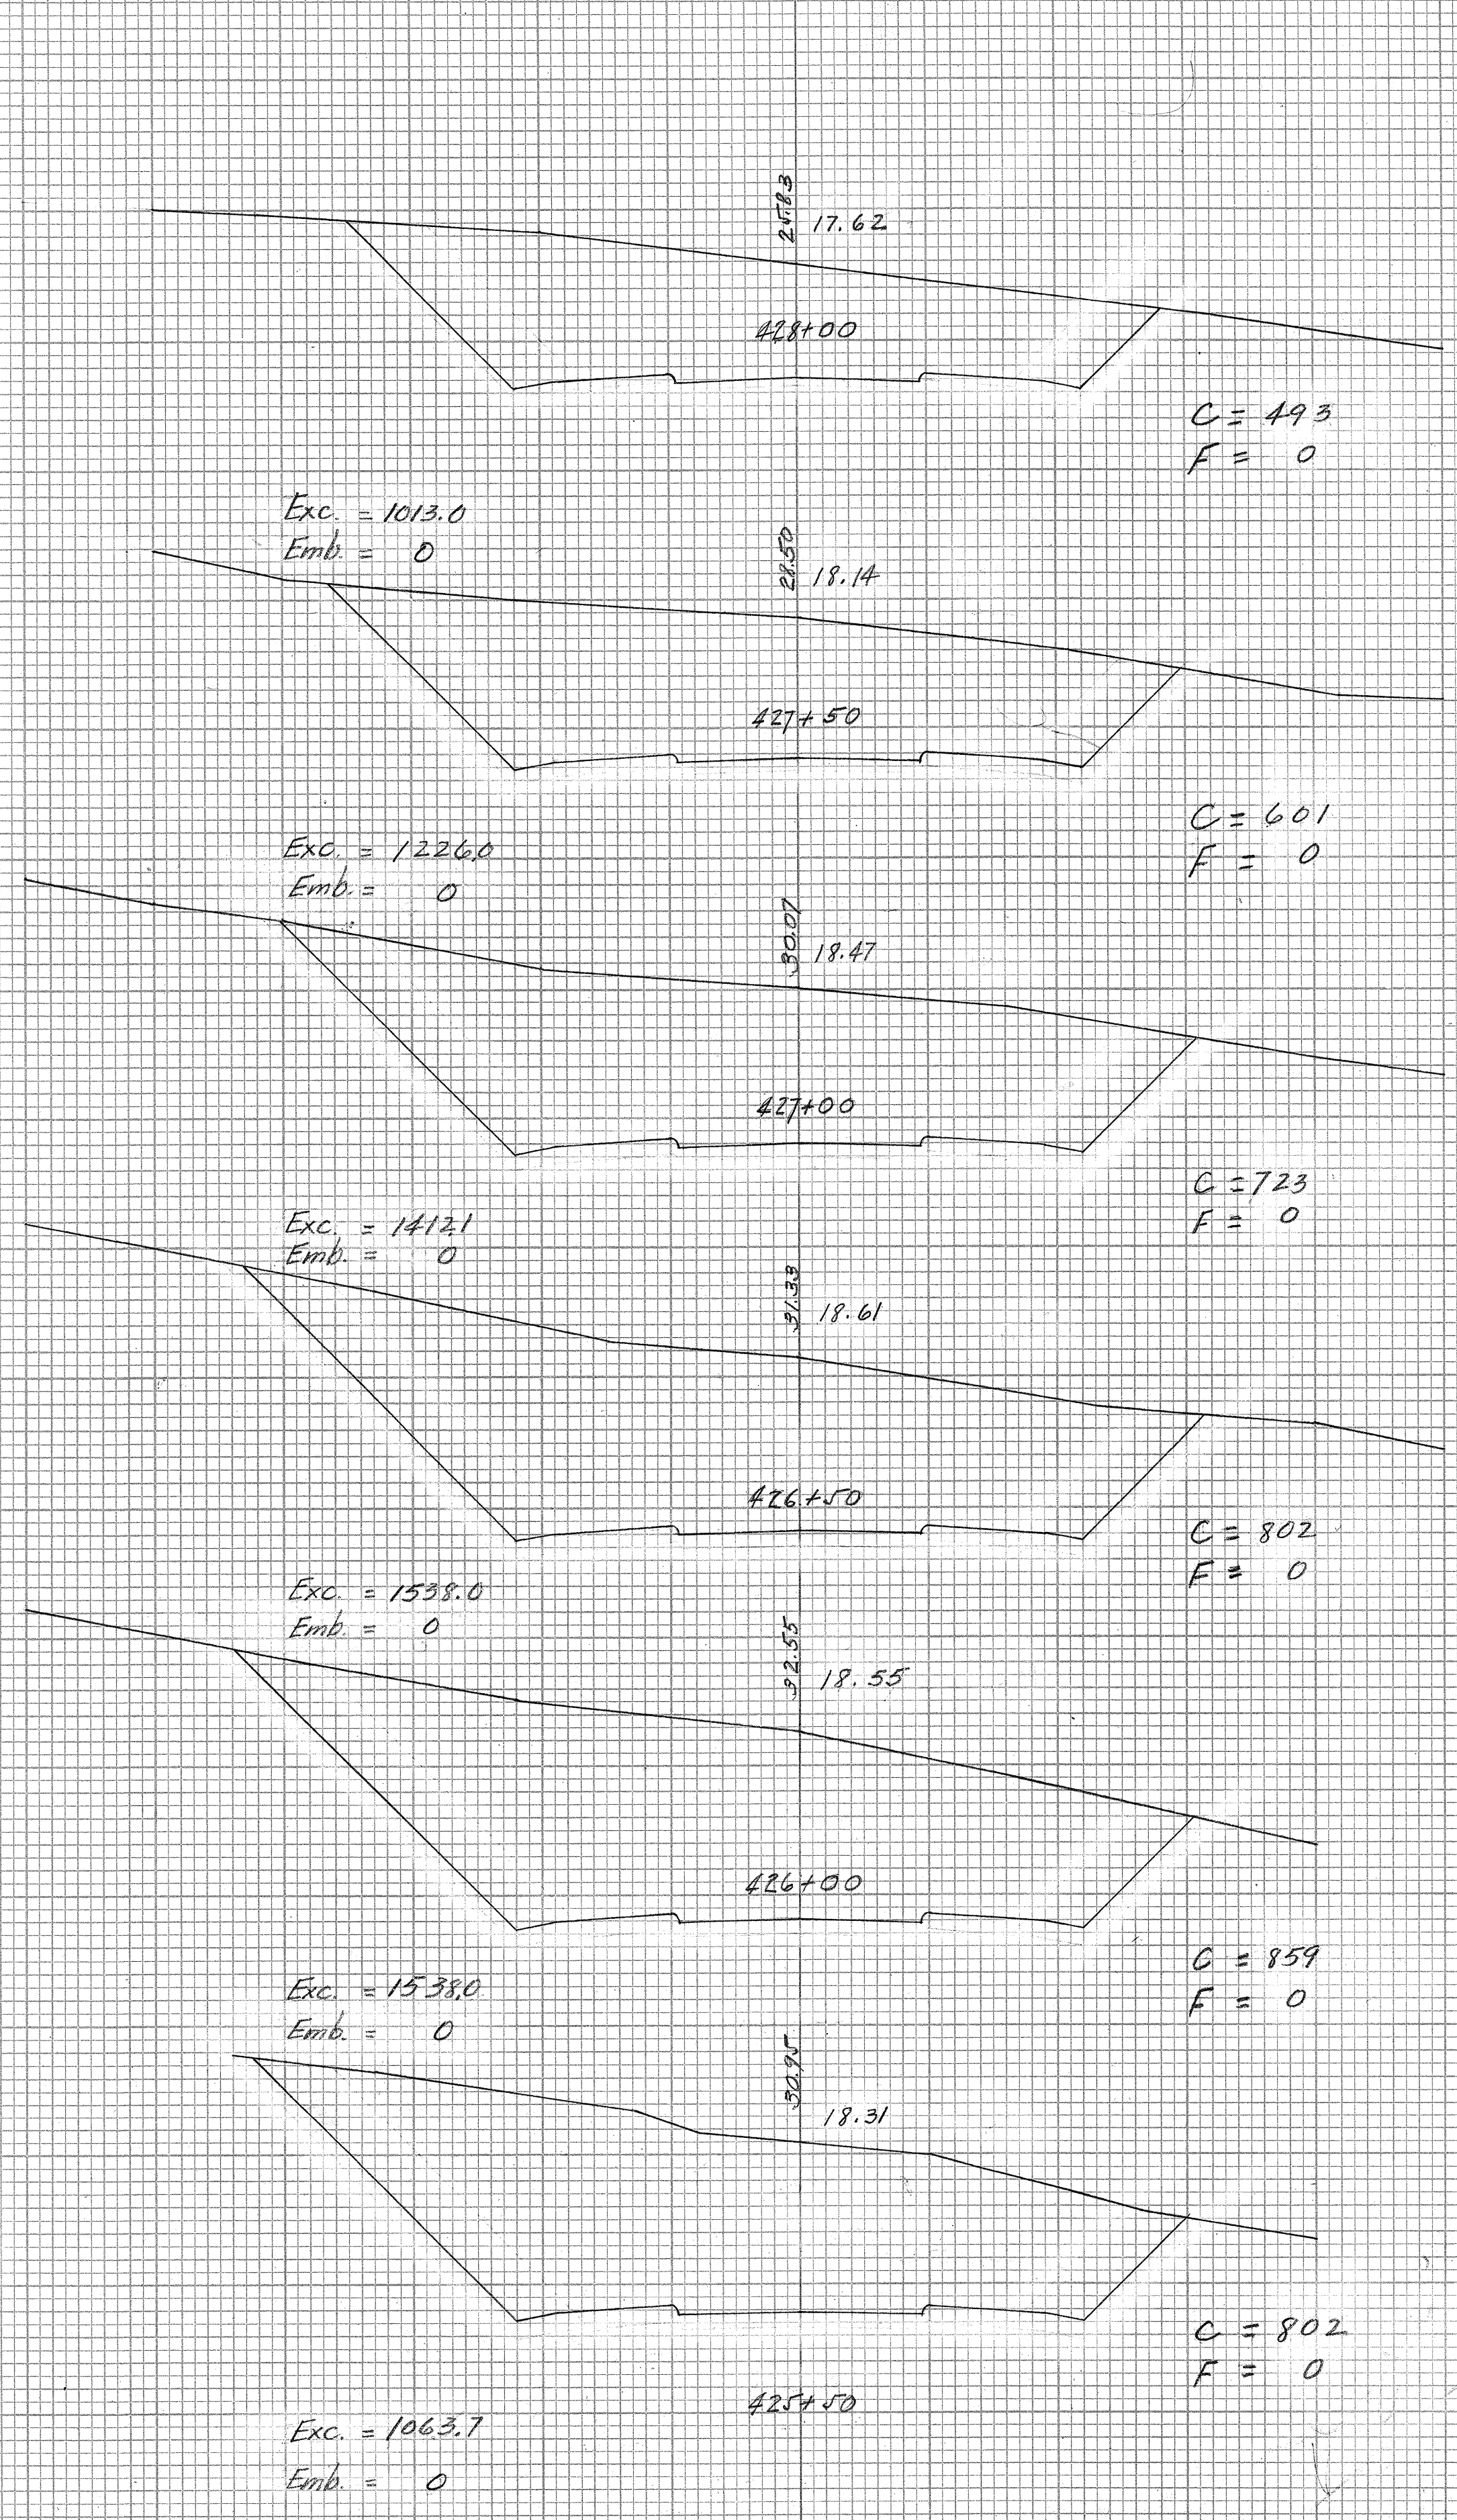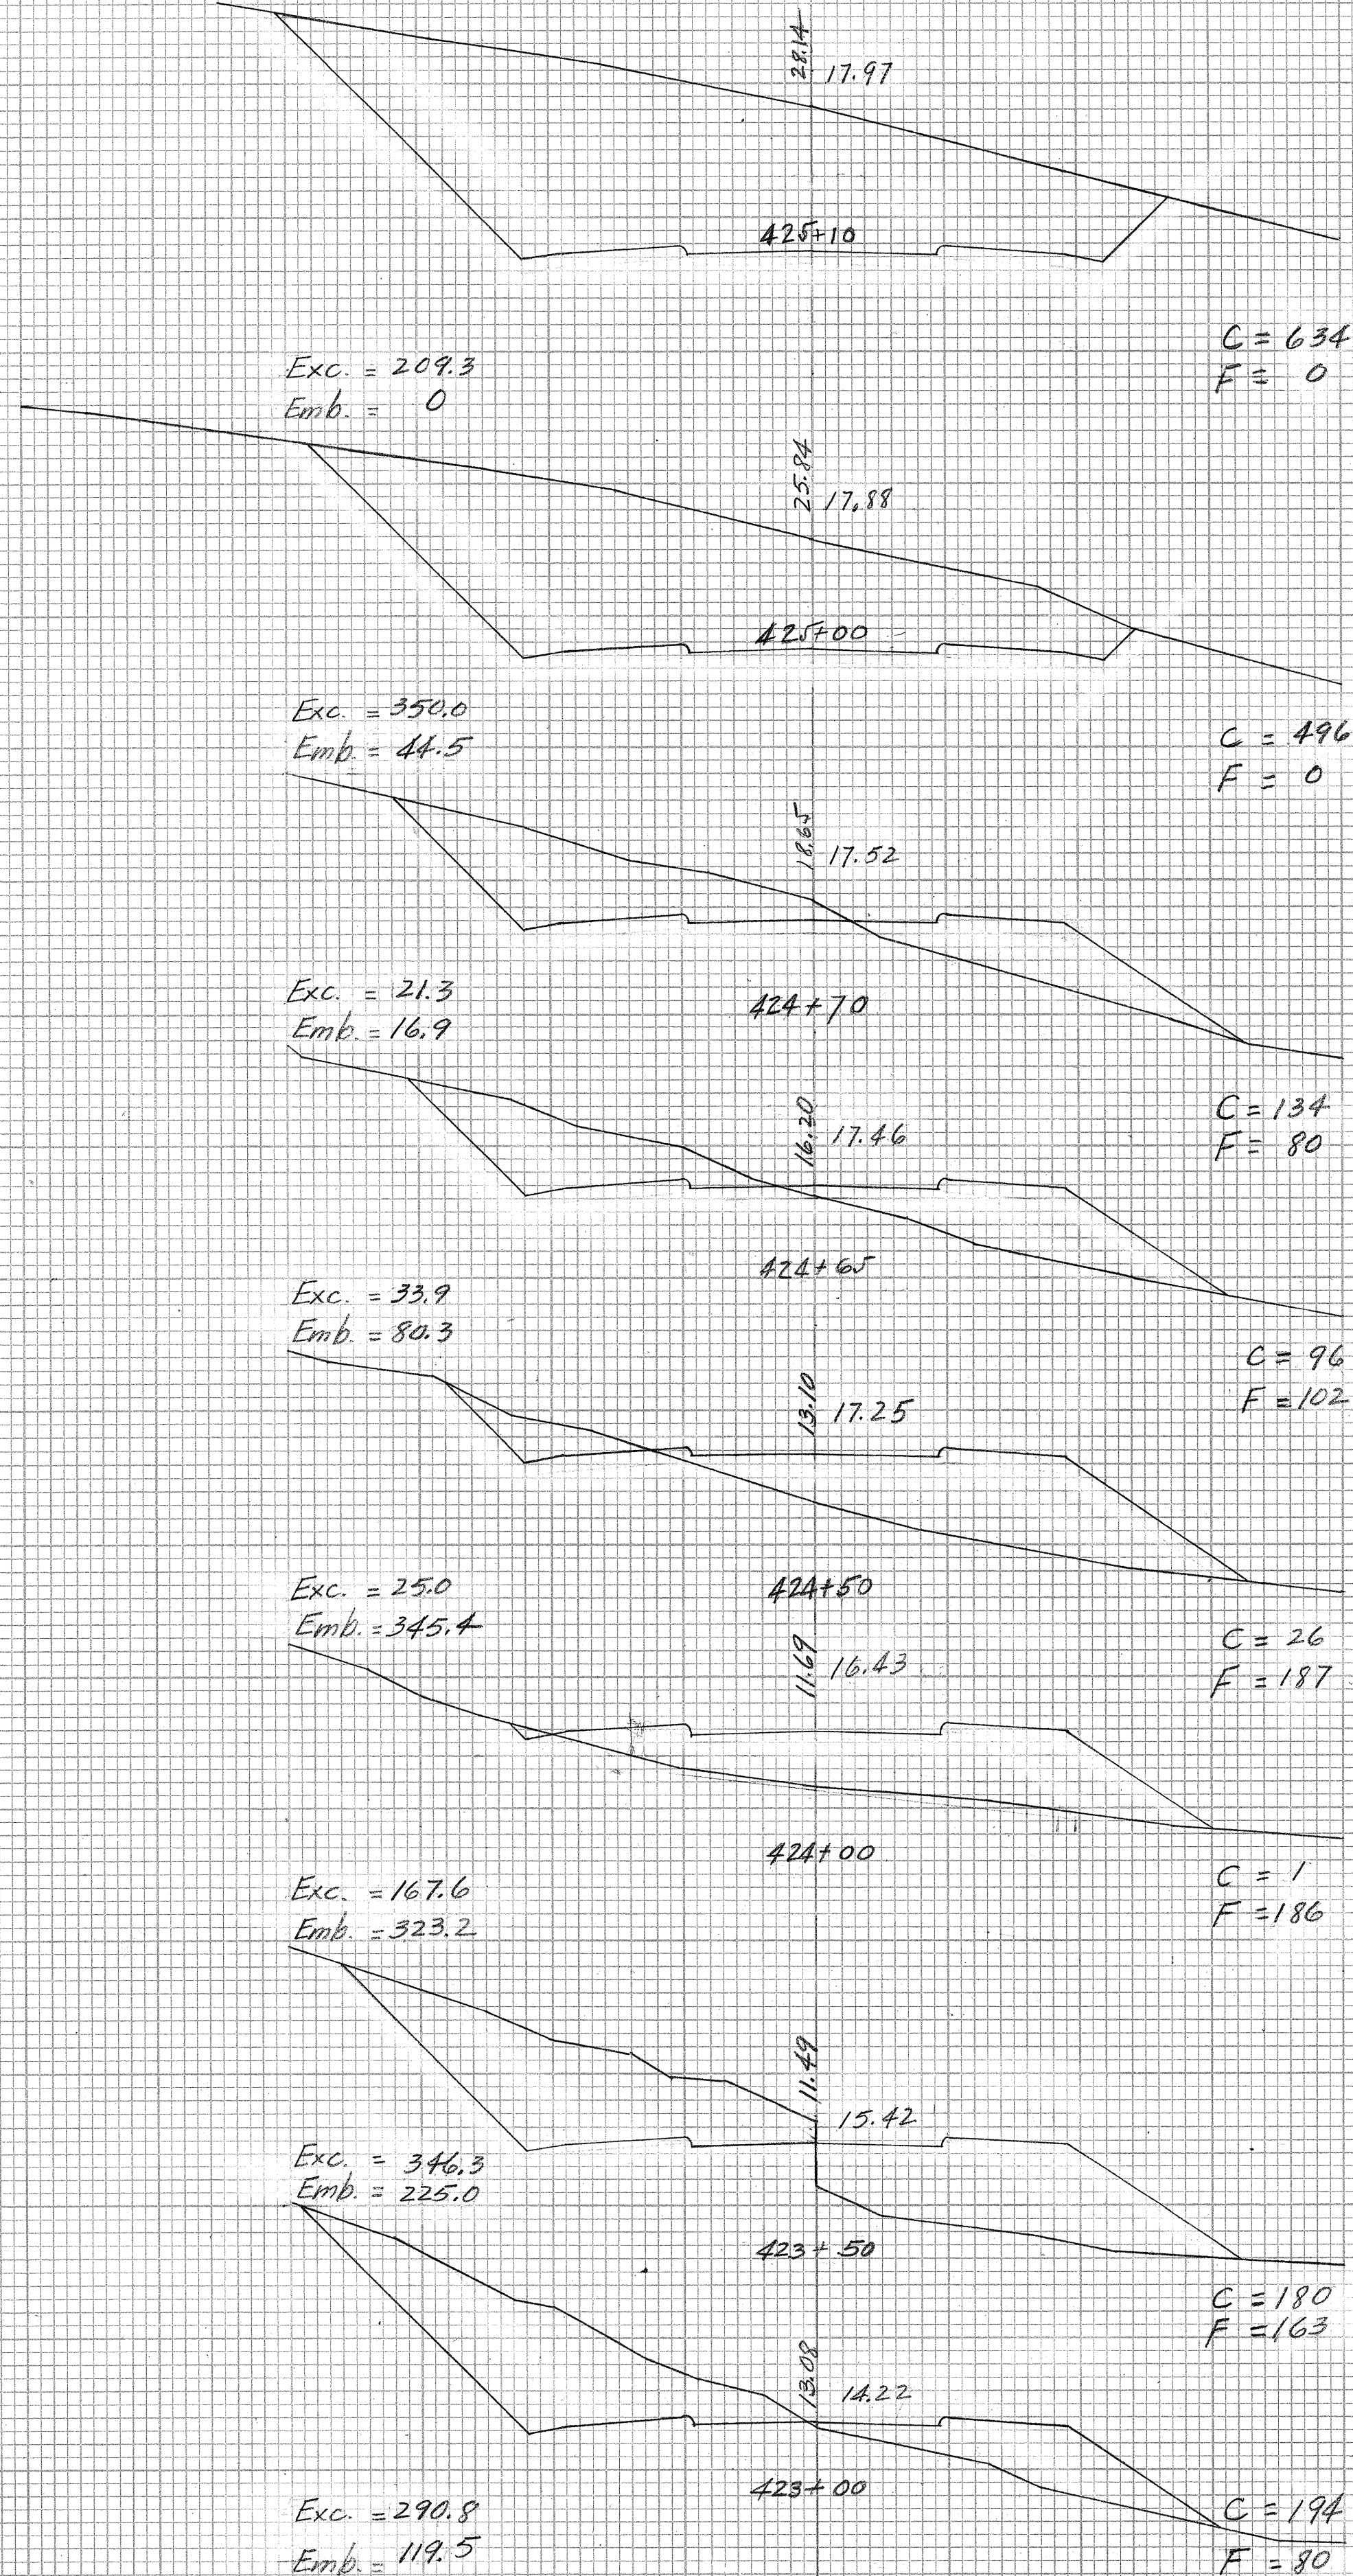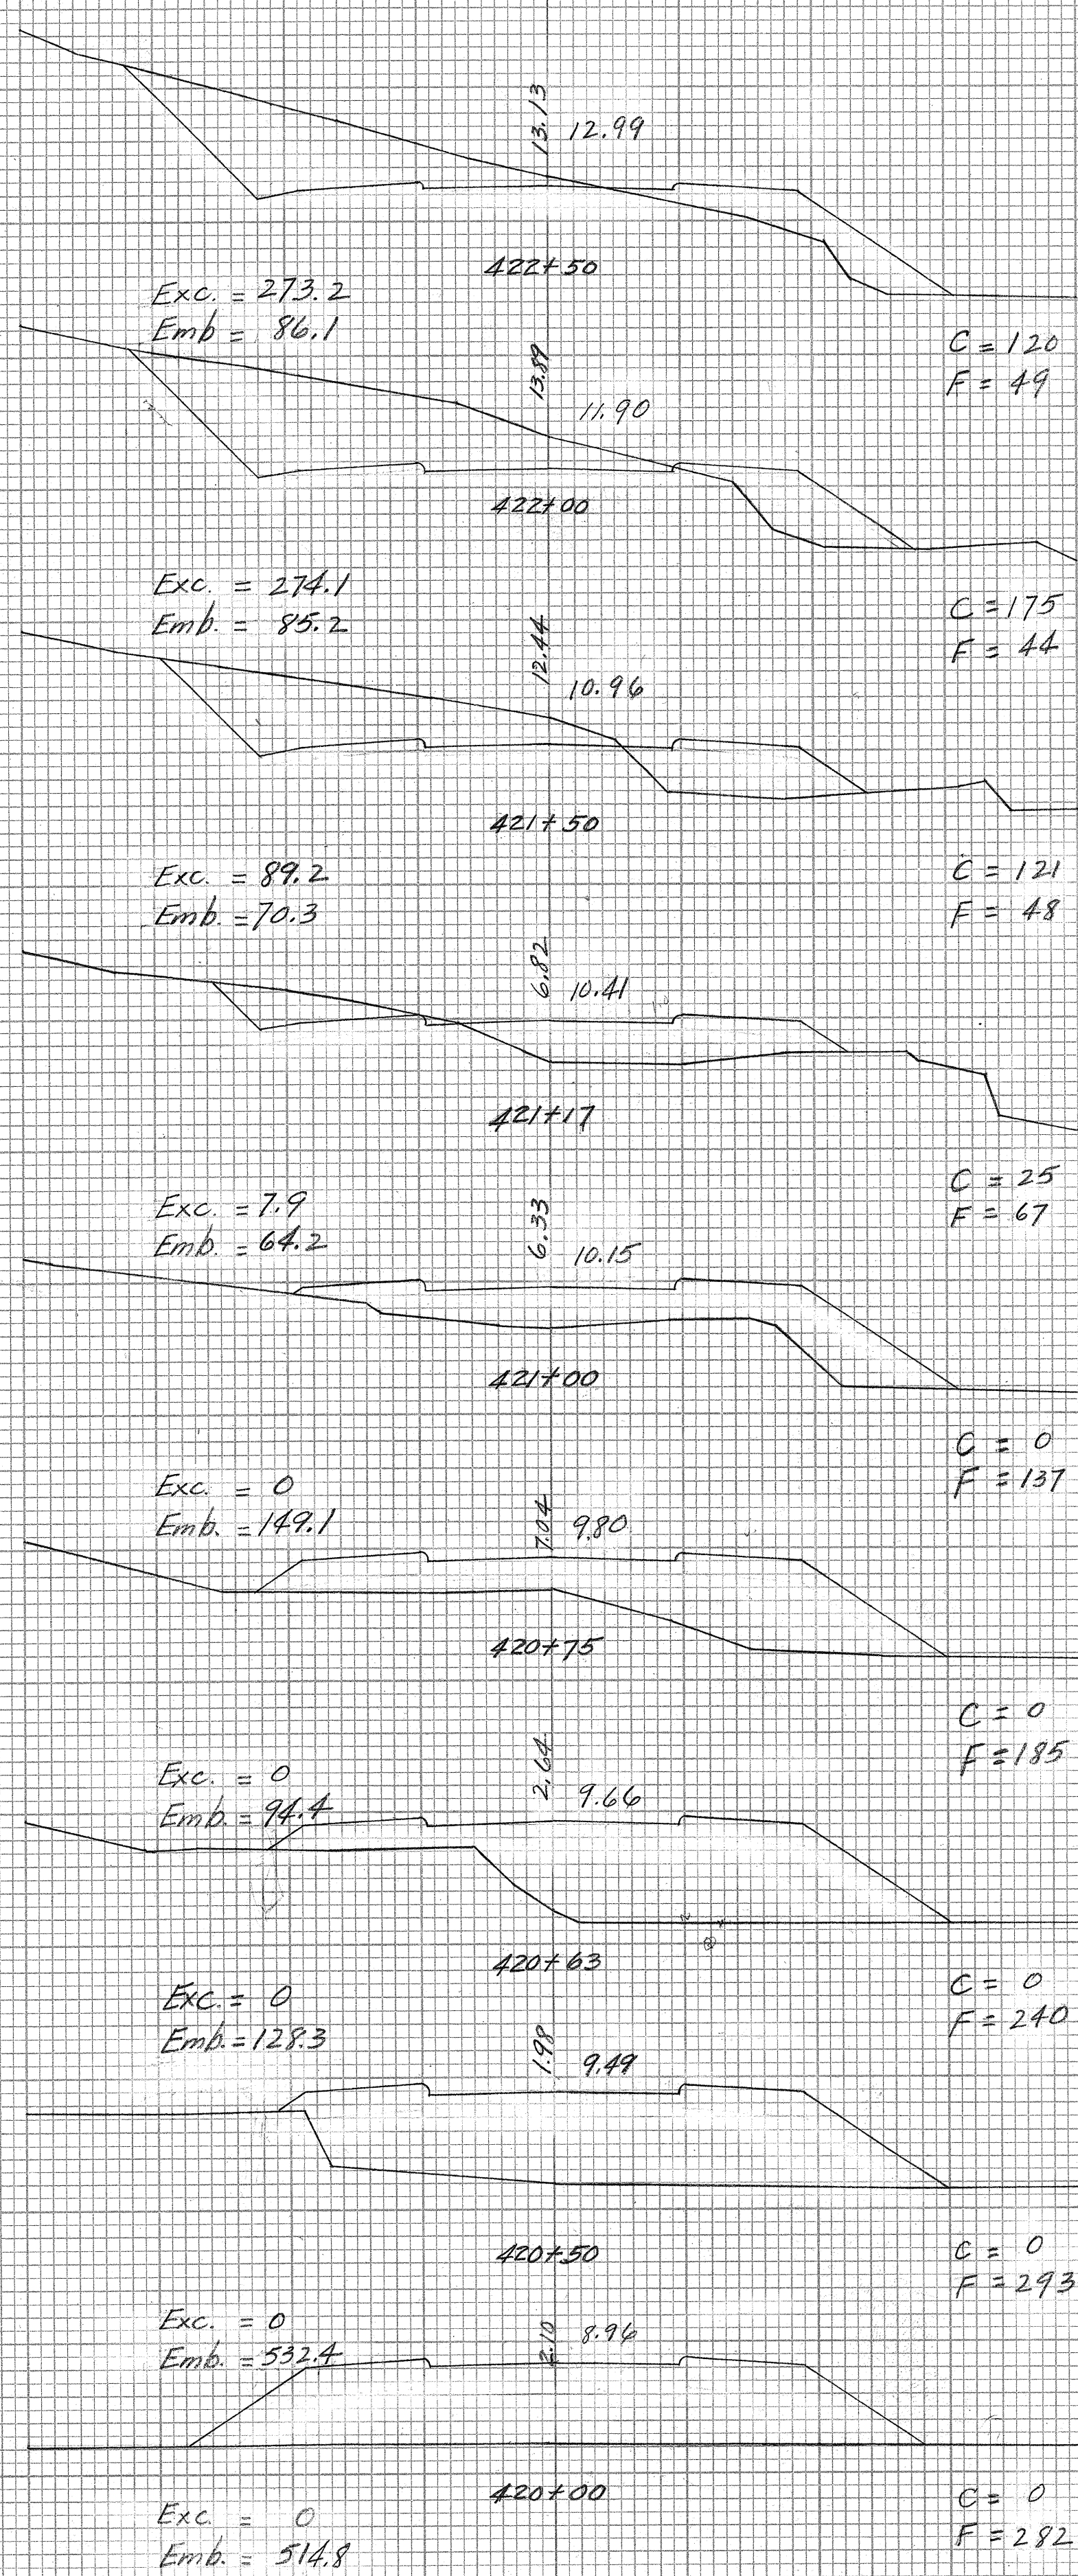

DATE	BY	ORIGINAL SURVEY	NOTED	PLOTTED	TEMP.	NO.
11/1/47	H. HAYASHI					

DATE	BY	ORIGINAL SURVEY	NOTED	PLOTTED	TEMP.	NO.

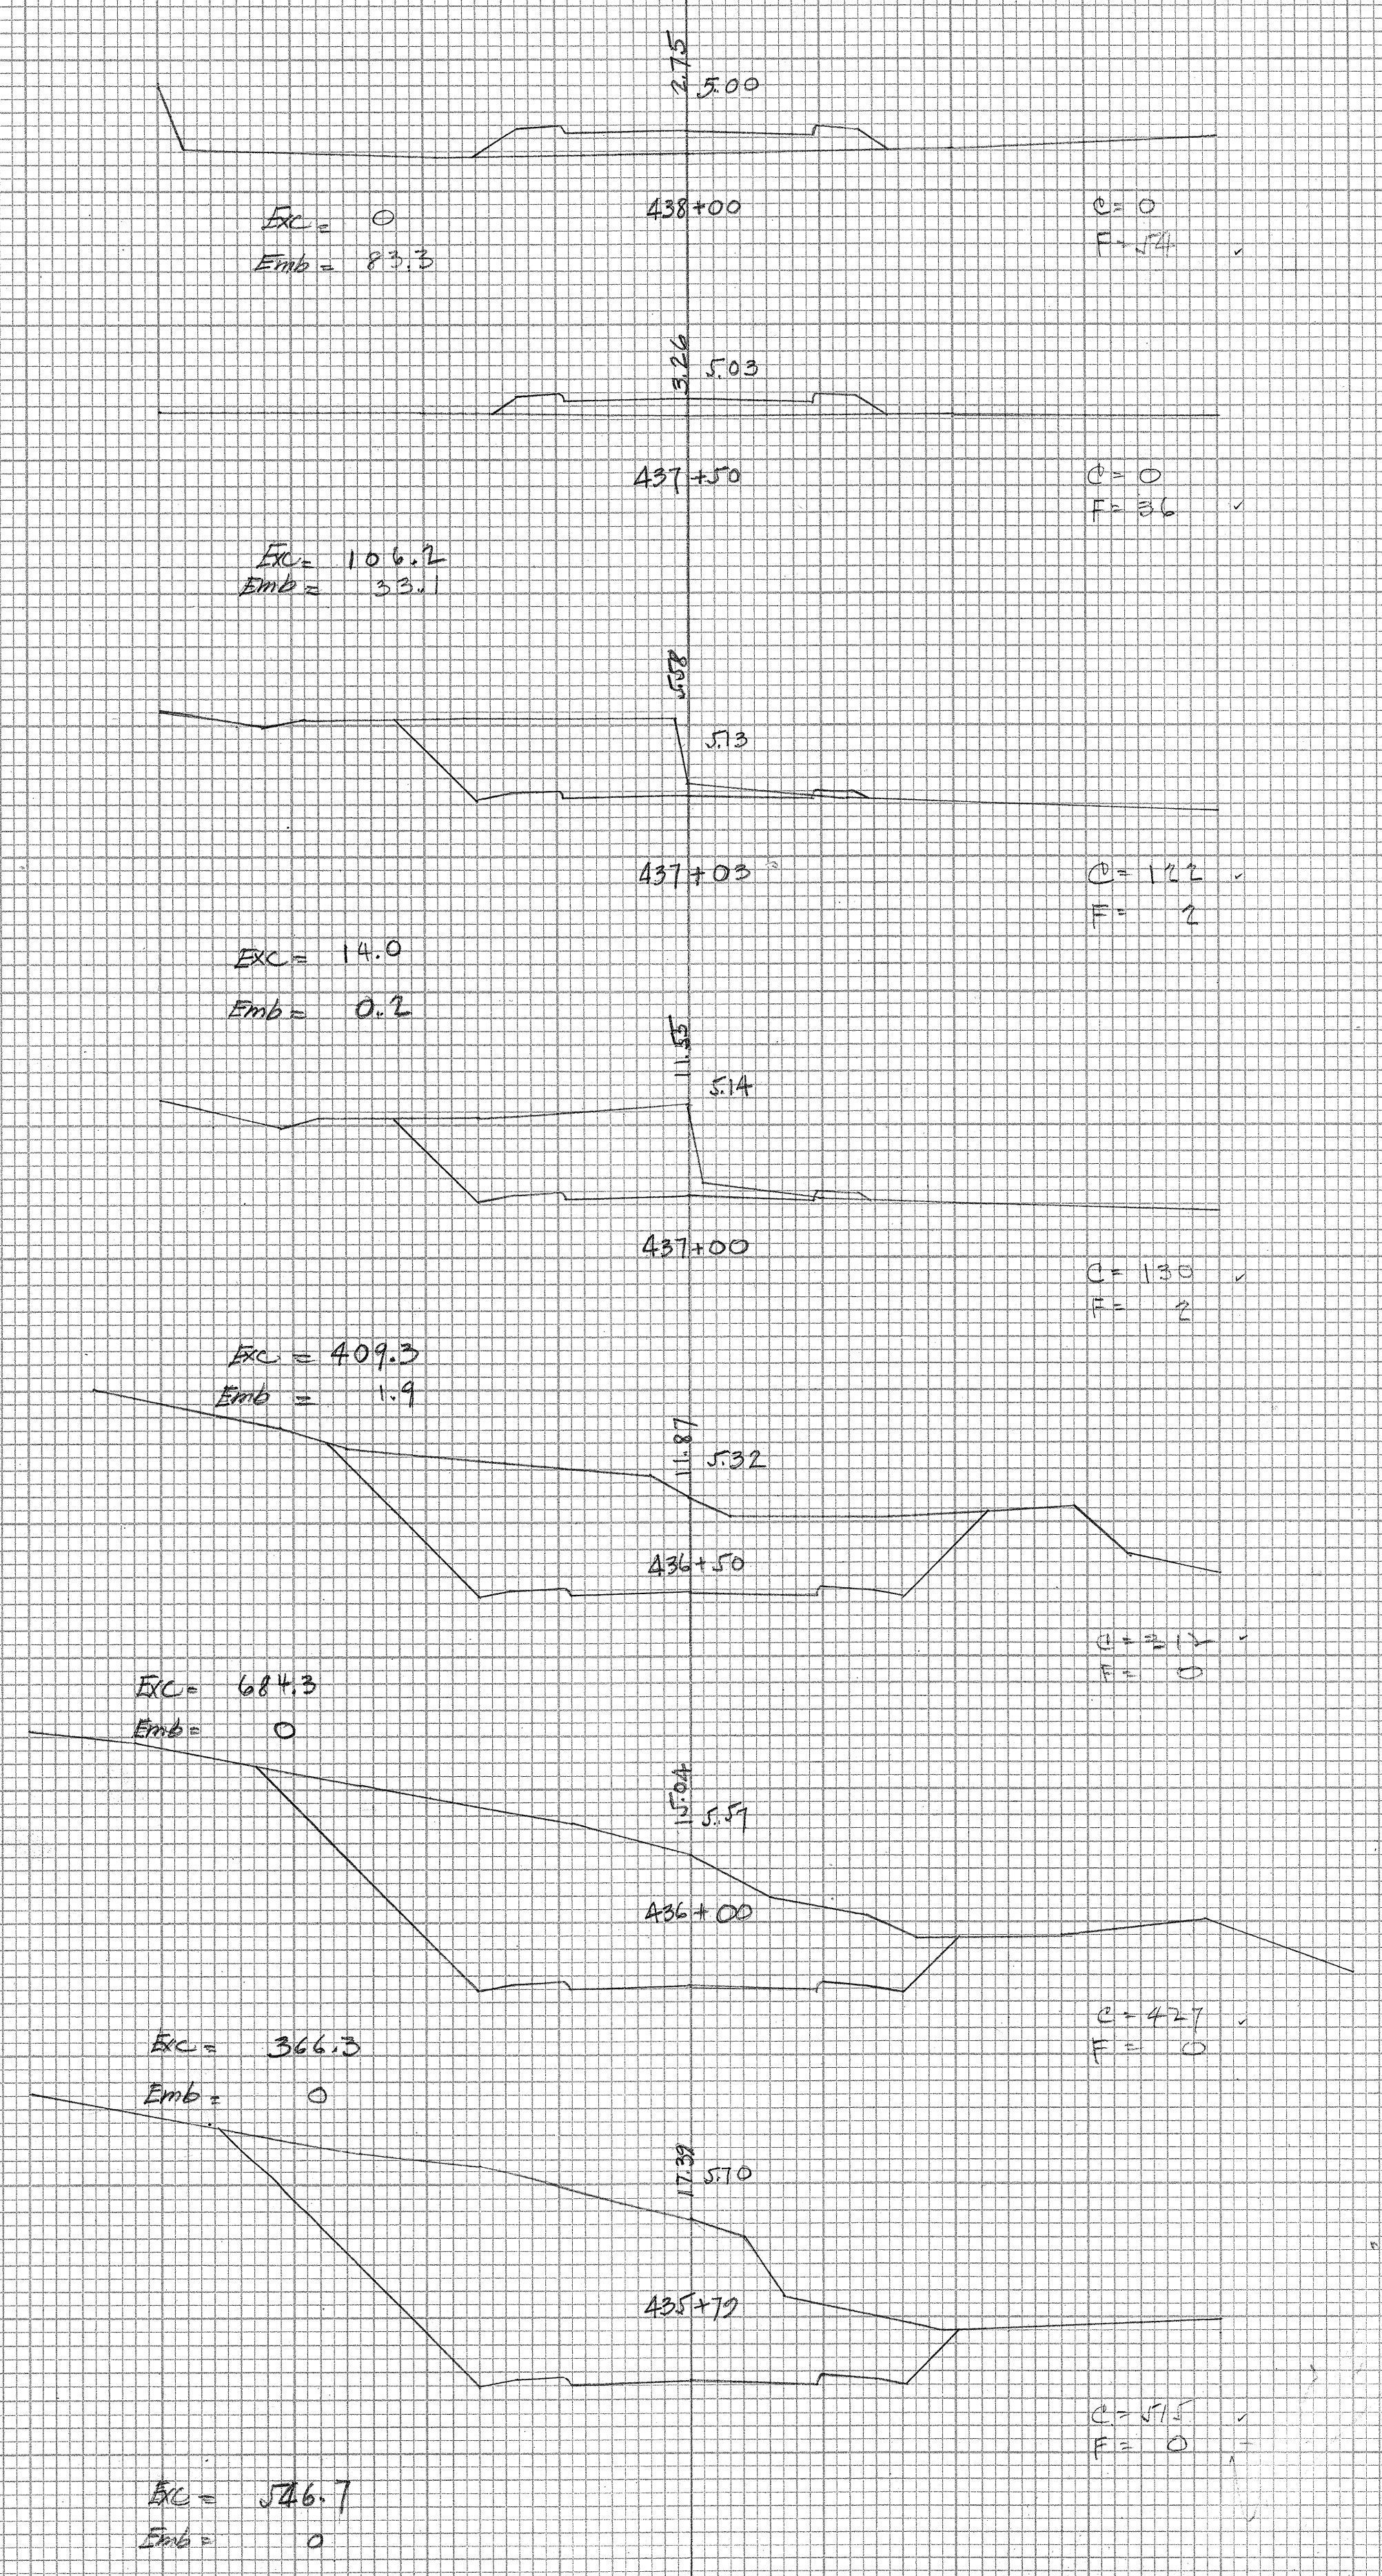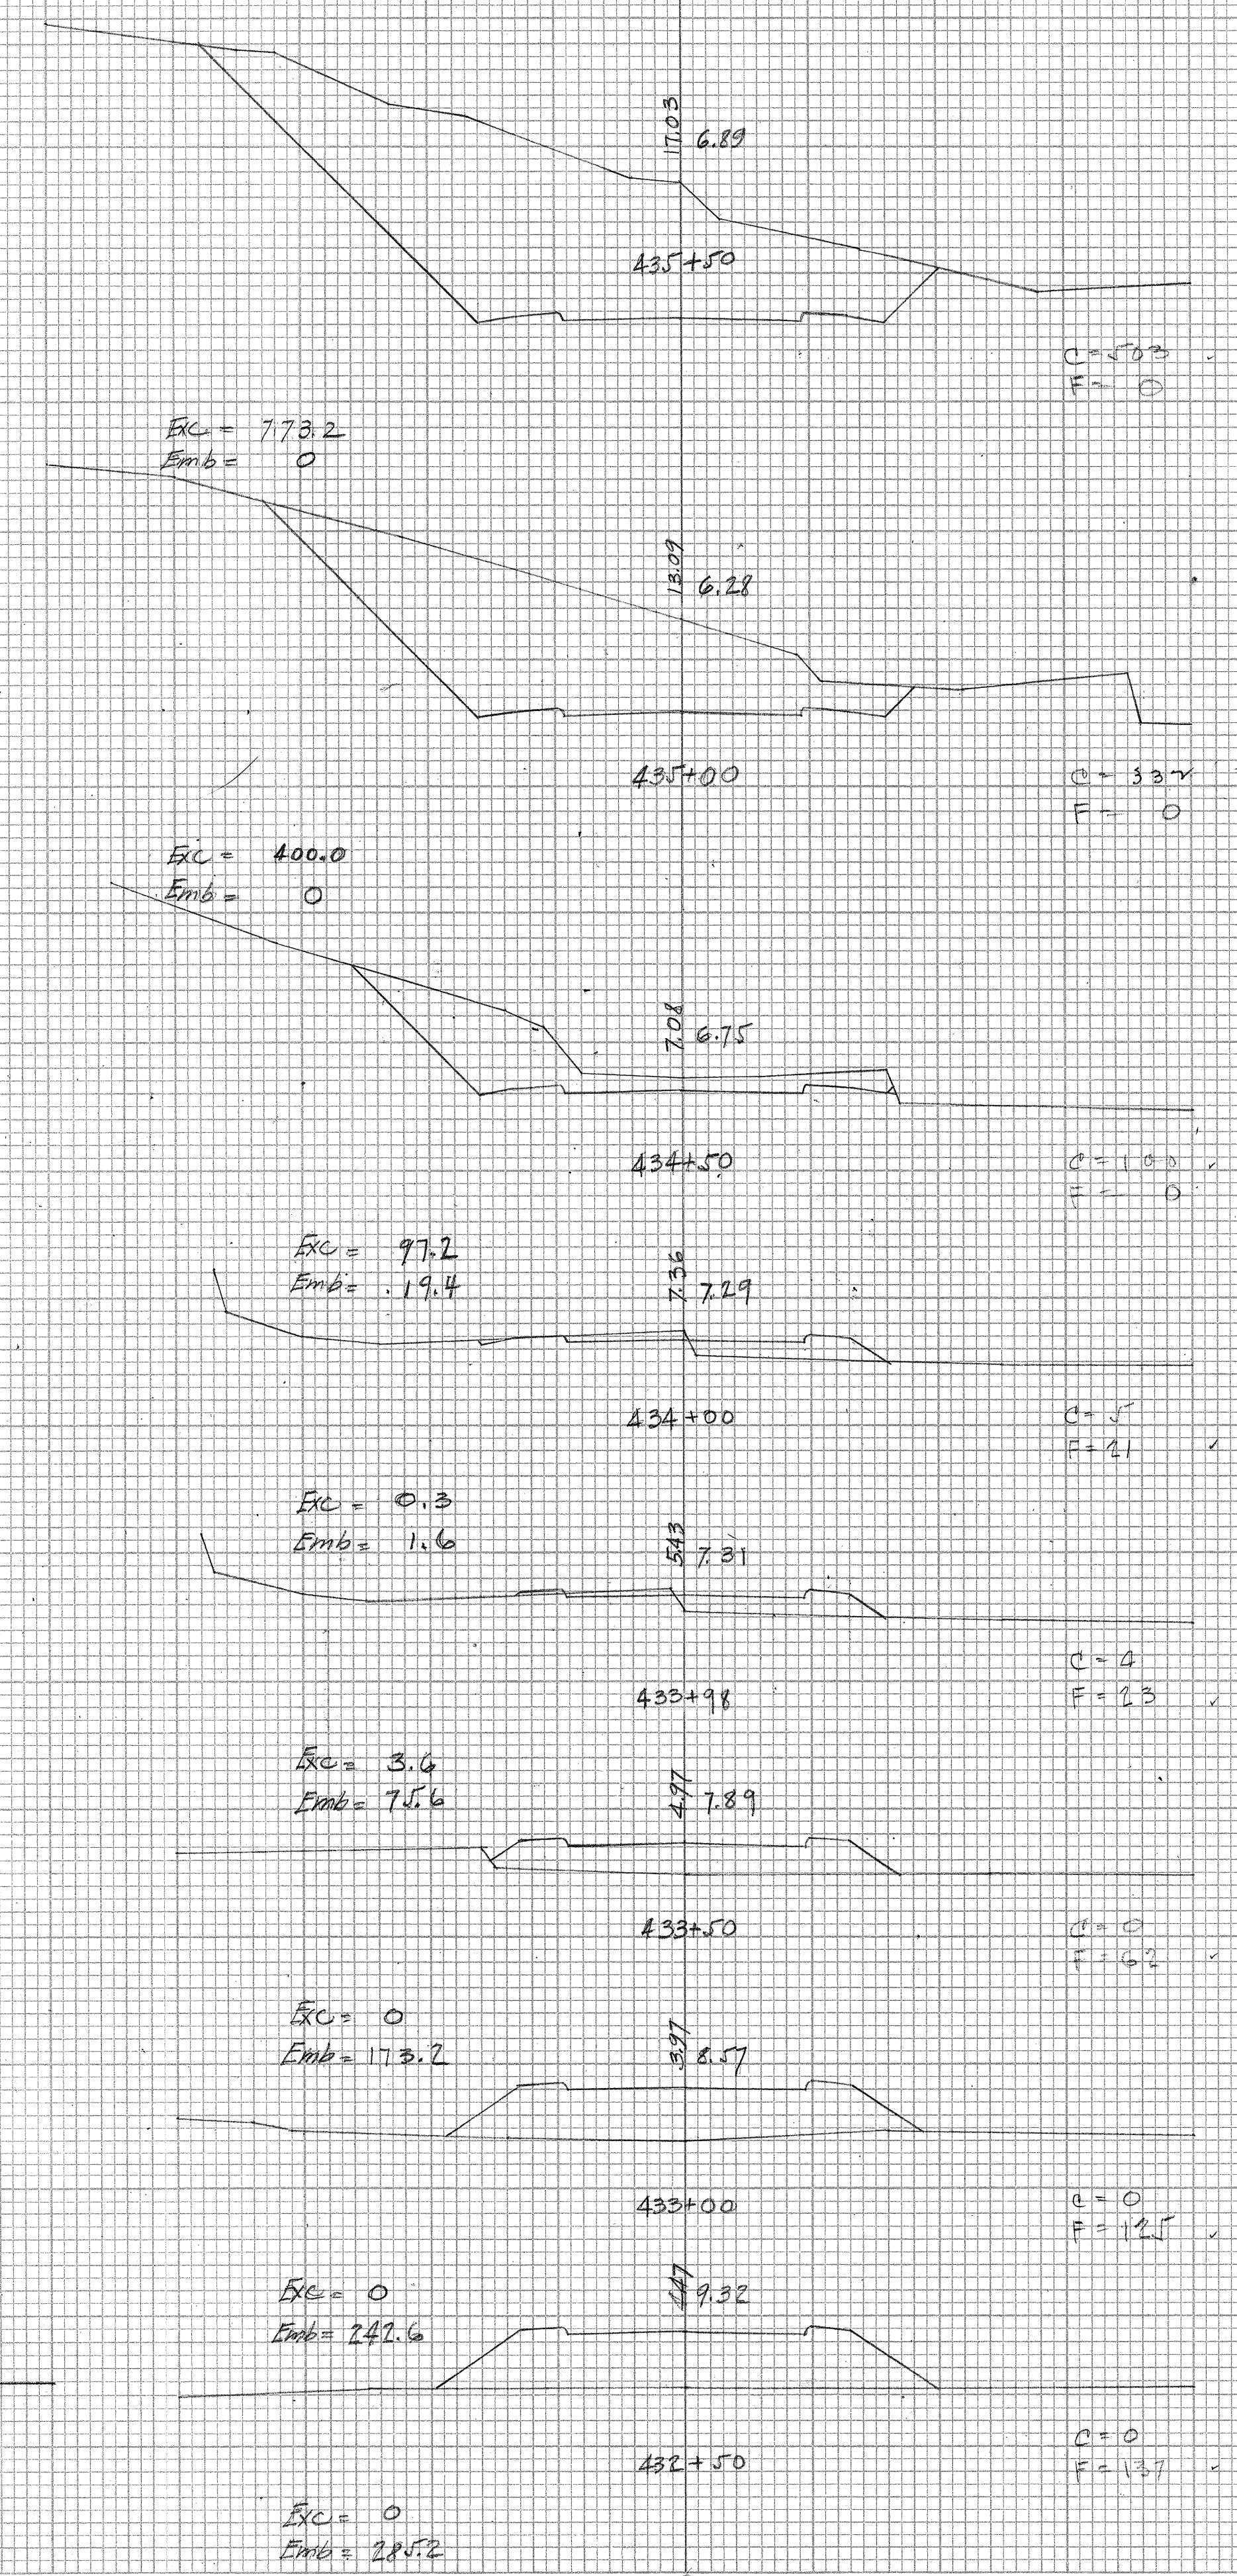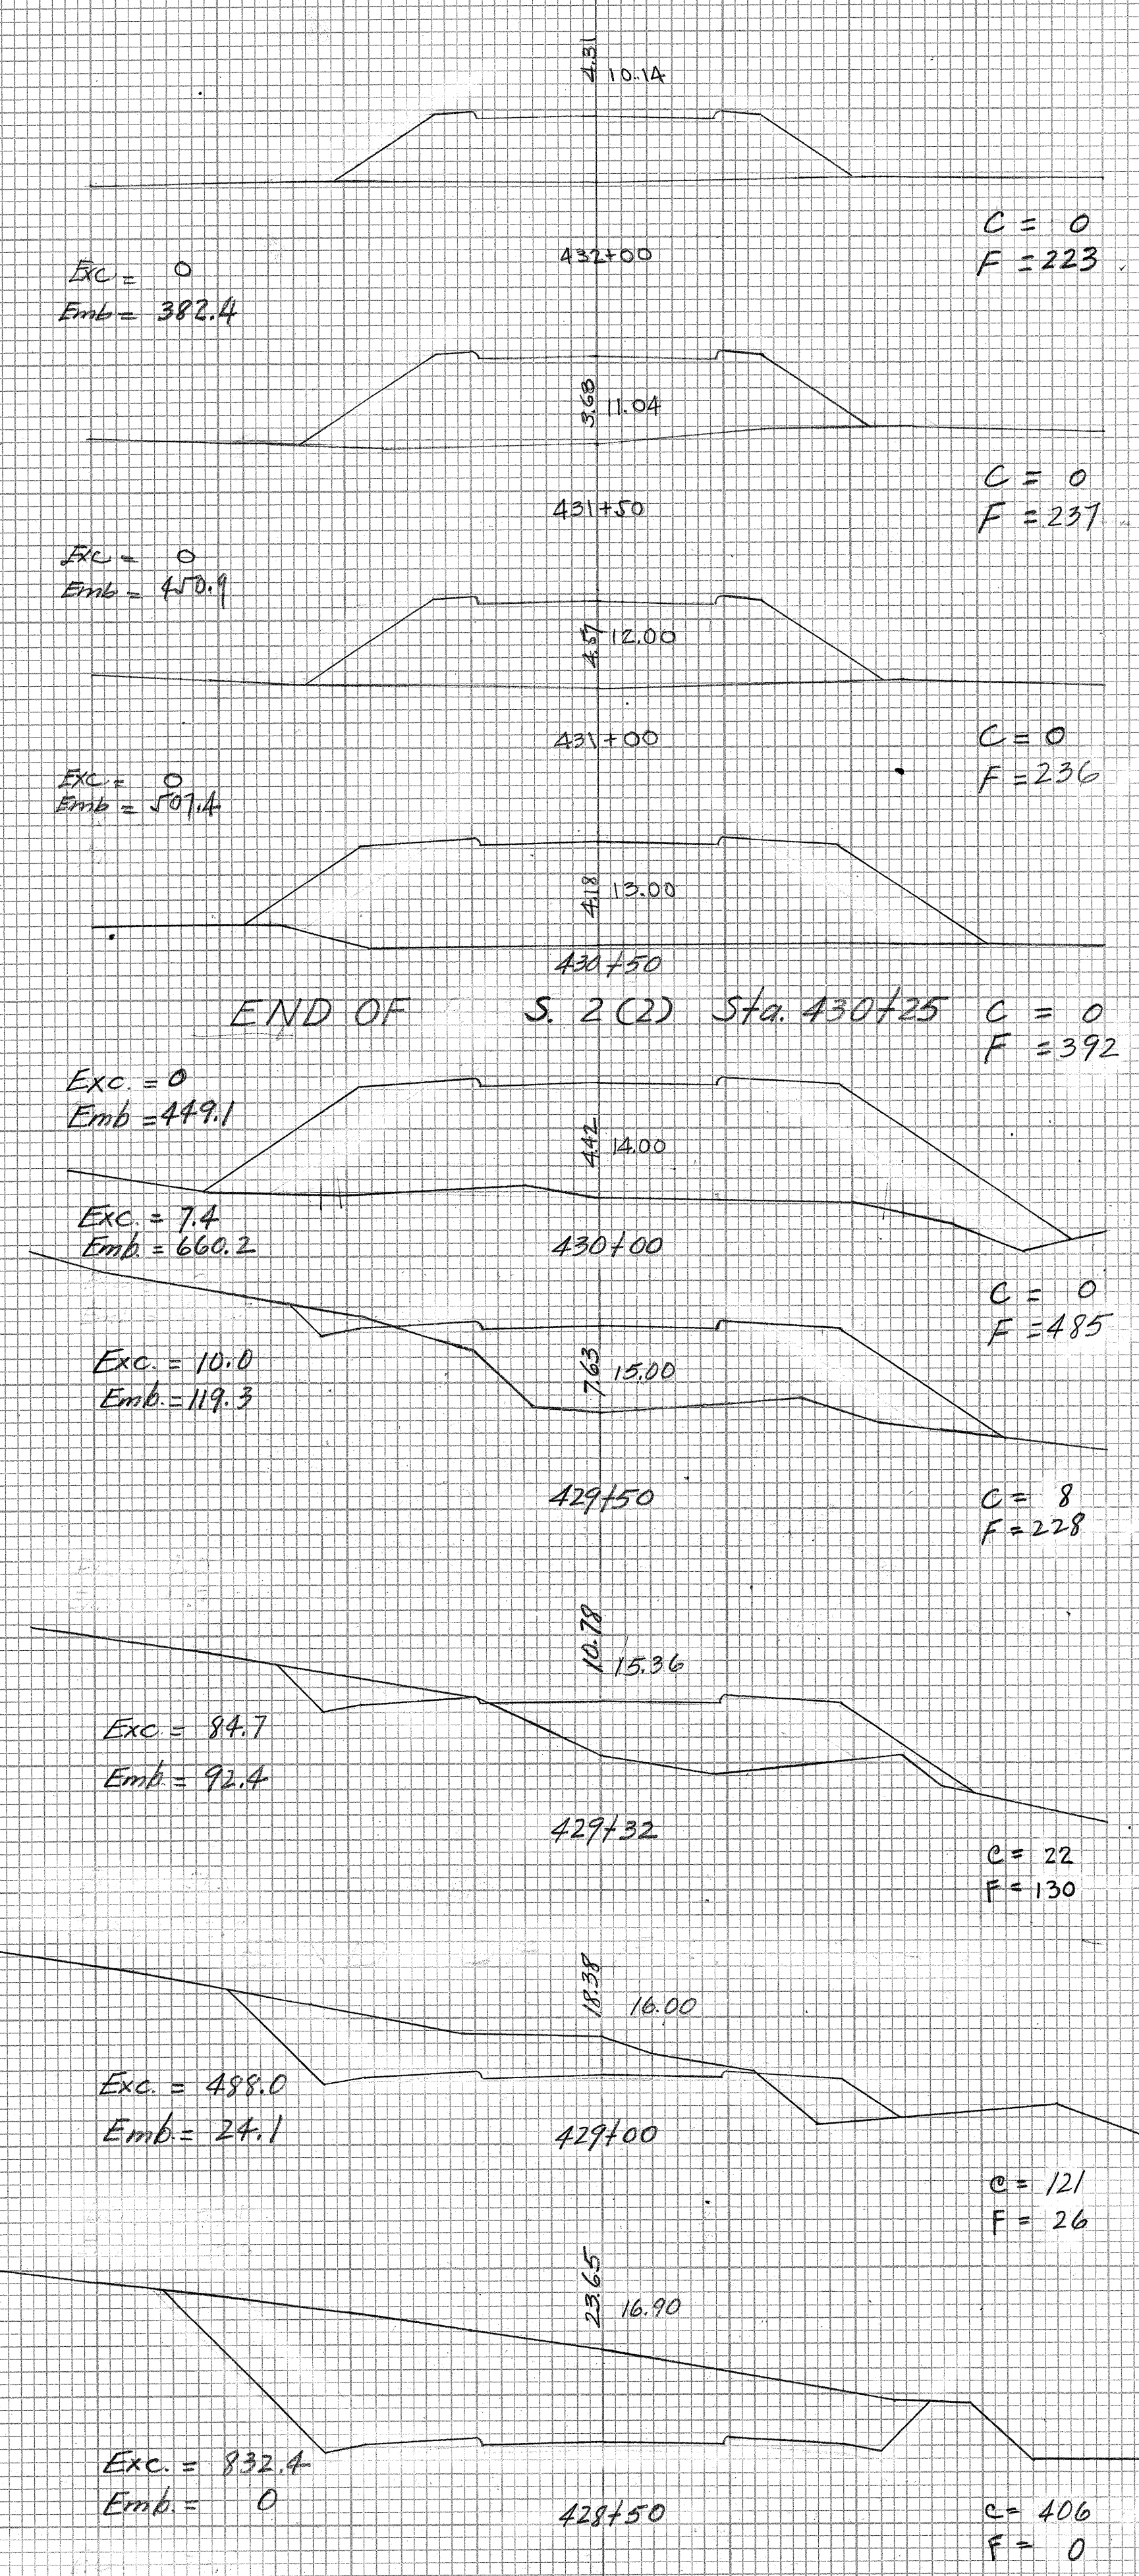

Exc = 1051.9
Emb = 5.6

5254.15
Exc = 1051.9
Emb = 5.6
TOTAL EMB = 40,004