



May, 1947
Easement details at Sta. 418+50 added.

BL 5 A A
Nov 1937
Nov 1937
Nov 1937

53

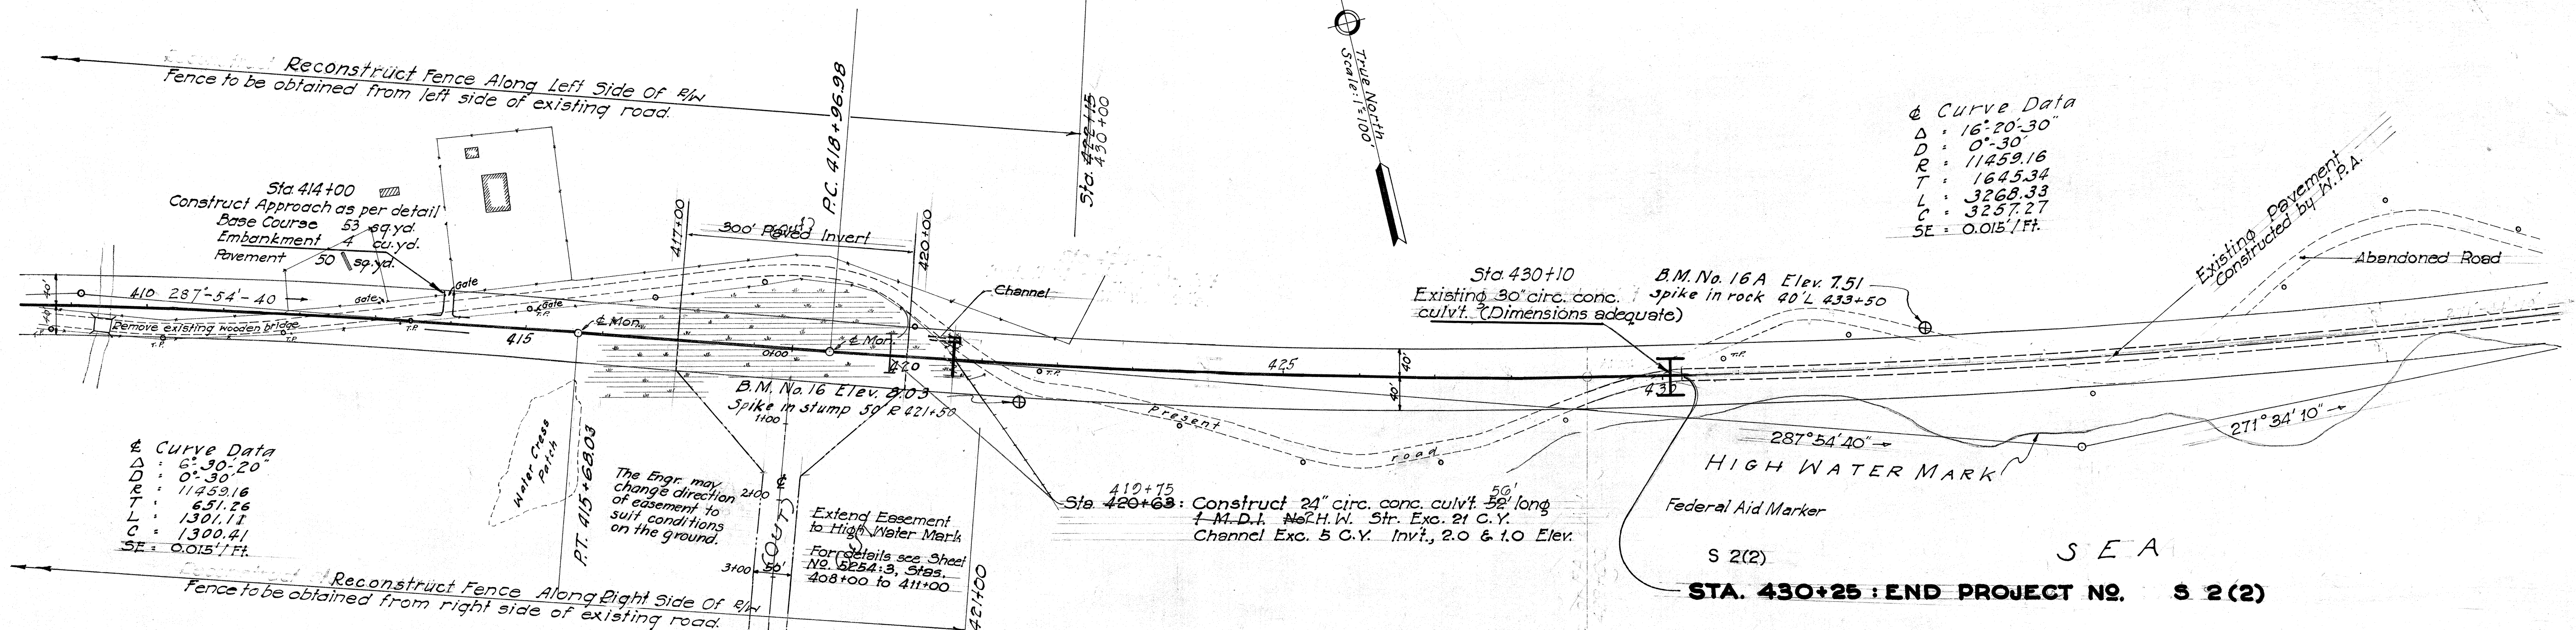

Note to Project Engineer
All Embankments across marshes to be of the best rocky material available.

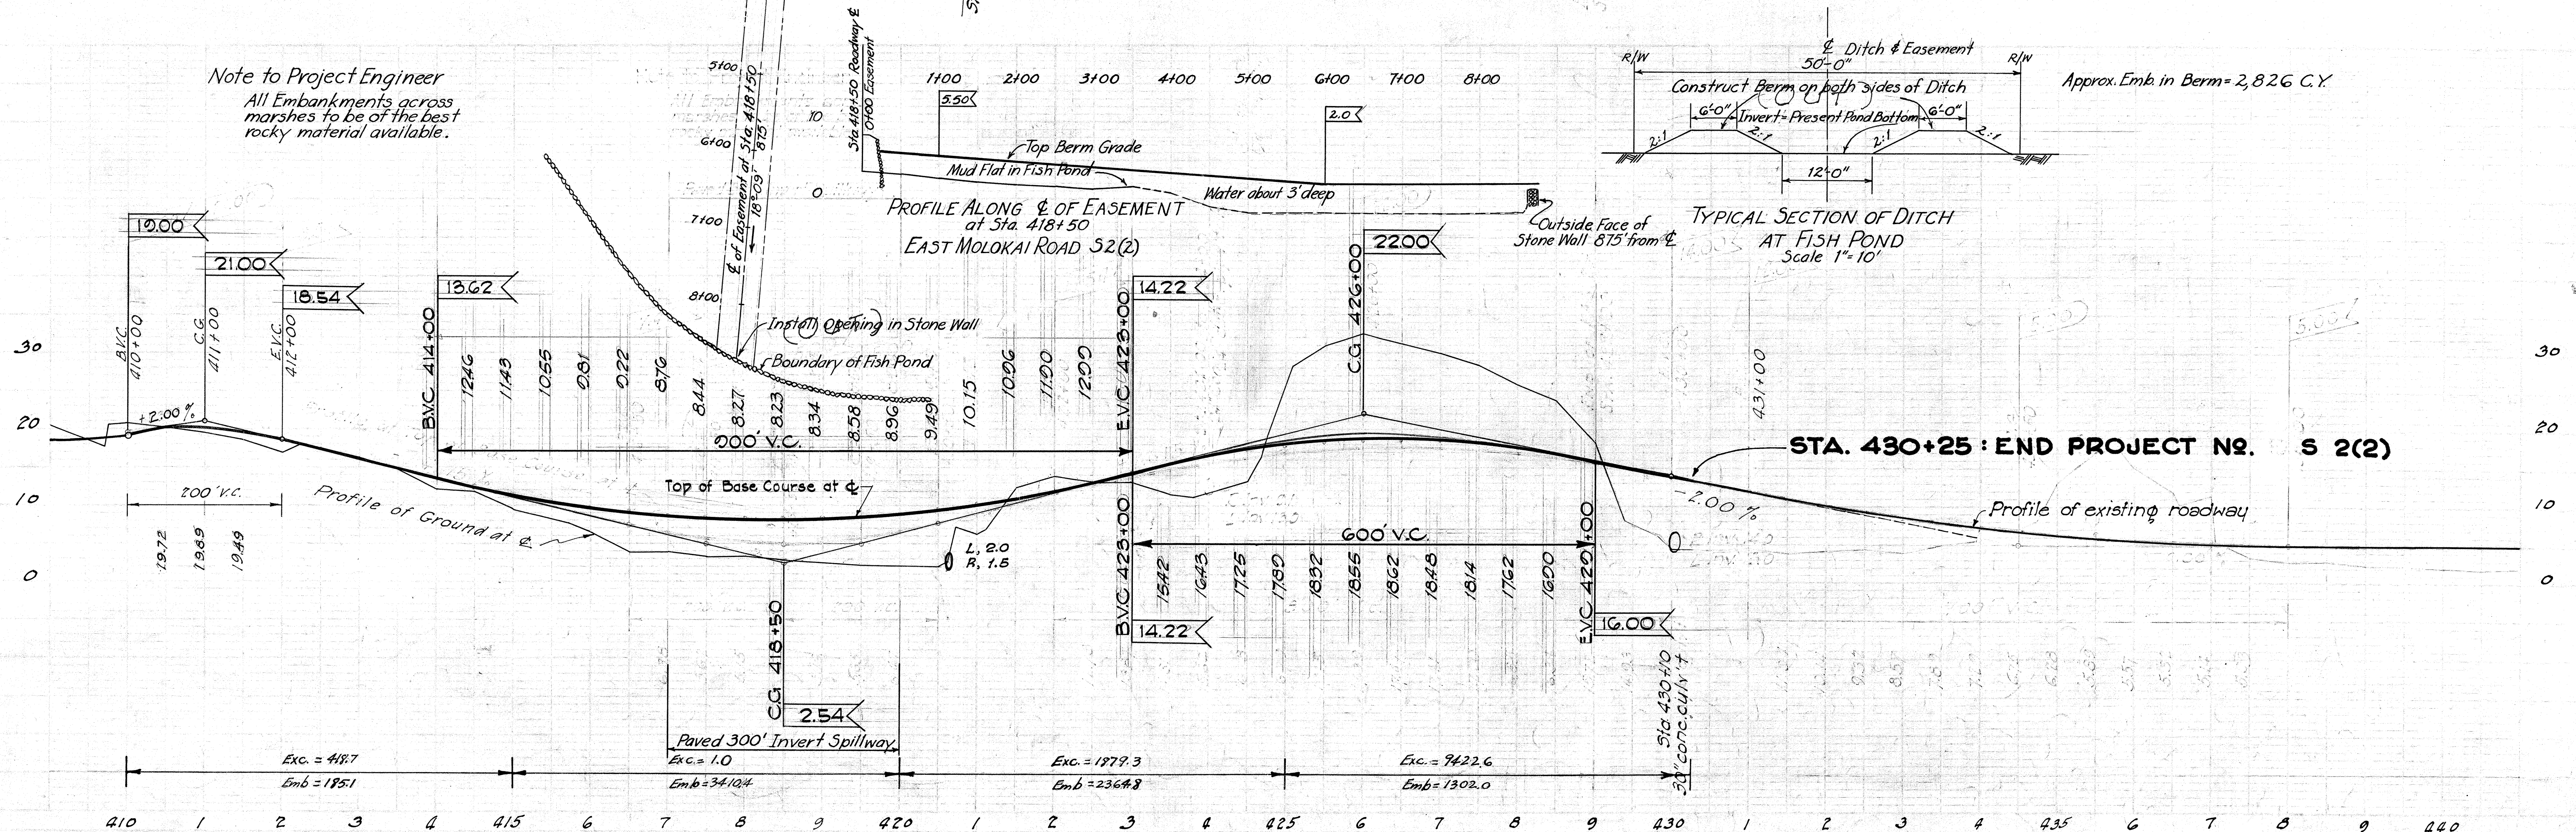

54
A.H.A.
H.H.A.
Nov 1937
Nov 1937
Nov 1937

54