INDEX	TO DRAWINGS
SHEET NO.	DESCRIPTION
1	TITLE SHEET
2 - 3	PLAN
4	STANDARD DETAILS

STATE OF HAWAII

DEPARTMENT OF TRANSPORTATION

HIGHWAYS DIVISION HONOLULU, HAWAII

"AS BUILT" PLANS FOR

KAM V HIGHWAY RESURFACE FROM KAUNAKAKAI TOWARD KAMALO


PROJECT NO. 450A-01-72

DISTRICT OF MOLOKAI COUNTY OF MAUI ISLAND OF MOLOKAI

GENERAL NOTES


MAUI DISTRICT OFFICE STATE HIGHWAYS DIVISION


- 1. The existing paved roadway shall be cleaned according to Section 310 of the Standard Specifications. Payment incidental to A.C. Pavement.
- 2. Dressing at the shoulder area shall be with material approved by the Engineer. The shoulders shall be cut or filled, graded, watered and rolled as directed by the Engineer. Payment incidental to A.C. Pavement.
- 3. All chuck holes and large depressions, if any, shall be filled and compacted with A.C. Pavement prior to resurfacing. Payment incidental to A.C. Pavement.
- 4. Location of pavement markers shall be staked out by the Engineer

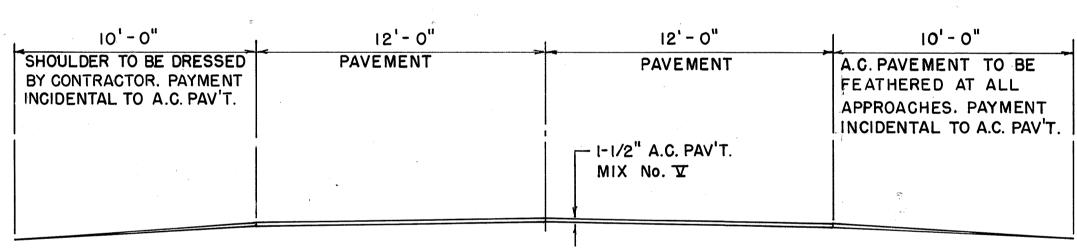

TYPICAL SECTION

SCALE: 1/4" = 1'-0"

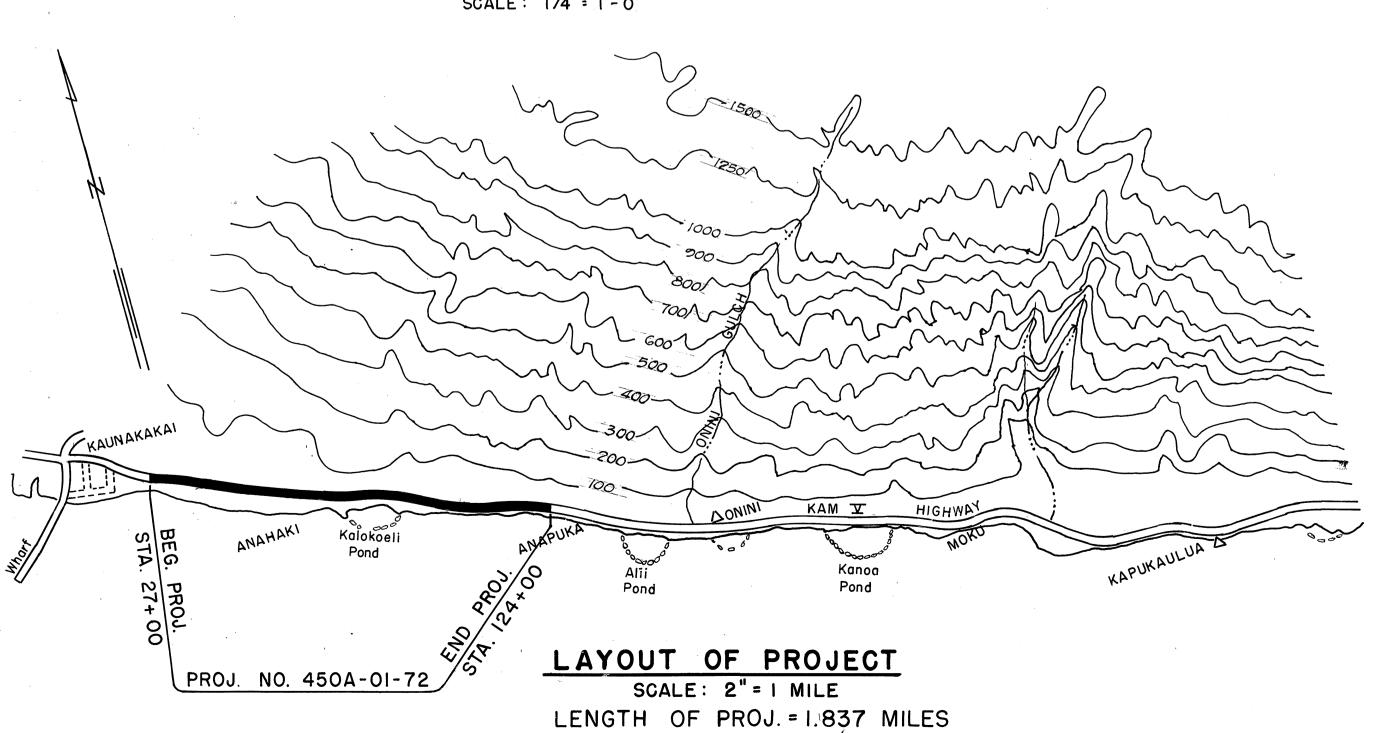

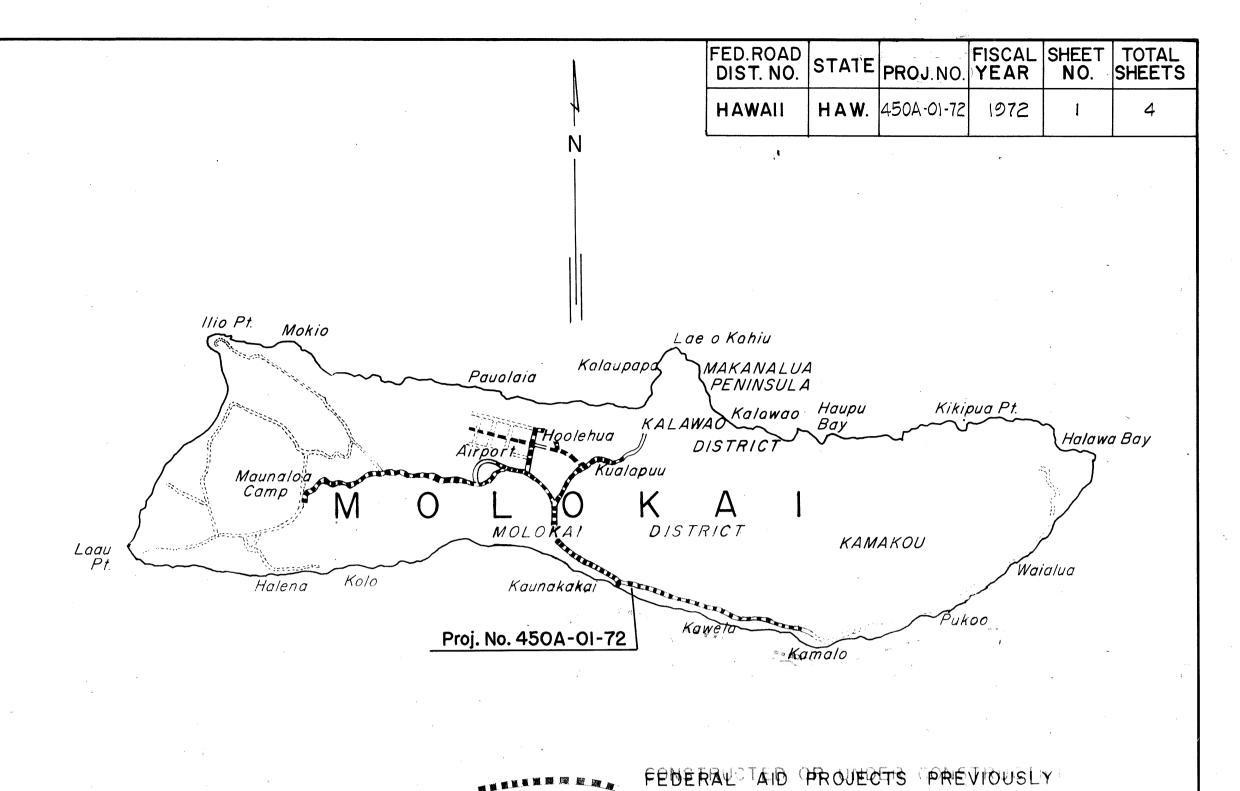

NOTE:

ALL CHANGES MADE DURING CONSTRUCTION HAVE BEEN NOTED ON THESE TRACINGS IN RED AND CHECKED BY:

> DATE PROJECT ENGINEER

CONSTRUCTED OR UNDER CONSTRUCTION

All the quantities shown on these plans are original theoretical quantities. For actual quantities, refer to project ledger and/or computation book.

> DEPARTMENT OF TRANSPORTATION STATE OF HAWAII APPROVED: 3/16/72 FOR DIR. OF TRANSPORTATION DATE