


INDEX TO DRAWINGS	
SHEET NO.	DESCRIPTION
1	TITLE SHEET
2-3	TYPICAL SECTION, PLAN & DETAILS
4-7	STANDARD DETAILS

STATE OF HAWAII
DEPARTMENT OF TRANSPORTATION
HIGHWAYS DIVISION
HONOLULU, HAWAII
"AS BUILT" PLANS OF
KAMEHAMEHA V HIGHWAY
(RESURFACING KAMALO TOWARDS HALAWA)

PROJECT NO. 450AB - 01 - 76
(KAMALO TO PUAHALA)

PROJECT NO. 450B - 01 - 76M
(PUAHALA TOWARDS HALAWA)

FED. ROAD DIST. NO.	STATE	PROJ. NO.	FISCAL YEAR	SHEET NO.	TOTAL SHEETS
HAWAII	HAW.	450AB-01-76 450B-01-76M	1975	1	7

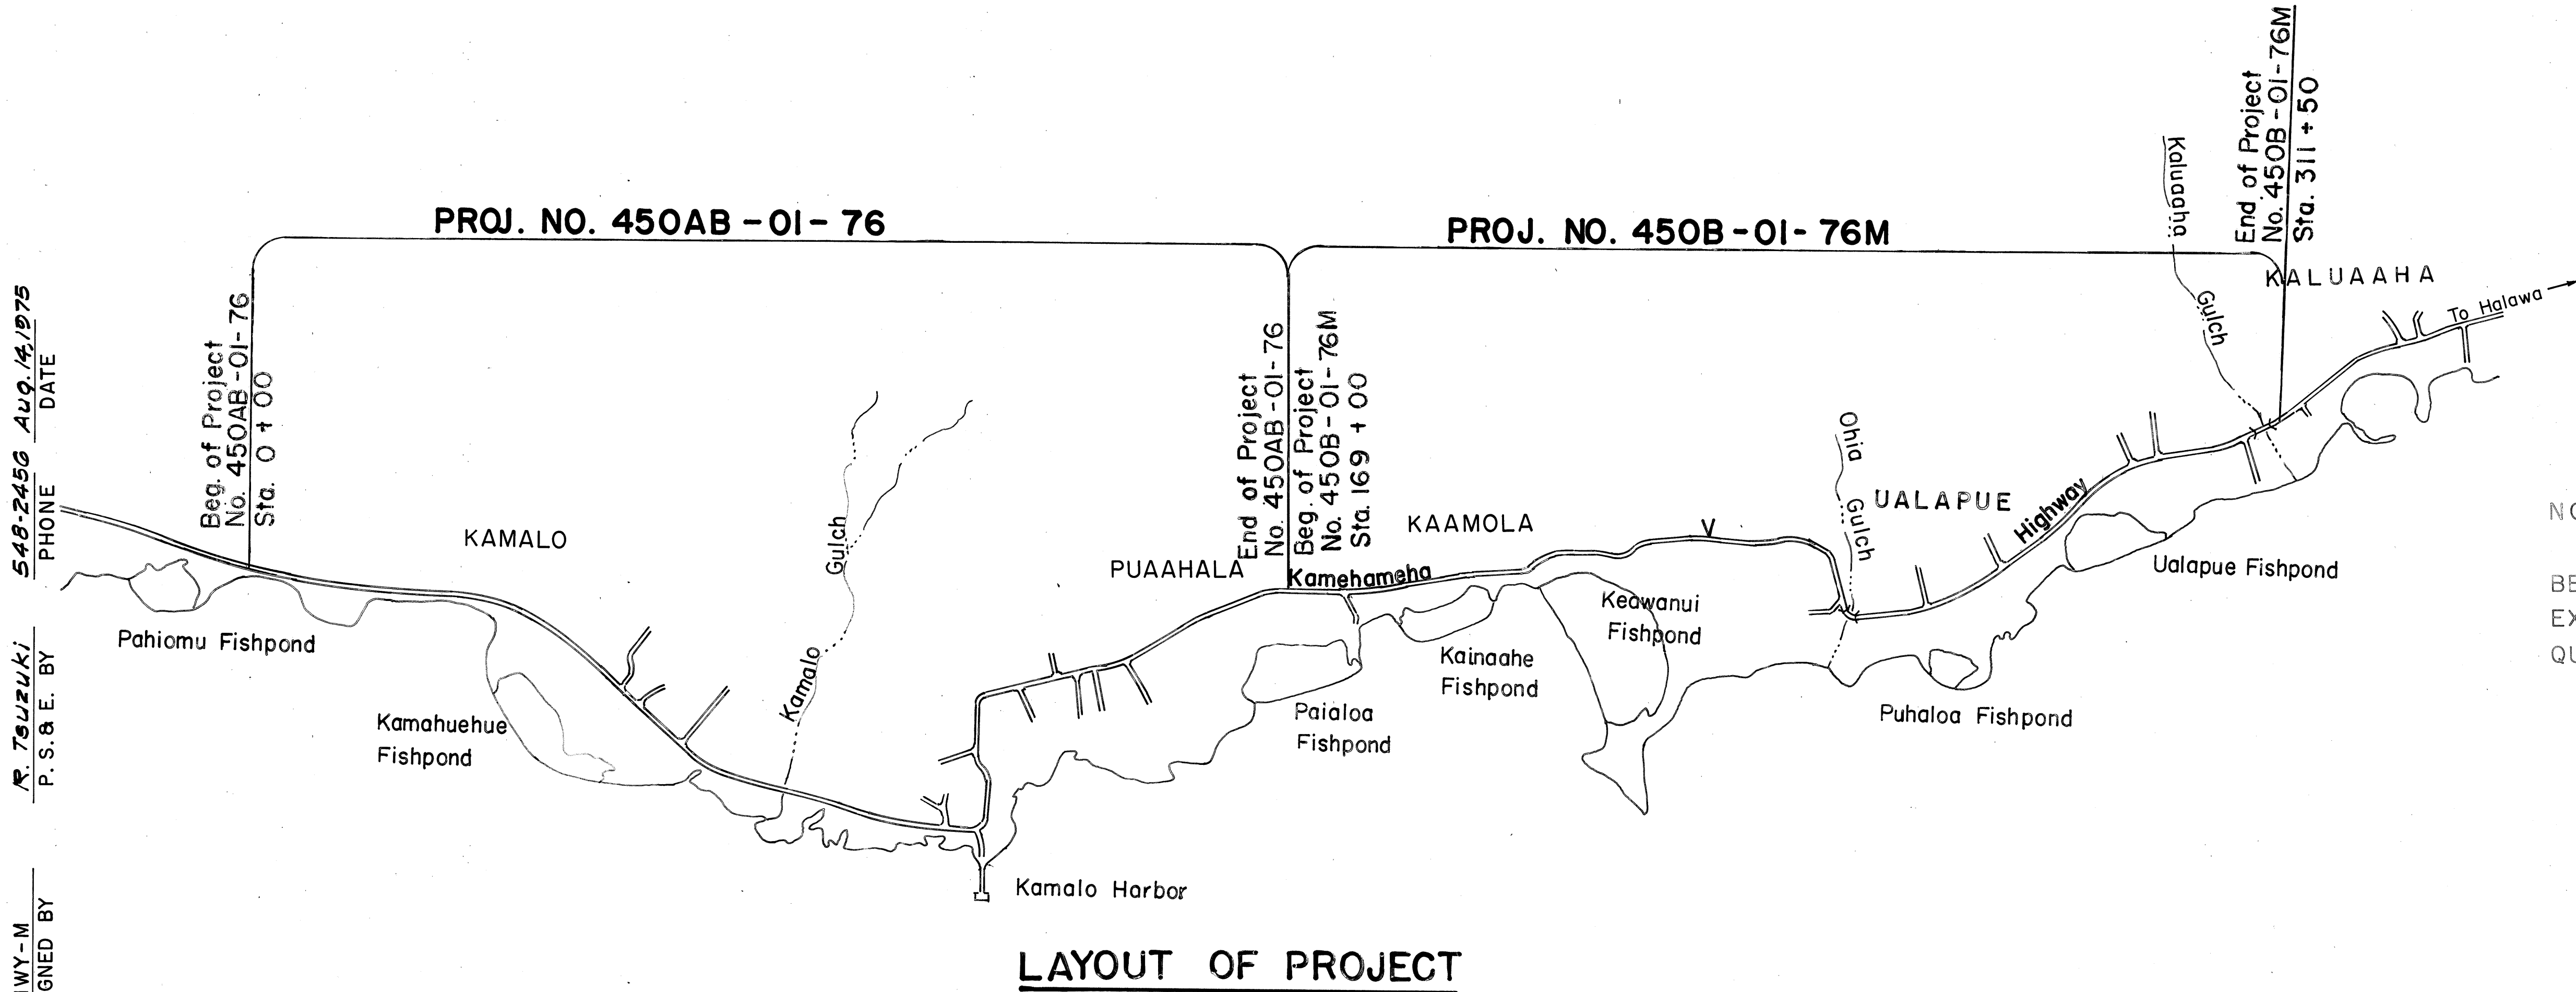

HWY - M
DESIGNED BY

R. T. Suzuki
P. S. & E. BY

548-2450
PHONE

Aug. 14, 1975
DATE

DEPARTMENT OF TRANSPORTATION STATE OF HAWAII	
APPROVED: <i>R. Higashimura</i>	8-21-75
DIR. OF TRANSPORTATION	DATE