


| FED. ROAD DIST. NO. | STATE | FED. AID PROJ. NO. | FISCAL YEAR | SHEET NO. | TOTAL SHEETS |
|---------------------|-------|--------------------|-------------|-----------|--------------|
| HAWAII              | HAW.  | 05-0900(10)        | 1978        | 6         | 23           |

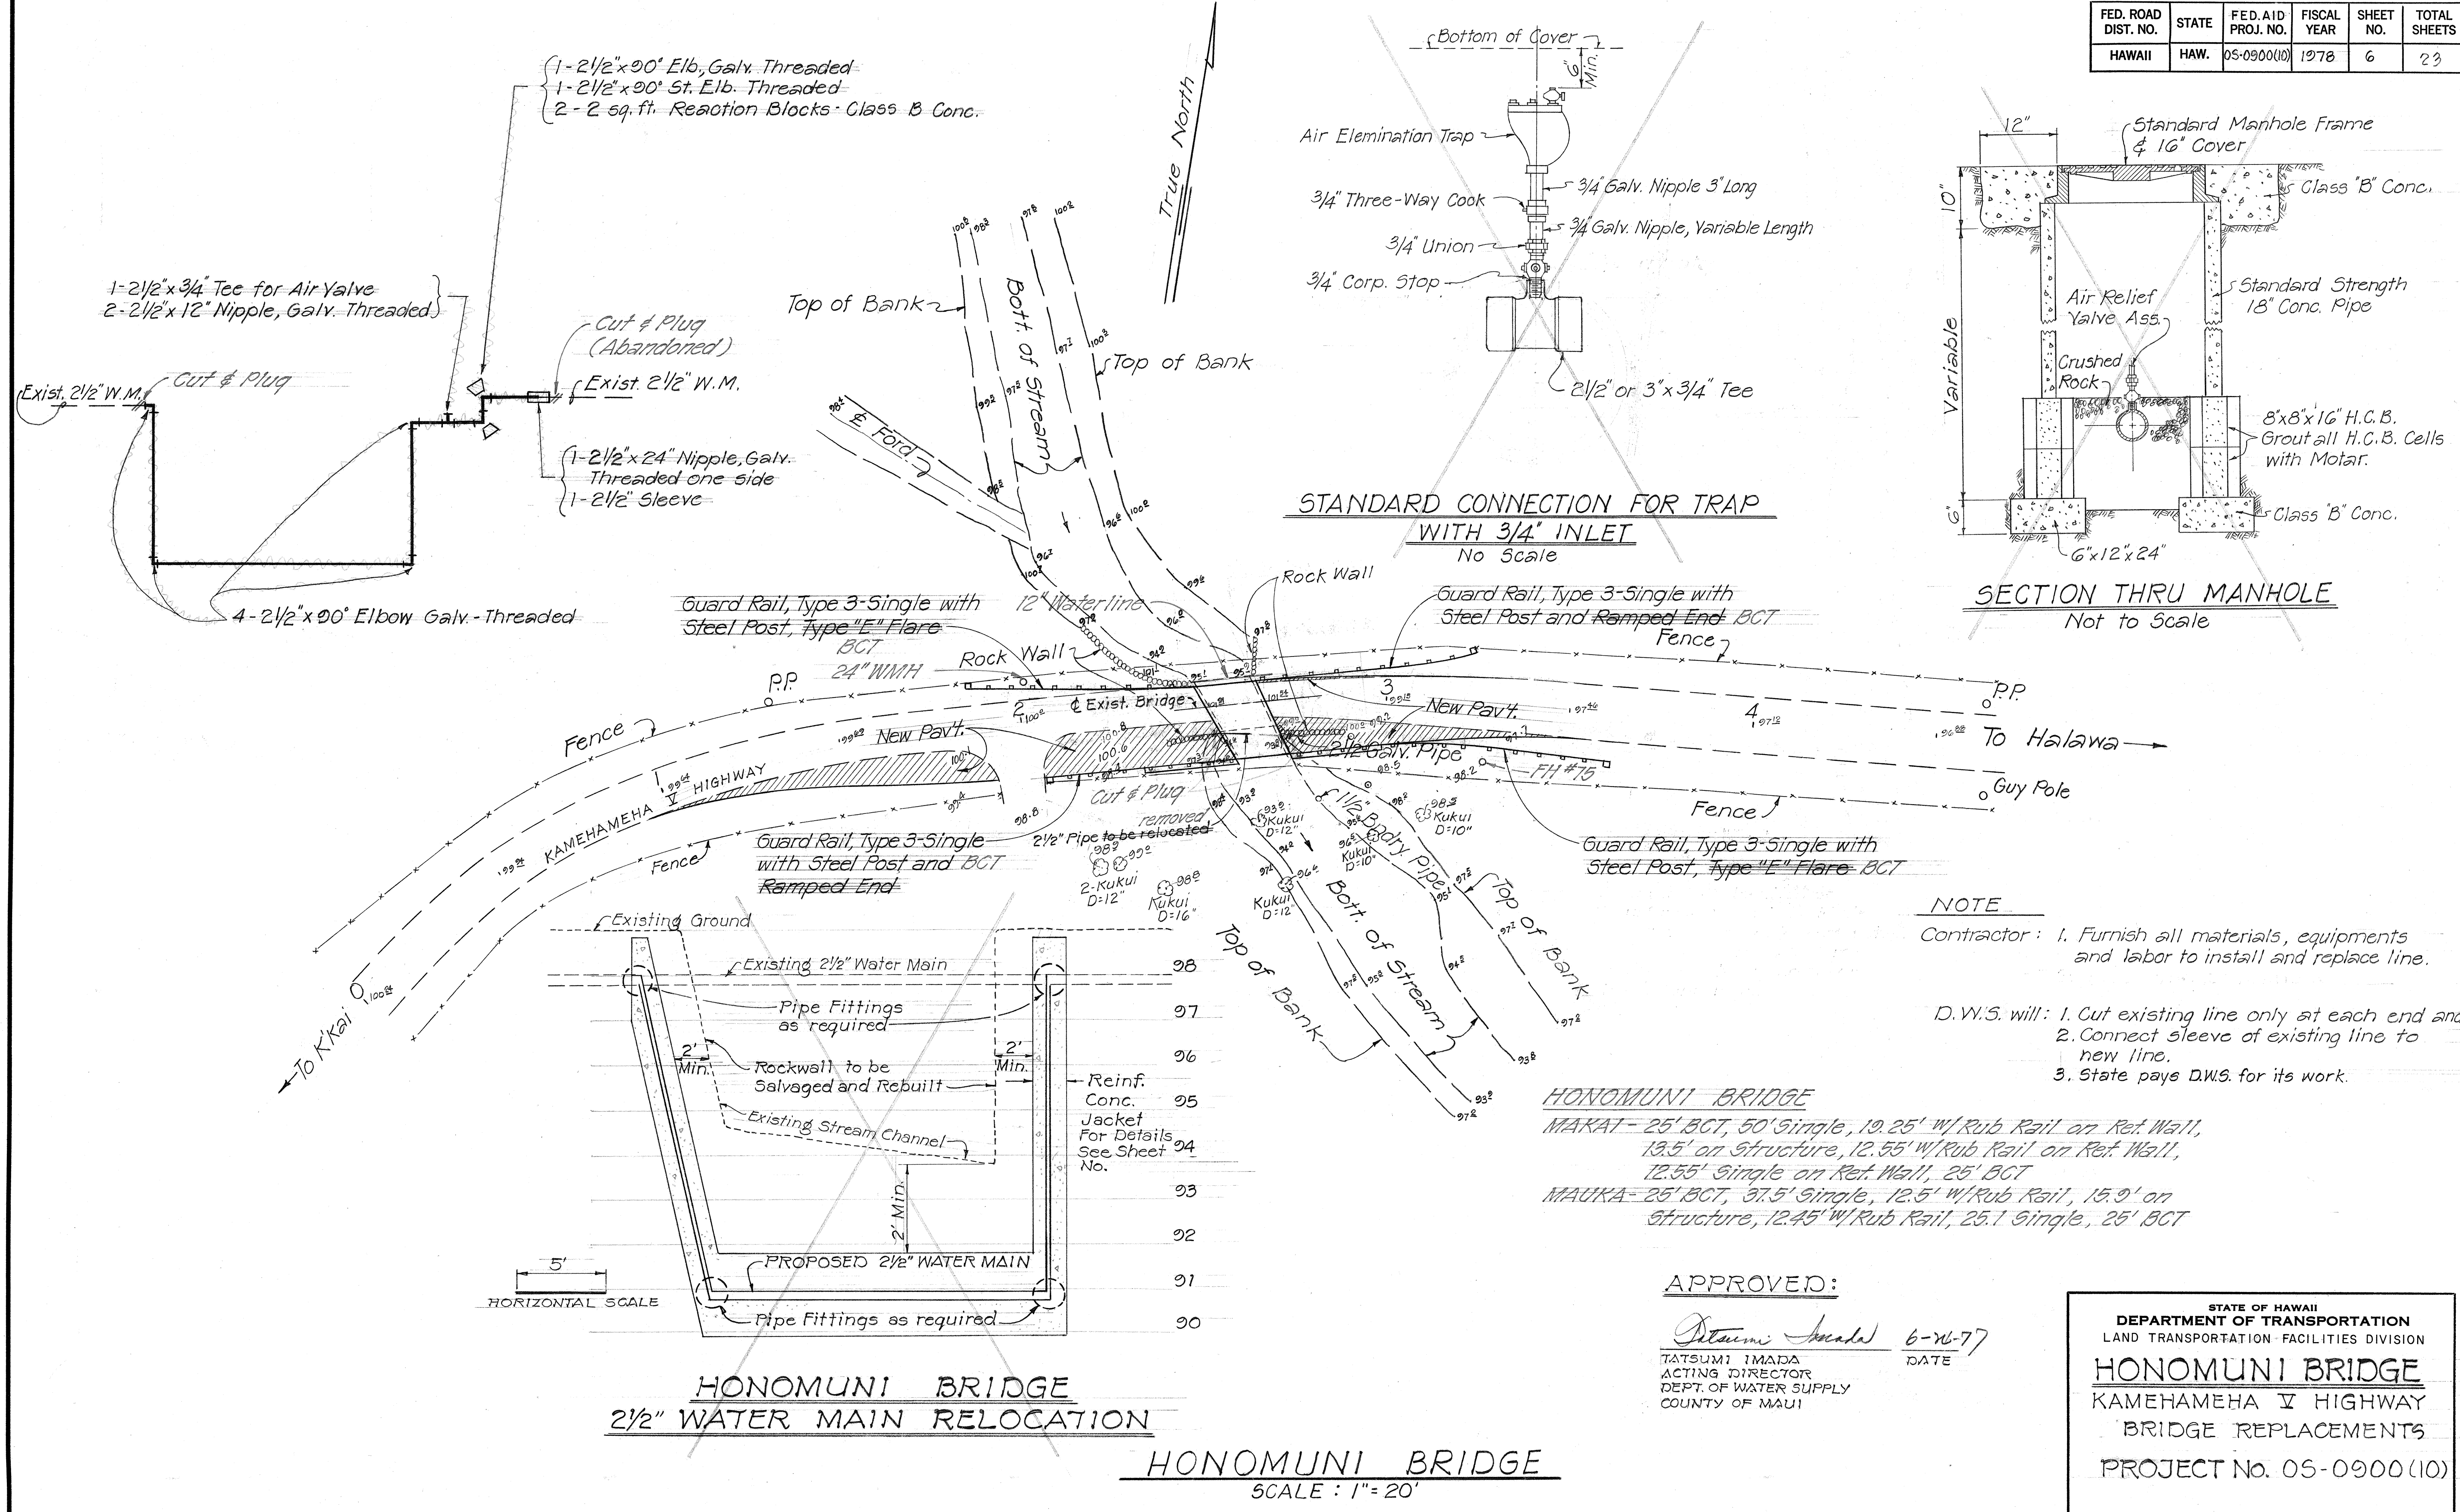

|                   |        |
|-------------------|--------|
| DATE              | 2/12/2 |
| SURVEY PLOTTED BY |        |
| DRAWN BY          |        |
| DESIGNED BY       |        |
| QUANTITIES BY     |        |
| CHECKED BY        |        |
| ORIGINAL PLAN     |        |
| NOTE BOOK         |        |
| No.               |        |

STATE OF HAWAII  
DEPARTMENT OF TRANSPORTATION  
LAND TRANSPORTATION FACILITIES DIVISION

HONOMUNI BRIDGE  
KAMEHAMEHA V HIGHWAY  
BRIDGE REPLACEMENTS  
PROJECT No. 05-0900(10)

SHEET No. 1 OF 1 SHEETS