


FED. ROAD DIST. NO.	STATE	FED. AID PROJ. NO.	FISCAL YEAR	SHEET NO.	TOTAL SHEETS
HAWAII	HAW.	05-0900(10)	1978	4	23

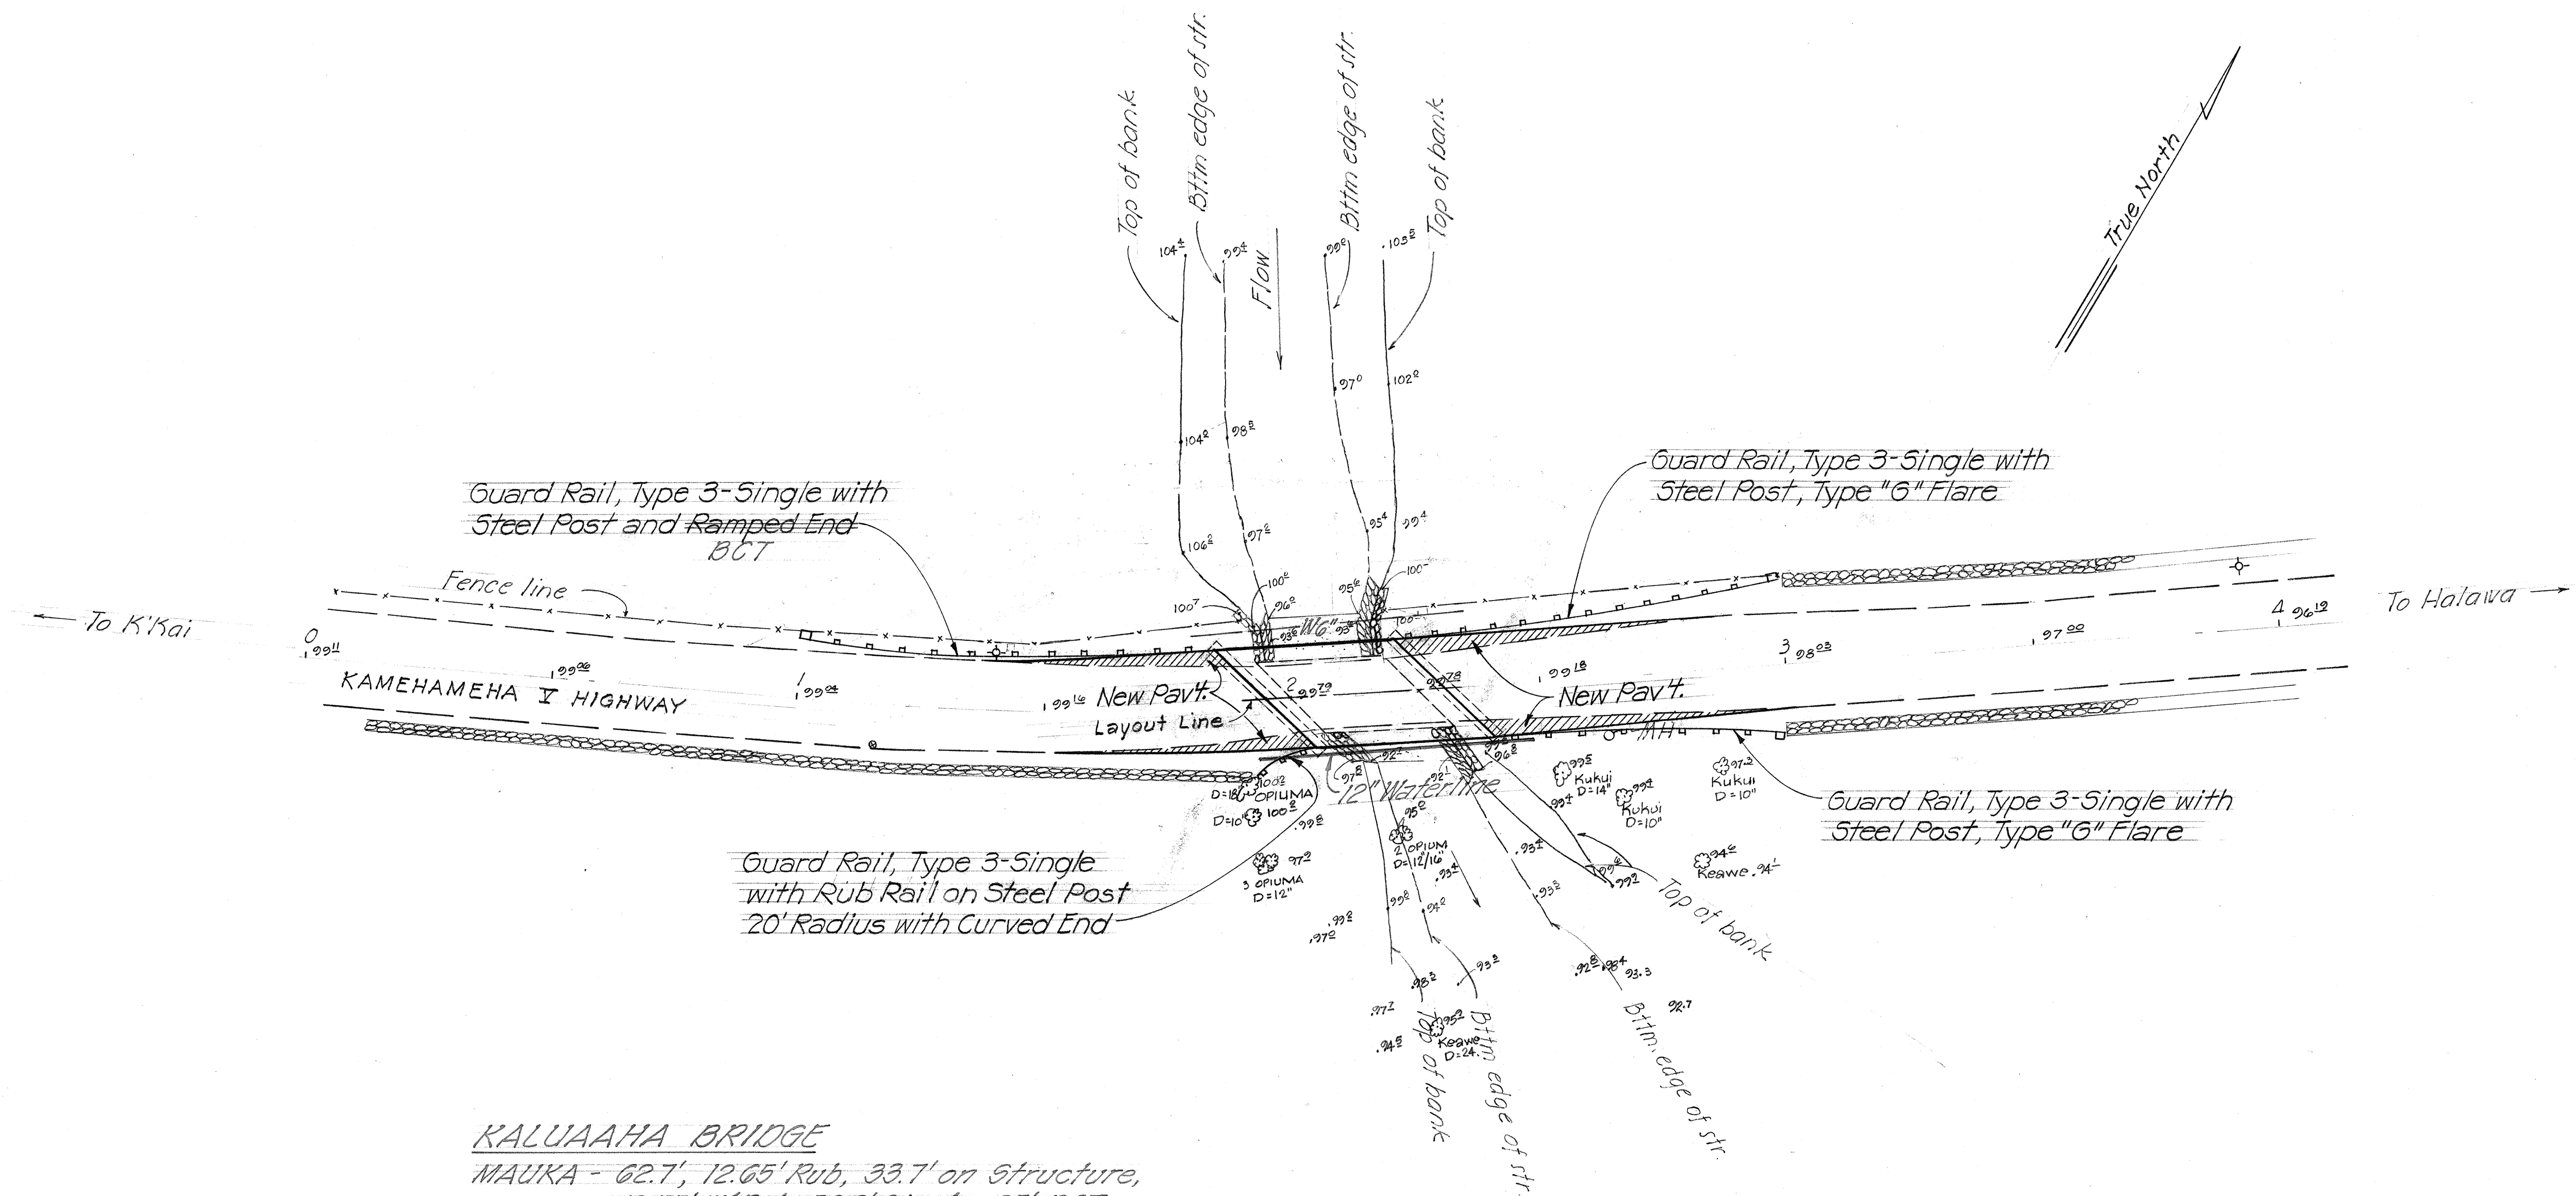

KALUAHAHA BRIDGE
 MAUKA - 62.7', 12.65' Rub, 33.7' on Structure,
 12.55' W/Rub, 50.2' Single, 25' BCT
 MAKAI - Radius Rail, 33.8' Single W/Rub on
 Structure, 12.85' W/Rub, 43.8' Single

KALUAHAHA BRIDGE
 Scale: 1" = 20'

STATE OF HAWAII

DEPARTMENT OF TRANSPORTATION

LAND TRANSPORTATION FACILITIES DIVISION

KALUAHAHA BRIDGE

KAMEHAMEHA I HIGHWAY

BRIDGE REPLACEMENTS

PROJECT NO. 05-0900(10)

SHEET NO. 1 OF 1 SHEETS

4

ORIGINAL PLAN	SURVEY PLOTTED BY	DATE
NO.	DRAWN BY	
	DESIGNED BY	
	CHECKED BY	