

INDEX TO DRAWINGS	
SHEET NO.	DESCRIPTION
1	TITLE SHEET
2	TYPICAL SECTION AND GENERAL NOTES
3	PLAN-OHIA BRIDGE
4	PLAN-KALUAAHA BRIDGE
5	PLAN-KUPEKE BRIDGE
6	PLAN-HONOMUNI BRIDGE
* 7 - 9	DECK LAYOUTS AND TYPICAL SECTIONS
10 - 16	BRIDGE REPLACEMENT DETAILS
17 - 23	STANDARD DETAILS


* Sheet Nos. 7, 8 & 9 deleted from the Plans per Addendum No.1, dated 4/20/78.

STATE OF HAWAII
DEPARTMENT OF TRANSPORTATION
LAND TRANSPORTATION FACILITIES DIVISION
HONOLULU, HAWAII
"AS BUILT"
PLANS FOR
KAMEHAMEHA V HIGHWAY
BRIDGE REPLACEMENTS

REPLACEMENT OF OHIA BRIDGE, KALUAAHA BRIDGE,
KUPEKE BRIDGE AND HONOMUNI BRIDGE
FEDERAL AID PROJECT NO. OS-0900(10)

DISTRICT OF MOLOKAI
ISLAND OF MOLOKAI

FED. ROAD DIST. NO.	STATE	FED. AID PROJ. NO.	FISCAL YEAR	SHEET NO.	TOTAL SHEETS
HAWAII	HAW.	OS-0900(10)	1978	1	23

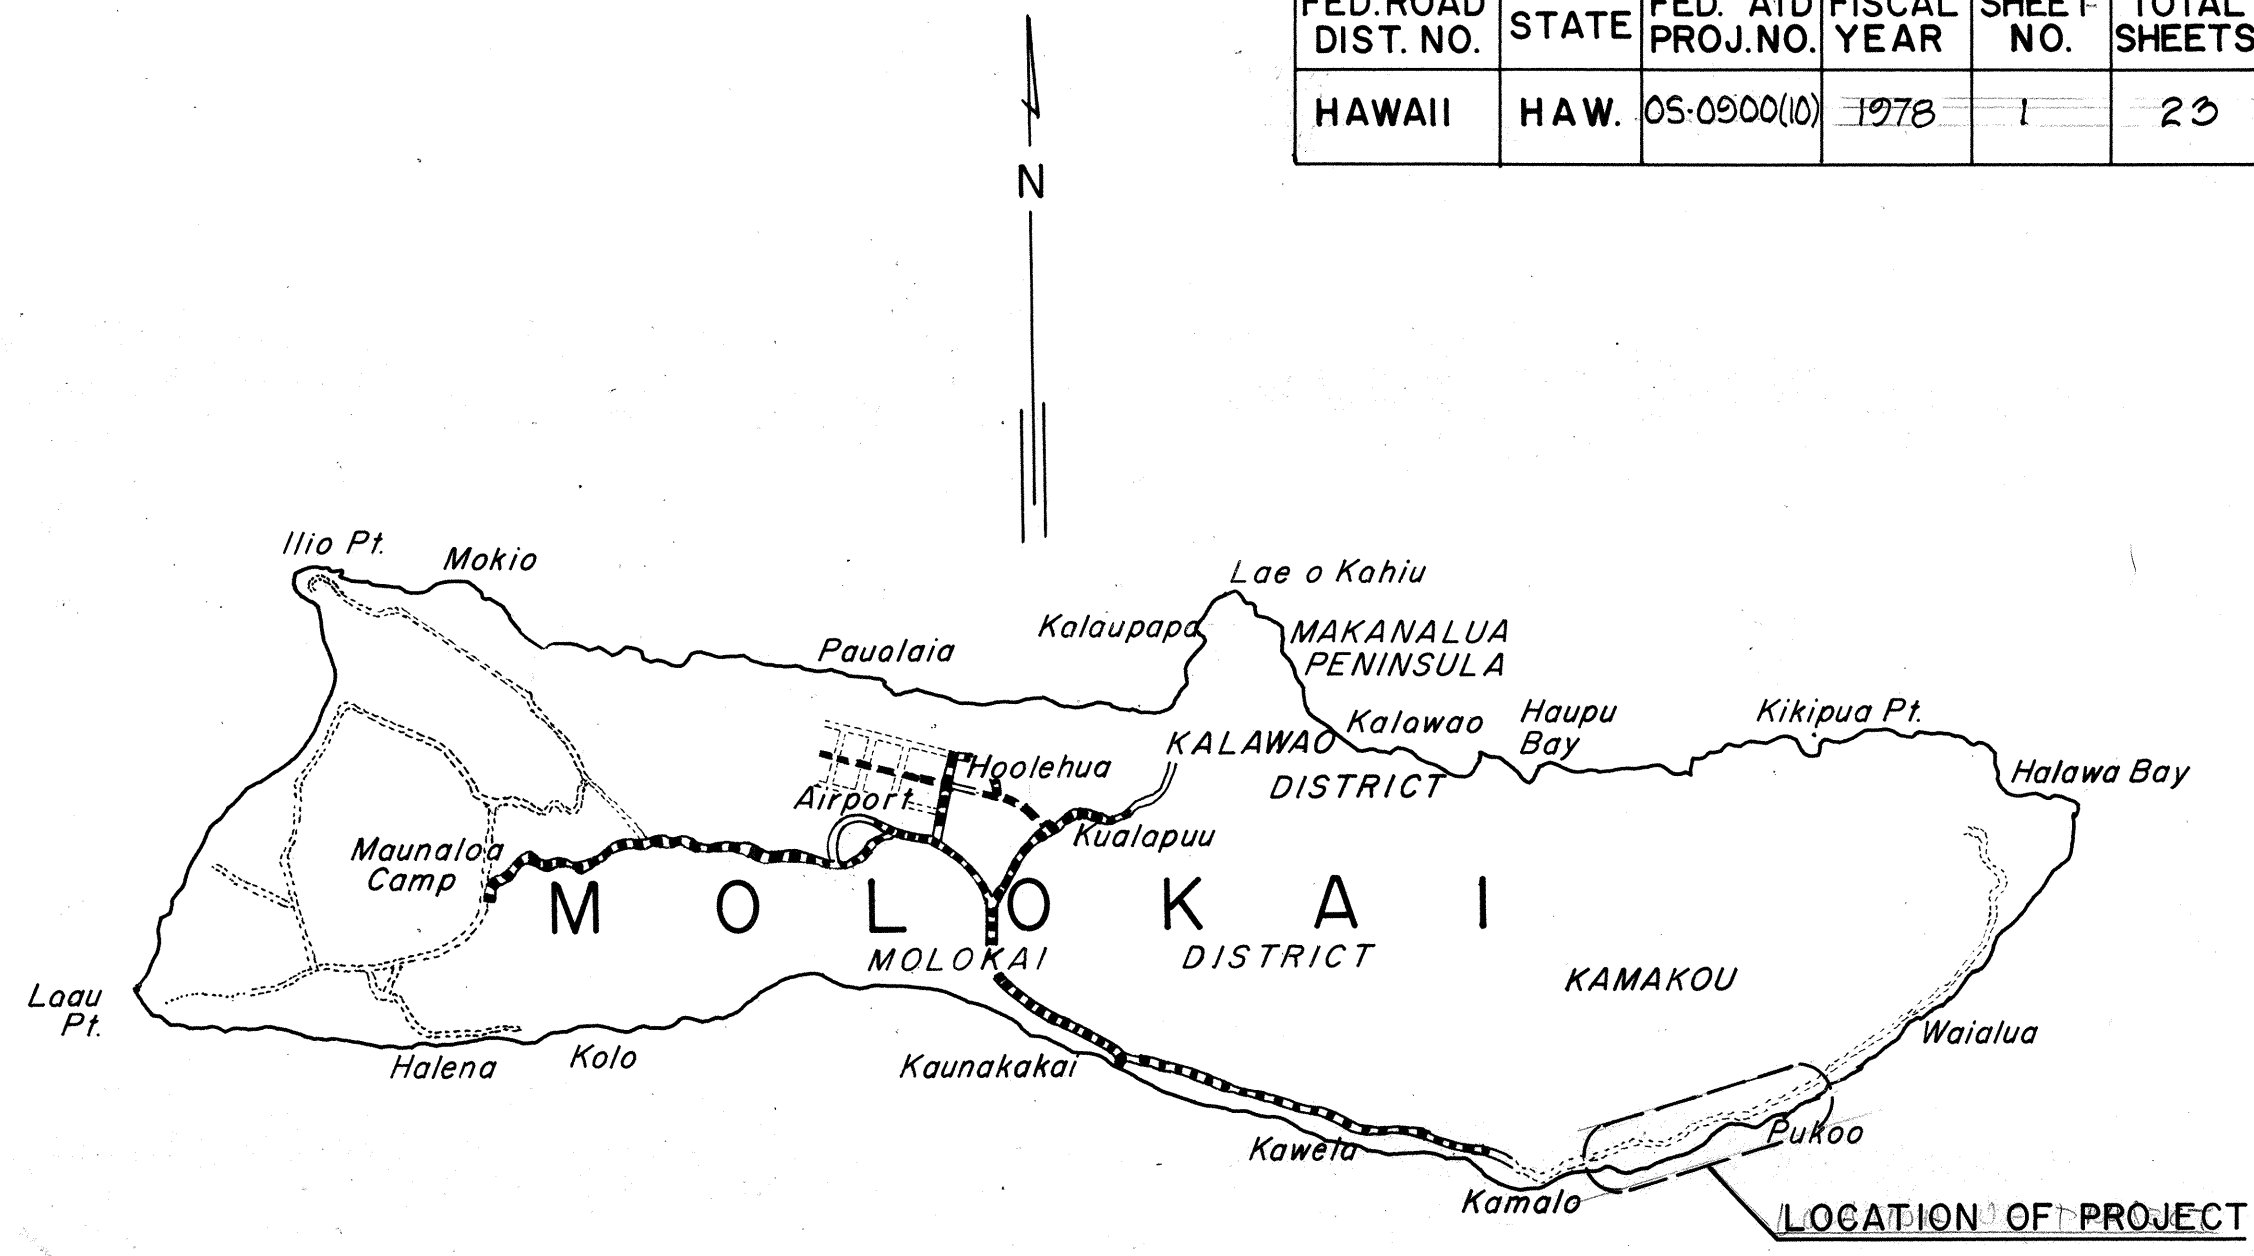

FEDERAL AID PROJECTS PREVIOUSLY CONSTRUCTED OR UNDER CONSTRUCTION


ALL CHANGES MADE DURING CONSTRUCTION HAVE BEEN INCORPORATED ON THESE PLANS EXCEPT CHANGES IN THE ORIGINAL THEORETICAL QUANTITIES

Shirley F. Felt
PROJECT ENGINEER 12-21-81
DATE

DESIGN CLASSIFICATION

ADT (1978)	590
DESIGN ADT (1998)	940
DHV	100
D	75/25
T	3.0%
K	11.0%

DESIGN UNIT "E"
DESIGNED BY
D. BEVER
P. S. & E. BY
548-7537
PHONE
Mar. 21, 1978
DATE

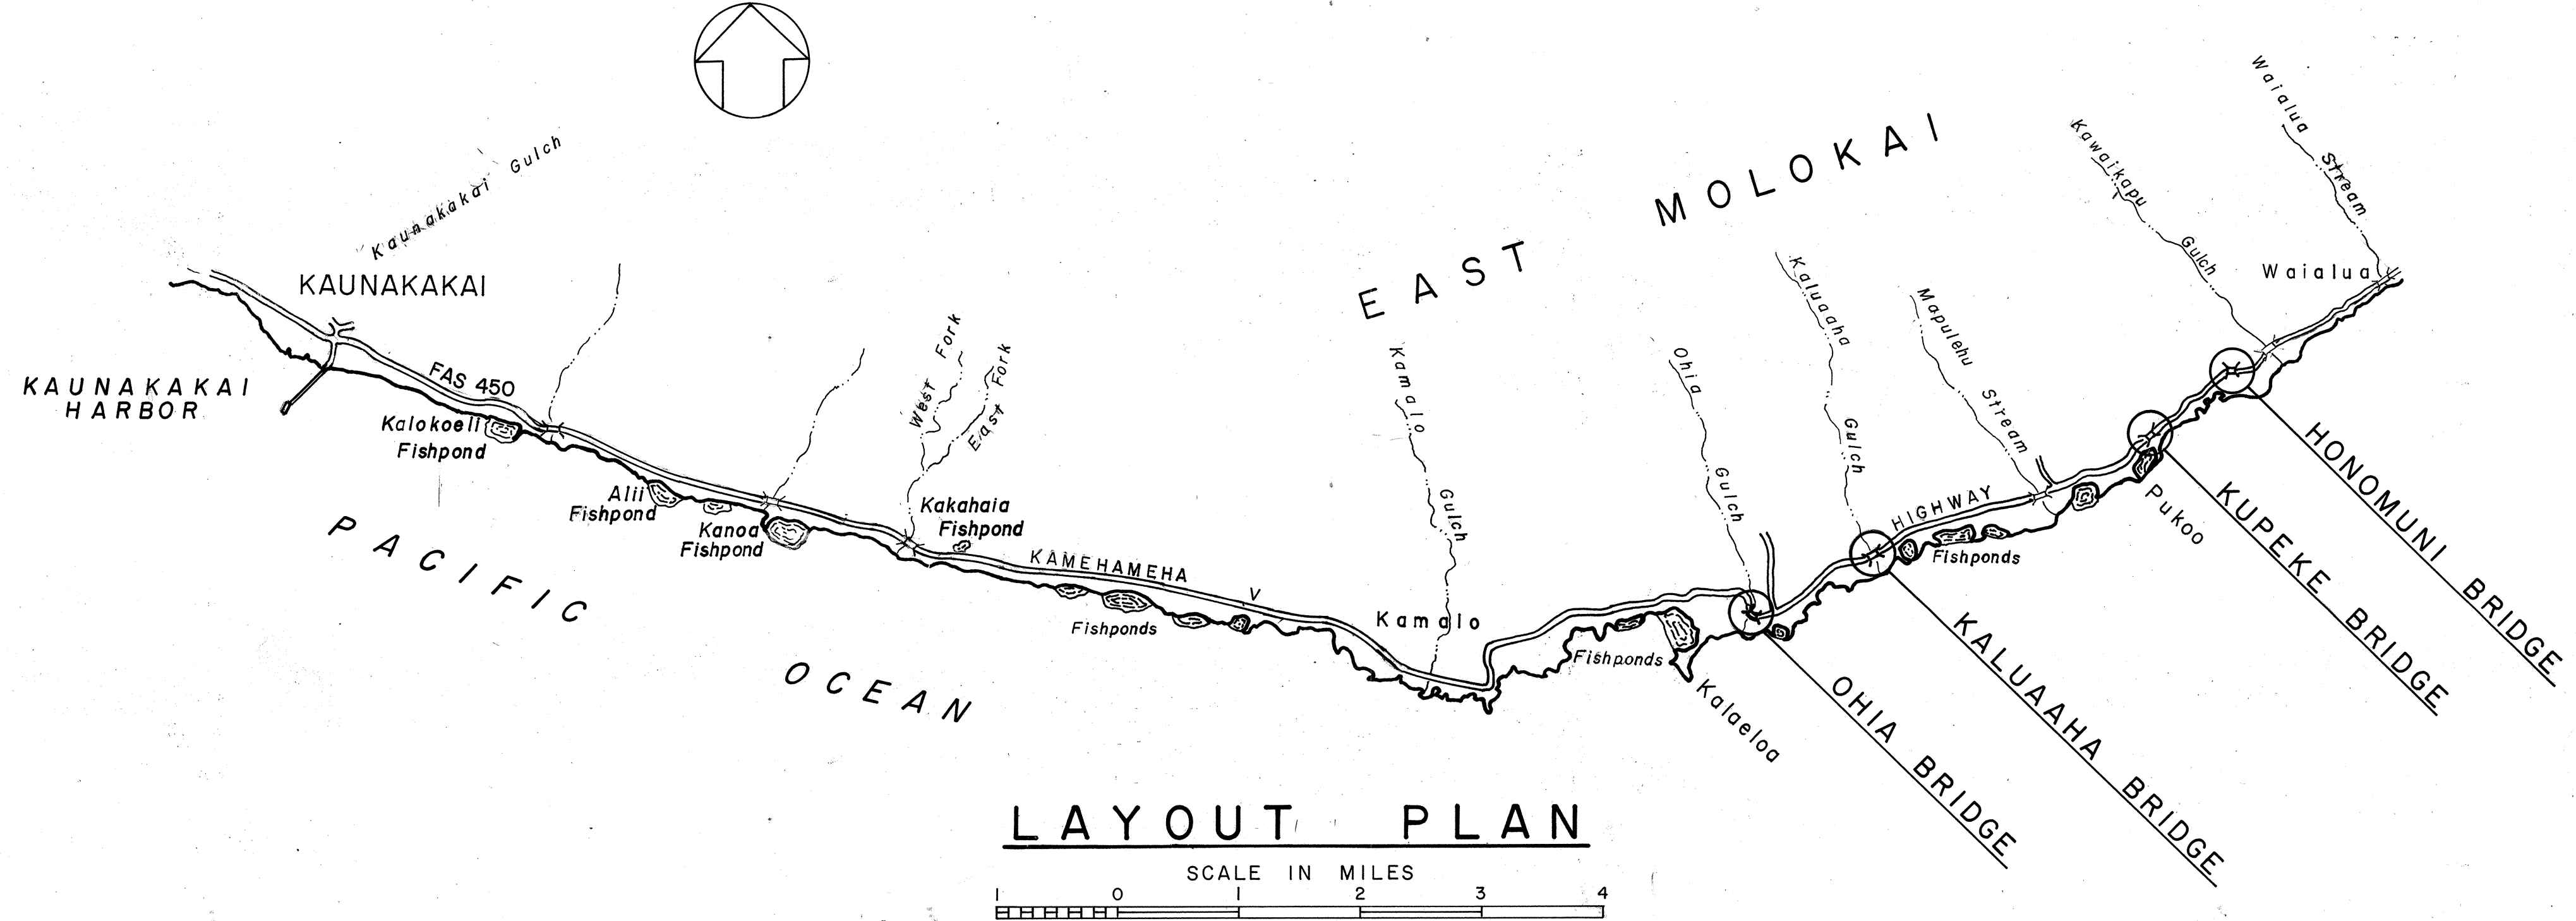

LAYOUT PLAN
SCALE IN MILES
0 1 2 3 4

DEPARTMENT OF TRANSPORTATION
FEDERAL HIGHWAY ADMINISTRATION
APPROVED:
[Signature]
DIVISION ADMINISTRATOR 4-3-78
DATE

DEPARTMENT OF TRANSPORTATION
STATE OF HAWAII
APPROVED:
Ryohichi Higashionna
DIR. OF TRANSPORTATION 3/21/78
DATE