	INDEX TO DRAWINGS
SHEET NO.	DESCRIPTION
	TITLE SHEET
2	TYPICAL & GENERAL NOTES
3-7	PLANS
8-11	PLANS & DETAILS OF END POST
	EXTENSION & CONCRETE RAILING/
	HEADWALL BUILD-UP FOR
	STRUCTURES
12-26	TYPICAL & STANDARD DETAILS
3	
	•

APR.,1979 DATE

R. TSUZUKI P. S. & E. BY



STATE OF HAWAII



SIAIL OI HAWAII

DEPARTMENT OF TRANSPORTATION
LAND TRANSPORTATION FACILITIES DIVISION
"AS-BUILT" PLAN

KAMEHAMEHA V HIGHWAY RESURFACING (KAMILOLOA TOWARDS KAMALO) FED. AID PROJECT NO. RS-0450(I)


DISTRICT OF MOLOKAI
ISLAND OF MOLOKAI

Lacu Maunaloa M O L N Kaunakakai N PROJ. NO. RS-0450(I)

Airport Maunakakai N PROJ. NO. RS-0450(I)

OR UNDER CONSTRUCTION

DIST. NO.

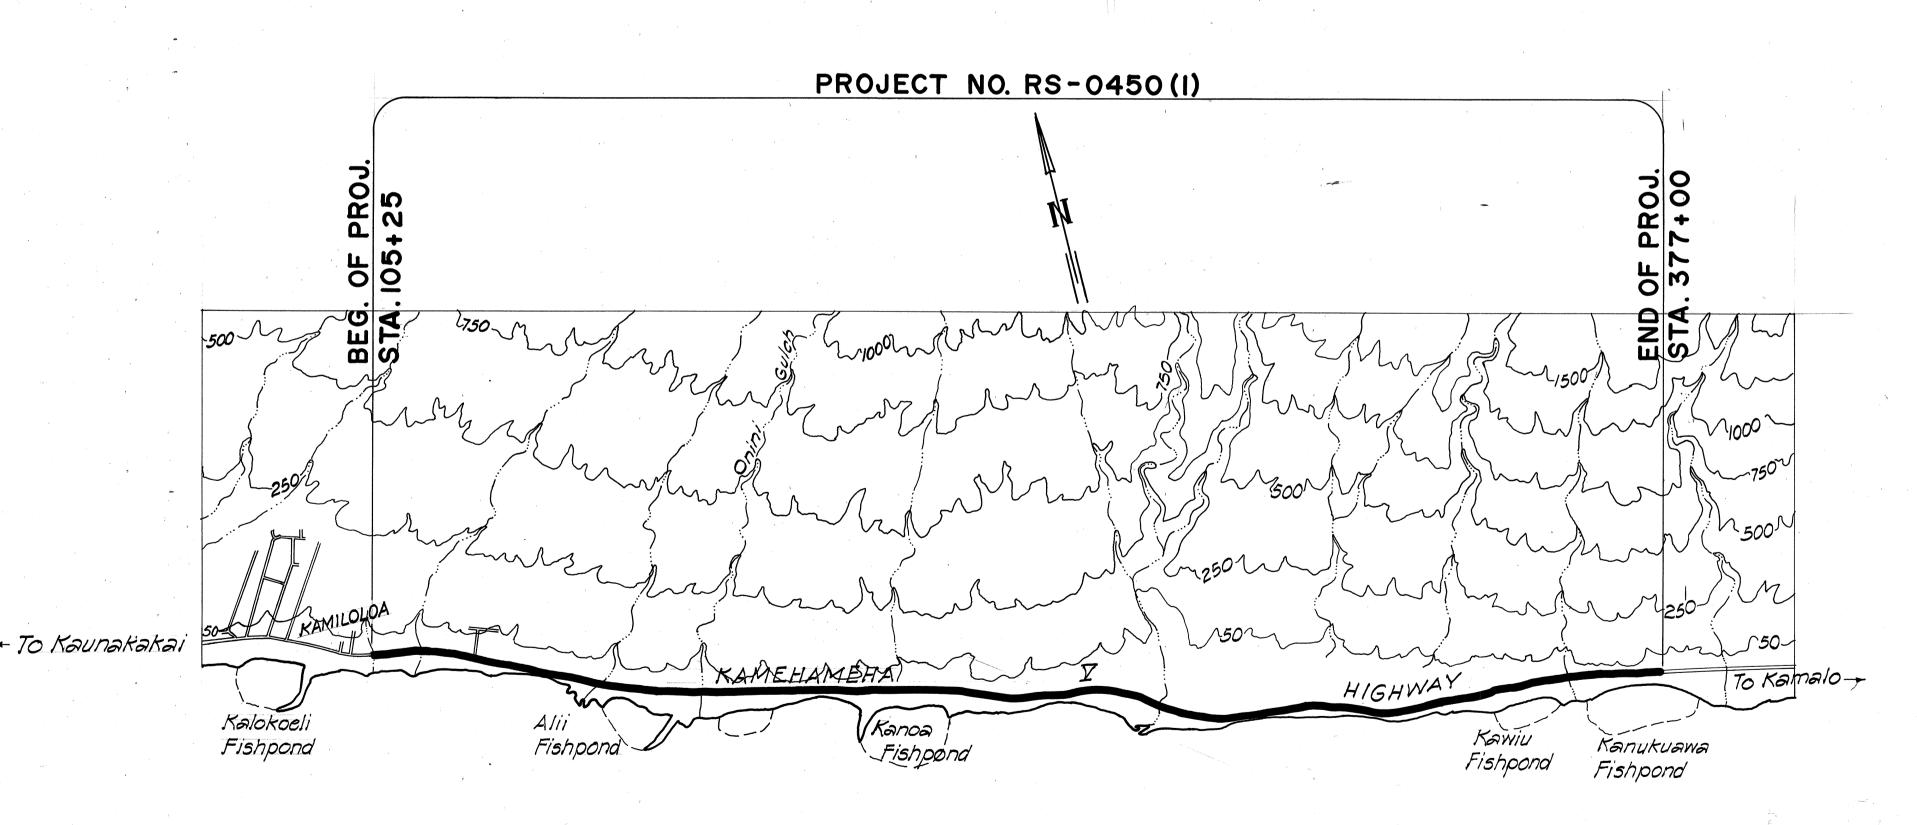

LAYOUT OF PROJECT

Scale: I" = 2000'

LENGTH OF PROJECT = 5.147 MILES

ALL CHANGES MADE DURING CONSTRUCTION HAVE BEEN NOTED IN RED ON THESE TRACINGS AND CHECKED BY

FISCAL SHEET TOTAL YEAR NO. SHEETS

FED. AID PROJ. NO.

RS-0450(1)

STATE OF HAWAII

Leonge M. Kaya 5/12/80
RESIDENT ENGINEER DATE

DEPARTMENT OF TRANSPORTATION
STATE OF HAWAII

APPROVED:

James 2. Carras 5/15/79

BIR. OF TRANSPORTATION DATE