


INDEX TO DRAWINGS	
SHEET NO.	DESCRIPTION
1	TITLE SHEET
* 2 - 3	PLAN
4 - 7	BRIDGE DETAILS
8 - 18	TYPICAL AND STANDARD DETAILS
* 2S-1R	PAVEMENT MARKING SCHEDULE

TOTAL SHEET COUNT AFTER "AS-BUILT"  
POSTINGS: 19 SHEETS

STATE OF HAWAII  
DEPARTMENT OF TRANSPORTATION  
HIGHWAYS DIVISION  
"AS - BUILT"  
PLANS FOR  
GUARDRAIL IMPROVEMENTS AT VARIOUS LOCATIONS  
(NEAR KAUNAKAKAI, KAMALO AND PUKOO)  
PROJECT NO. HWY-M-03-82




DISTRICT OF MOLOKAI  
COUNTY OF MAUI  
ISLAND OF MOLOKAI

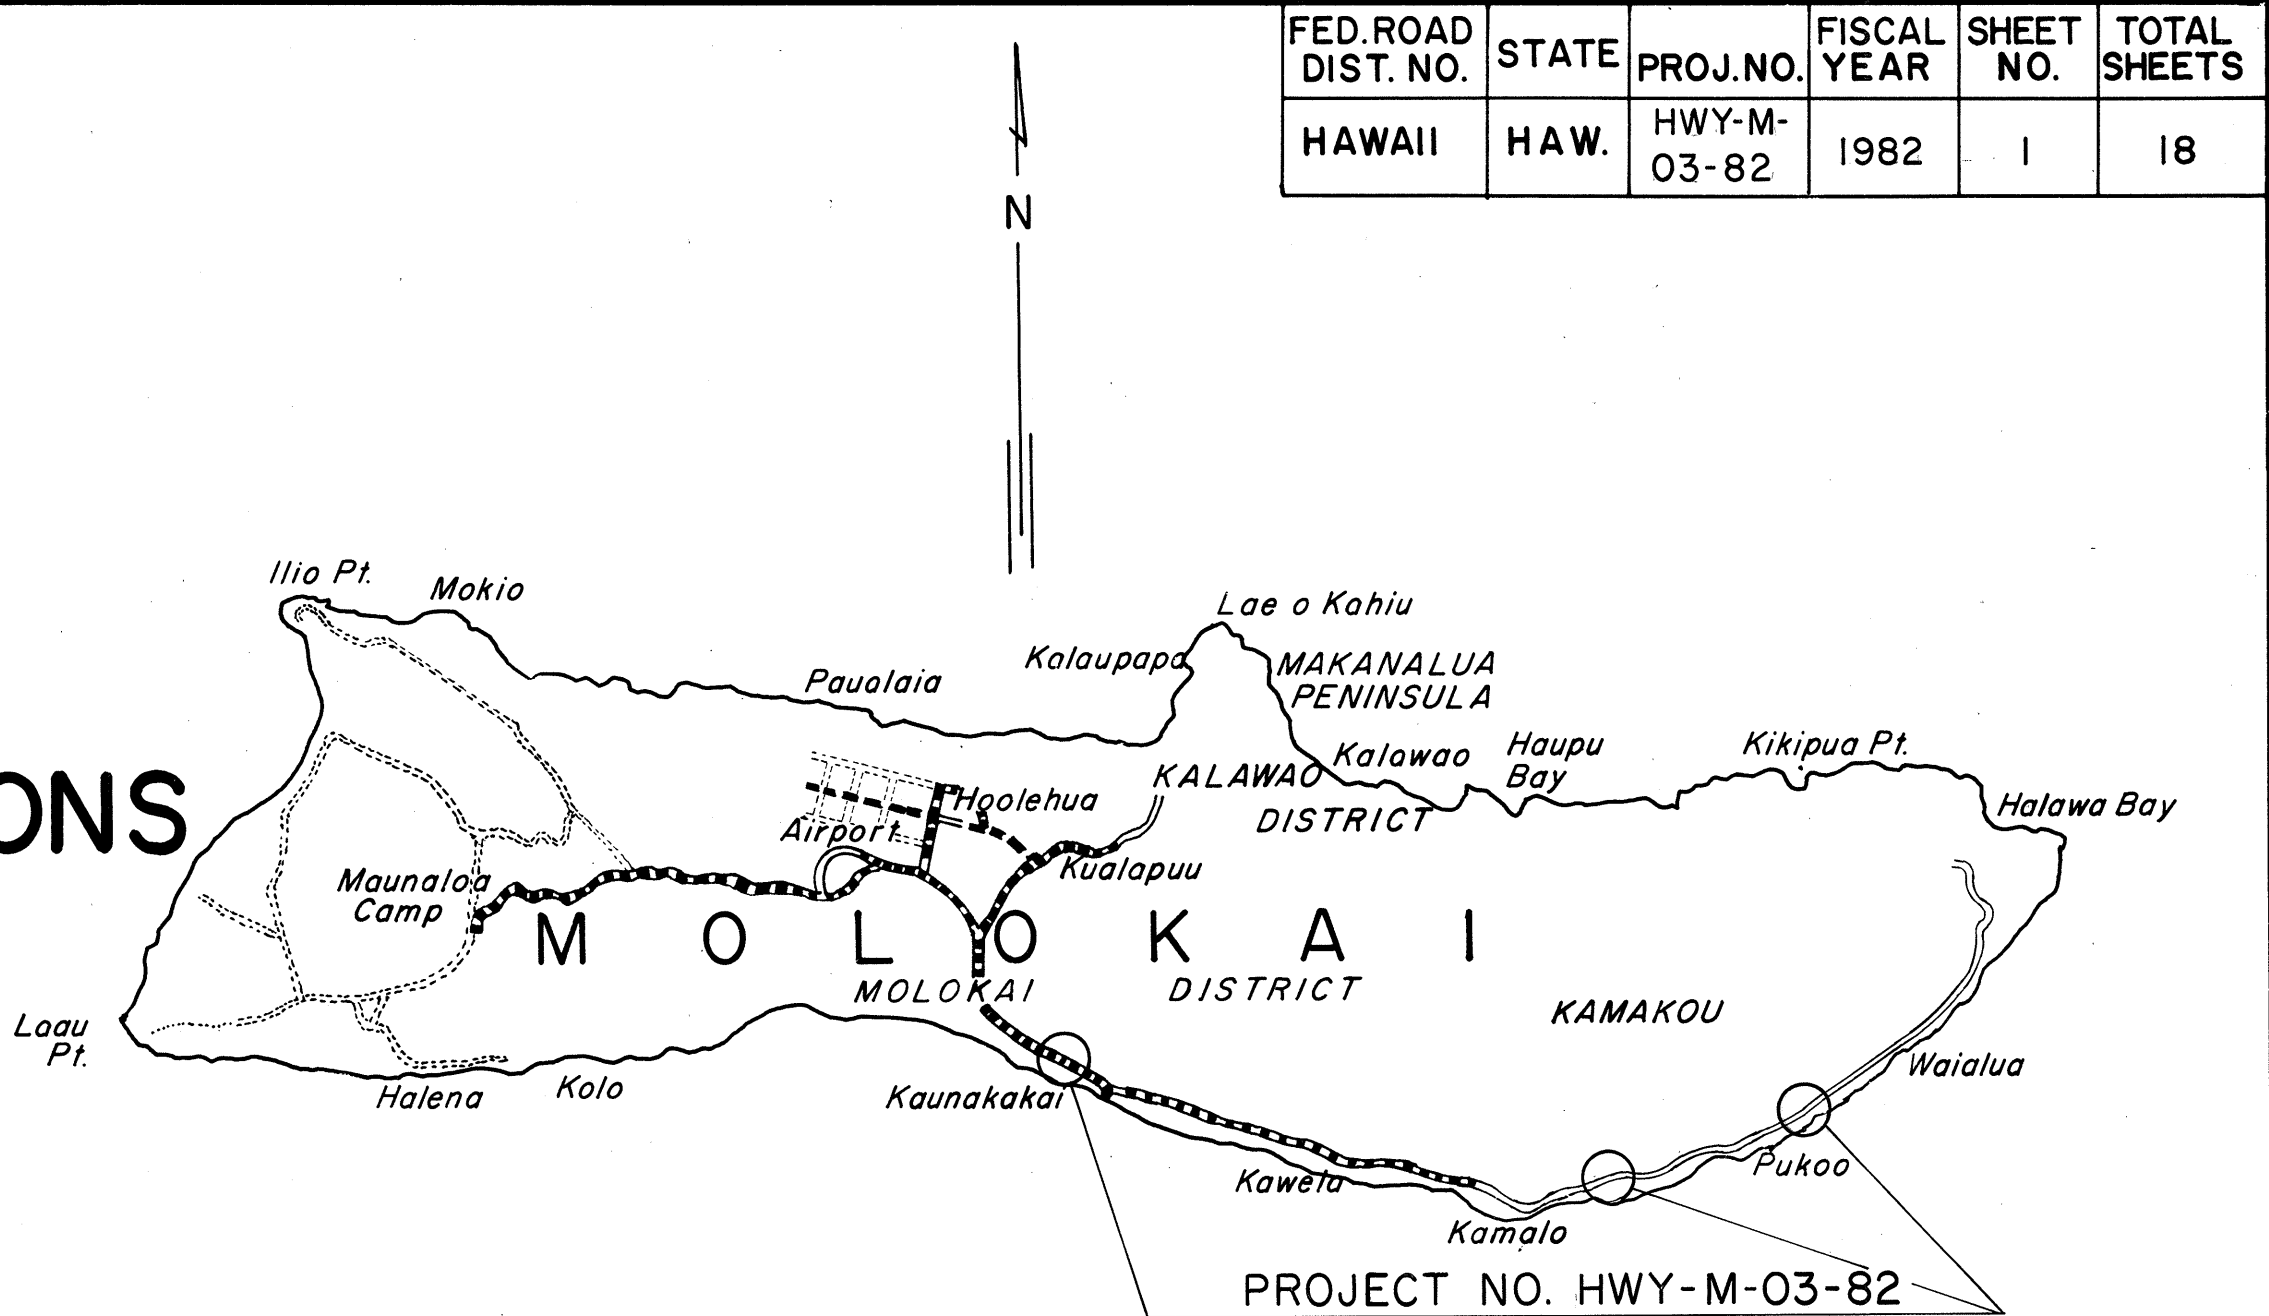

FEDERAL AID PROJECTS PREVIOUSLY  
CONSTRUCTED OR UNDER CONSTRUCTION

CHANGES MADE DURING CONSTRUCTION HAVE  
BEEN INCORPORATED ON THESE PLANS EXCEPT  
CHANGES IN THE ORIGINAL THEORETICAL  
QUANTITIES. FOR ACTUAL QUANTITIES, REFER TO  
PROJECT LEDGER AND/OR COMPUTATION BOOK.

*Ferdinand Canale* 6/20/82  
RESIDENT ENGINEER DATE

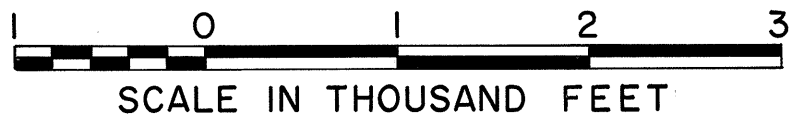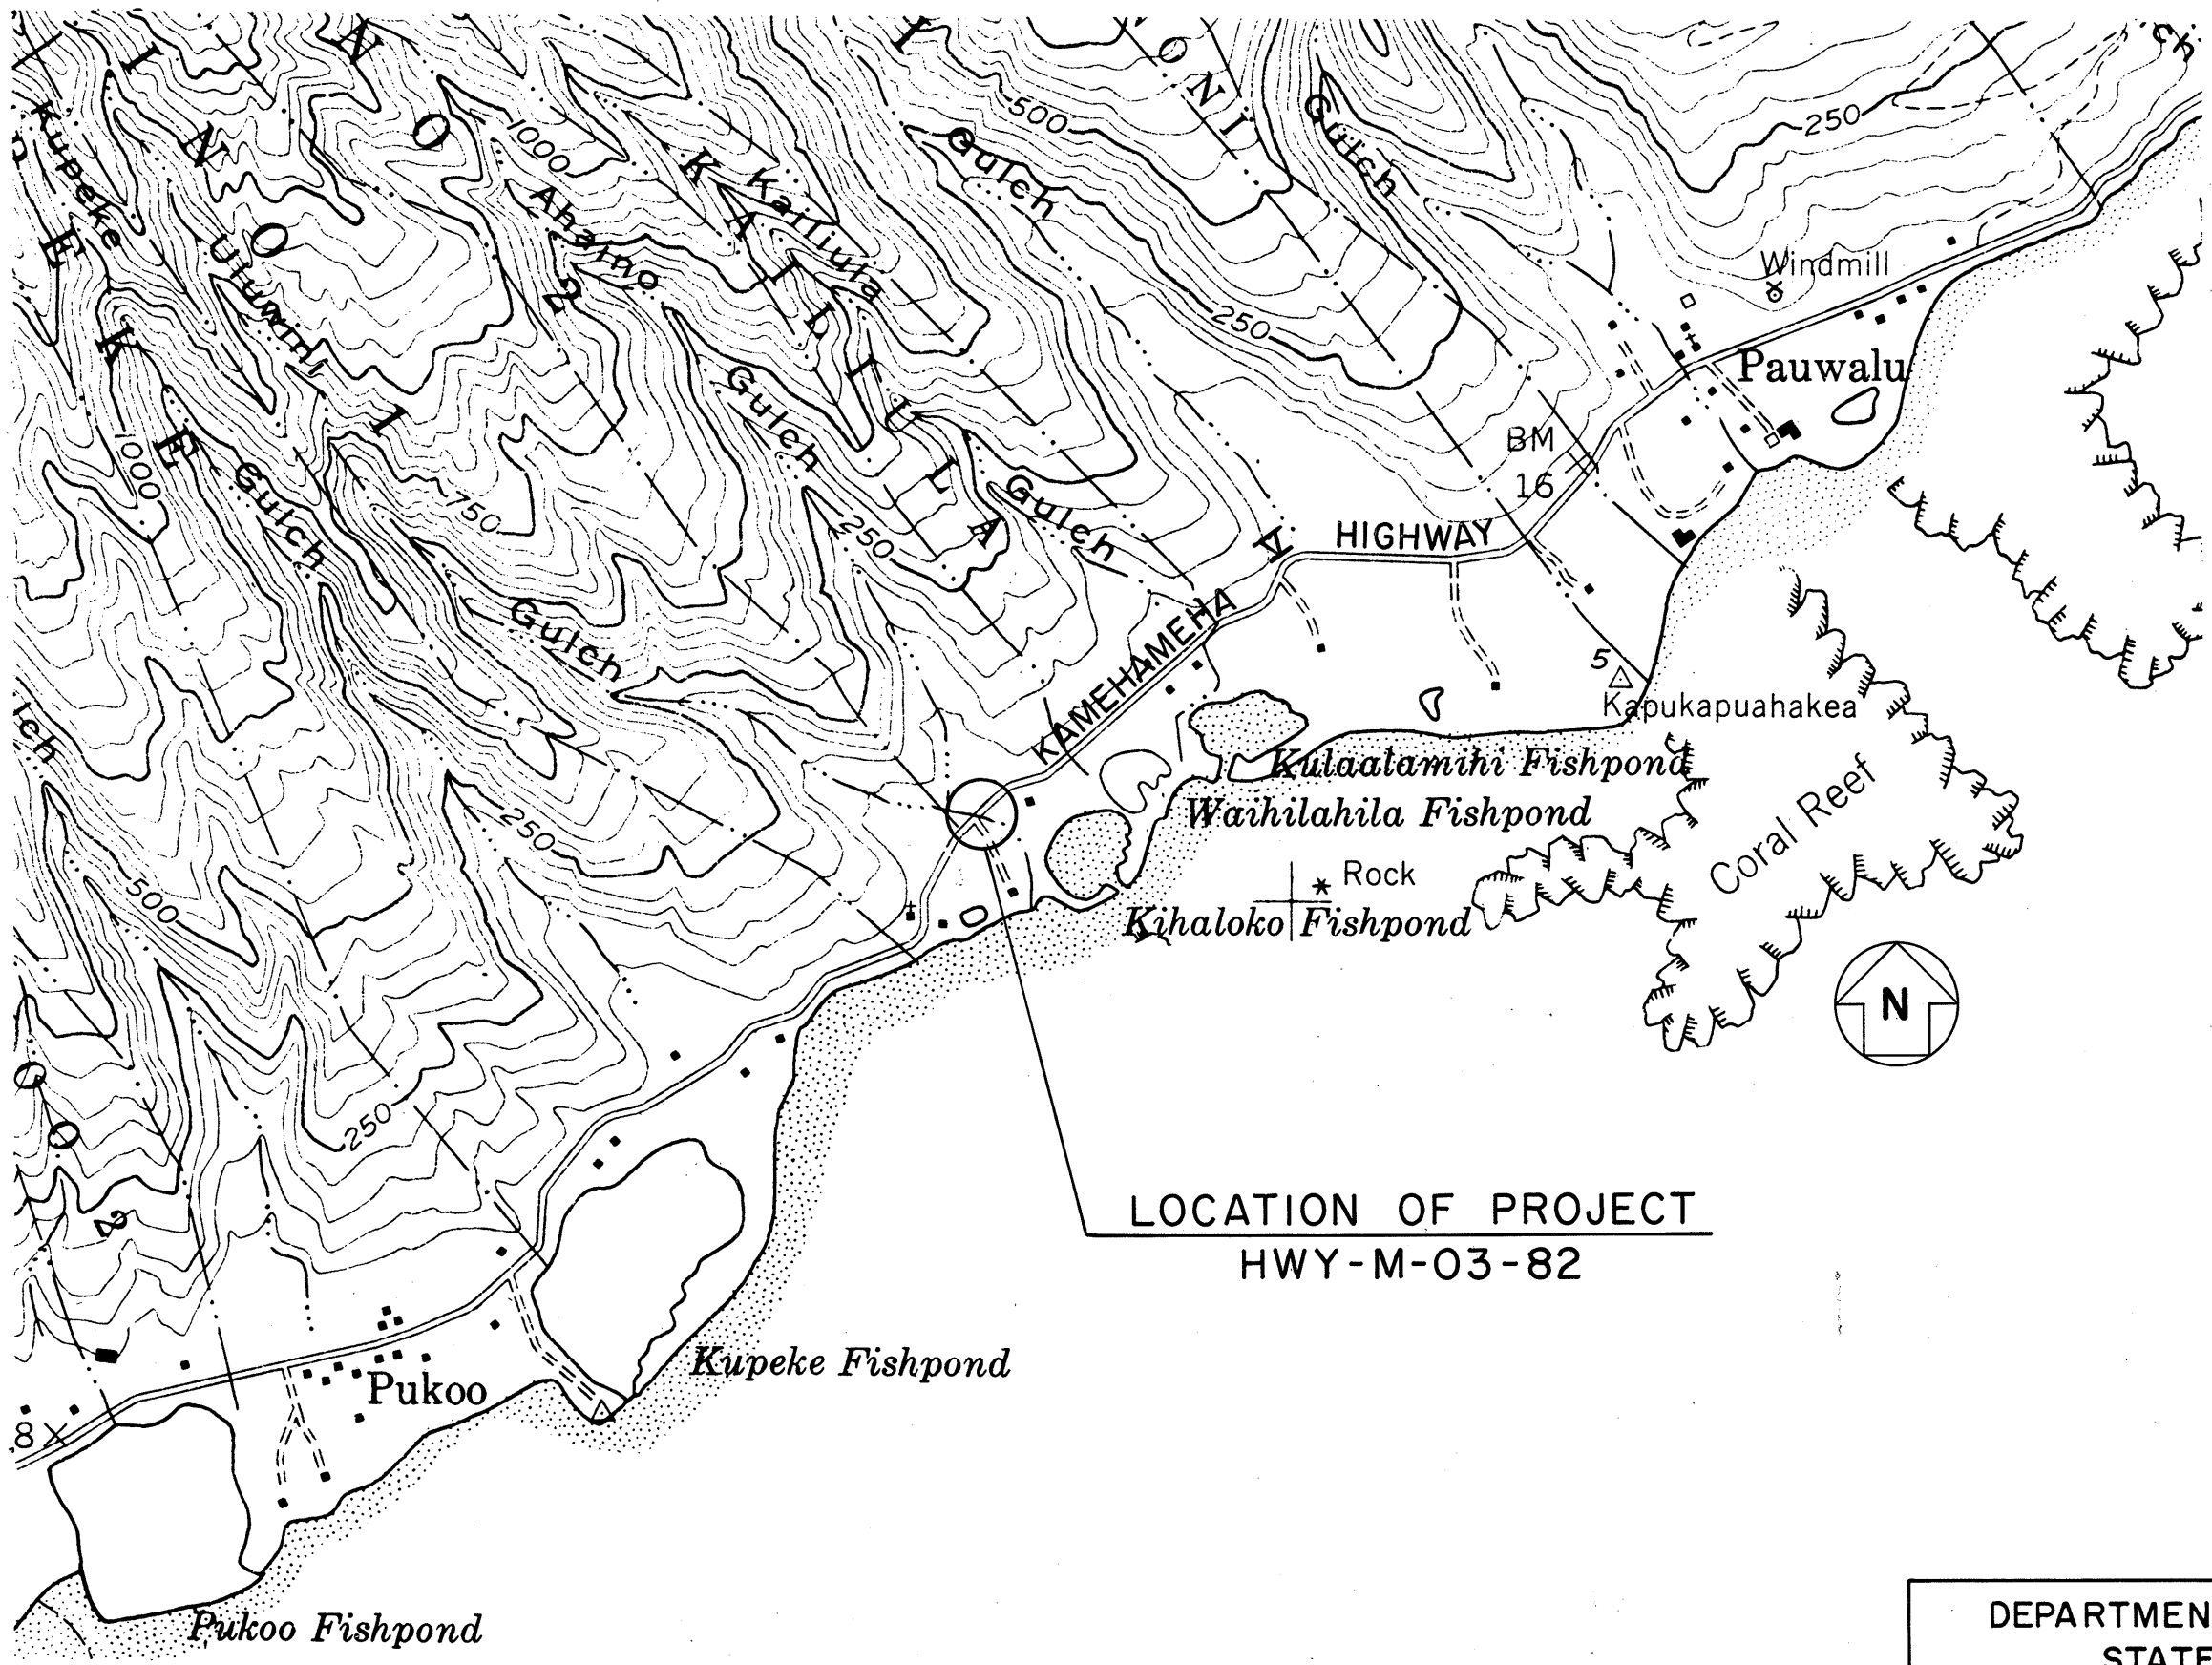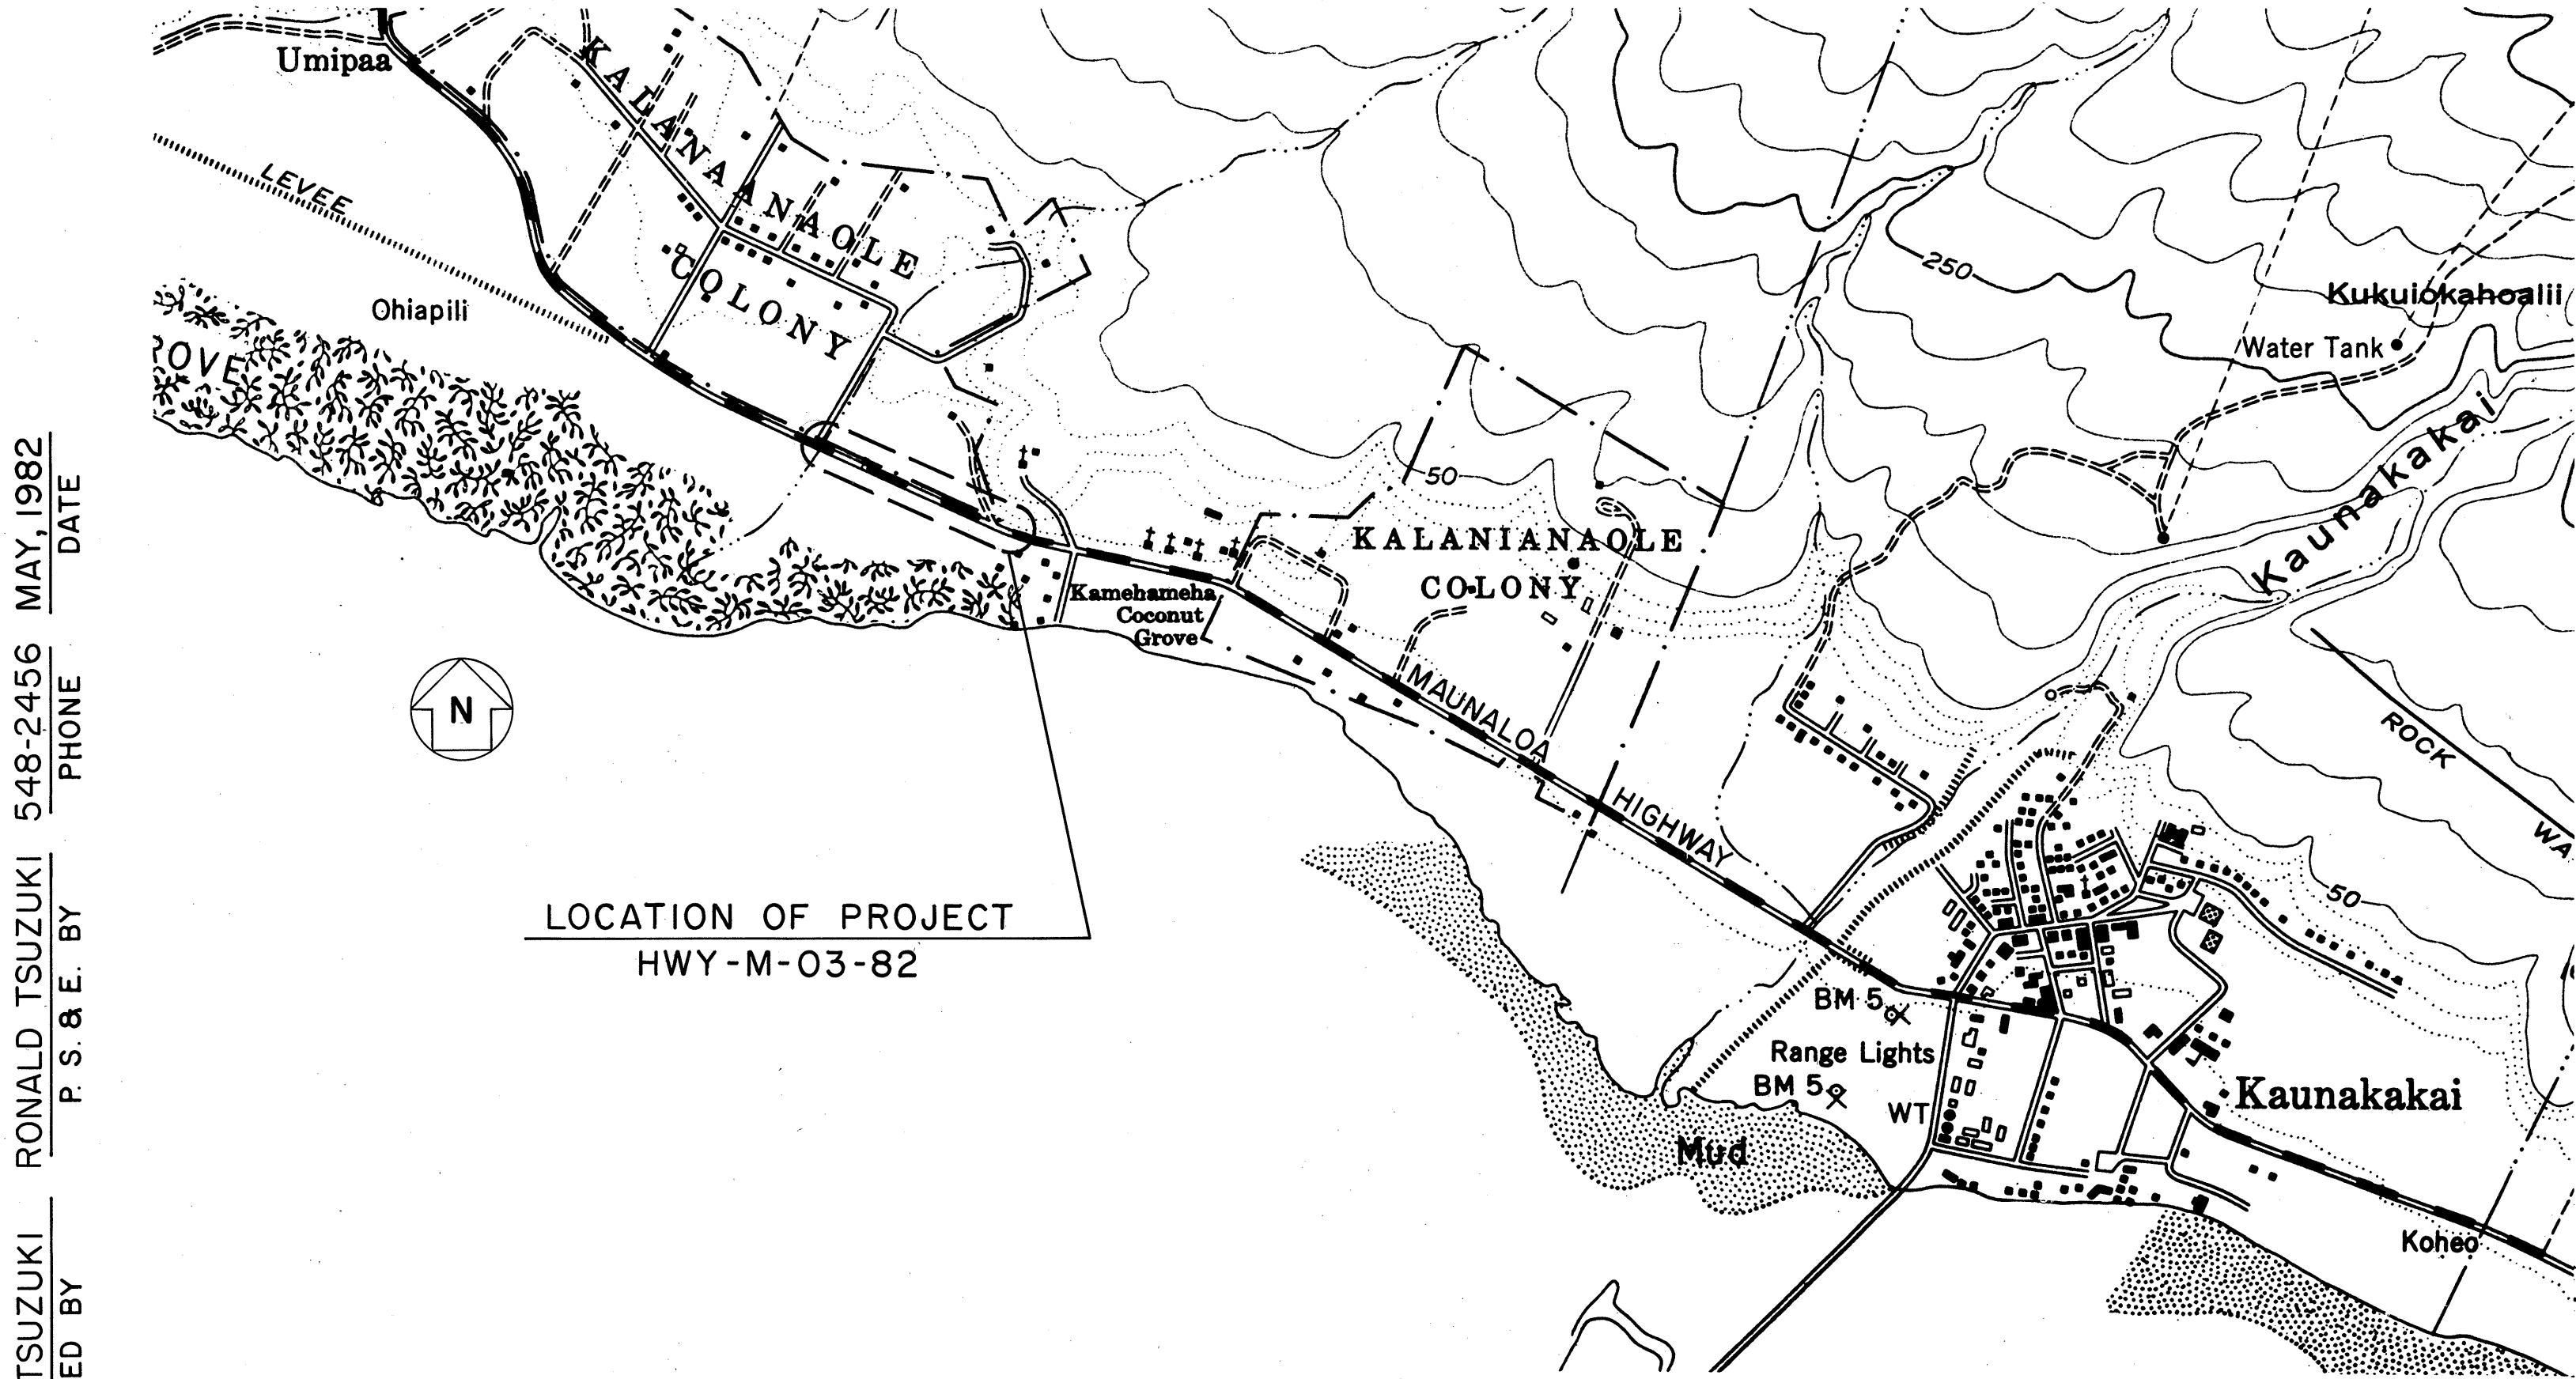

RONALD TSUZUKI 548-2456 MAY, 1982  
DESIGNED BY P.S. & E. BY PHONE DATE

DEPARTMENT OF TRANSPORTATION  
STATE OF HAWAII  
APPROVED:  
*James R. Carras* 6/13/82  
DIR. OF TRANSPORTATION DATE