



GENERAL NOTES

-
- Diagram illustrating the cross-section of a road construction. The road width is 14.0m ± 18.0m, divided into Inbound and Outbound lanes. The shoulders are 20m ± 6.0m wide. The road is constructed on a 1/2" A.C. Leveling Course. The diagram shows the road surface, the leveling course, and the existing ground level.

Not To Scale

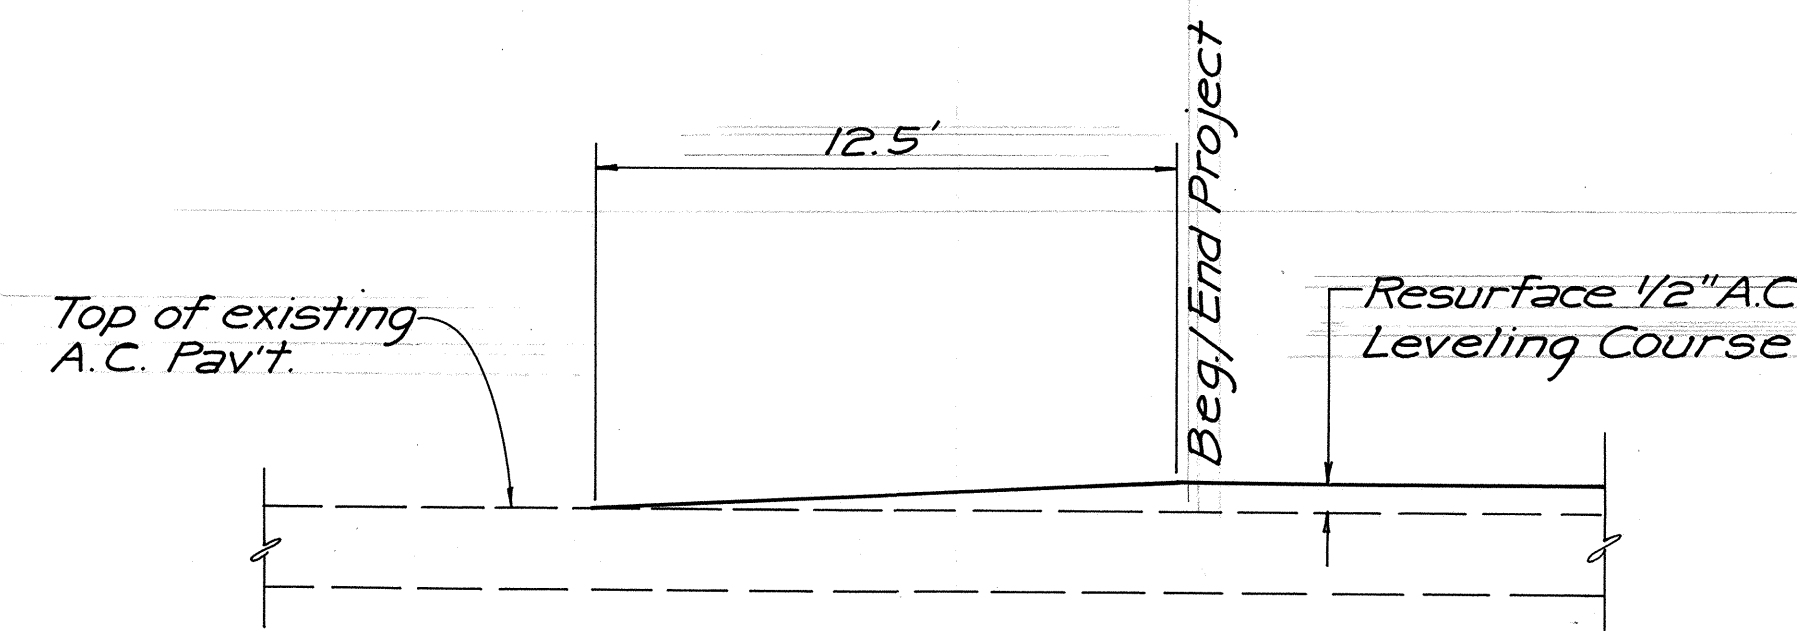

Not To Scale

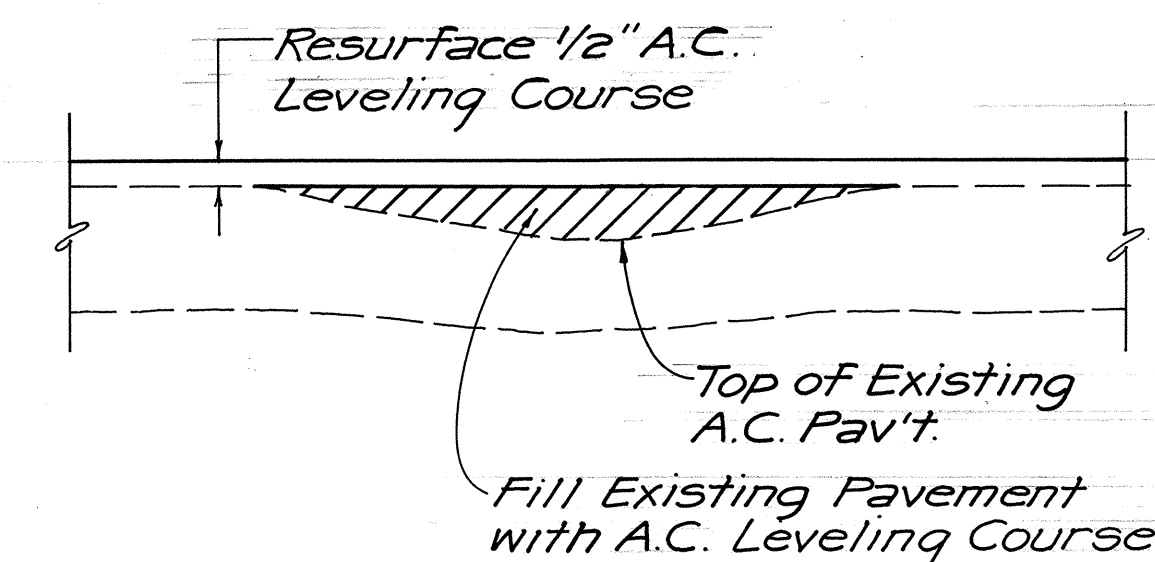

Not To Scale

STATE OF HAWAII
DEPARTMENT OF TRANSPORTATION
HIGHWAYS DIVISION

GENERAL NOTES AND
TYPICAL SECTIONS

KAMEHAMEHA I HIGHWAY RESURFACING
Vicinity of Waialua Tncls. Puv-O Hoku
PROJ. NO. 450B-01-87M

Scale: As Shown Date: Mar., 1987