4	INDEX TO DRAWINGS
SHEET NO.	DESCRIPTION
en la maria de la compania de la co	TITLE SHEET
<u> </u>	STANDARD PLAN SUMMARY
3	TYPICAL SECTIONS
4 - 5	PLAN
6 - 7	DRAINAGE DETAILS
	SIGN SUMMARY
① 9	GENERAL NOTES & MARKER/
more restricted to the second of the second	STRIPING SUMMARY
	enter and the second se
•	
•	ts.

SHEET NOS. () ADD. 95-1 TO 95-6 ARE SUPPLEMENTARY SHEETS TO THIS PROJECT. TOTAL SHEET COUNT AFTER "AS-BUILT" POSTING 15 SHEETS.

STATE OF HAWAII

DEPARTMENT OF TRANSPORTATION


HIGHWAYS DIVISION

"AS-BUILT"

PLANS FOR

KAMEHAMEHA V HIGHWAY RESURFACING KAUNAKAKAI TO KAMILOLOA BRIDGE F. A. PROJECT NO. RS-0450(4)


> DISTRICT OF MOLOKAI ISLAND OF MOLOKAL

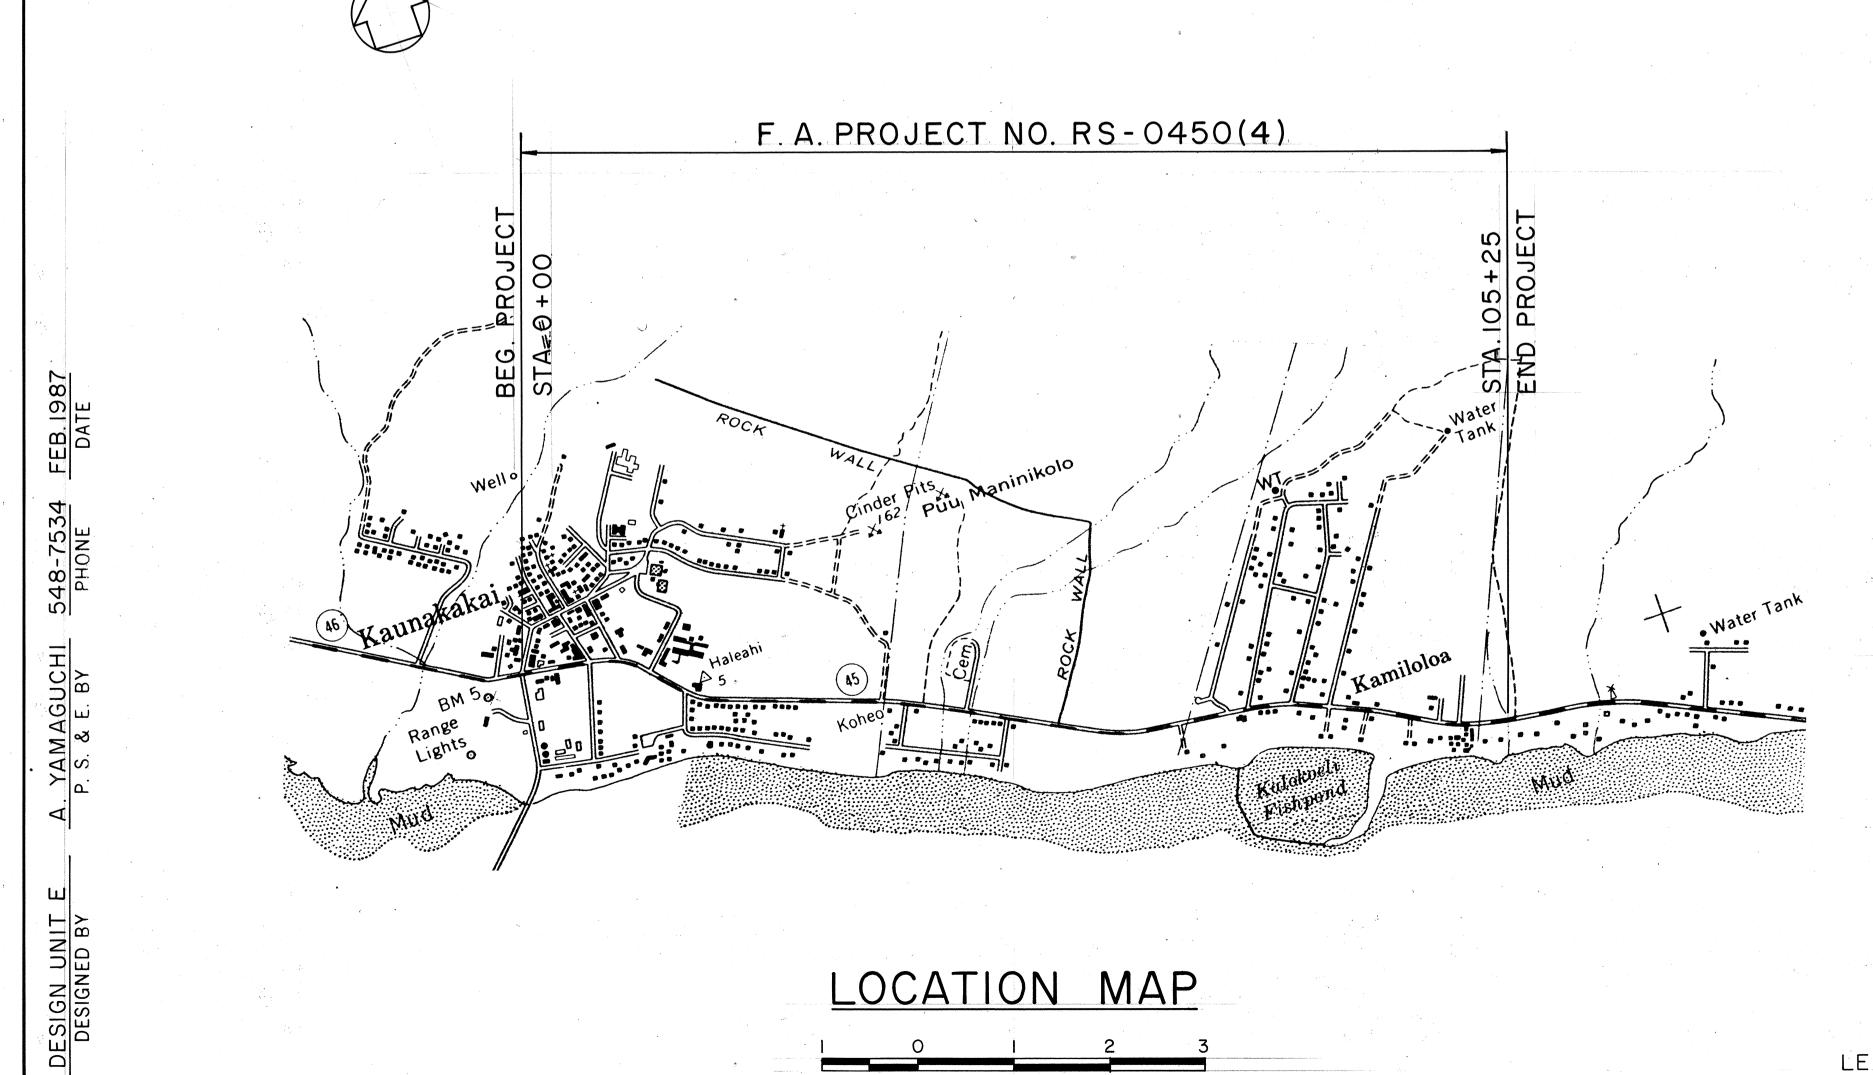



DESIGN DESIGNATION CURRENT ADT (1987) 3.960

CURREINI ADI (1901).	
DESIGN ADT (1997)	5,140
DHV	90
D	55/45
	6.0

FISCAL SHEET YEAR NO. FED. AID PROJ. NO. DIST. NO. RS-0450(4)

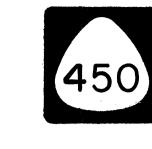

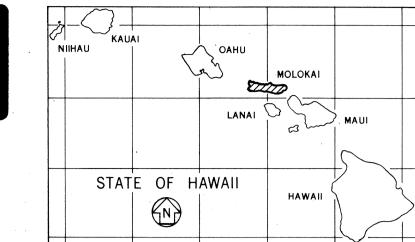

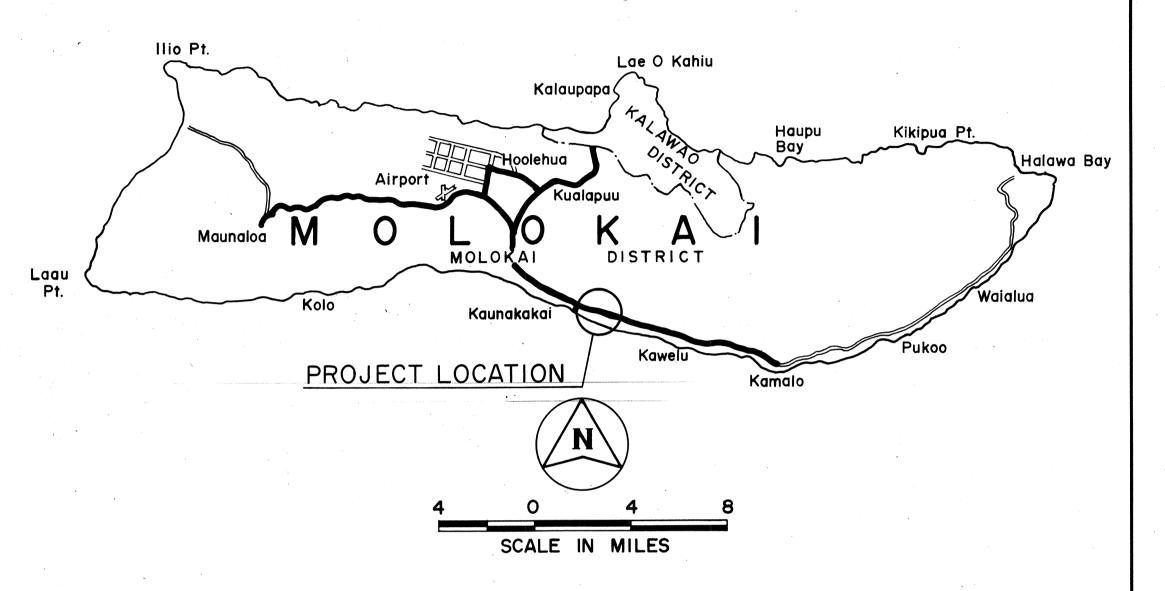

AID PROJECTS PREVIOUSLY CONSTRUCTED OR UNDER CONSTRUCTION

NO SIGNIFICANT CHANGES WERE MADE DURING CONSTRUCTION ON THESE PLANS EXCEPT CHANGES IN THE ORIGINAL THEORETICAL QUANTITIES, FOR ACTUAL QUANTITIES, REFER TO PROJECT LEDGER AND/OR COMPUTATION BOOK.

RESIDENT ENGINEER

DATE

DEPARTMENT OF TRANSPORTATION STATE OF HAWAII APPROVED:

_OCATION MAP

SCALE IN THOUSAND FEET

LENGTH OF PROJECT. . . 1.99 MI.