



FED. ROAD DIST. NO.	STATE	FED. AID PROJ. NO.	FISCAL YEAR	SHEET NO.	TOTAL SHEETS
HAWAII	HAW.	STP-0450(5)	1993	6	10

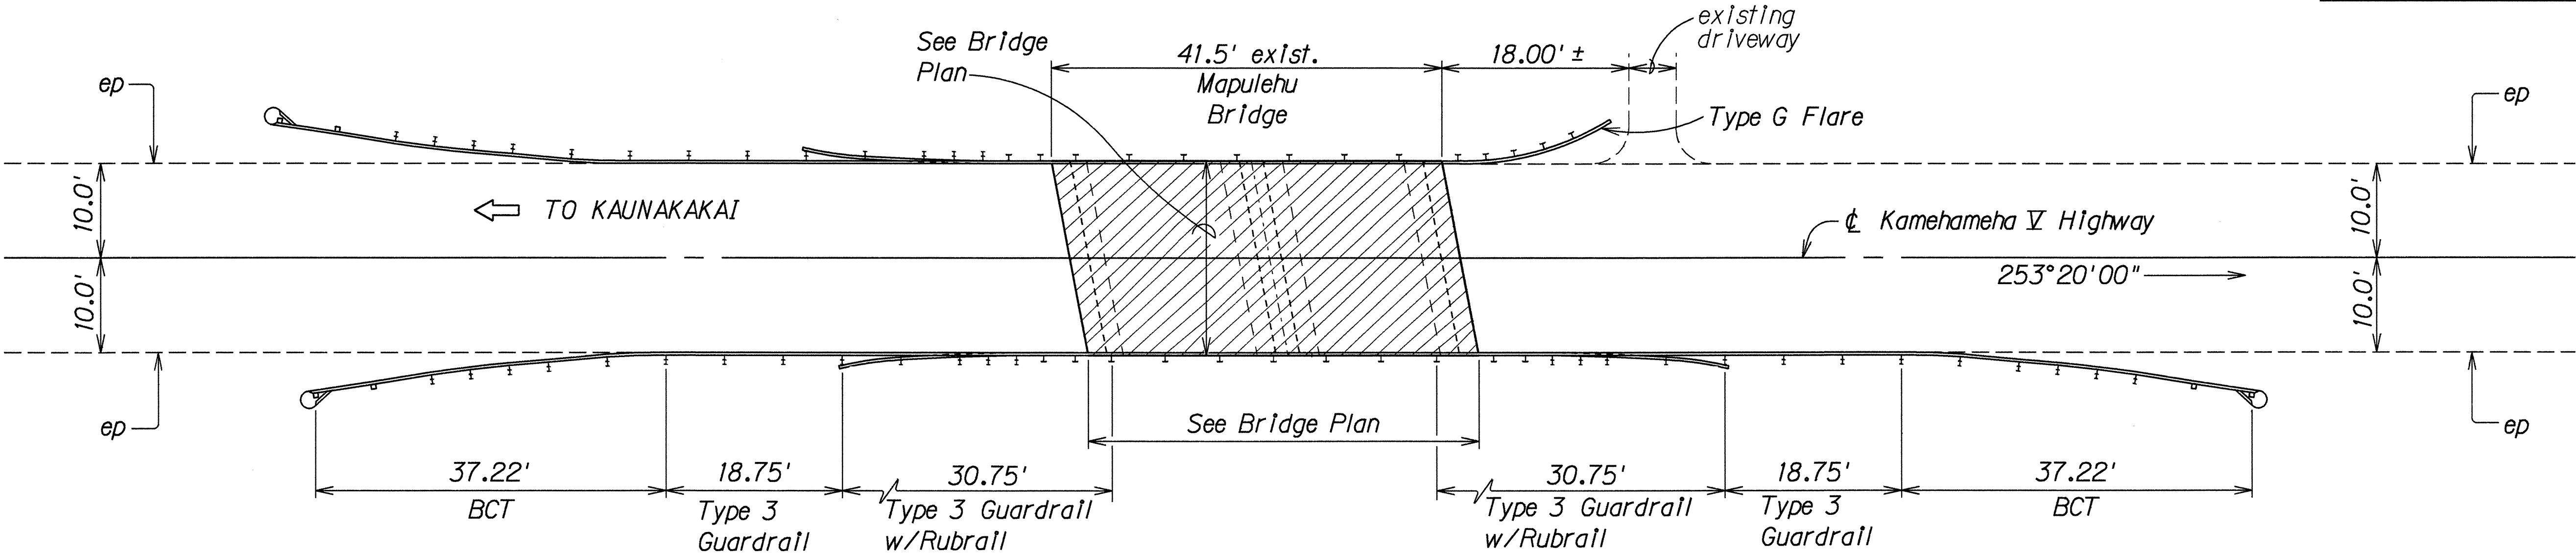

PLAN
GUARDRAIL LAYOUT
MAPULEHU BRIDGE
Scale: 1" = 10'

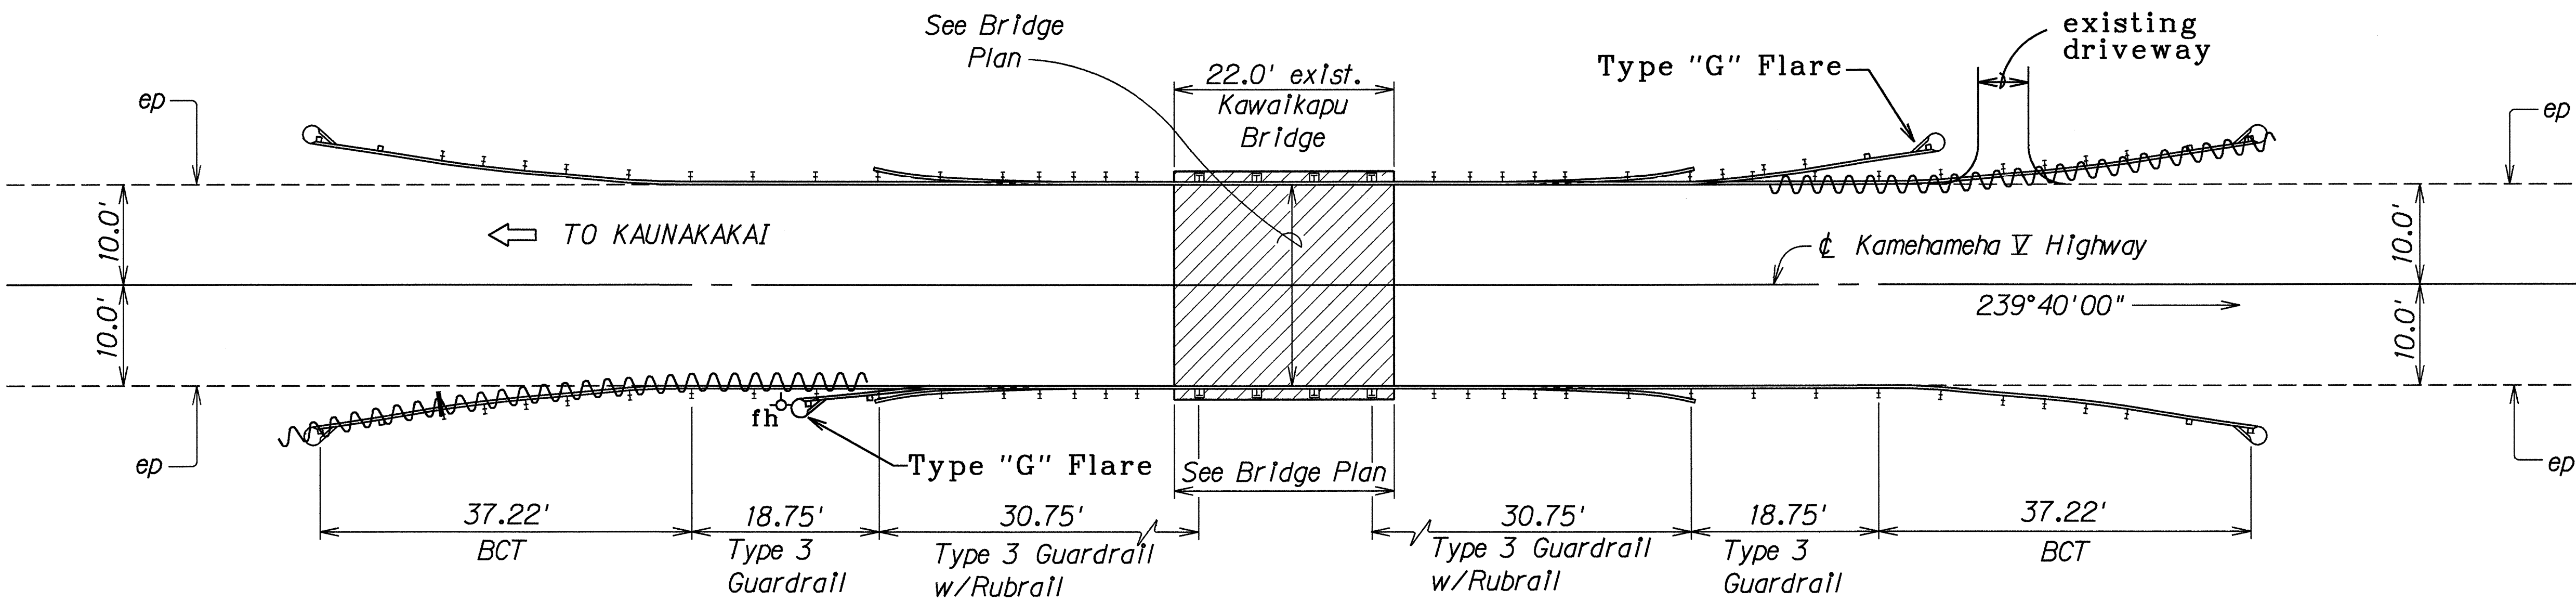

PLAN
GUARDRAIL LAYOUT
KAWAIKAPU BRIDGE
Scale: 1" = 10'

LEGEND FOR AS-BUILT POSTINGS	
	Squiggly line for as-built deletion
	Double line for as-built deletion
Roadway	Text for as-built posting

STATE OF HAWAII
DEPARTMENT OF TRANSPORTATION
HIGHWAYS DIVISION

PLAN
GUARDRAIL LAYOUT AT STRUCTURES
KAMEHAMEHA V HIGHWAY GUARDRAIL
AND SHOULDER IMPROVEMENTS
Fed. Aid Project No. STP-0450(5)
Scale: 1" = 10' Date: Aug., 1992
SHEET No. 1 OF 1 SHEETS

"AS-BUILT"