
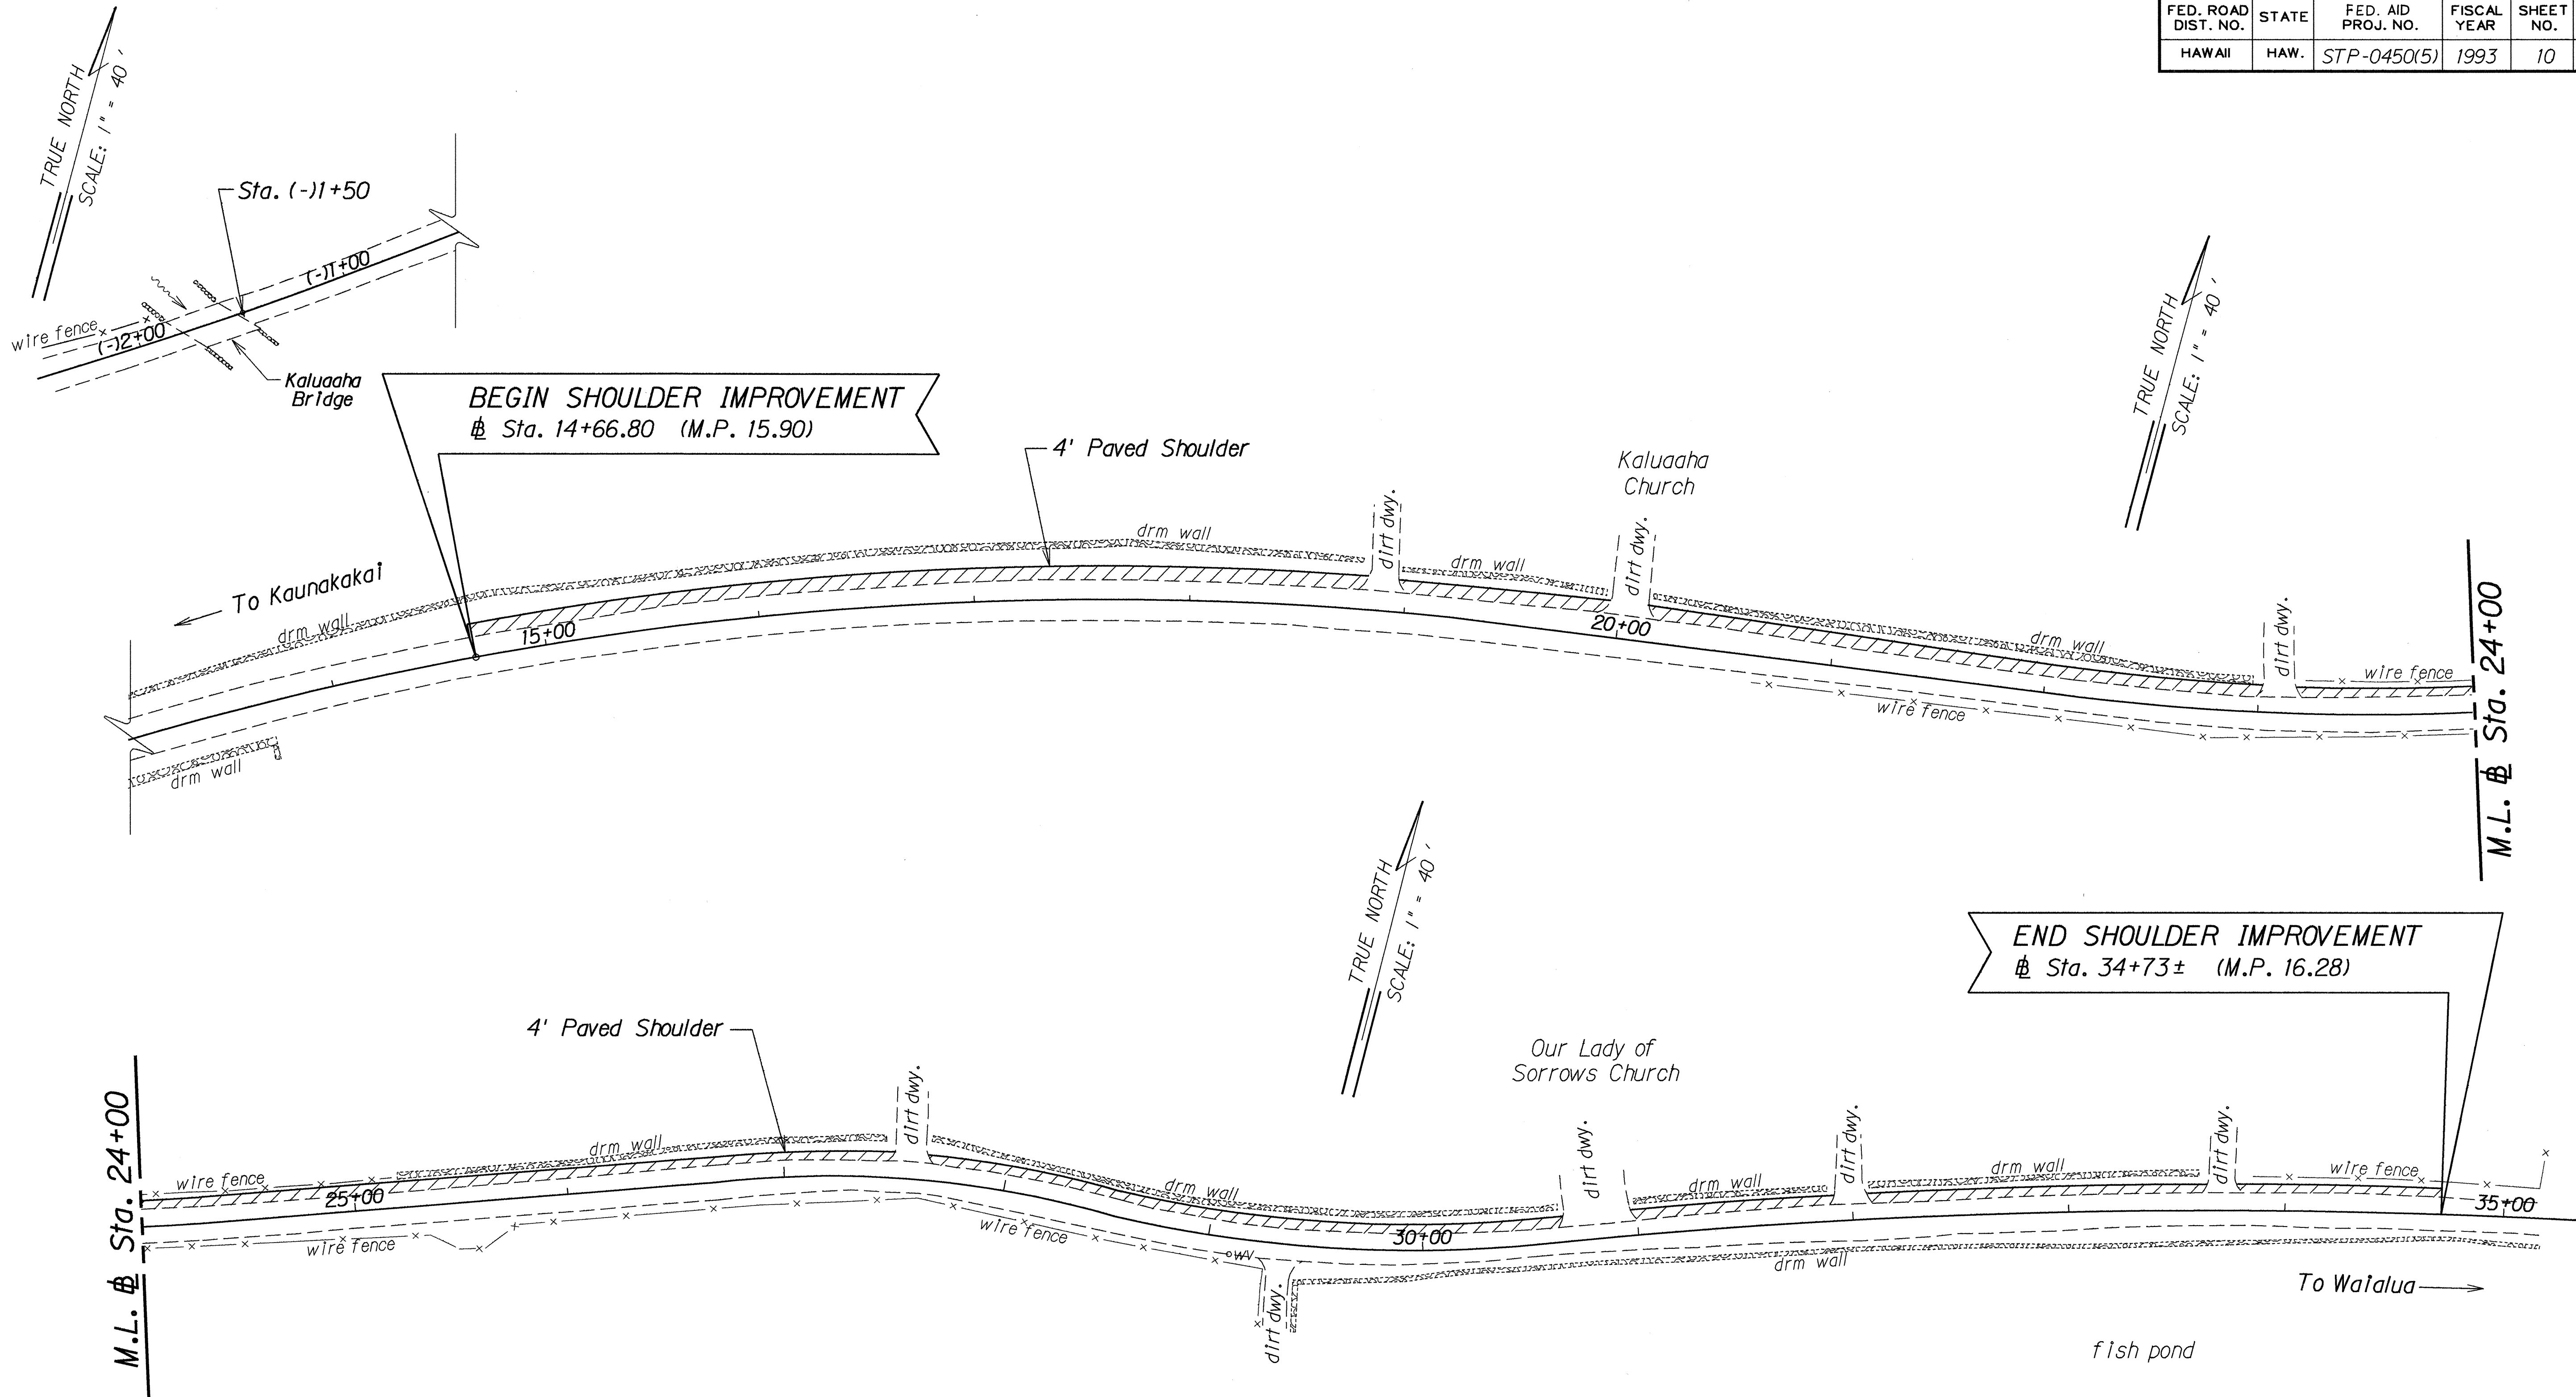


FED. ROAD DIST. NO.	STATE	FED. AID PROJ. NO.	FISCAL YEAR	SHEET NO.	TOTAL SHEETS
HAWAII	HAW.	STP-0450(5)	1993	10	10

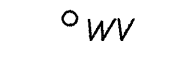

ORIGINAL PLAN	SURVEY PLOTTED BY	DATE
NOTE BOOK	DESIGNED BY	
3kmdpl.dgn	QUANTITIES BY	
	CHECKED BY	

LEGEND

-  4 feet Paved Shoulder
-  Existing Water Valve

STATE OF HAWAII
DEPARTMENT OF TRANSPORTATION
HIGHWAYS DIVISION

SHOULDER IMPROVEMENT PLAN
KAMEHAMEHA V HIGHWAY
GUARDRAIL AND SHOULDER
IMPROVEMENT
Fed. Aid Project No. STP-0450(5)

Scale: 1" = 40'
Date: Sept., 1992
SHEET No. 1 OF 1 SHEETS