


FED. ROAD DIST. NO.	STATE	PROJ. NO.	FISCAL YEAR	SHEET NO.	TOTAL SHEETS
HAWAII	HAW.	450B-01-94M	1994	6	31

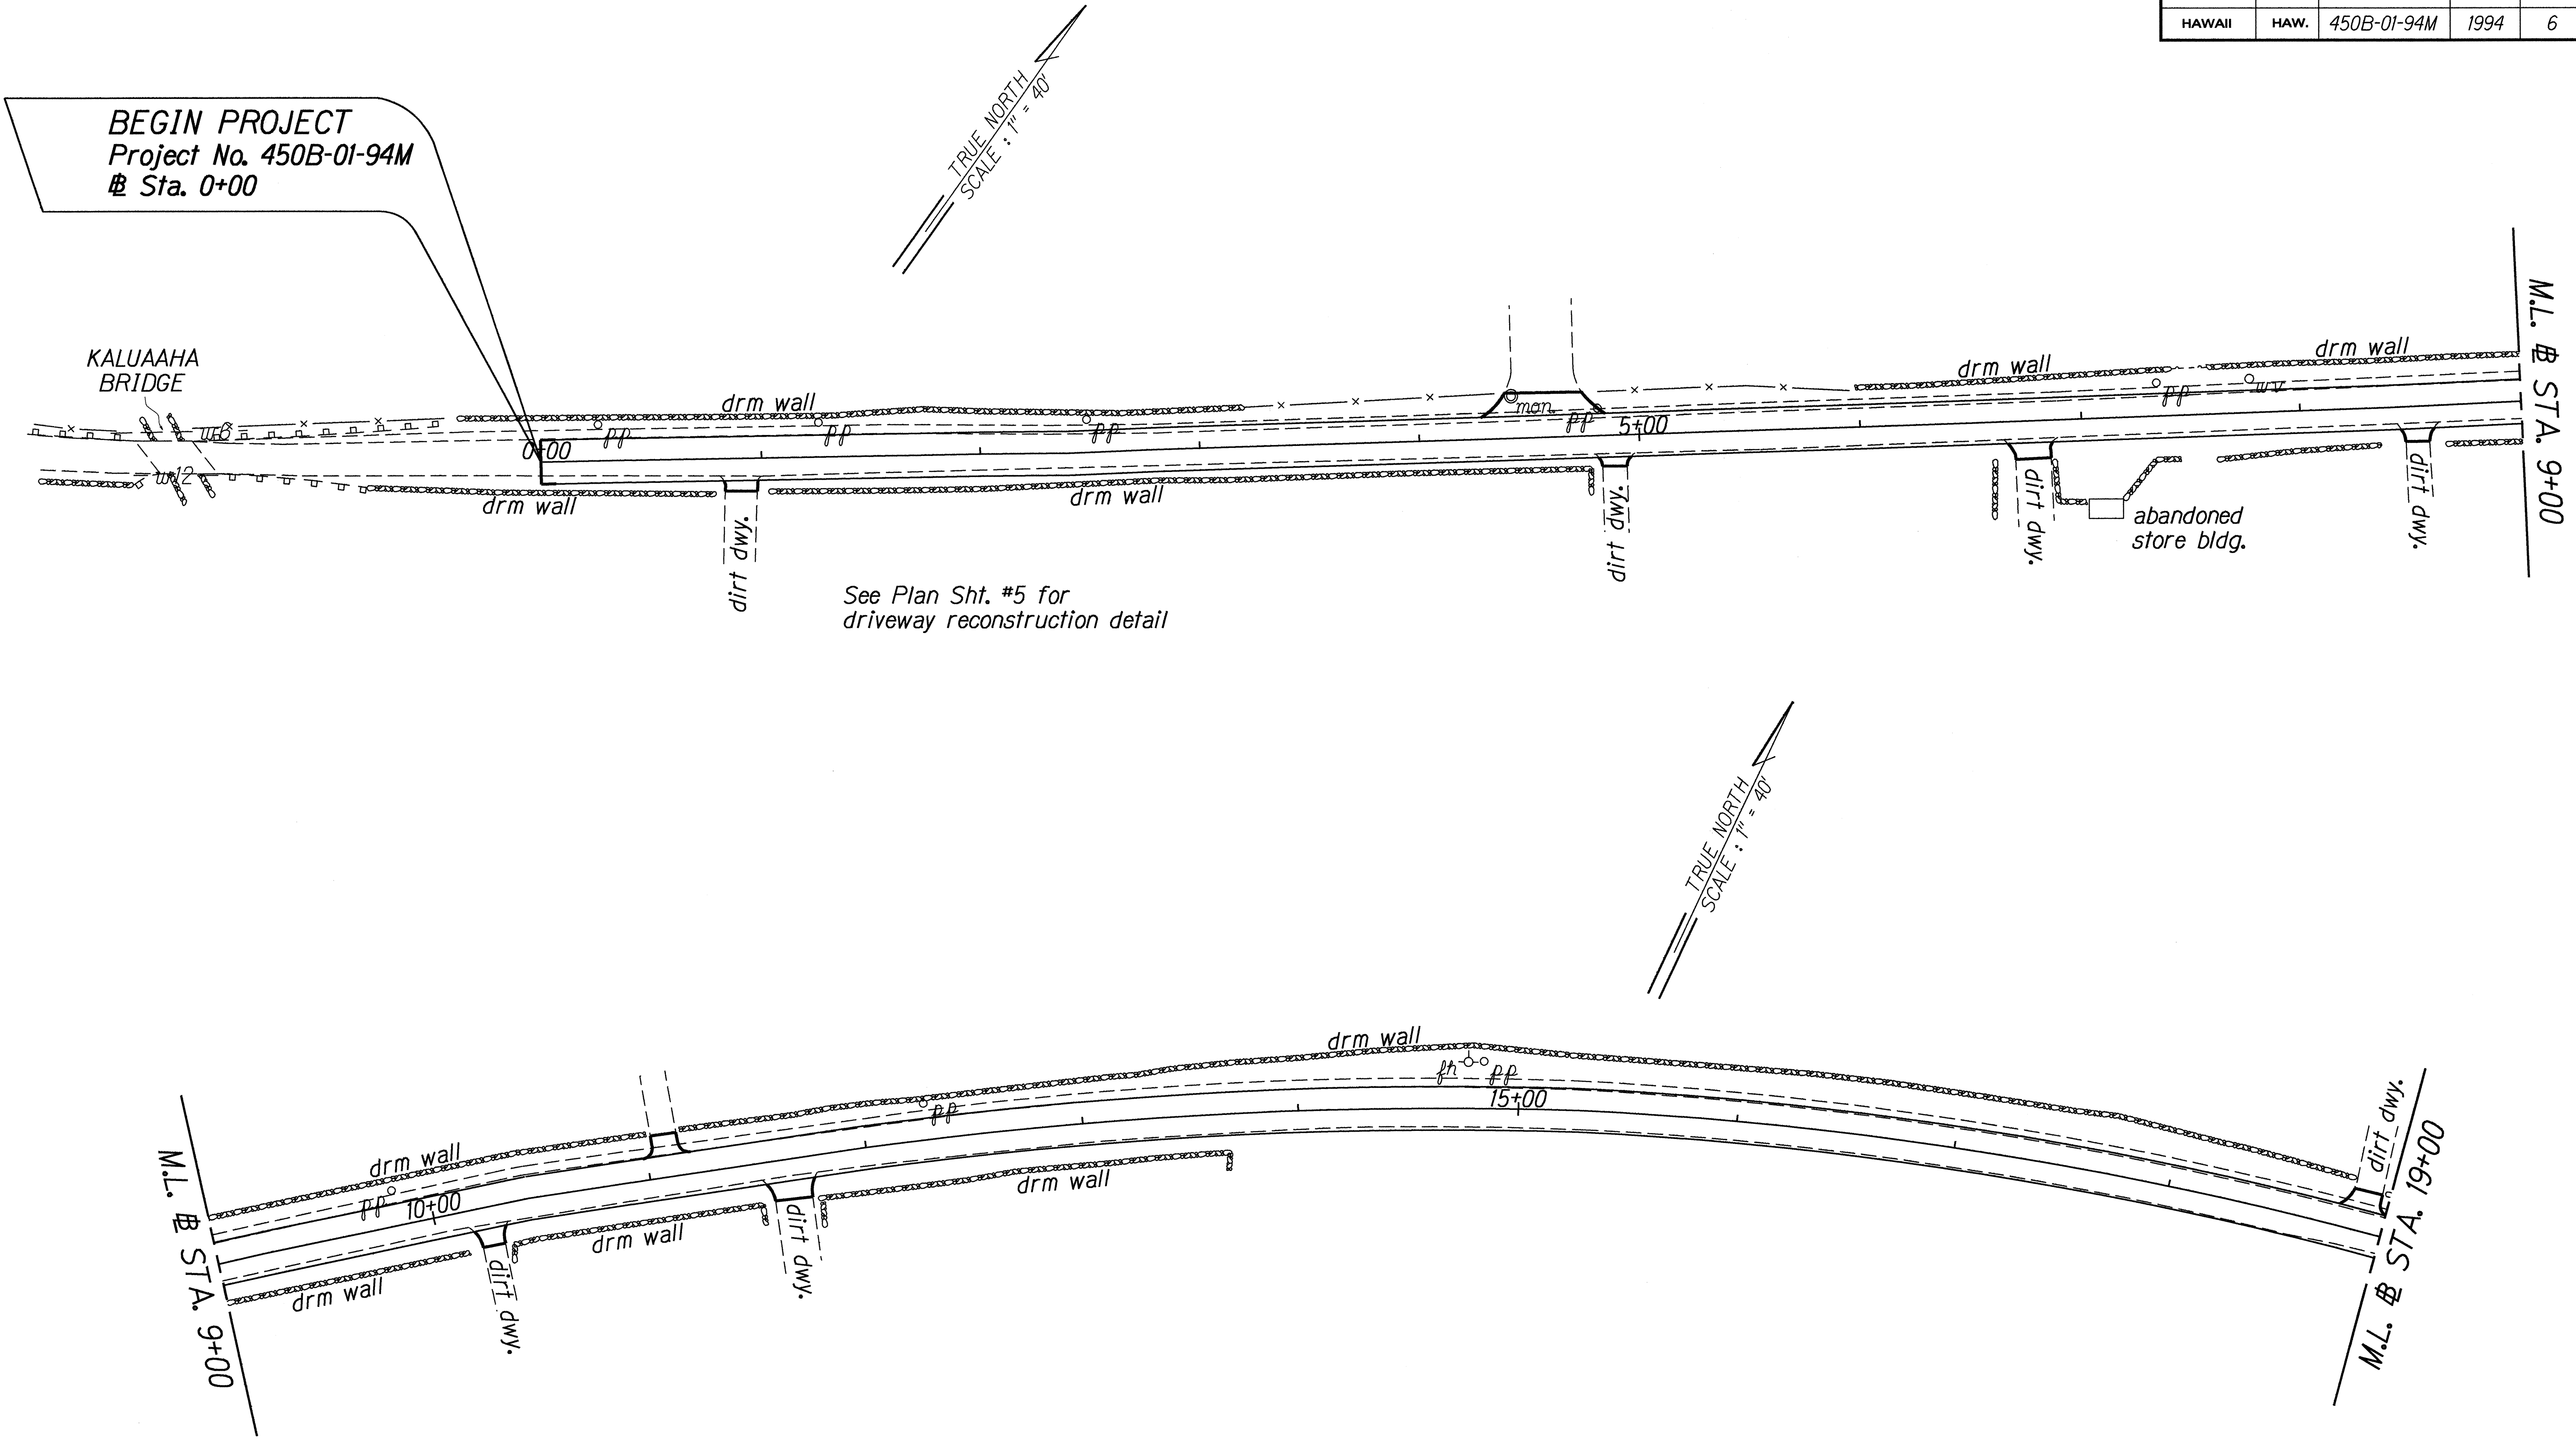


DESIGNED BY	DATE
DRAWN BY	Jan. 1994
CHECKED BY	
NOTED BY	
QUANTITIES BY	
ORIGINAL PLAN	
NOTE BOOK	
2/10/94	

STATE OF HAWAII
DEPARTMENT OF TRANSPORTATION
HIGHWAYS DIVISION

ROADWAY PLAN
KAMEHAMEHA V HIGHWAY RESURFACING
Kilohana School to Waialua
Project No. 450B-01-94M
Scale: 1" = 40' Date: May, 1994
SHEET No. 1 OF 12 SHEETS

FED. ROAD DIST. NO.	STATE	PROJ. NO.	FISCAL YEAR	SHEET NO.	TOTAL SHEETS
HAWAII	HAW.	450B-01-94M	1994	7	31

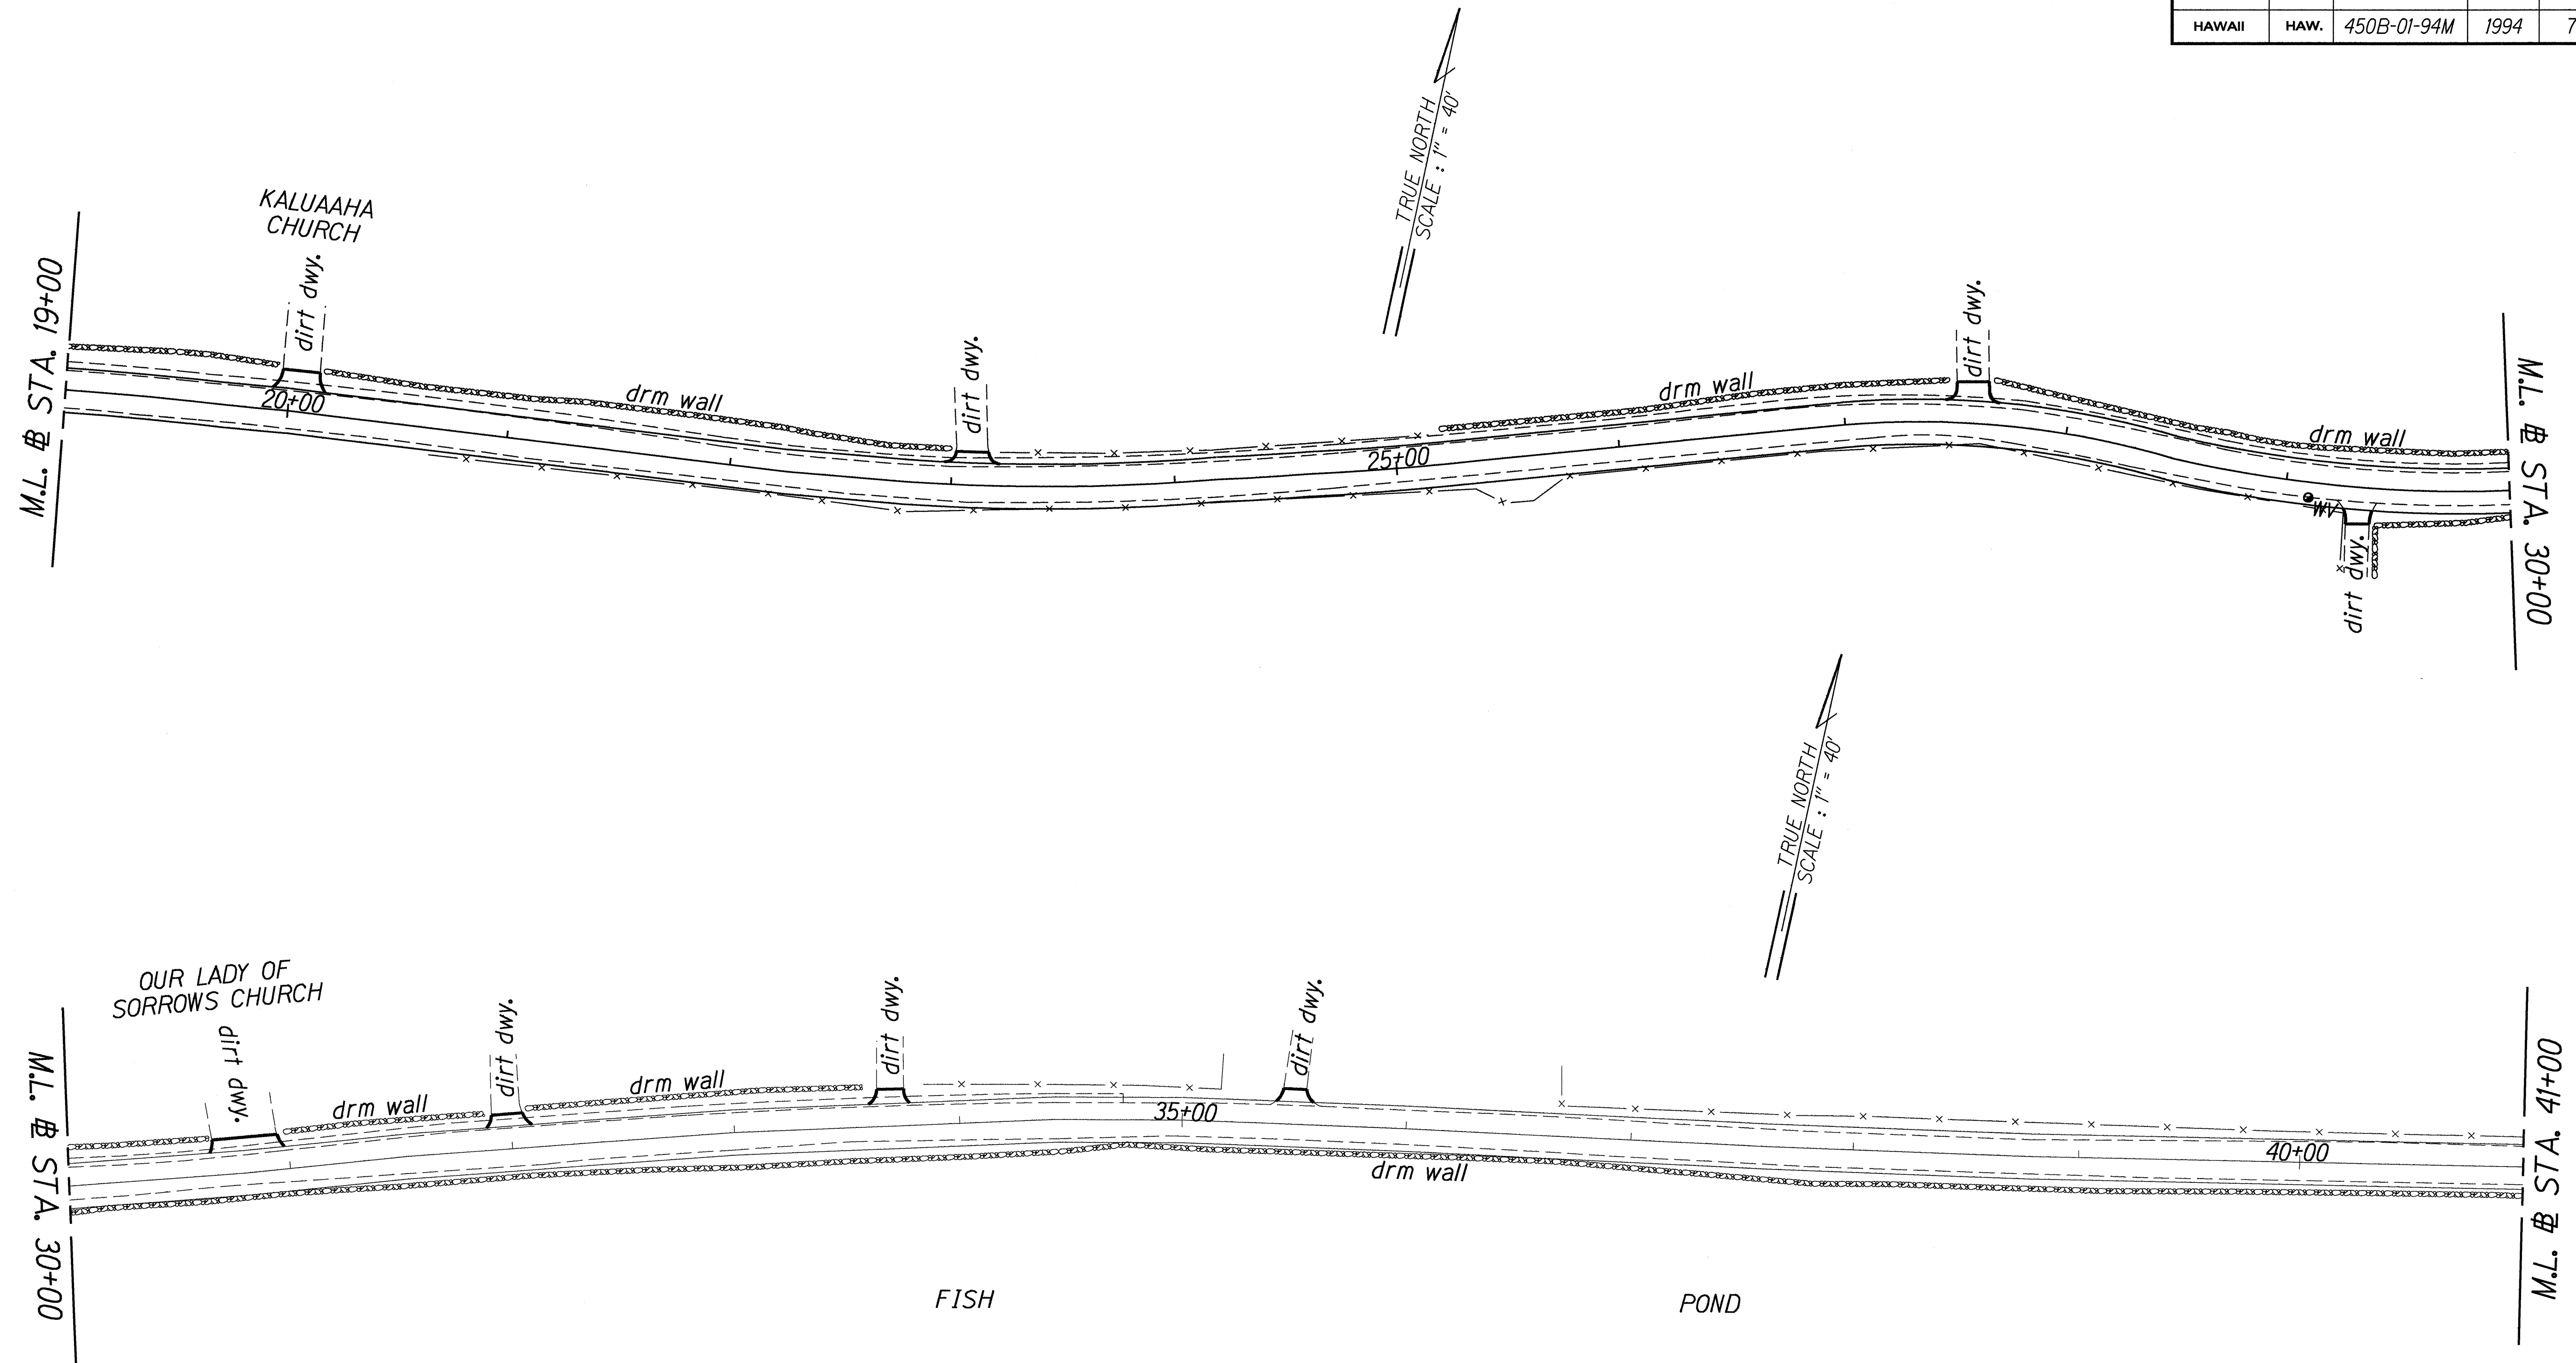

ORIGINAL PLAN	DATE
DESIGNED BY	Jan. 1994
DRAWN BY	
CHECKED BY	
NOTED BY	
QUANTITIES BY	
2/m5mp2.dgn	

STATE OF HAWAII
DEPARTMENT OF TRANSPORTATION
HIGHWAYS DIVISION

ROADWAY PLAN

KAMEHAMEHA V HIGHWAY RESURFACING



Kilohana School to Waialua

Project No. 450B-01-94M

Scale: 1" = 40' Date: May, 1994

SHEET No. 2 OF 12 SHEETS

FED. ROAD DIST. NO.	STATE	PROJ. NO.	FISCAL YEAR	SHEET NO.	TOTAL SHEETS
HAWAII	HAW.	450B-01-94M	1994	8	31

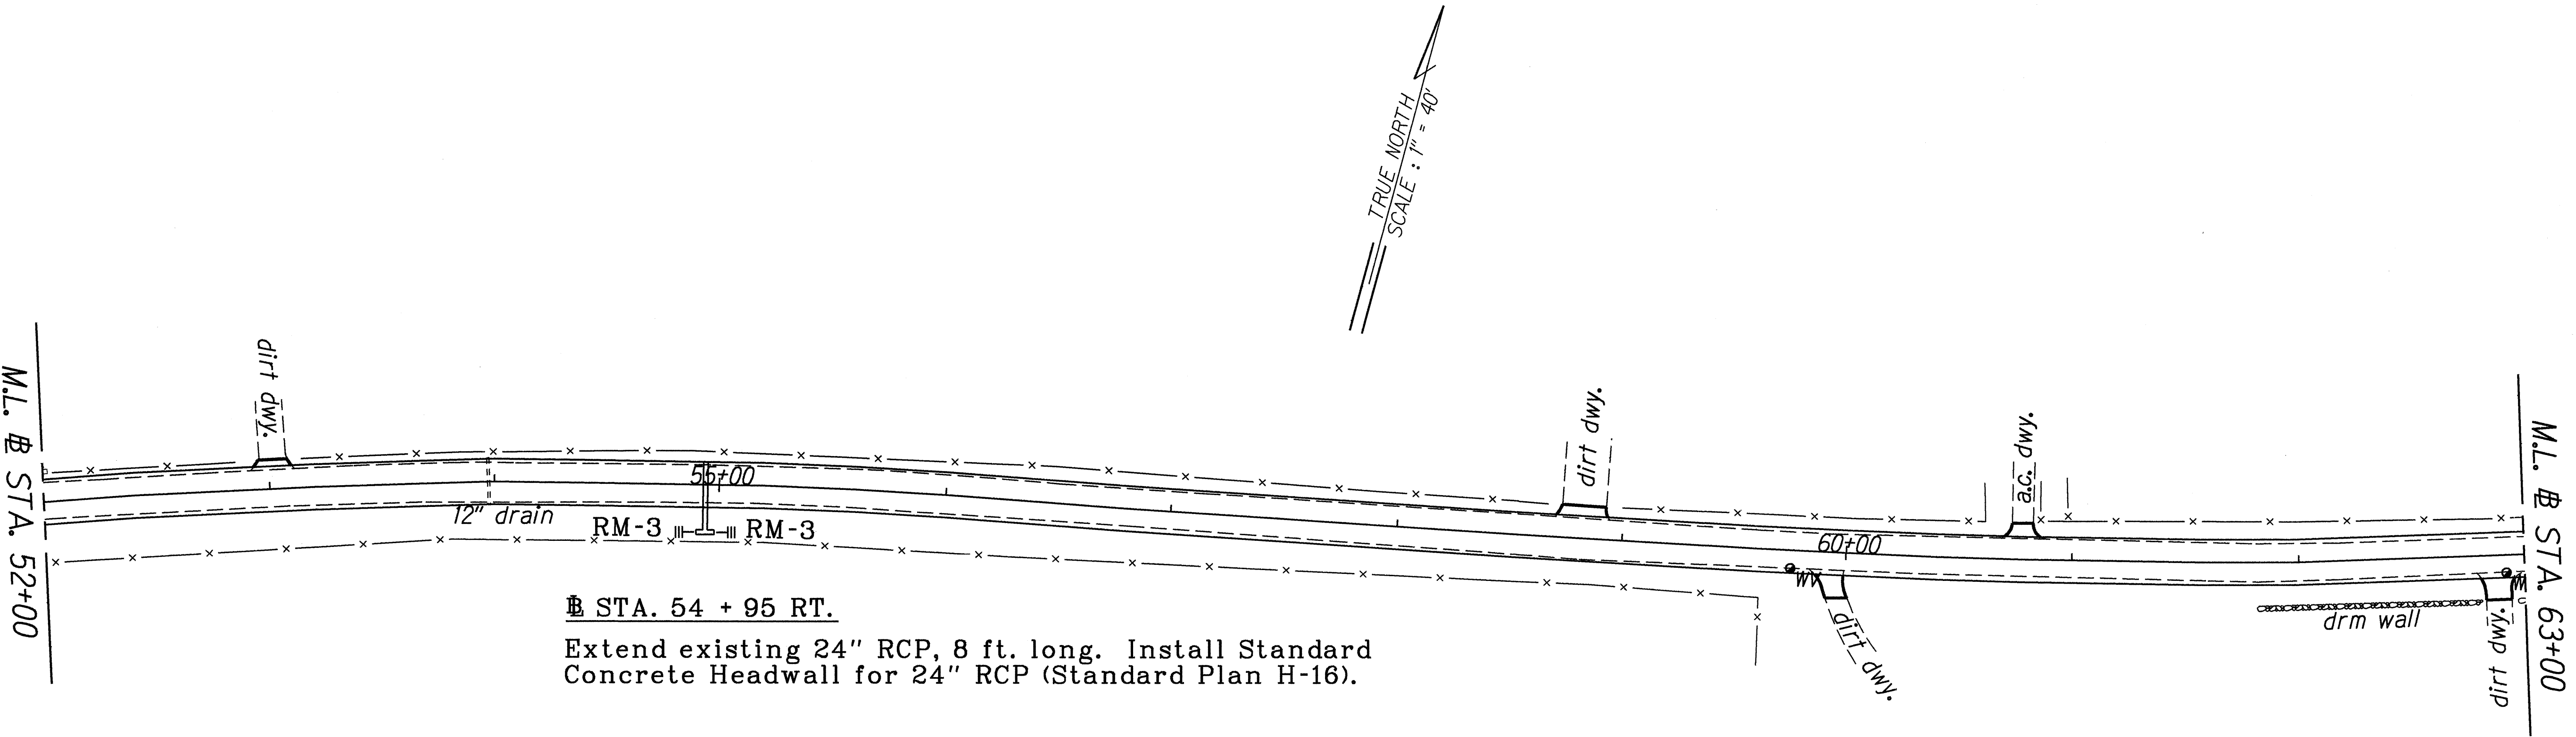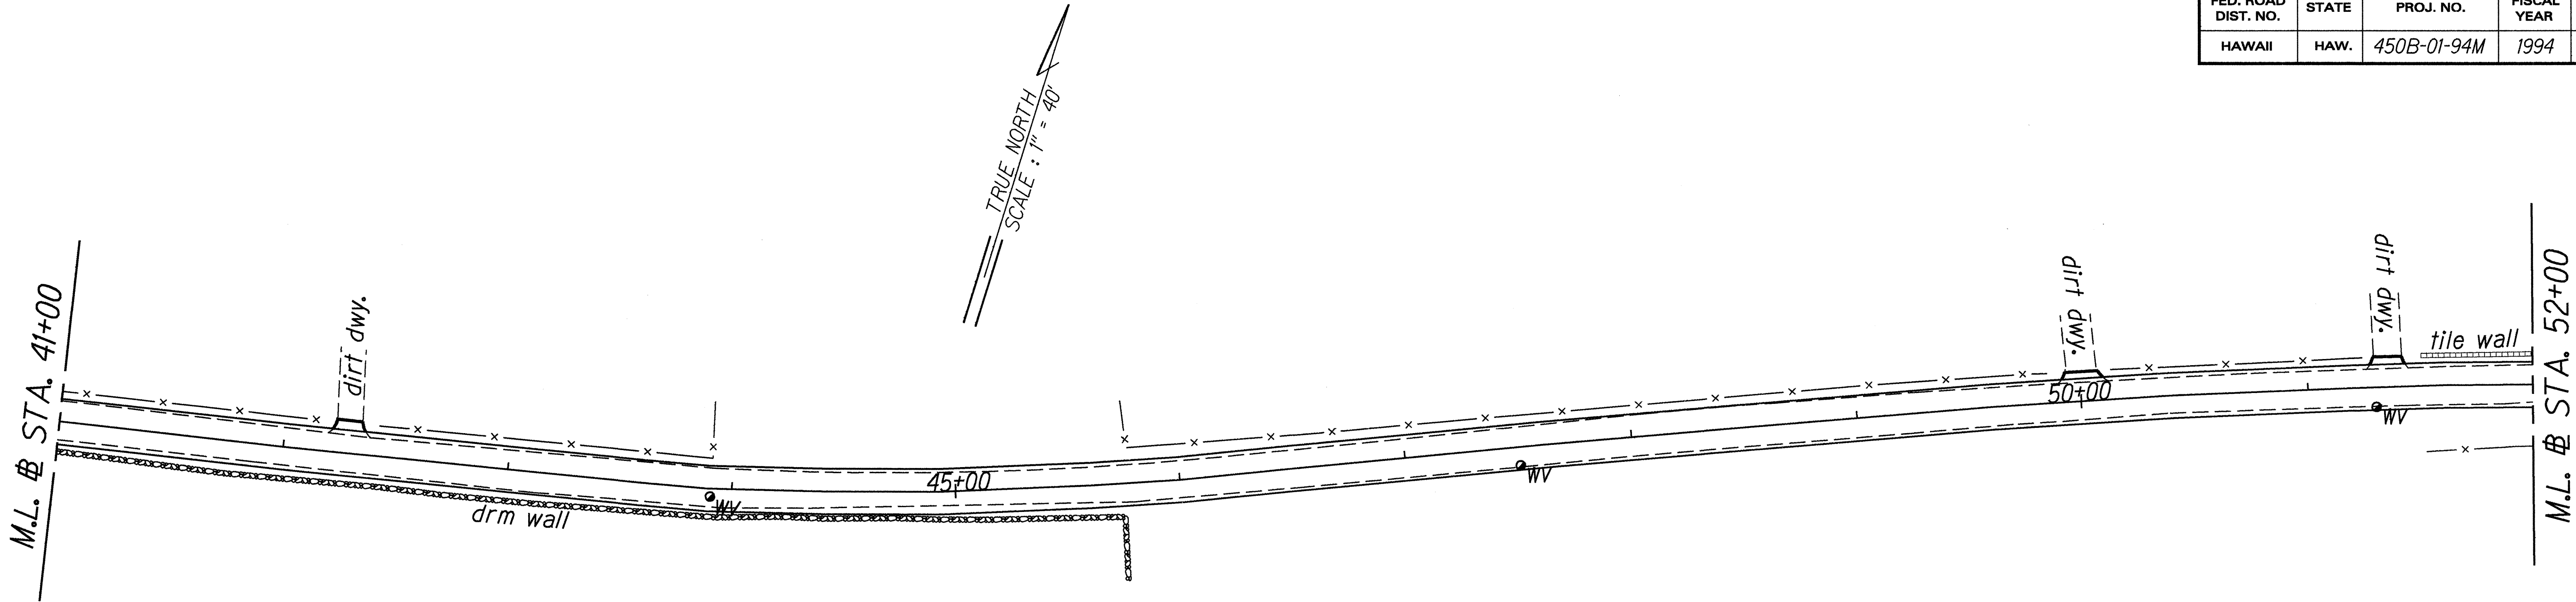

STA. 54 + 95 RT.
 Extend existing 24" RCP, 8 ft. long. Install Standard Concrete Headwall for 24" RCP (Standard Plan H-16).

ORIGINAL PLAN	DATE
NOTED BY	DATE
DESIGNED BY	DATE
CHECKED BY	DATE



LEGEND FOR AS-BUILT POSTINGS	
	Squiggly line for as-built deletion
	Double line for as-built deletion
Roadway	Text for as-built posting

STATE OF HAWAII
 DEPARTMENT OF TRANSPORTATION
 HIGHWAYS DIVISION

ROADWAY PLAN
 KAMEHAMEHA V HIGHWAY RESURFACING
 Kilohana School to Waialua
 Project No. 450B-01-94M
 Scale: 1" = 40' Date: May, 1994

SHEET No. 3 OF 12 SHEETS

FED. ROAD DIST. NO.	STATE	PROJ. NO.	FISCAL YEAR	SHEET NO.	TOTAL SHEETS
HAWAII	HAW.	450B-01-94M	1994	9	31

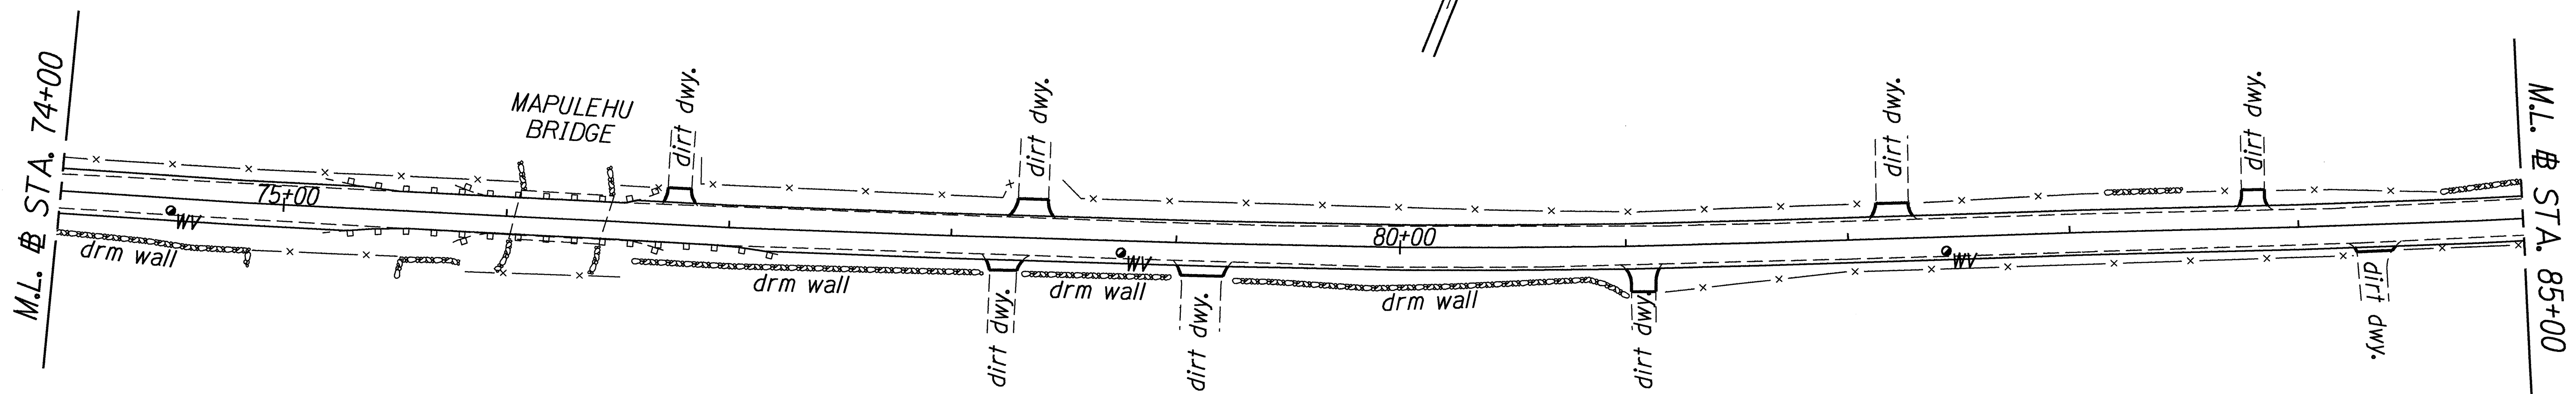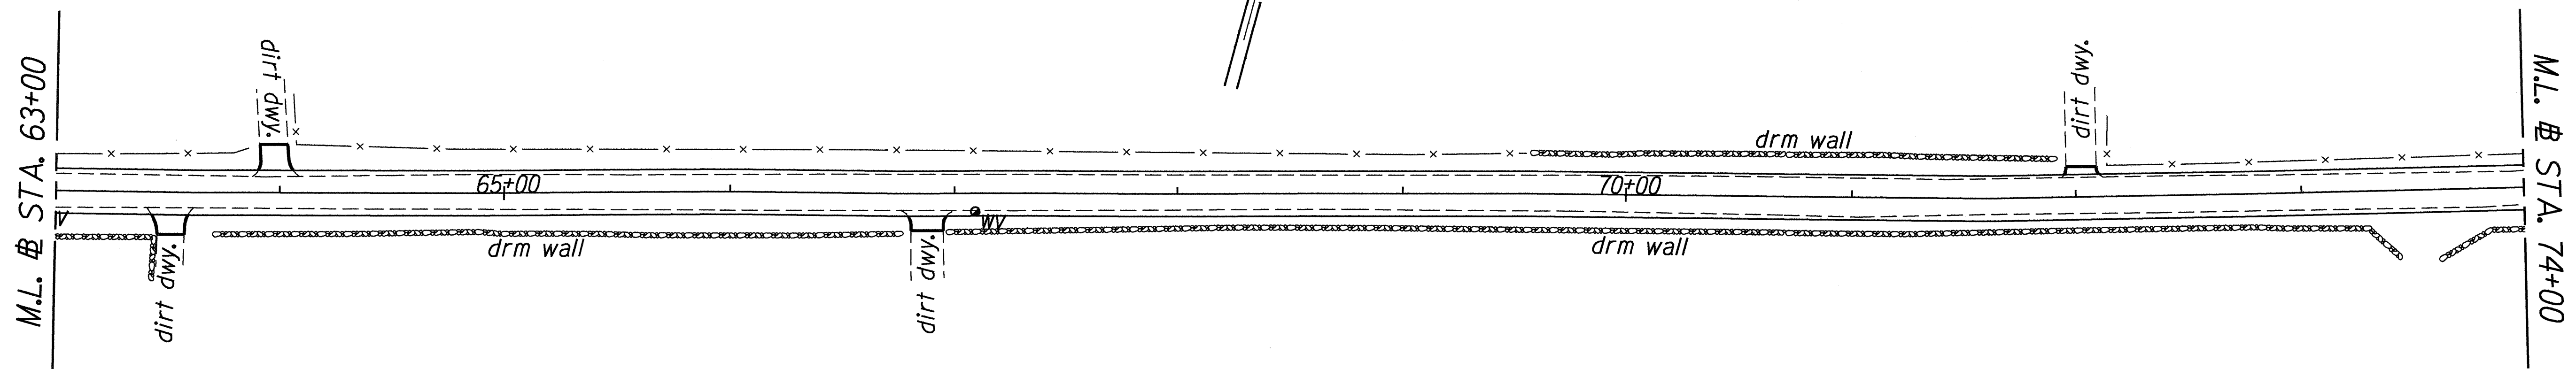

ORIGINAL PLAN	DATE
QUANTITY PLOTTED BY	Jan. 1994
DRAWN BY	J. L. Guzman
DESIGNED BY	C. Tagasa
QUANTITIES BY	
CHECKED BY	

STATE OF HAWAII
DEPARTMENT OF TRANSPORTATION
HIGHWAYS DIVISION


ROADWAY PLAN

KAMEHAMEHA V HIGHWAY RESURFACING
Kilohana School to Waialua
Project No. 450B-01-94M

Scale: 1" = 40' Date: May, 1994

SHEET No. 4 OF 12 SHEETS

FED. ROAD DIST. NO.	STATE	PROJ. NO.	FISCAL YEAR	SHEET NO.	TOTAL SHEETS
HAWAII	HAW.	450B-01-94M	1994	10	31

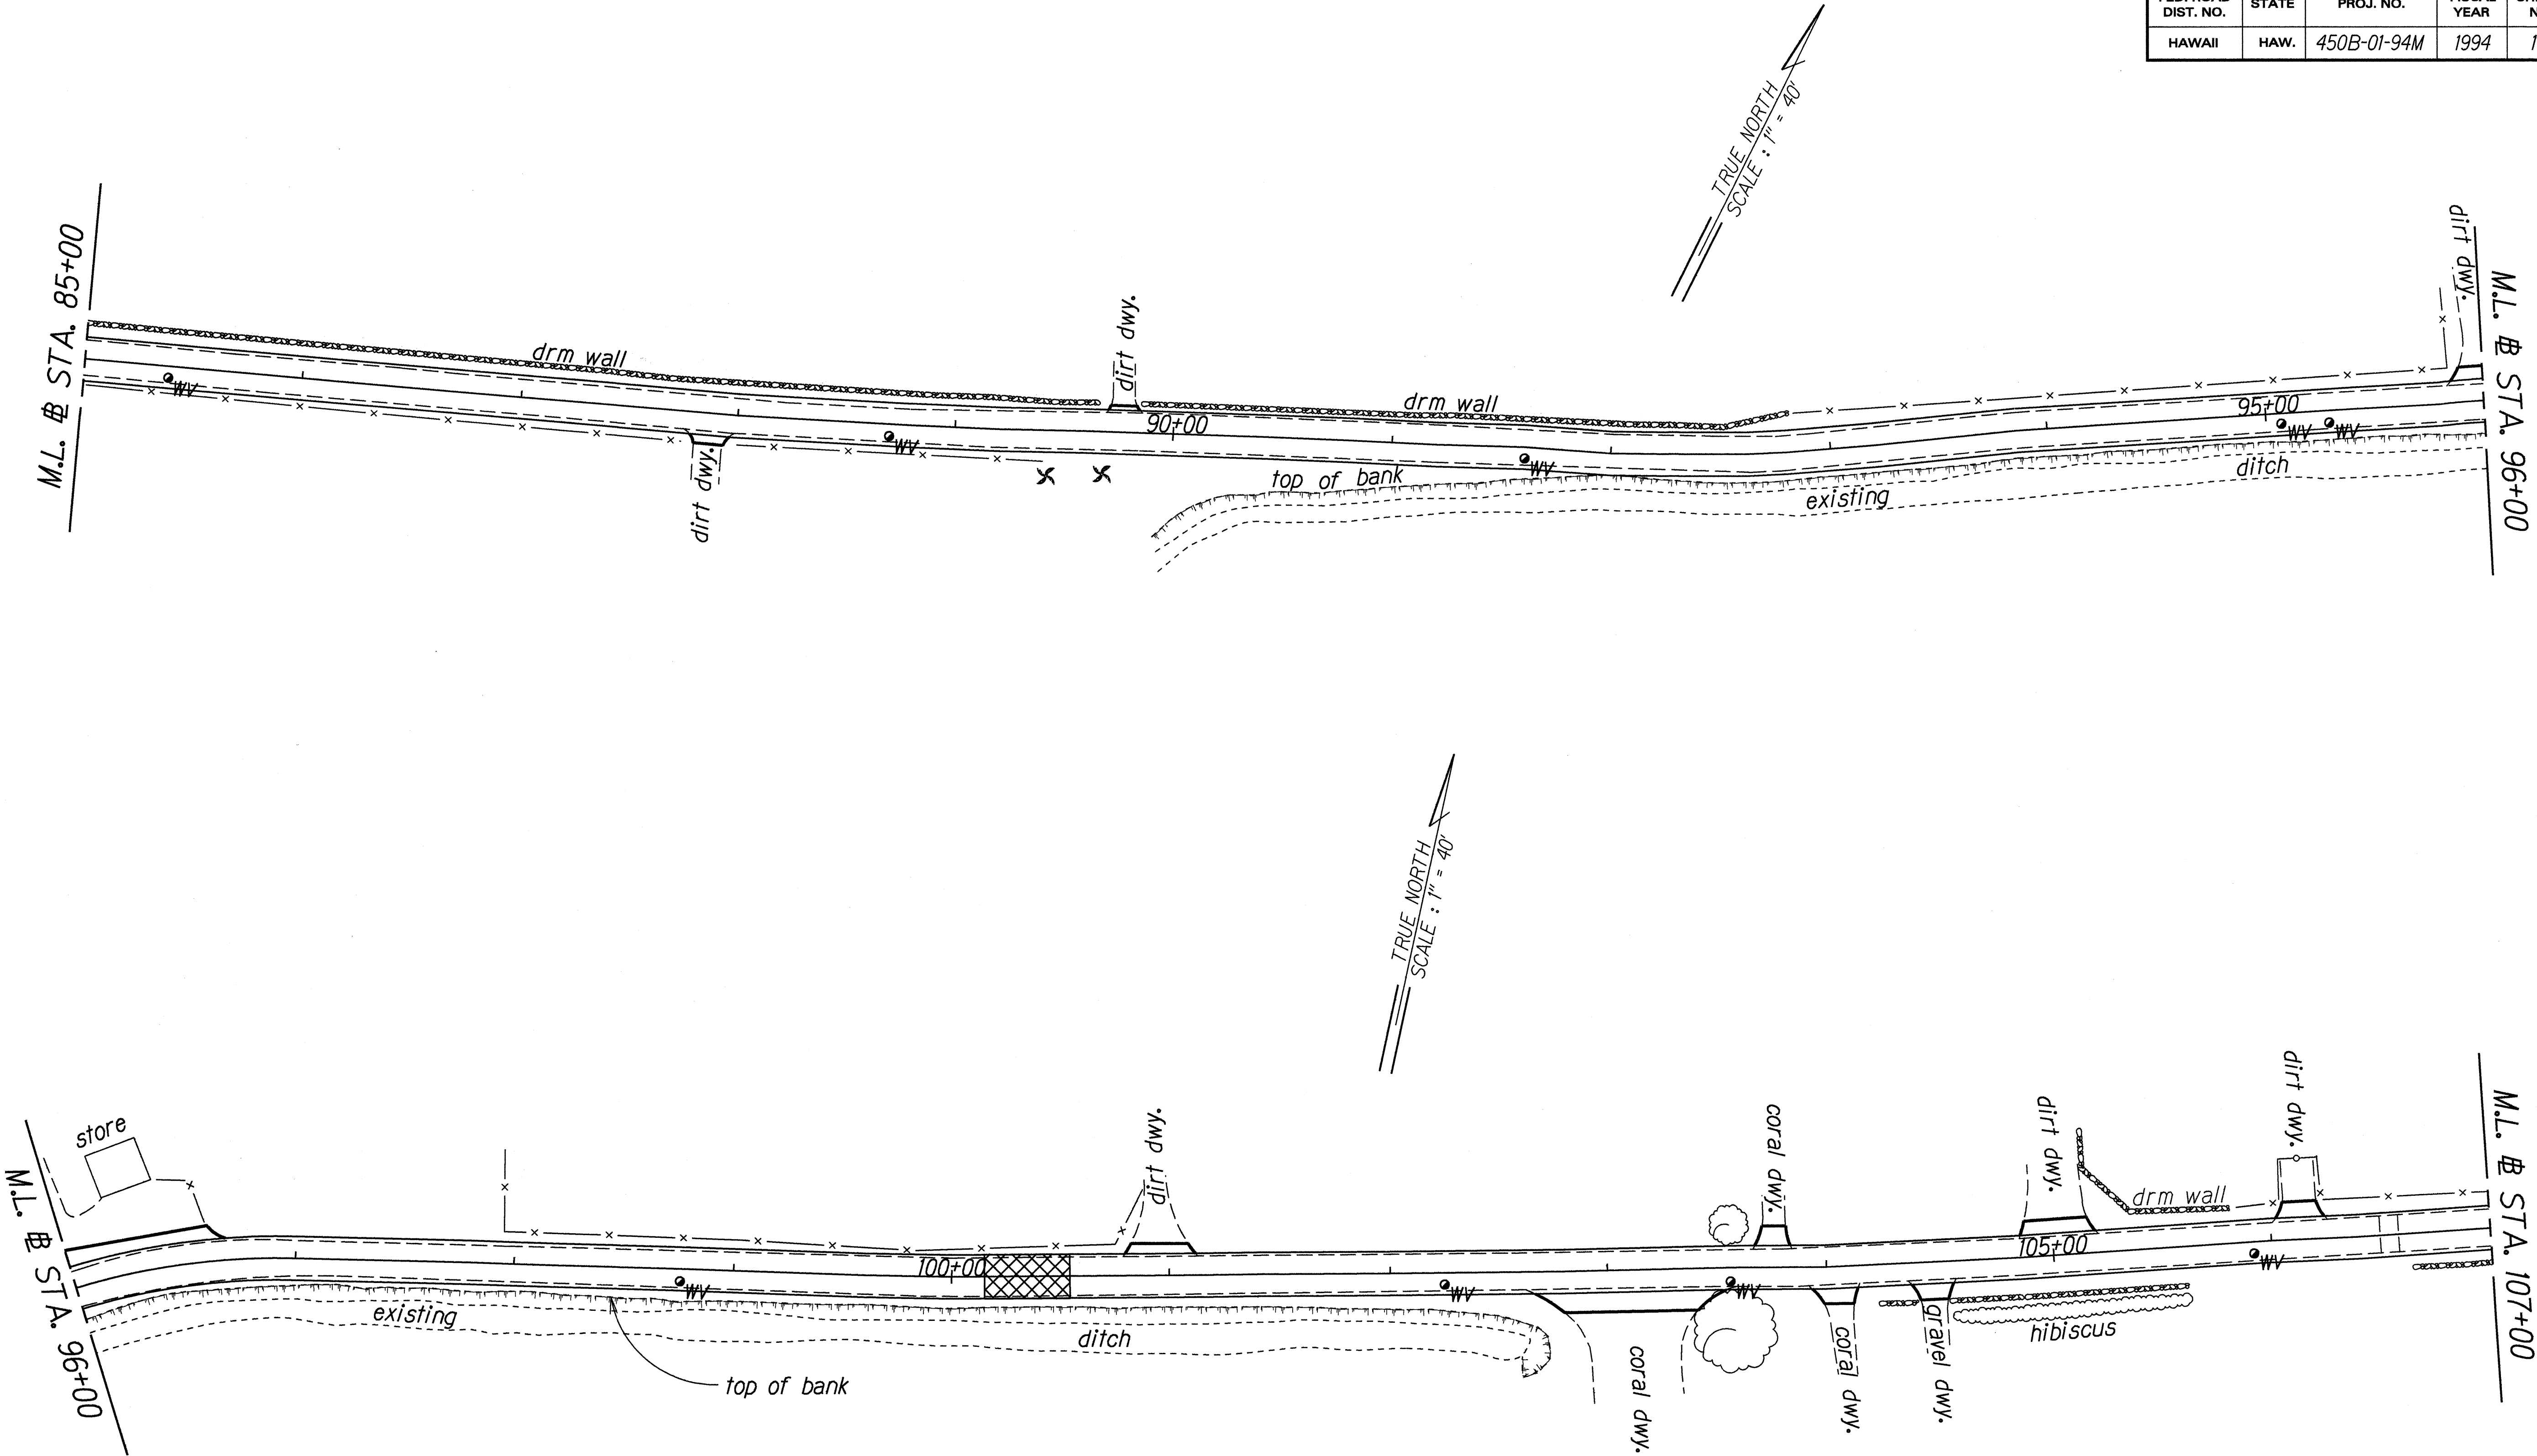

ORIGINAL PLAN	DATE
NOTED BY	10/10/94
DESIGNED BY	
CHECKED BY	

LEGEND FOR AS-BUILT POSTINGS	
	Squiggly line for as-built deletion
	Double line for as-built deletion
Roadway	Text for as-built posting

STATE OF HAWAII
DEPARTMENT OF TRANSPORTATION
HIGHWAYS DIVISION

ROADWAY PLAN



KAMEHAMEHA V HIGHWAY RESURFACING

Kilohana School to Waialua

Project No. 450B-01-94M

Scale: 1" = 40' Date: May, 1994



FED. ROAD DIST. NO.	STATE	PROJ. NO.	FISCAL YEAR	SHEET NO.	TOTAL SHEETS
HAWAII	HAW.	450B-01-94M	1994	11	31

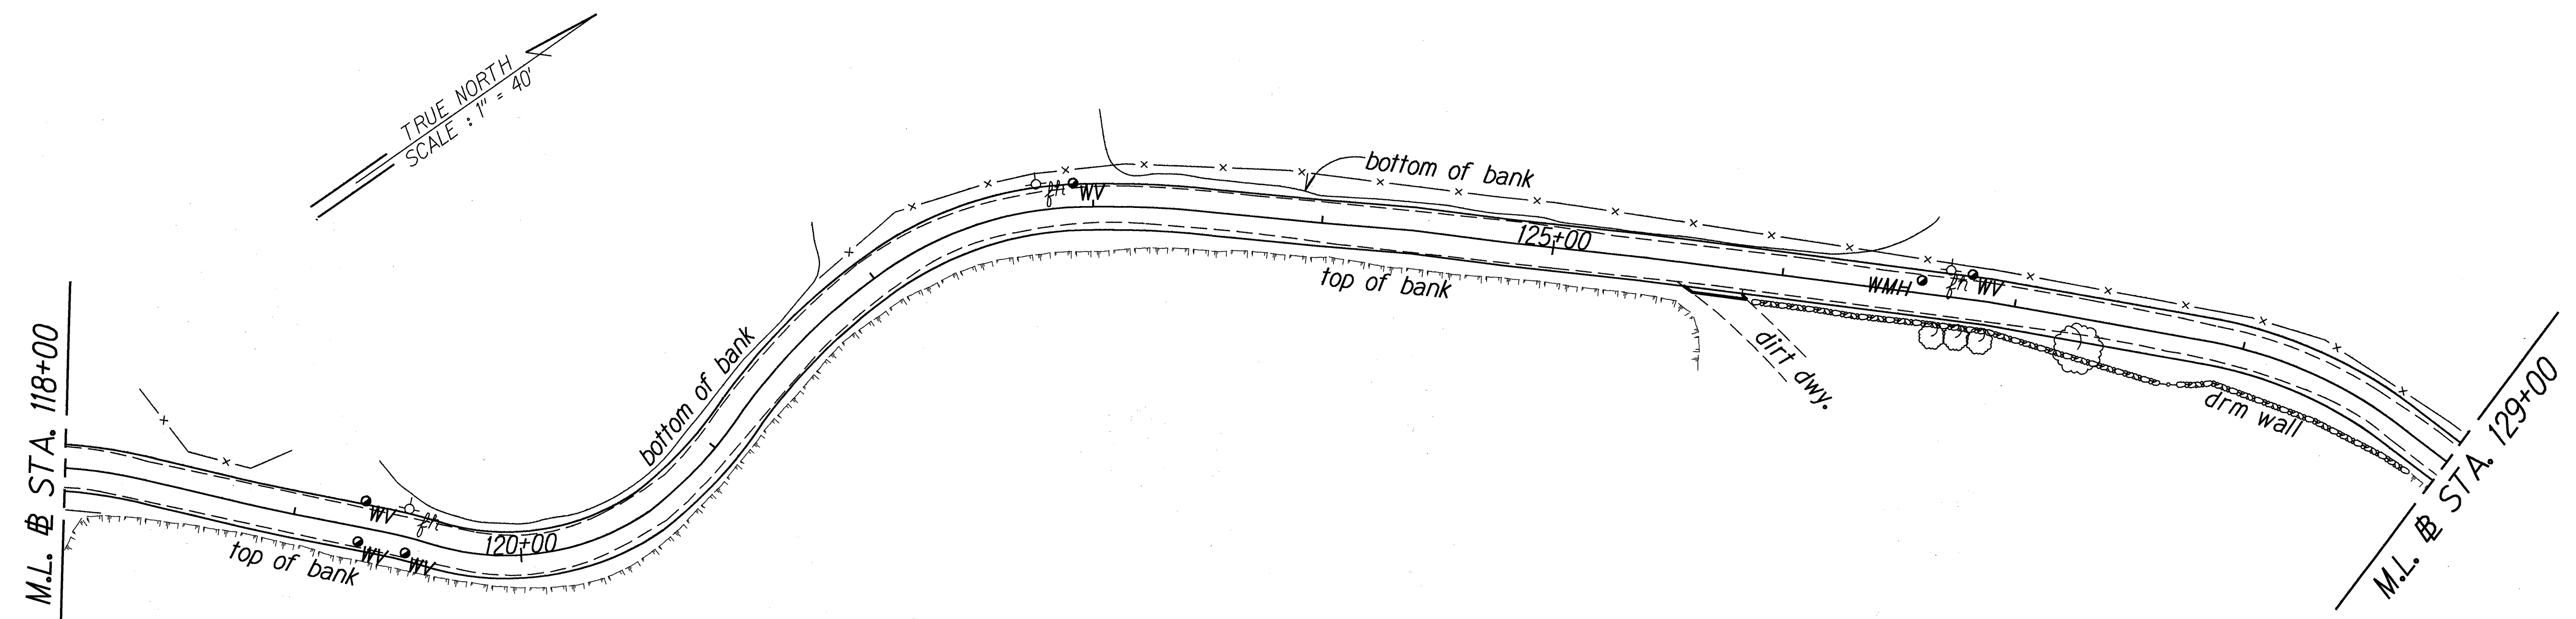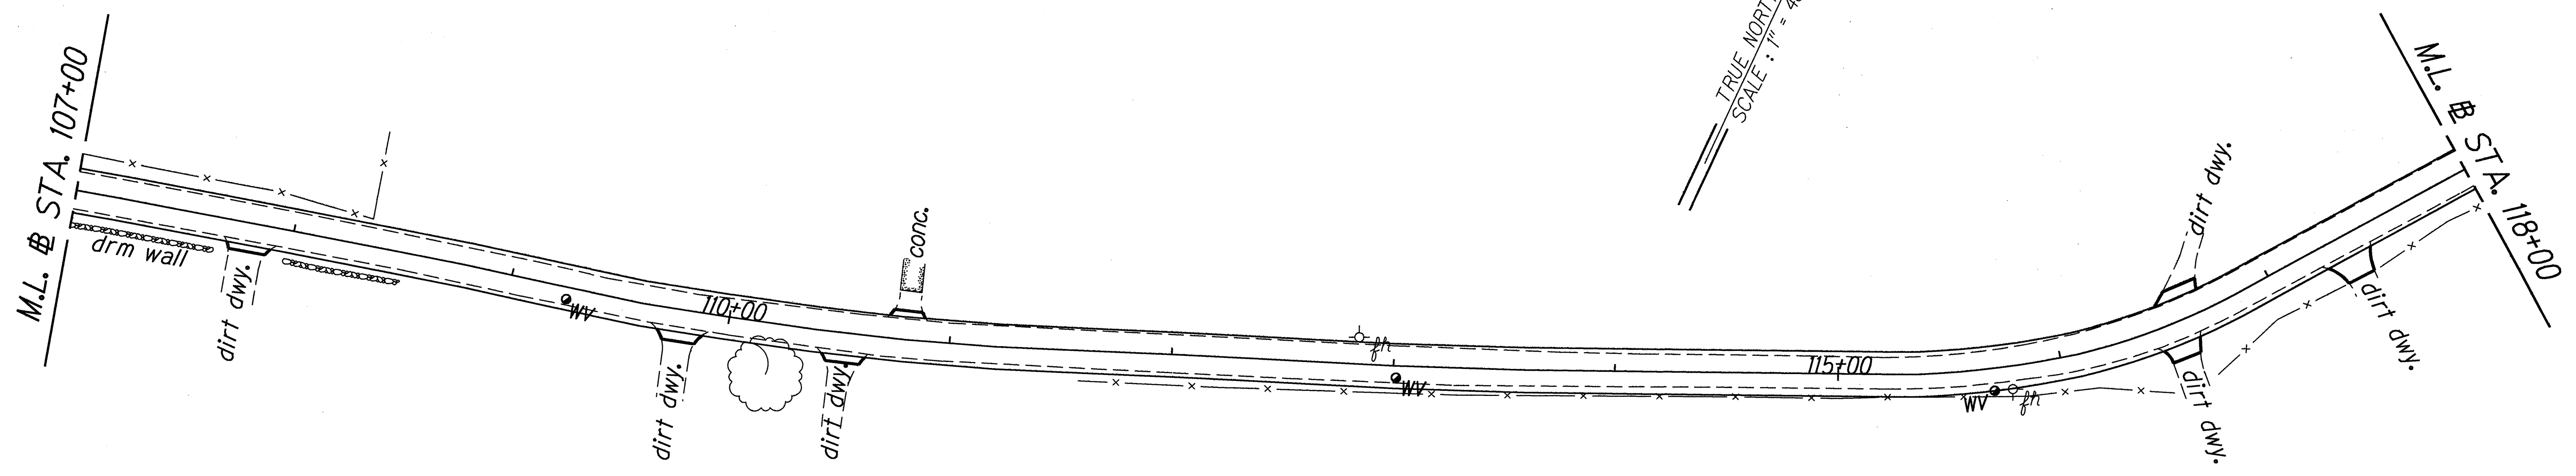

ORIGINAL PLAN	DATE
QUANTITY PLotted BY	JAN. 1994
DRAWN BY	J. G. G. G.
TRACED BY	
DESIGNED BY	C. Fagasa
QUANTITIES BY	
CHECKED BY	

STATE OF HAWAII
DEPARTMENT OF TRANSPORTATION
HIGHWAYS DIVISION
ROADWAY PLAN
KAMEHAMEHA V HIGHWAY RESURFACING
Kilohana School to Waialua
Project No. 450B-01-94M
Scale: 1" = 40' Date: May, 1994
SHEET No. 6 OF 12 SHEETS

FED. ROAD DIST. NO.	STATE	PROJ. NO.	FISCAL YEAR	SHEET NO.	TOTAL SHEETS
HAWAII	HAW.	450B-01-94M	1994	12	31

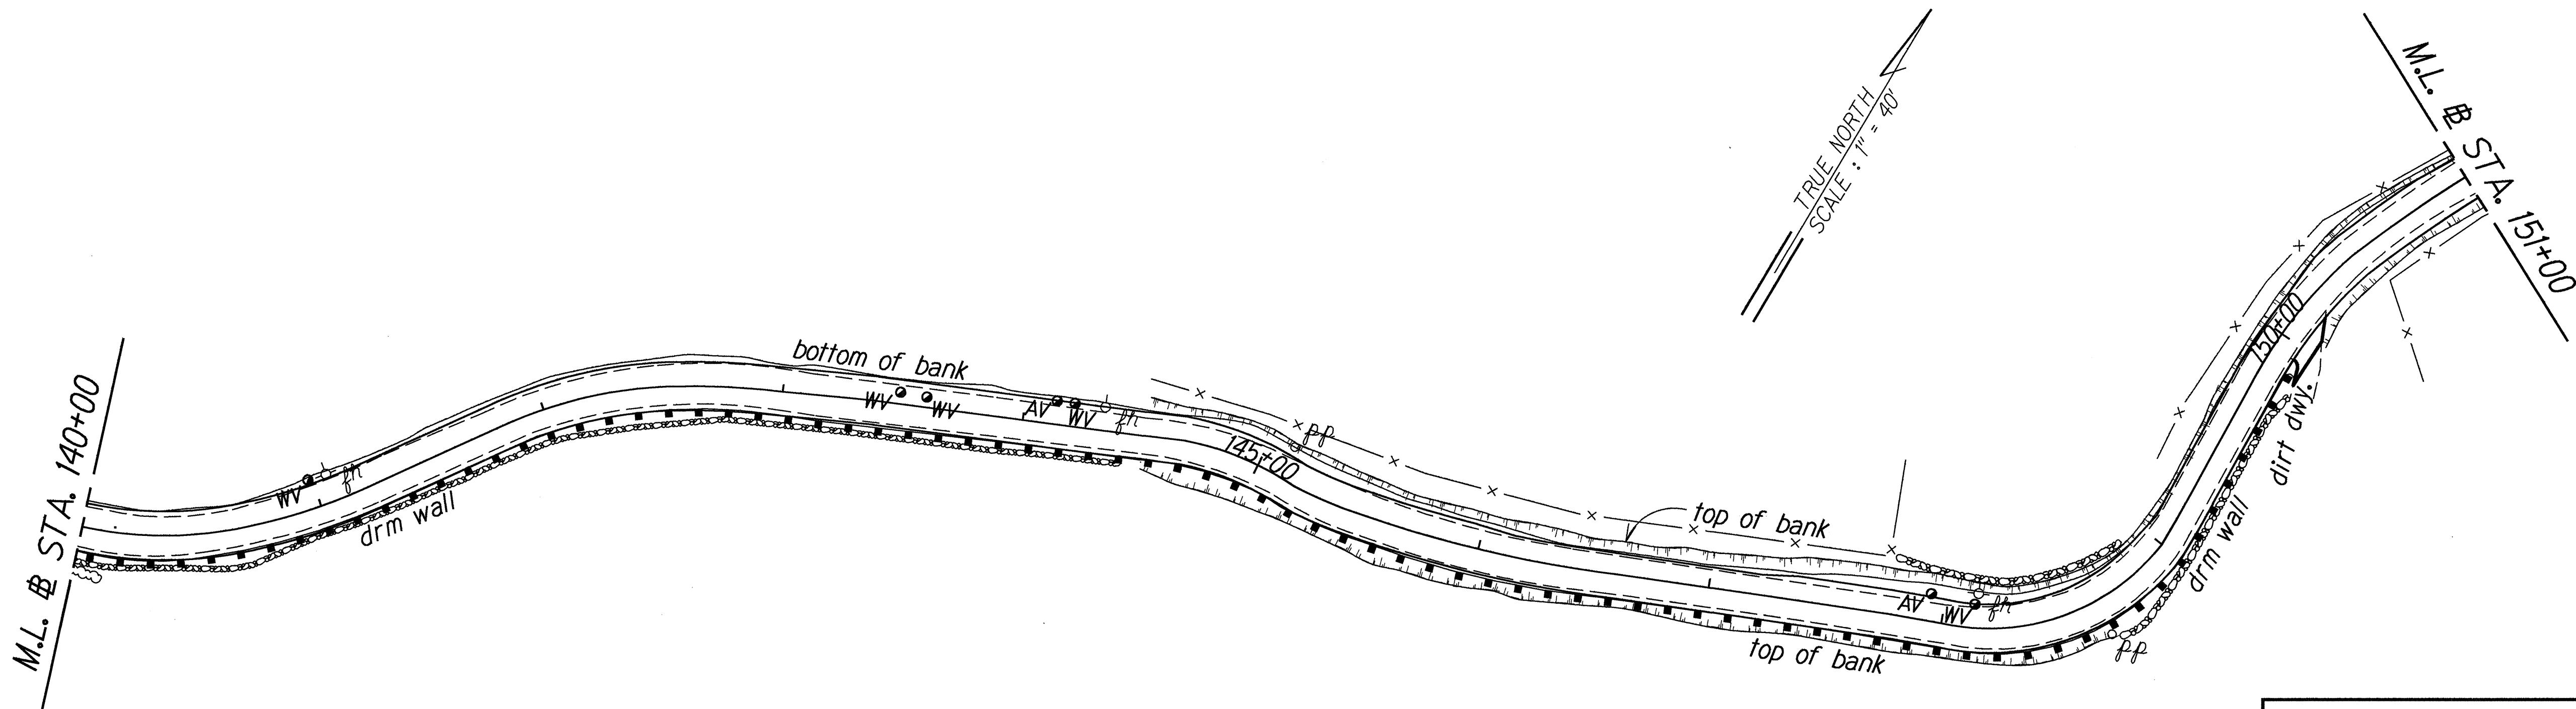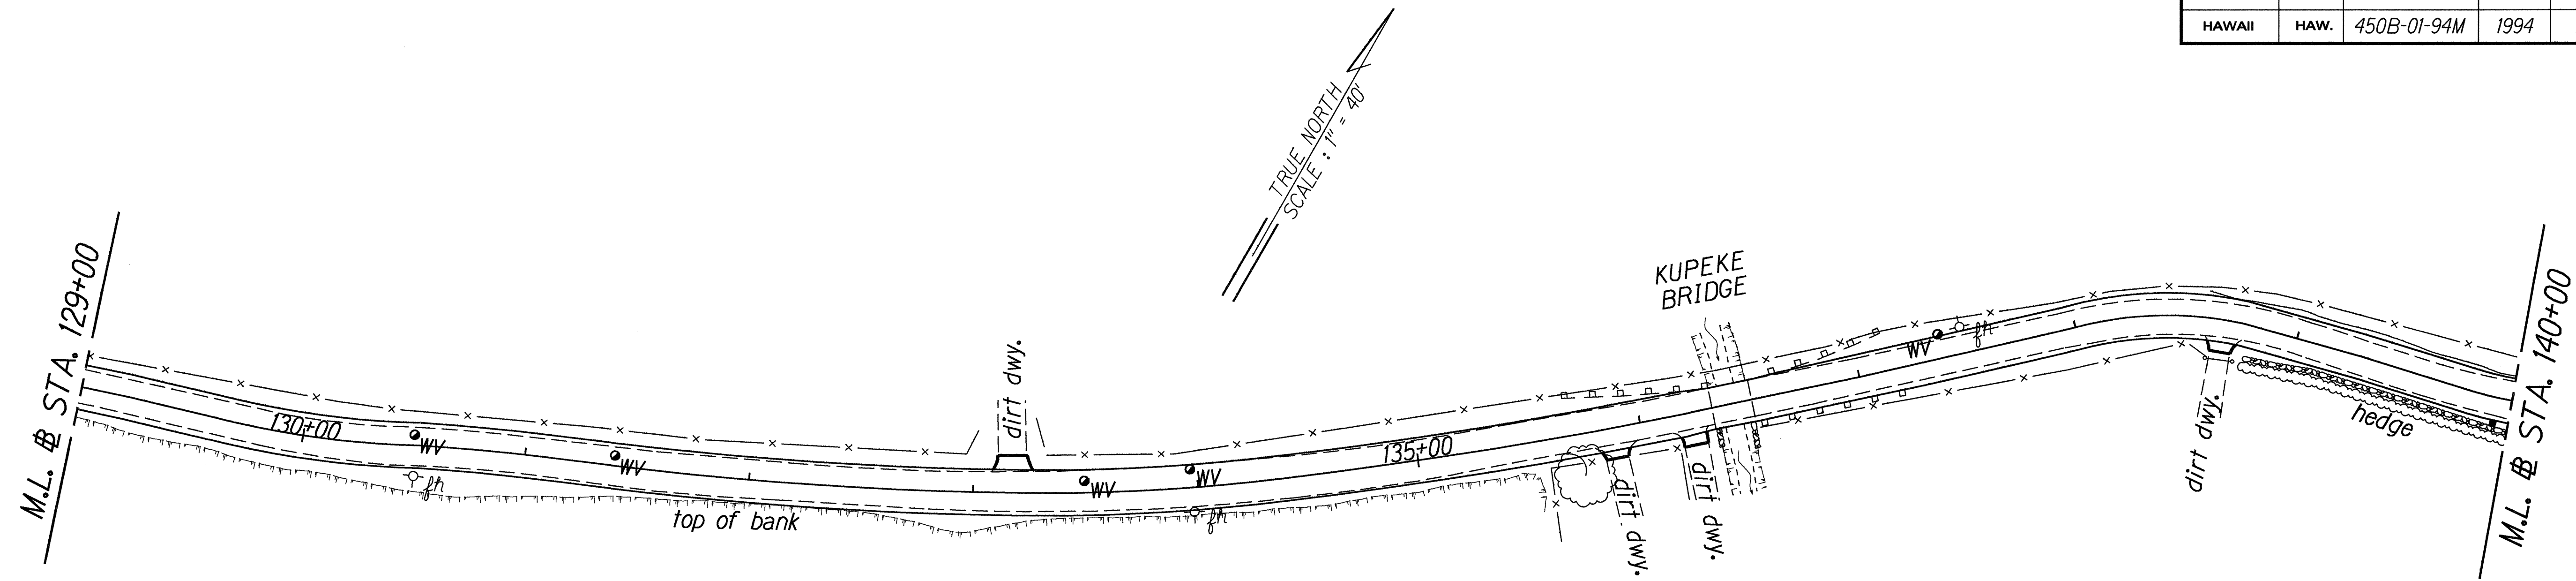

STA. 140+00± RT. - STA. 150+00± RT.
 Install Guardrail, Type 3, Single with 8' steel post
 Approach End - Type "G" with 15:l flare
 Trailing End - Type "G" with 10:l flare

ORIGINAL PLAN	SURVEY PLOTTED BY	DATE
NOTE BOOK	DRAWN BY	
2/15/94	DESIGNED BY	
	CHECKED BY	


STATE OF HAWAII
DEPARTMENT OF TRANSPORTATION
HIGHWAYS DIVISION

ROADWAY PLAN

KAMEHAMEHA V HIGHWAY RESURFACING
Kilohana School to Waialua
Project No. 450B-01-94M

Scale: 1" = 40' Date: May, 1994

FED. ROAD DIST. NO.	STATE	PROJ. NO.	FISCAL YEAR	SHEET NO.	TOTAL SHEETS
HAWAII	HAW.	450B-01-94M	1994	13	31

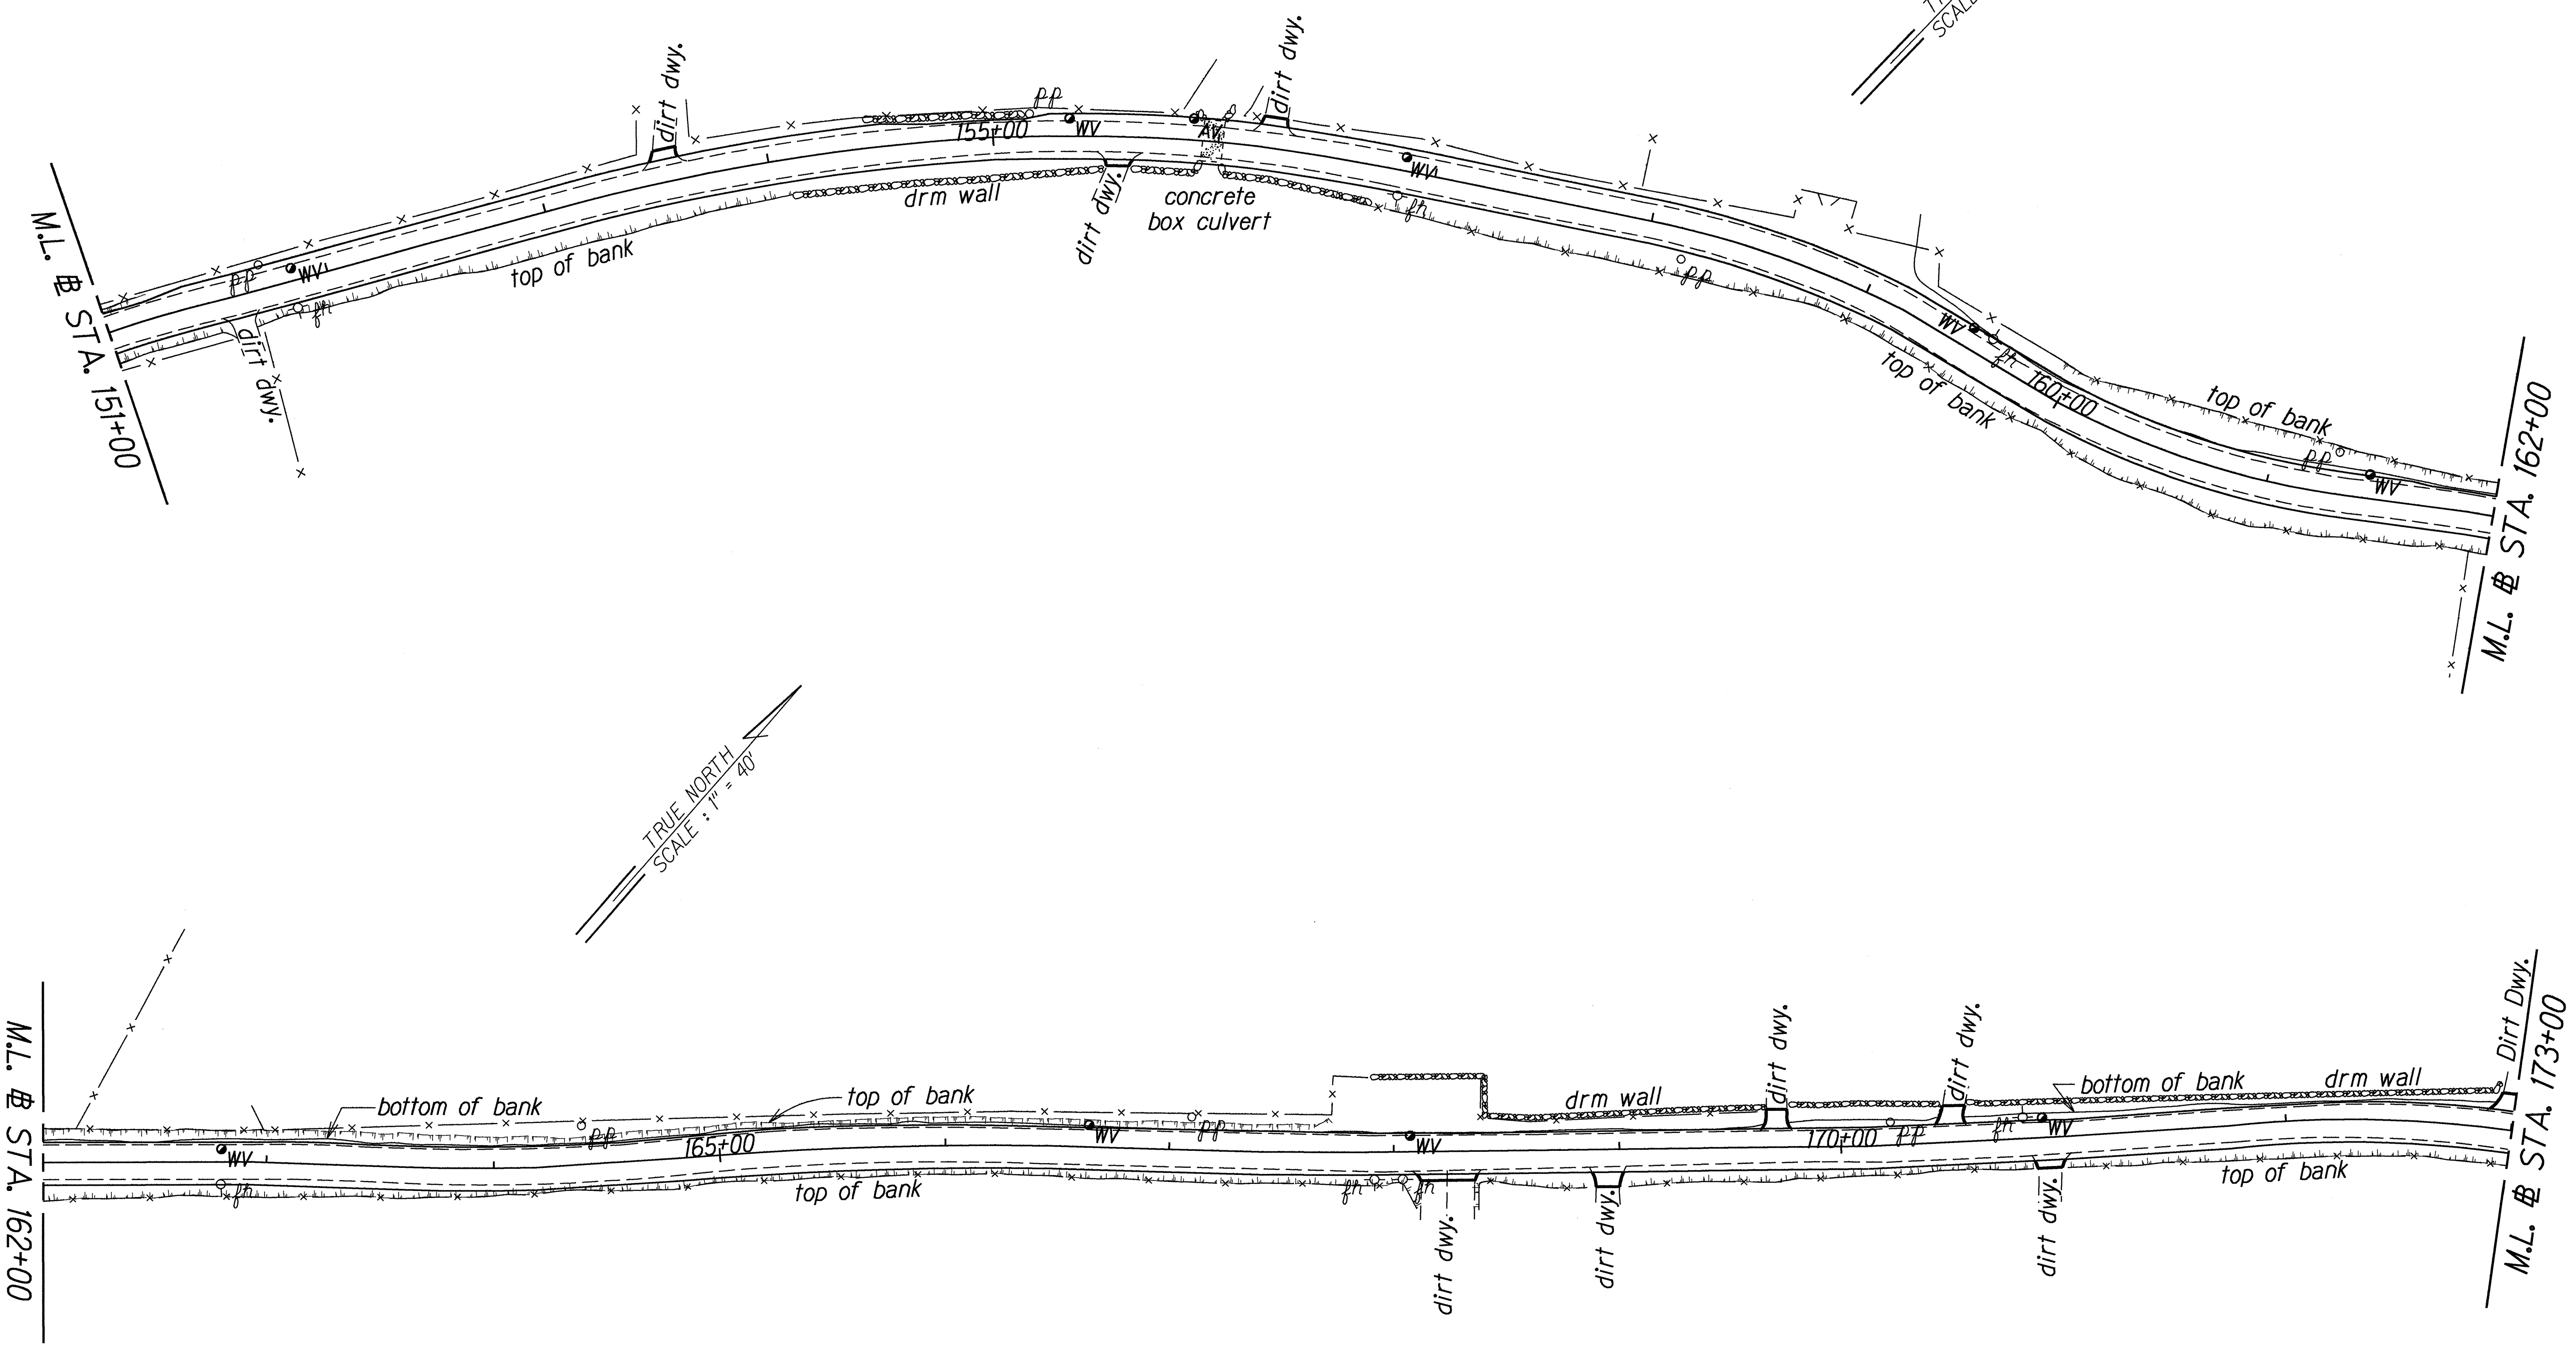

ORIGINAL PLAN	DATE
NOTE BOOK	
DESIGNED BY C. Tagasa	
CHECKED BY	


STATE OF HAWAII
DEPARTMENT OF TRANSPORTATION
HIGHWAYS DIVISION

ROADWAY PLAN

KAMEHAMEHA V HIGHWAY RESURFACING
Kilohana School to Waialua
Project No. 450B-01-94M

Scale: 1" = 40' Date: May, 1994

FED. ROAD DIST. NO.	STATE	PROJ. NO.	FISCAL YEAR	SHEET NO.	TOTAL SHEETS
HAWAII	HAW.	450B-01-94M	1994	14	31

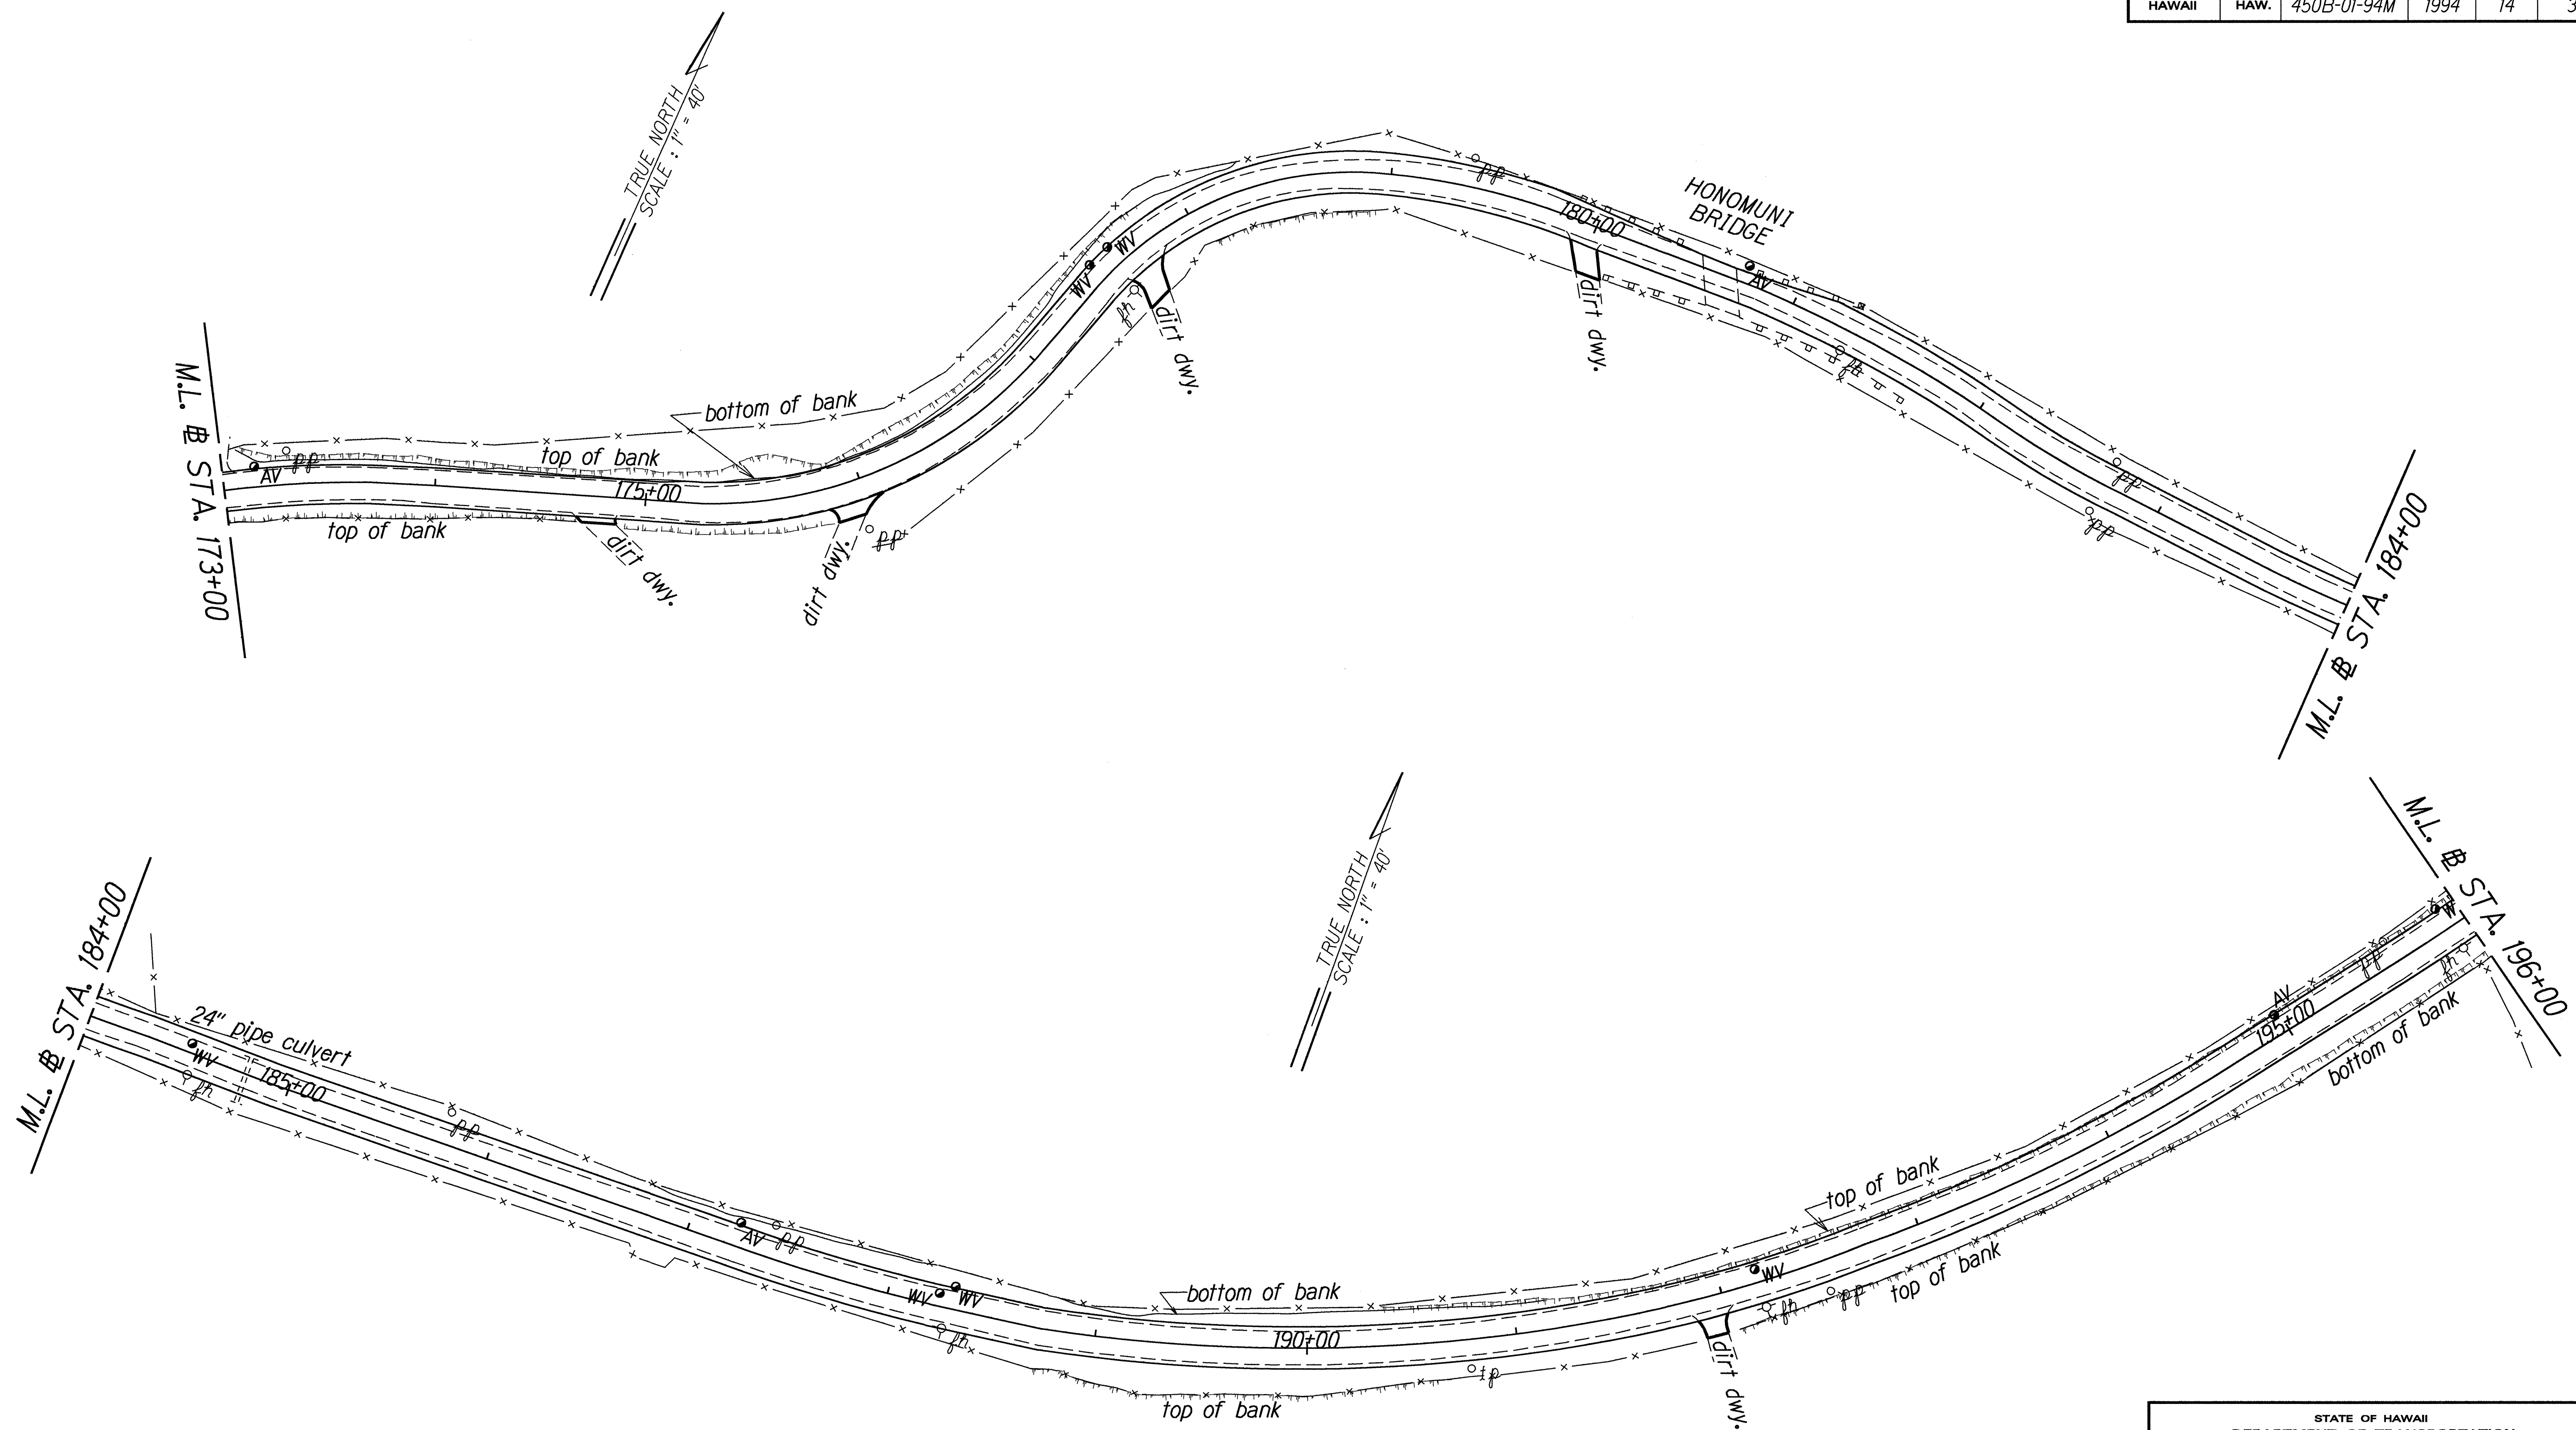

ORIGINAL PLAN	DATE
DESIGNED BY	
CHECKED BY	
NOTED BY	
2/15/94	

STATE OF HAWAII
DEPARTMENT OF TRANSPORTATION
HIGHWAYS DIVISION

ROADWAY PLAN



KAMEHAMEHA V HIGHWAY RESURFACING

Kilohana School to Waialua

Project No. 450B-01-94M

Scale: 1" = 40' Date: May, 1994

FED. ROAD DIST. NO.	STATE	PROJ. NO.	FISCAL YEAR	SHEET NO.	TOTAL SHEETS
HAWAII	HAW.	450B-01-94M	1994	15	31

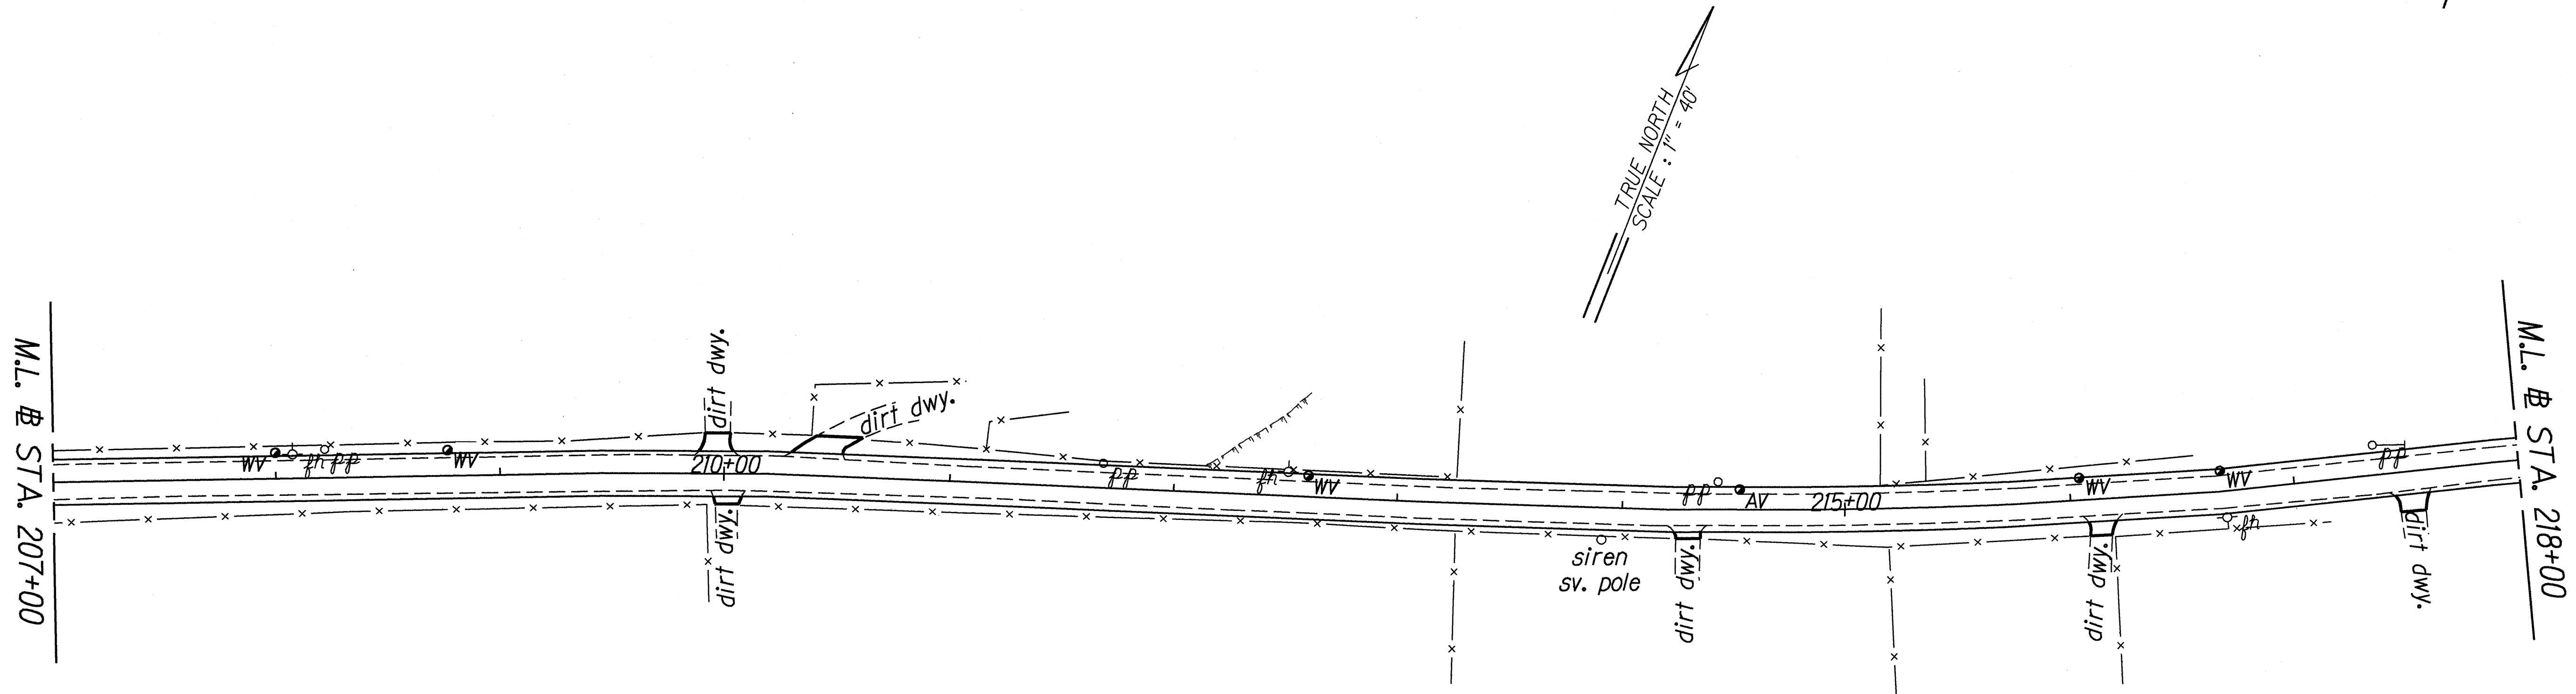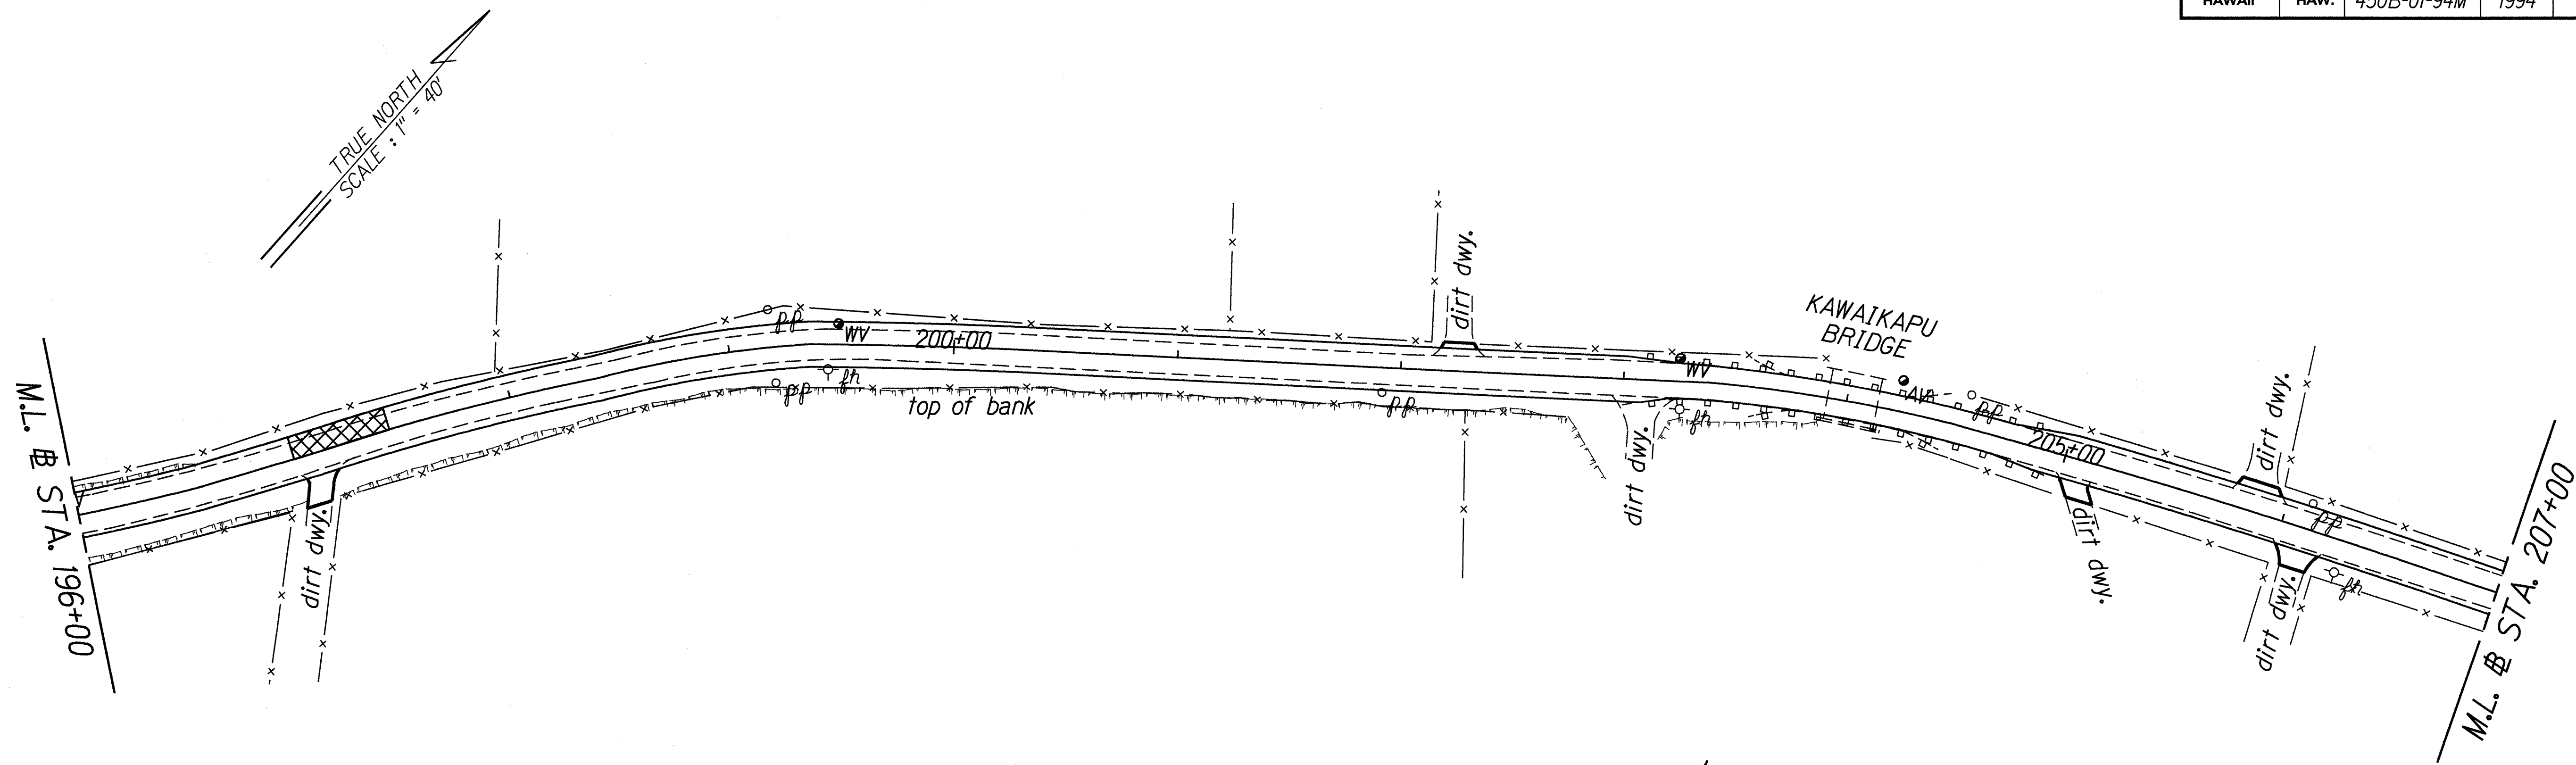


ORIGINAL PLAN	DATE
DESIGNED BY	Jan. 1994
DRAWN BY	
CHECKED BY	
NOTES	
QUANTITIES	
BY	

LEGEND FOR AS-BUILT POSTINGS	
	Squiggly line for as-built deletion
	Double line for as-built deletion
Roadway	Text for as-built posting


STATE OF HAWAII
DEPARTMENT OF TRANSPORTATION
HIGHWAYS DIVISION

ROADWAY PLAN
KAMEHAMEHA V HIGHWAY RESURFACING
Kilohana School to Waialua
Project No. 450B-01-94M
Scale: 1" = 40'
Date: May, 1994

FED. ROAD DIST. NO.	STATE	PROJ. NO.	FISCAL YEAR	SHEET NO.	TOTAL SHEETS
HAWAII	HAW.	450B-01-94M	1994	16	31

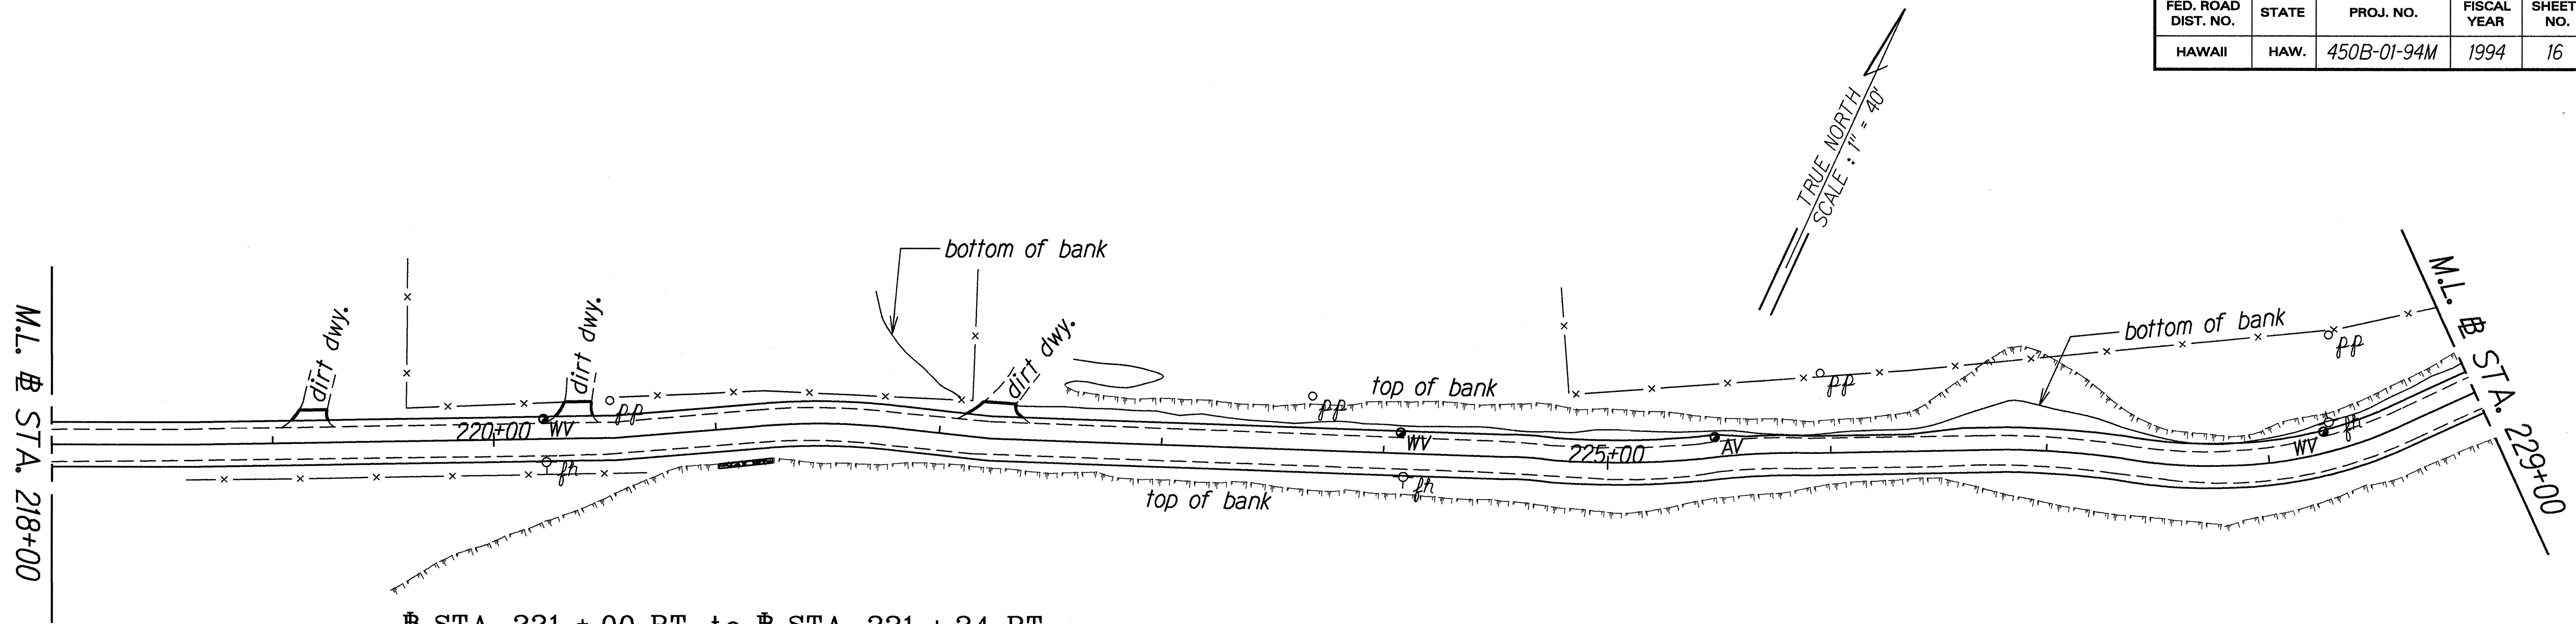

STA. 221 + 00 RT. to STA. 221 + 24 RT.
 Repair existing rockwall with concrete rubble masonry (CRM) wall: 24 ft. long, 2+ ft. wide, 7 ft. high.

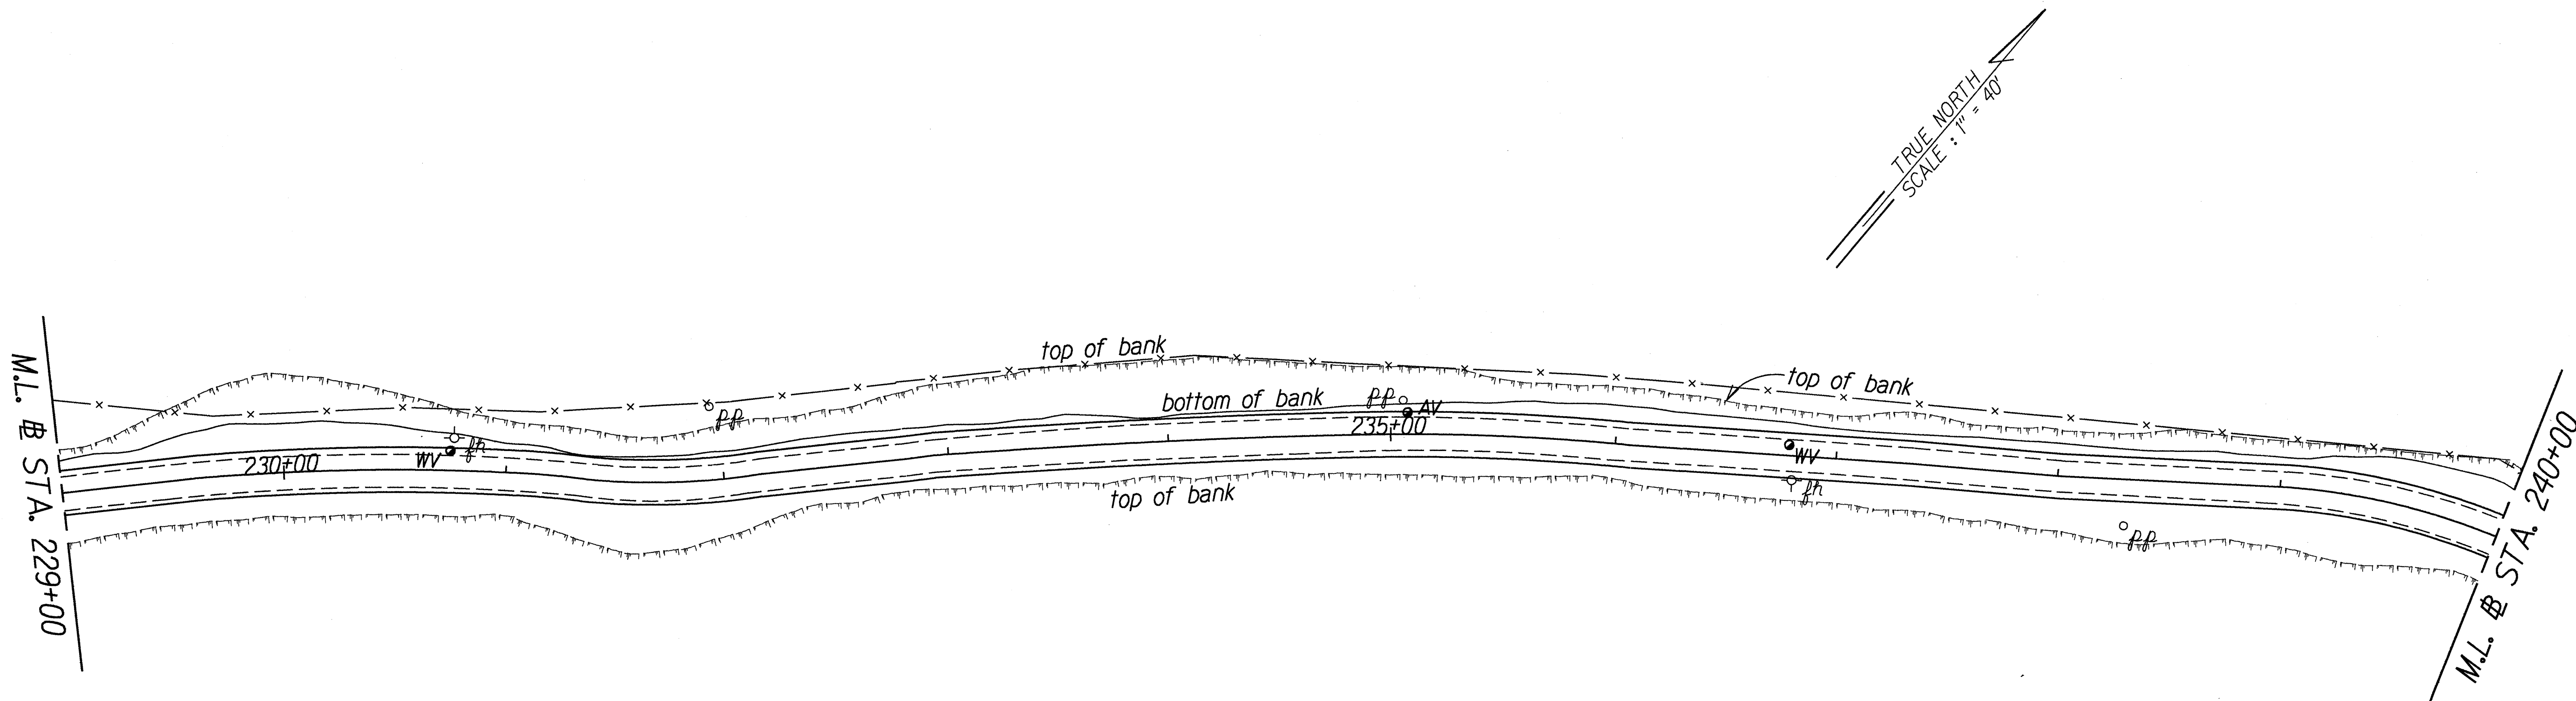

ORIGINAL PLAN	DATE
NOTED BY	Jan. 1994
DESIGNED BY	
CHECKED BY	

LEGEND FOR AS-BUILT POSTINGS

	Squiggly line for as-built deletion
	Double line for as-built deletion
Roadway	Text for as-built posting

STATE OF HAWAII
 DEPARTMENT OF TRANSPORTATION
 HIGHWAYS DIVISION


ROADWAY PLAN

KAMEHAMEHA V HIGHWAY RESURFACING
 Kilohana School to Waialua
 Project No. 450B-01-94M

Scale: 1" = 40' Date: May, 1994

SHEET No. 11 OF 12 SHEETS

FED. ROAD DIST. NO.	STATE	PROJ. NO.	FISCAL YEAR	SHEET NO.	TOTAL SHEETS
HAWAII	HAW.	450B-01-94M	1994	17	31

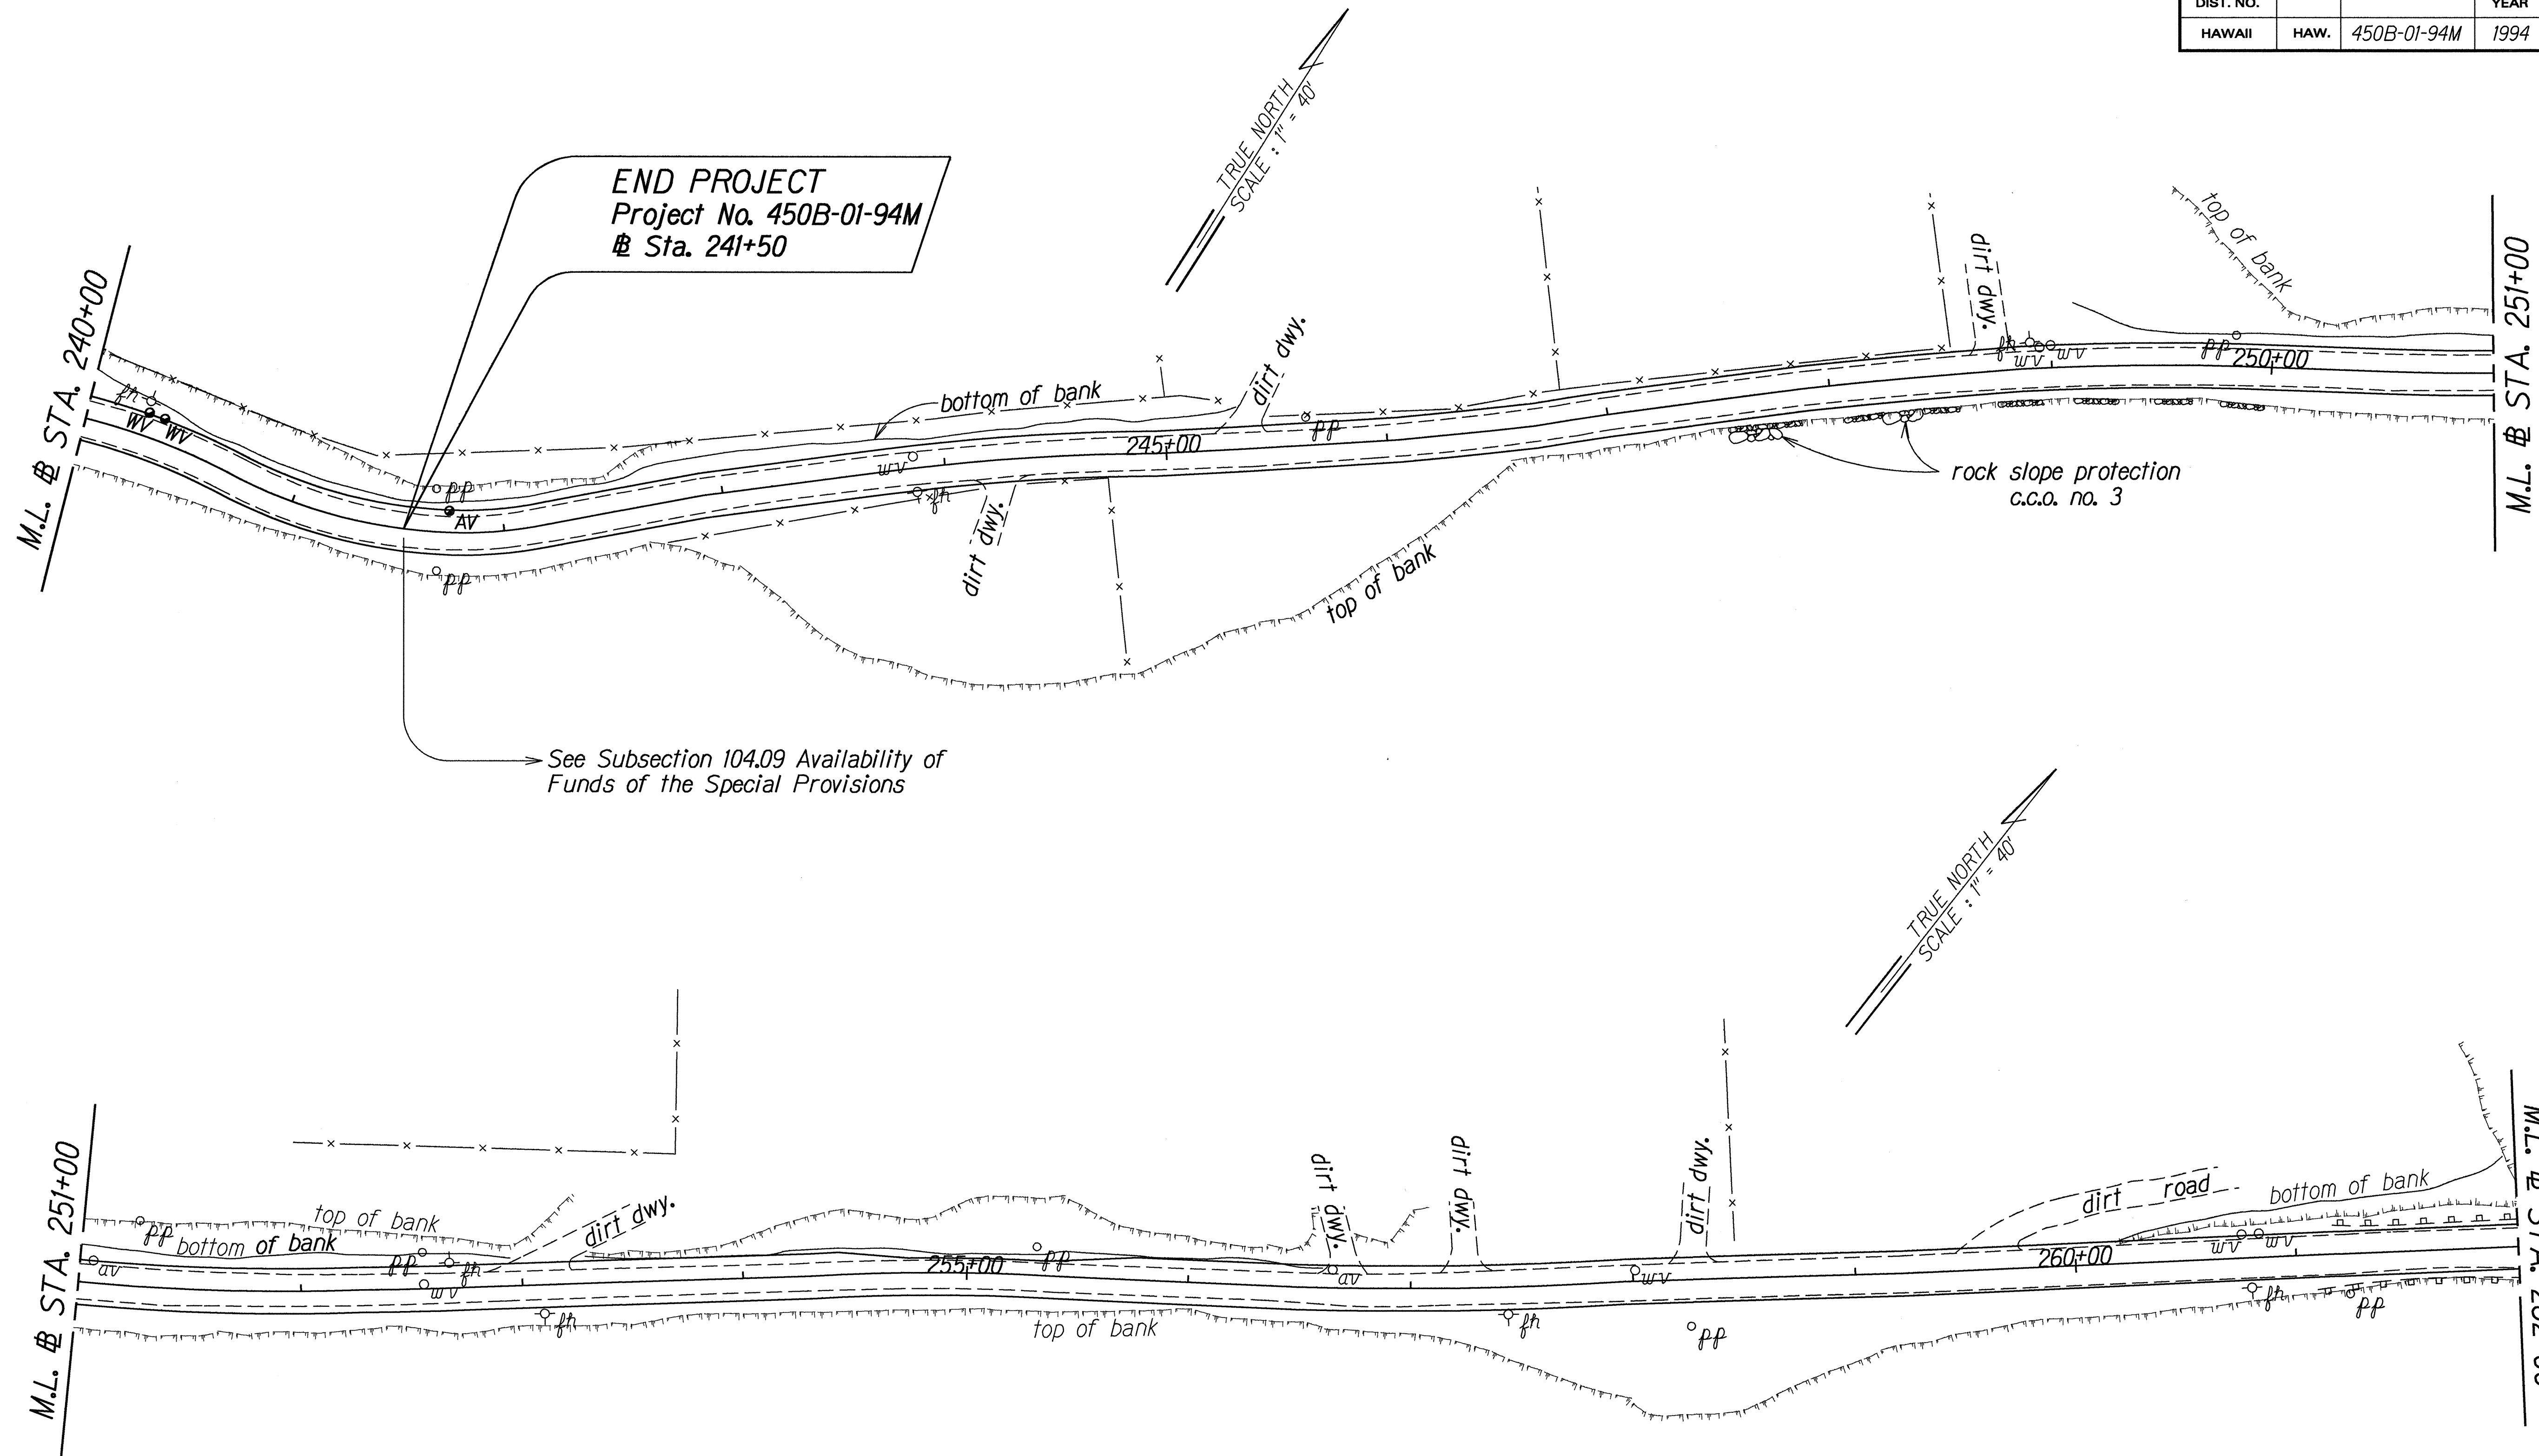

ORIGINAL PLAN	SURVEY PLOTTED BY	DATE
NOTE BOOK	DRAWN BY	Jan. 1994
240001/01/01	DESIGNED BY	
	QUANTITIES BY	
	CHECKED BY	

STATE OF HAWAII
DEPARTMENT OF TRANSPORTATION
HIGHWAYS DIVISION

ROADWAY PLAN

KAMEHAMEHA V HIGHWAY RESURFACING

Kilohana School to Waialua

Project No. 450B-01-94M

Scale: 1" = 40'
Date: May, 1994

SHEET No. 12 OF 12 SHEETS