


FED. ROAD DIST. NO.	STATE	FED. AID PROJ. NO.	FISCAL YEAR	SHEET NO.	TOTAL SHEETS
HAWAII	HAW.	STP-0450(6)	1995	24	39

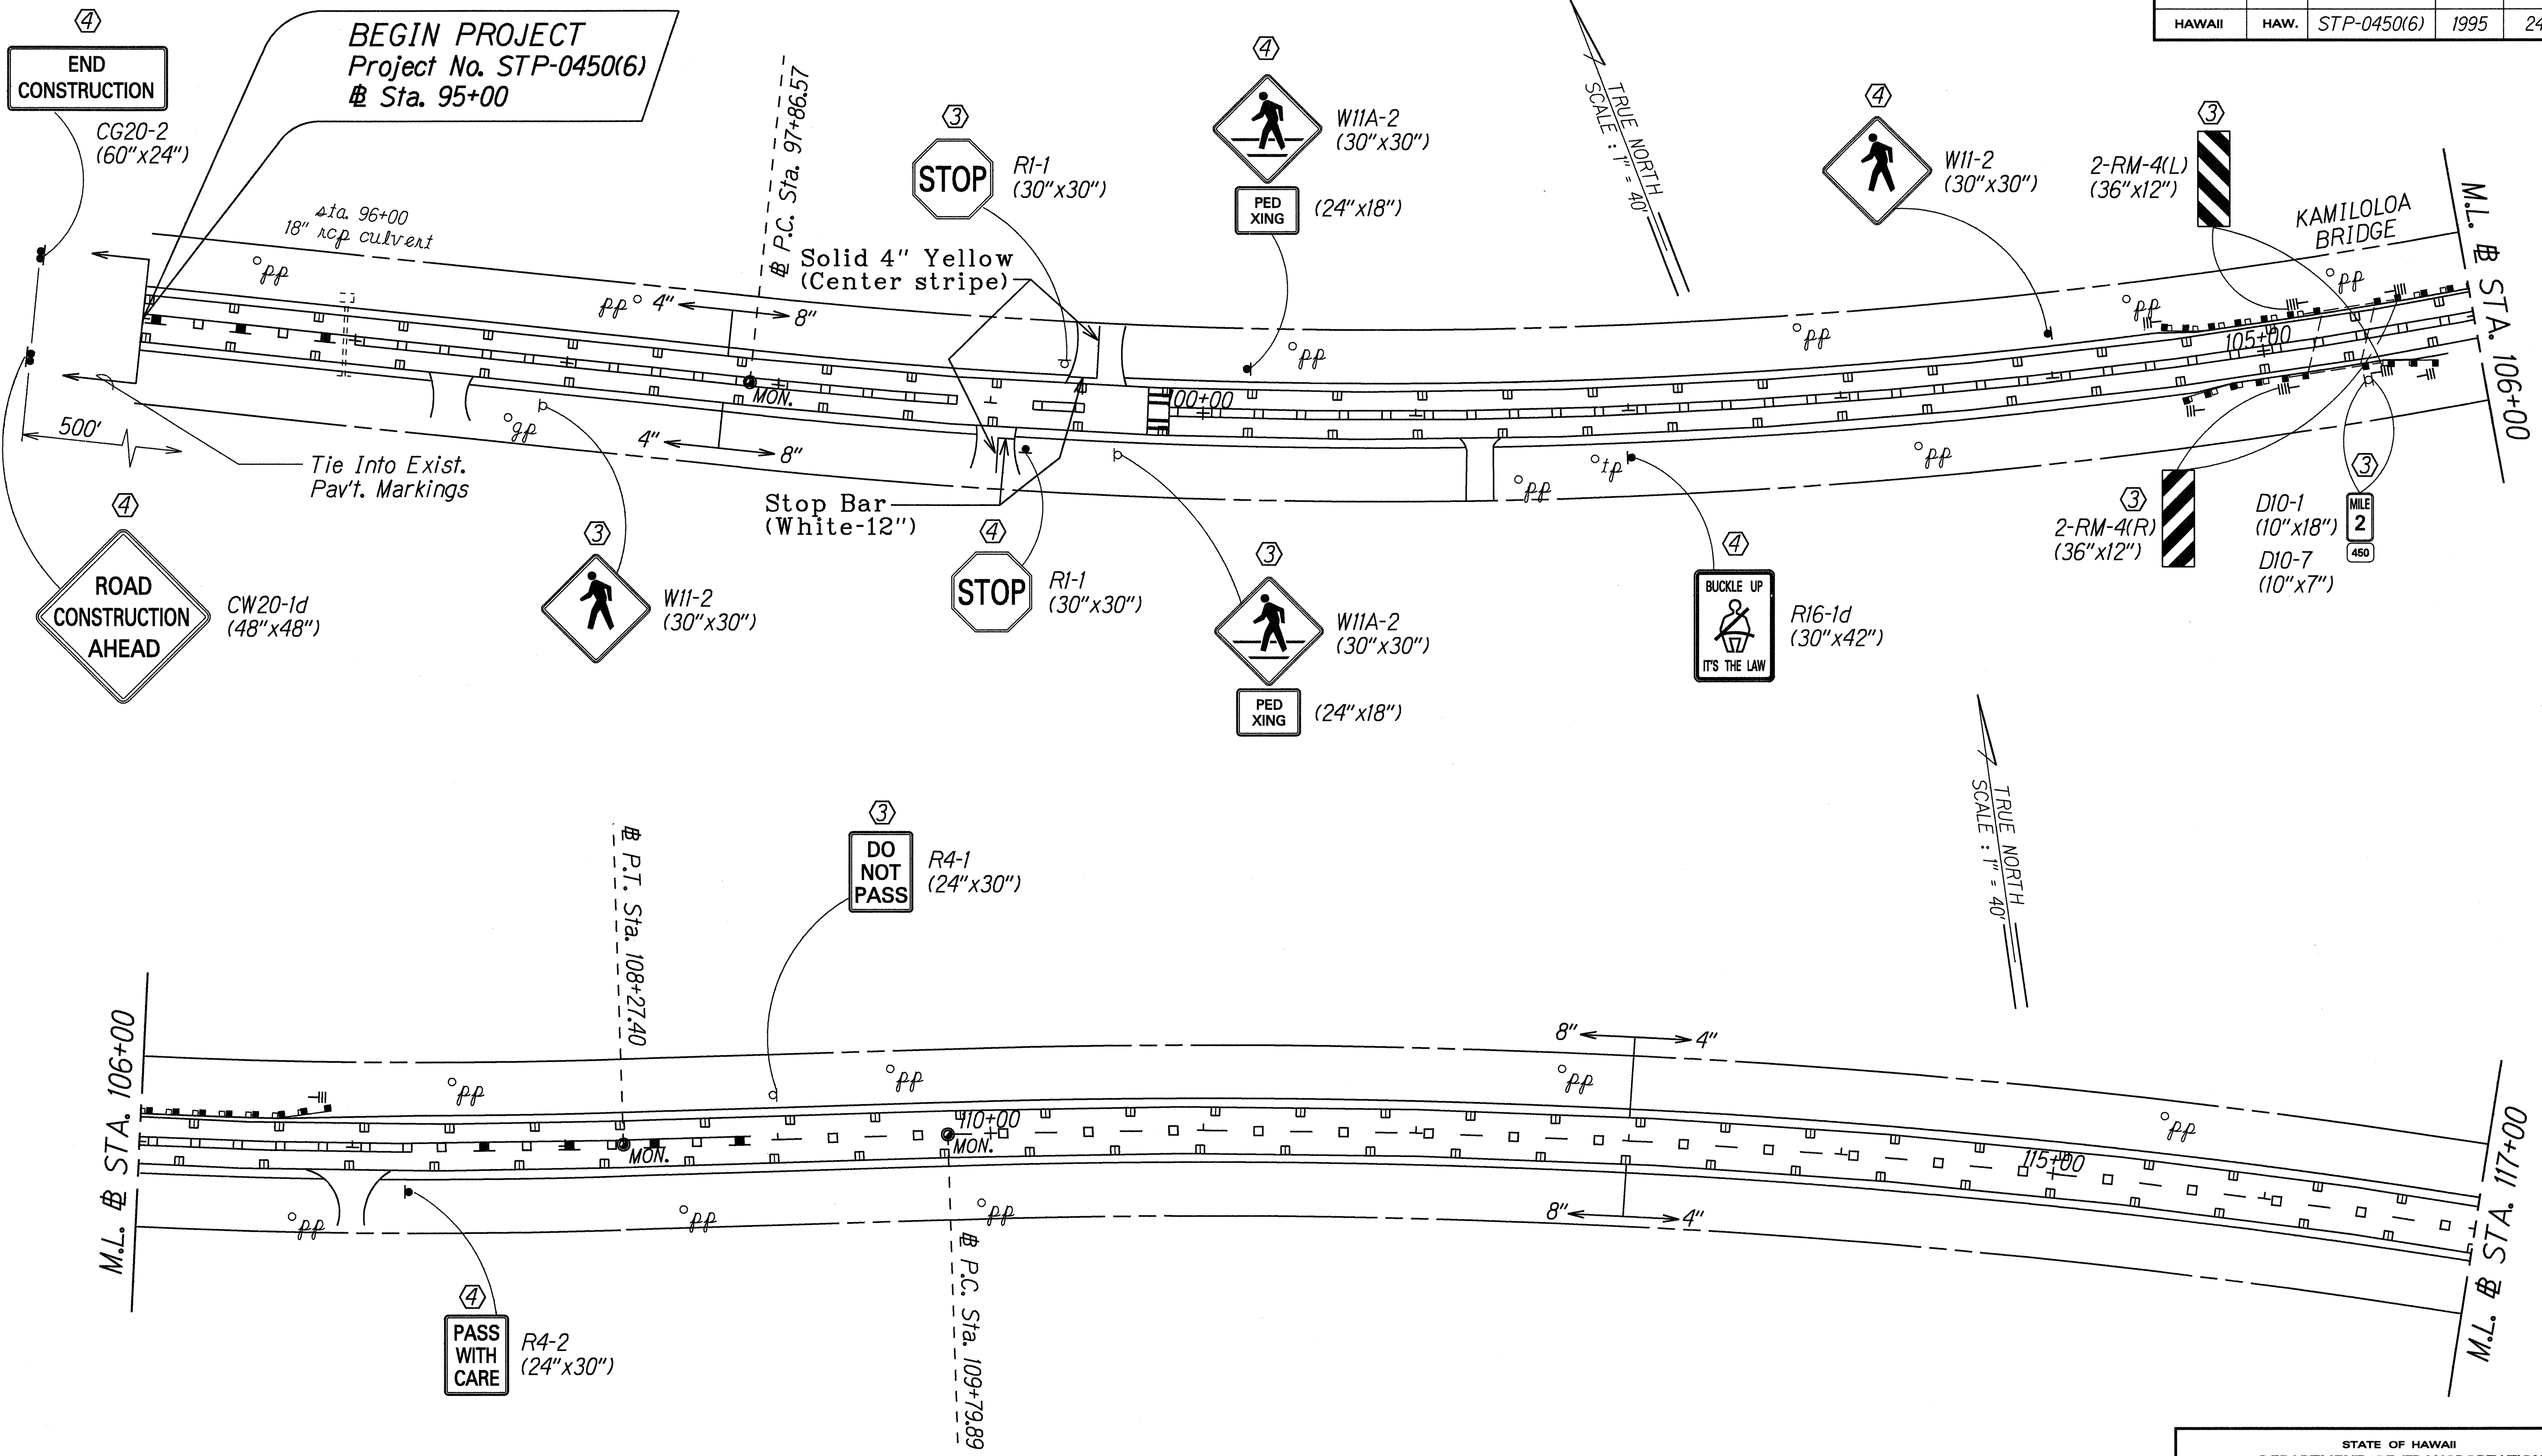

ORIGINAL PLAN	DATE
SURVEY PLOTTED BY	APRIL 1995
DRAWN BY	J. Guzman
DESIGNED BY	C. Pabasa
QUANTITIES BY	3/25/95
CHECKED BY	

LEGEND FOR AS-BUILT POSTINGS	
	Squiggly line for as-built deletion
	Double line for as-built deletion
Roadway	Text for as-built posting



- KEY:
- ① Exist. Sign(s) & Post(s) to Remain
 - ② Remove Exist. Sign(s) & Post(s)
 - ③ Remove Exist. & Install New Sign(s) & Post(s)
 - ④ Install New Sign(s) & Post(s)

STATE OF HAWAII
DEPARTMENT OF TRANSPORTATION
HIGHWAYS DIVISION

**SIGNING & PAVEMENT
MARKING PLAN**
KAMEHAMEHA V HIGHWAY RESURFACING
KamiloLoa Bridge to Kapuokoolau
Federal-Aid Project No. STP-0450(6)
Scale: 1"= 40' Date: April, 1995

SHEET No. 1 OF 13 SHEETS

FED. ROAD DIST. NO.	STATE	FED. AID PROJ. NO.	FISCAL YEAR	SHEET NO.	TOTAL SHEETS
HAWAII	HAW.	STP-0450(6)	1995	26	39

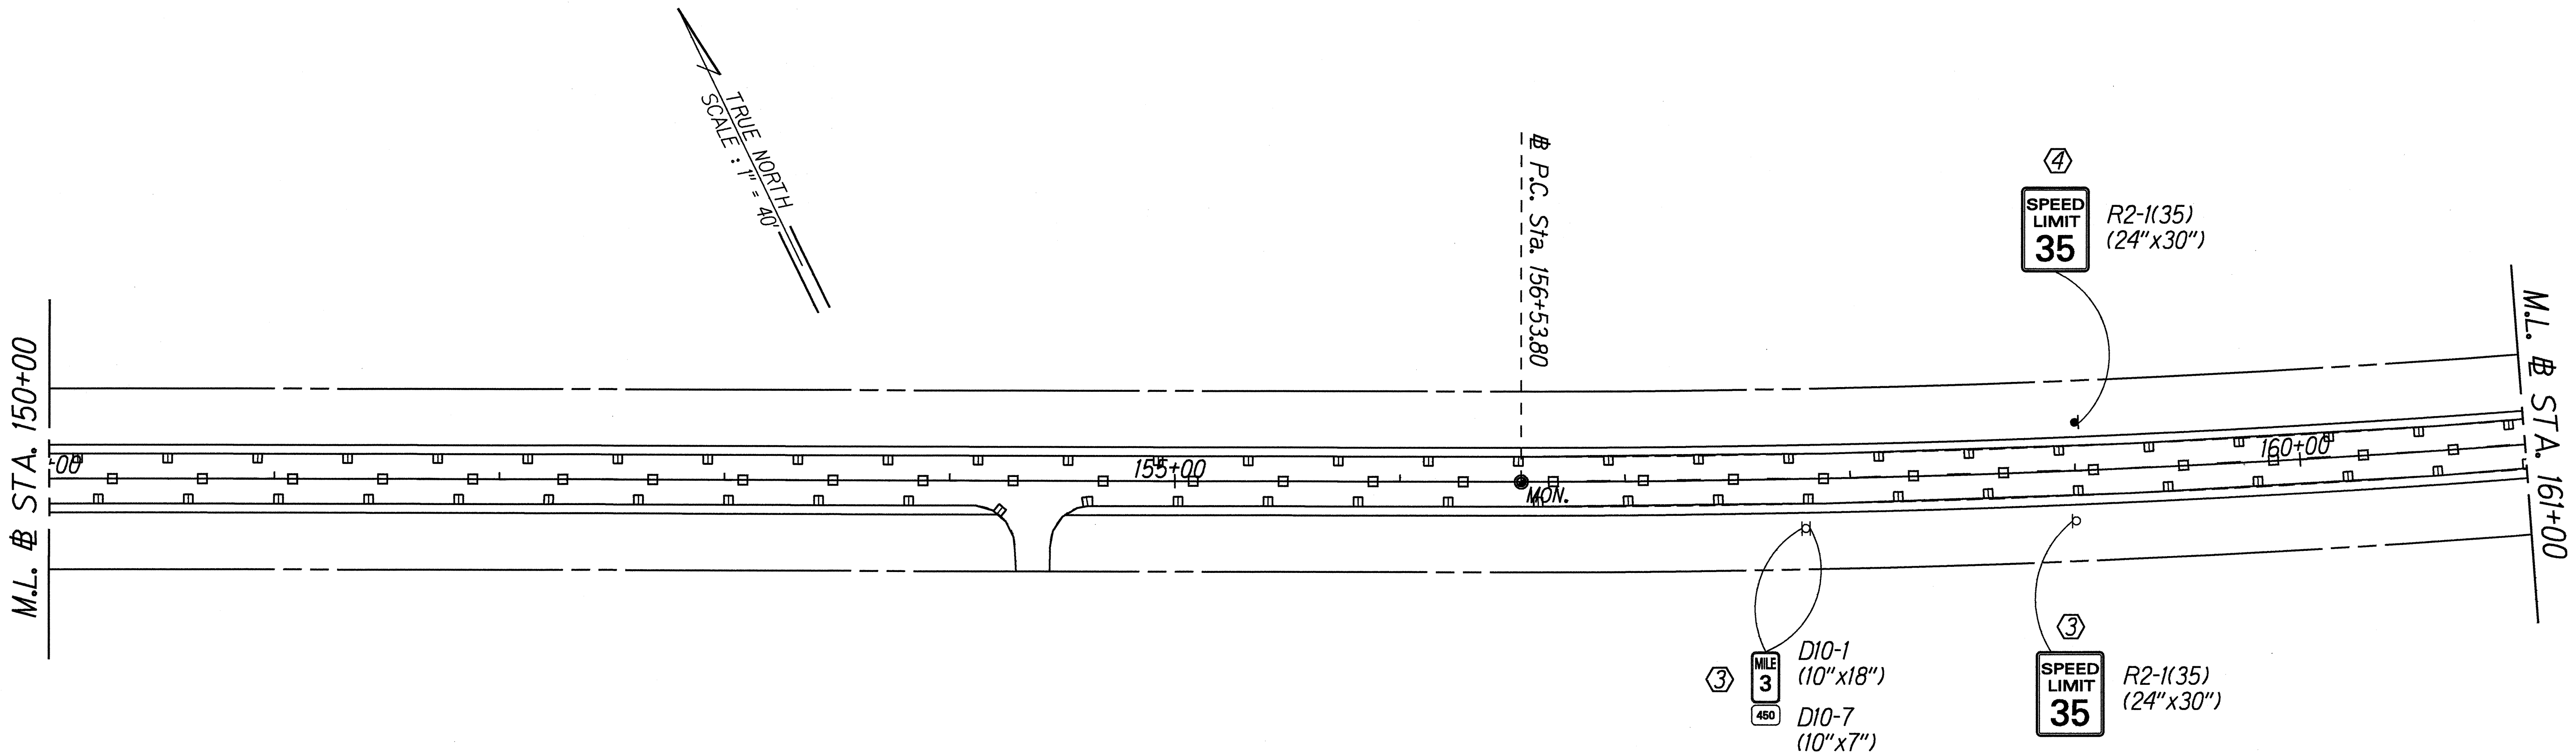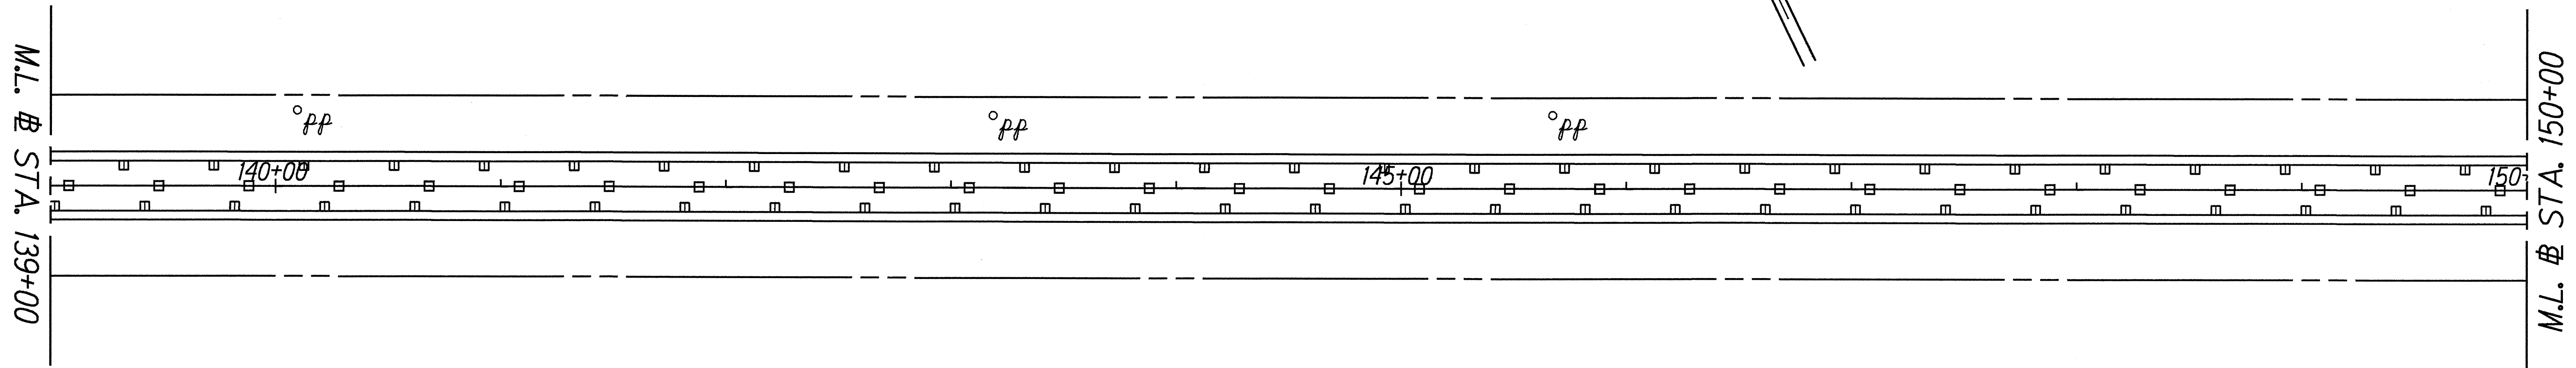

- KEY:
- ① Exist. Sign(s) & Post(s) to Remain
 - ② Remove Exist. Sign(s) & Post(s)
 - ③ Remove Exist. & Install New Sign(s) & Post(s)
 - ④ Install New Sign(s) & Post(s)


STATE OF HAWAII
DEPARTMENT OF TRANSPORTATION
HIGHWAYS DIVISION

**SIGNING & PAVEMENT
MARKING PLAN**

KAMEHAMEHA V HIGHWAY RESURFACING
Kamiloioa Bridge to Kapuokoolau
Federal-Aid Project No. STP-0450(6)
Scale: 1"= 40' Date: April, 1995

ORIGINAL PLAN	DATE
DESIGNED BY	APRIL 1995
TRACED BY	
CHECKED BY	
NOTED BY	
QUANTITIES BY	
CHECKED BY	

FED. ROAD DIST. NO.	STATE	FED. AID PROJ. NO.	FISCAL YEAR	SHEET NO.	TOTAL SHEETS
HAWAII	HAW.	STP-0450(6)	1995	27	39

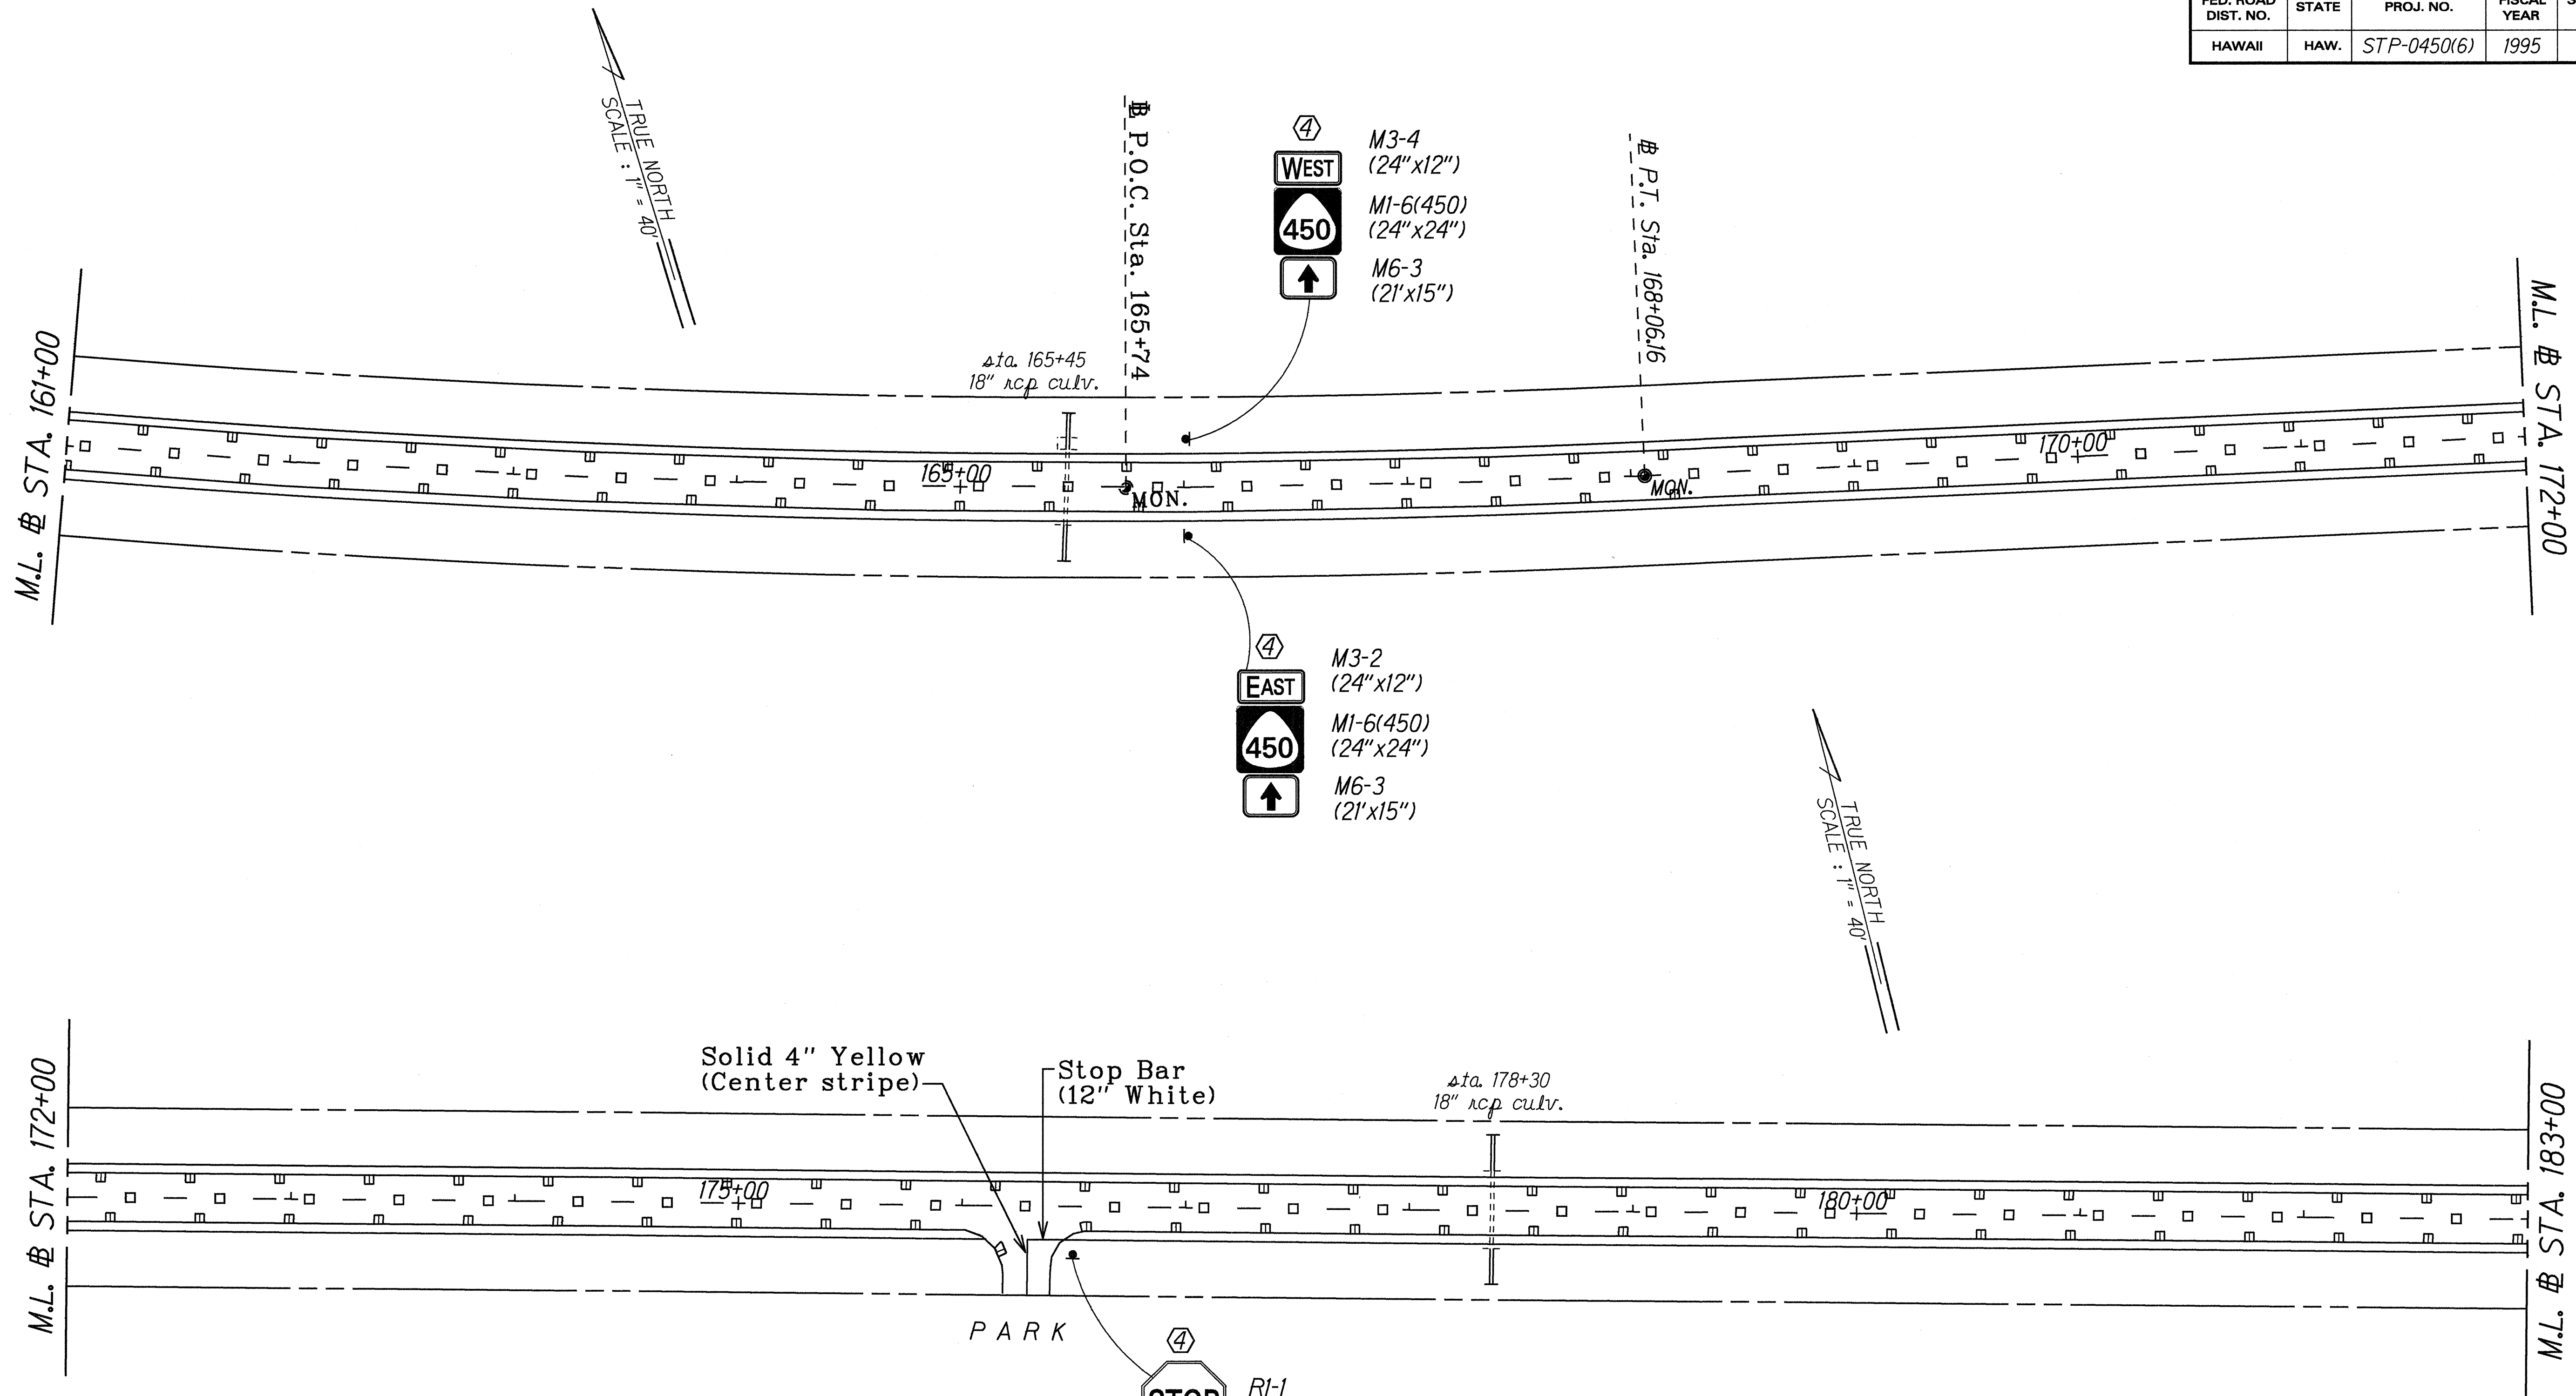

ORIGINAL PLAN	DATE
DRAWN BY	April, 1995
DESIGNED BY	
CHECKED BY	
NOTED BY	
QUANTITIES BY	
CHECKED BY	

LEGEND FOR AS-BUILT POSTINGS	
	Squiggly line for as-built deletion
	Double line for as-built deletion
Roadway	Text for as-built posting



- KEY:
- ① Exist. Sign(s) & Post(s) to Remain
 - ② Remove Exist. Sign(s) & Post(s)
 - ③ Remove Exist. & Install New Sign(s) & Post(s)
 - ④ Install New Sign(s) & Post(s)

STATE OF HAWAII
DEPARTMENT OF TRANSPORTATION
HIGHWAYS DIVISION

**SIGNING & PAVEMENT
MARKING PLAN**
KAMEHAMEHA V HIGHWAY RESURFACING
Kamiloloa Bridge to Kapuokoolau
Federal-Aid Project No. STP-0450(6)
Scale: 1"= 40' Date: April, 1995

SHEET No. 4 OF 13 SHEETS

FED. ROAD DIST. NO.	STATE	FED. AID PROJ. NO.	FISCAL YEAR	SHEET NO.	TOTAL SHEETS
HAWAII	HAW.	STP-0450(6)	1995	28	39

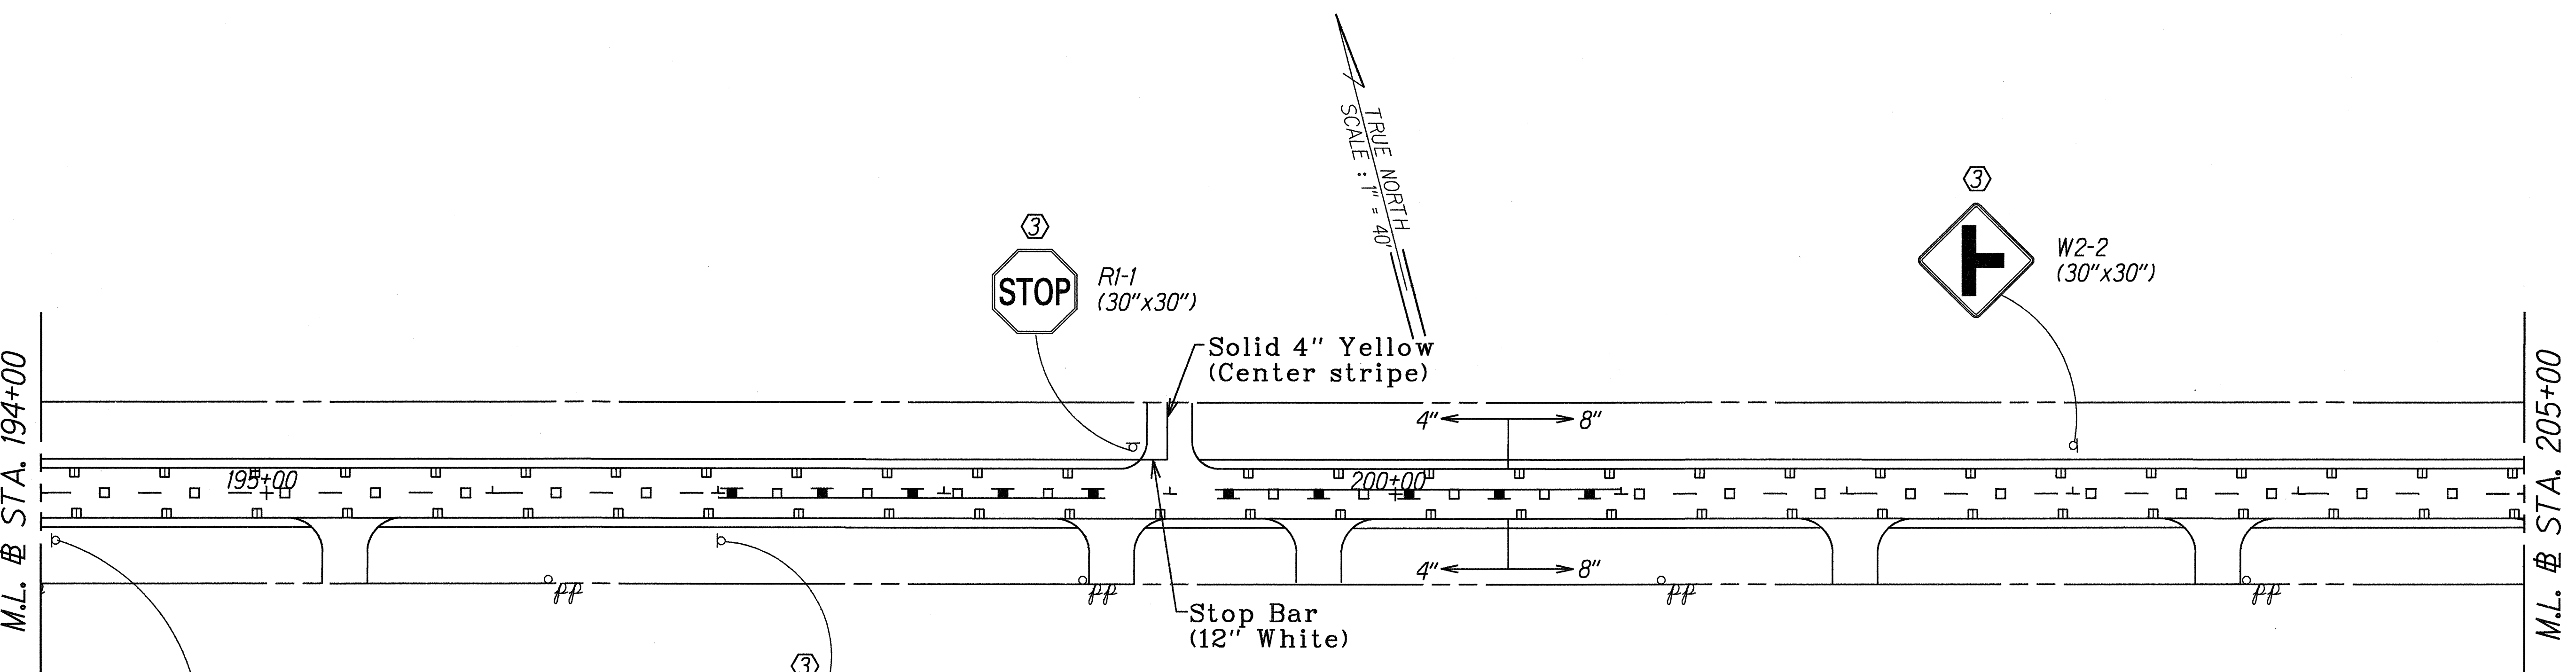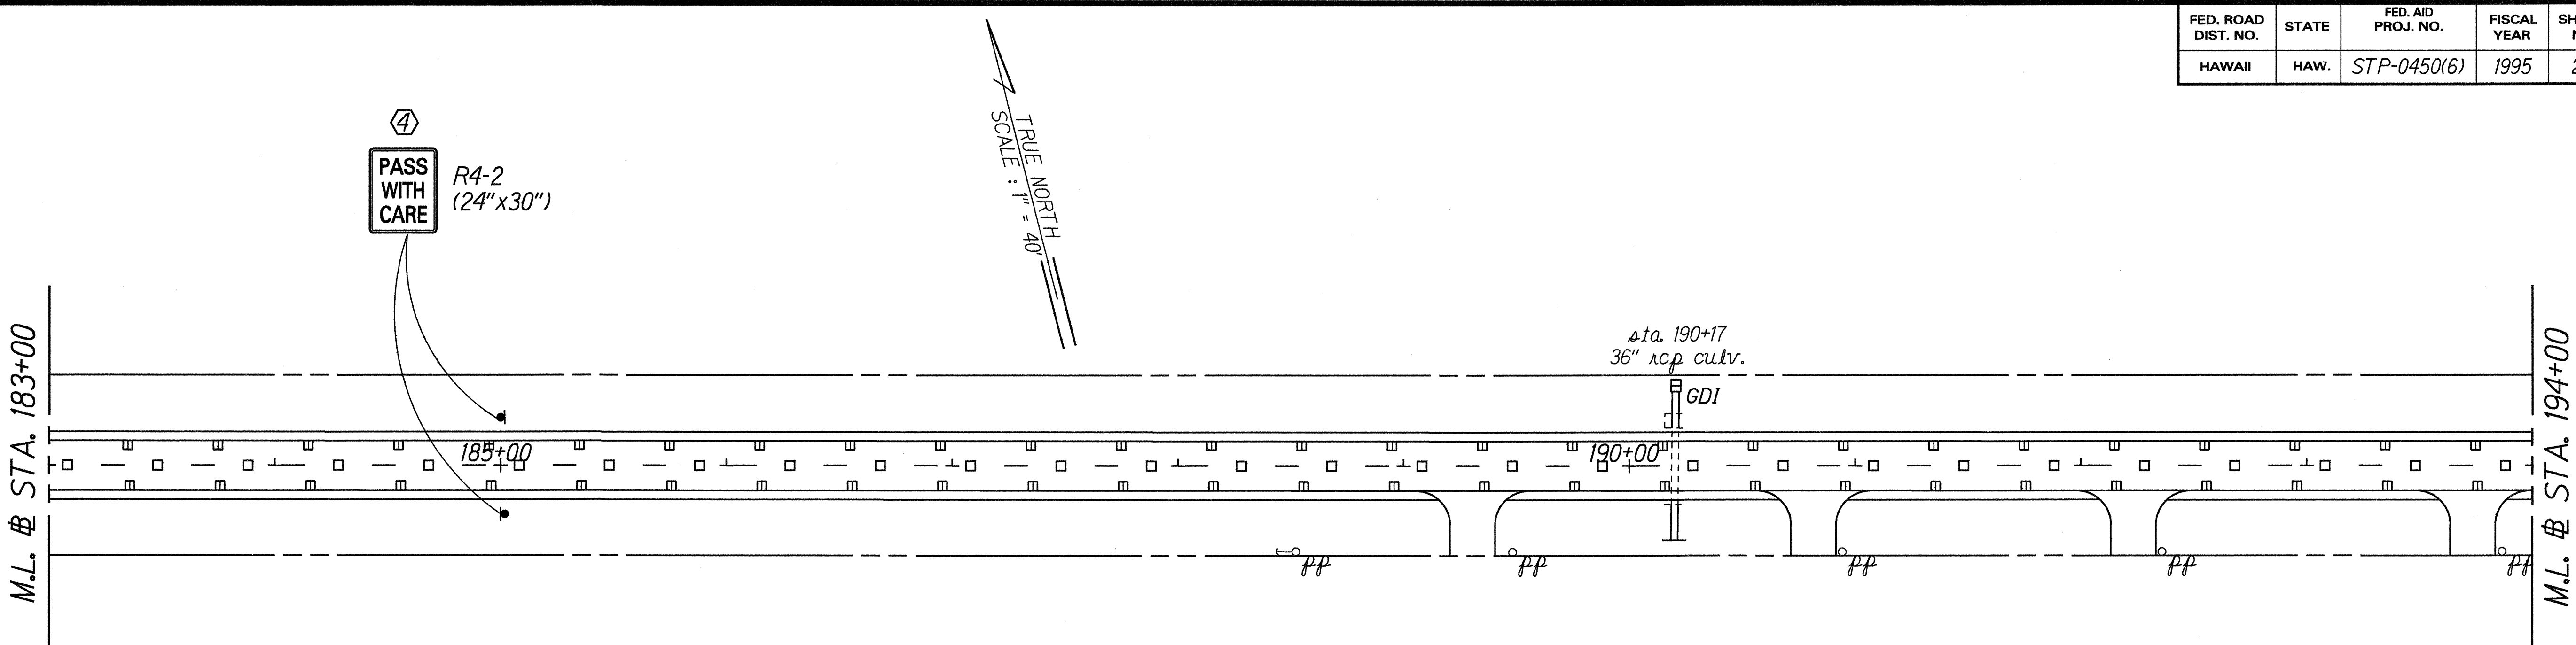

ORIGINAL PLAN	SURVEY PLOTTED BY	DATE
NOTED	DRAWN BY	April 1995
DESIGNED BY	CHECKED BY	
QUANTITIES BY		
CHECKED BY		

LEGEND FOR AS-BUILT POSTINGS	
	Squiggly line for as-built deletion
	Double line for as-built deletion
Roadway	Text for as-built posting


- KEY:
- ① Exist. Sign(s) & Post(s) to Remain
 - ② Remove Exist. Sign(s) & Post(s)
 - ③ Remove Exist. & Install New Sign(s) & Post(s)
 - ④ Install New Sign(s) & Post(s)

STATE OF HAWAII
DEPARTMENT OF TRANSPORTATION
HIGHWAYS DIVISION

**SIGNING & PAVEMENT
MARKING PLAN**
KAMEHAMEHA V HIGHWAY RESURFACING
Kamiloloa Bridge to Kapuokoolau
Federal-Aid Project No. STP-0450(6)
Scale: 1"= 40' Date: April, 1995

SHEET No. 5 OF 13 SHEETS

FED. ROAD DIST. NO.	STATE	FED. AID PROJ. NO.	FISCAL YEAR	SHEET NO.	TOTAL SHEETS
HAWAII	HAW.	STP-0450(6)	1995	30	39

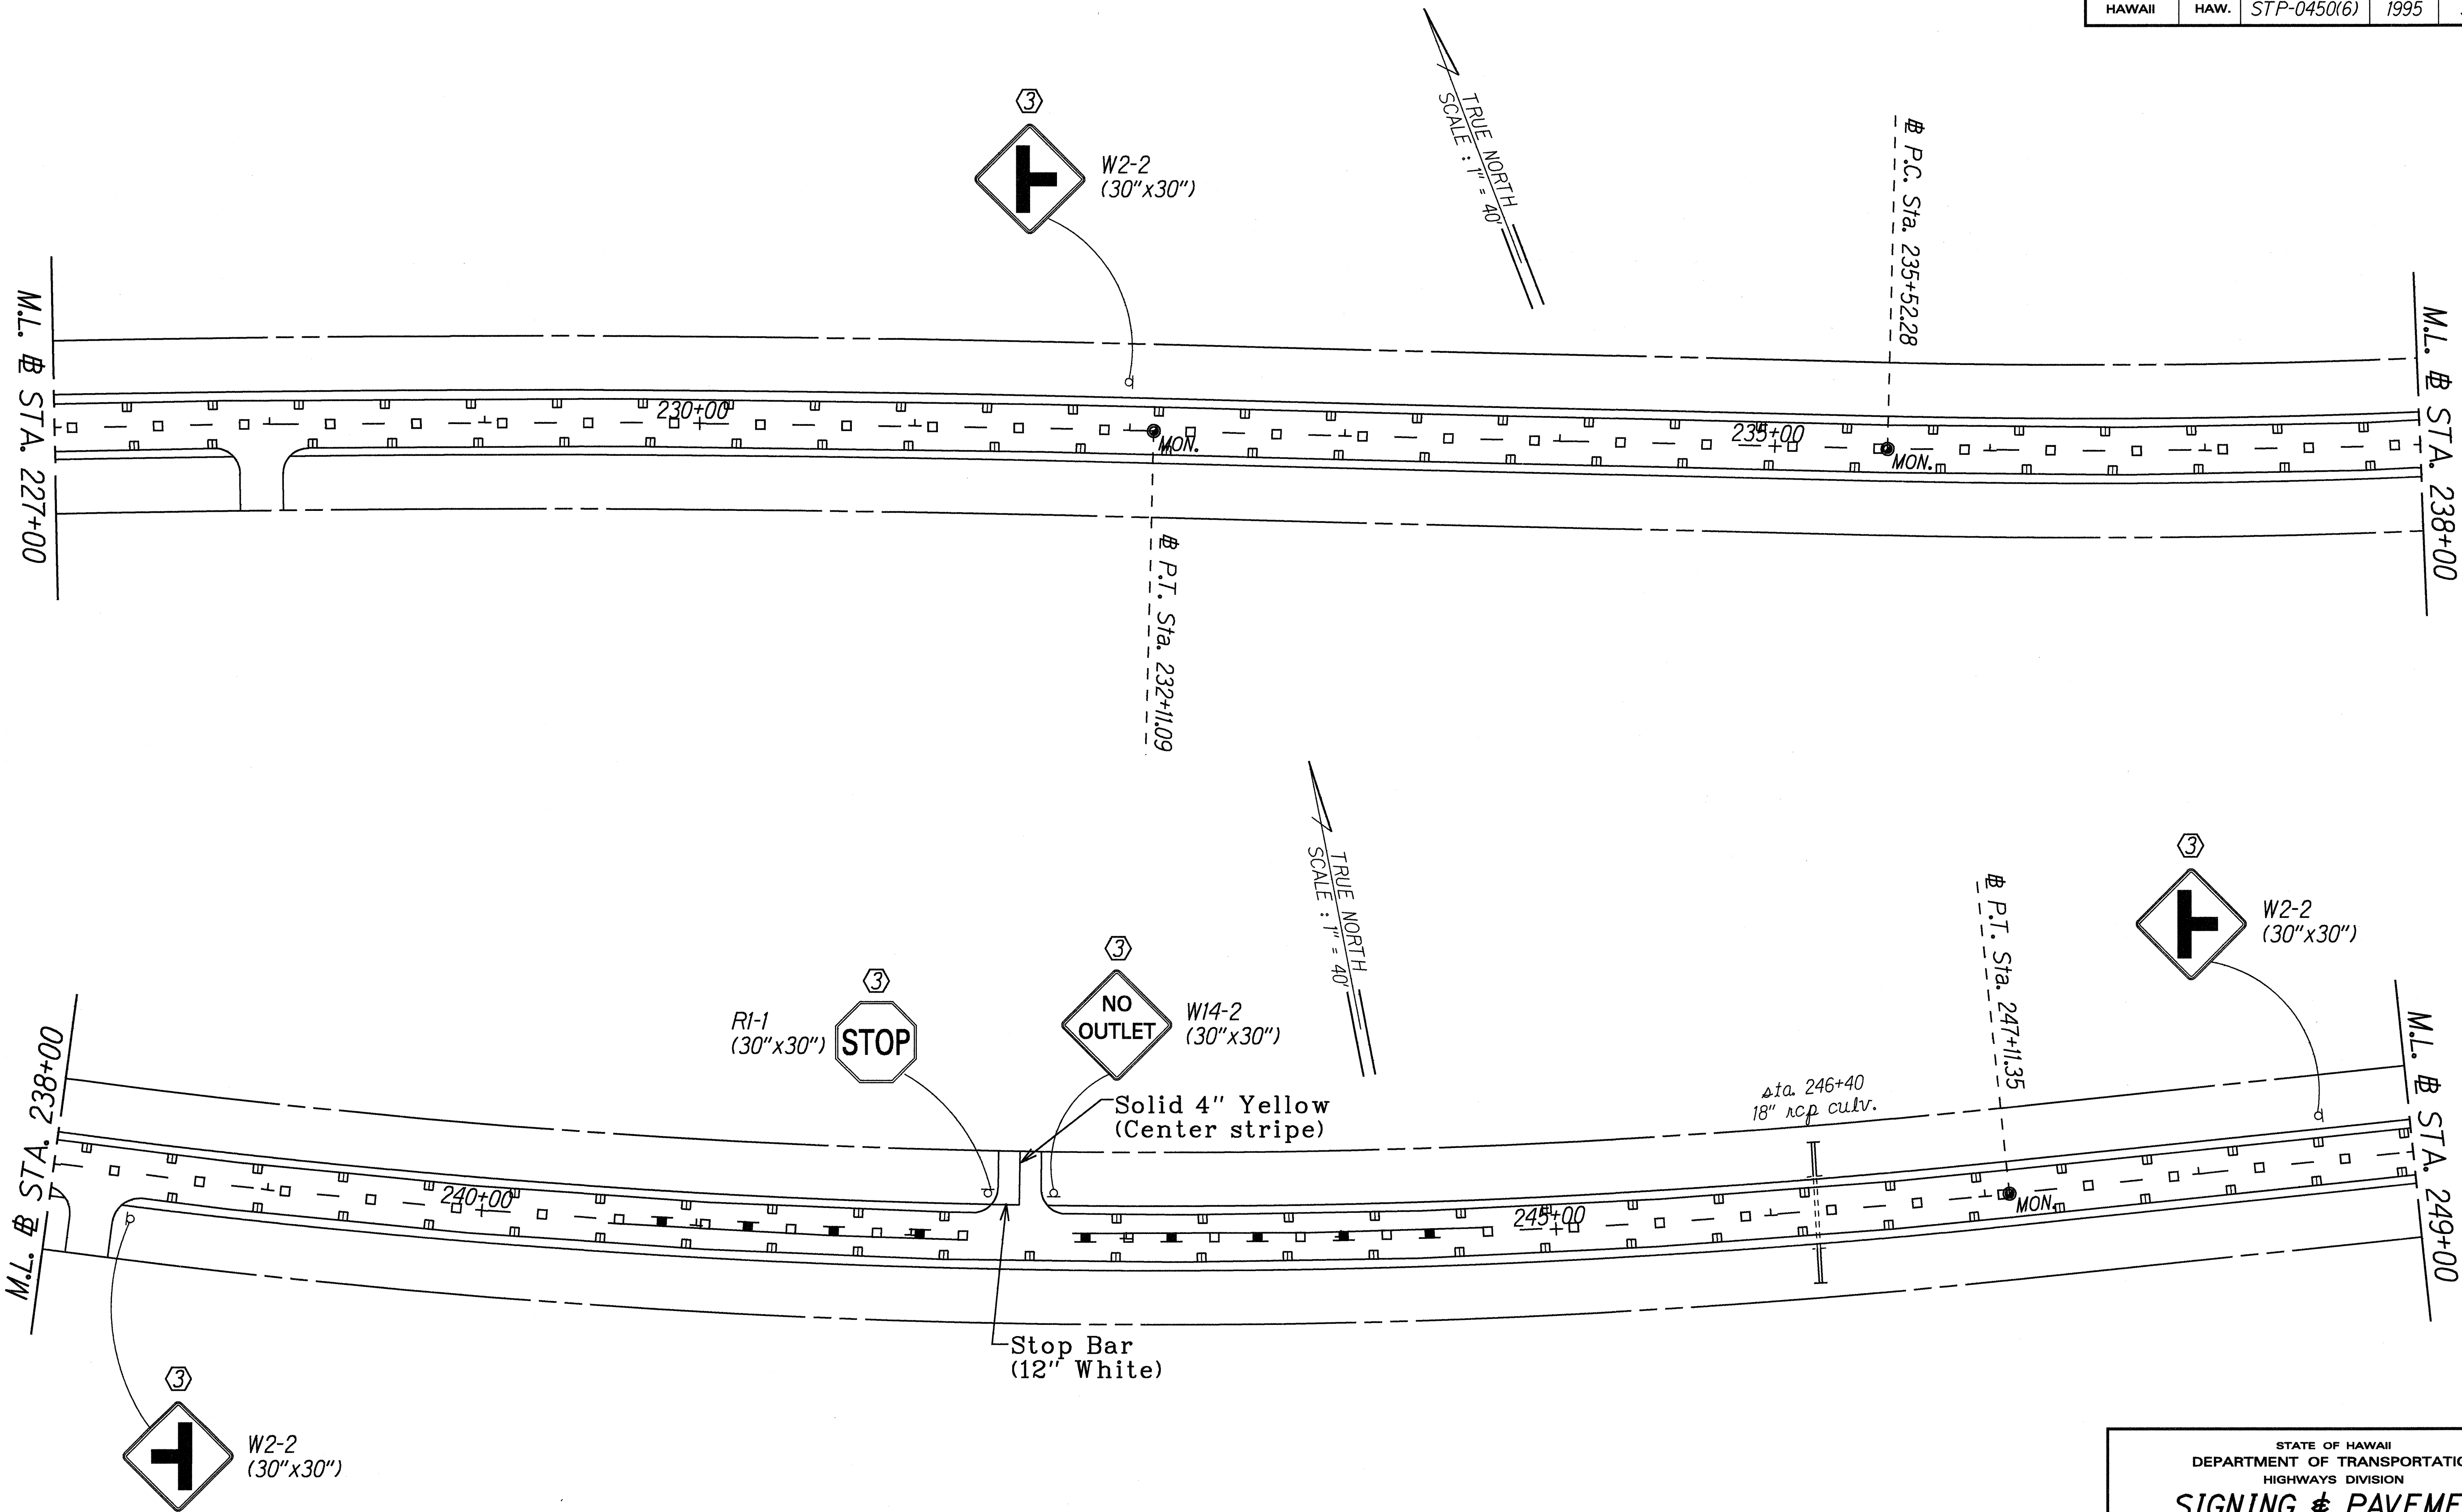

ORIGINAL PLAN	DATE
SURVEY BY: J. G. GILBERT	APRIL 1995
DESIGNED BY: C. D. DAVIS	
CHECKED BY: J. G. GILBERT	



LEGEND FOR AS-BUILT POSTINGS	
	Squiggly line for as-built deletion
	Double line for as-built deletion
Roadway	Text for as-built posting

- KEY:
- ① Exist. Sign(s) & Post(s) to Remain
 - ② Remove Exist. Sign(s) & Post(s)
 - ③ Remove Exist. & Install New Sign(s) & Post(s)
 - ④ Install New Sign(s) & Post(s)

STATE OF HAWAII
DEPARTMENT OF TRANSPORTATION
HIGHWAYS DIVISION

**SIGNING & PAVEMENT
MARKING PLAN**
KAMEHAMEHA V HIGHWAY RESURFACING
Kamiloloa Bridge to Kapuokoolau
Federal-Aid Project No. STP-0450(6)
Scale: 1"= 40' Date: April, 1995

FED. ROAD DIST. NO.	STATE	FED. AID PROJ. NO.	FISCAL YEAR	SHEET NO.	TOTAL SHEETS
HAWAII	HAW.	STP-0450(6)	1995	31	39

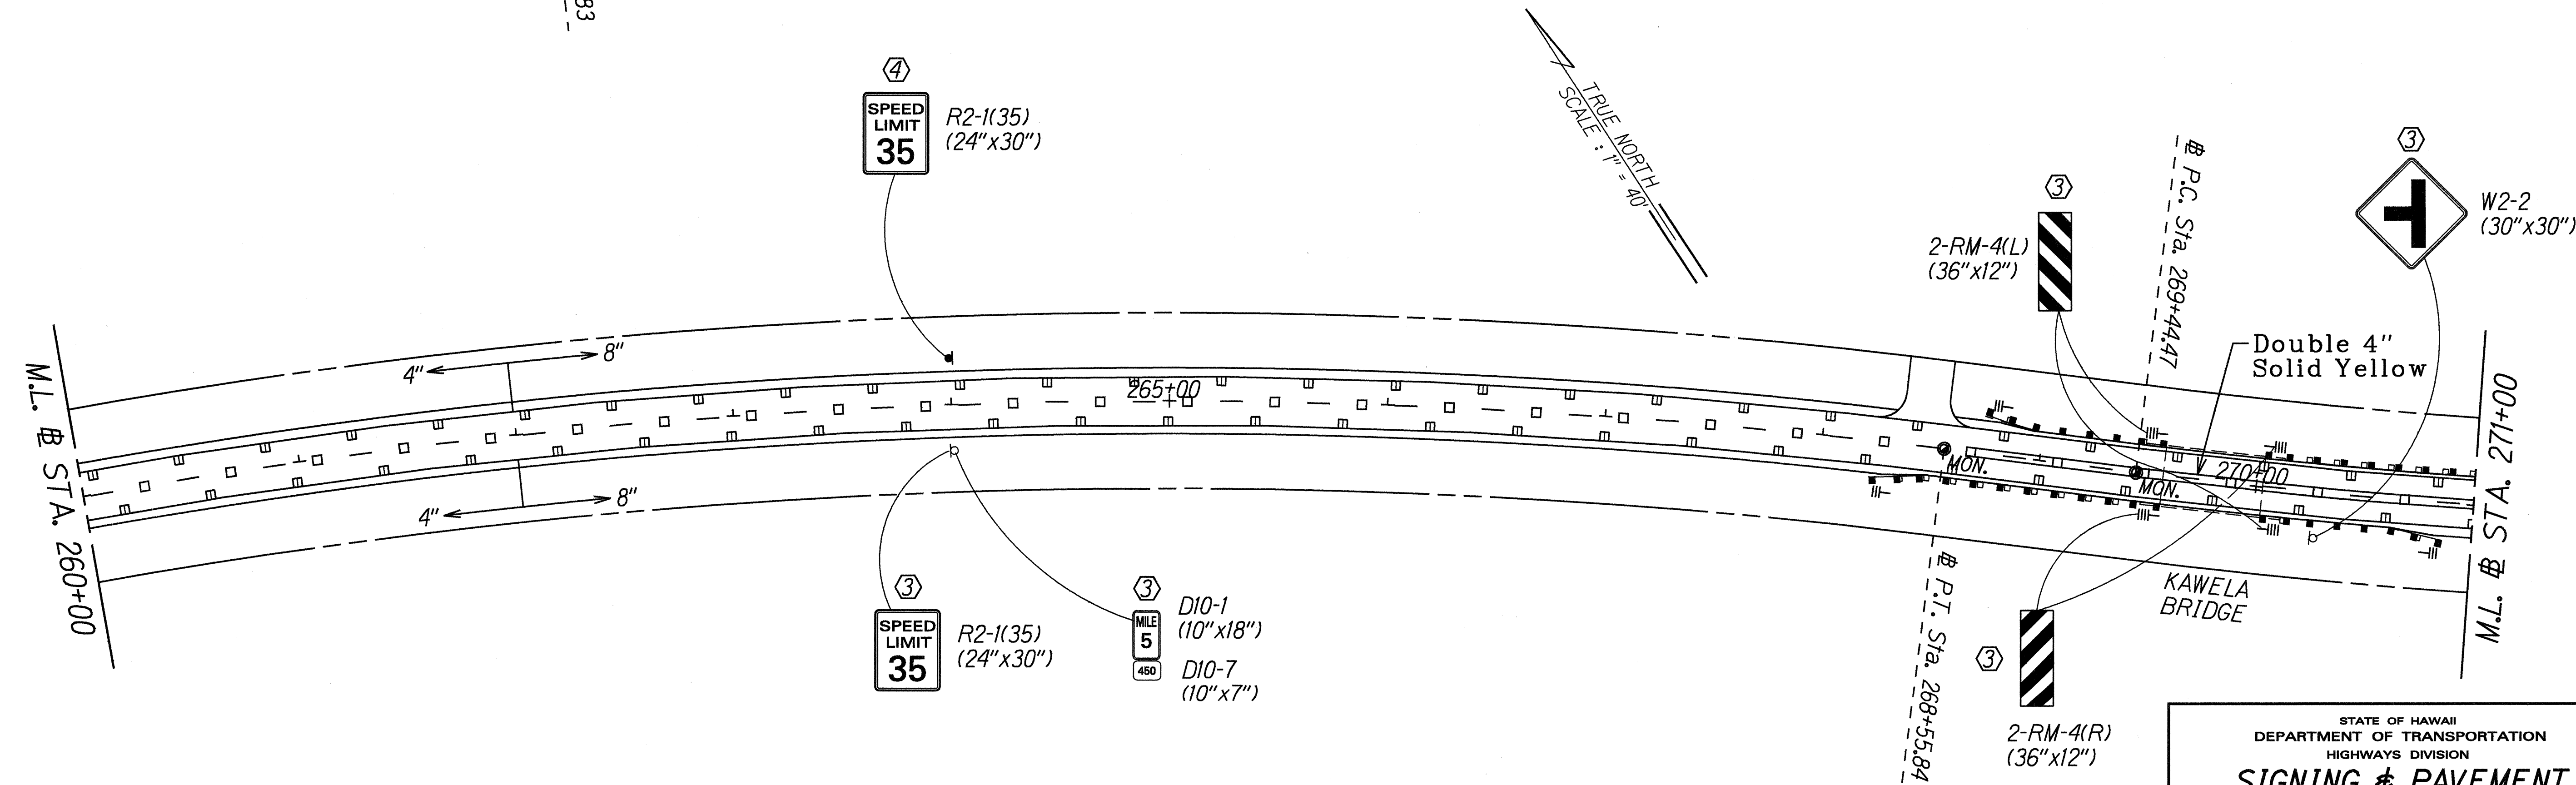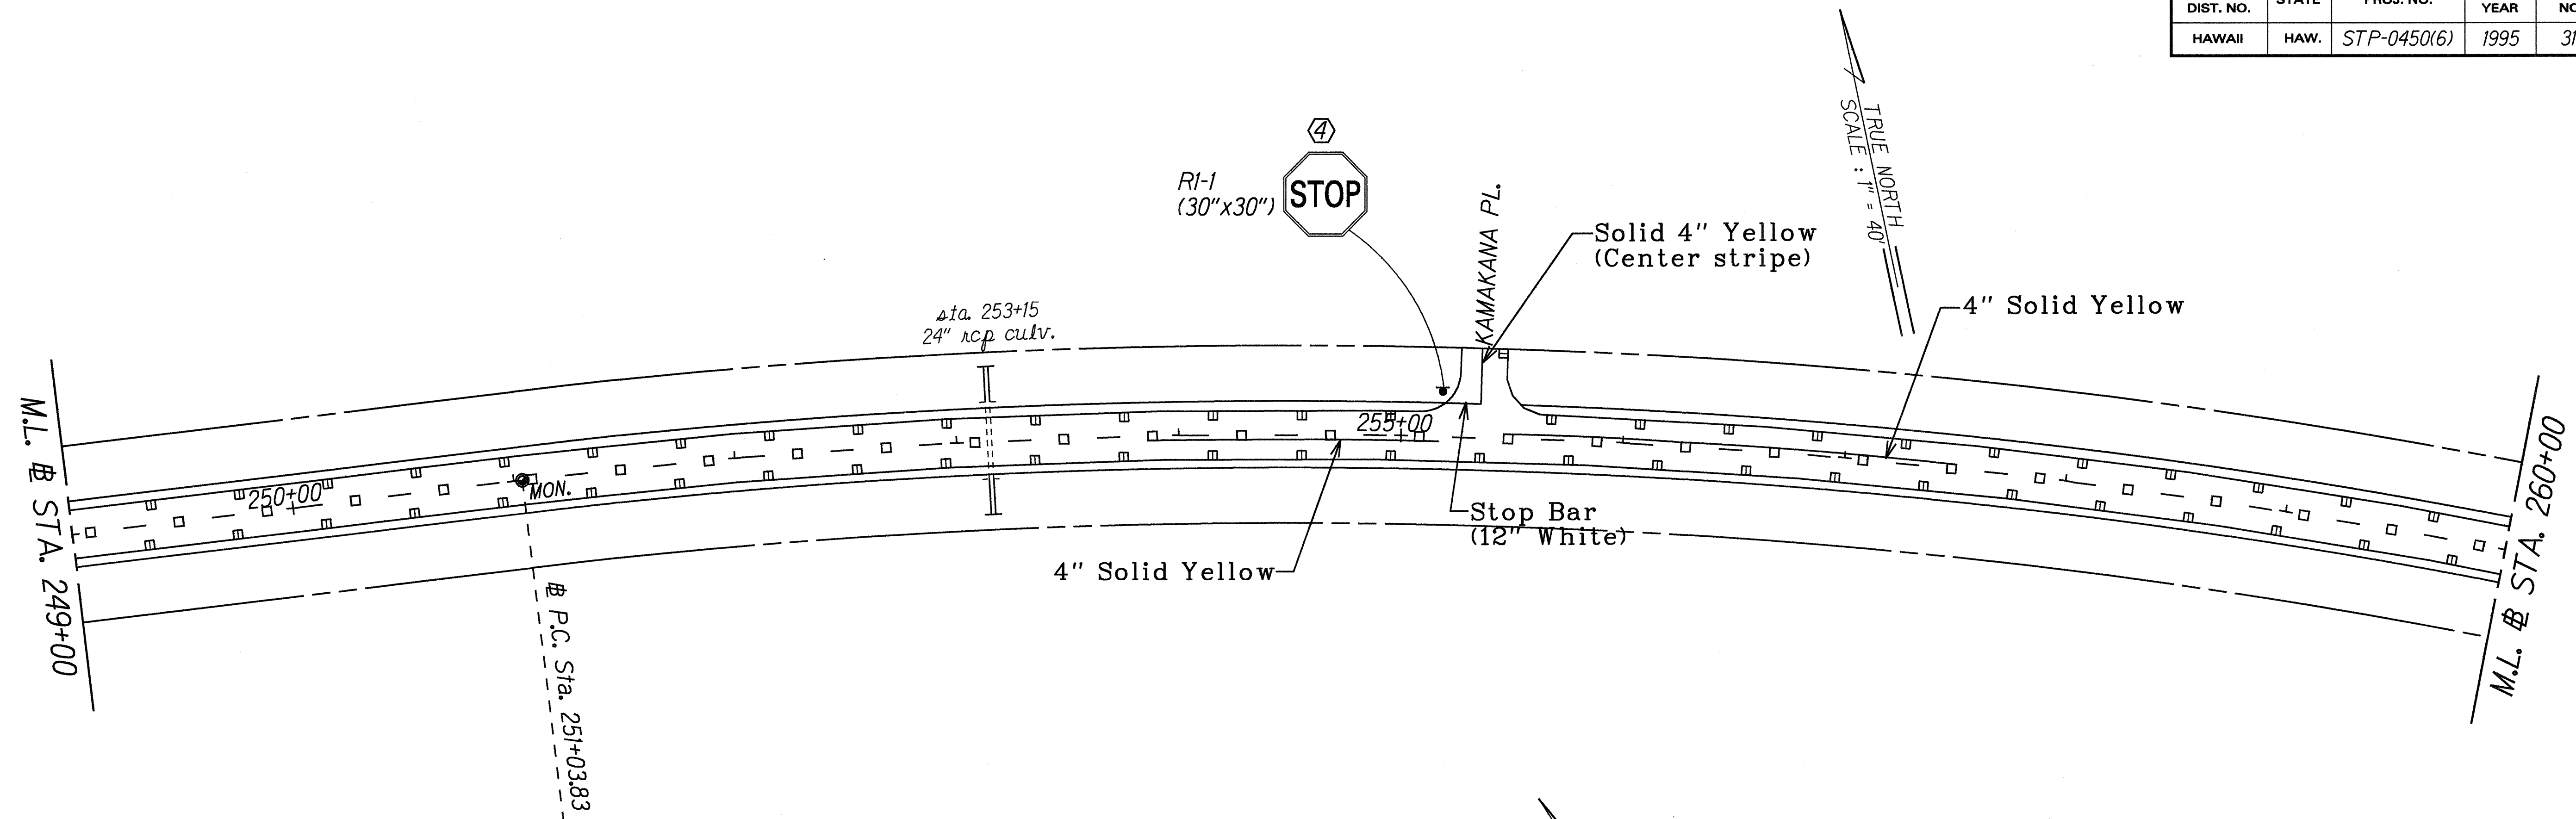

DATE	April 1995
DESIGNED BY	C. Hagan
CHECKED BY	3/10/95/10/95
ORIGINAL PLAN	

LEGEND FOR AS-BUILT POSTINGS	
	Squiggly line for as-built deletion
	Double line for as-built deletion
Roadway	Text for as-built posting



- KEY:
- ① Exist. Sign(s) & Post(s) to Remain
 - ② Remove Exist. Sign(s) & Post(s)
 - ③ Remove Exist. & Install New Sign(s) & Post(s)
 - ④ Install New Sign(s) & Post(s)

STATE OF HAWAII
DEPARTMENT OF TRANSPORTATION
HIGHWAYS DIVISION

**SIGNING & PAVEMENT
MARKING PLAN**
KAMEHAMEHA V HIGHWAY RESURFACING
Kamiloloa Bridge to Kapuokoolau
Federal-Aid Project No. STP-0450(6)
Scale: 1"= 40' Date: April, 1995

SHEET No. 8 OF 13 SHEETS

FED. ROAD DIST. NO.	STATE	FED. AID PROJ. NO.	FISCAL YEAR	SHEET NO.	TOTAL SHEETS
HAWAII	HAW.	STP-0450(6)	1995	32	39

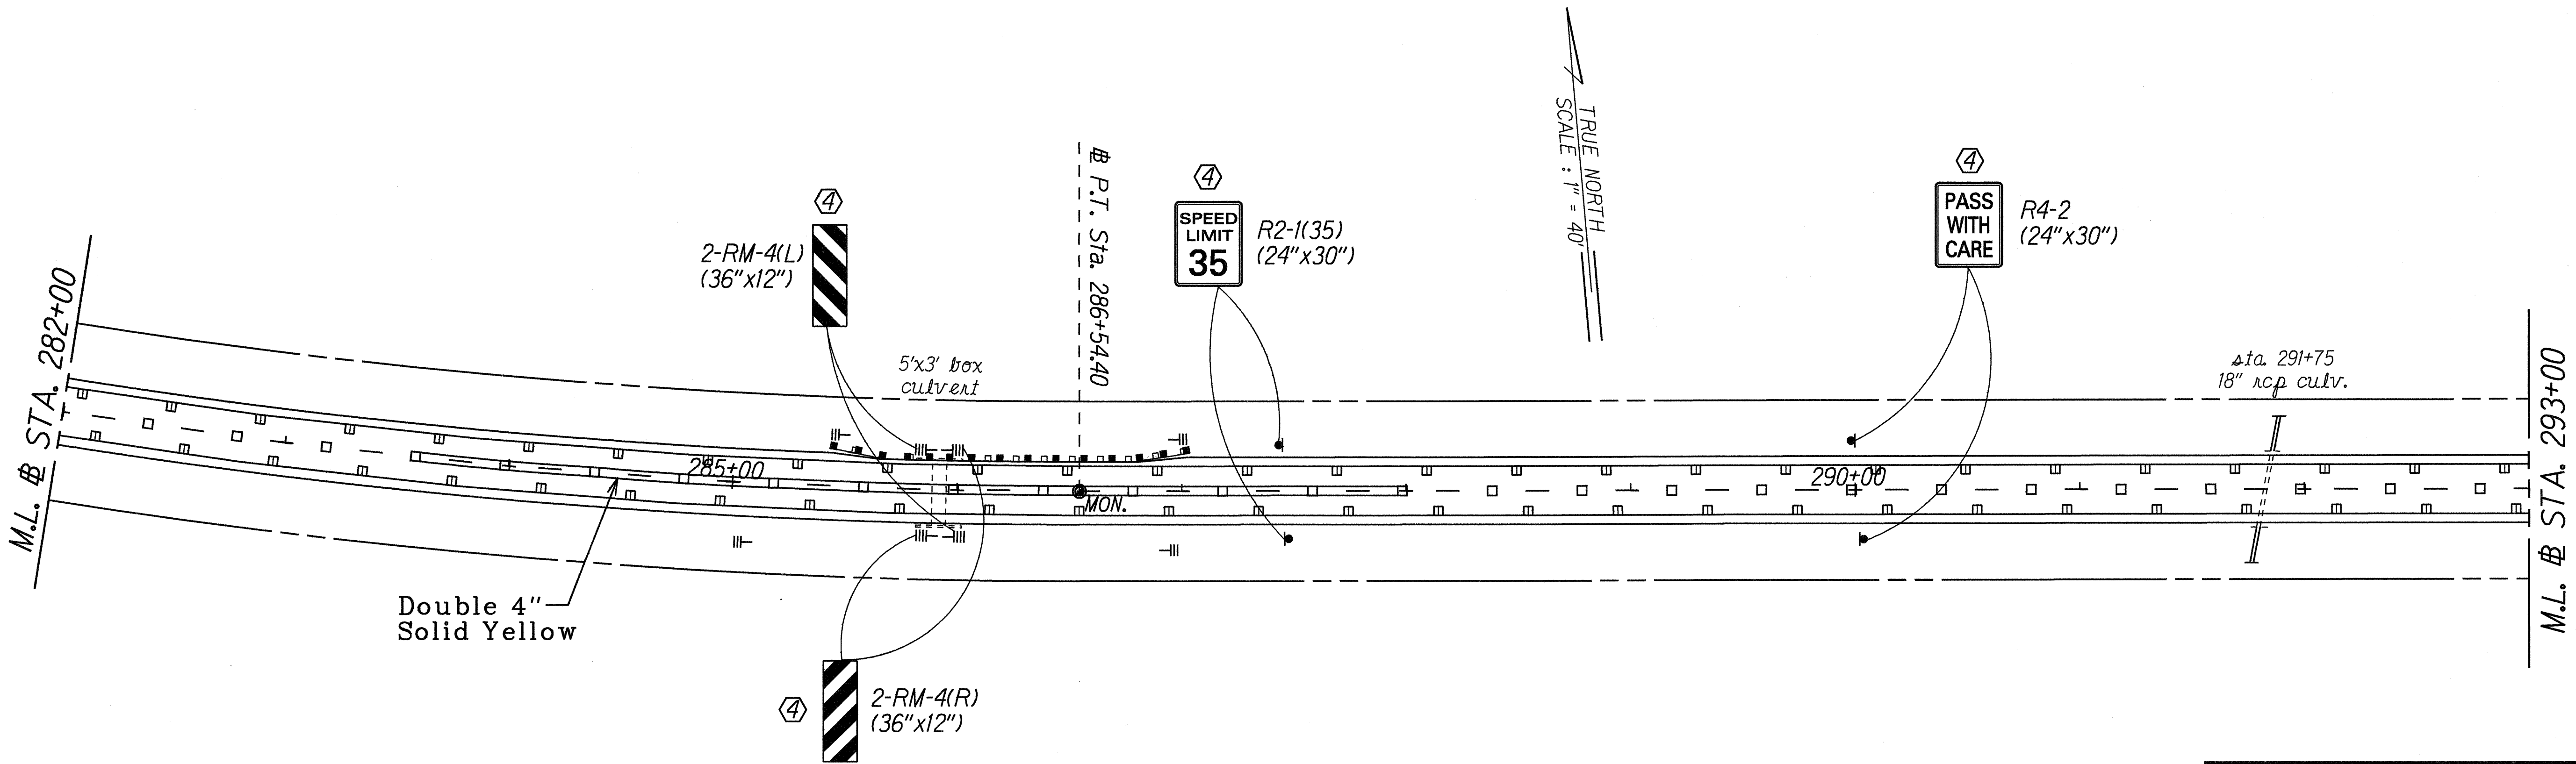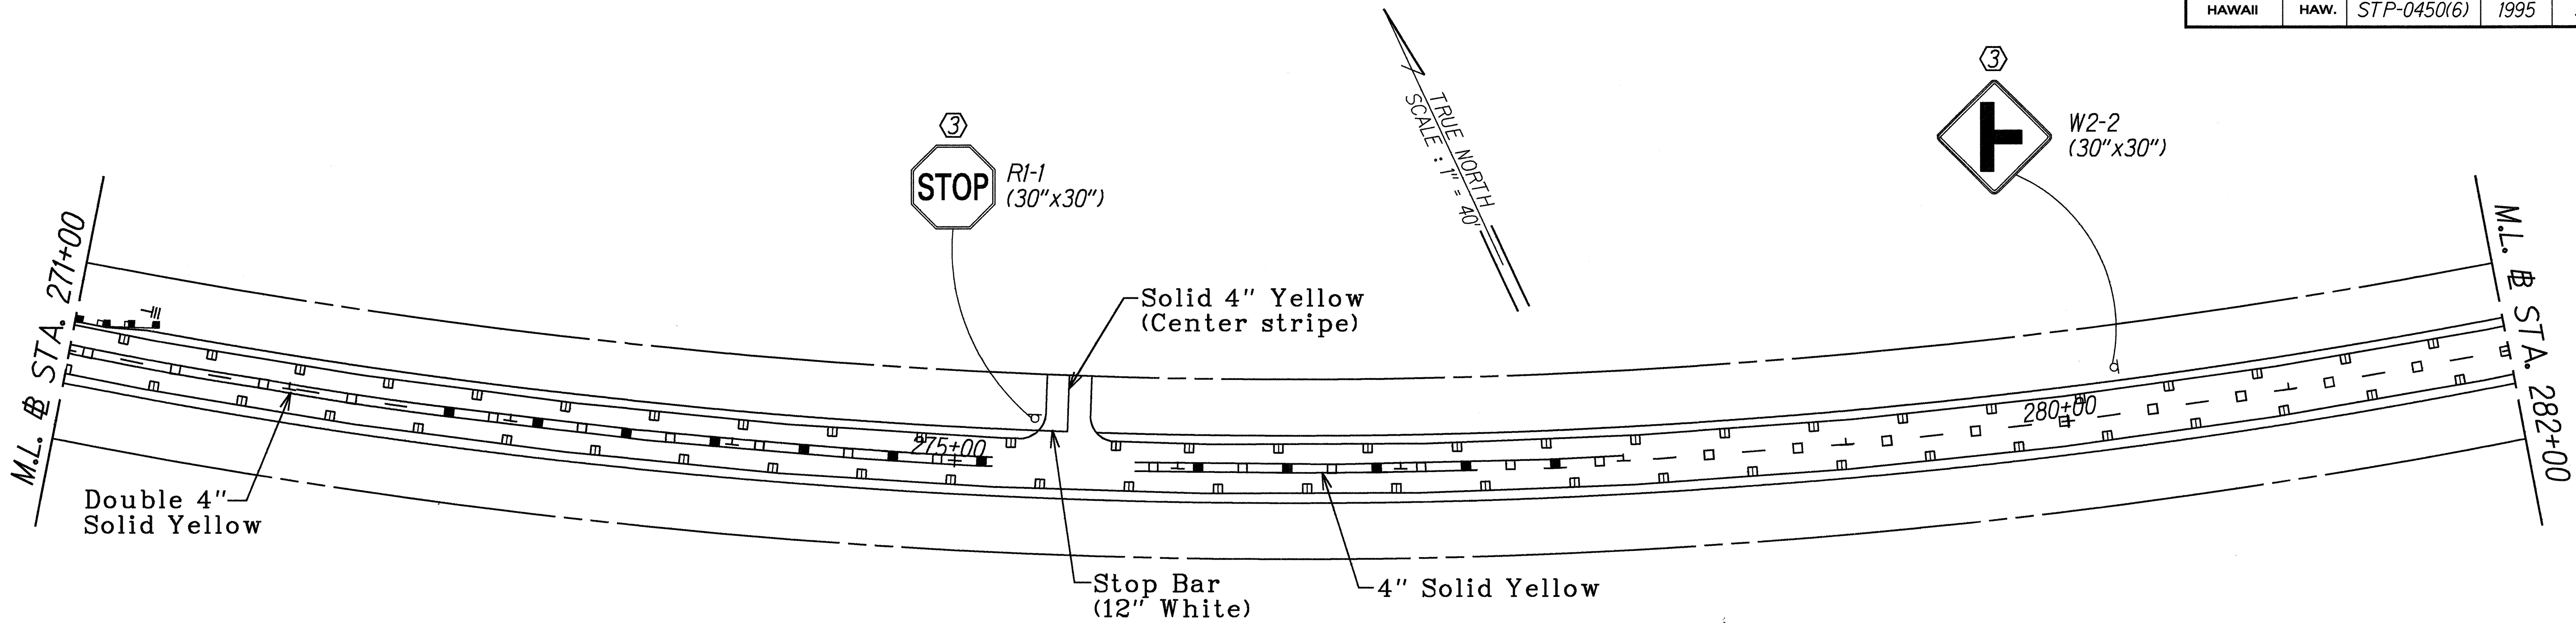

DATE	10/11/95
DESIGNED BY	C. Fagasa
CHECKED BY	W. H. H. H.
NOTED BY	
QUANTITIES BY	
ORIGINAL PLAN	

LEGEND FOR AS-BUILT POSTINGS	
	Squiggly line for as-built deletion
	Double line for as-built deletion
Roadway	Text for as-built posting


- KEY:
- ① Exist. Sign(s) & Post(s) to Remain
 - ② Remove Exist. Sign(s) & Post(s)
 - ③ Remove Exist. & Install New Sign(s) & Post(s)
 - ④ Install New Sign(s) & Post(s)

STATE OF HAWAII
DEPARTMENT OF TRANSPORTATION
HIGHWAYS DIVISION

**SIGNING & PAVEMENT
MARKING PLAN**
KAMEHAMEHA V HIGHWAY RESURFACING
Kamiloloa Bridge to Kapuokoolau
Federal-Aid Project No. STP-0450(6)
Scale: 1"= 40' Date: April, 1995

SHEET No. 9 OF 13 SHEETS

FED. ROAD DIST. NO.	STATE	FED. AID PROJ. NO.	FISCAL YEAR	SHEET NO.	TOTAL SHEETS
HAWAII	HAW.	STP-0450(6)	1995	33	39

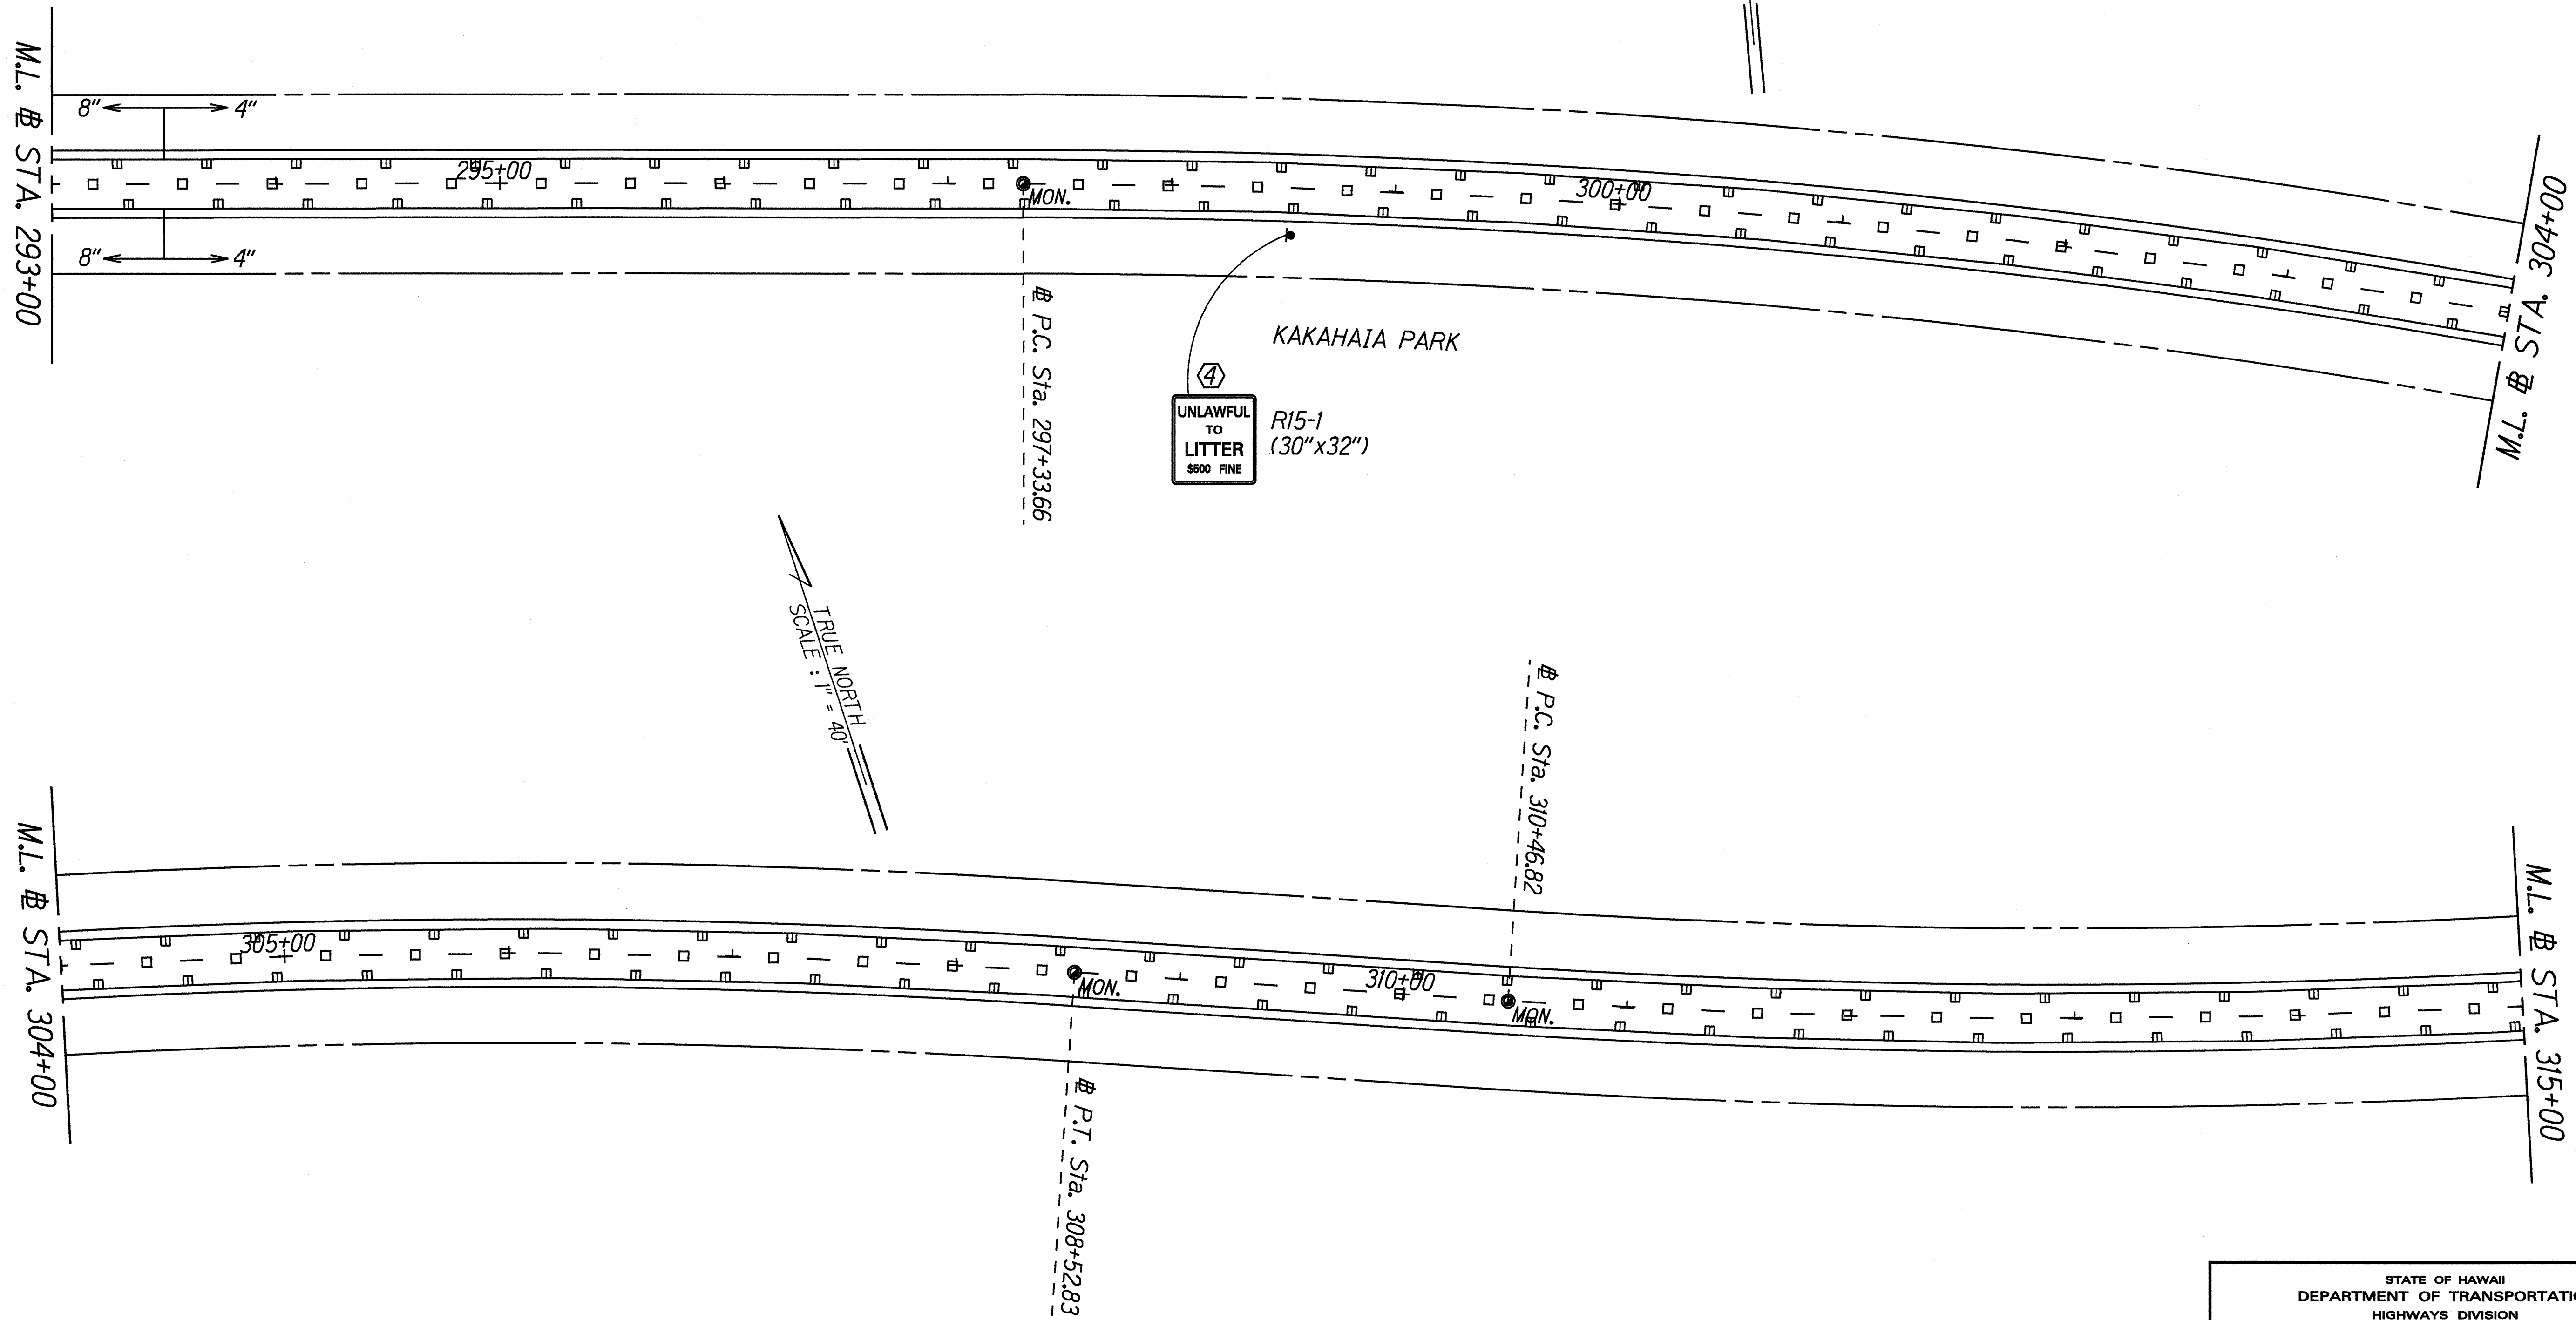

- KEY:
- ① Exist. Sign(s) & Post(s) to Remain
 - ② Remove Exist. Sign(s) & Post(s)
 - ③ Remove Exist. & Install New Sign(s) & Post(s)
 - ④ Install New Sign(s) & Post(s)


STATE OF HAWAII
DEPARTMENT OF TRANSPORTATION
HIGHWAYS DIVISION

SIGNING & PAVEMENT
MARKING PLAN

KAMEHAMEHA V HIGHWAY RESURFACING
Kamiloloa Bridge to Kapuokoolau
Federal-Aid Project No. STP-0450(6)
Scale: 1"= 40' Date: April, 1995

ORIGINAL PLAN	DATE
SURVEY PLOTTED BY	April 1995
DRAWN BY	
DESIGNED BY	
QUANTITIES BY	
CHECKED BY	

FED. ROAD DIST. NO.	STATE	FED. AID PROJ. NO.	FISCAL YEAR	SHEET NO.	TOTAL SHEETS
HAWAII	HAW.	STP-0450(6)	1995	34	39

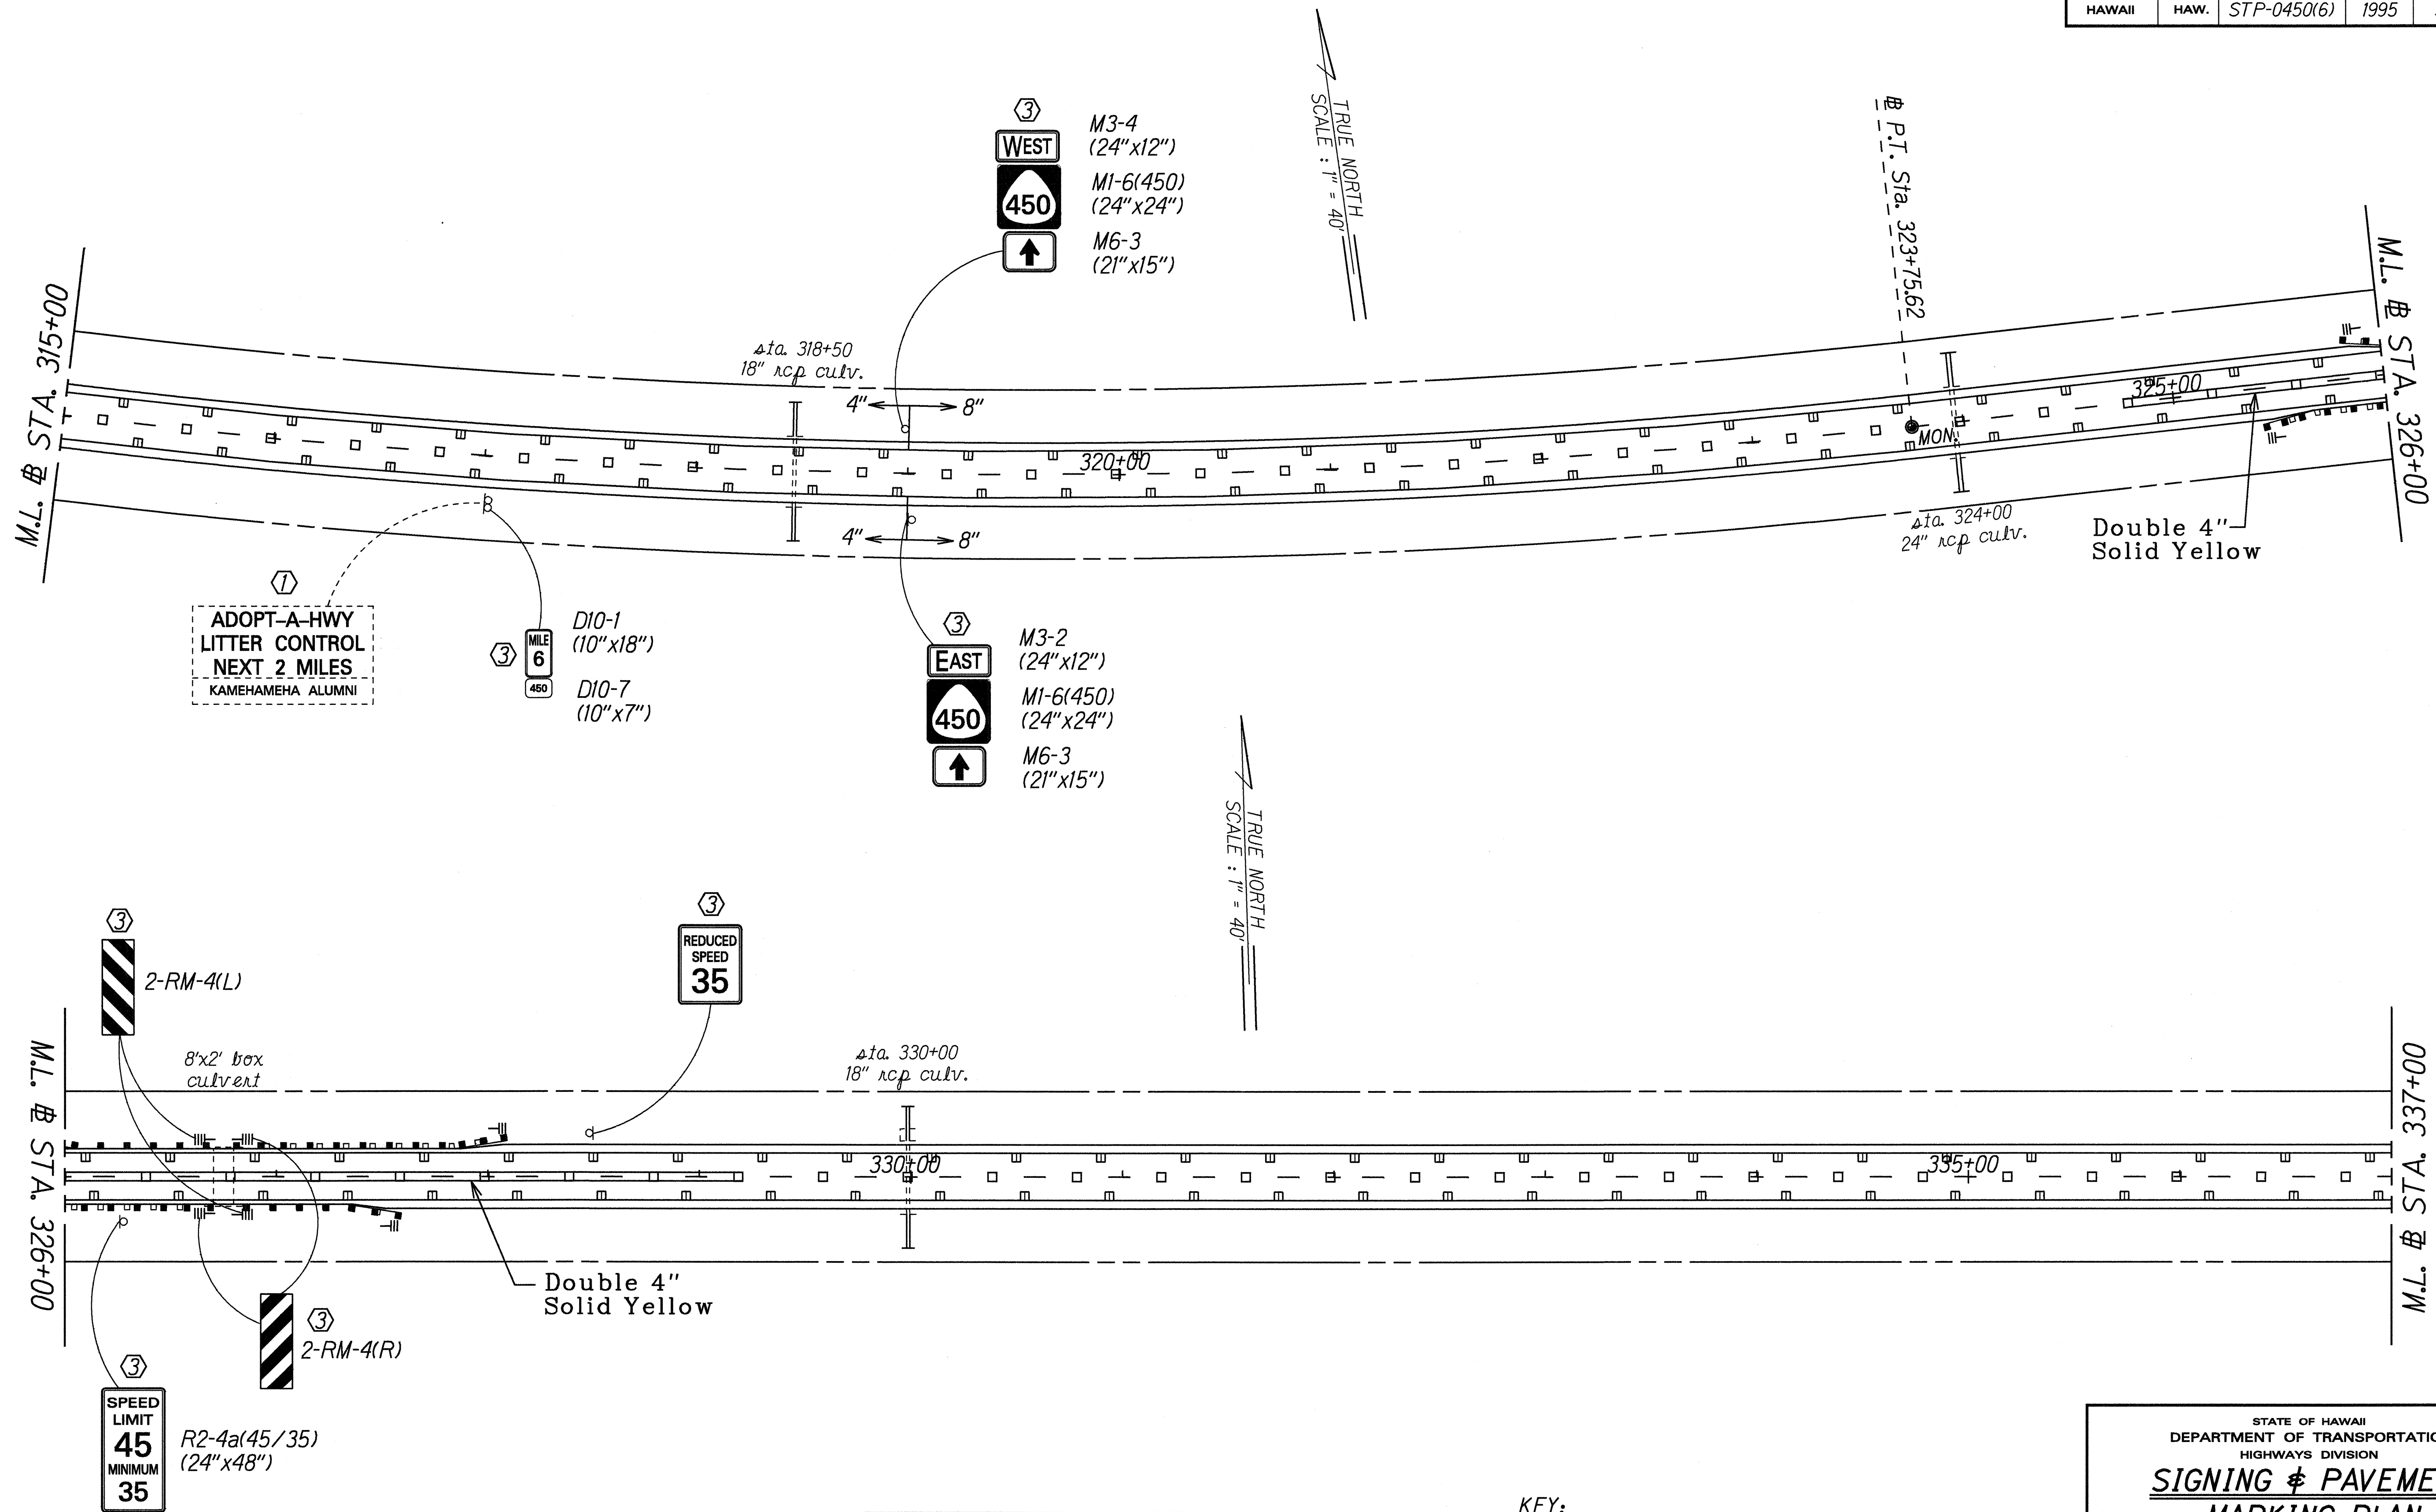


ORIGINAL PLAN	DATE
SURVEY PLOTTED BY	April, 1995
DRAWN BY	
DESIGNED BY	
NOTED BY	
QUANTITIES BY	
CHECKED BY	

LEGEND FOR AS-BUILT POSTINGS	
	Squiggly line for as-built deletion
	Double line for as-built deletion
Roadway	Text for as-built posting

- KEY:
- ① Exist. Sign(s) & Post(s) to Remain
 - ② Remove Exist. Sign(s) & Post(s)
 - ③ Remove Exist. & Install New Sign(s) & Post(s)
 - ④ Install New Sign(s) & Post(s)

STATE OF HAWAII
DEPARTMENT OF TRANSPORTATION
HIGHWAYS DIVISION
SIGNING & PAVEMENT MARKING PLAN
KAMEHAMEHA V HIGHWAY RESURFACING
Kamiloloa Bridge to Kapuokoolau
Federal-Aid Project No. STP-0450(6)
Scale: 1"= 40' Date: April, 1995
SHEET No. 11 OF 13 SHEETS

FED. ROAD DIST. NO.	STATE	FED. AID PROJ. NO.	FISCAL YEAR	SHEET NO.	TOTAL SHEETS
HAWAII	HAW.	STP-0450(6)	1995	35	39

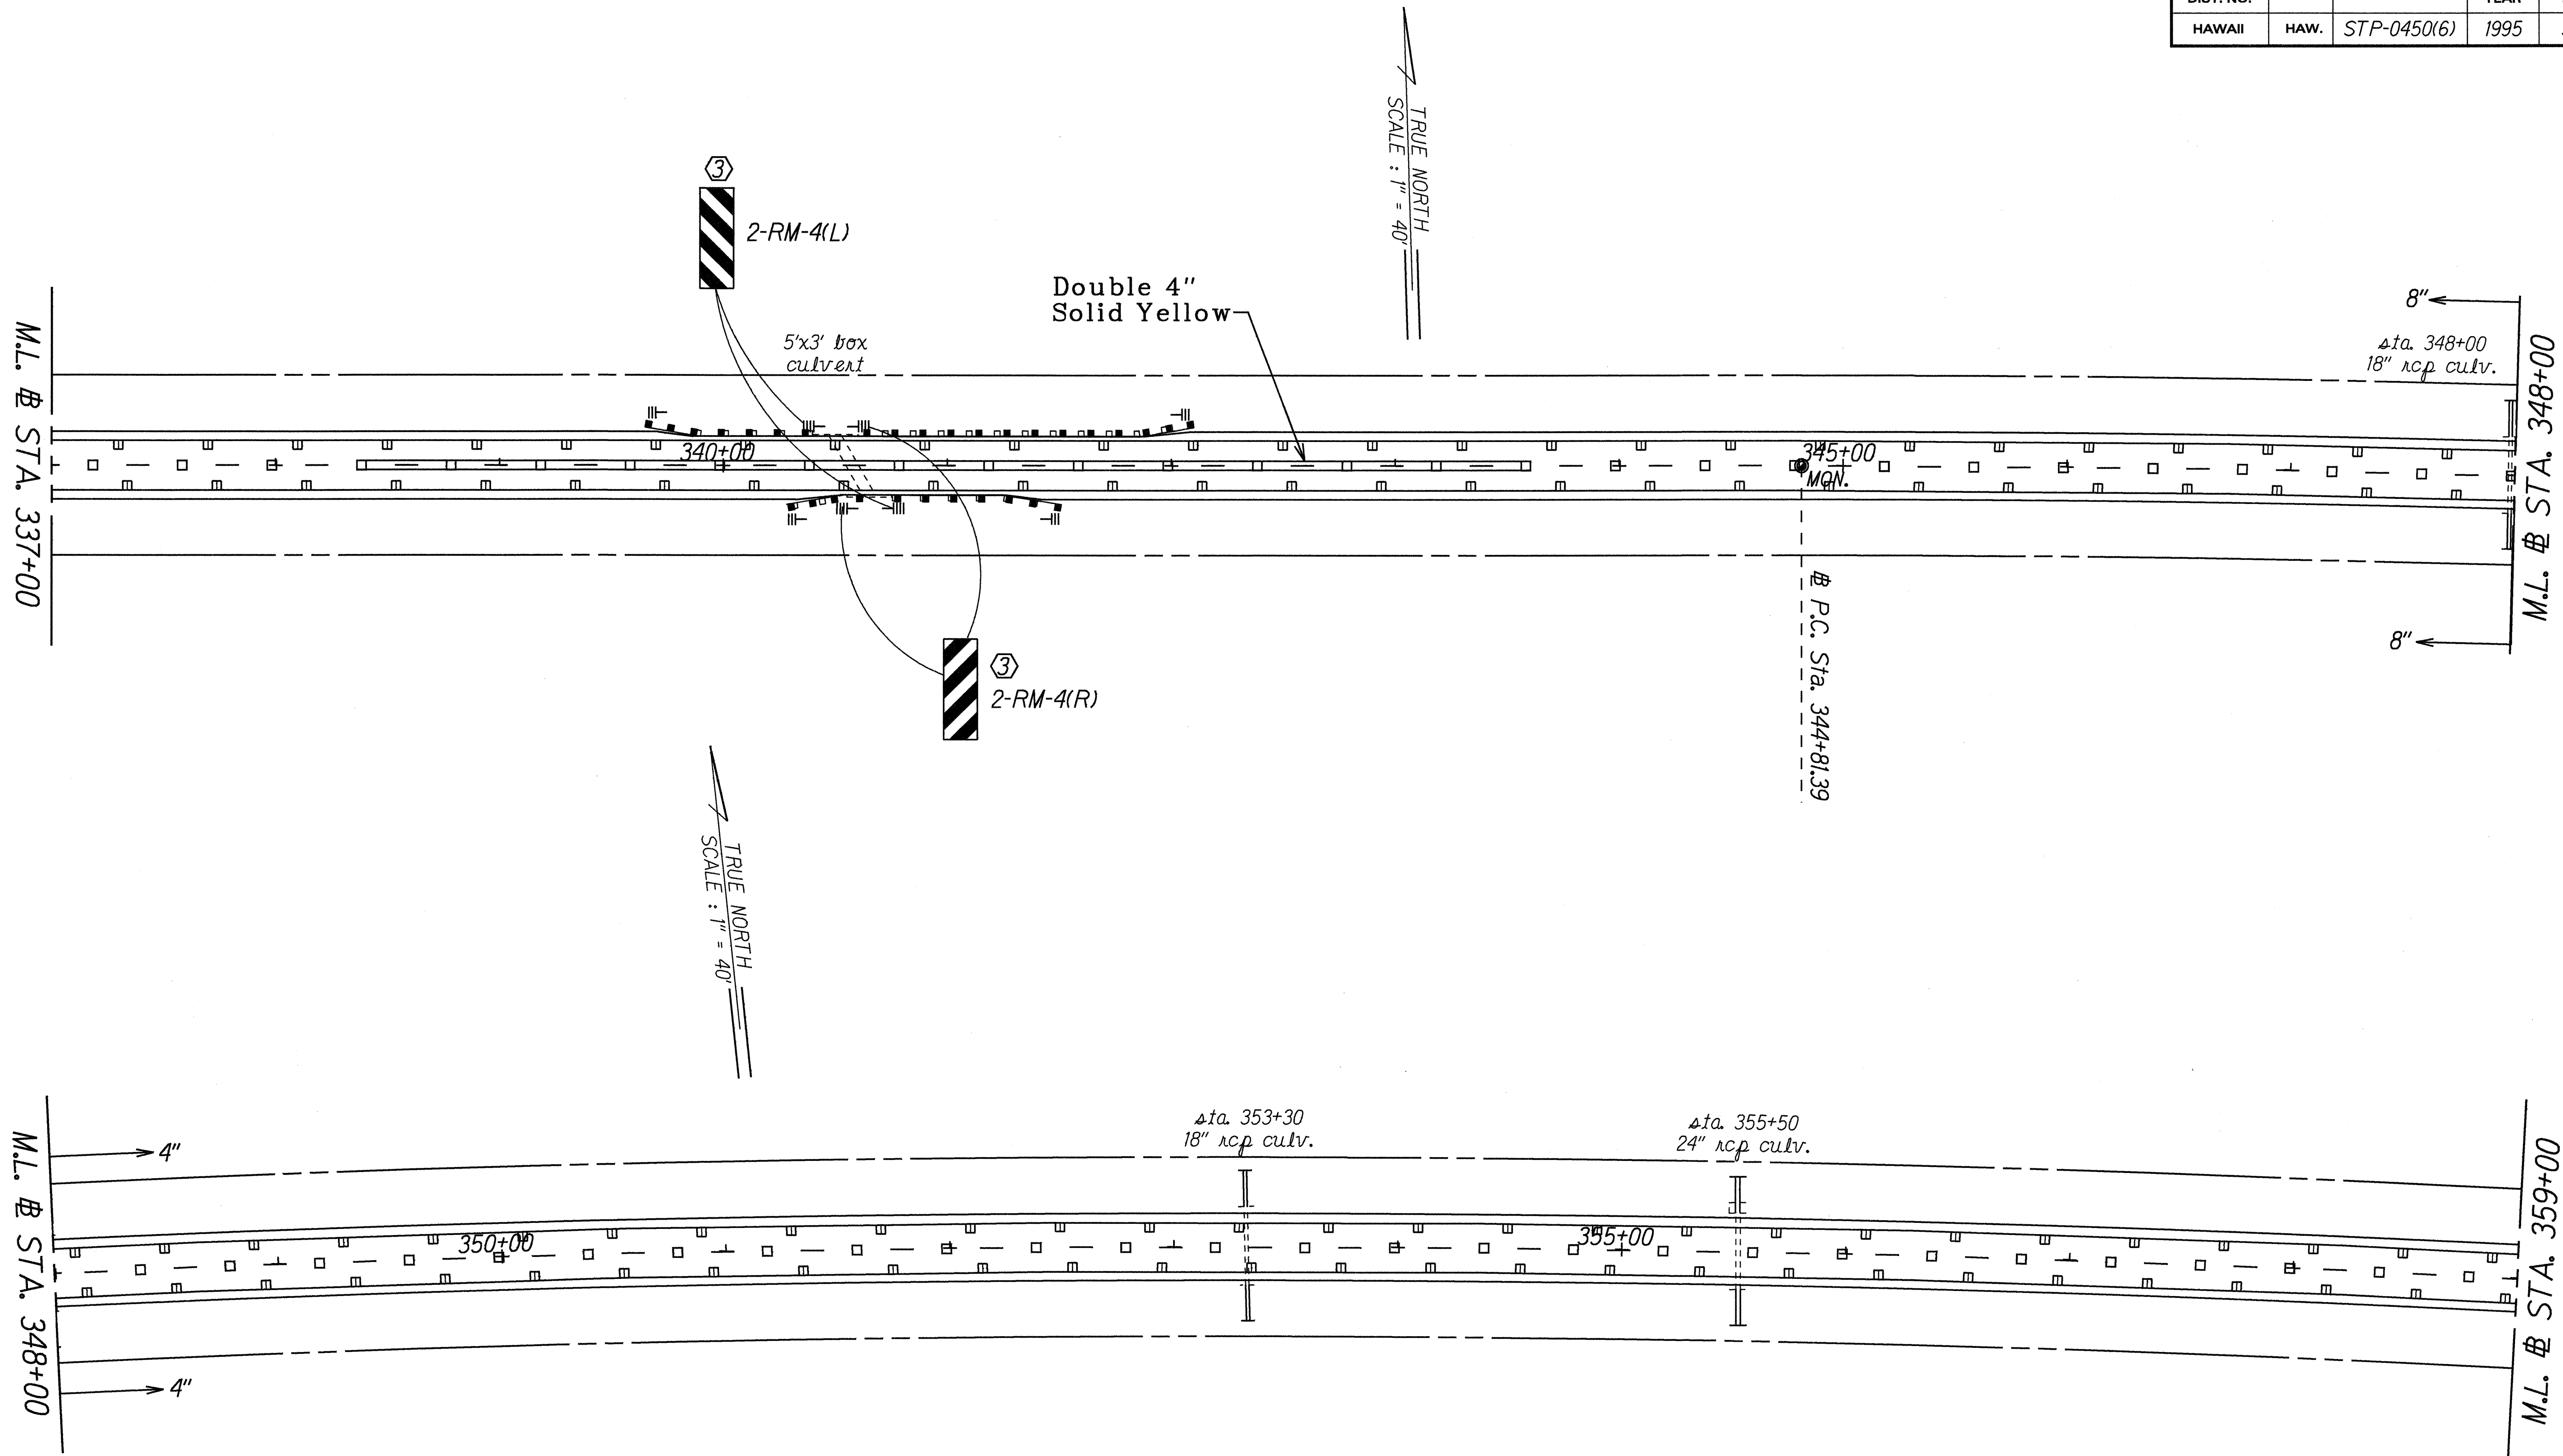

DATE	APRIL 1995
DESIGNED BY	C. HAGASA
CHECKED BY	
QUANTITIES BY	
NOTED BY	
ORIGINAL PLAN	

LEGEND FOR AS-BUILT POSTINGS	
	Squiggly line for as-built deletion
	Double line for as-built deletion
Roadway	Text for as-built posting


- KEY:
- ① Exist. Sign(s) & Post(s) to Remain
 - ② Remove Exist. Sign(s) & Post(s)
 - ③ Remove Exist. & Install New Sign(s) & Post(s)
 - ④ Install New Sign(s) & Post(s)

STATE OF HAWAII
DEPARTMENT OF TRANSPORTATION
HIGHWAYS DIVISION


**SIGNING & PAVEMENT
MARKING PLAN**
KAMEHAMEHA V HIGHWAY RESURFACING
Kamiloloa Bridge to Kapuokoolau
Federal-Aid Project No. STP-0450(6)
Scale: 1"= 40' Date: April, 1995

SHEET No. 12 OF 13 SHEETS

FED. ROAD DIST. NO.	STATE	FED. AID PROJ. NO.	FISCAL YEAR	SHEET NO.	TOTAL SHEETS
HAWAII	HAW.	STP-0450(6)	1995	36	39

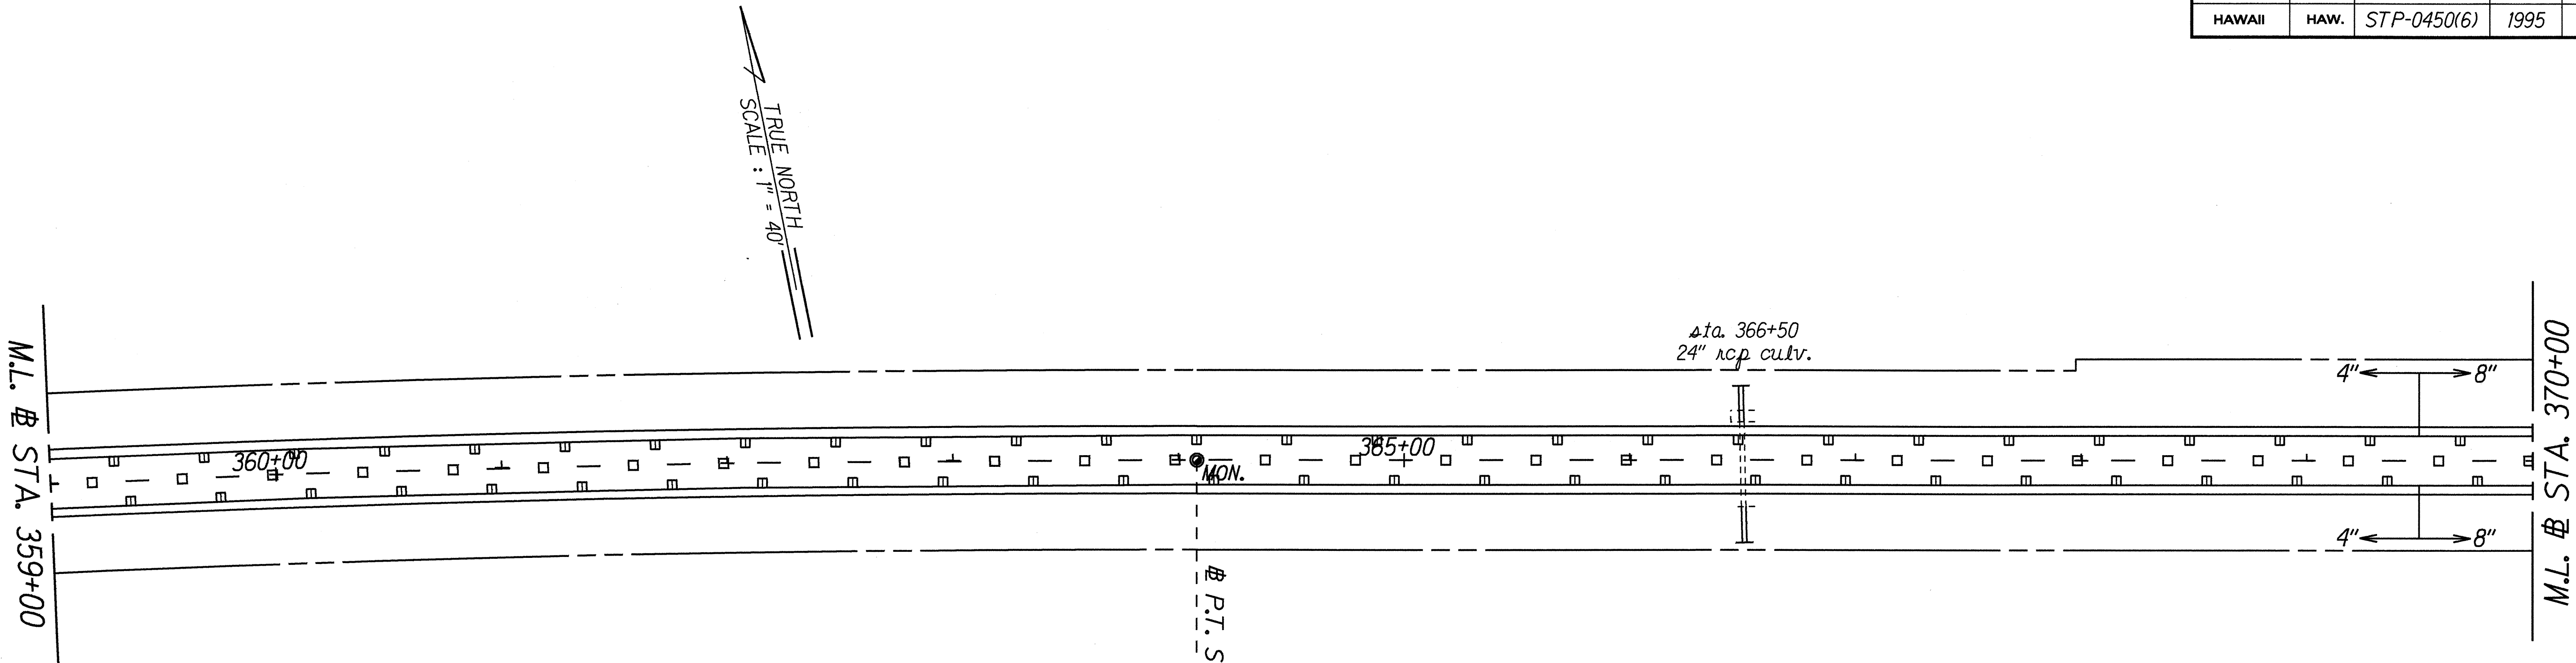

END PROJECT
Project No. STP-0450(6)
Sta. 377+80

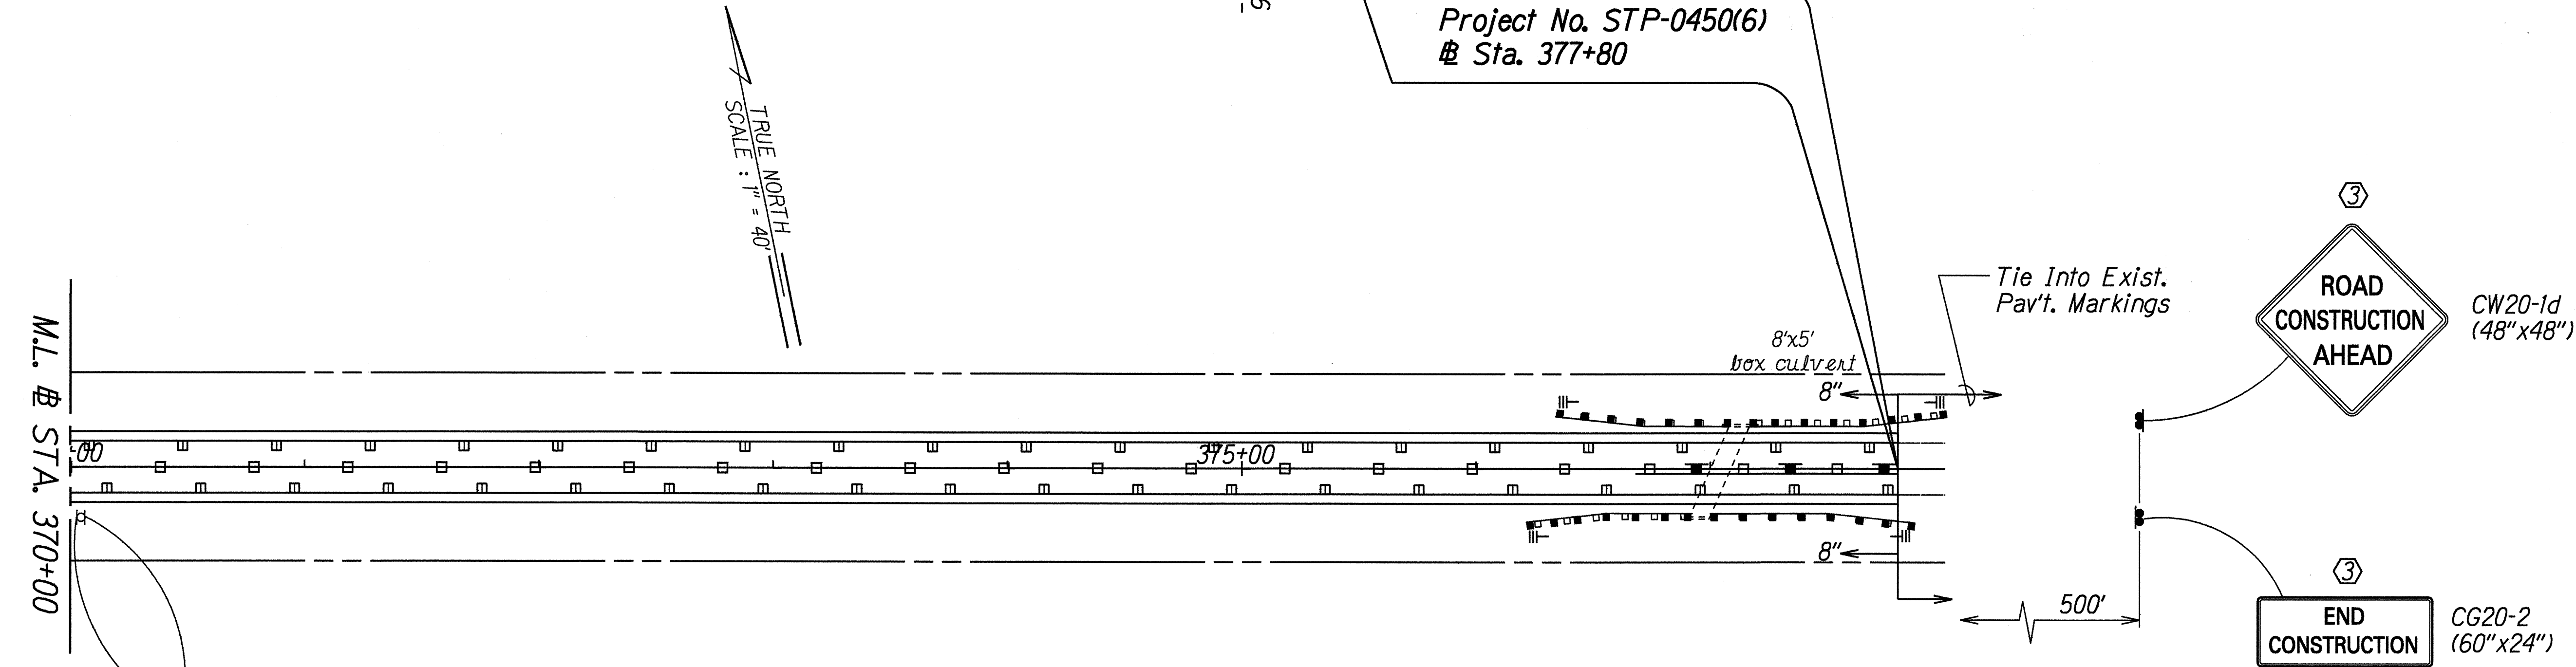

③ MILE 7 (10" x 18")
③ MILE 7 (10" x 7")

- KEY:
- ① Exist. Sign(s) & Post(s) to Remain
 - ② Remove Exist. Sign(s) & Post(s)
 - ③ Remove Exist. & Install New Sign(s) & Post(s)
 - ④ Install New Sign(s) & Post(s)

STATE OF HAWAII
DEPARTMENT OF TRANSPORTATION
HIGHWAYS DIVISION

SIGNING & PAVEMENT
MARKING PLAN

KAMEHAMEHA V HIGHWAY RESURFACING
Kamiloloa Bridge to Kapuokoolau
Federal-Aid Project No. STP-0450(6)
Scale: 1"= 40' Date: April, 1995

ORIGINAL PLAN	SURVEY PLOTTED BY	DATE
APR 1995	APR 1995	APR 1995
DESIGNED BY C. B. BAKER	DRAWN BY J. GUERIN	CHECKED BY
QUANTITIES BY		
CHECKED BY		