		INDEX TO DRAWINGS
	SHEET NO.	DESCRIPTION
	1	TITLE SHEET
	2	STANDARD PLANS SUMMARY
	3	GENERAL NOTES
	4 – 5	TYPICAL SECTIONS AND DETAILS
	6 – 11	ROADWAY PLANS
	12	PAVEMENT MARKING LEGEND,
		DETAILS & NOTES
	13	MISCELLANEOUS DETAILS
	14	MISCELLANEOUS SUMMARIES
		·
,		

STATE OF HAWAII

## DEPARTMENT OF TRANSPORTATION


HIGHWAYS DIVISION HONOLULU, HAWAII

"AS-BUILT"

## PLANS FOR KAMEHAMEHA V HIGHWAY RESURFACING


PUU-O-HOKU RANCH TO HALAWA BAY PROJECT NO. 450B-01-92M


> DISTRICT OF MOLOKAI ISLAND OF MOLOKAI

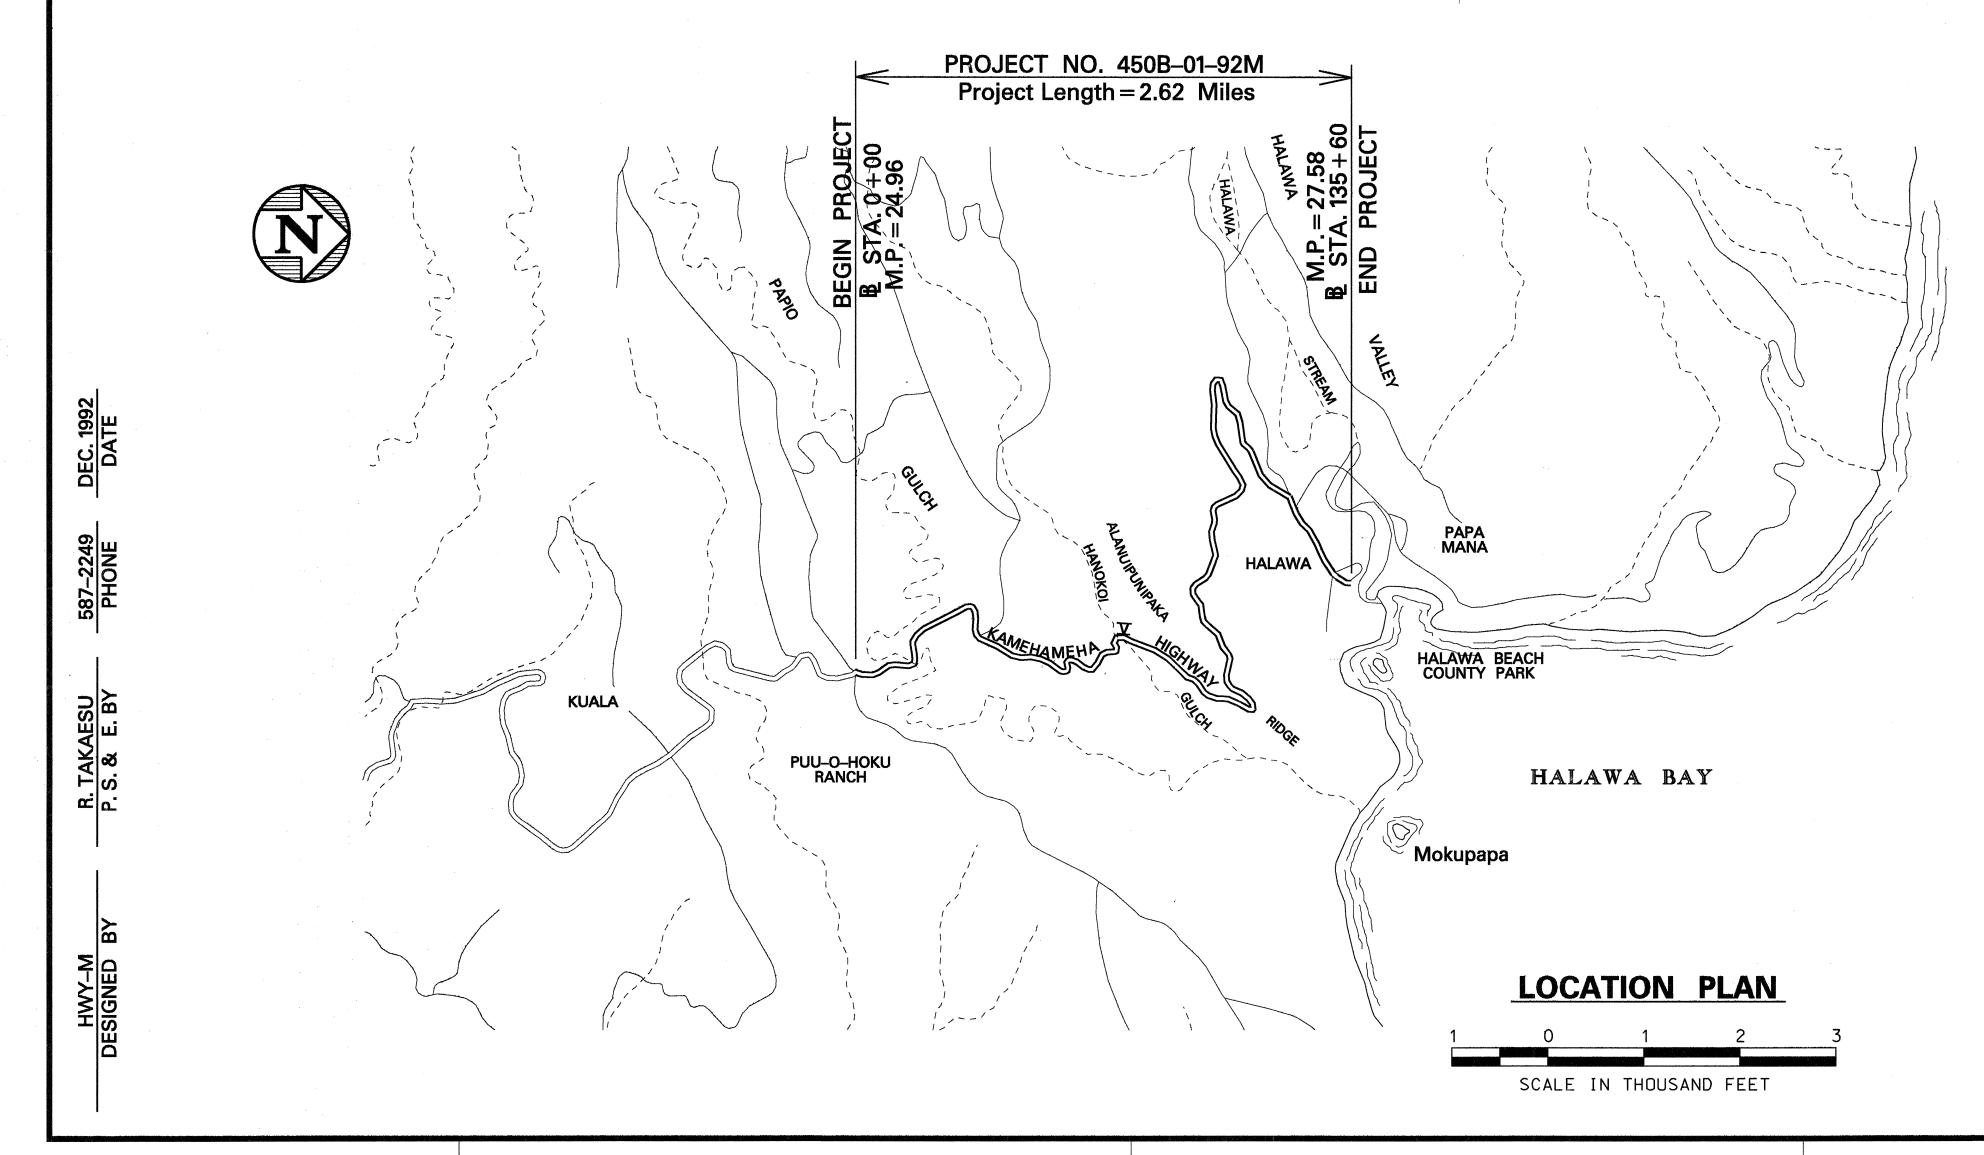

FED. ROAD DIST. NO. PROJ. NO. 450B-01-92M



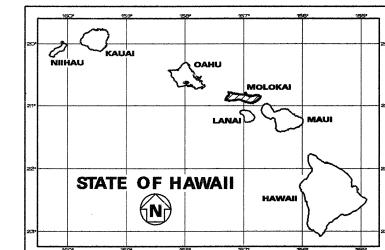

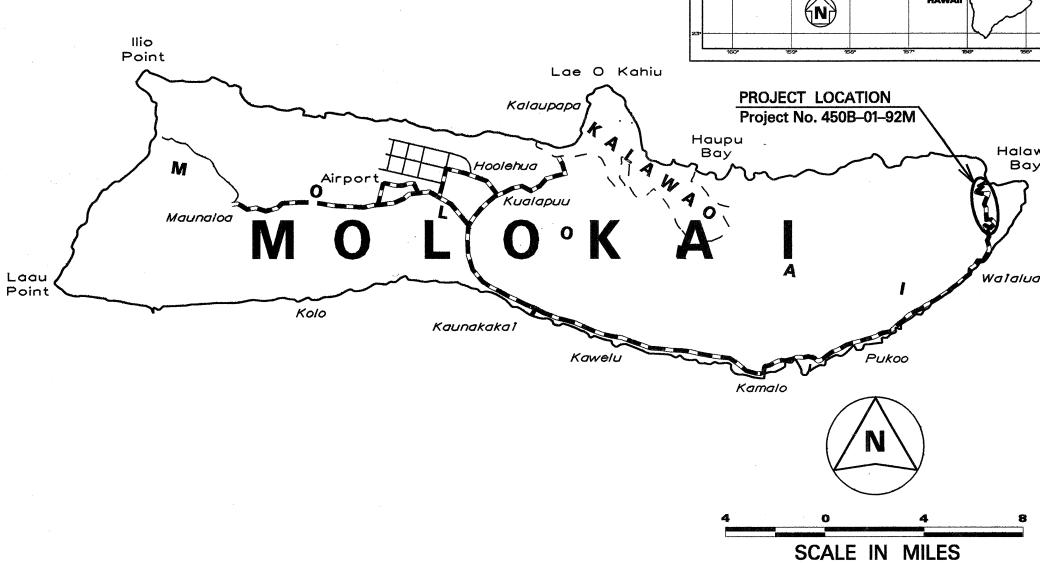

. AID PROJECTS PREVIOUSLY CONSTRUCTED OR UNDER CONSTRUCTION

MILE POST 24.96 TO MILE POST 27.58

CHANGES MADE DURING CONSTRUCTION HAVE BEEN INCORPORATED ON THESE PLANS EXCEPT CHANGES IN THE ORIGINAL THEORETICAL QUANTITIES. FOR ACTUAL QUANTITIES, REFER TO PROJECT LEDGER AND/OR COMPUTATION BOOK.

RESIDENT ENGINEER

**DEPARTMENT OF TRANSPORTATION** STATE OF HAWAII

**APPROVED:** 

FR DIR. OF TRANSPORTATION

5/19/93

DATE