


FED. ROAD DIST. NO.	STATE	FED. AID PROJ. NO.	FISCAL YEAR	SHEET NO.	TOTAL SHEETS
HAWAII	HAW.	STP-0450(7)	1997	13	13

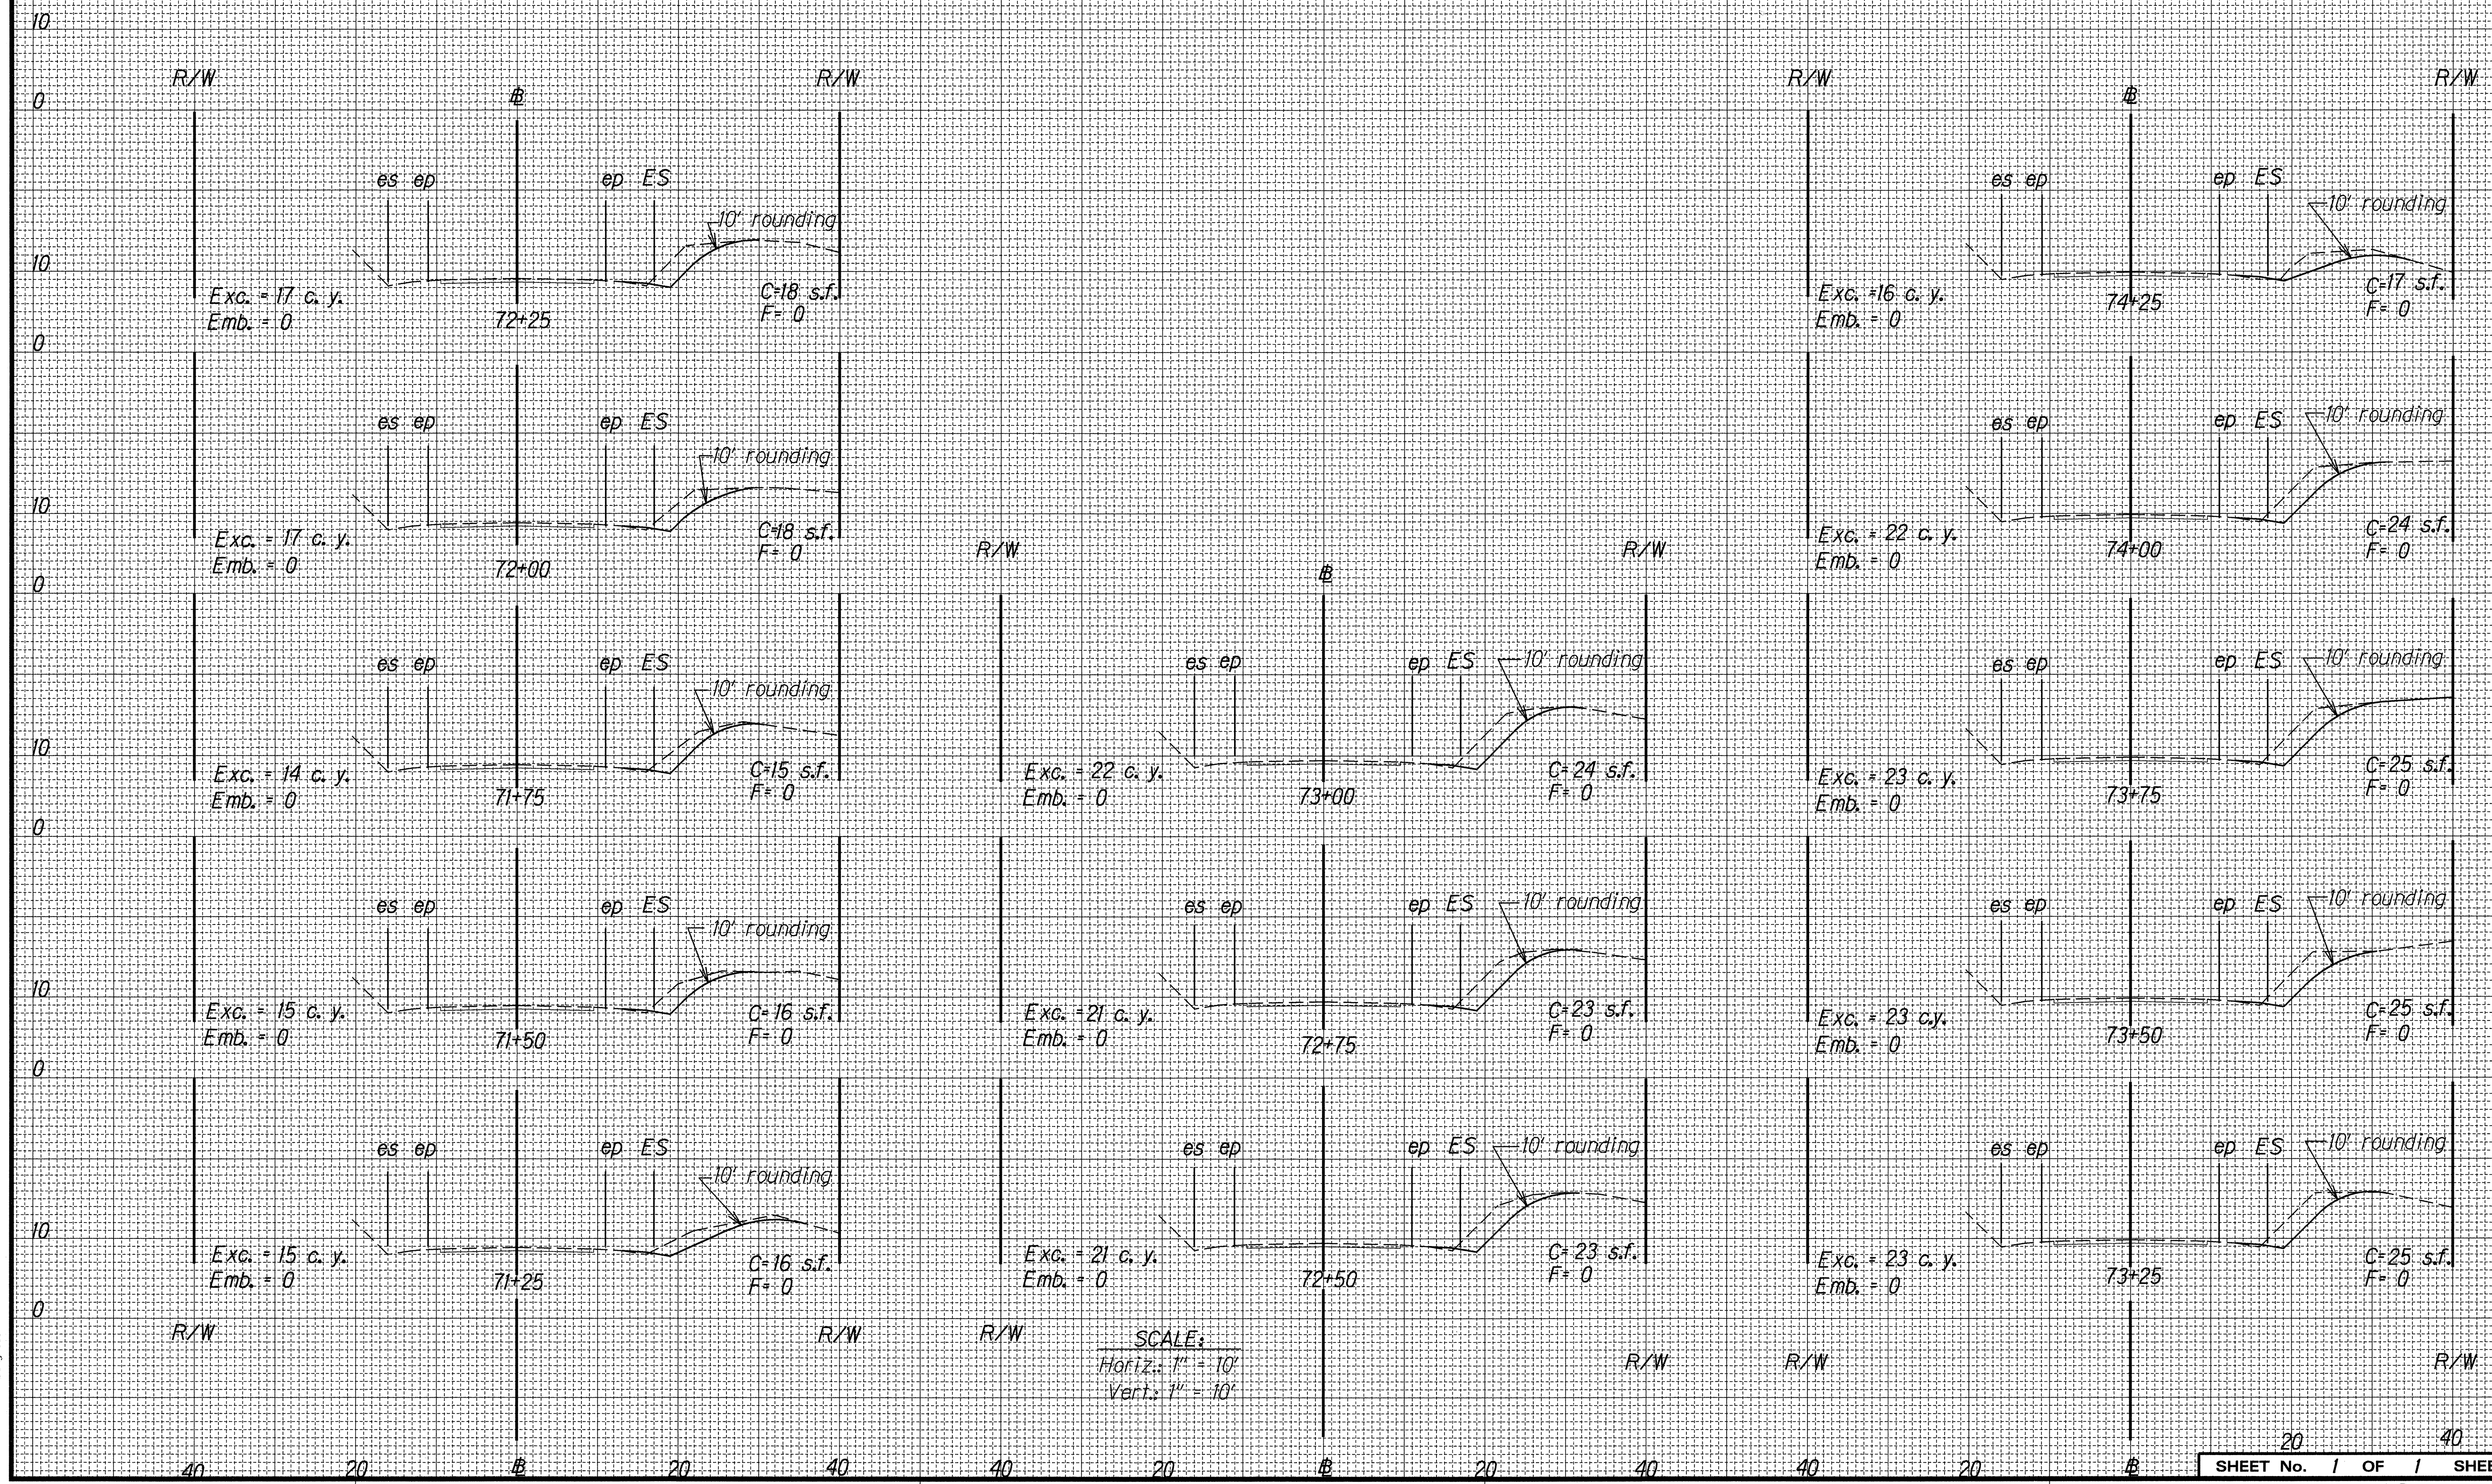

SURVEY PLOTTED BY: DATE: 4-2-97
 DESIGNED BY: L. Maull / m
 CHECKED BY: J. Maull / m
 NOTE: BOOK QUANTITIES BY J. Maull / m
 CHECKED BY: J. Maull / m

SCALE:
 Horiz.: 1" = 10'
 Vert.: 1" = 10'