




FED. ROAD DIST. NO.	STATE	FED. AID PROJ. NO.	FISCAL YEAR	SHEET NO.	TOTAL SHEETS
HAWAII	HAW.	STP-0450(7)	1997	4	13

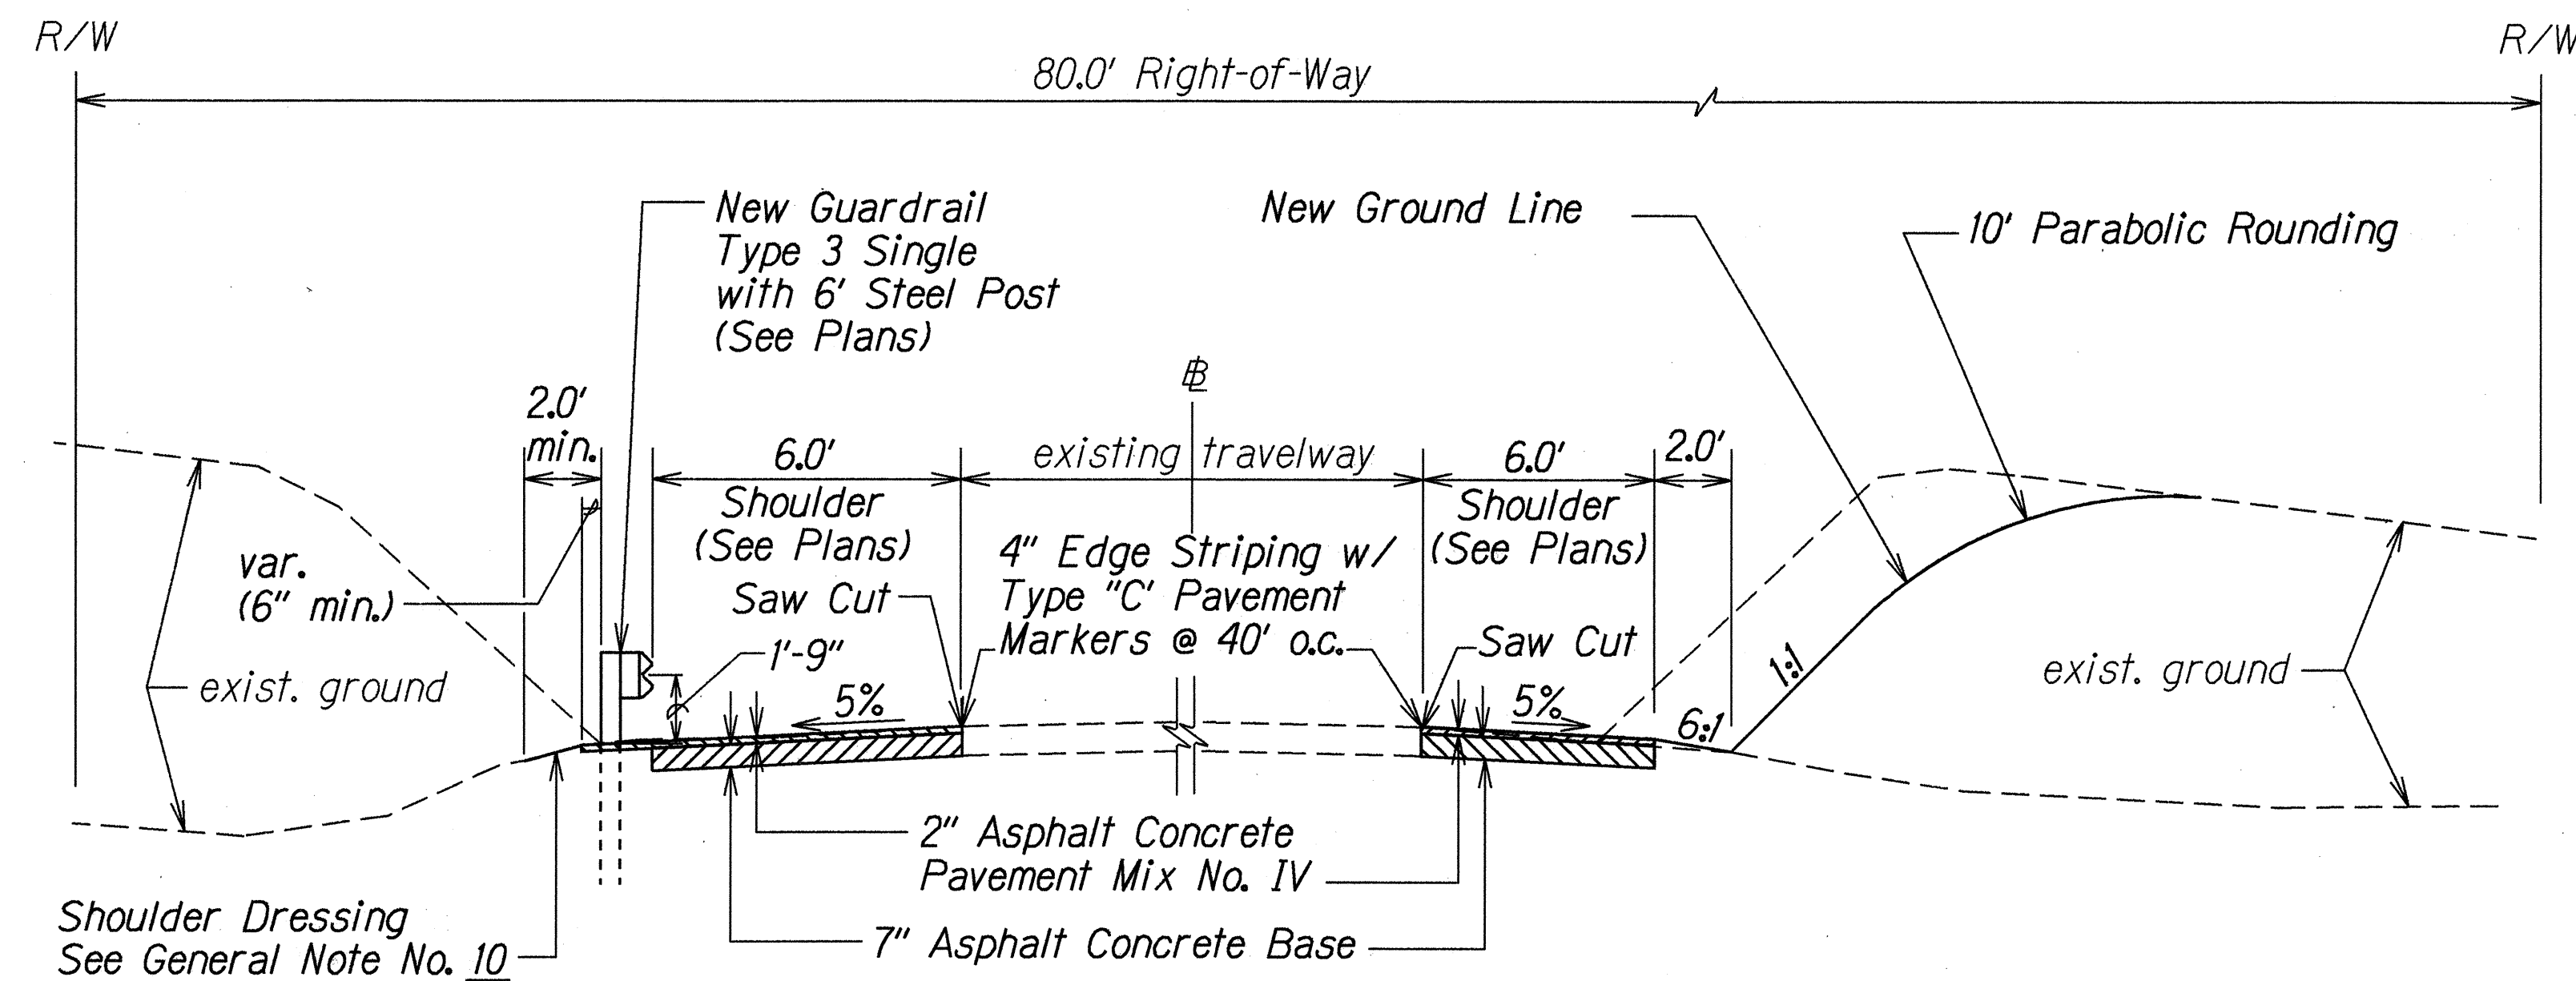

TYPICAL SECTION ON TANGENT
AT Sta. 68+00 to 95+00
 Scale: 1/4"=1'

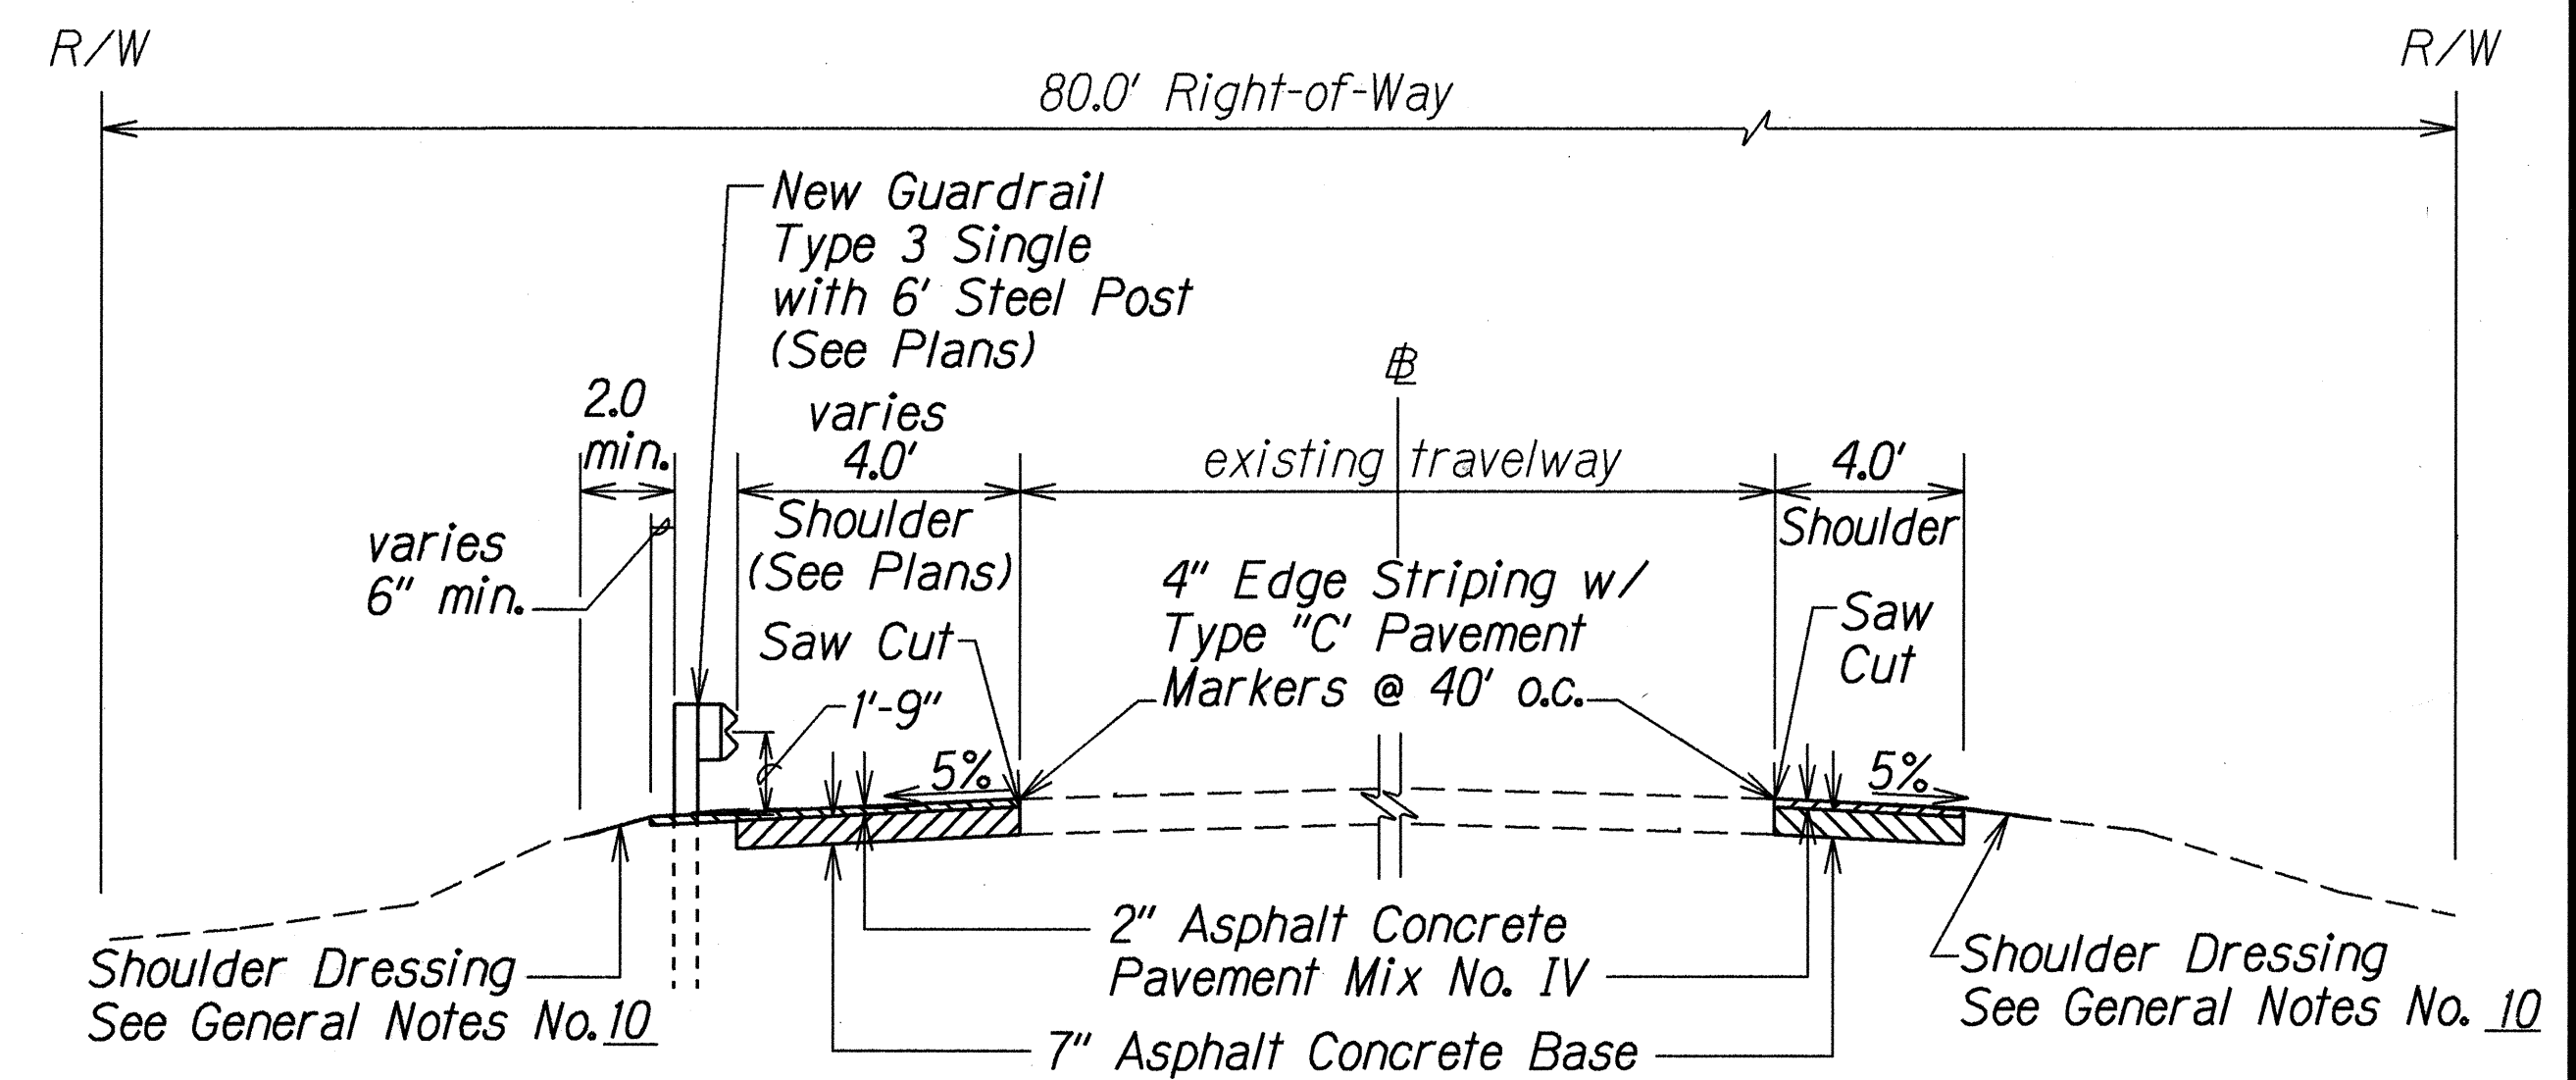

TYPICAL SECTION
Sta. 377+80 to 415+00
 Scale: 1/4"=1'

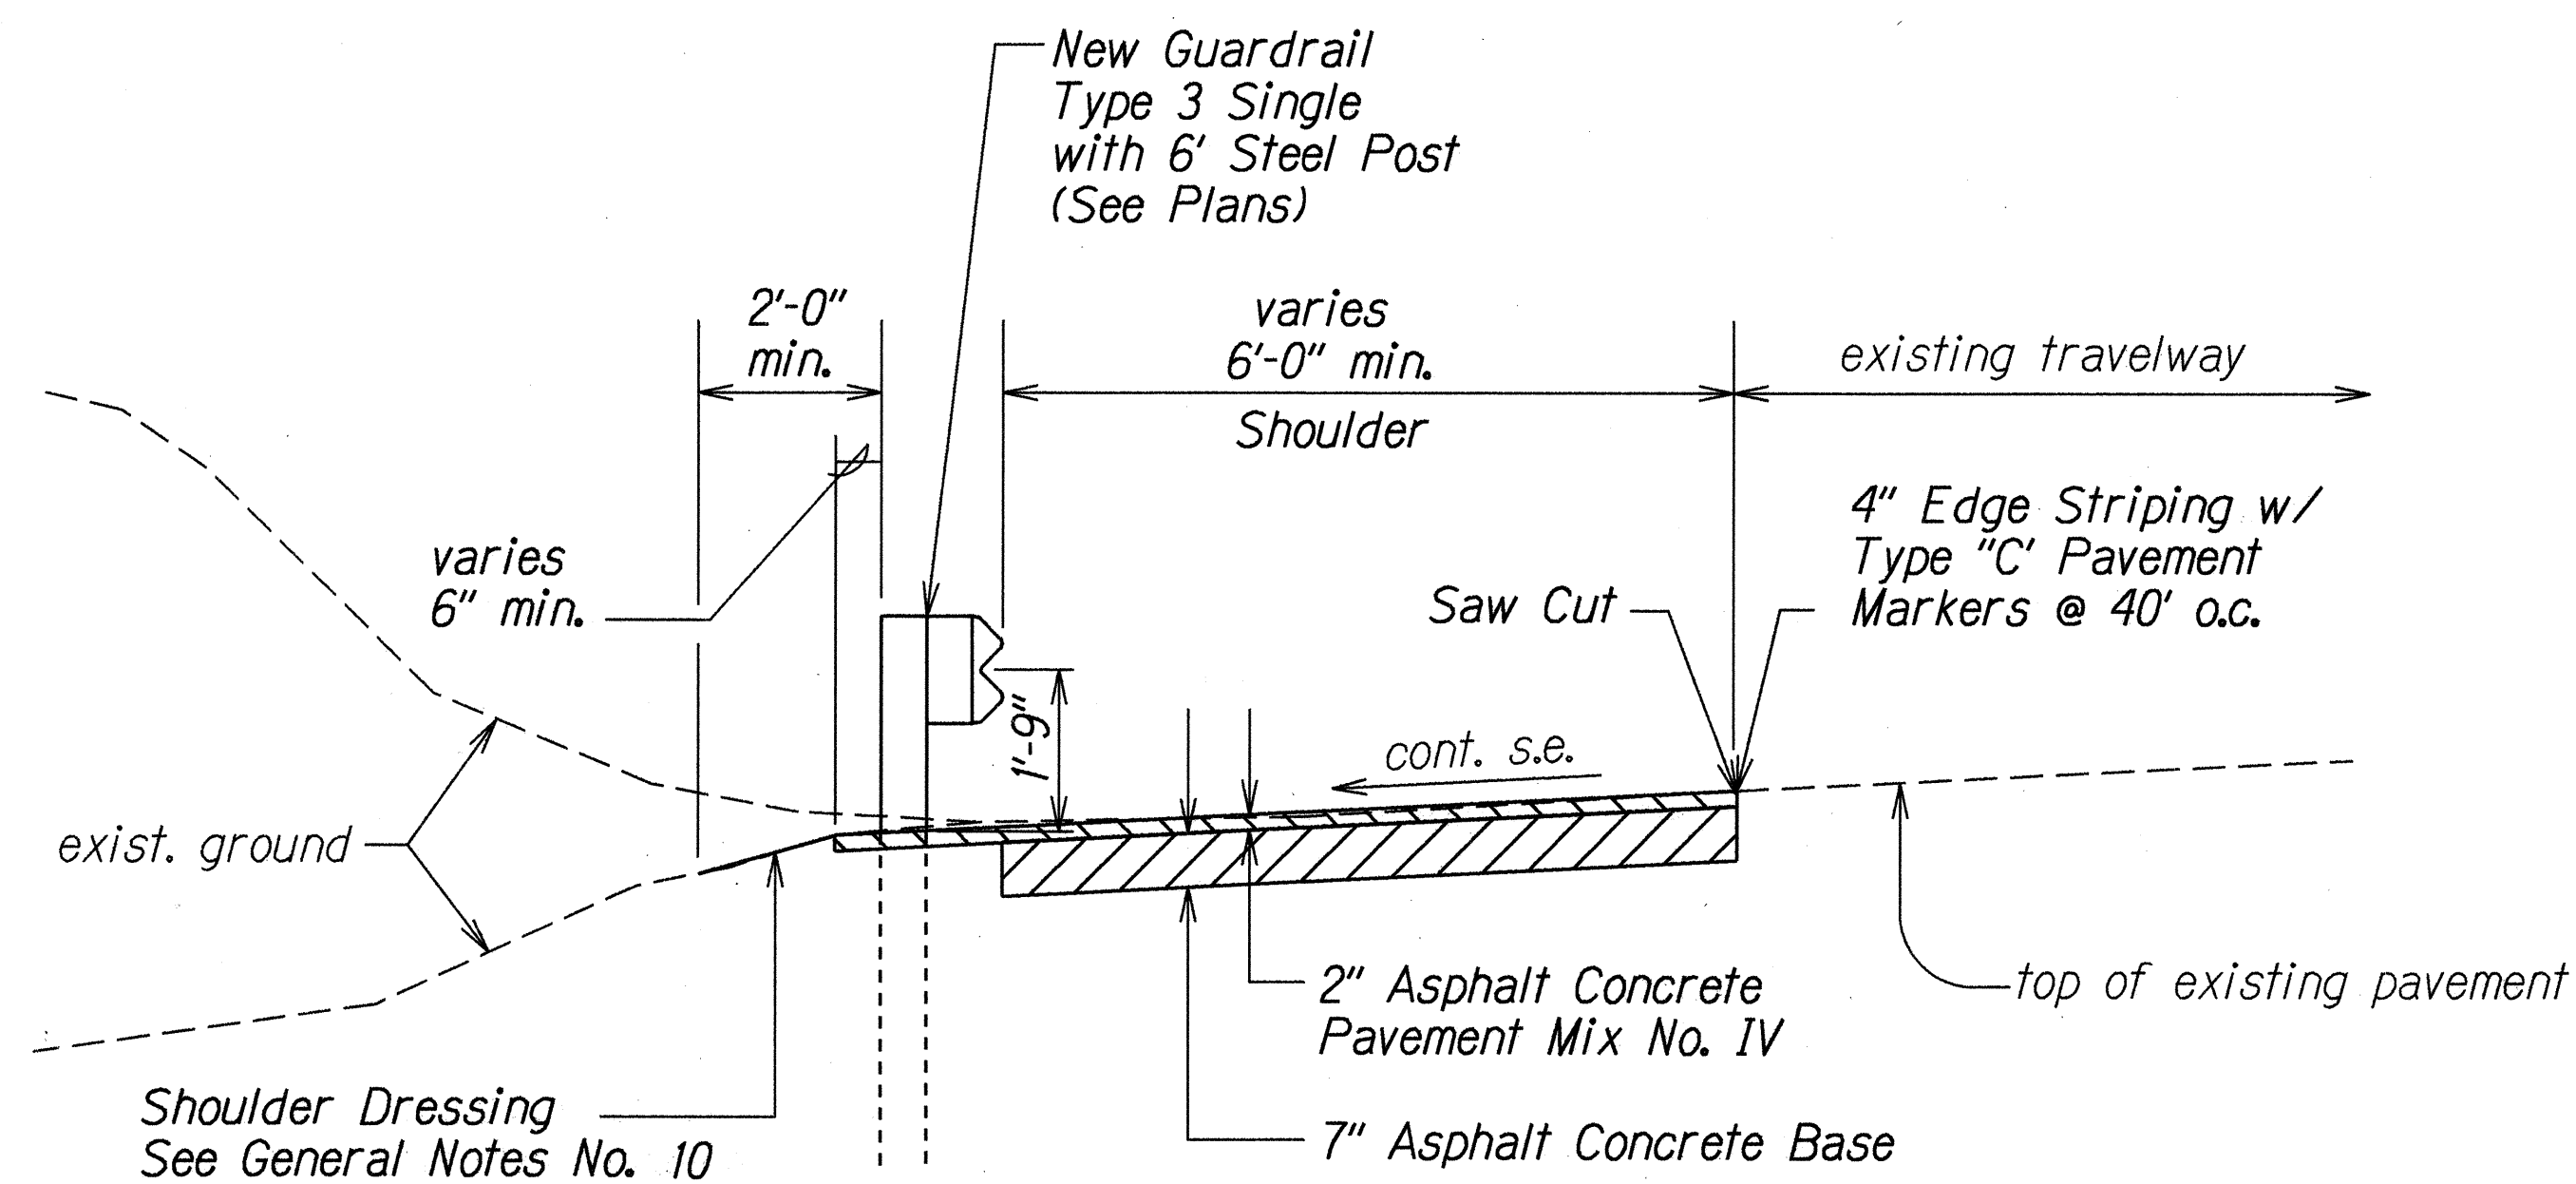

TYPICAL HALF SECTION ON CURVES
Sta. 68+00 to Sta. 95+00
 Scale: 1/2"=1'

DESIGNED BY	DATE
TRACED BY	4-1-97
DESIGNED BY	
TRACED BY	
DESIGNED BY	
TRACED BY	
DESIGNED BY	
TRACED BY	
DESIGNED BY	
TRACED BY	

STATE OF HAWAII
 DEPARTMENT OF TRANSPORTATION
 HIGHWAYS DIVISION

TYPICAL SECTIONS

KAMEHAMEHA V HIGHWAY,
GUARDRAIL & SHOULDER IMPROVEMENTS,
Kamiloloa to Kapuokoolau
Federal Aid Project No. STP-0450(7)

Scale: As Shown Date: March, 1997

SHEET No. 1 OF 1 SHEETS