




FED. ROAD DIST. NO.	STATE	PROJ. NO.	FISCAL YEAR	SHEET NO.	TOTAL SHEETS
HAWAII	HAW.	450AB-01-01M	2001	4	42

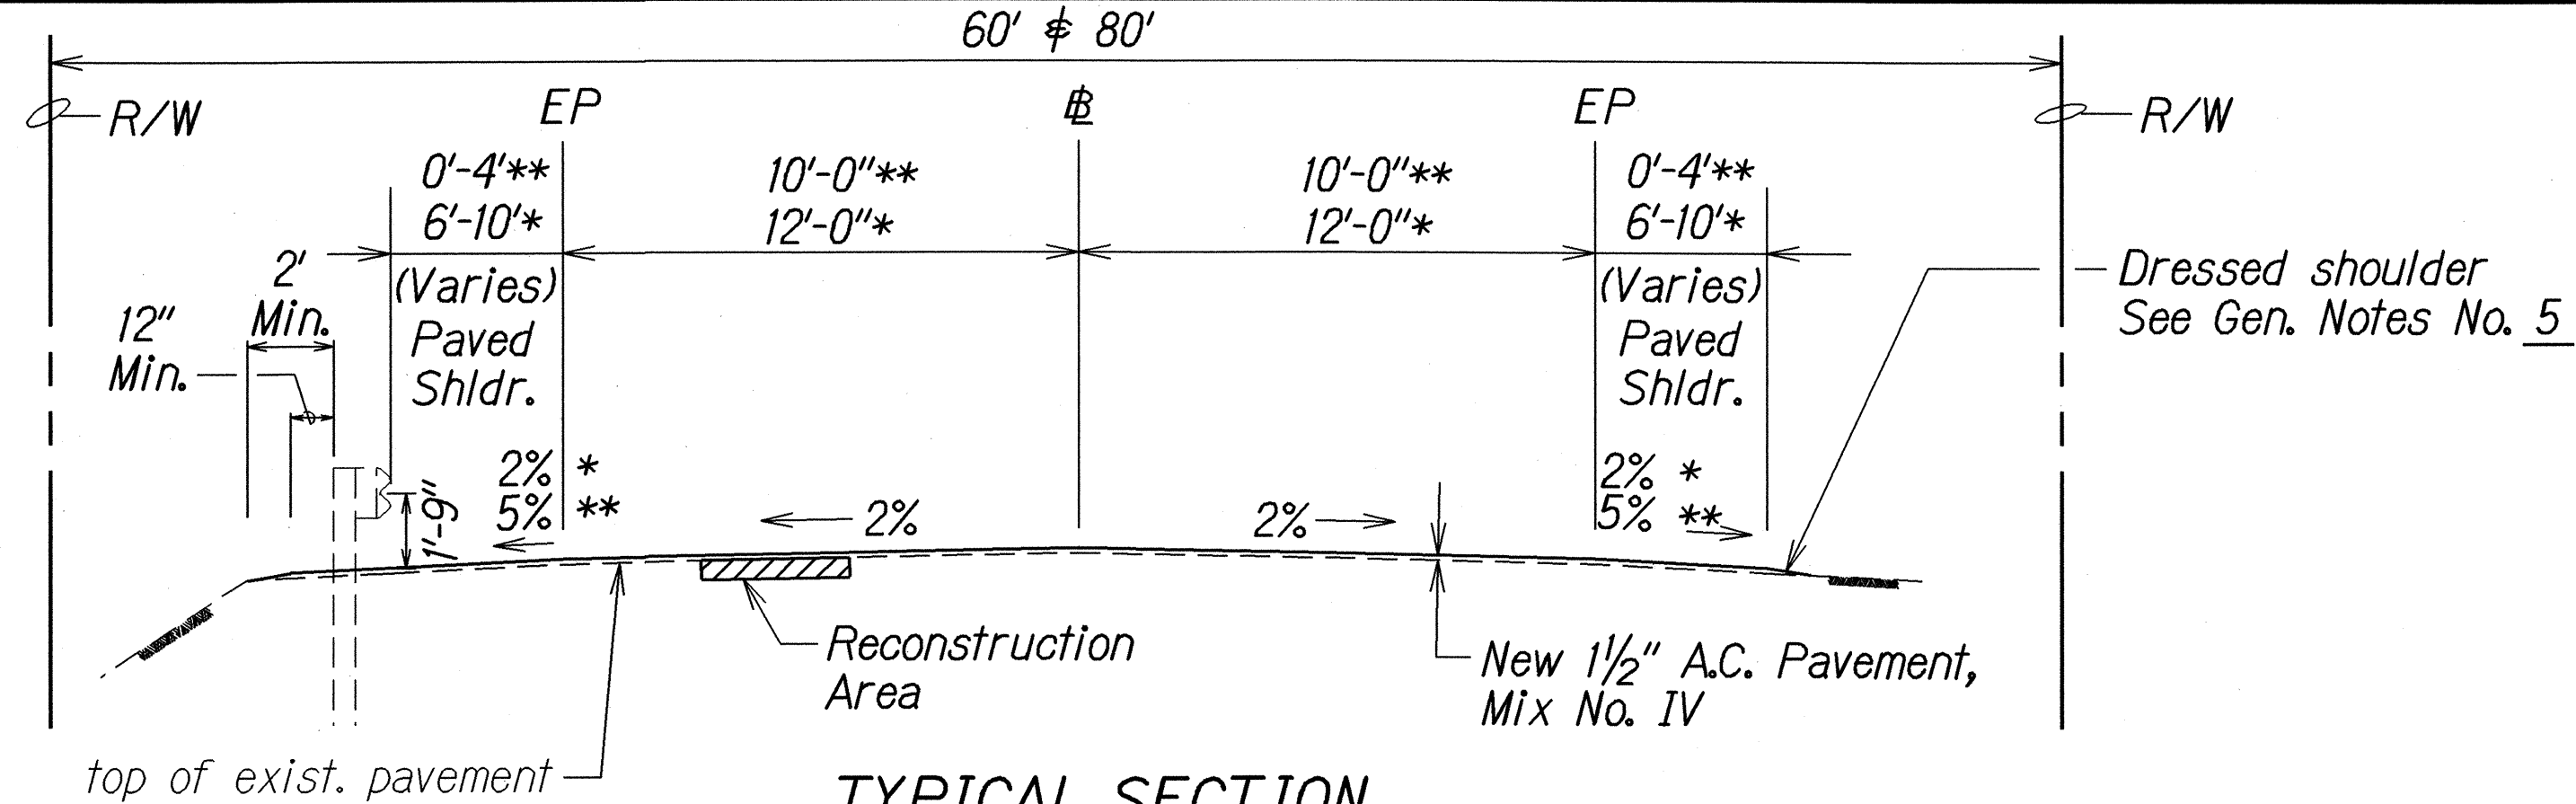

TYPICAL SECTION
 *(WORKSITE #1) STA. 1+00 - STA. 95+00
 **(WORKSITE #2) STA. 377+80 - STA. 169+00
 Scale: 1/4" = 1'-0"

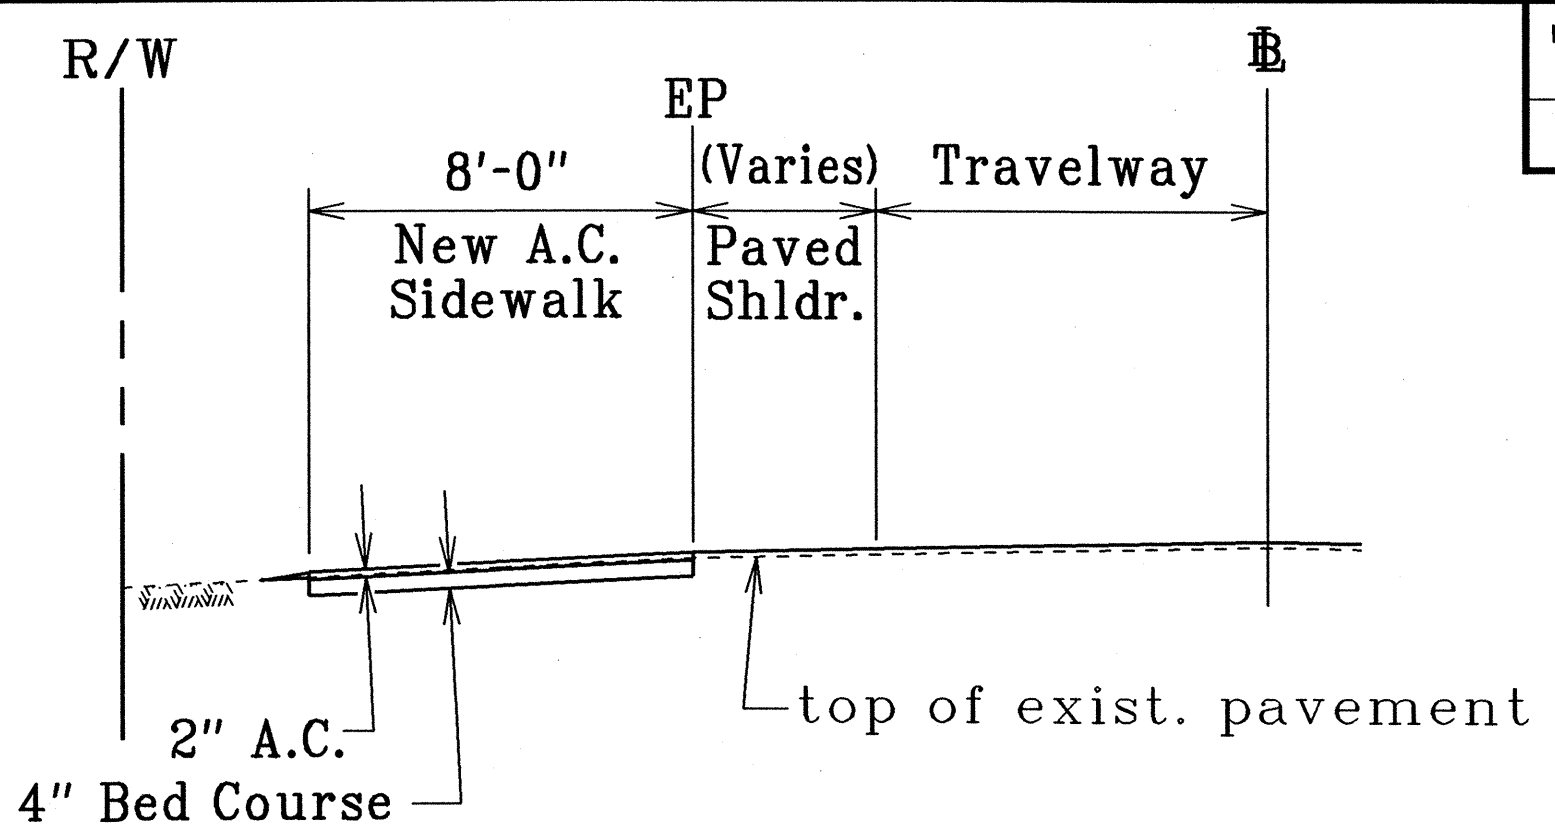


PARTIAL TYPICAL SECTION
 STA. 13+90± TO STA. 54+75±
 Not to Scale

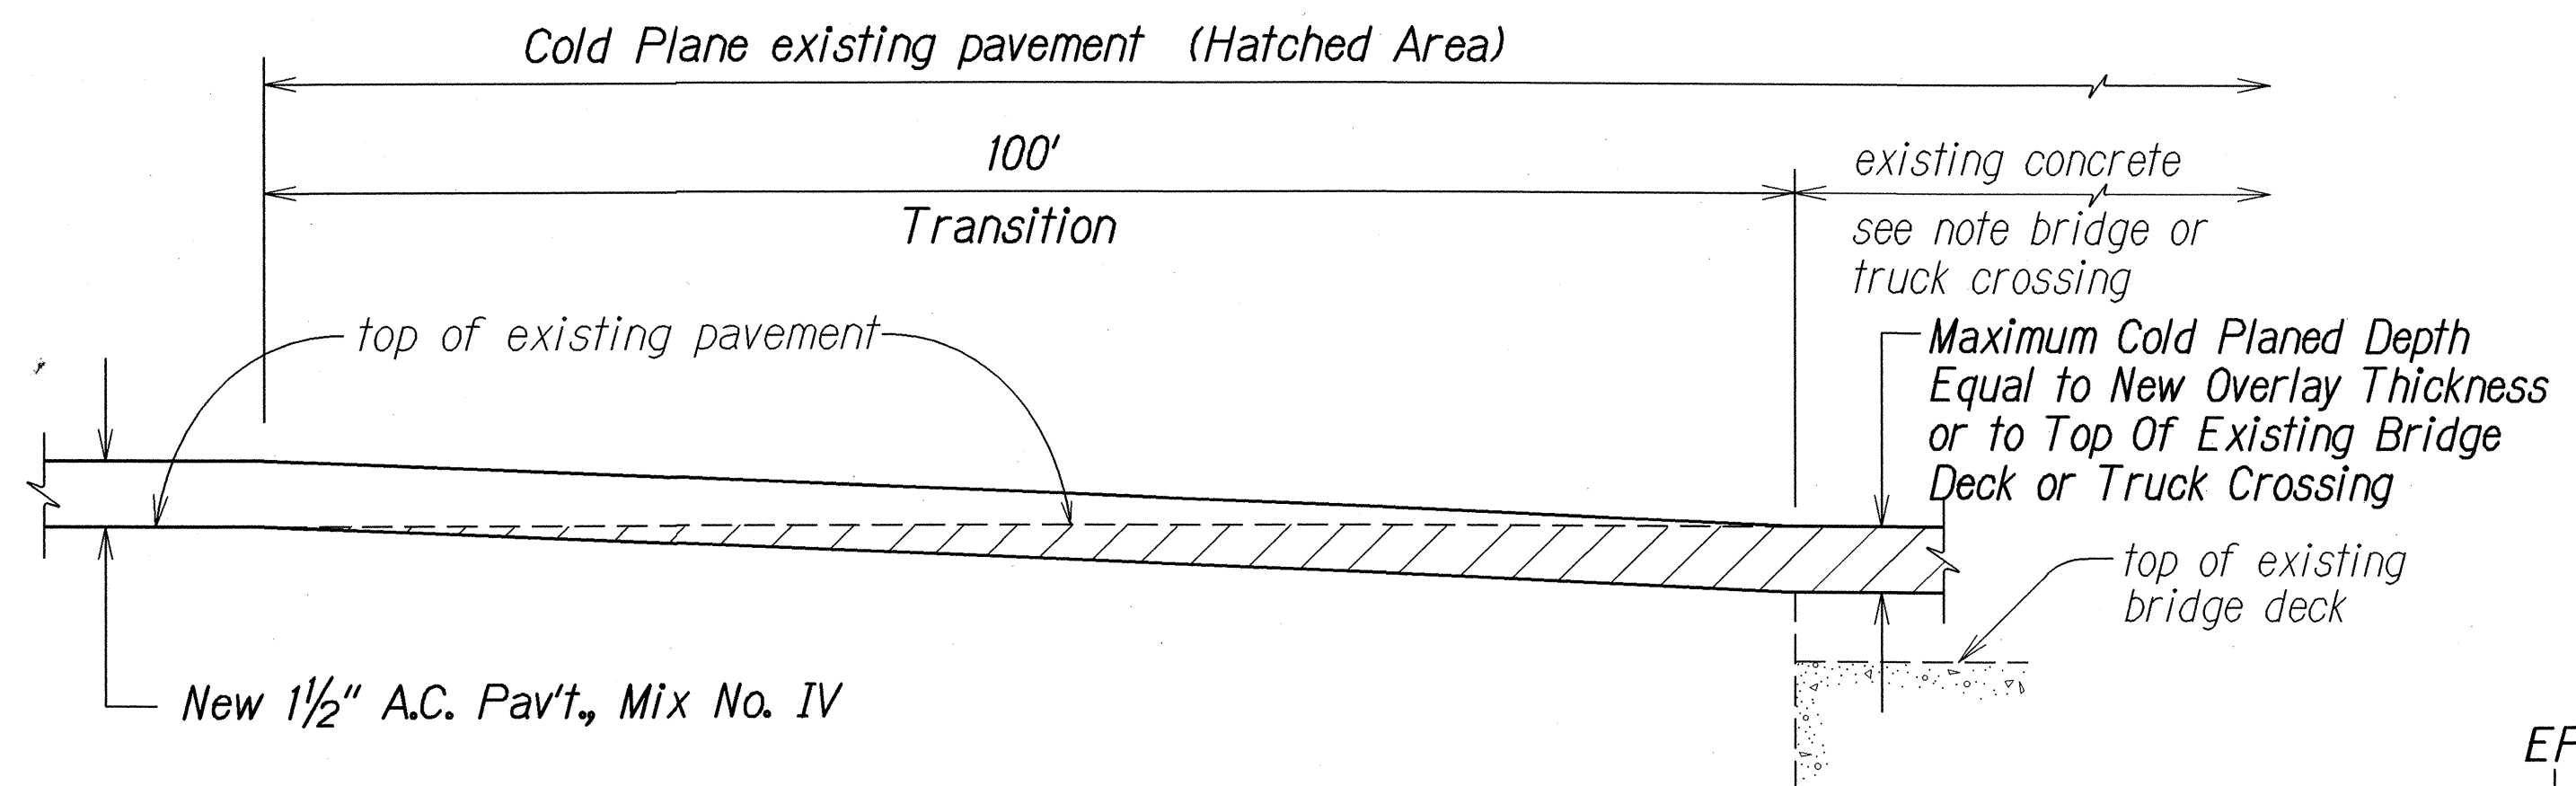


Note: In cold planing the pavement over the structure, the Contractor shall exercise care not to damage any portion of the structure, especially the slab, joints, drainage pipes or reinforcement. Any damage to the structure during the cold planing operations shall be repaired by the Contractor at his expense. Repair work shall be directed by the Engineer. The Contractor shall verify the thickness of the pavement by taking several measurements throughout the structure.


COLD PLANED TRANSITION AND RESURFACING OVER EXISTING STRUCTURE
 Not to Scale

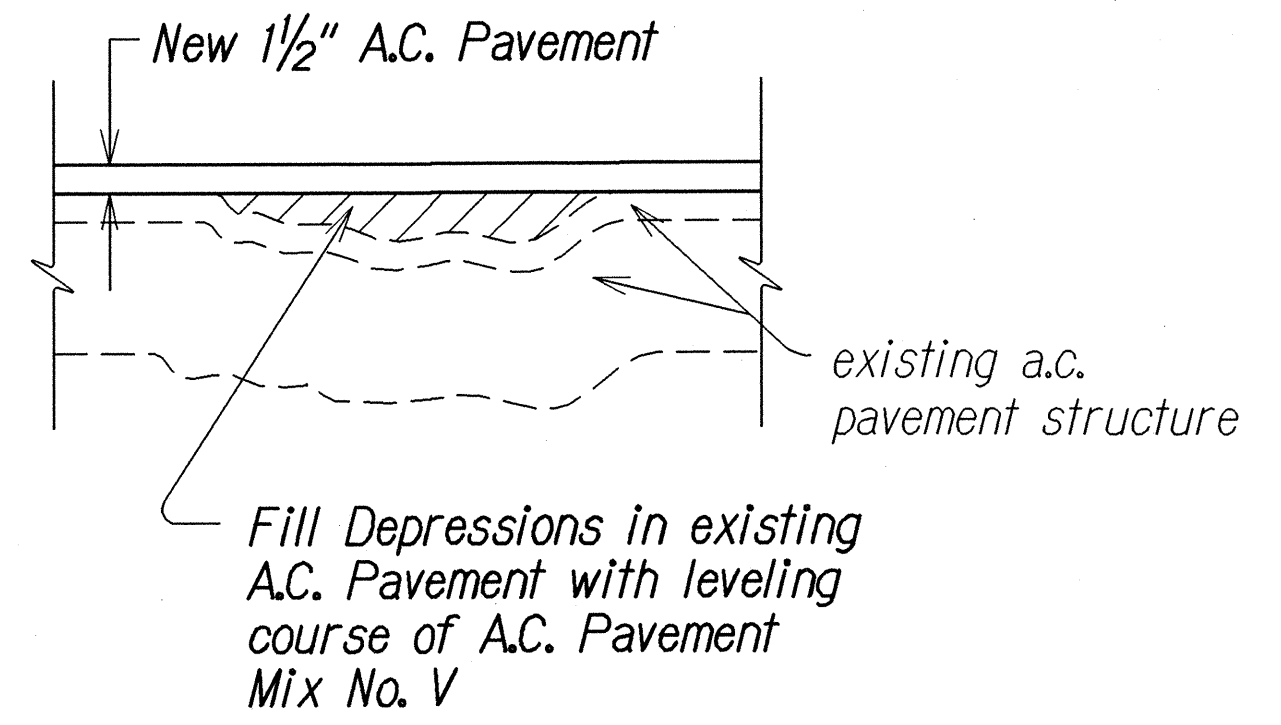


LEVELING COURSE DETAIL
 Not To Scale

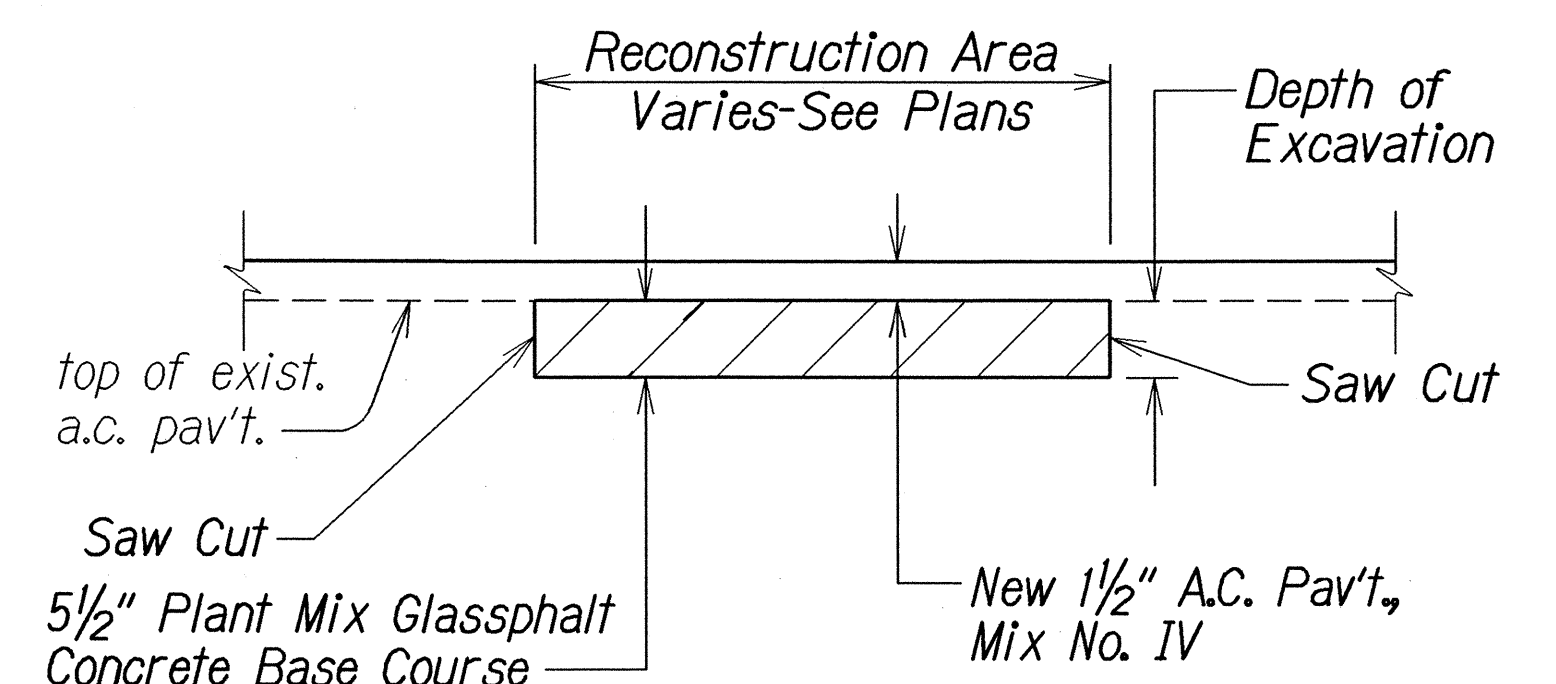


A.C. PAVEMENT RECONSTRUCTION DETAIL
 Not To Scale

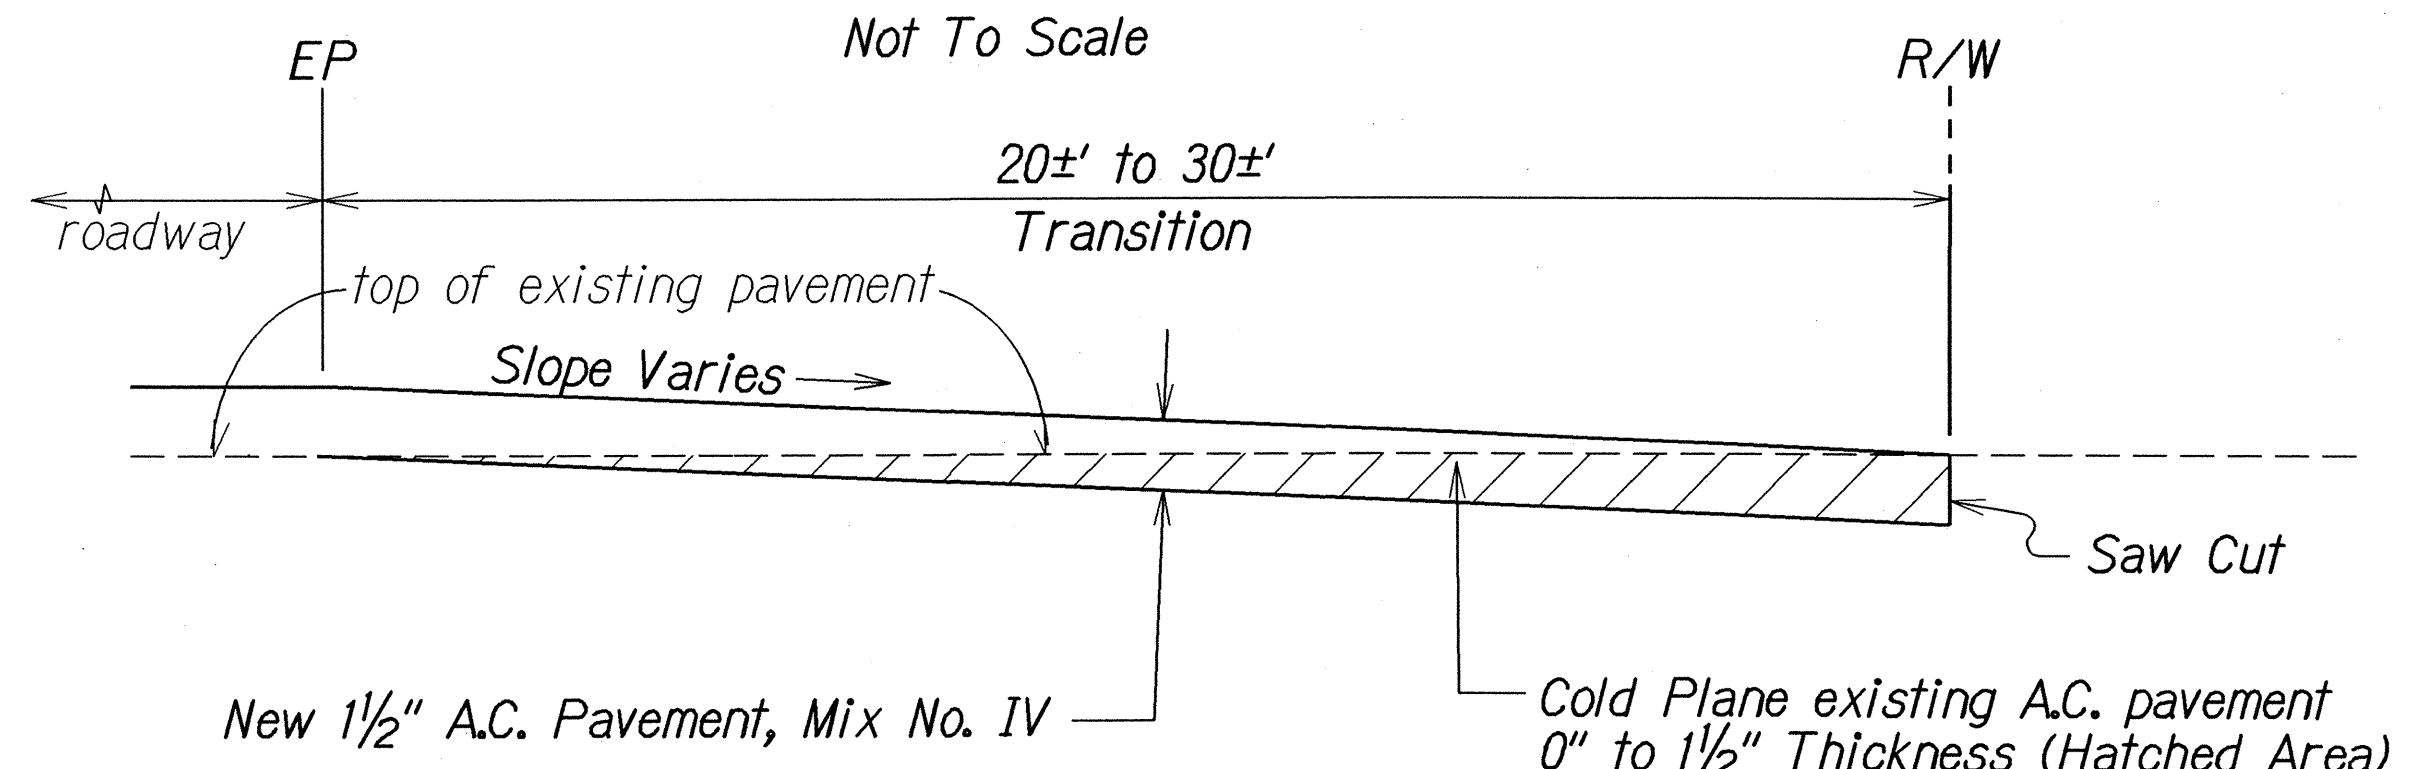

PAVED SIDE ROAD DETAIL
 Not To Scale

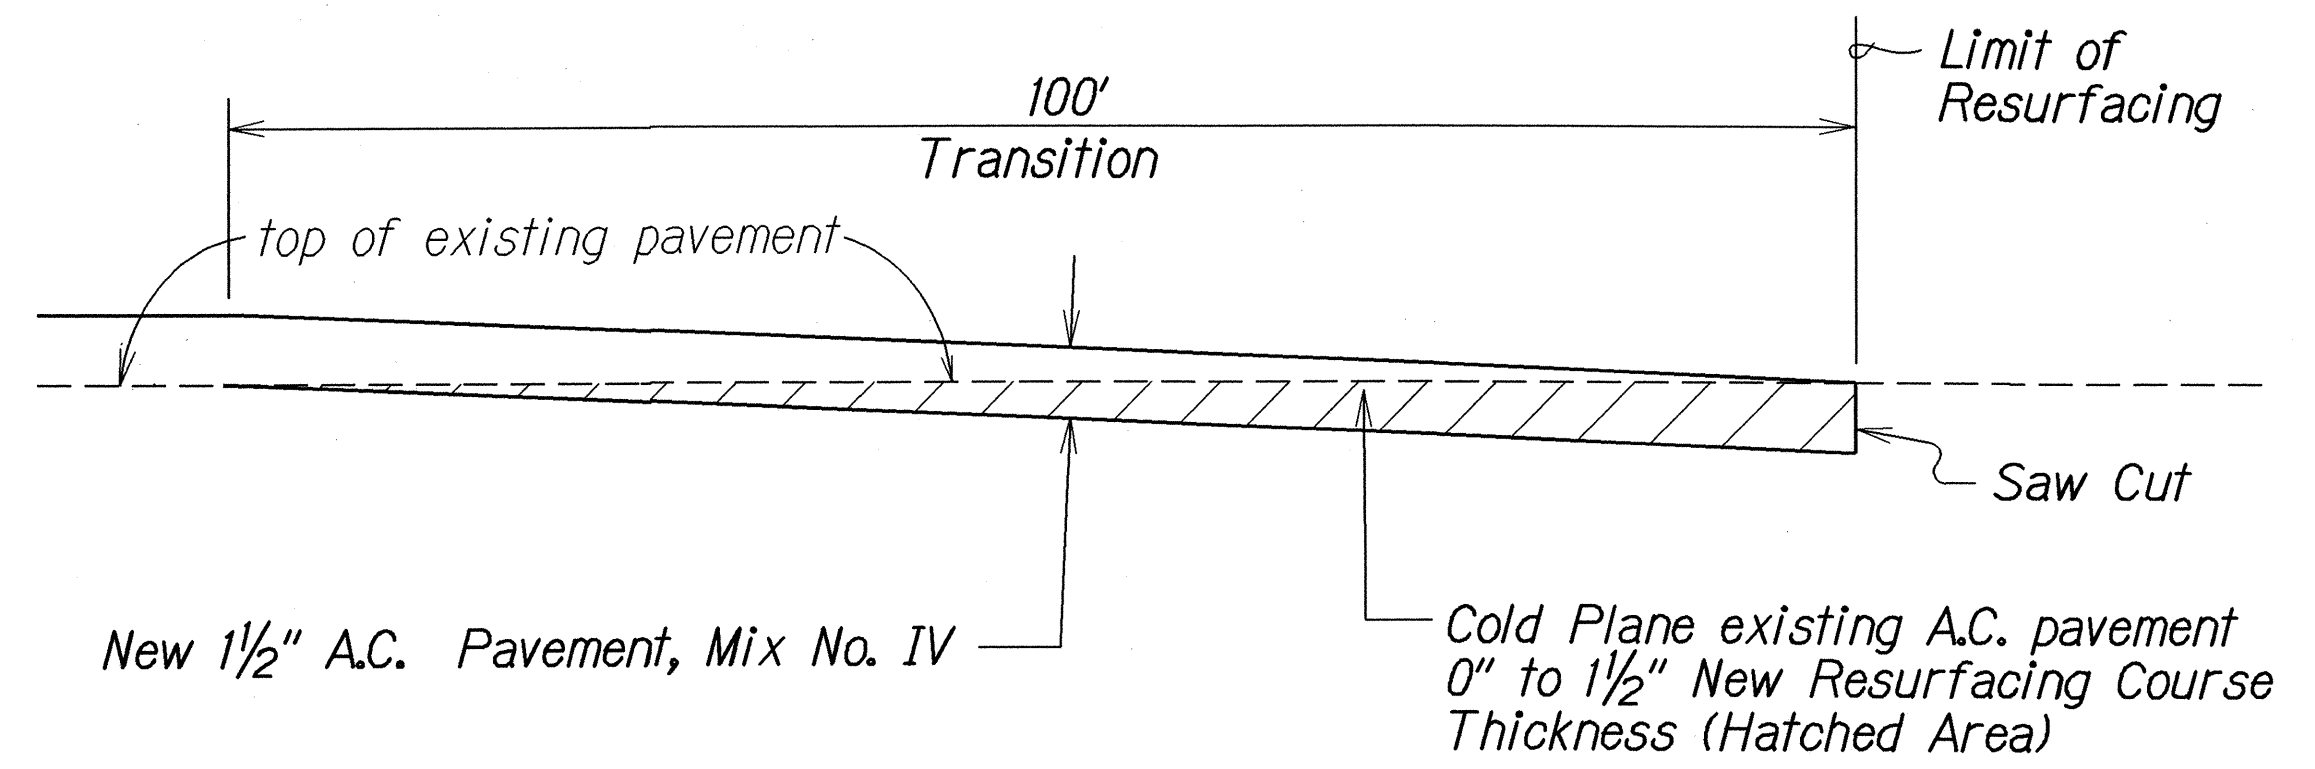

COLD PLANED TRANSITION TO EXISTING A.C. PAVEMENT
 Not To Scale

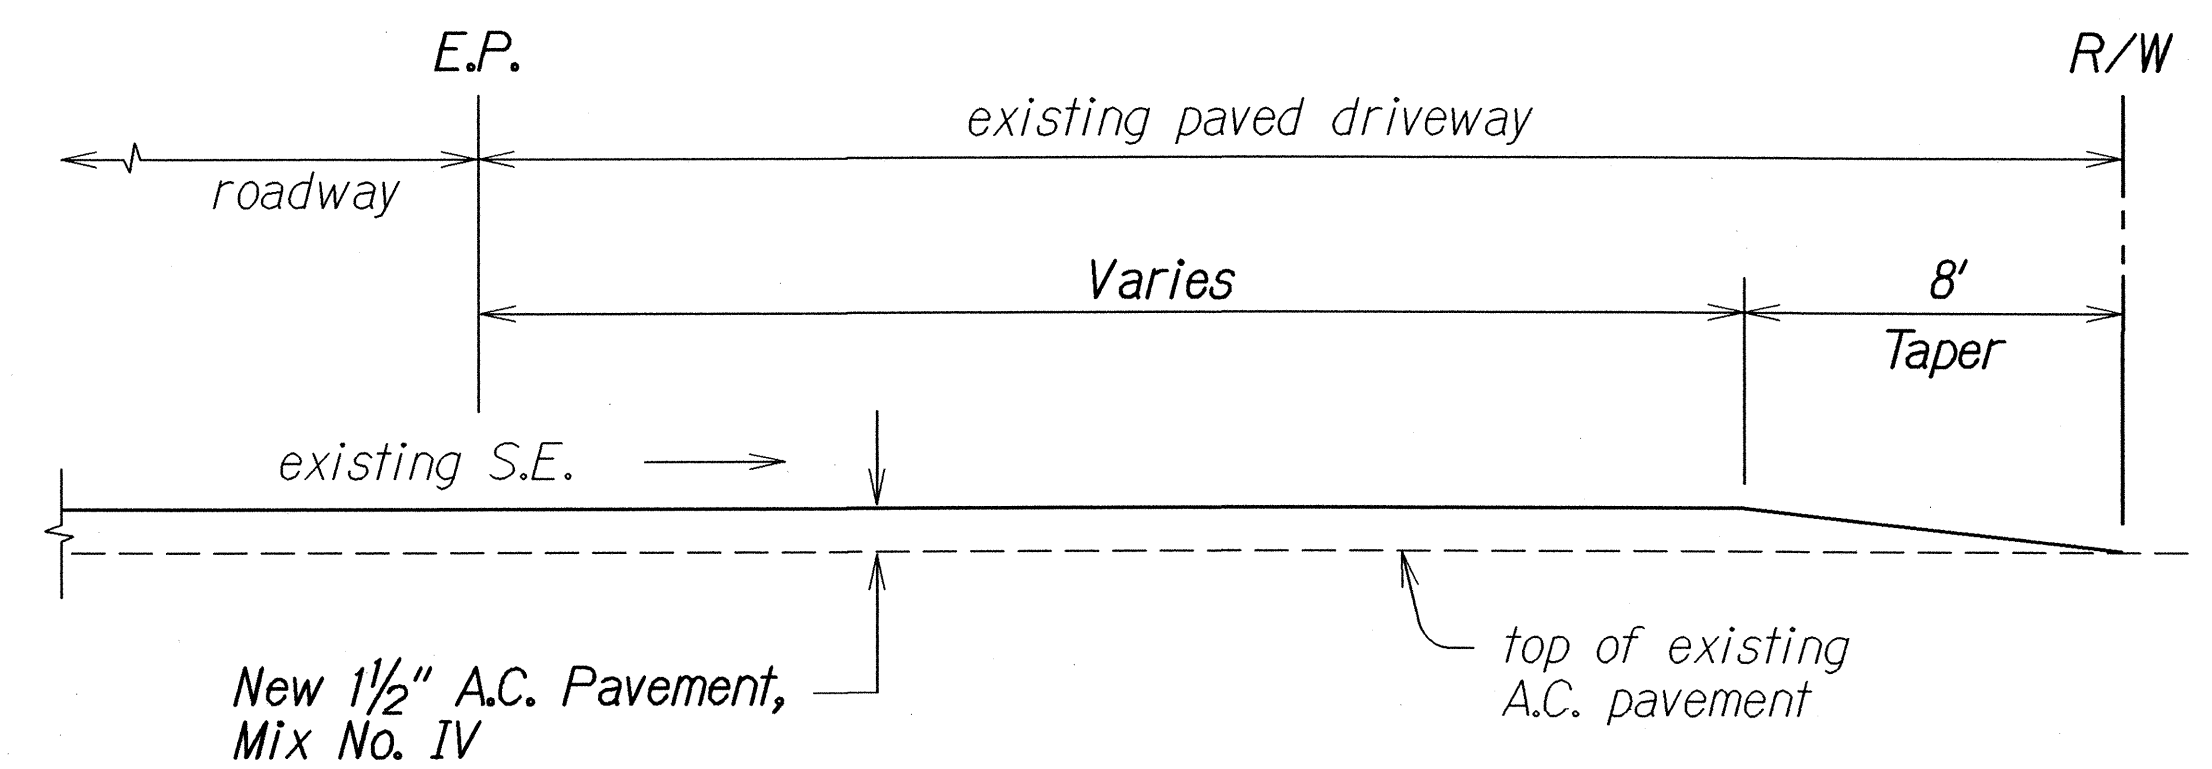

PAVED DRIVEWAY DETAIL
 Not To Scale

LEGEND FOR AS-BUILT POSTINGS

	Squiggly line for as-built deletion
	Double line for as-built deletion
	Text for as-built posting

STATE OF HAWAII
 DEPARTMENT OF TRANSPORTATION
 HIGHWAYS DIVISION

TYPICAL SECTIONS & DETAILS
 KAMEHMEHA V HIGHWAY RESURFACING
 Kaunakakai to Kamiloloa Bridge
 and Kapukoolau to Kamalo
 Project No. 450AB-01-01M
 Date: August, 2000