

INDEX TO DRAWINGS	
SHEET NO.	DESCRIPTION
1	TITLE SHEET
2	STANDARD PLANS SUMMARY
3	GENERAL NOTES AND LEGEND
4 - 5	WATER POLLUTION & EROSION CONTROL NOTES
6	ET-2000
7	FLEAT-350
8 - 9	TYPICAL SECTIONS & DETAILS
10	DRAINAGE DETAILS
11 - 23	ROADWAY PLANS
24	PAVEMENT MARKING LEGEND, DETAILS & NOTES
25 - 37	SIGNING & PAVEMENT MARKING PLANS
38	MISCELLANEOUS SUMMARIES
39	RAISED PAVEMENT MARKERS SUMMARY

STATE OF HAWAII

DEPARTMENT OF TRANSPORTATION

HIGHWAYS DIVISION

HONOLULU, HAWAII

PLANS FOR

KAMEHAMEHA V HIGHWAY RESURFACING



PUKOO TO WAIALUA

PROJECT NO. 450B-01-03M

DISTRICT OF MOLOKAI


ISLAND OF MOLOKAI

FED. ROAD DIST. NO.	STATE	FED. AID PROJ. NO.	FISCAL YEAR	SHEET NO.	TOTAL SHEETS
HAWAII	HAW.	450B-01-03M	2003	1	39

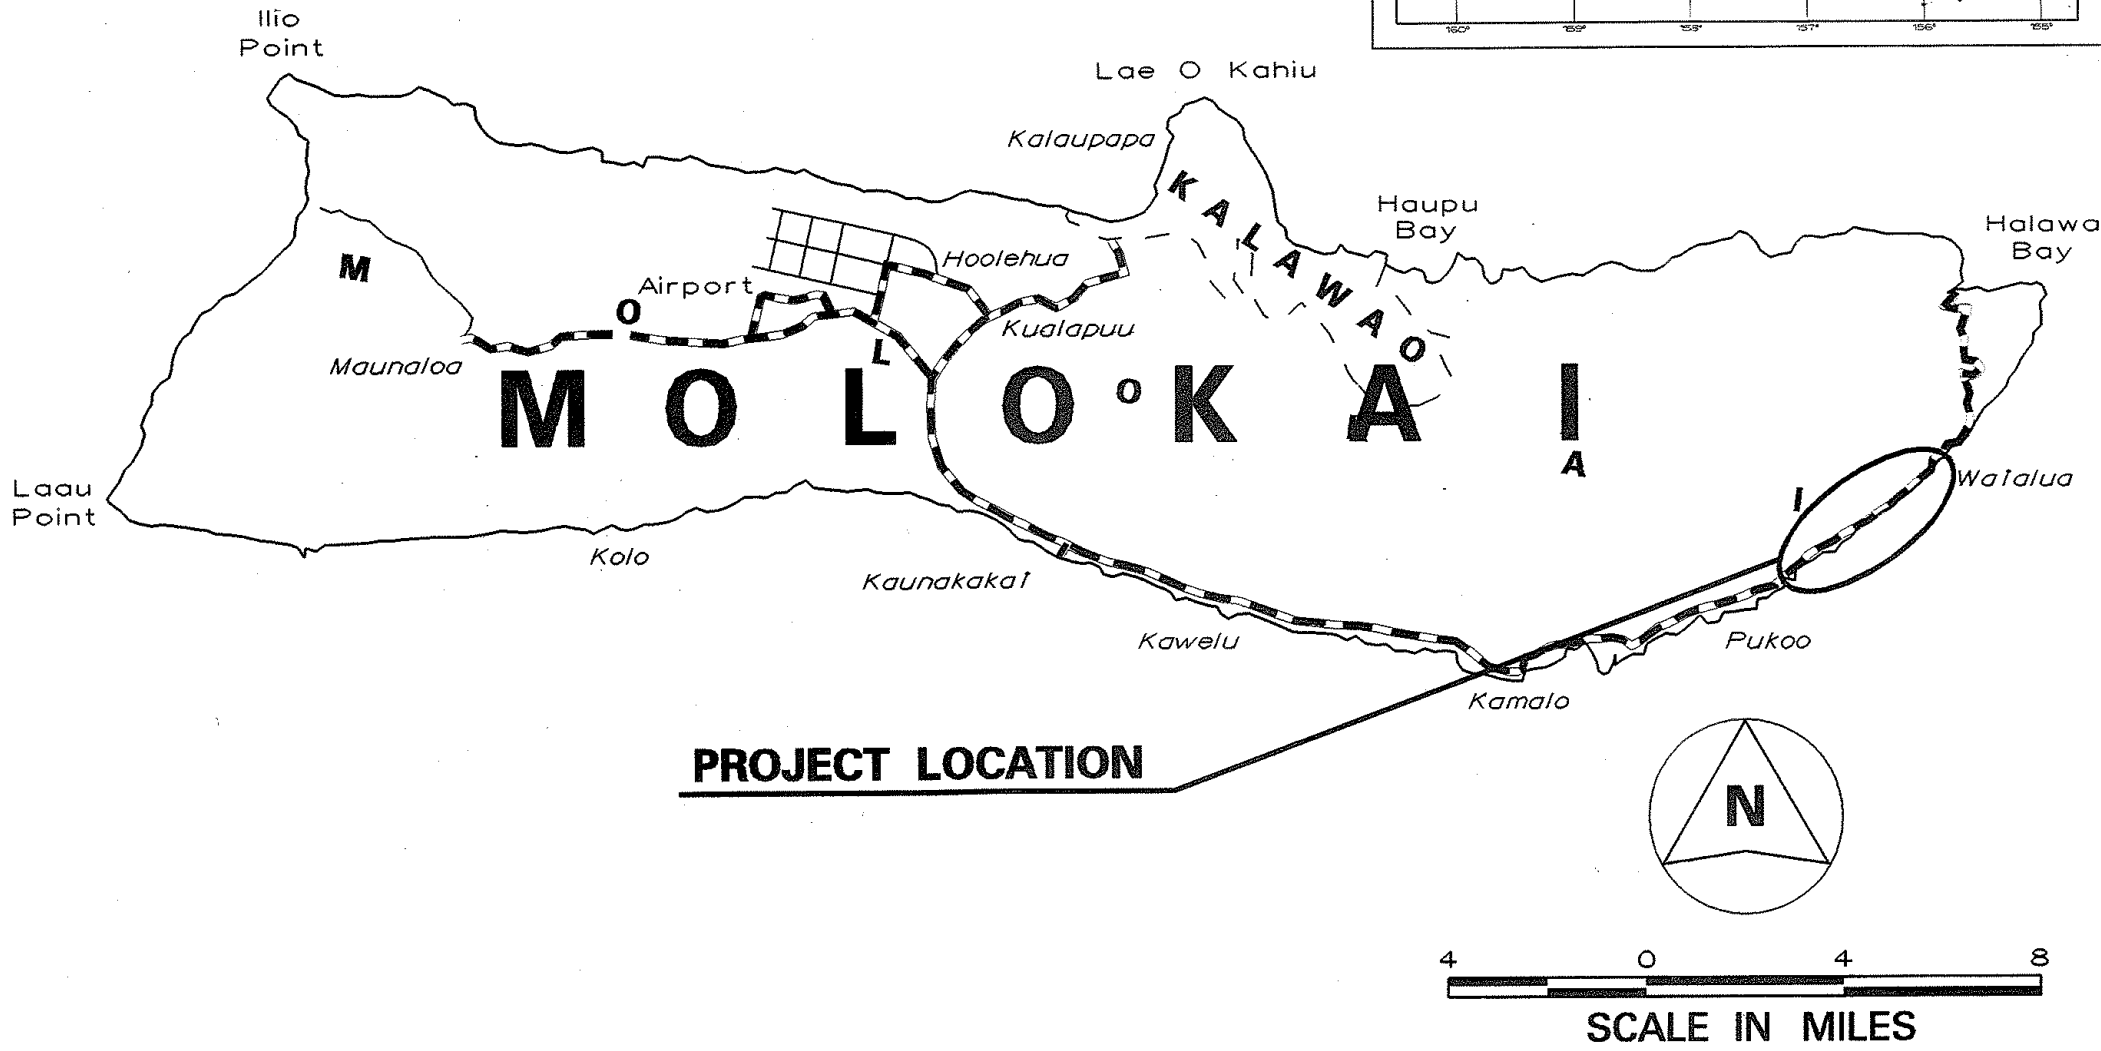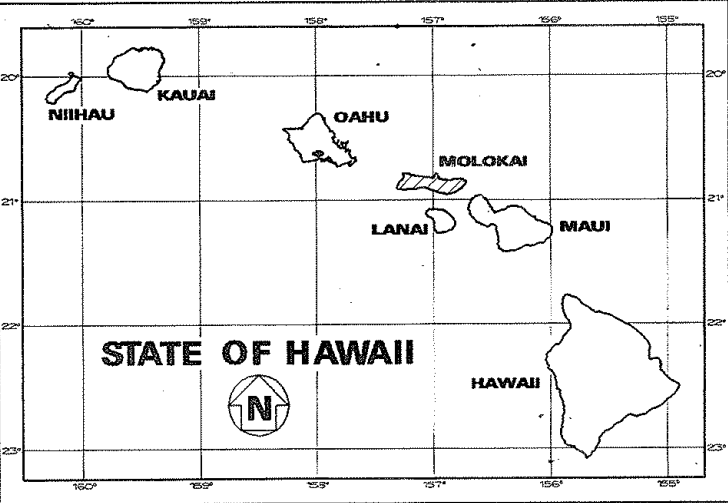

FEDERAL AID PROJECTS PREVIOUSLY CONSTRUCTED OR UNDER CONSTRUCTION

MILE POST 16.50 TO MILE POST 22.00

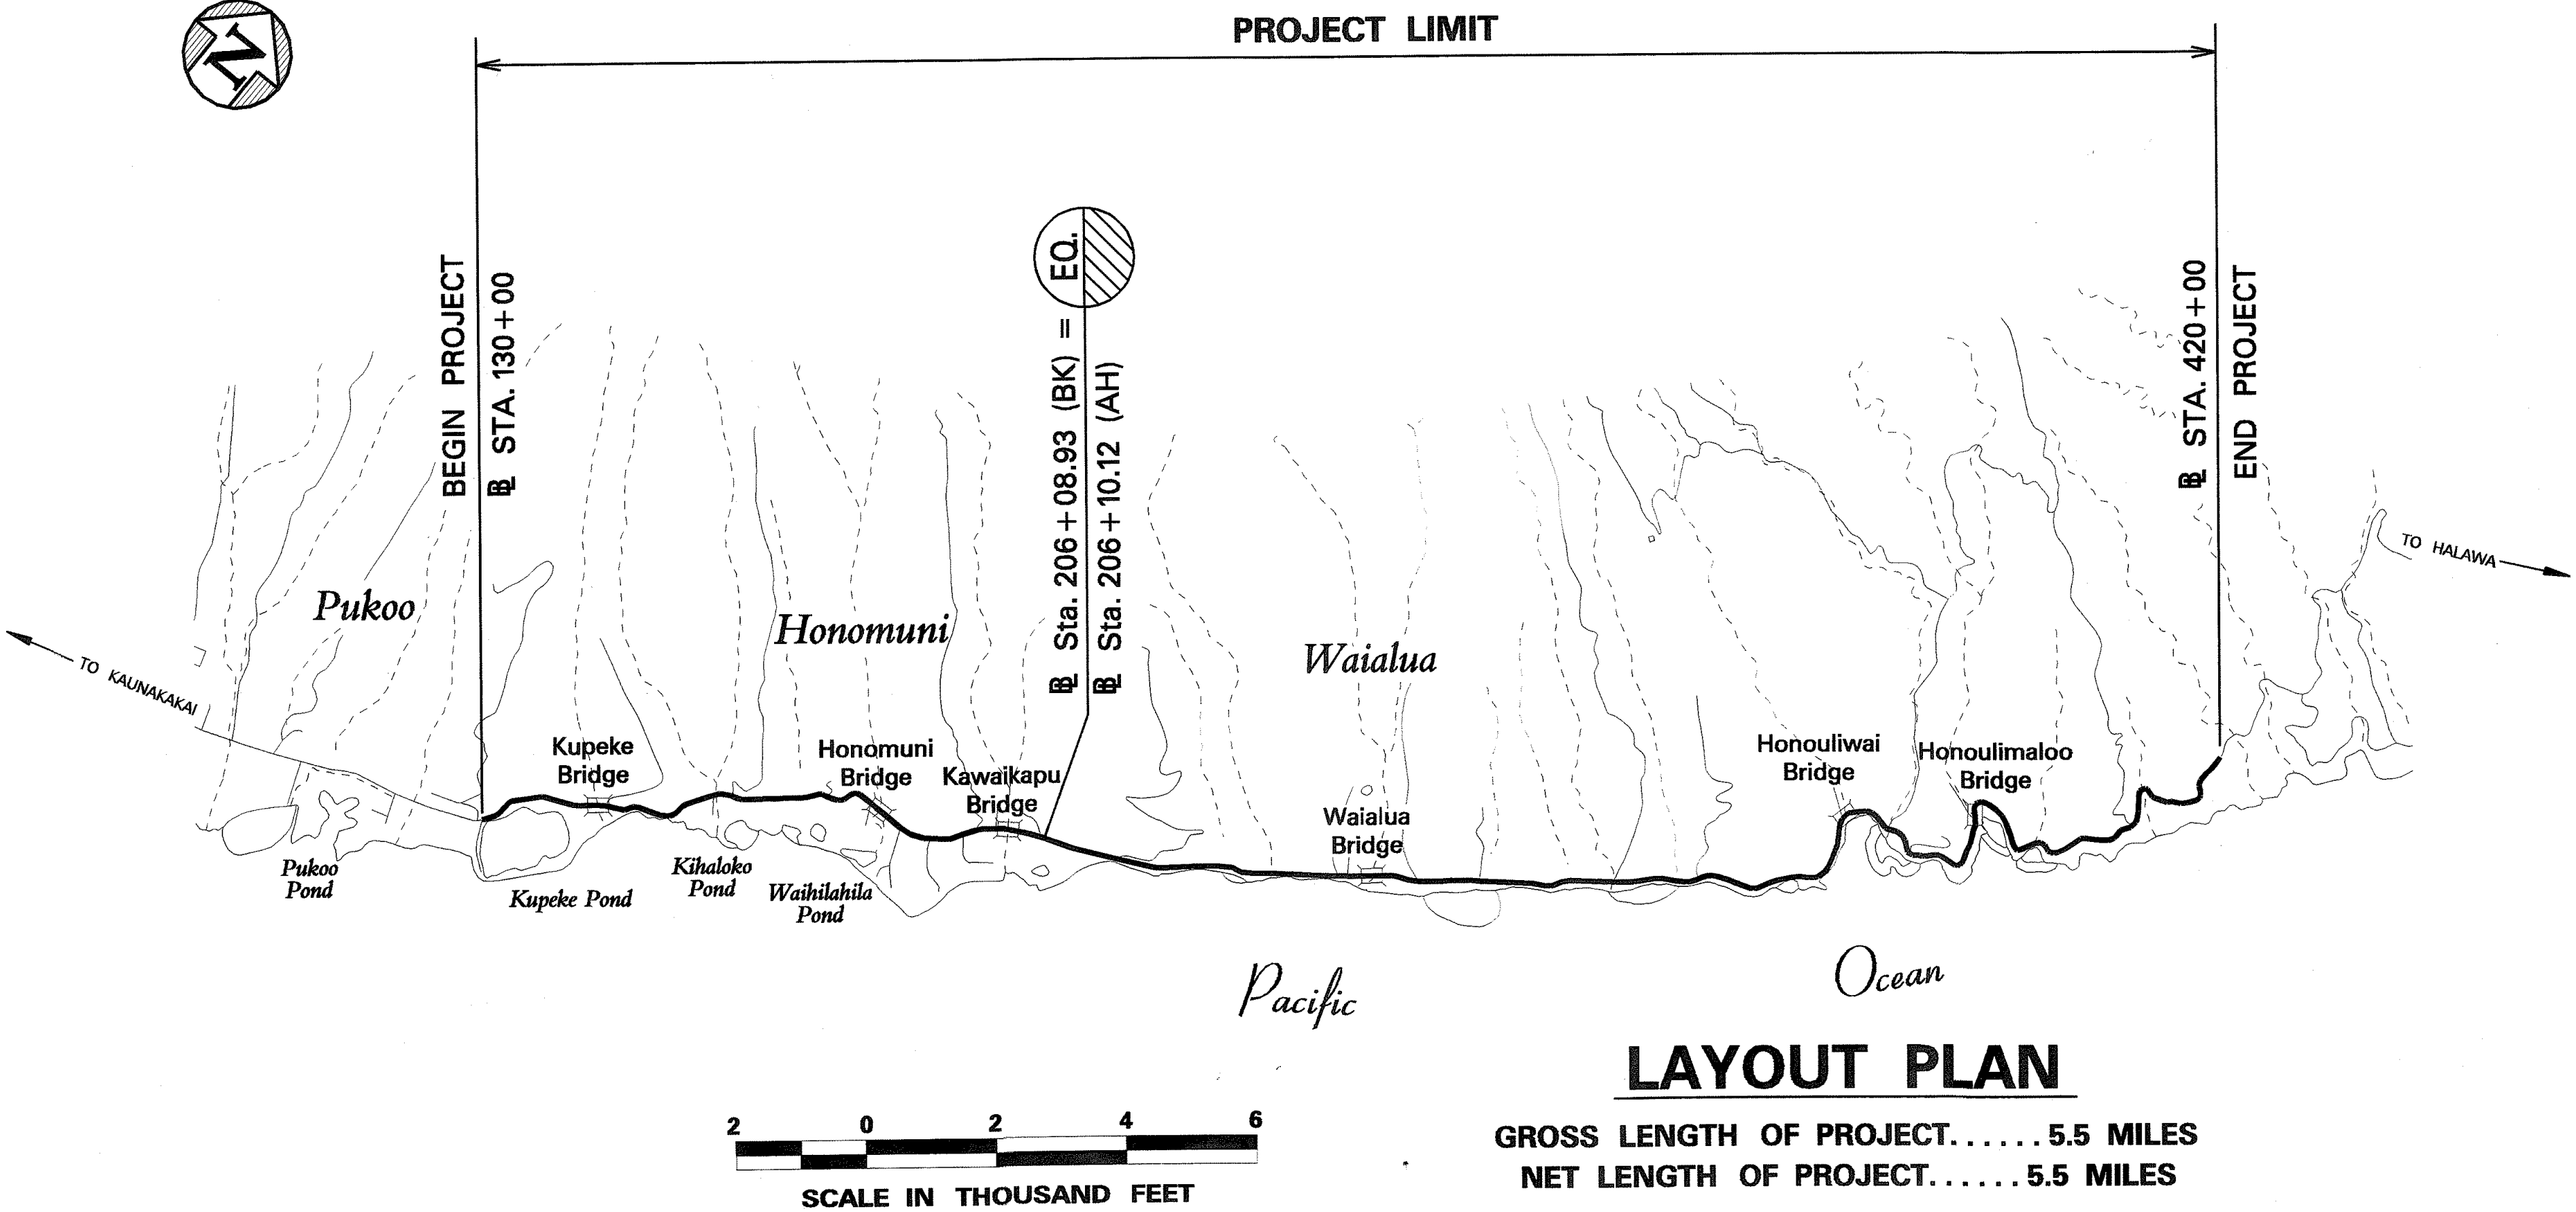

CHANGES MADE DURING CONSTRUCTION HAVE BEEN INCORPORATED ON THESE PLANS EXCEPT CHANGES IN THE ORIGINAL THEORETICAL QUANTITIES. FOR ACTUAL QUANTITIES, REFER TO PROJECT LEDGER AND/OR COMPUTATION BOOK.
 2/14/08
 [Signature]

HWY-M
 DESIGNED BY
 PAUL CHUNG
 P.S. & E.BY
 873-3535
 PHONE
 JAN., 2003
 DATE

LAYOUT PLAN
 GROSS LENGTH OF PROJECT.....5.5 MILES
 NET LENGTH OF PROJECT.....5.5 MILES

DEPARTMENT OF TRANSPORTATION
 STATE OF HAWAII
 APPROVED:
 [Signature]
 for DIR. OF TRANSPORTATION
 5/9/03
 DATE