



FED. ROAD DIST. NO.	STATE	PROJ. NO.	FISCAL YEAR	SHEET NO.	TOTAL SHEETS
HAWAII	HAW.	450B-01-03M	2003	8	39

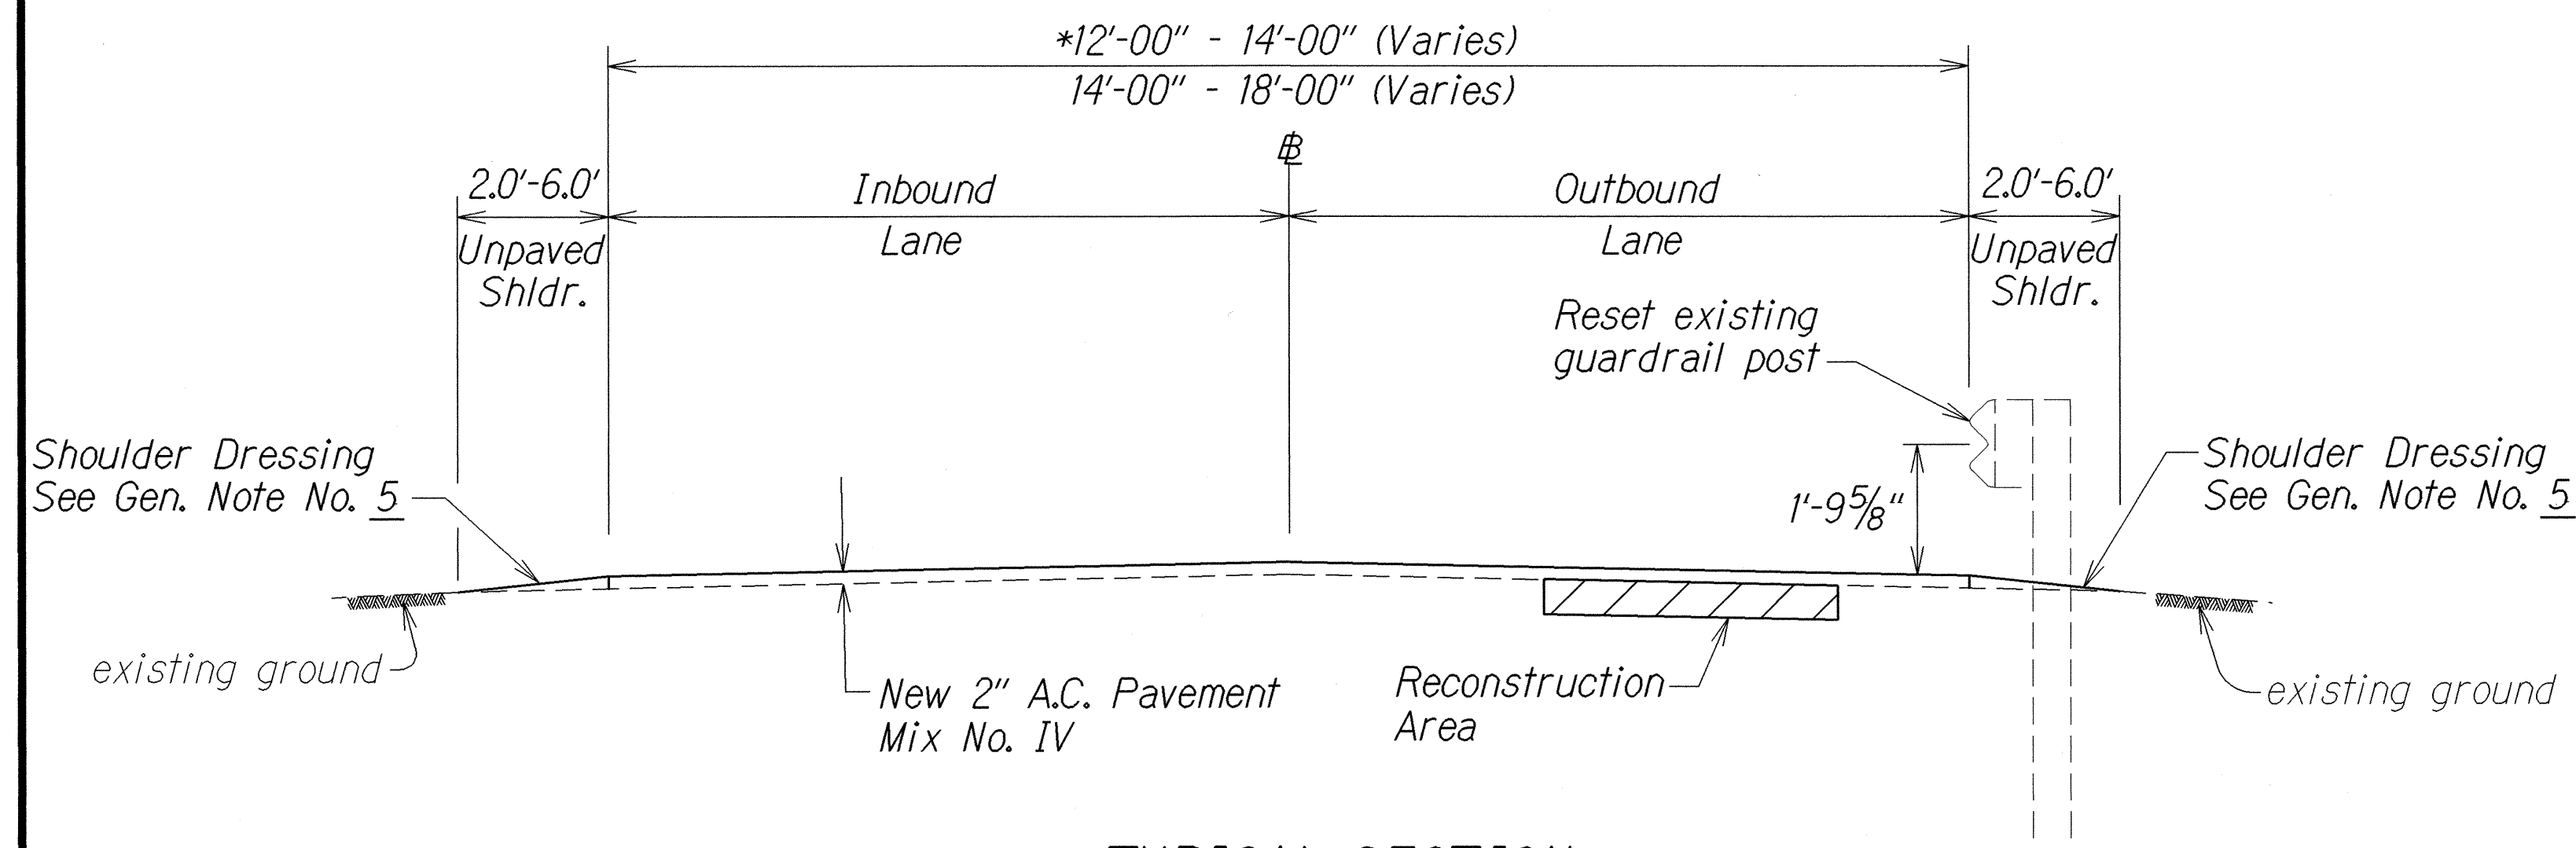


*No centerline striping to be installed


TYPICAL SECTION
 STA. 130+00± - STA. 297+00±
 *STA. 297+00± - STA. 420+00
 Scale: 1/2" = 1'-0"

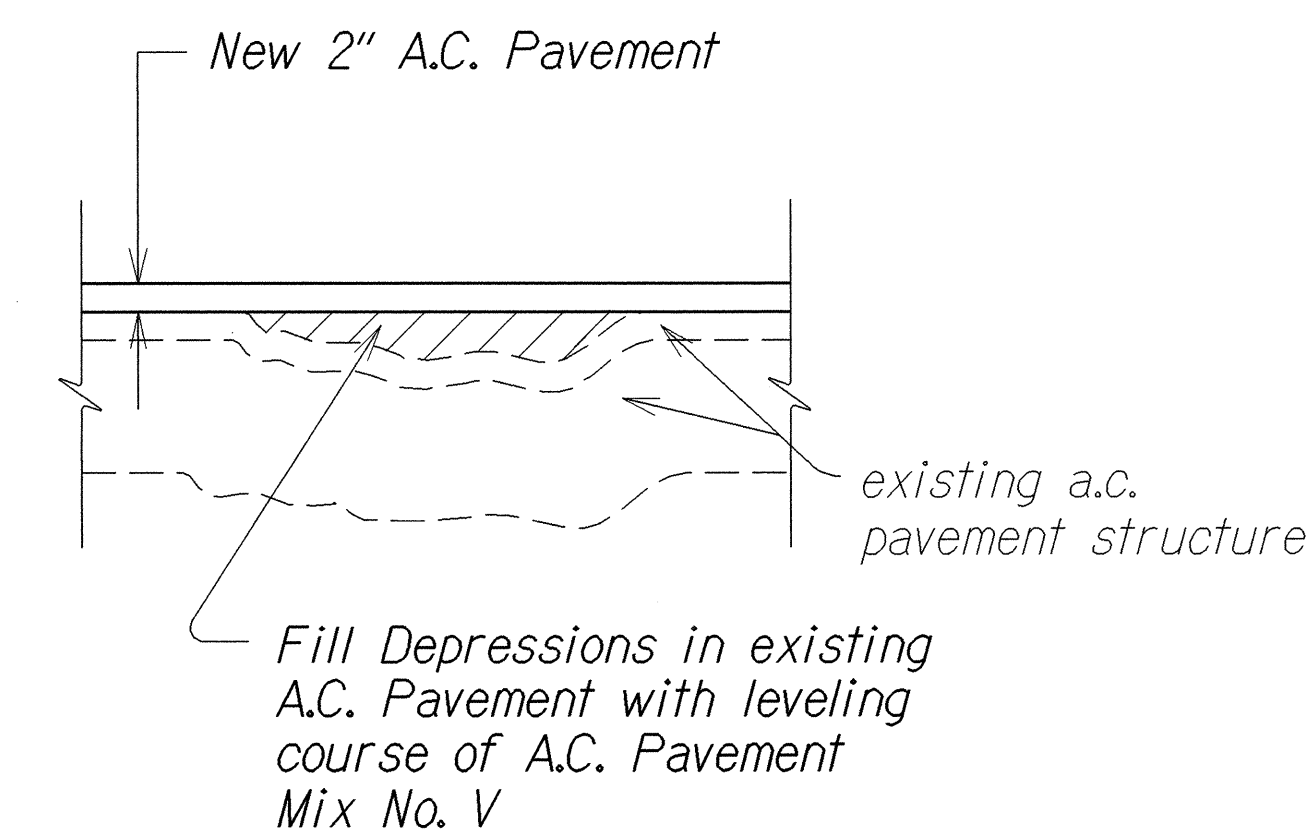


LEVELING COURSE DETAIL
 Not To Scale

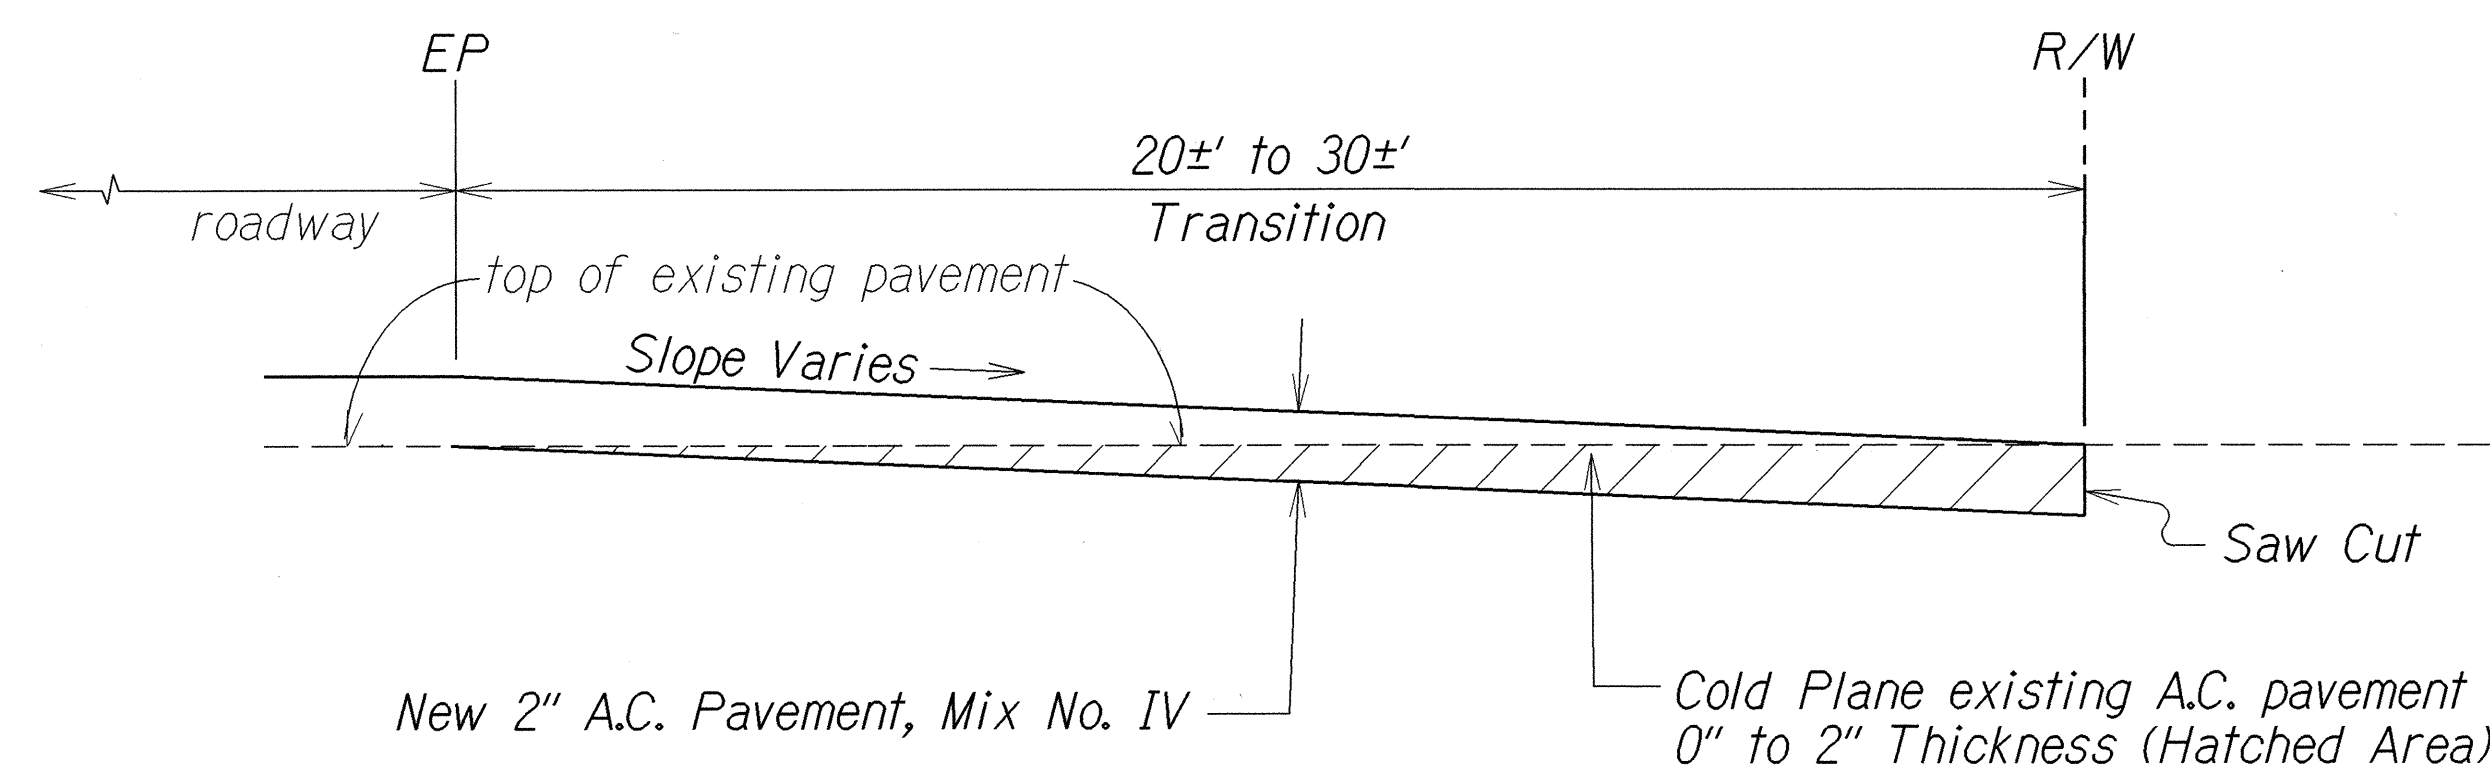


PAVED SIDE ROAD DETAIL
 Not To Scale

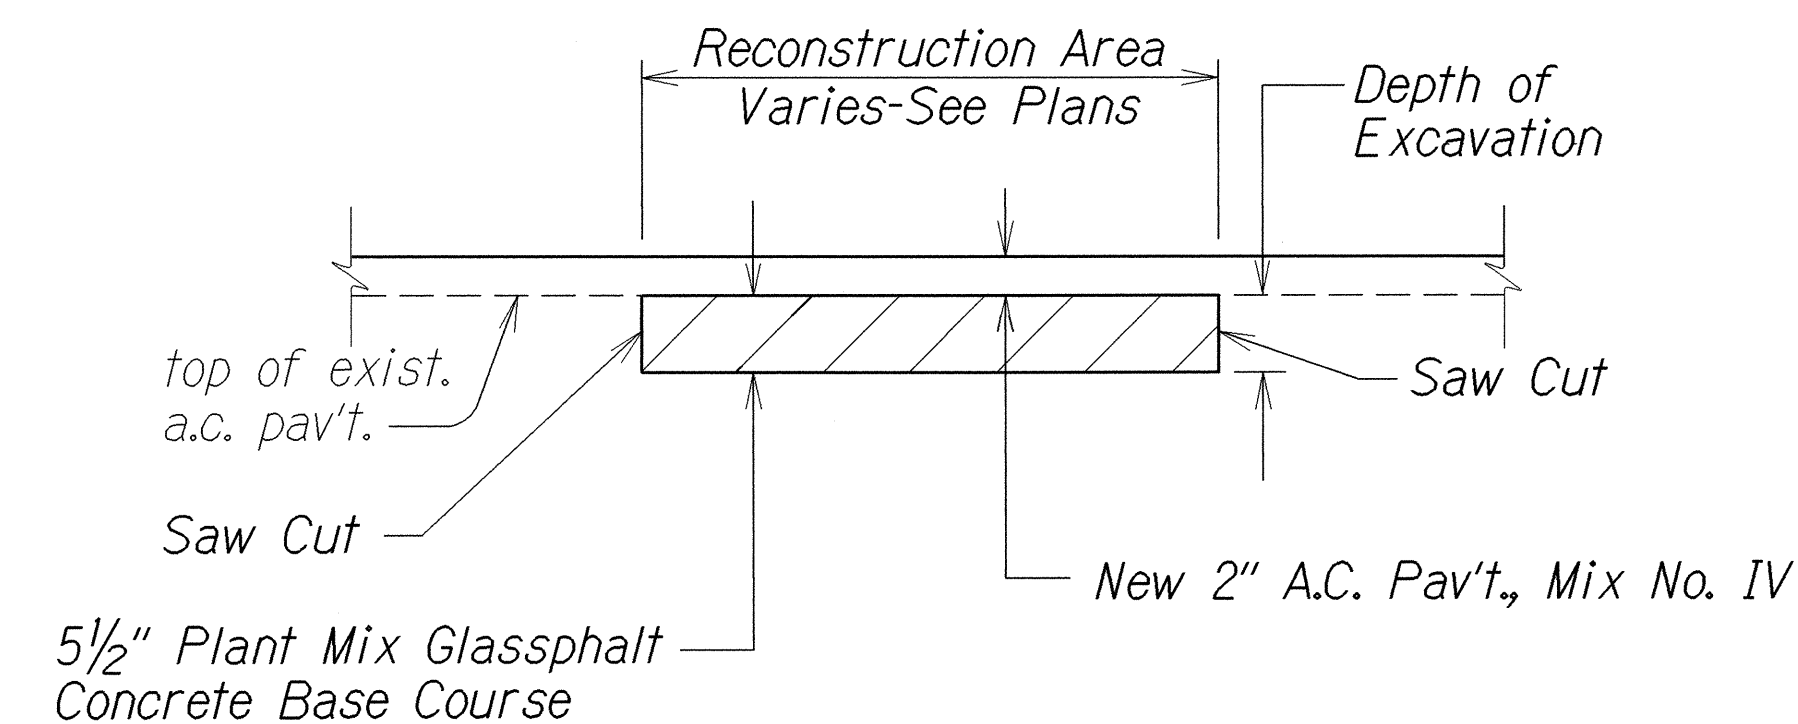

A.C. PAVEMENT RECONSTRUCTION DETAIL
 Not To Scale

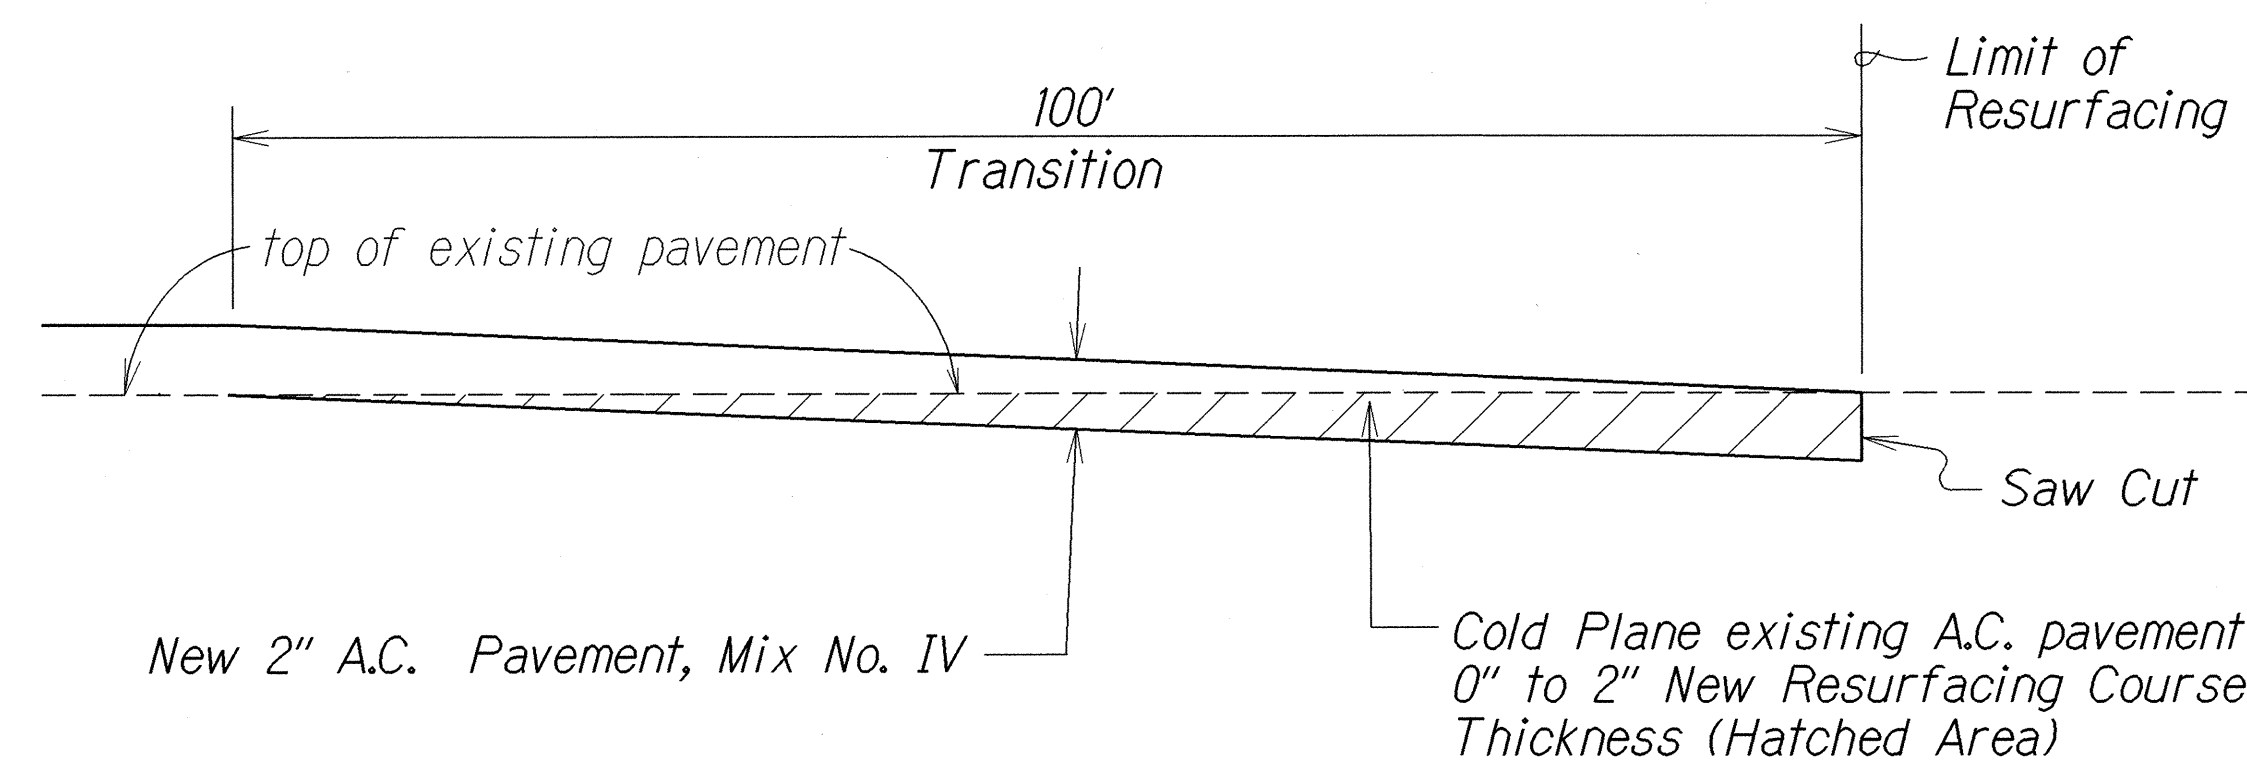

COLD PLANED TRANSITION TO EXISTING A.C. PAVEMENT
 Not To Scale

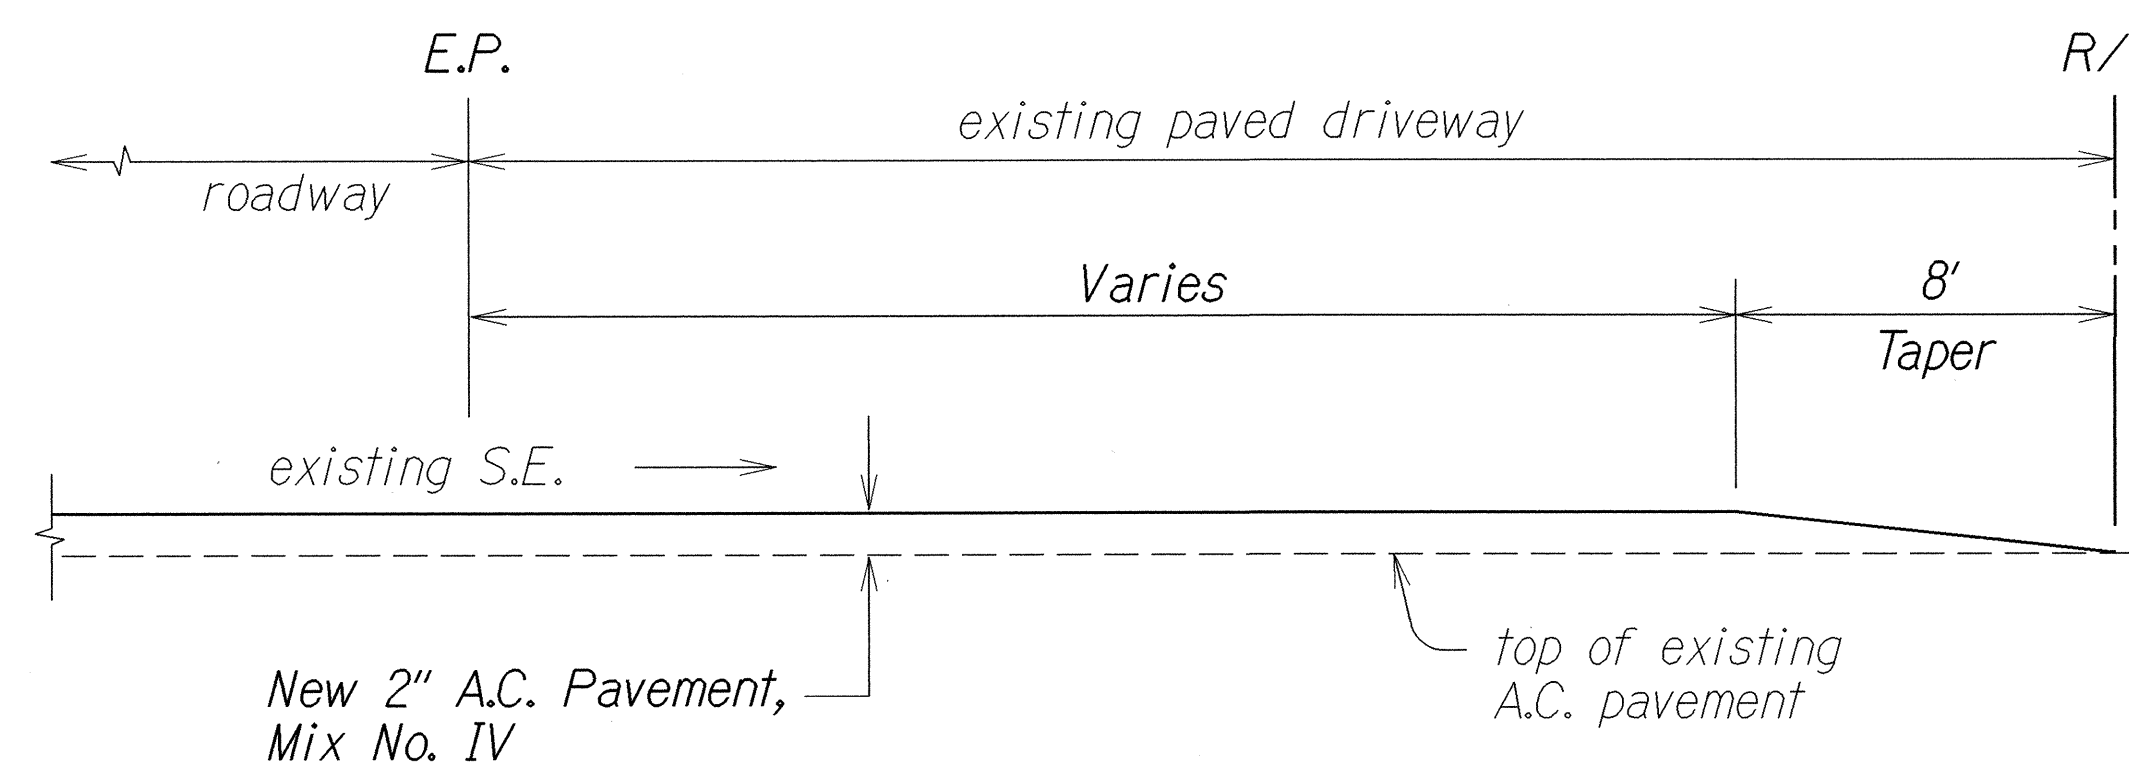


PAVED DRIVEWAY DETAIL
 Not To Scale


DATE	12/02
DESIGNED BY	
CHECKED BY	
NOTED BY	
QUANTITIES BY	
ORIGINAL PLAN	

STATE OF HAWAII DEPARTMENT OF TRANSPORTATION HIGHWAYS DIVISION
TYPICAL SECTIONS & DETAILS
KAMEHAMEHA V HIGHWAY RESURFACING
Pukoo to Waialua
Project No. 450B-01-03M
Scale: As Shown Date: December, 2002
SHEET No. 1 OF 2 SHEETS


FED. ROAD DIST. NO.	STATE	PROJ. NO.	FISCAL YEAR	SHEET NO.	TOTAL SHEETS
HAWAII	HAW.	450B-01-03M	2003	9	39

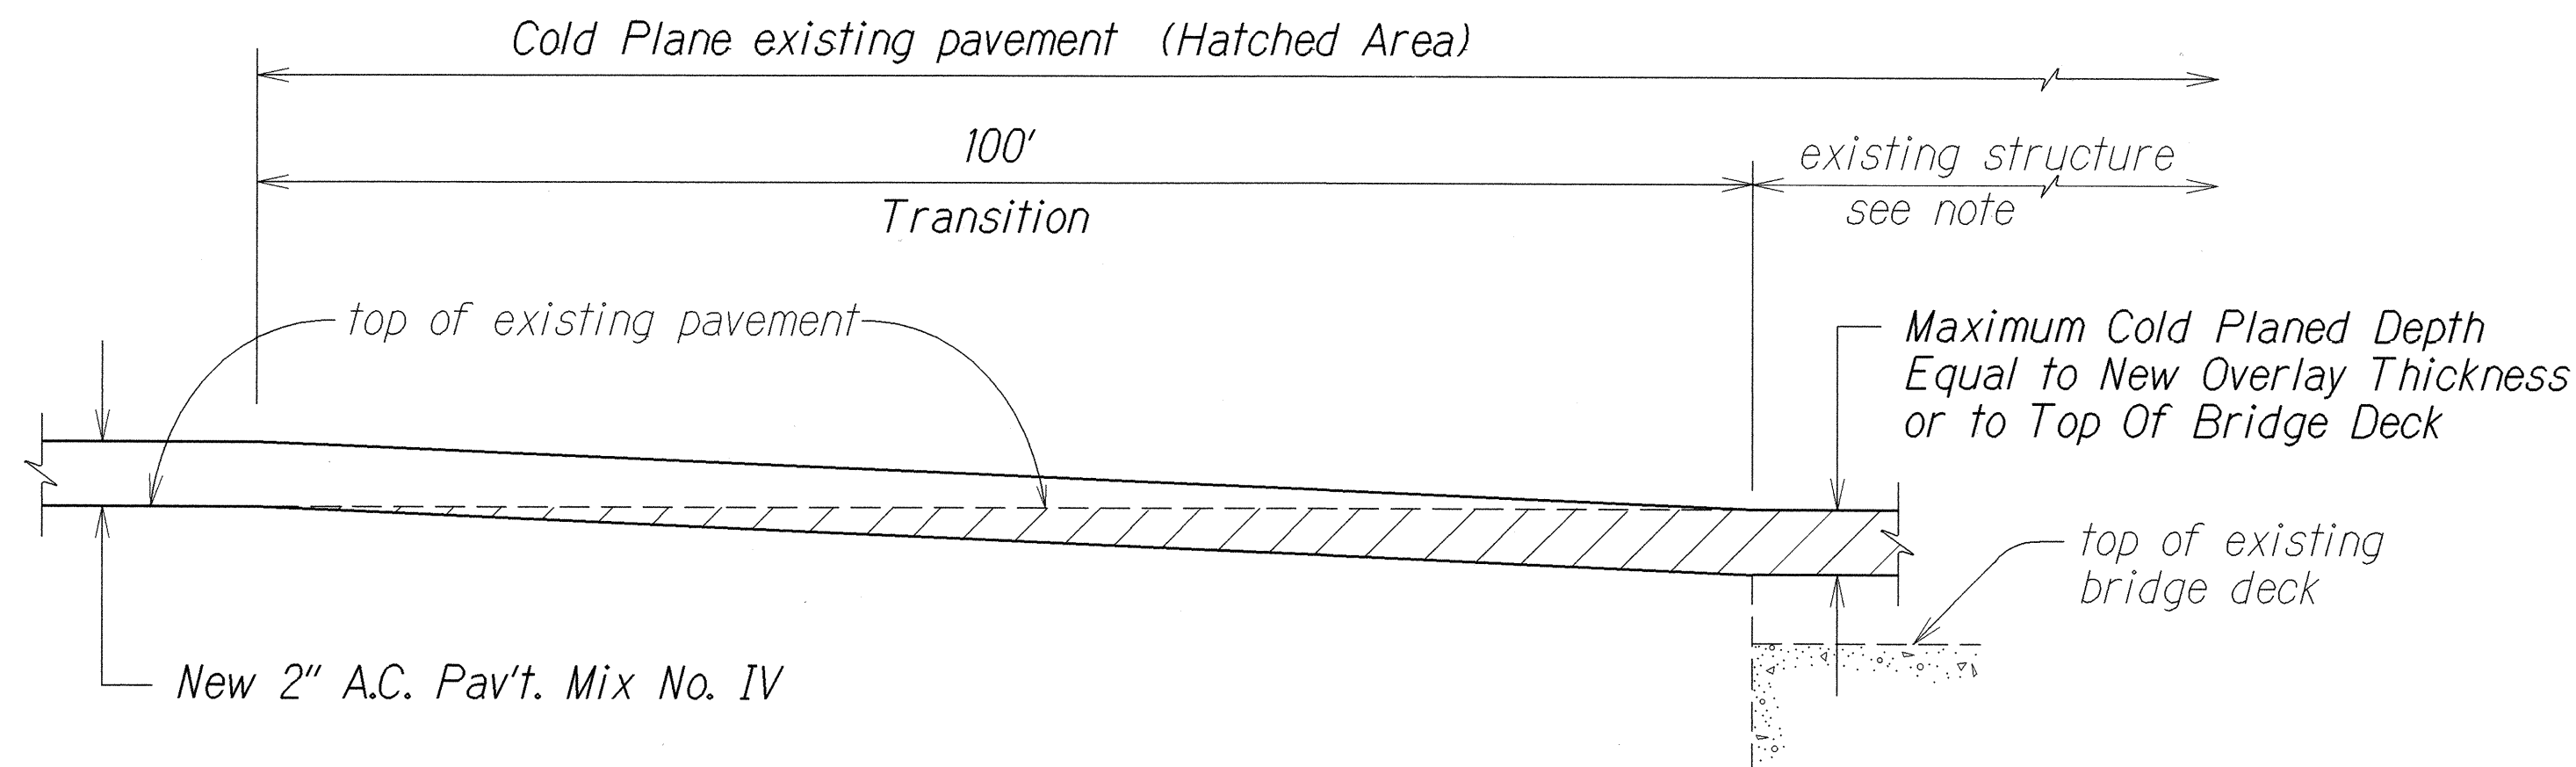


KUPEKE, HONOMUNI AND HONOULIWAI BRIDGE
COLD PLANED TRANSITION AND RESURFACING
OVER EXISTING STRUCTURE
 Not to Scale

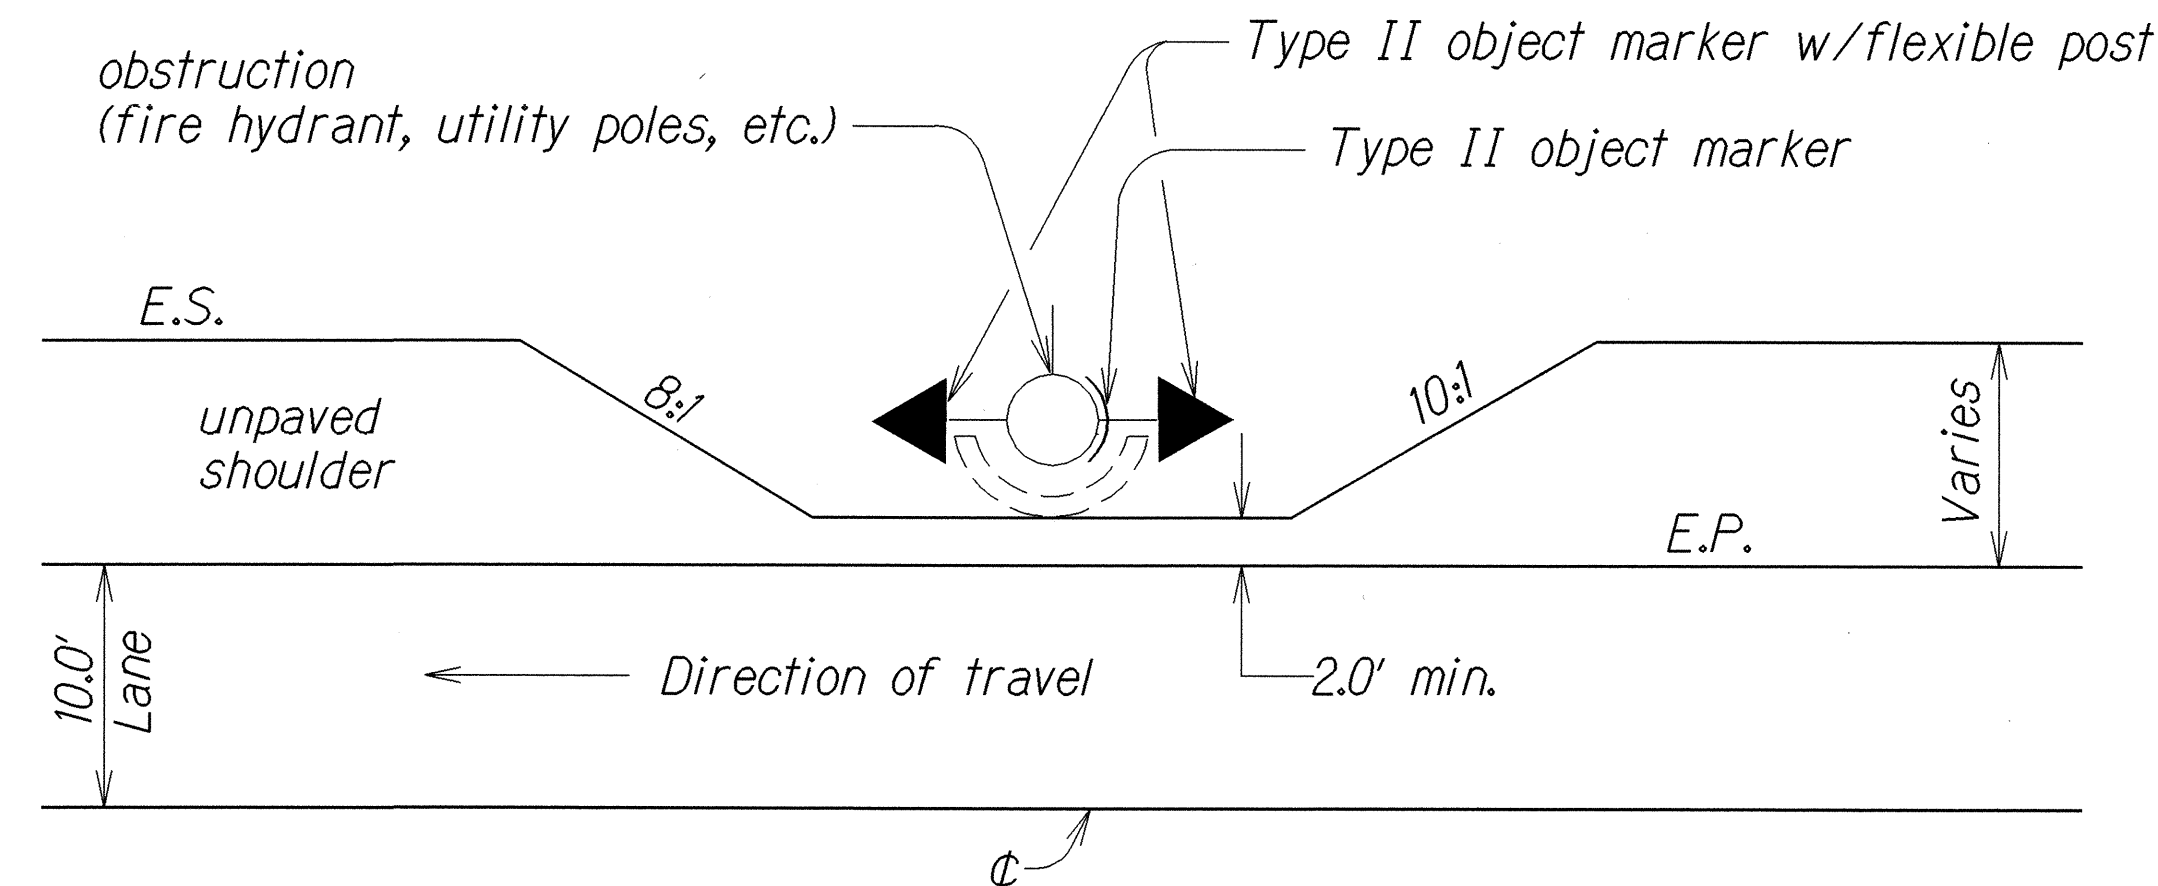

PAVEMENT TRANSITION DETAIL AT OBSTRUCTIONS
 Scale: $\frac{1}{8}$ " = 1'-0"

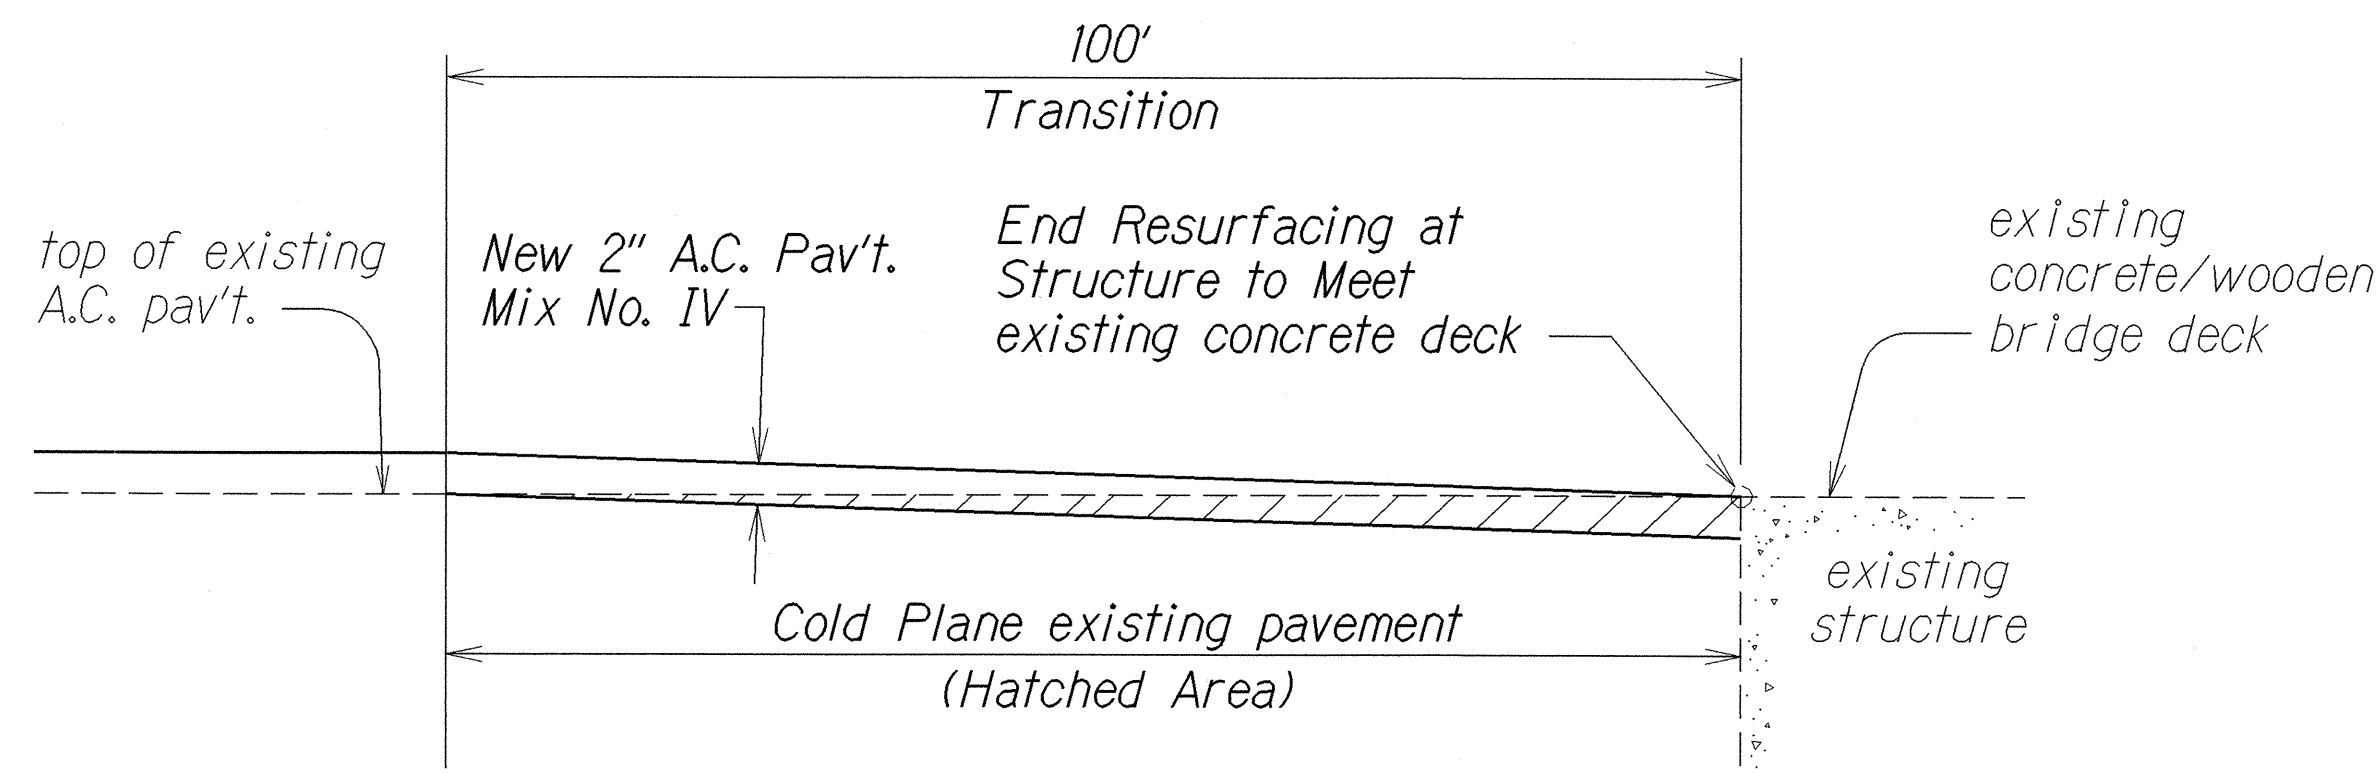

CONCRETE BOX CULVERT, WAIALUA AND HONOULIMALOO BRIDGE
COLD PLANED TRANSITION AT STRUCTURE
 Not to Scale

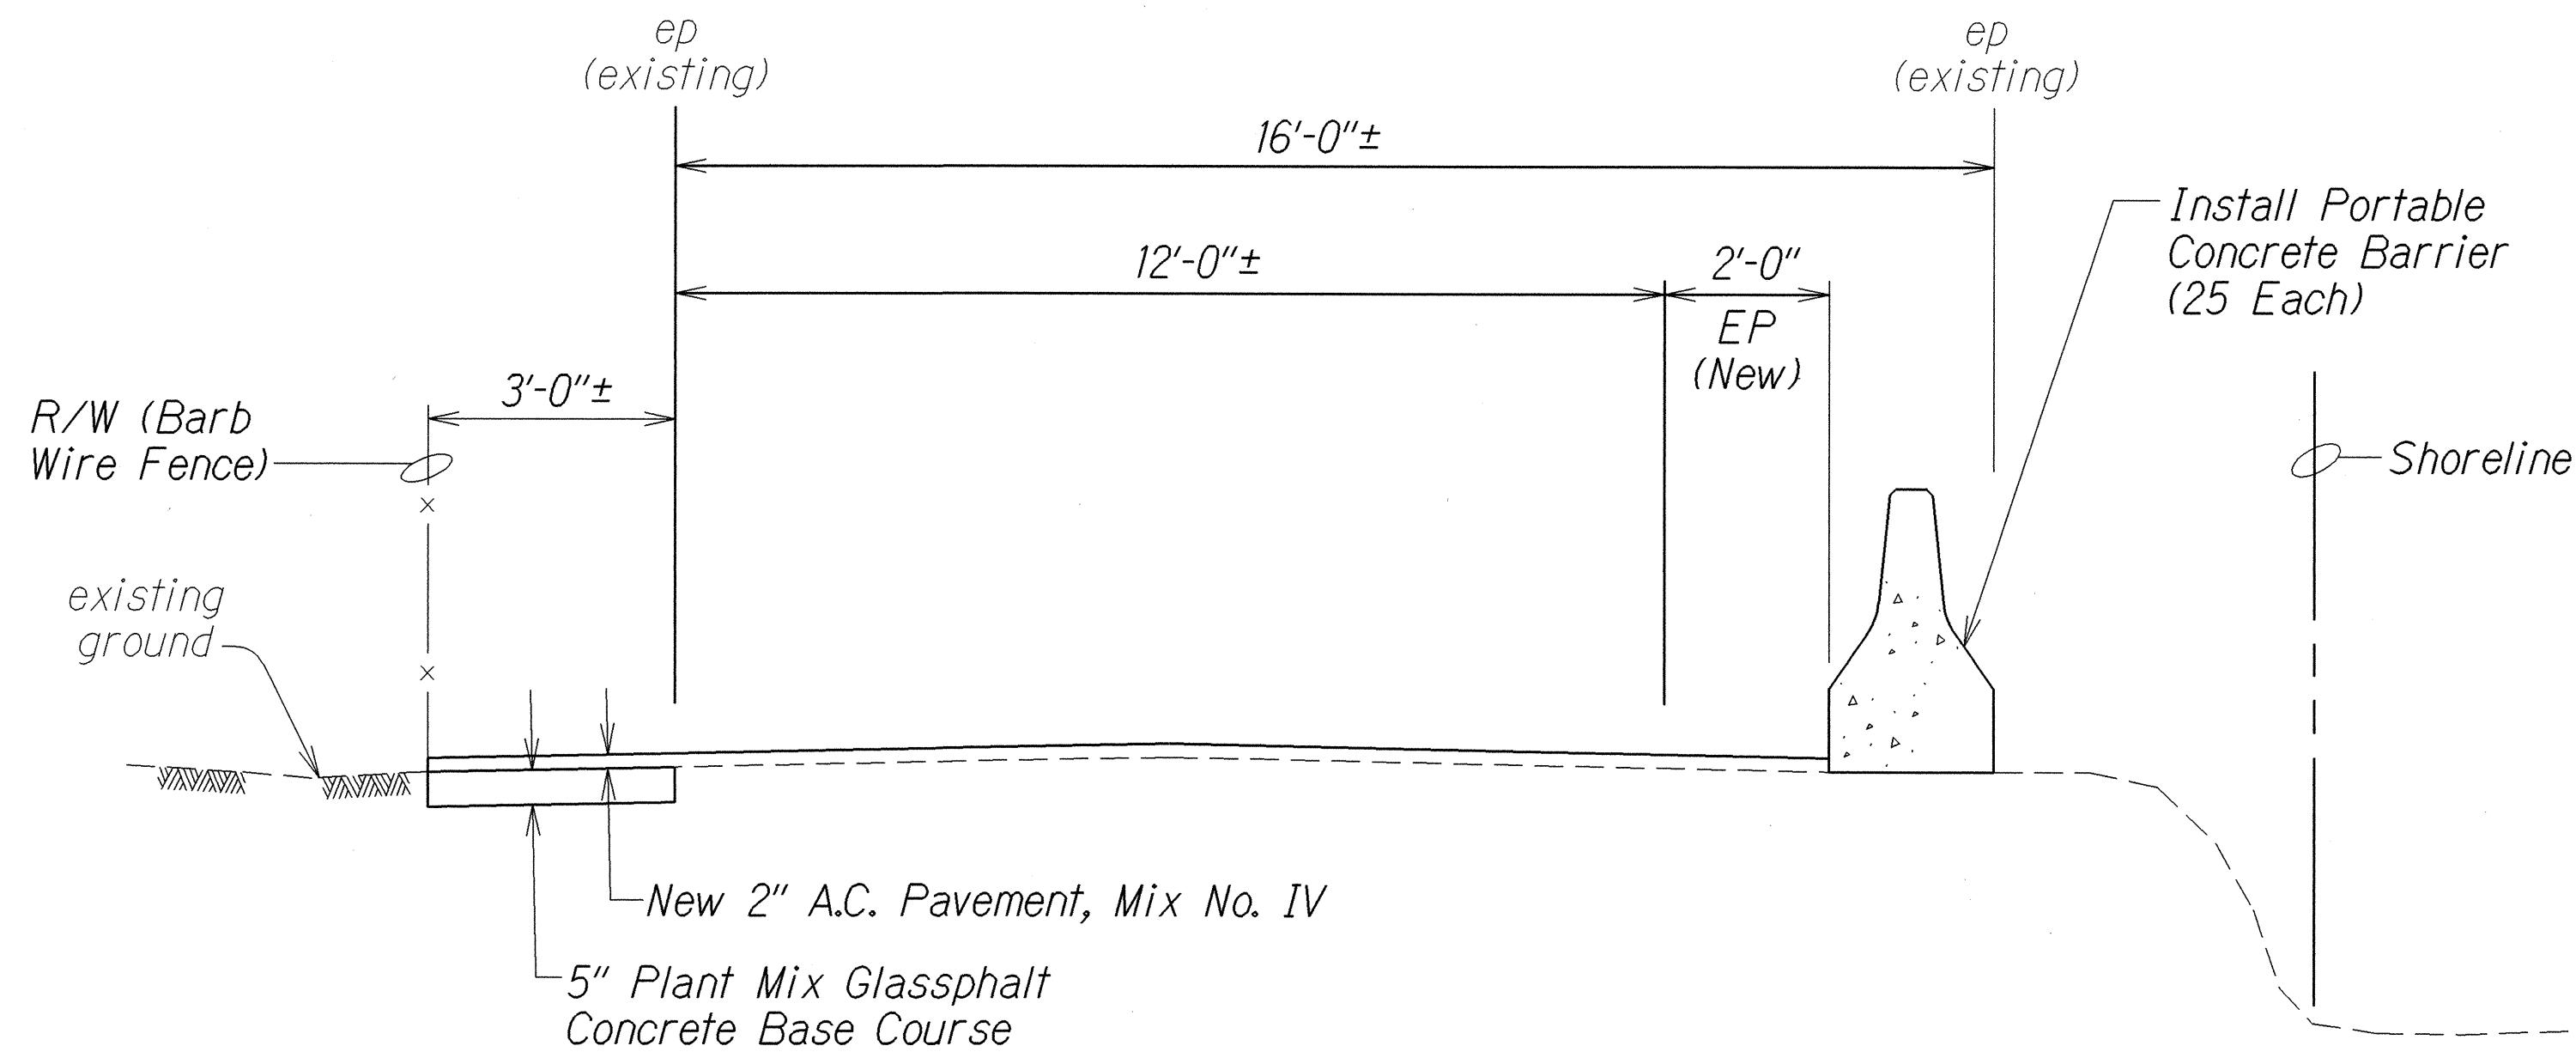

TYPICAL SECTION
PORTABLE CONCRETE BARRIER INSTALLATION
 M.P. 20.00 - M.P. 20.09
 STA. 315+20± RT. - STA. 319+95± RT.
 Scale: $\frac{1}{2}$ " = 1'-0"

ORIGINAL PLAN	DATE	12/02
DRAWN BY	TRACED BY	
NOTED BY	QUANTITIES BY	
CHECKED BY		

6-5-03	Added Portable Concrete Barrier Typical Section
DATE	REVISION

STATE OF HAWAII DEPARTMENT OF TRANSPORTATION HIGHWAYS DIVISION
TYPICAL SECTIONS & DETAILS
KAMEHAMEHA V HIGHWAY RESURFACING Pukoo to Waialua Project No. 450B-01-03M
Scale: As Shown Date: December, 2002
SHEET No. 2 OF 2 SHEETS