



NOTES:


- All stationings are based on new Kamehameha V Highway baseline.
- See Sht. C8 for Curve Data and Roadway Layout.
- See Structural Plans for Bridge Layout.

Meet Exist. Pavement (Sawcut)
Saw cutting shall be considered
incidental to various contract items.
See Sht. C6 for Pavement
Connection Detail.

BEGIN PROJECT
F.A. Project No. ER-12(4)
Sta. 200+50

LEGEND FOR AS-BUILT POSTINGS

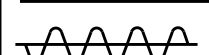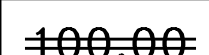	Squiggly line for as-built deletion
	Double line for as-built deletion
Roadway	Text for as-built posting

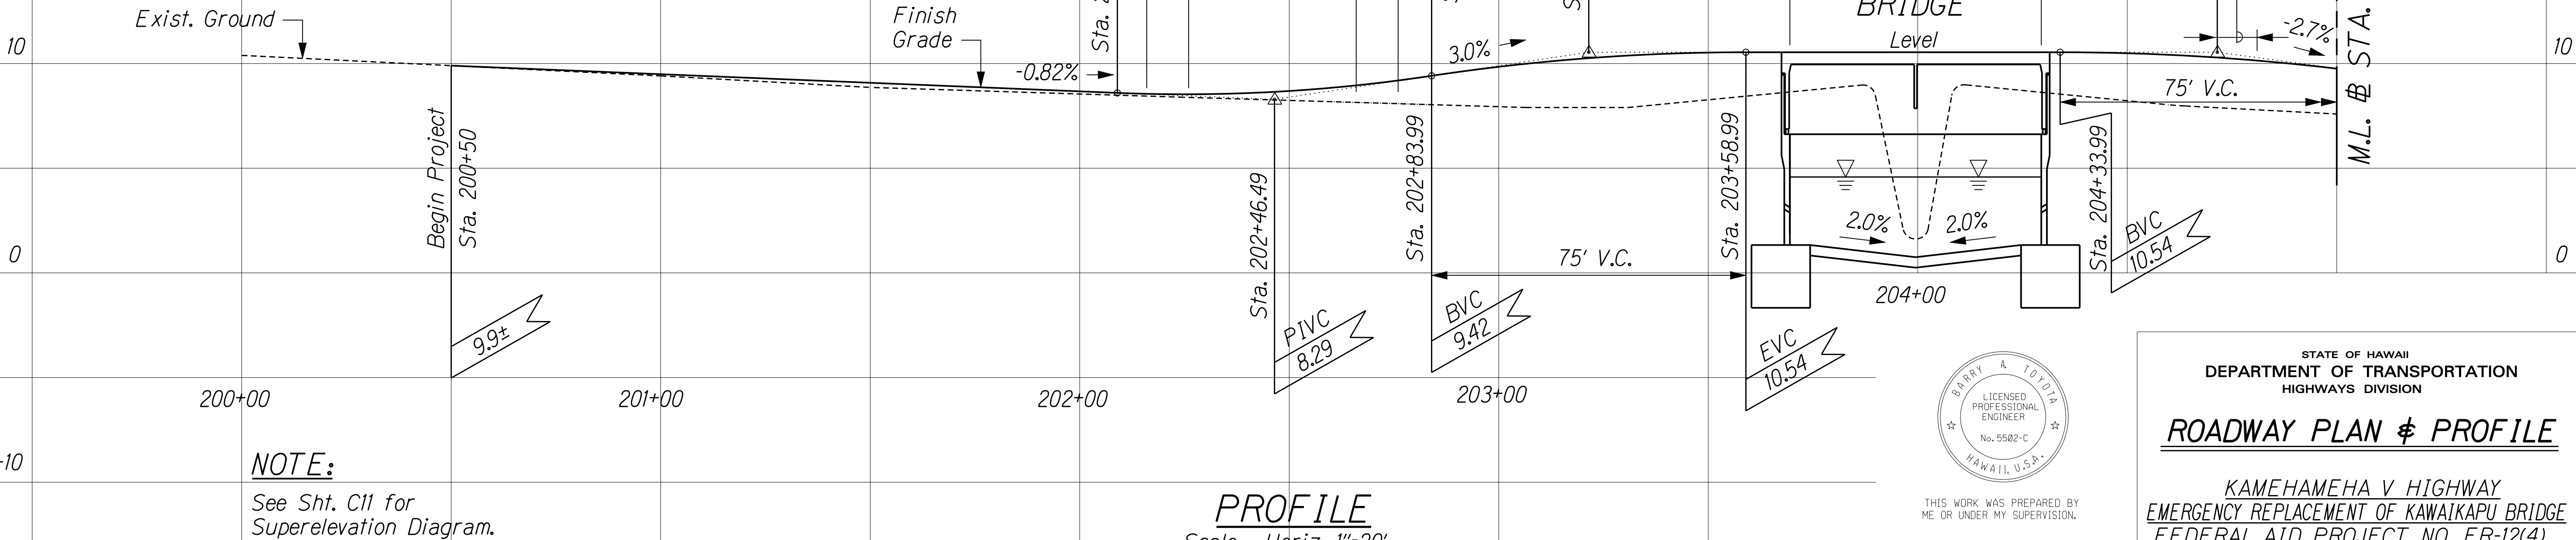

SURVEY PLOTTED BY	DATE
DRAWN BY	
DESIGNED BY	
QUANTITIES BY	
CHECKED BY	

NOTE:

See Sht. C11 for
Superelevation Diagram.

PROFILE

Scale: Horiz. 1"=20'
Vert. 1"=4'



THIS WORK WAS PREPARED BY
ME OR UNDER MY SUPERVISION.

SIGNATURE

STATE OF HAWAII
DEPARTMENT OF TRANSPORTATION
HIGHWAYS DIVISION

ROADWAY PLAN & PROFILE

KAMEHAMEHA V HIGHWAY
EMERGENCY REPLACEMENT OF KAWAIKAPU BRIDGE
FEDERAL AID PROJECT NO. ER-12(4)

Scale: As Shown

Date: April 30, 2001

SHEET No. C9 OF 46 SHEETS

"AS-BUILT"

Remove and Pot Existing Croton Shrubs and Areca Palms. Arrange with owner for desired storage location. This work shall be paid for under Section 201 - Clearing and Grubbing.

Exist. Kamehameha V Highway

TO KAUNAKAKAI

Relocate Mail Box & Post See Sht. C6 for Detail

Slope Easement

M.L. STA. 205+00

Slope Easement

NEW A.C. BERM

New Kamehameha V Highway
Sta. 205+09.65 to Sta. 205+19.78 o/s 5' Rt. from Edge of Pavement
Install 10 L.F. 4' High Wire Fence See Standard Plan D-03

Sta. 204+30.7 to Sta. 205+19.1 Rt. Approach: Install Fleet-350

LEGEND FOR AS-BUILT POSTINGS

- Squiggly line for as-built deletion
- Double line for as-built deletion
- Roadway Text for as-built posting

TO HALAWA

Meet Exist. Pavement (Sawcut) Saw cutting shall be considered incidental to various contract items. See Sht. C6 for Pavement Connection Detail.


END PROJECT
F.A. Project No. ER-12(4)
Sta. 207+72

NOTES:

- All stationings are based on new Kamehameha V Highway baseline.
- See Sht. C8 for Curve Data and Roadway Layout.

PLAN

Scale: 1"=20'

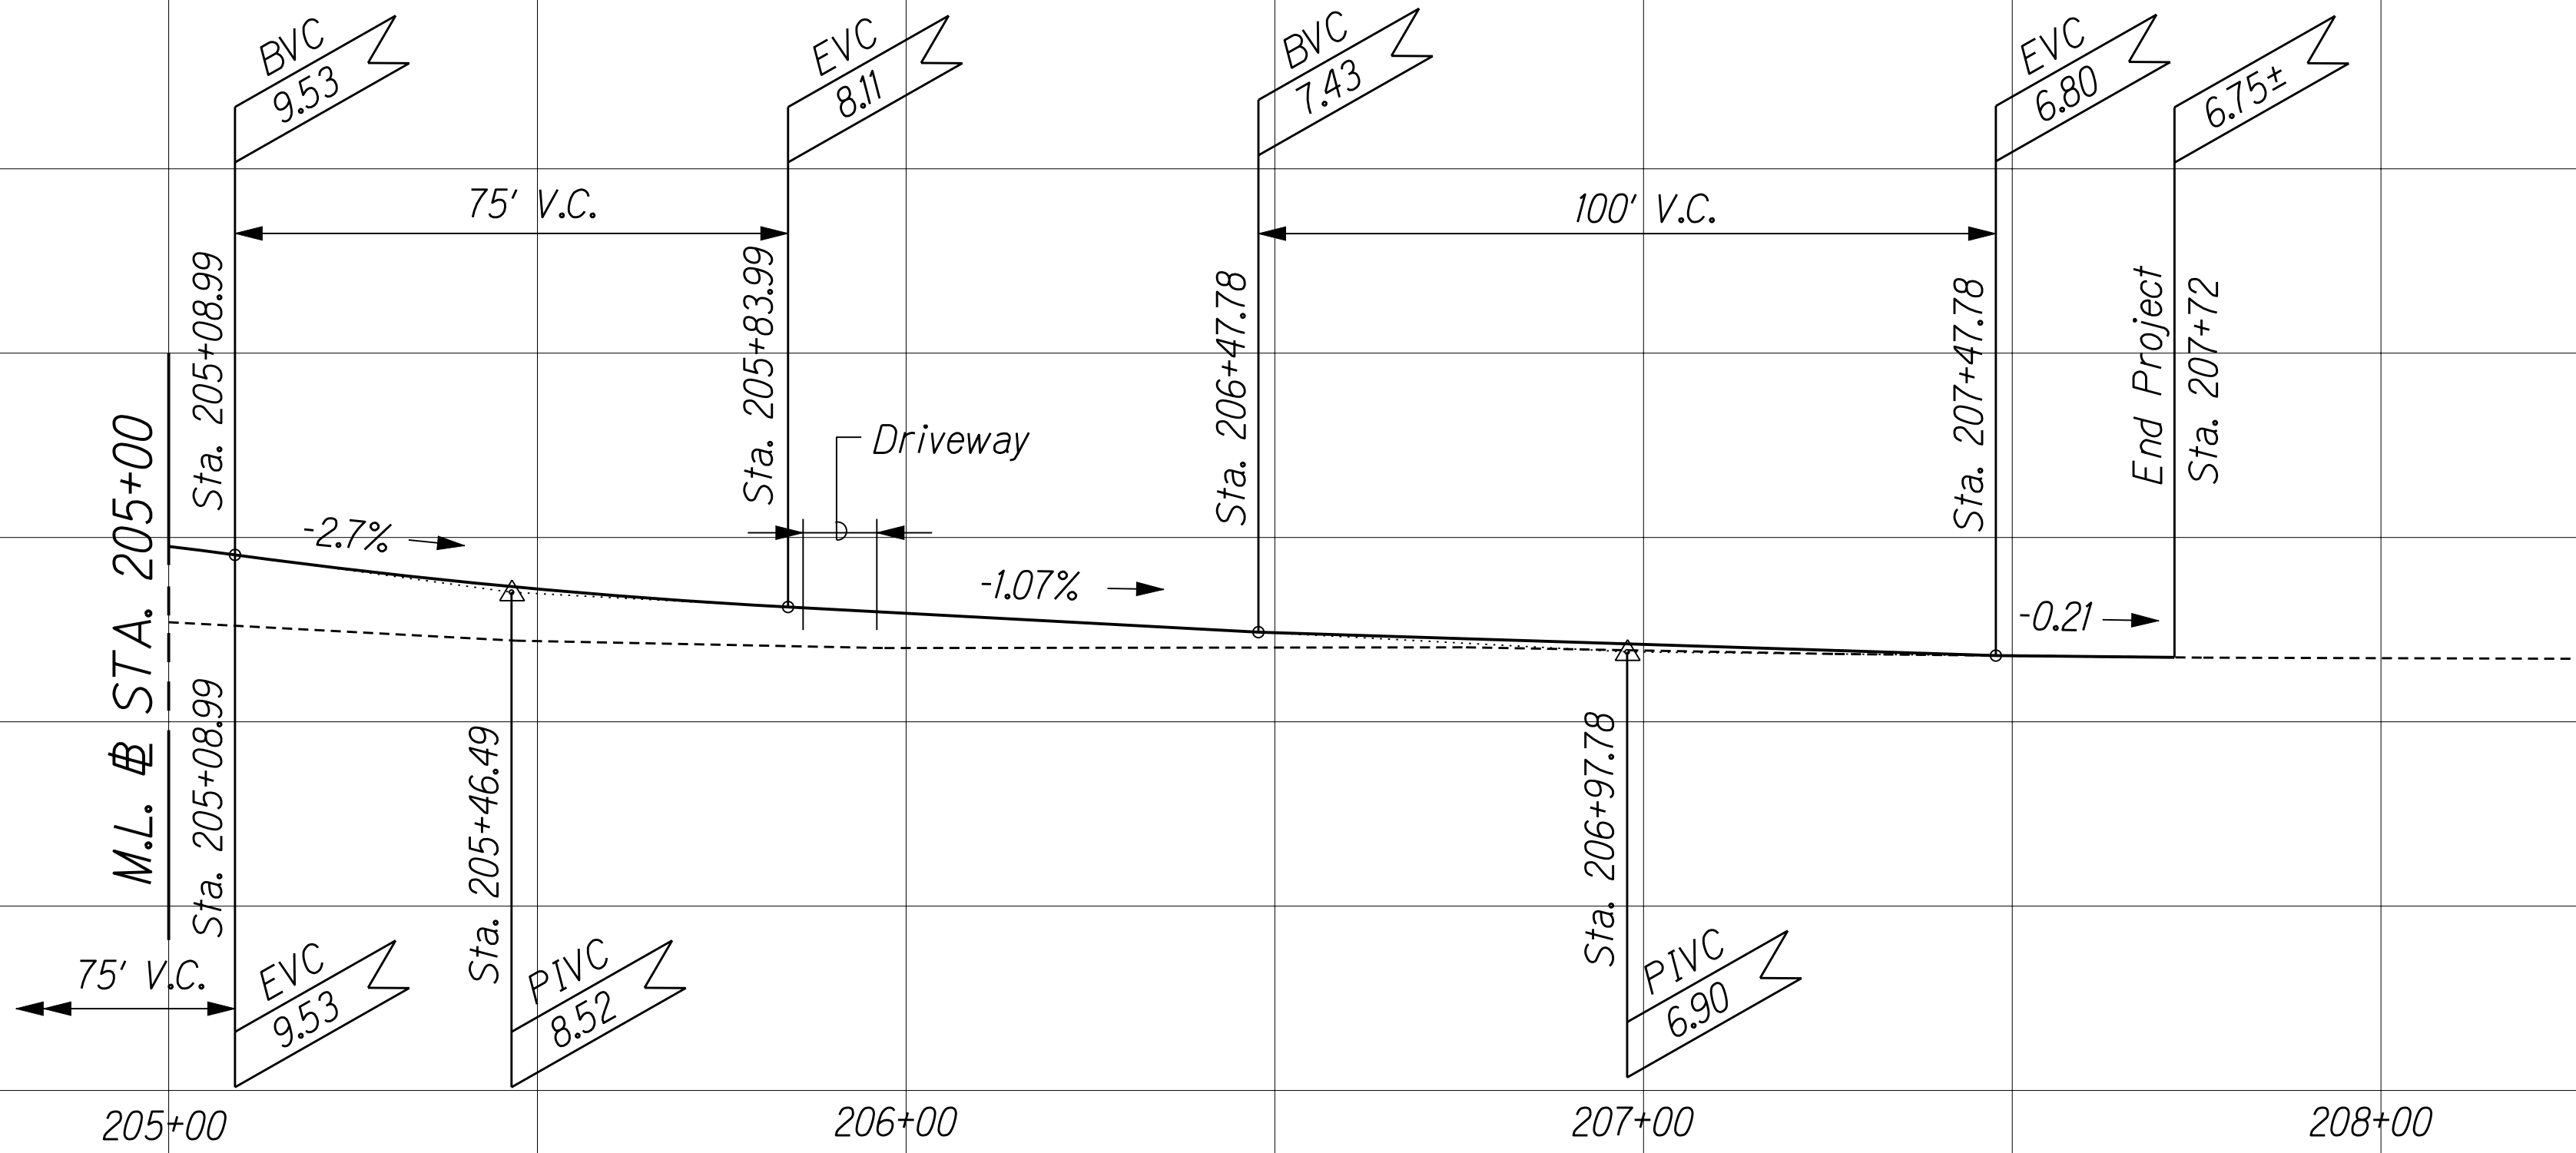

NOTE:

See Sht. C11 for Superelevation Diagram.

PROFILE

Scale: Horiz. 1"=20'
Vert. 1"=4'



THIS WORK WAS PREPARED BY ME OR UNDER MY SUPERVISION.

SIGNATURE

STATE OF HAWAII
DEPARTMENT OF TRANSPORTATION
HIGHWAYS DIVISION

ROADWAY PLAN & PROFILE

KAMEHAMEHA V HIGHWAY
EMERGENCY REPLACEMENT OF KAWAIKAPU BRIDGE
FEDERAL AID PROJECT NO. ER-12(4)

Scale: As Shown Date: April 30, 2001

SHEET No. C10 OF 46 SHEETS

"AS-BUILT"