

FED. ROAD DIST. NO.	STATE	FED. AID PROJ. NO.	FISCAL YEAR	SHEET NO.	TOTAL SHEETS
HAWAII	HAW.	ER-12(4)	2003	51	76

GIRDER BEARINGS:

1. *Girder concrete seats receiving elastomeric pads shall be poured monolithically with supporting structure. Top of concrete seats shall be finished with a steel trowel to a smooth level surface to the elevation shown on the plans.*
2. *Elastomeric pads: Bottom of bridge bearing pads shall be secured to the concrete seats, to prevent displacement with adhesives approved by the Engineer.*

CONSTRUCTION NOTES:

1. See Standard Specifications and Special Provisions.
2. In general, top of concrete deck slab shall be constructed to follow the roadway vertical and horizontal curves.
3. For the installation of anchor bolts, the Contractor shall provide rigid templates to maintain the proper locations and shall protect such anchor bolts at all times during the period of construction. Methods shall be approved by the Engineer.
4. Except as noted otherwise, all vertical dimensions are measured plumb.
5. The Contractor shall verify all site conditions and not rely upon these plans for utilities or stream location, etc. Conditions may differ from those shown.
6. The Contractor shall verify the location of all utility lines and notify the respective owners before commencing the work of excavation or the installation of drilled shafts, including any temporary piling or sheeting. Any damage to utility lines caused by the Contractor shall be replaced at his expense and at no cost to the State.
7. For concrete finish, see Standard Specifications.
8. Construction joints may be relocated or additional ones added, subject to the approval of the Engineer.
9. Unless noted otherwise, all exposed concrete edges shall be chamfered $3/4"$ x $3/4"$.
10. Concrete for closure pours in bridge deck and diaphragms to have admixtures to reduce setting time and drying shrinkage. See special provisions for requirements.

ADDITIONAL LOADS:

SEISMIC ACCELERATION COEFFICIENT:

MATERIALS:

Stainless Steel: Type 316.

Anchor Bolts: ASTM A325 Hot Dip Galvanized, unless noted otherwise.

Prestressed Concrete: $f'_c=6500$ PSI $f'_{ci}=5000$ PSI

All expansion and premolded joint filler shall be incidental to concrete and will not be paid for separately.

All welding shall be in accordance with the current edition of Reinforcing Steel Welding Code AWS D 1.4.

REINFORCEMENT:

1. The minimum clear cover measured from the surface of the concrete to the face of any reinforcing bar shall be as follows, except as noted otherwise.
 - A. Abutments, retaining walls, channel construction. 2"
 - B. Concrete cast against and permanently exposed to earth. . 3"
 - C. Bridge Deck: Bottom bars. 1 1/2"
Top bars. 2"
 - D. Drilled Shaft: 5" to spiral
2. Reinforcing shall be detailed in accordance with the latest editions of CRSI "Placing Reinforcing Bars" and ACI "Manual of Standard Practice" and the "Detailing Manual", unless noted otherwise.
3. Dimensions relating to reinforcing (E.G. spacing of bars) are to center of bars, unless noted otherwise.
4. Reinforcing bars shall be securely tied at all intersections and lap splices except where the spacing of intersections is less than one foot in each direction, in which case alternate intersections shall be tied.

GENERAL:


1. All items noted incidental will not be paid for separately.
2. Standard detail drawings refer to all structures in general, except for modifications as may be required for special conditions. For such modifications, refer to the corresponding detailed drawings.
3. For electrical conduit location details, see electrical drawings.

FOUNDATION:

1. *General:*
 - A. *The pay limits for excavation shown on the standard plans should not be considered as indicative of actual excavation requirements.*
 - B. *The Contractor shall assume sole responsibility for the construction and safety of all footing excavations. The Contractor shall submit his excavation plan to the Engineer for review, although such review will not absolve the Contractor from sole responsibility, as described.*
2. *A geotechnical report titled, "Geotechnical Engineering Exploration, Kamehameha V Highway, Emergency Replacement of Kawaikapu Bridge, Federal Aid Project No. ER-12(4), Island of Molokai, Hawaii" dated March 2001, by Geolabs, Inc., has been prepared and is available for review at the office of the Engineer.*

[illegible]


THIS WORK WAS PREPARED BY
ME OR UNDER MY SUPERVISION


Signature
April 30, 2004


Expiration Date of the License

DATE	REVISION
<p>STATE OF HAWAII</p> <p>DEPARTMENT OF TRANSPORTATION</p> <p>HIGHWAYS DIVISION</p>	
<p><u>GENERAL NOTES AND SUMMARY</u></p> <p><u>OF ESTIMATED QUANTITIES</u></p>	
<p><u><i>KAMEHAMEHA V HIGHWAY</i></u></p> <p><u><i>EMERGENCY REPLACEMENT OF KAWAIKAPU BRIDGE</i></u></p> <p><u><i>FEDERAL AID PROJECT NO. ER-12(4)</i></u></p>	
<p><i>Scale: As Noted</i> <i>Date: Nov. 25, 2002</i></p>	
<p>SHEET NO. S-1 OF 16 SHEETS</p>	


FED. ROAD DIST. NO.	STATE	FED. AID PROJ. NO.	FISCAL YEAR	SHEET NO.	TOTAL SHEETS
HAWAII	HAW.	ER-12(4)	2003	52	76

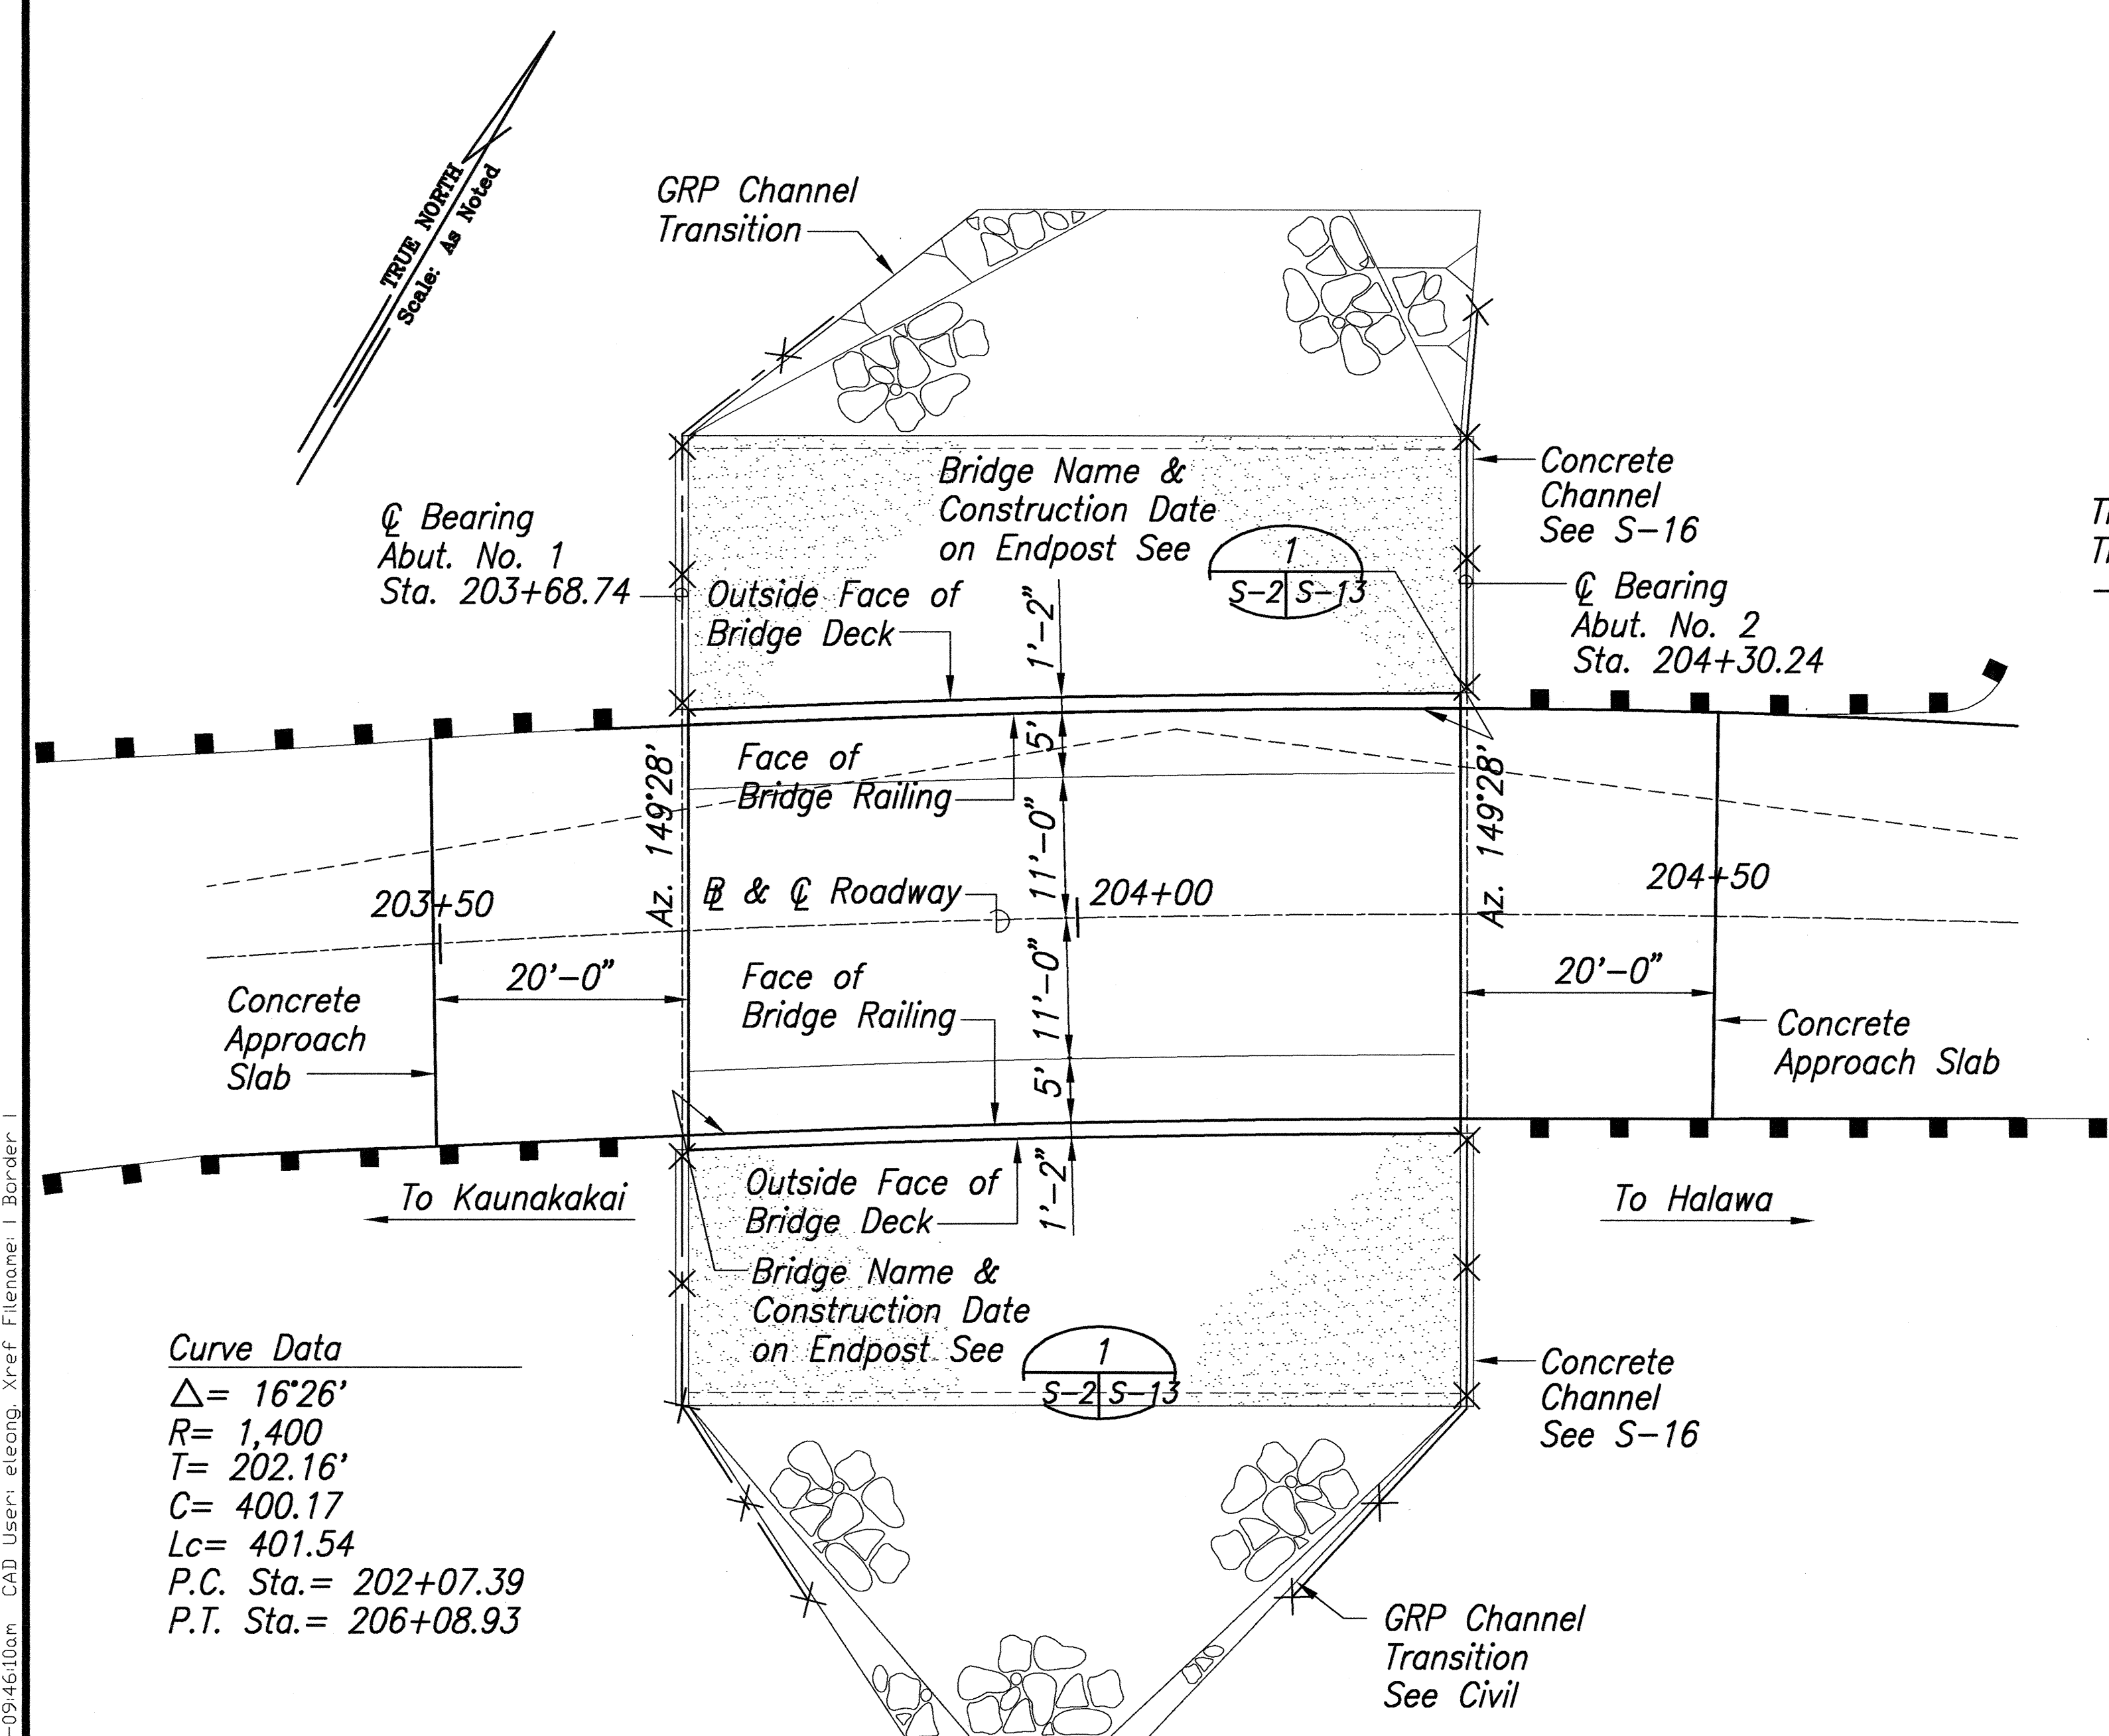

STRUCTURAL LAYOUT PLAN
Scale: 1"=10'

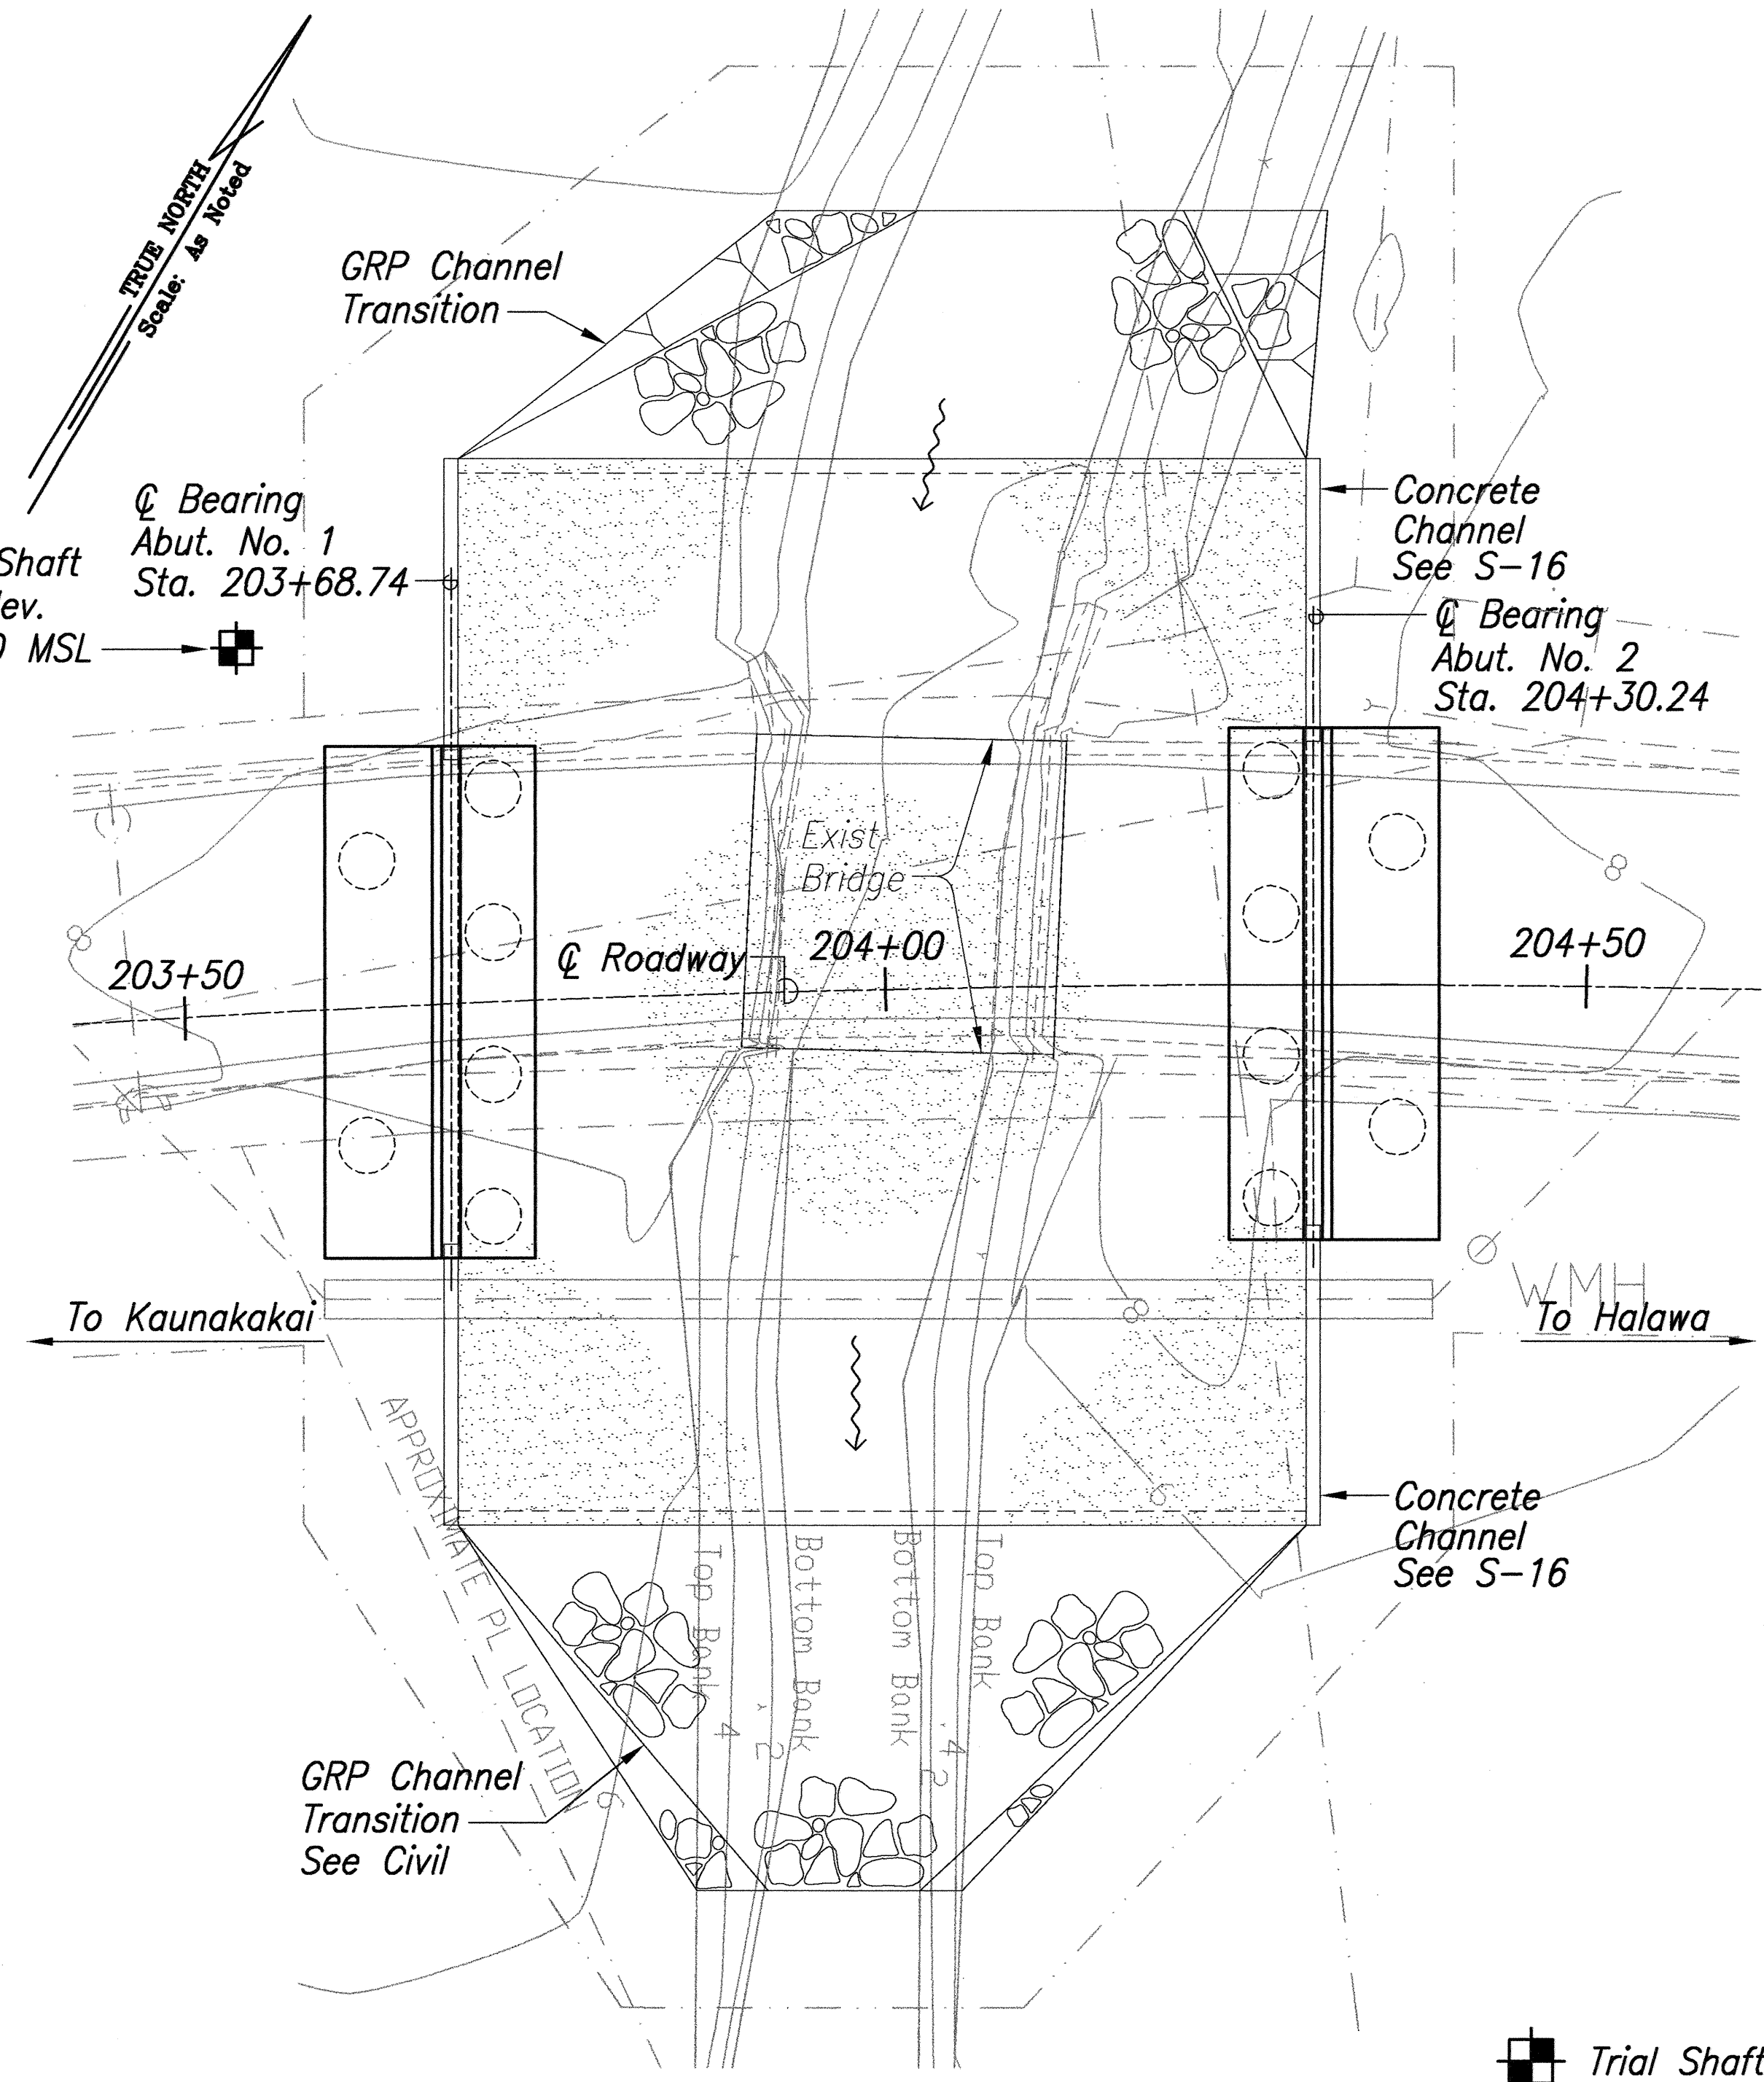

FOUNDATION PLAN
Scale: 1"=10'

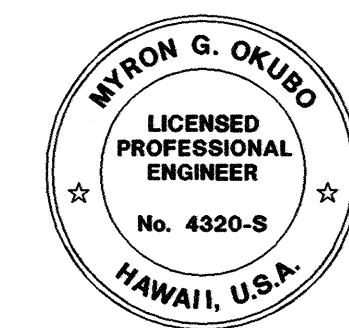

THIS WORK WAS PREPARED BY
ME OR UNDER MY SUPERVISION
Signature
April 30, 2004
Expiration Date of the License



DATE	REVISION
STATE OF HAWAII DEPARTMENT OF TRANSPORTATION HIGHWAYS DIVISION LAYOUT AND FOUNDATION PLANS KAMEHAMEHA V HIGHWAY EMERGENCY REPLACEMENT OF KAWAIKAPU BRIDGE FEDERAL AID PROJECT NO. ER-12(4) Scale: As Noted Date: Nov. 25, 2002 SHEET No. S-2 OF 16 SHEETS	

SURVEY PLOTTED BY	DATE
DRAWN BY	
DESIGNED BY	
CHECKED BY	
QUANTITIES BY	
NO.	


Path: L:\Voa\6465-01\STR File\name: S2 Plot date: Jan 17, 2003-09:46:00am CAD User: eleong, Xref File: none, I Border

FED. ROAD DIST. NO.	STATE	FED. AID PROJ. NO.	FISCAL YEAR	SHEET NO.	TOTAL SHEETS
HAWAII	HAW.	ER-12(4)	2003	53	76

(H) Hinged Girder End
(E) Expansion Girder End

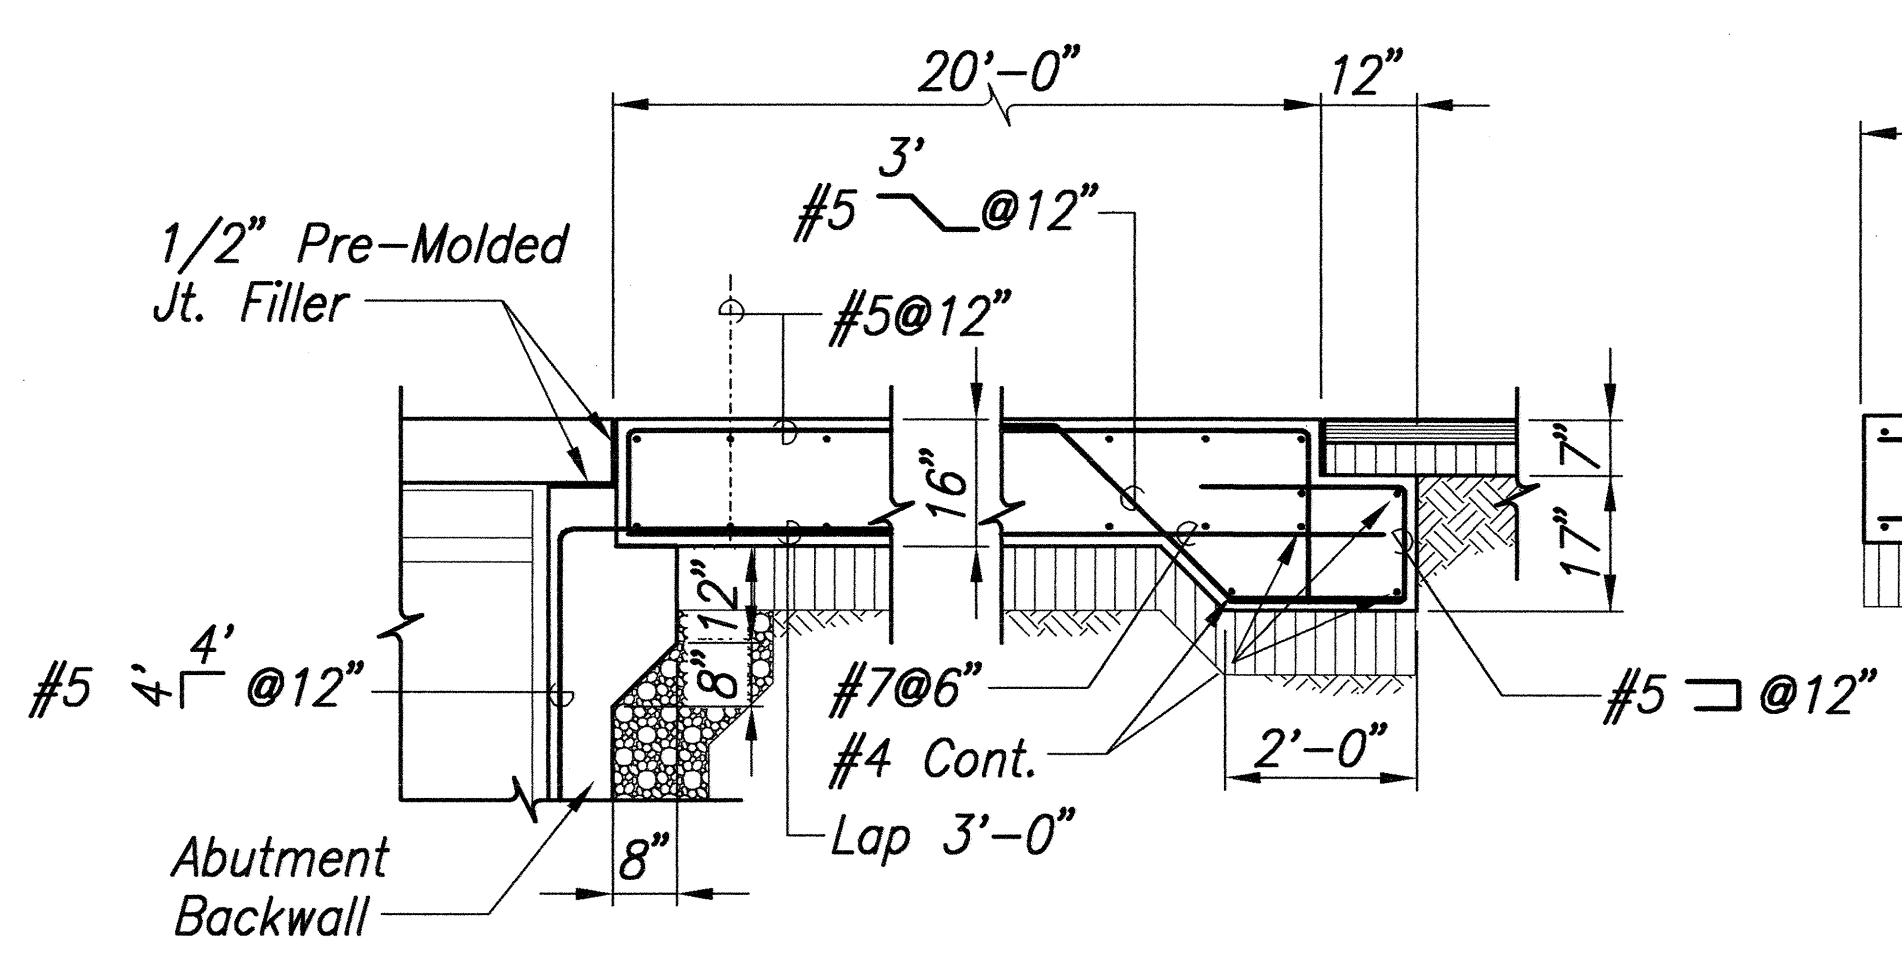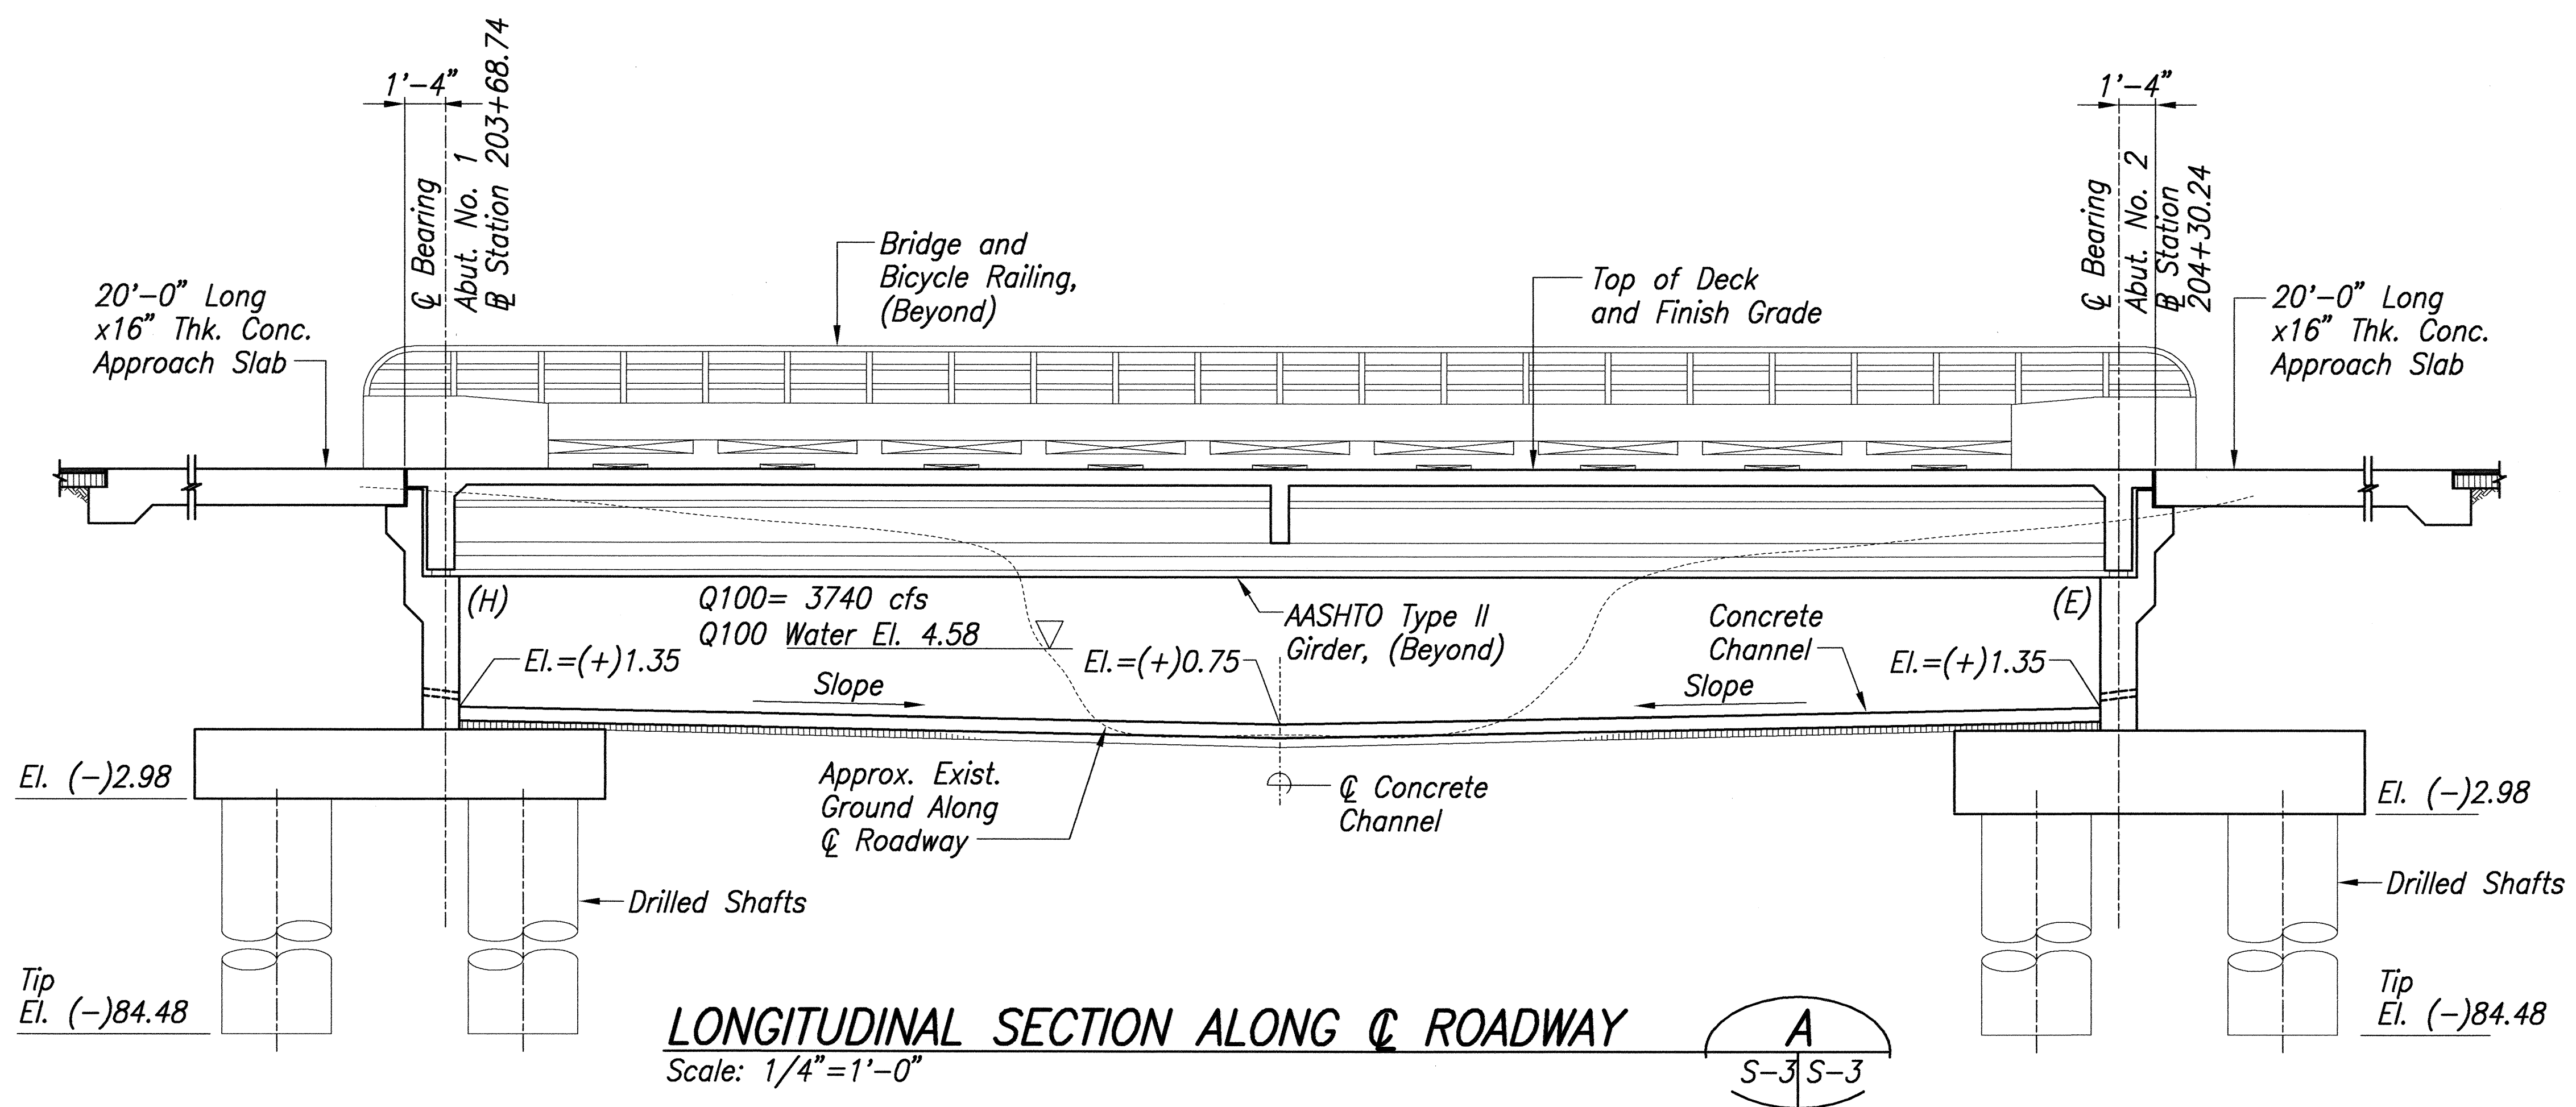

APPROACH SLAB DETAIL
Scale: 1/2" = 1'-0"

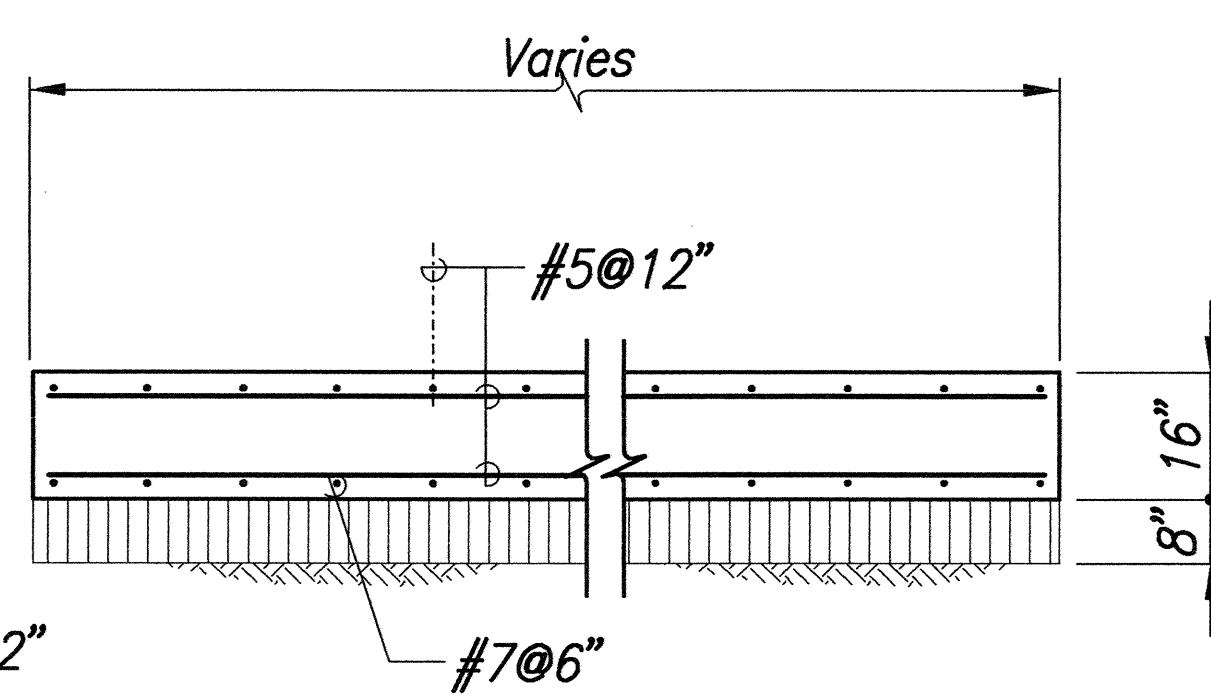

APPROACH SLAB TRANSVERSE SECTION
Scale: 1/2" = 1'-0"





THIS WORK WAS PREPARED BY ME OR UNDER MY SUPERVISION
Signature: *Myron G. Okubo*
April 30, 2004
Expiration Date of the License



DATE	REVISION
	<p>STATE OF HAWAII DEPARTMENT OF TRANSPORTATION HIGHWAYS DIVISION</p> <p>LONGITUDINAL SECTION</p> <p>KAMEHAMEHA V HIGHWAY EMERGENCY REPLACEMENT OF KAWAIKAPU BRIDGE FEDERAL AID PROJECT NO. ER-12(4)</p> <p>Scale: As Noted Date: Nov. 25, 2002</p>

SHEET No. S-3 OF 16 SHEETS

FED. ROAD DIST. NO.	STATE	FED. AID PROJ. NO.	FISCAL YEAR	SHEET NO.	TOTAL SHEETS
HAWAII	HAW.	ER-12(4)	2003	54	76

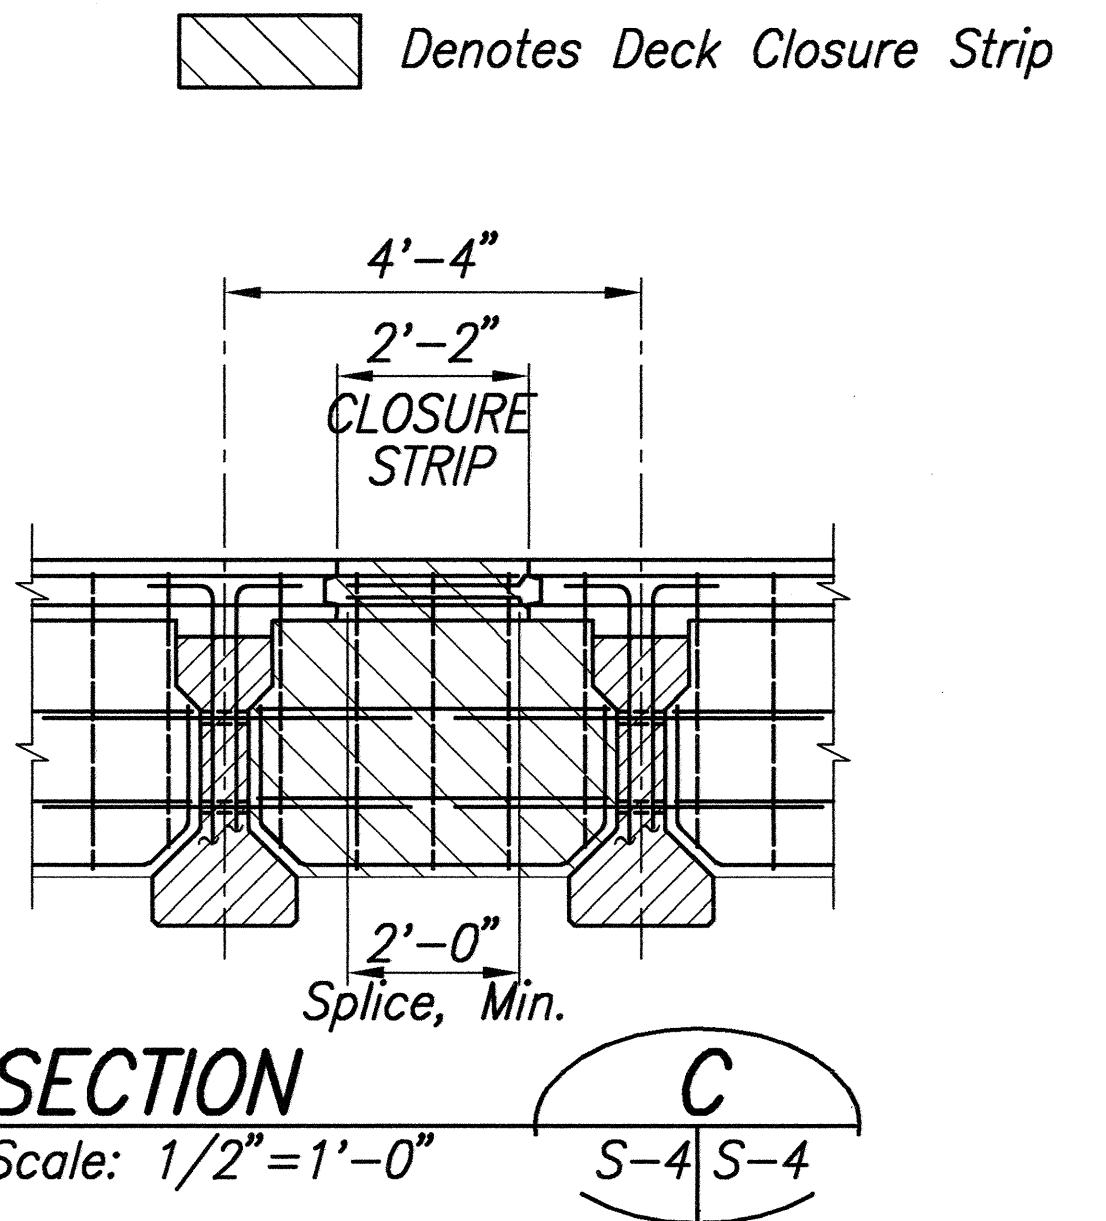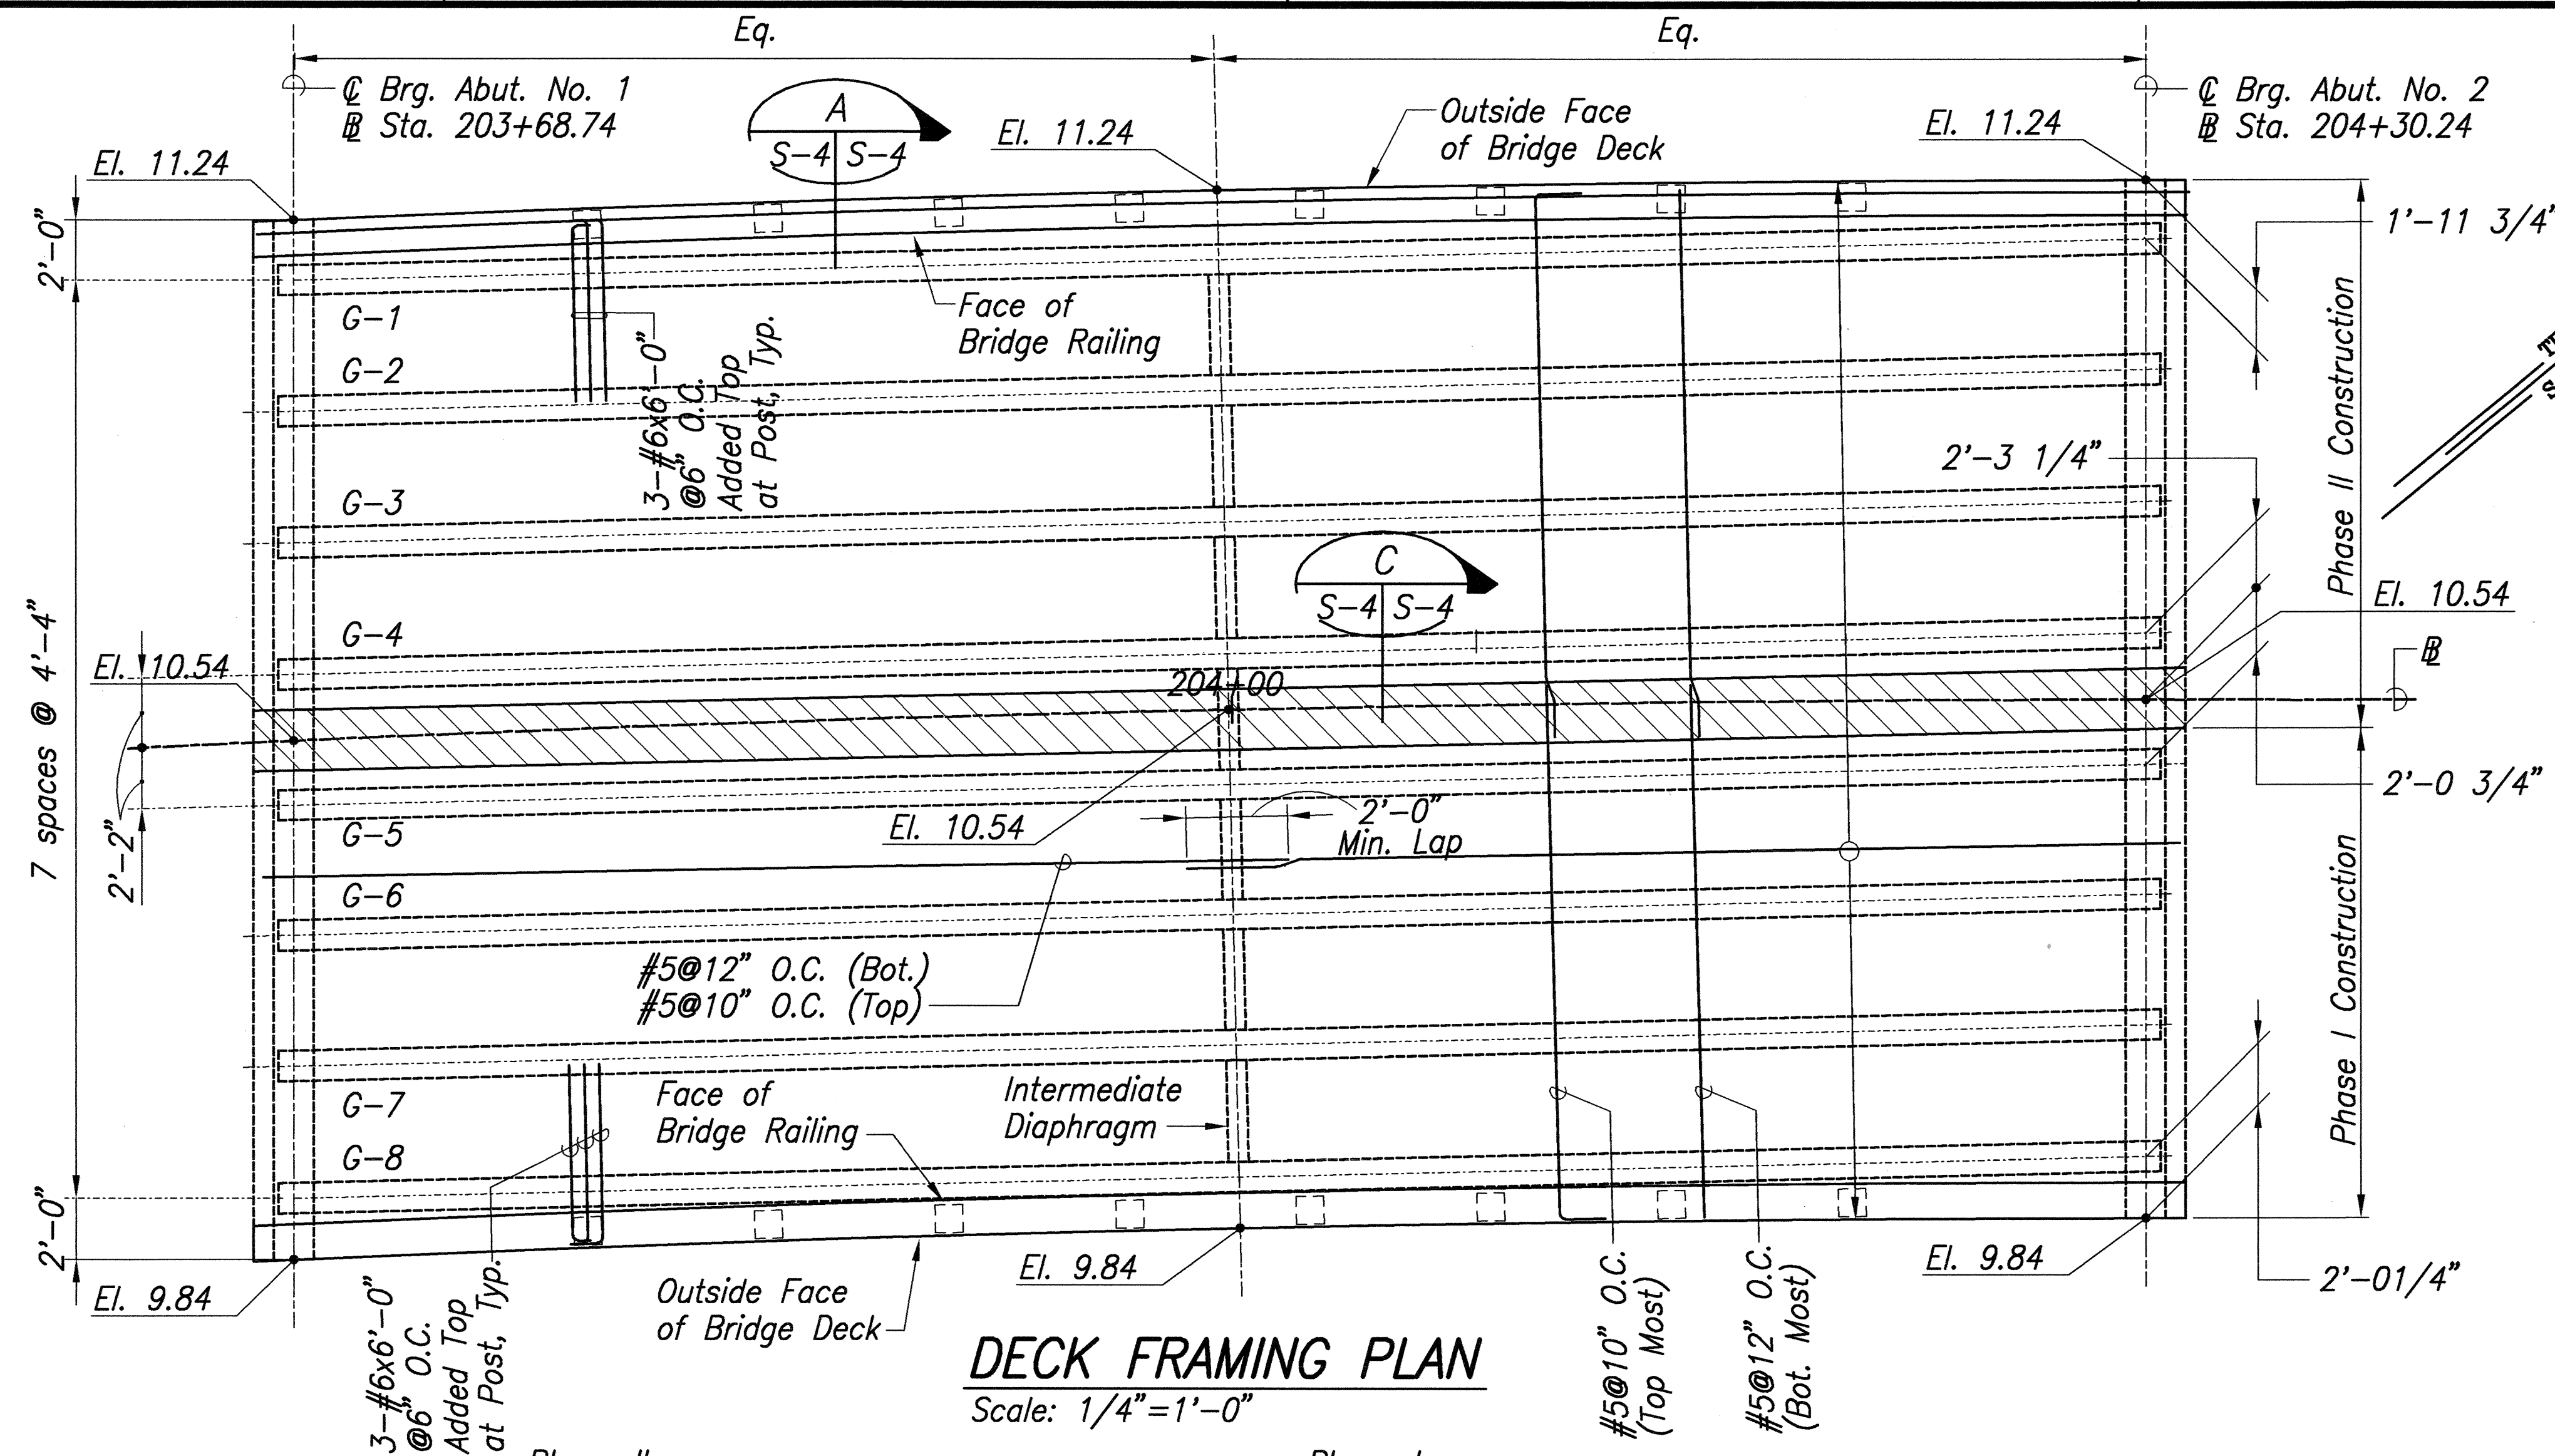


Note:
See Specifications for additional requirements. For Closure Pour Concrete Shall Obtain A Minimum Compressive Strength Of 3500 PSI Before The Bridge Is Opened To General Traffic. Contractor Shall Control Traffic To Be Keep As Far As Practical From Closure Pour And To Keep Vehicle Speed As Slow As Possible.

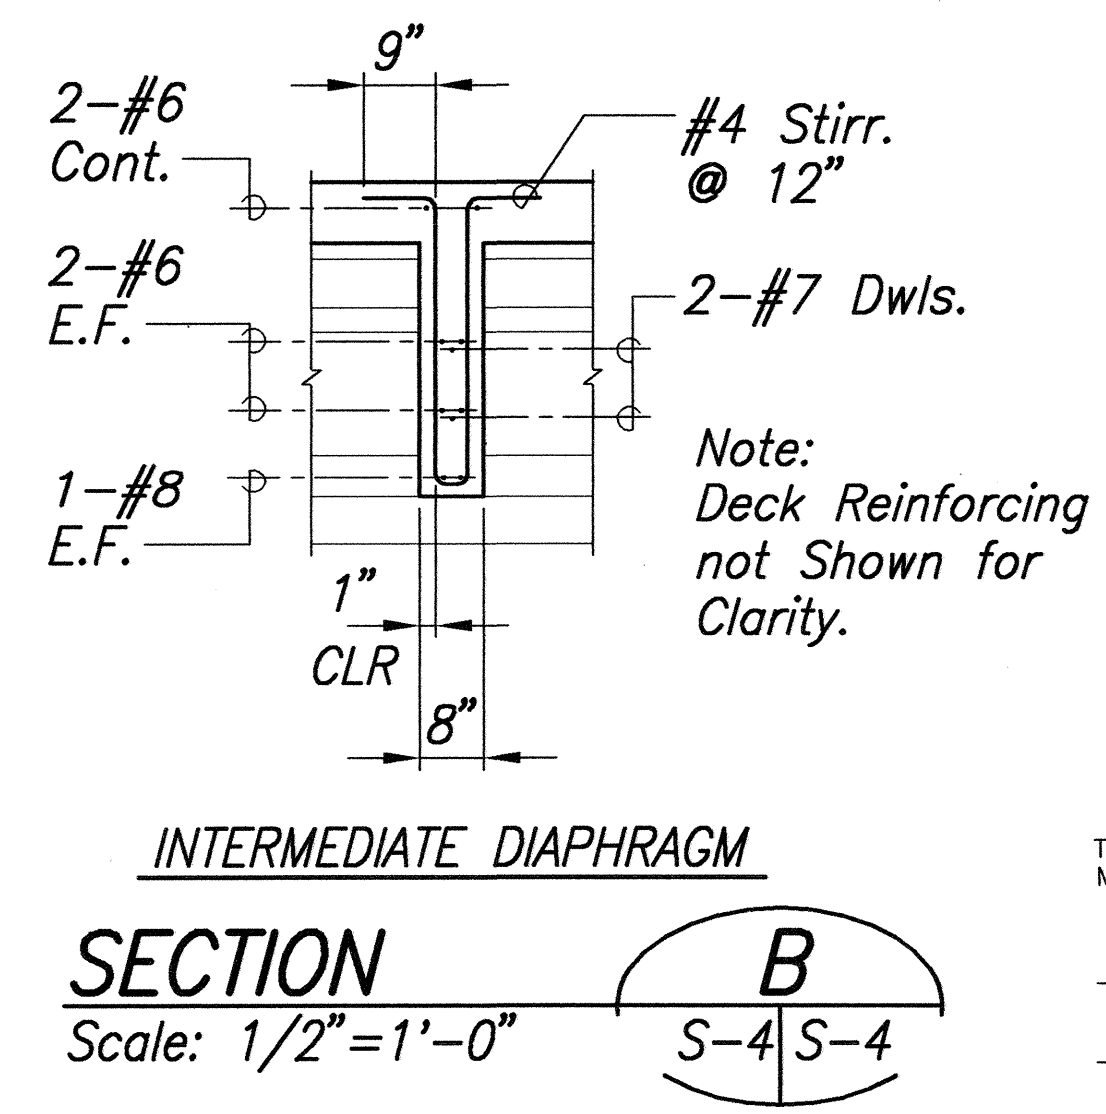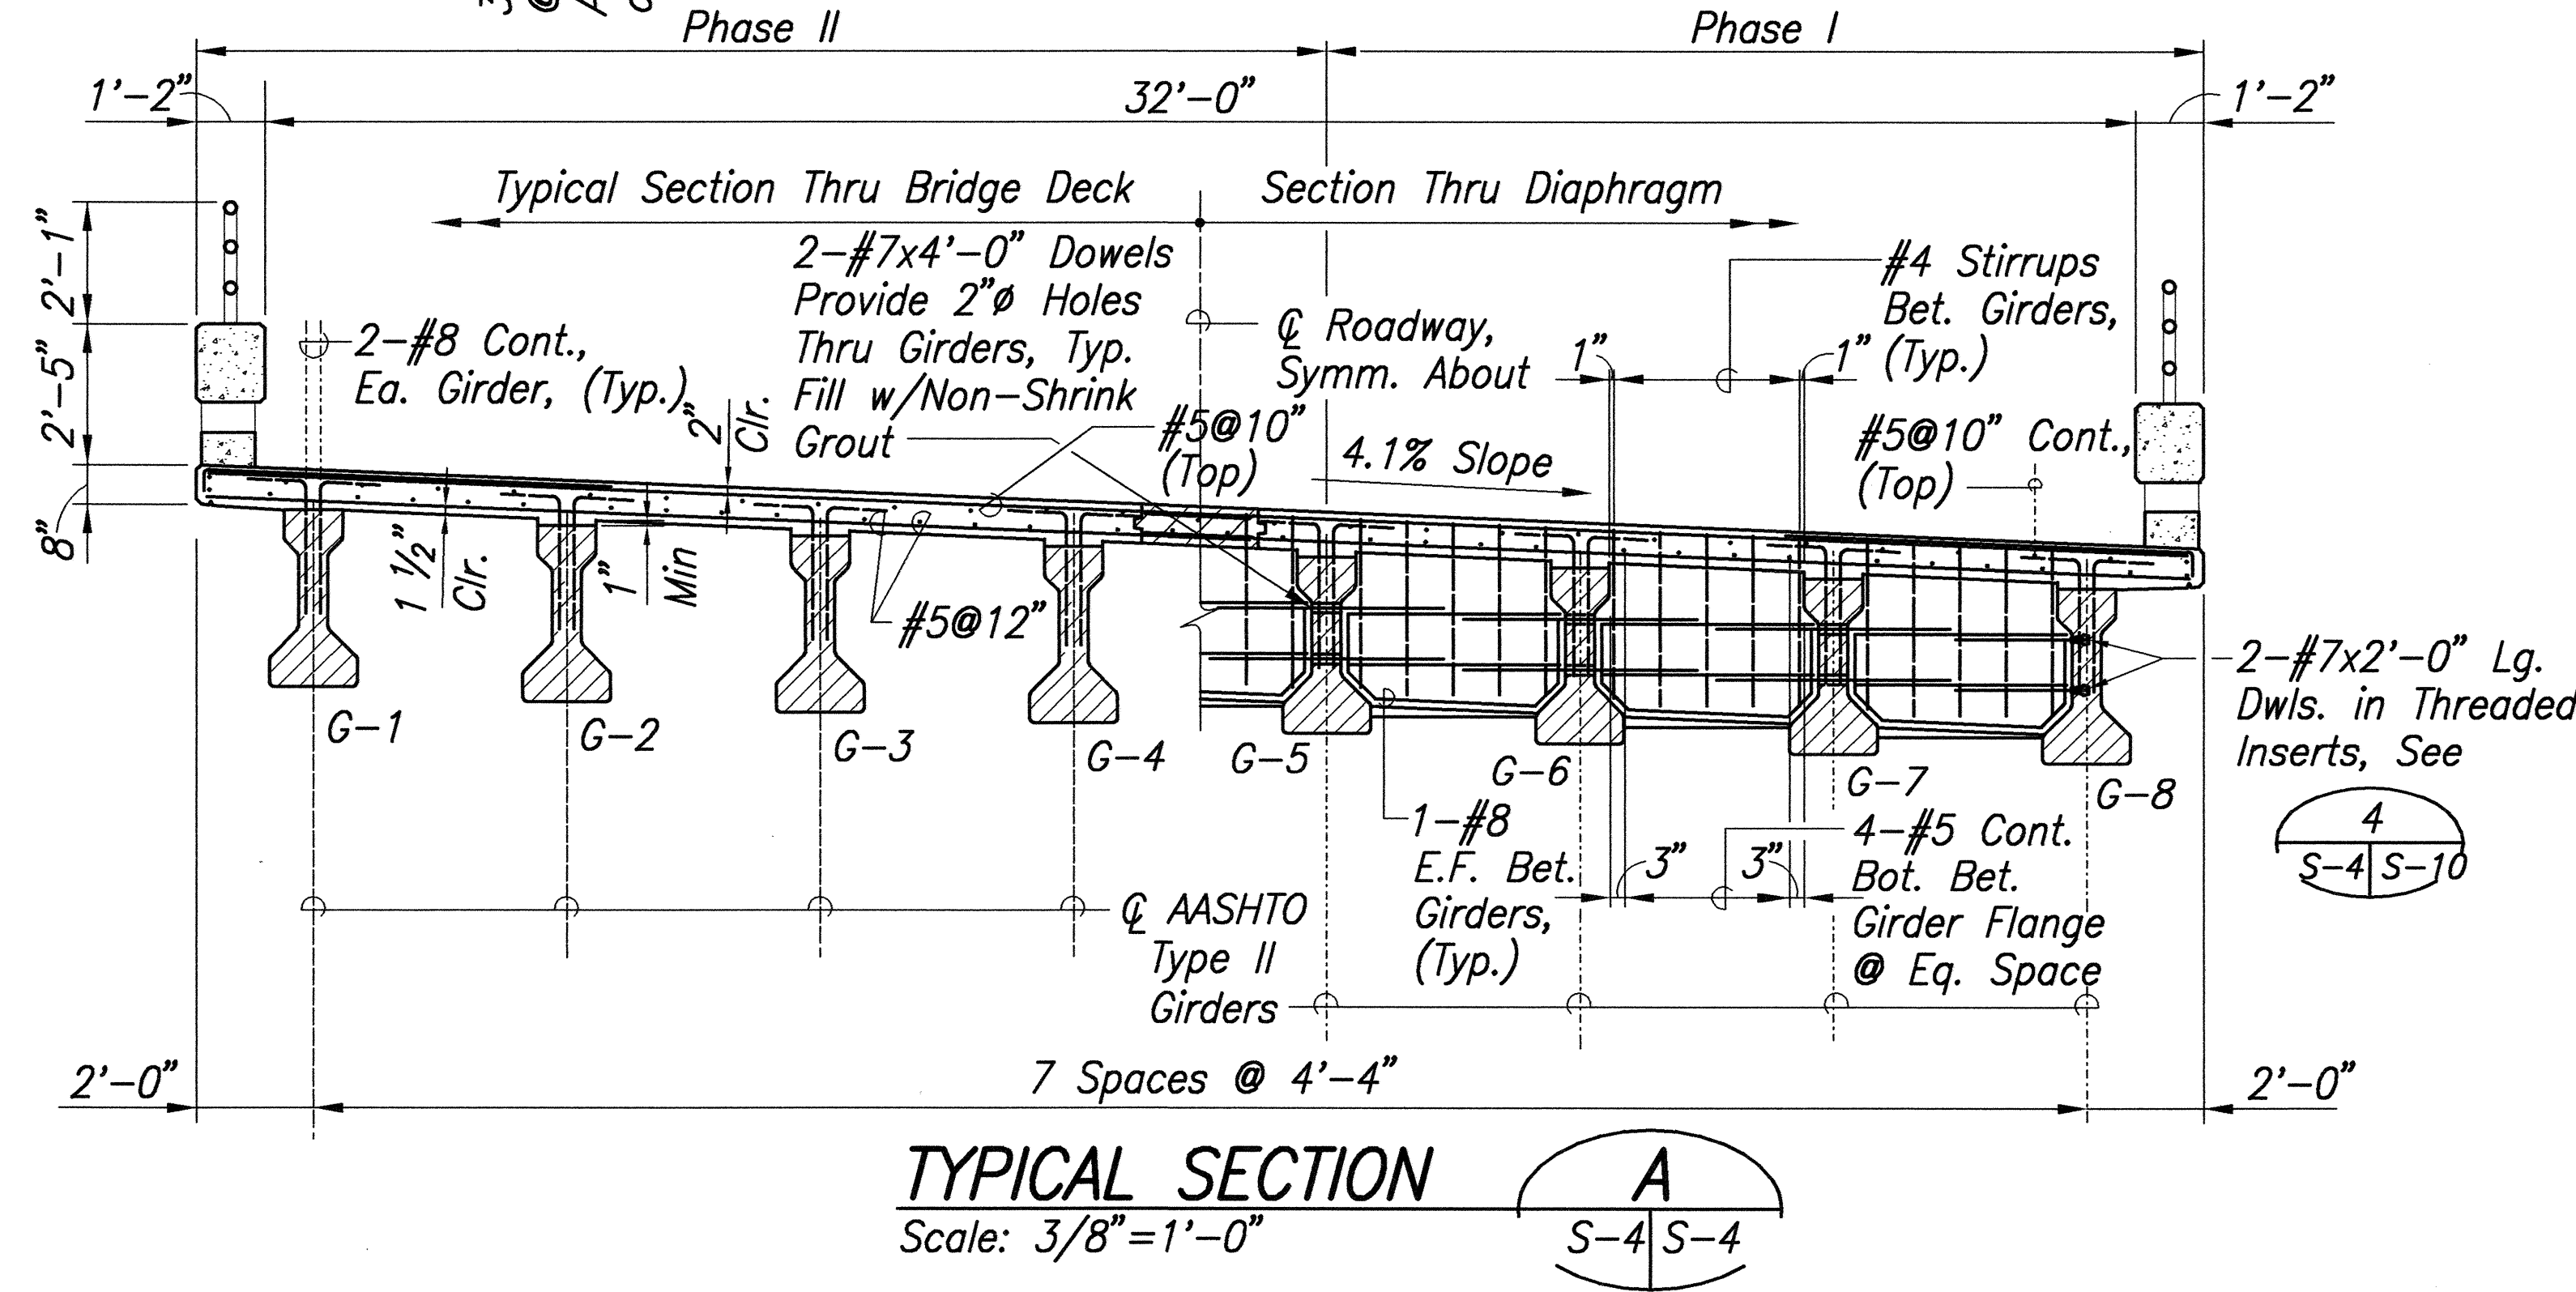

SURVEY PLOTTED BY	DATE
DRAWN BY	
DESIGNED BY	
QUANTITIES BY	
CHECKED BY	


Path: L:\Woods\6465-0\STR File Name: S4 Plot date: Jan 17, 2003-09:51:45am CAD User: eleong Xref File Name: ? Border ?

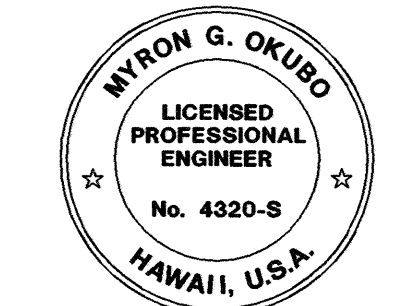

THIS WORK WAS PREPARED BY ME OR UNDER MY SUPERVISION
Signature
April 30, 2004
Expiration Date of the License



DATE	REVISION
STATE OF HAWAII DEPARTMENT OF TRANSPORTATION HIGHWAYS DIVISION DECK FRAMING PLAN, SECTIONS AND DETAILS KAMEHAMEHA V HIGHWAY EMERGENCY REPLACEMENT OF KAWAIKAPU BRIDGE FEDERAL AID PROJECT NO. ER-12(4) Scale: As Noted Date: Nov. 25, 2002	
SHEET NO. S-4 OF 16 SHEETS	

FED. ROAD DIST. NO.	STATE	FED. AID PROJ. NO.	FISCAL YEAR	SHEET NO.	TOTAL SHEETS
HAWAII	HAW.	ER-12(4)	2003	55	76

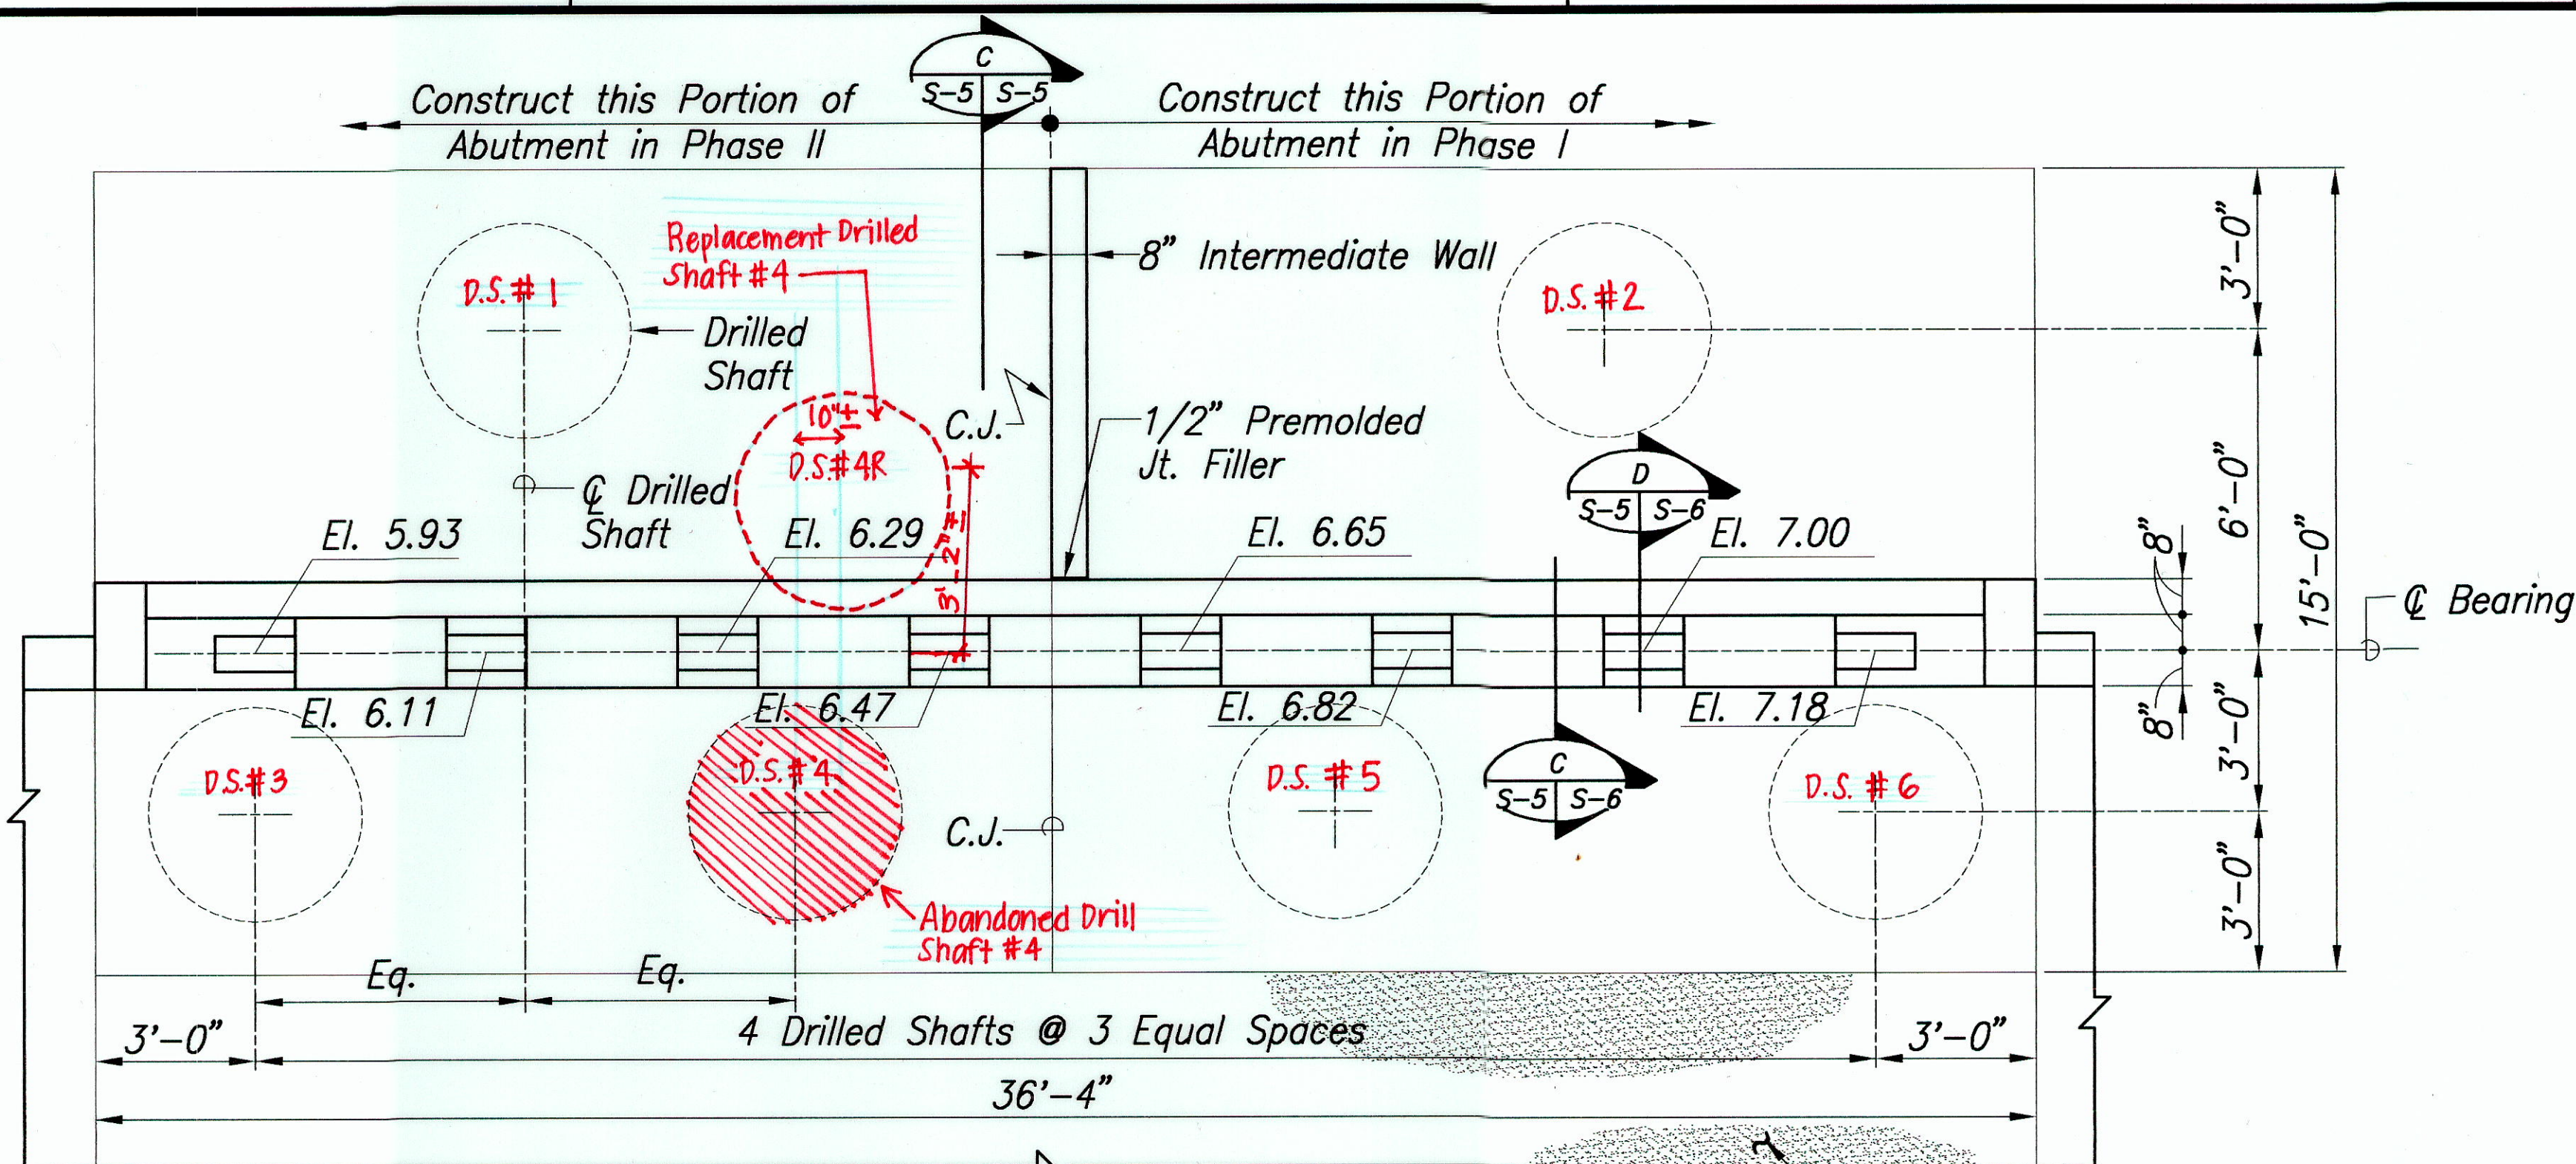


ABUTMENT NO. 1 PLAN

Scale: None

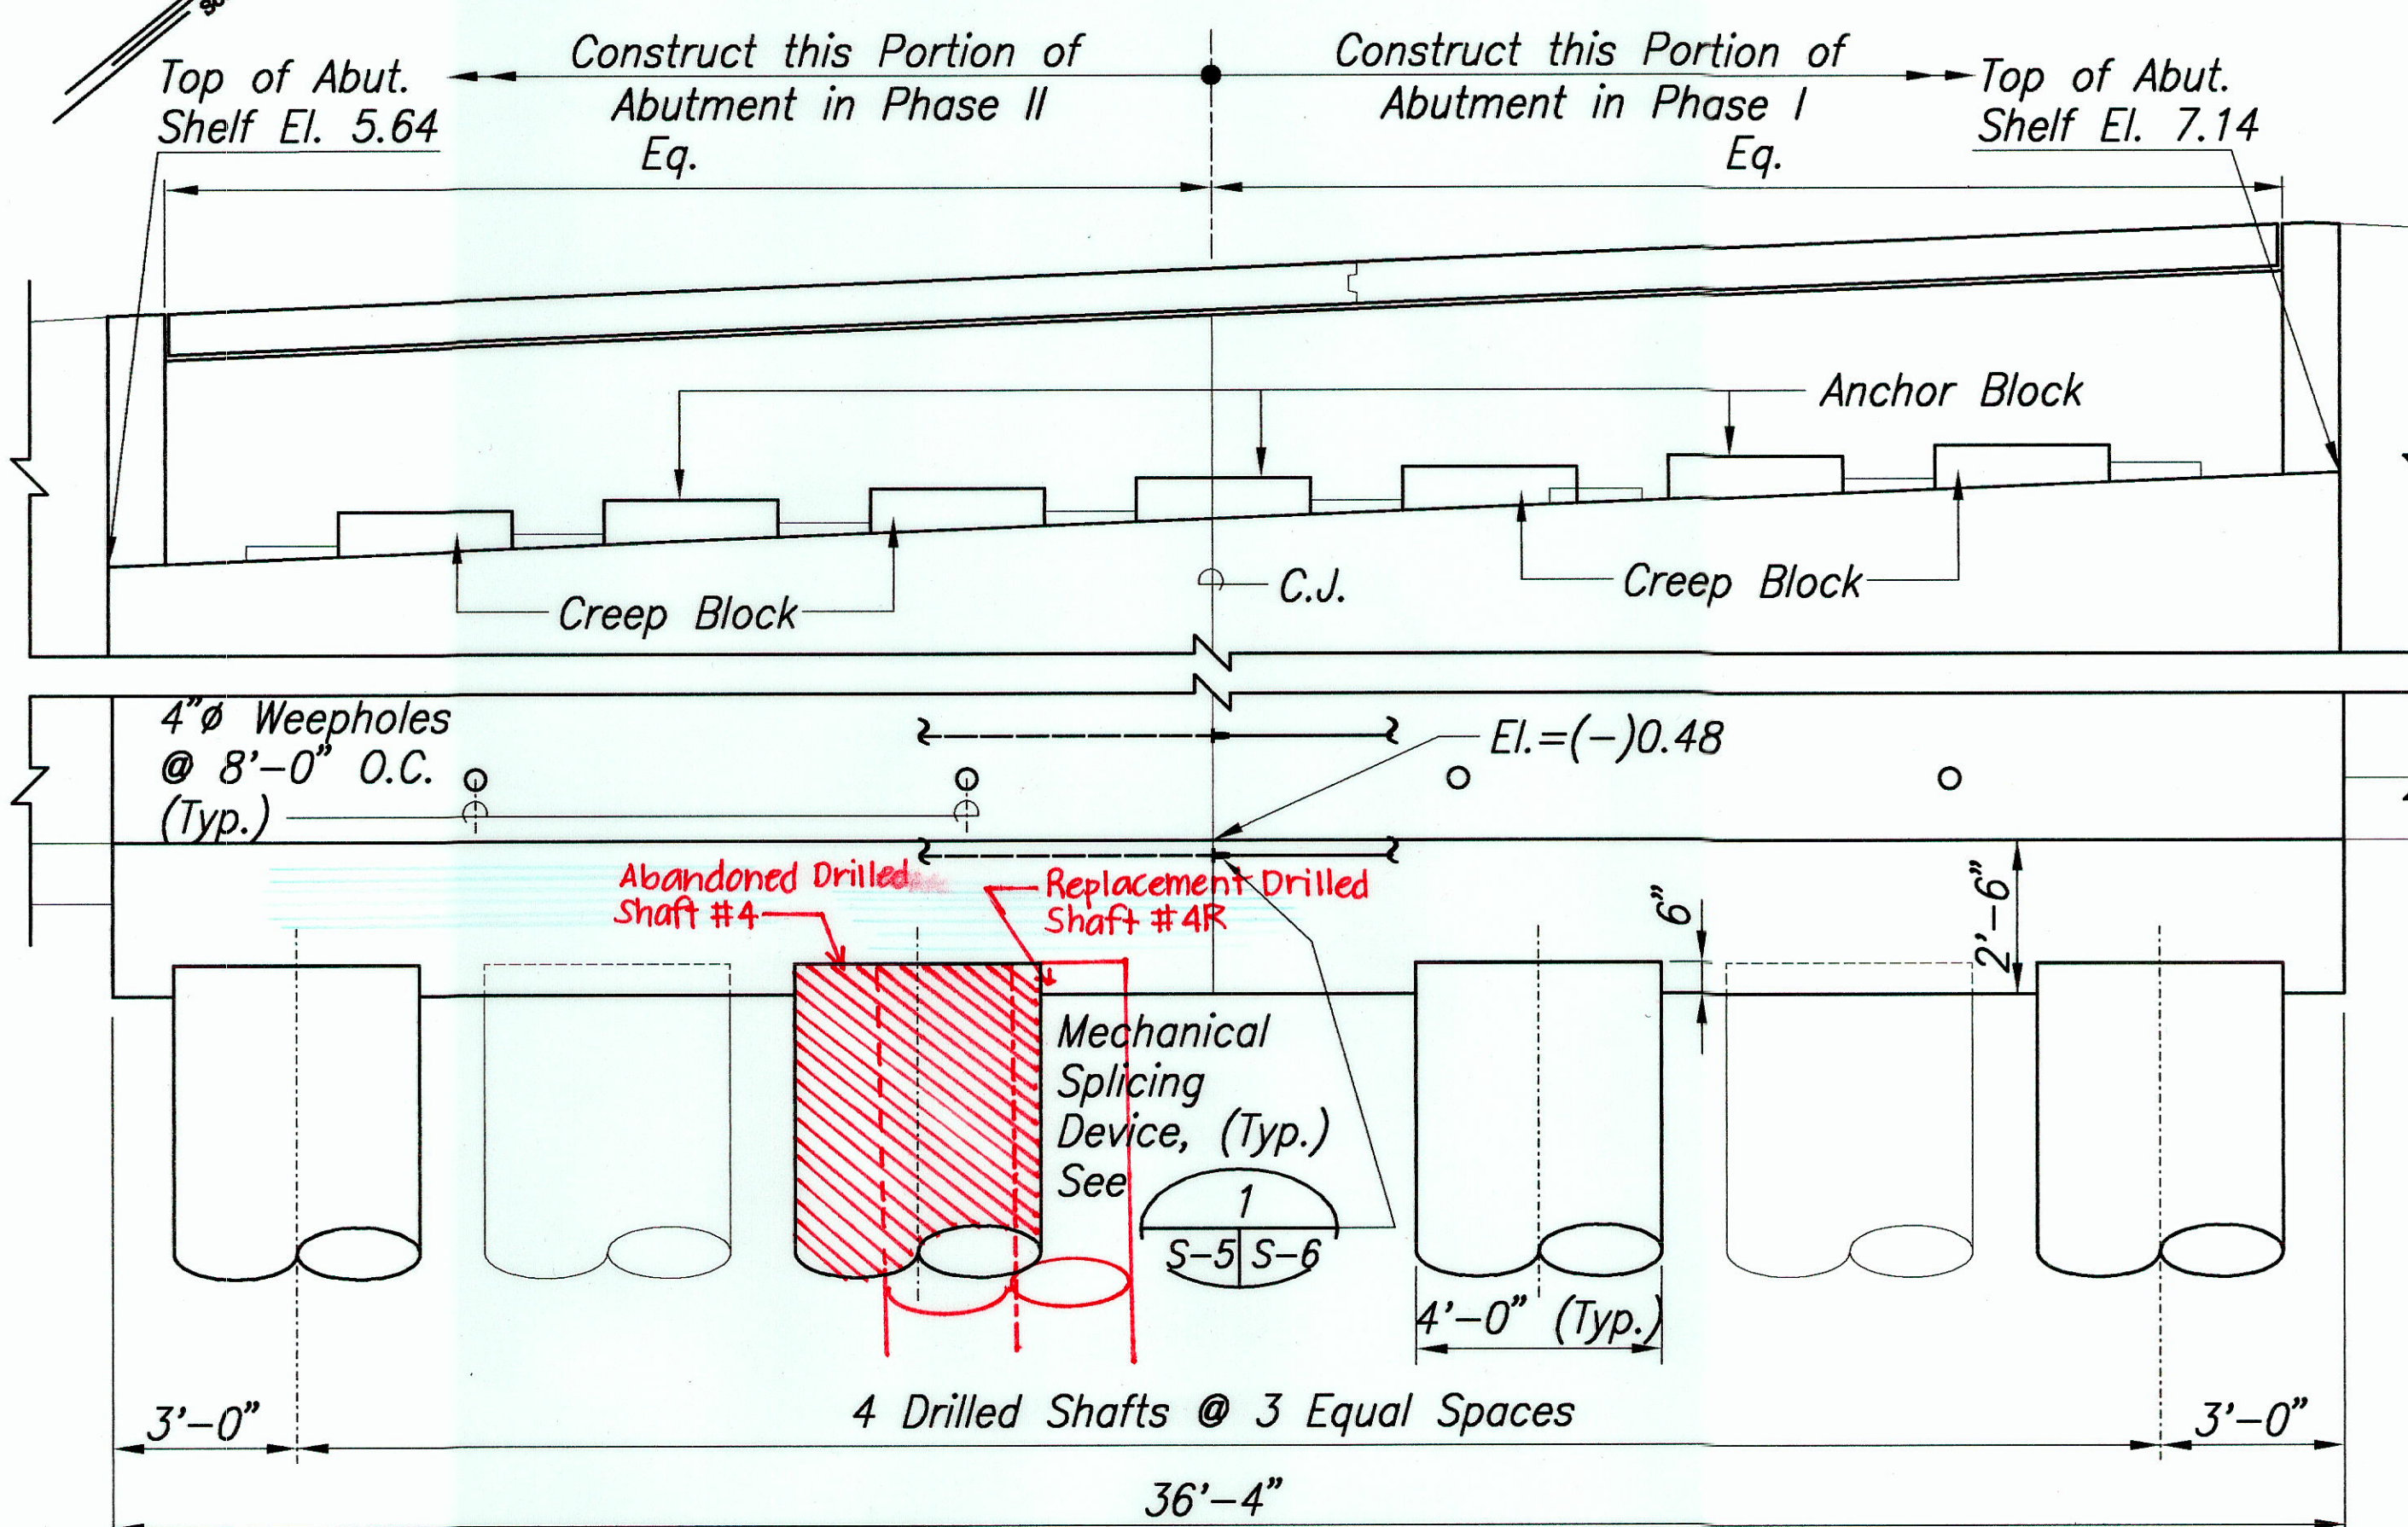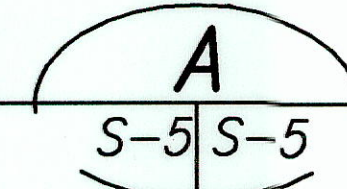


ABUTMENT NO. 1 ELEVATION

Scale: None


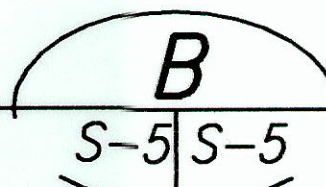


Note:
Creep and Anchor block
Details Shown on Sheet
S-7.

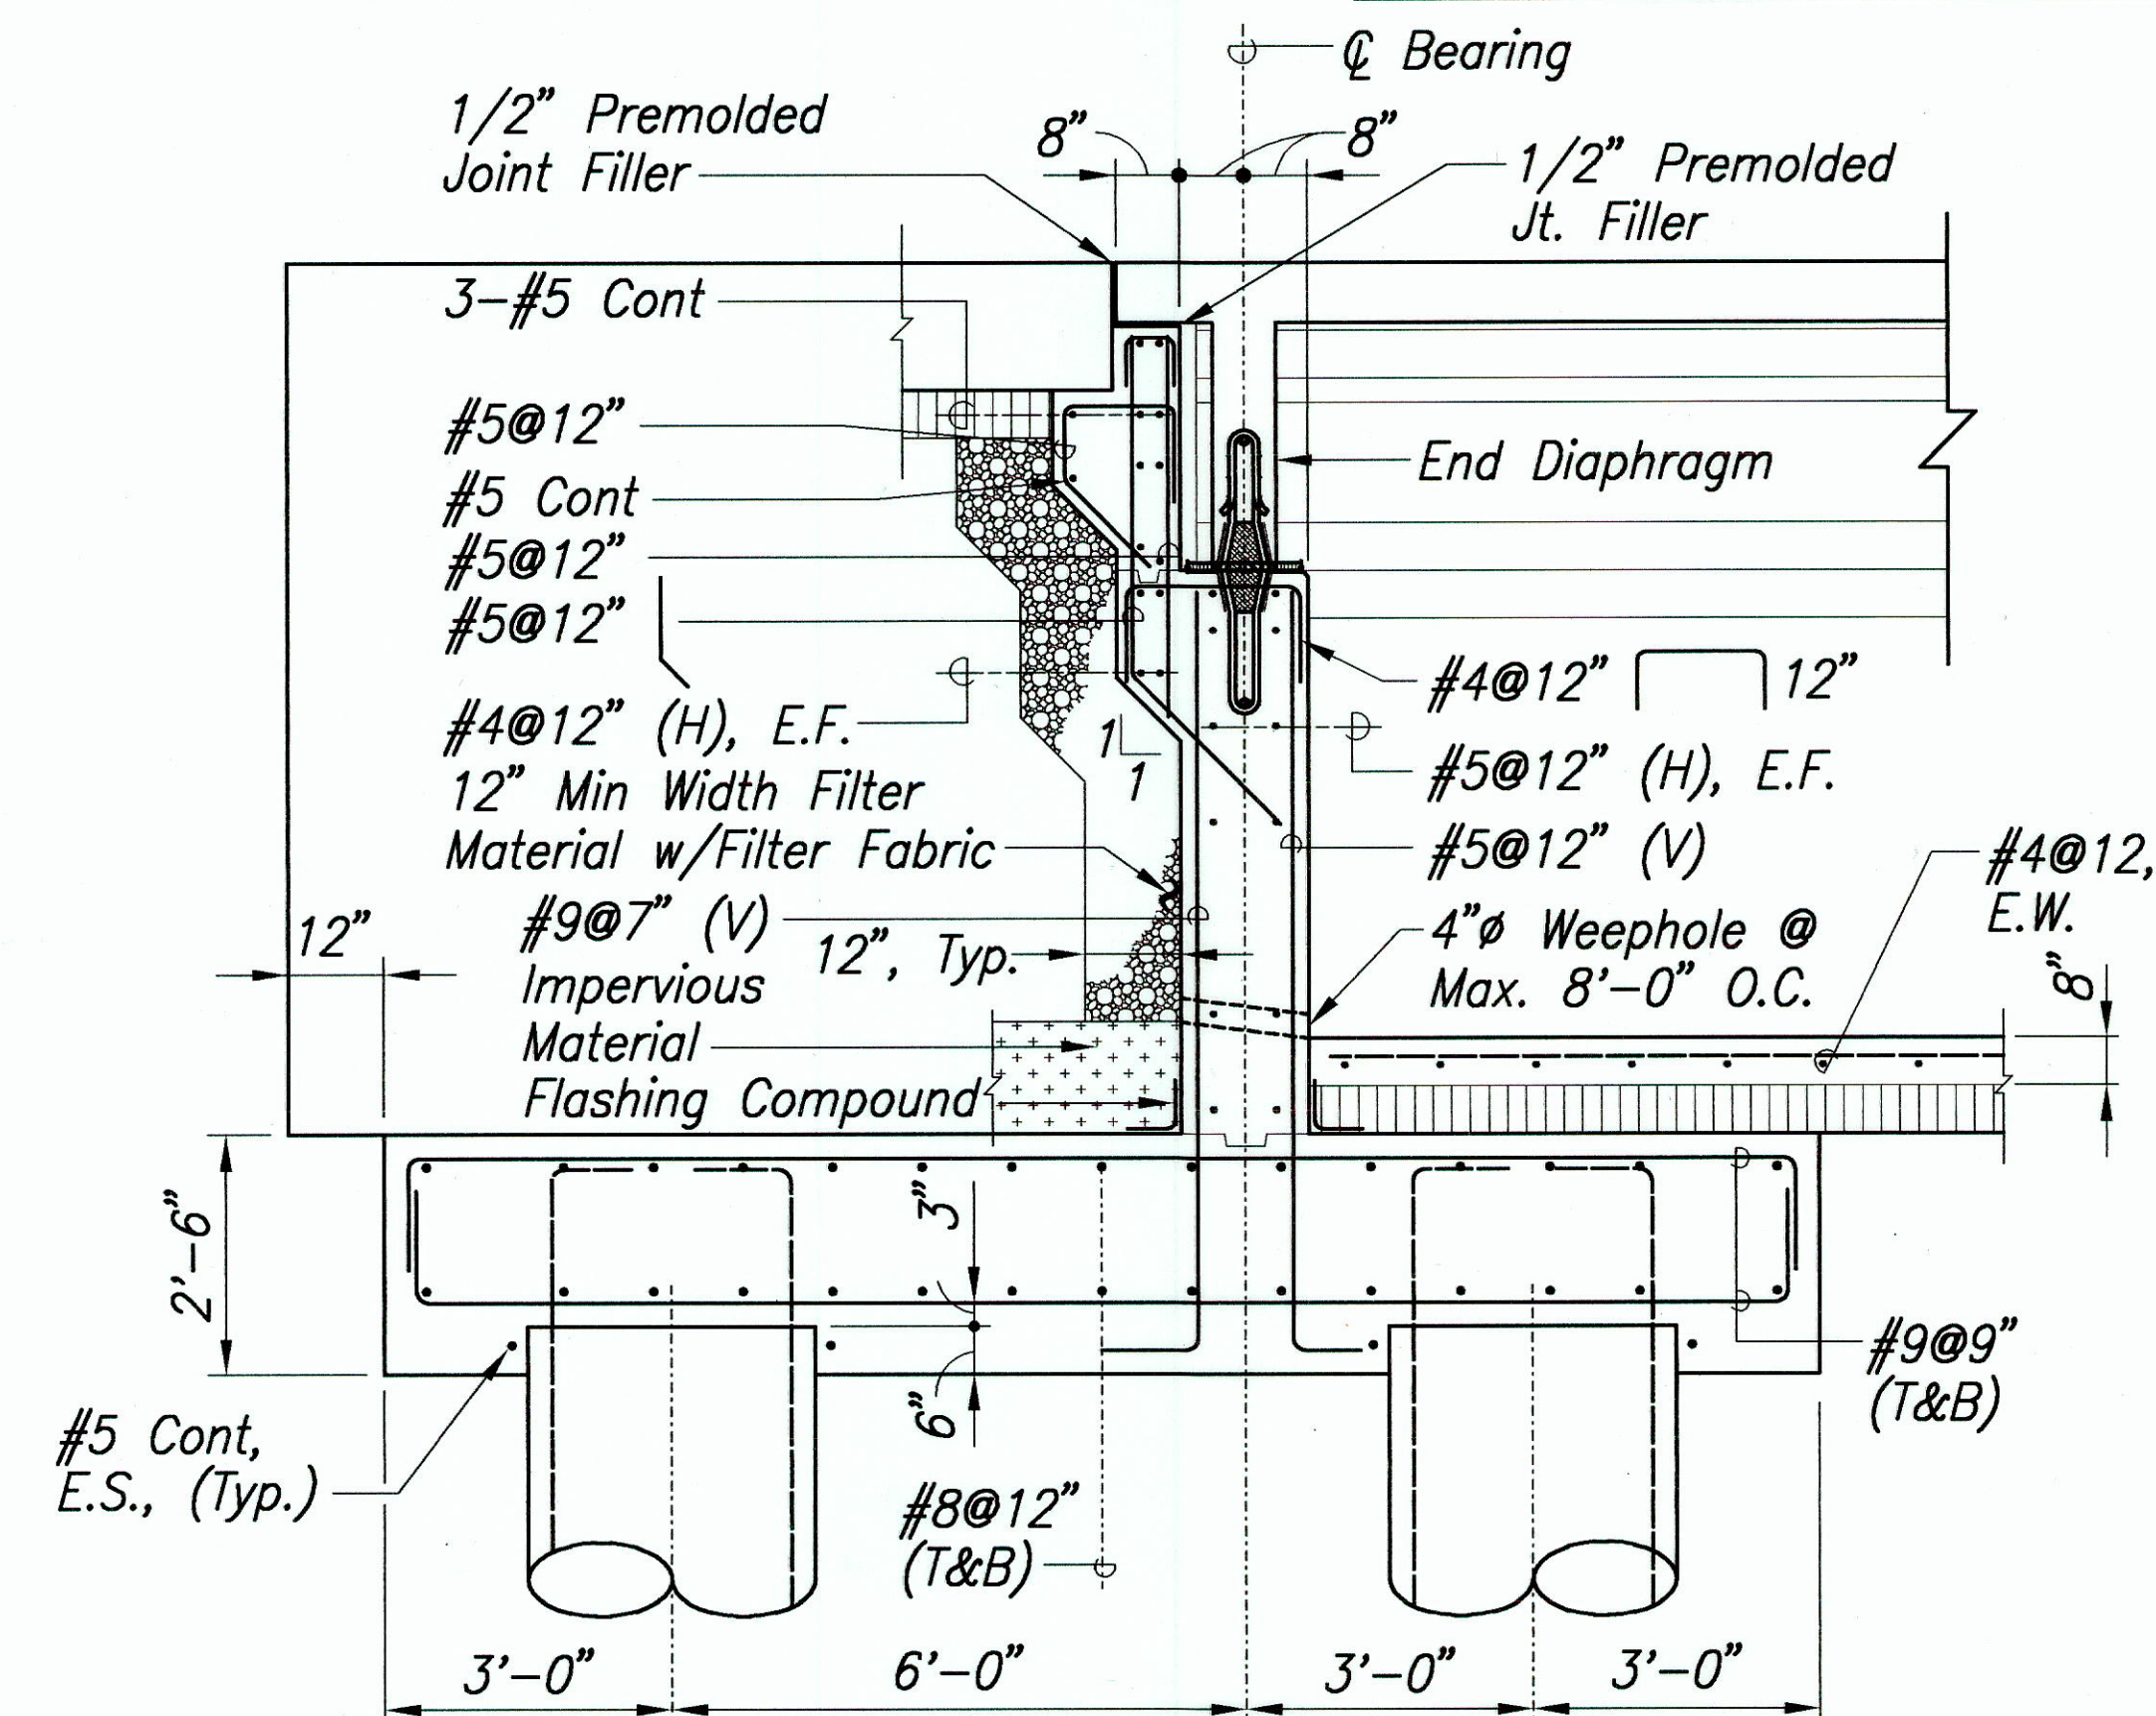


TYPICAL SECTION

Scale: 1/2"=1'-0"

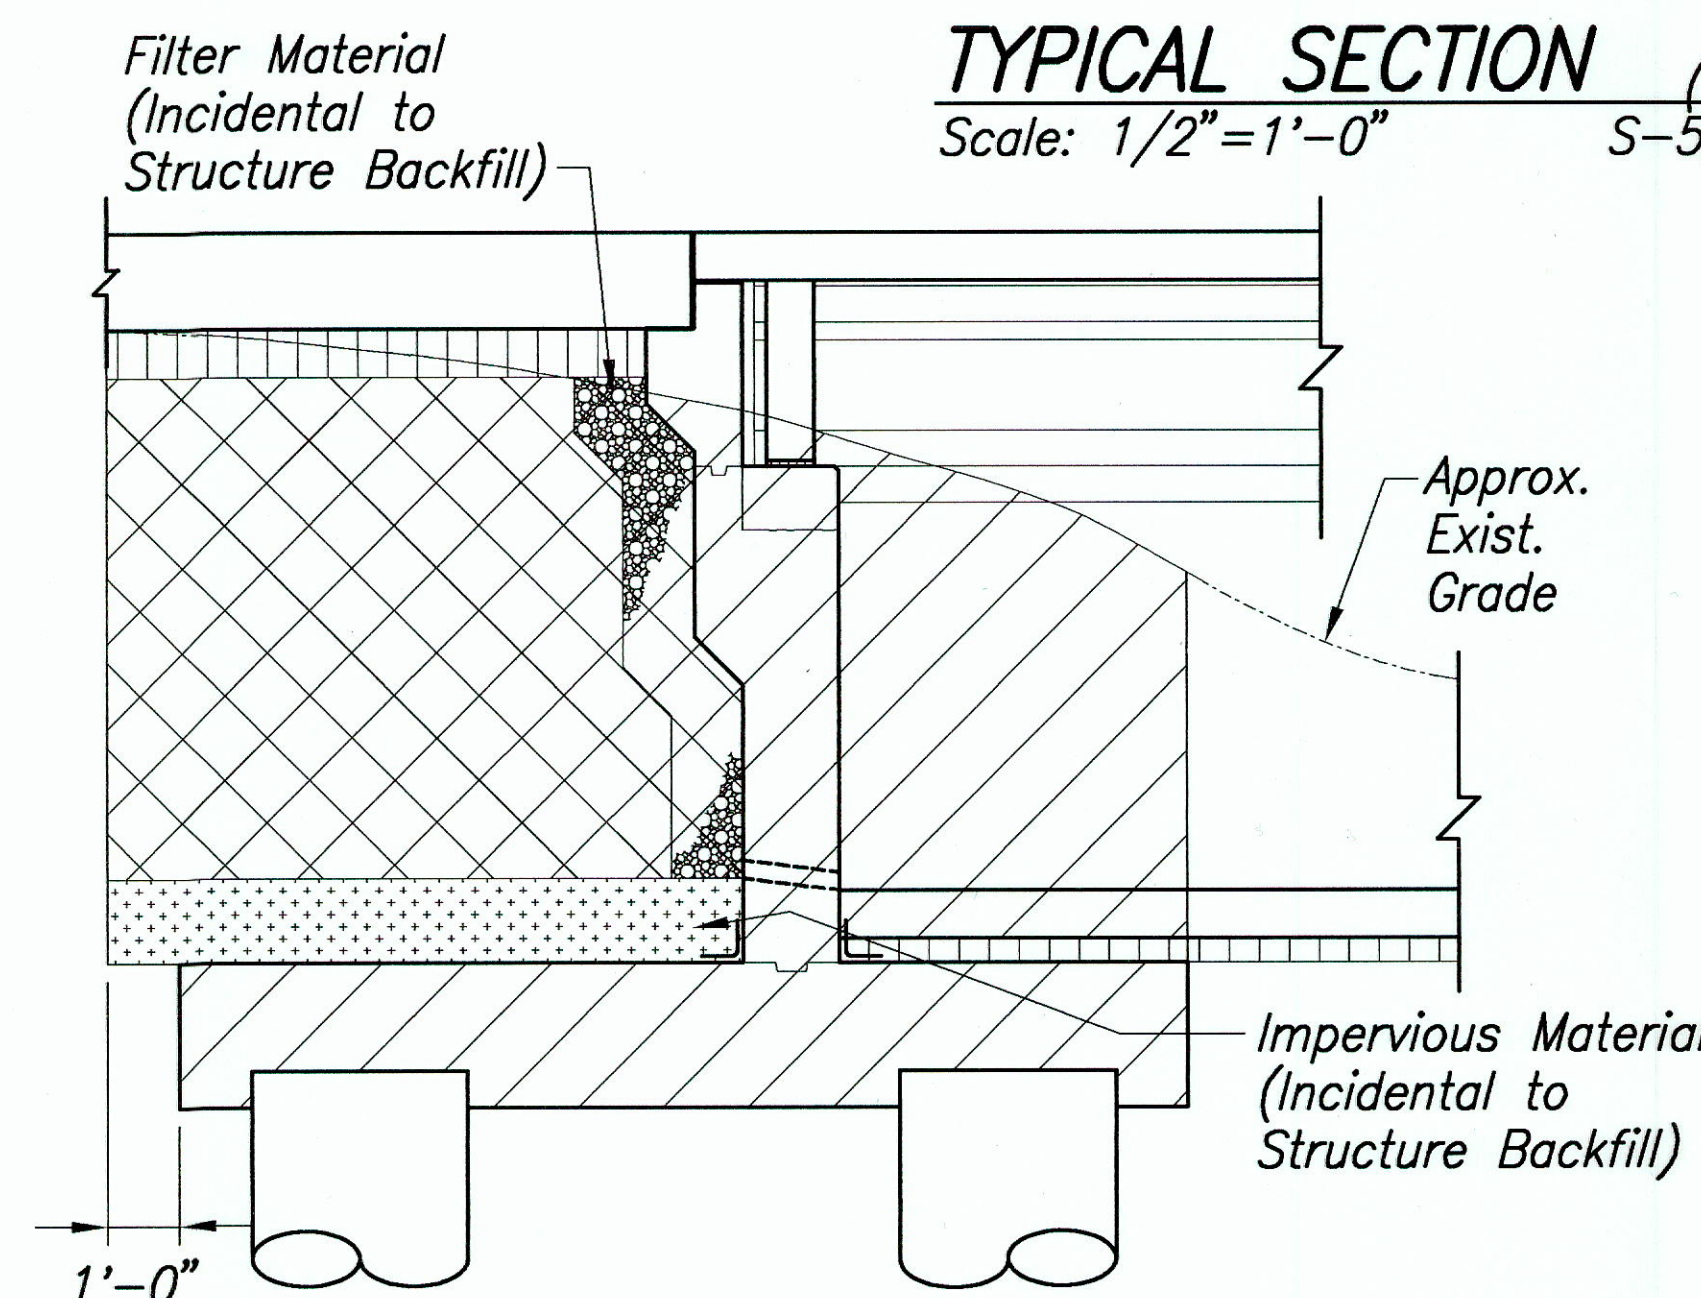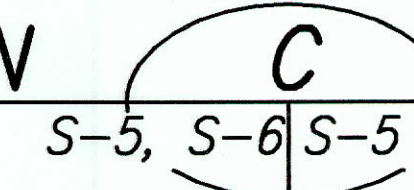

PAYLIMITS

Scale: 3/8"=1'-0"

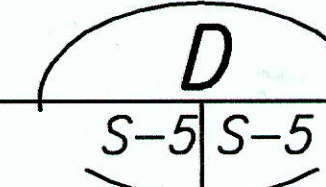


THIS WORK WAS PREPARED BY
ME OR UNDER MY SUPERVISION
Myron G. Okubo
Signature
April 30, 2004
Expiration Date of the License



DATE	REVISION
<p>STATE OF HAWAII DEPARTMENT OF TRANSPORTATION HIGHWAYS DIVISION</p> <p>ABUTMENT NO. 1 DETAILS AND FOUNDATION PLAN</p> <p>KAMEHAMEHA V HIGHWAY EMERGENCY REPLACEMENT OF KAWAIKAPU BRIDGE FEDERAL AID PROJECT NO. ER-12(4)</p> <p>Scale: As Noted Date: Nov. 25, 2002</p>	
SHEET NO. S-5 OF 16 SHEETS	

"AS-BUILT"

FED. ROAD DIST. NO.	STATE	FED. AID PROJ. NO.	FISCAL YEAR	SHEET NO.	TOTAL SHEETS
HAWAII	HAW.	ER-12(4)	2003	56	76

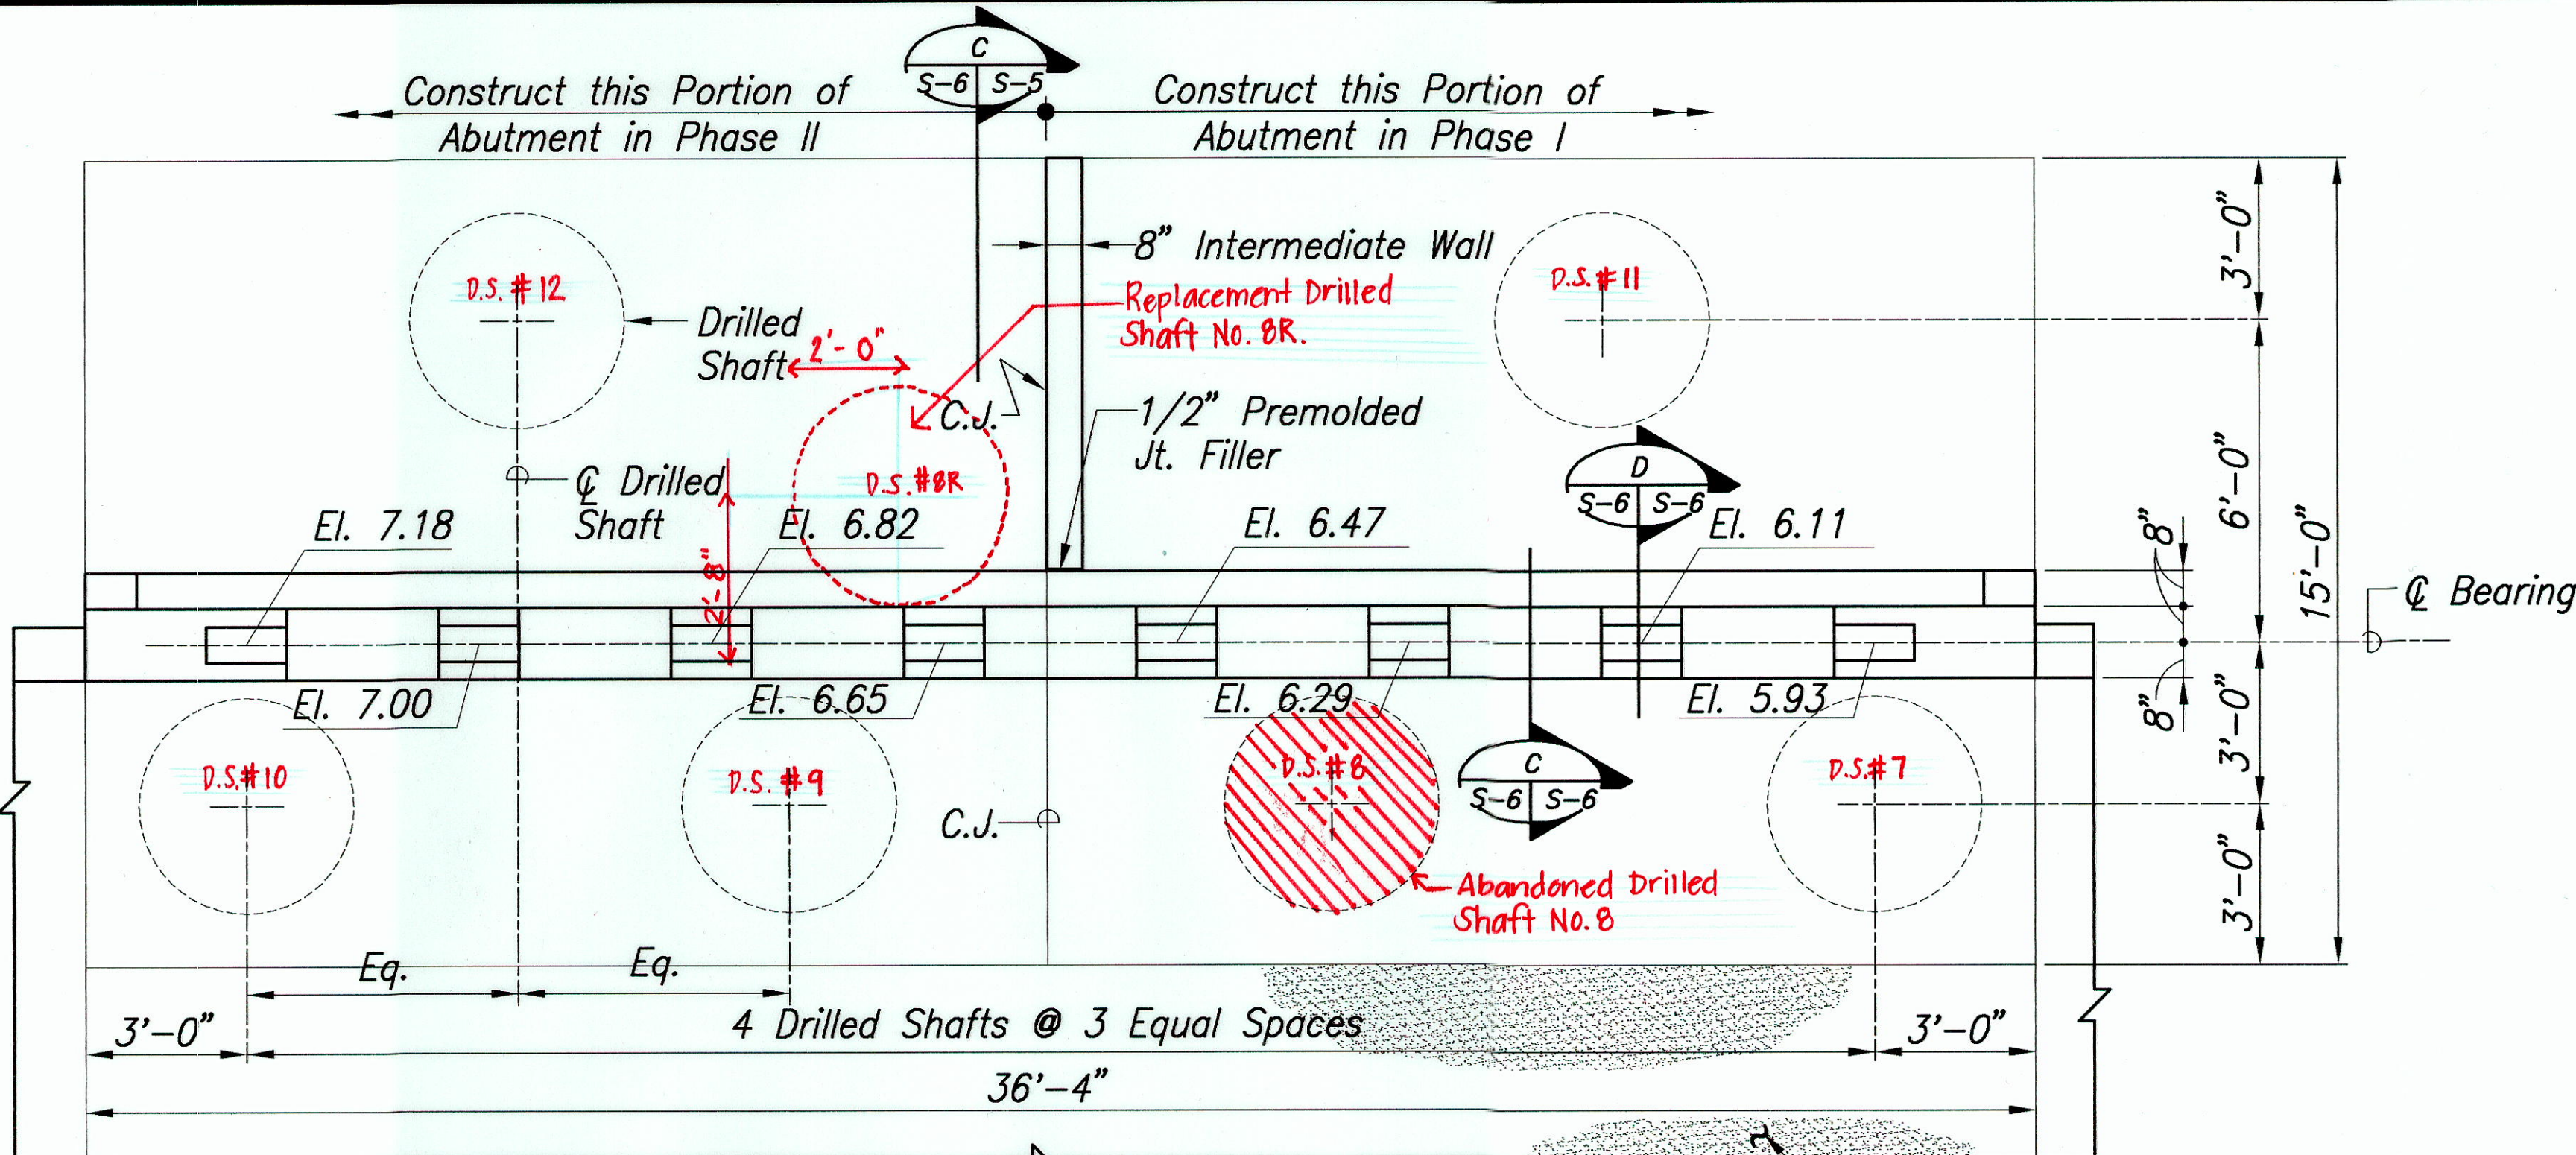


ABUTMENT NO. 2 PLAN
Scale: None
S-6 S-6

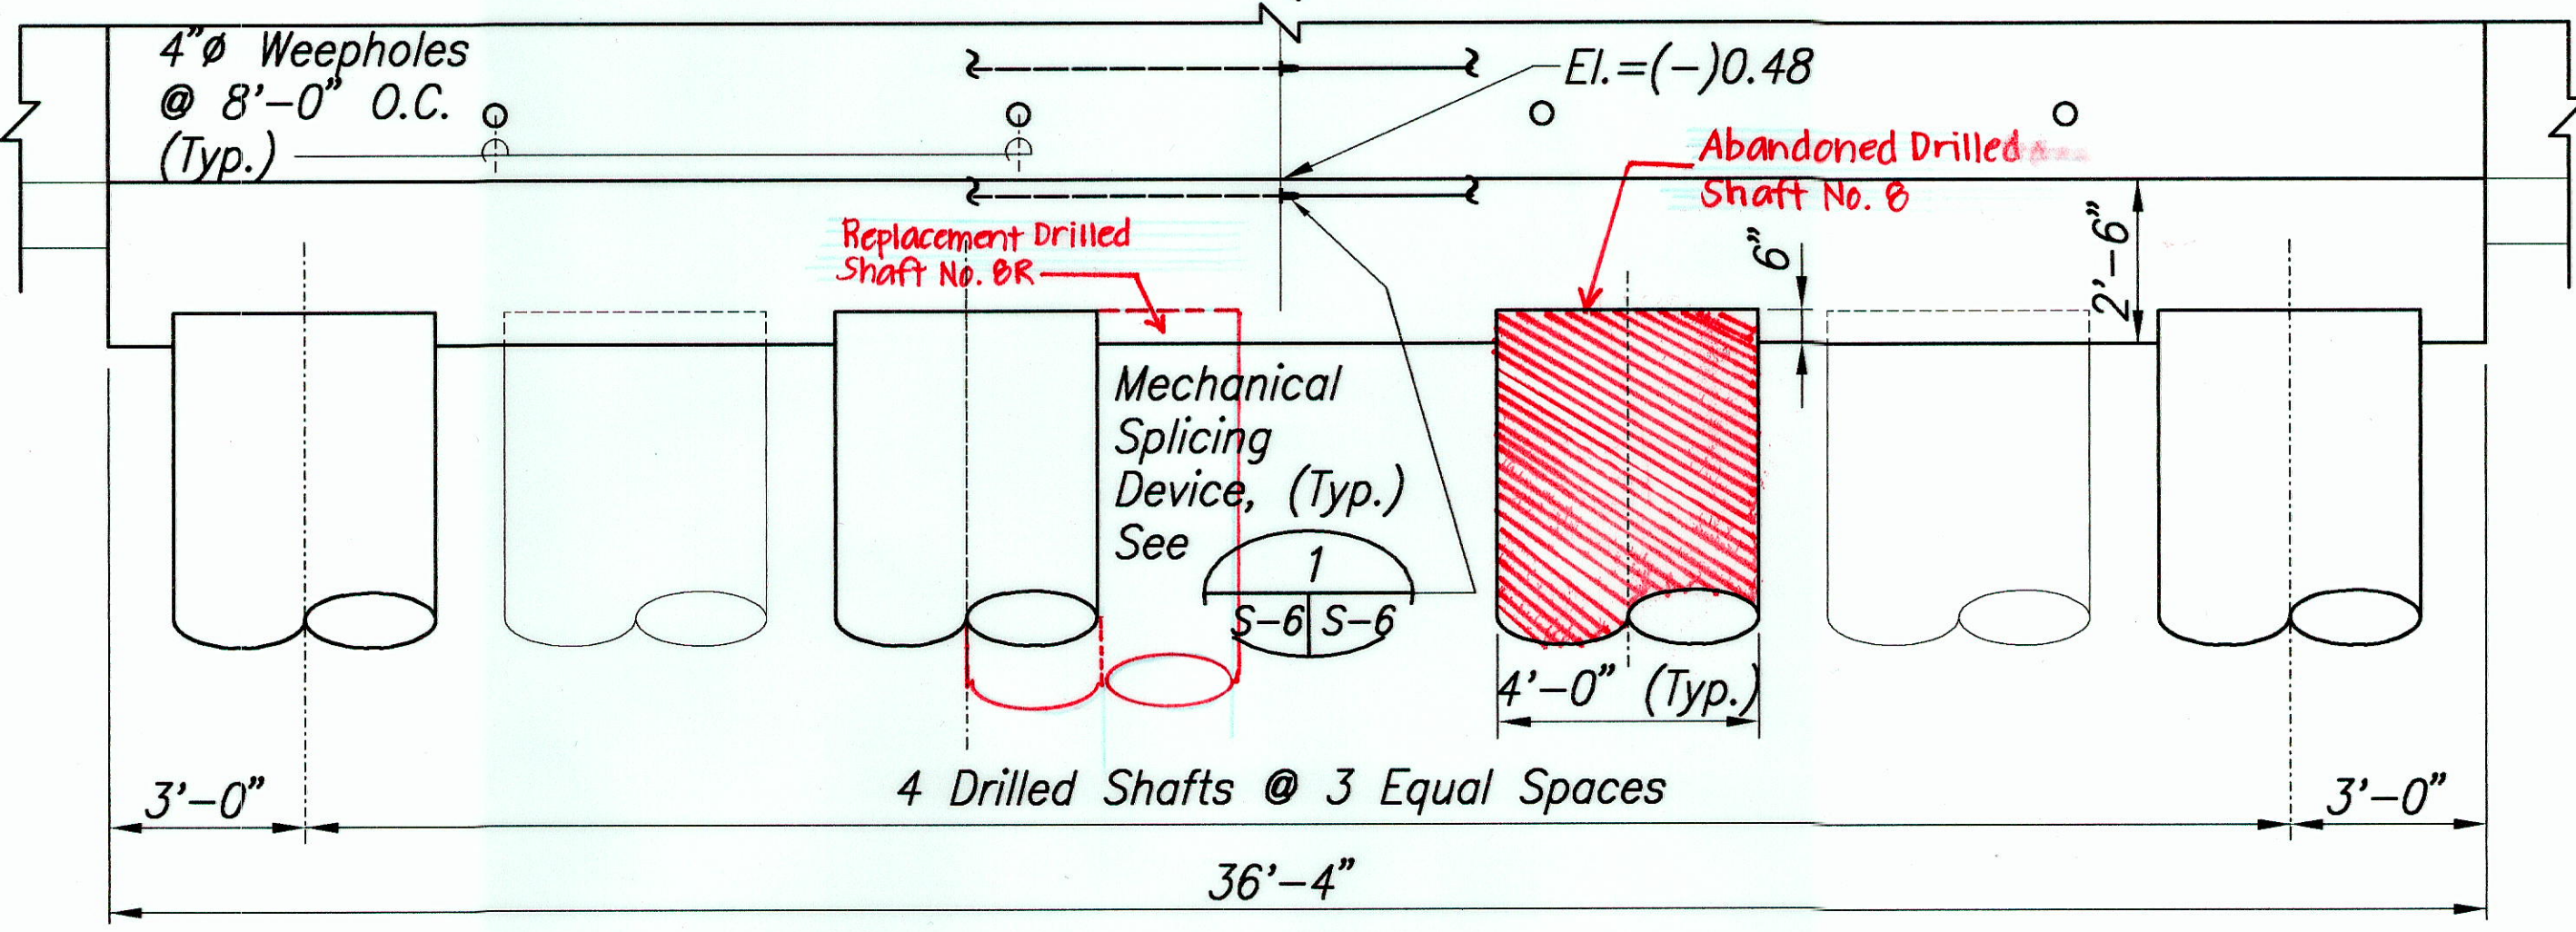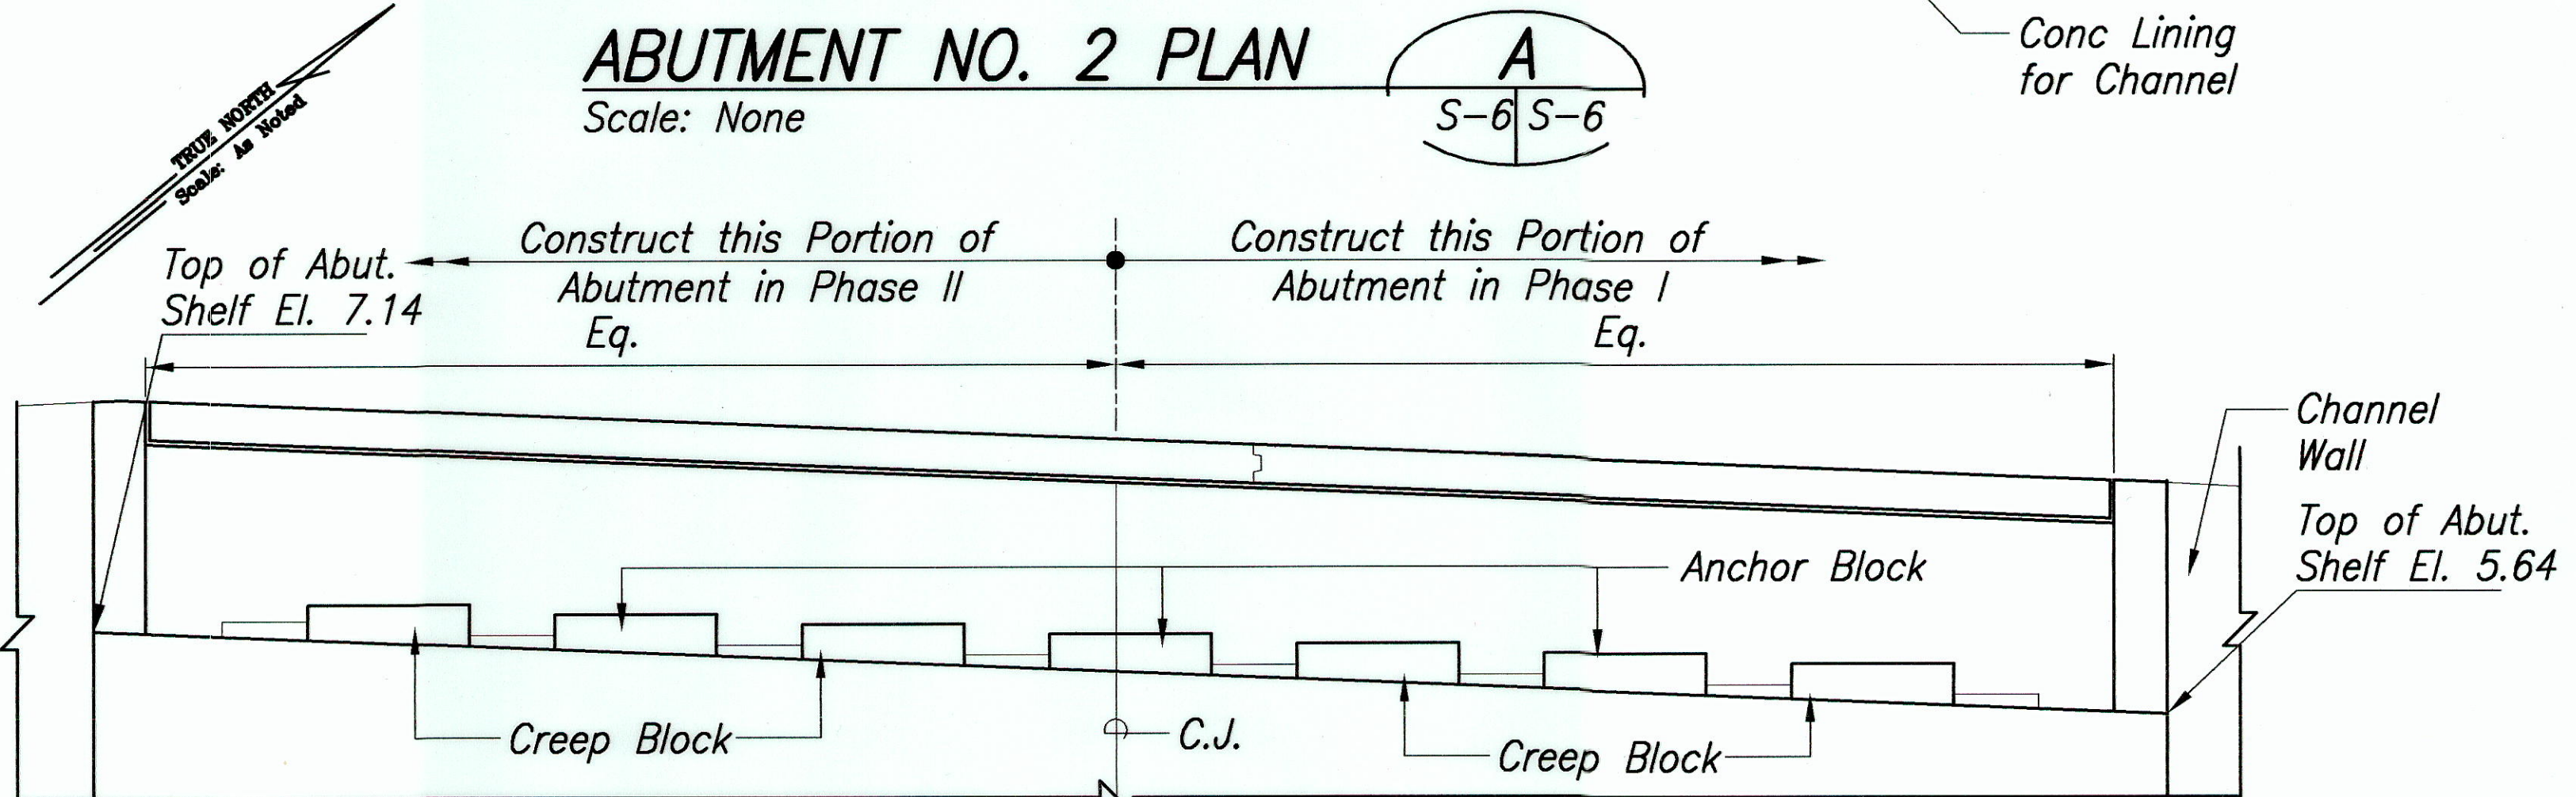


ABUTMENT NO. 2 ELEVATION
Scale: None
S-6 S-6


Note:
Creep and Anchor Block
Details Shown on Sheet
S-7.

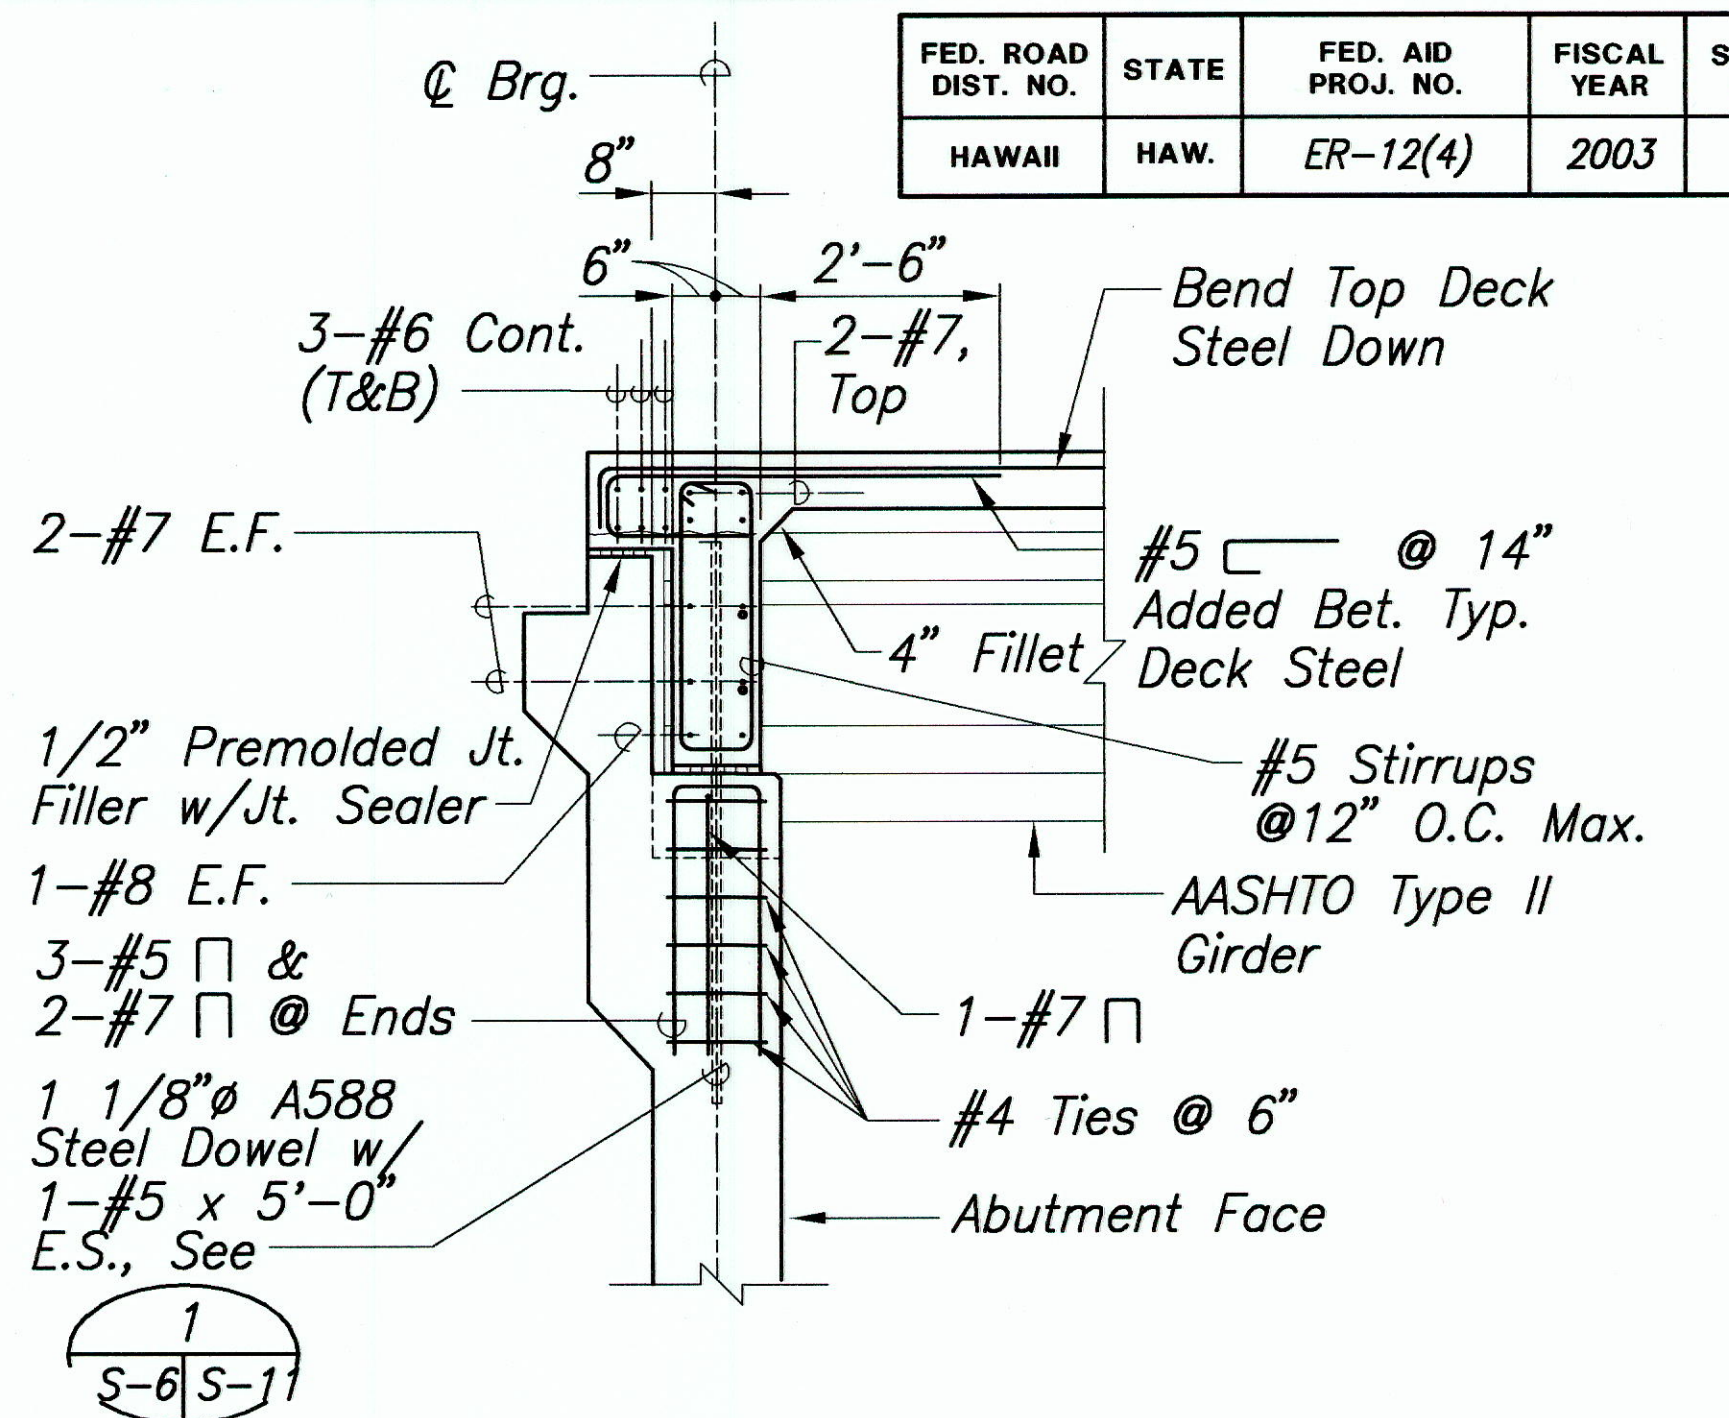

SECTION AT ANCHOR/CREEP BLOCK
Scale: 1/2"=1'-0"
S-6

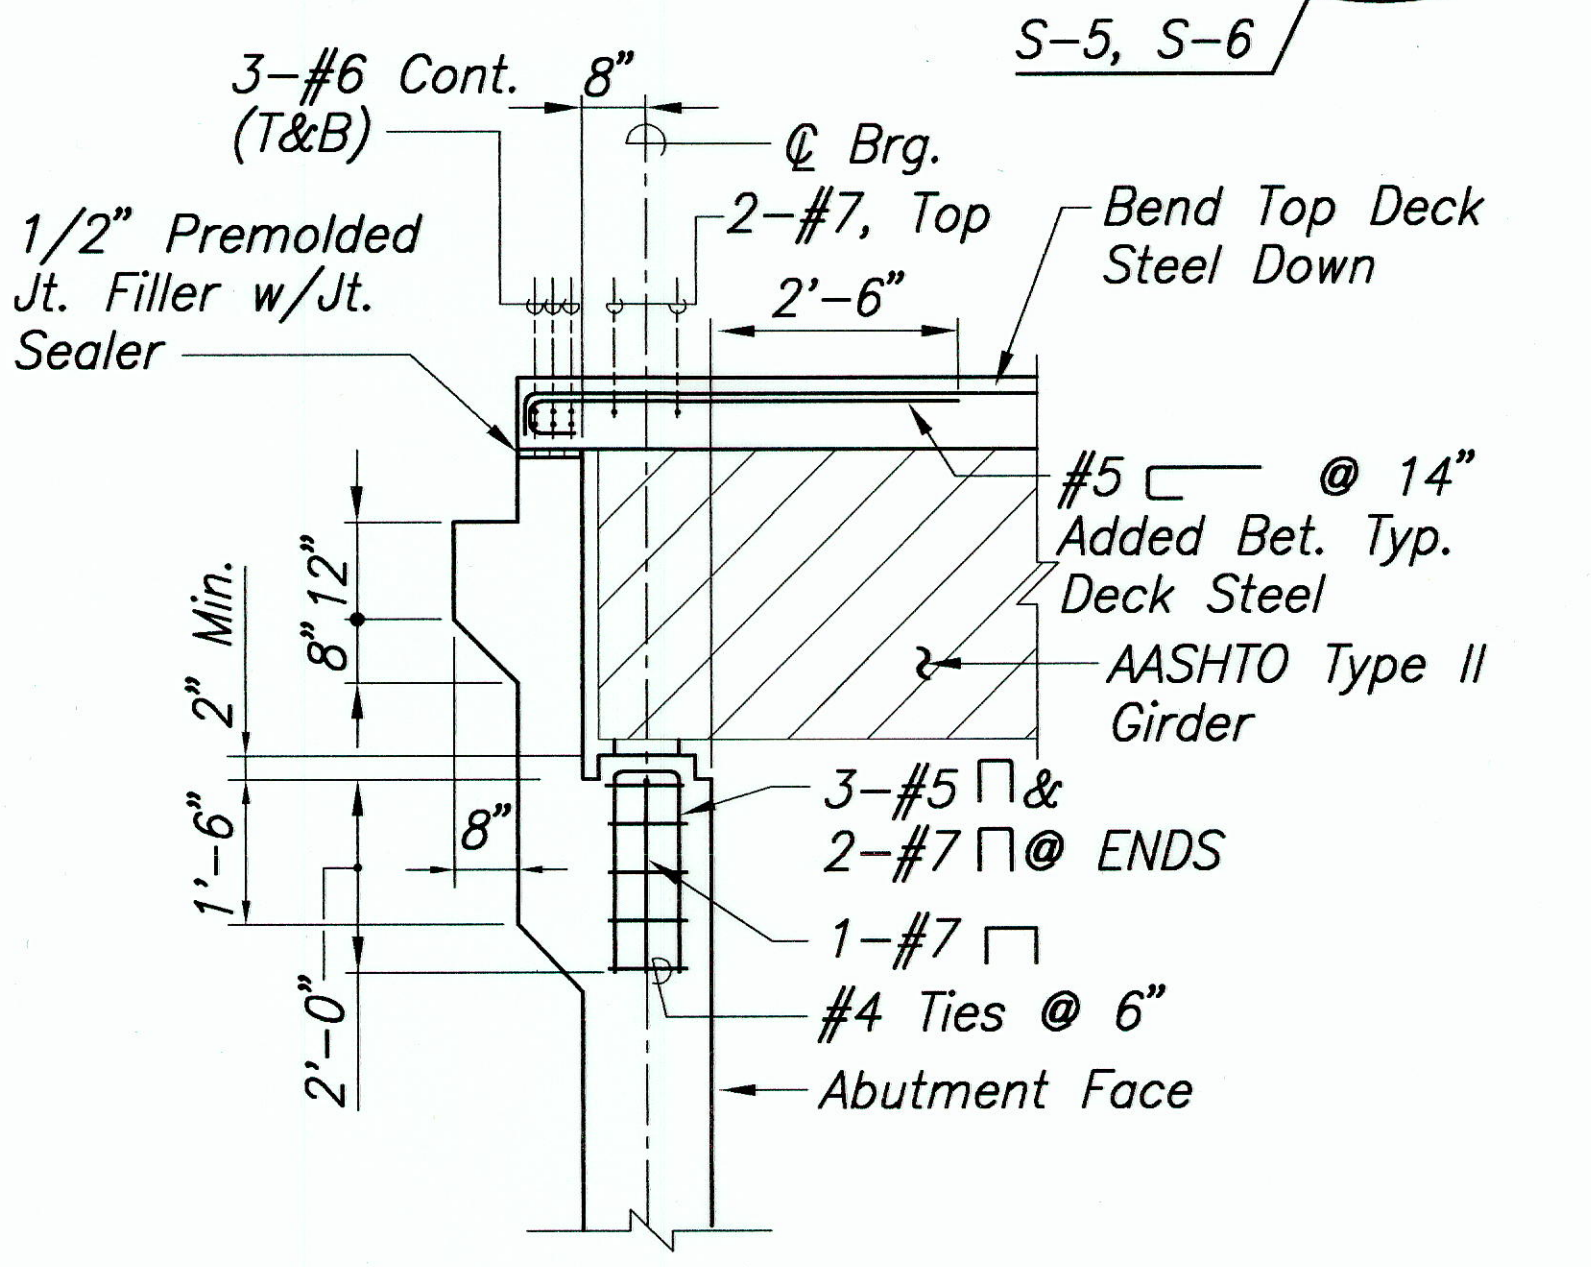

SECTION AT GIRDER SEAT
Scale: 1/2"=1'-0"
S-6

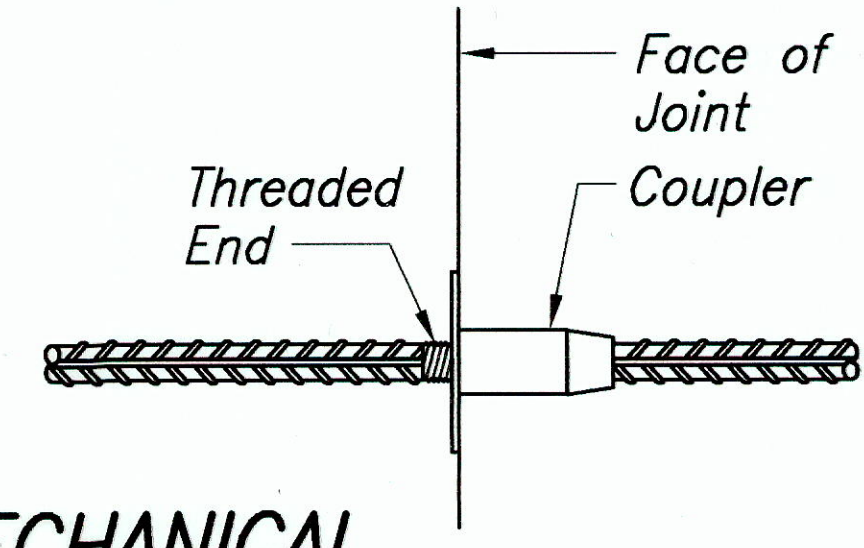

MECHANICAL SPLICING DEVICE
Scale: None
S-5, S-6




THIS WORK WAS PREPARED BY
ME OR UNDER MY SUPERVISION
Myron G. Okubo
Signature
April 30, 2004
Expiration Date of the License

DATE	REVISION
STATE OF HAWAII DEPARTMENT OF TRANSPORTATION HIGHWAYS DIVISION ABUTMENT NO. 2 DETAILS AND FOUNDATION PLAN KAMEHAMEHA V HIGHWAY EMERGENCY REPLACEMENT OF KAWAIKAPU BRIDGE FEDERAL AID PROJECT NO. ER-12(4) Scale: As Noted Date: Nov. 25, 2002	
SHEET NO. S-6 OF 16 SHEETS	


SURVEY PLOTTED BY	DATE
DRAWN BY	
TRACED BY	
QUANTITIES BY	
CHECKED BY	
ORIGINAL PLAN	
NO.	

Path: L:\W04\6465-01\STR File Name: S6 Plot Date: Jan 17, 2003 09:54:09am CAD User: alicong Xref File Name: 2 Border ?


FED. ROAD DIST. NO.	STATE	FED. AID PROJ. NO.	FISCAL YEAR	SHEET NO.	TOTAL SHEETS
HAWAII	HAW.	ER-12(4)	2003	57	76

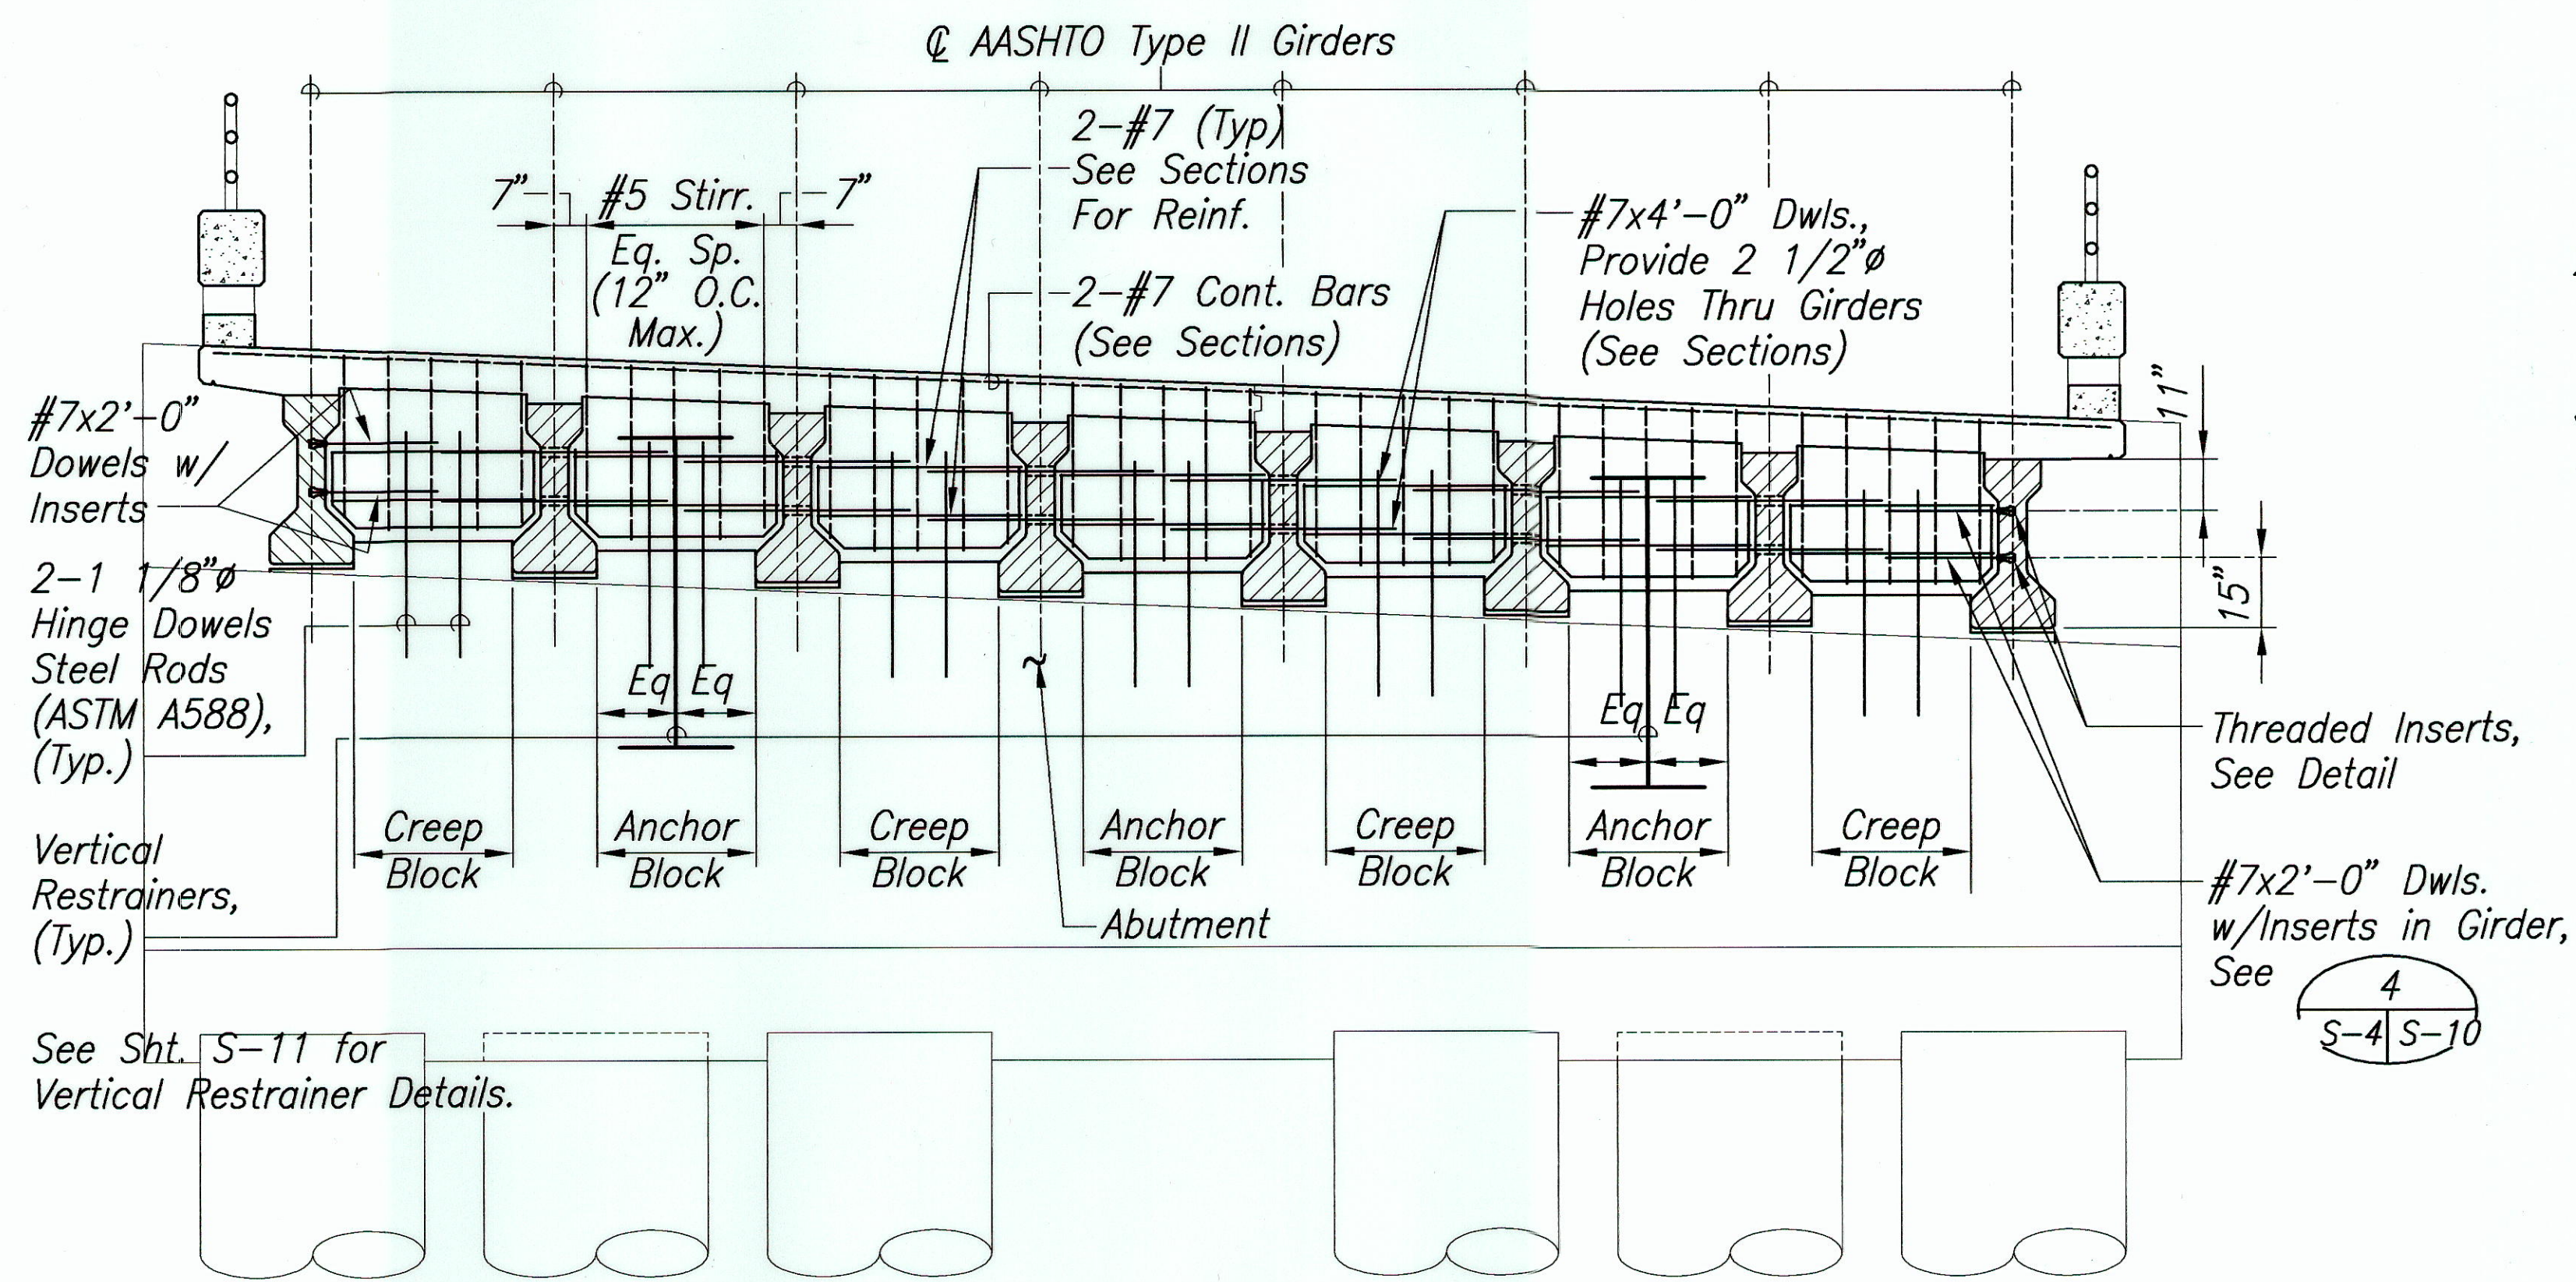

- Notes:
1. All End Diaphragm Stirrups Shall be Plumb and Parallel to the Girders.
 2. See Plan for Anchor or Creep Block Location. (See Typical Detail this Sheet).
 3. Deck Reinforcing Not Shown for Clarity.
 4. Vertical Restrainers and Hinge Dowels Are Located Along \bar{C} Bearing.

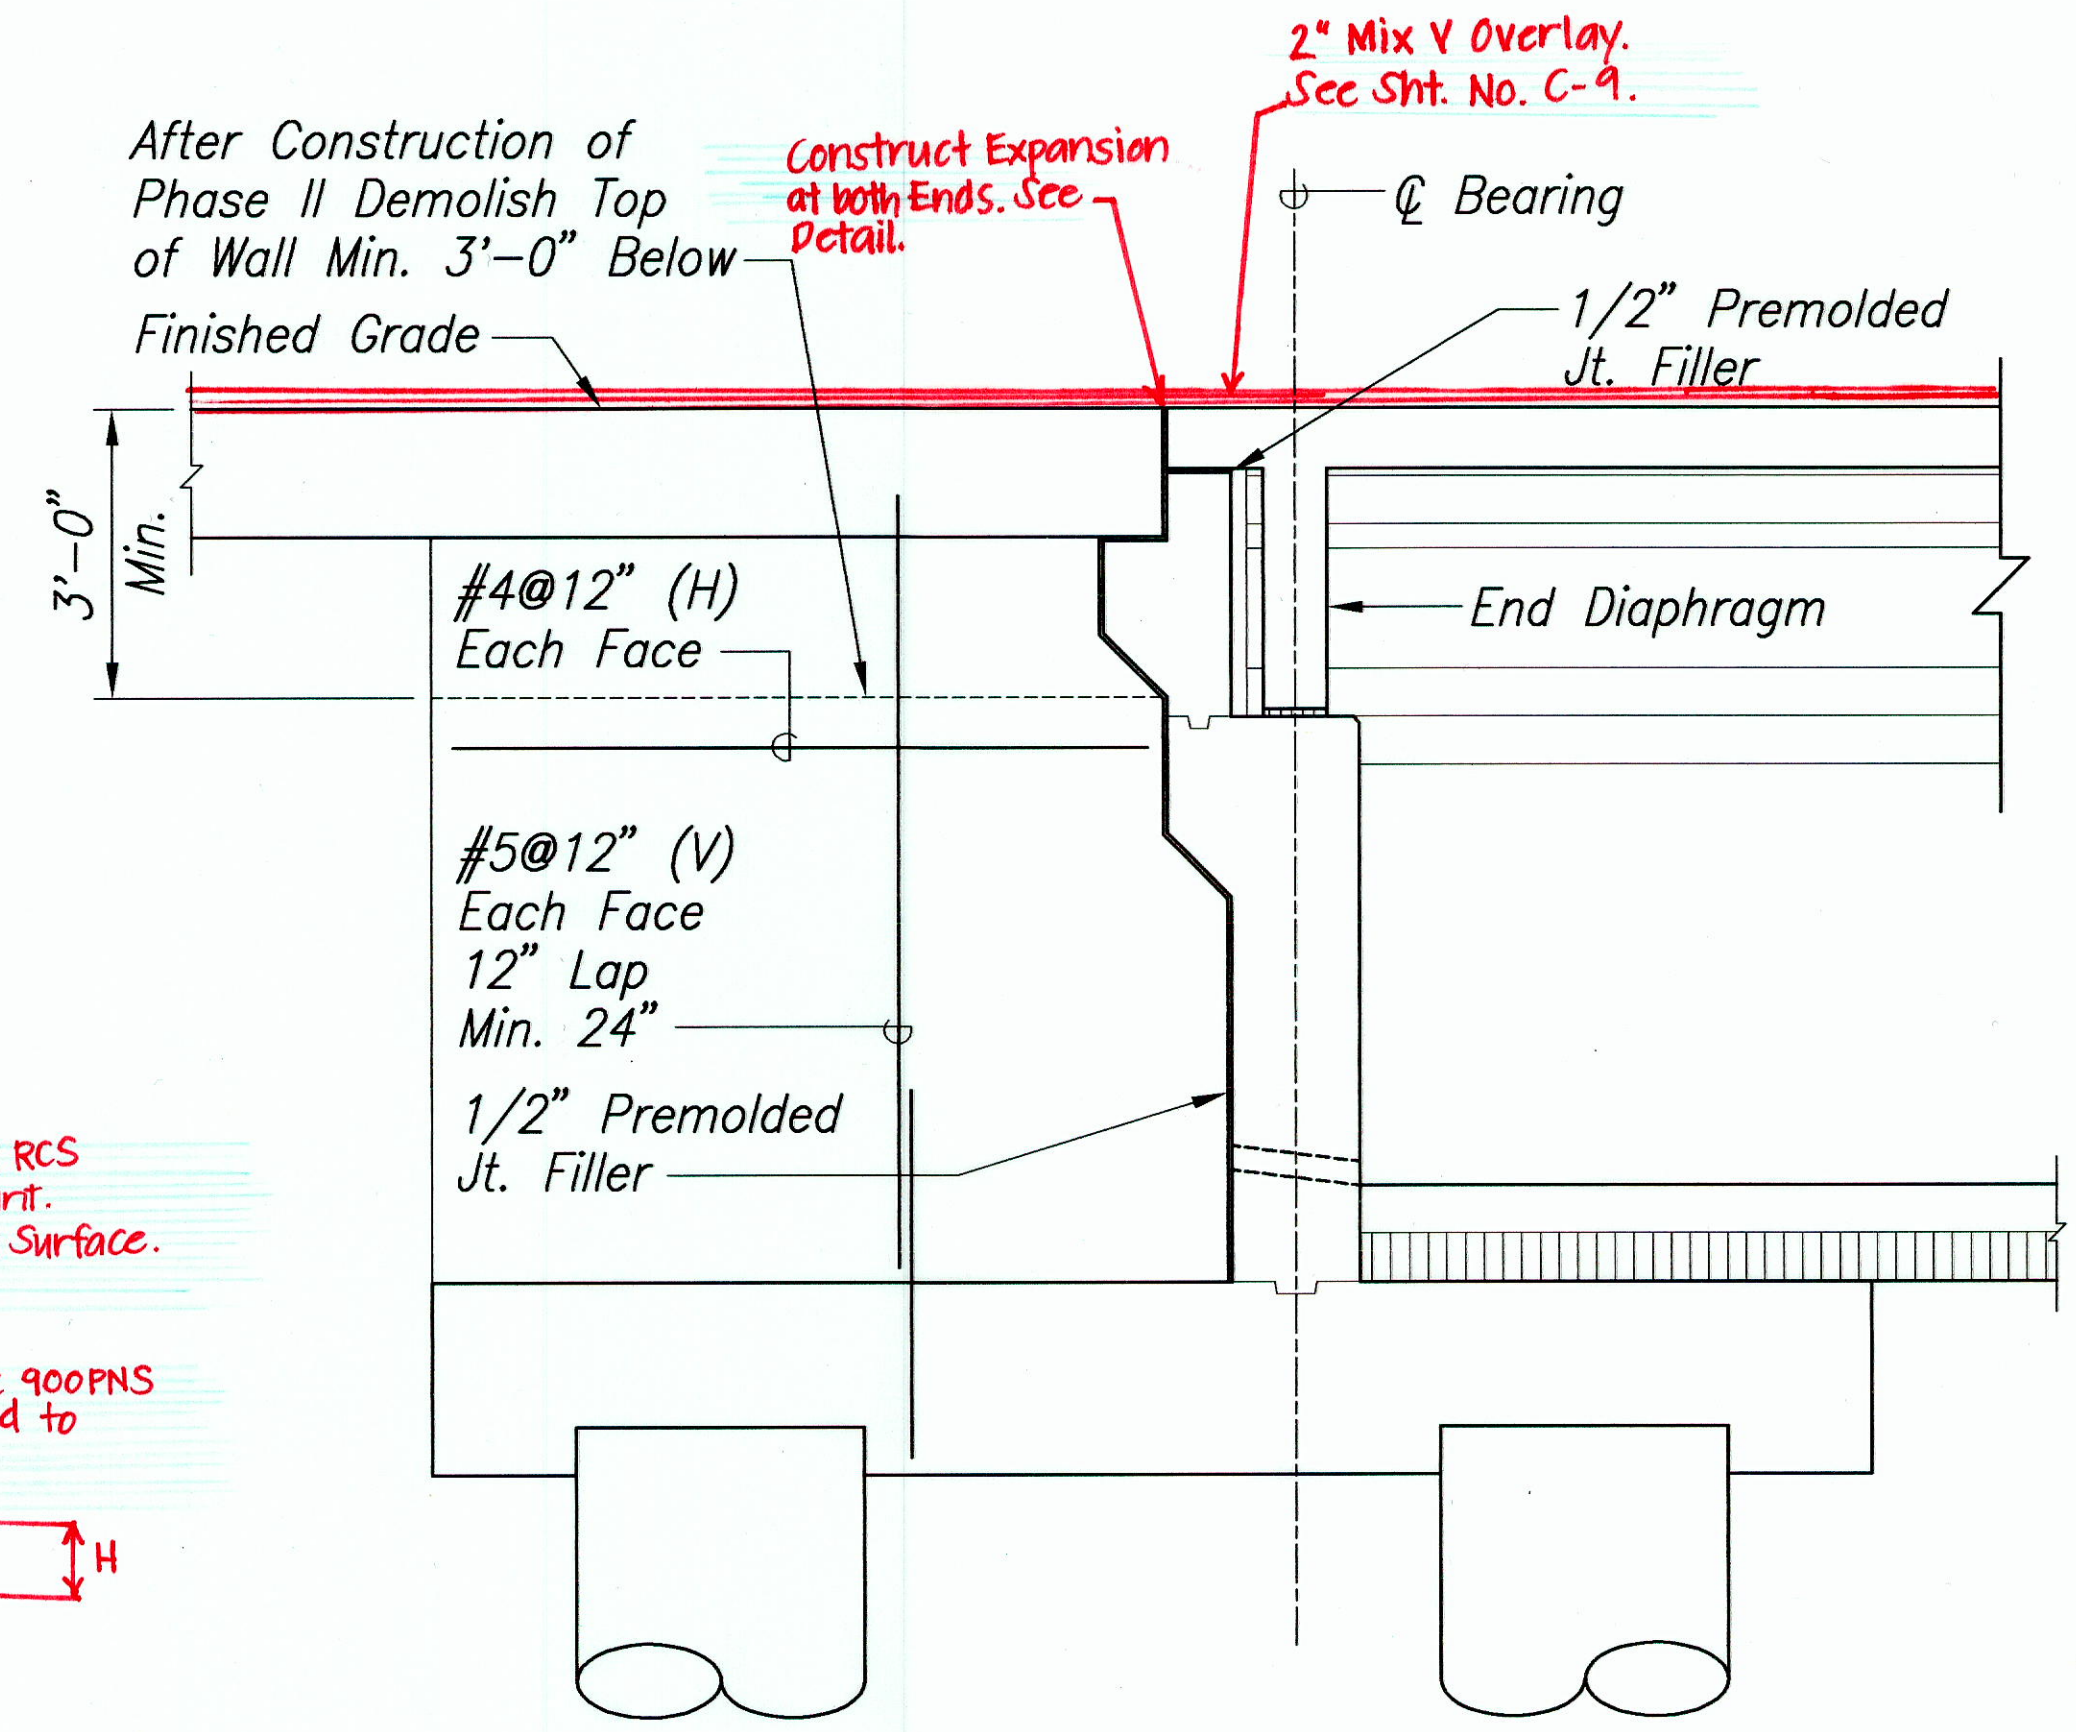

TYPICAL END DIAPHRAGM ELEVATION - TYPE II GIRDERS
Scale: 3/8"=1'-0"

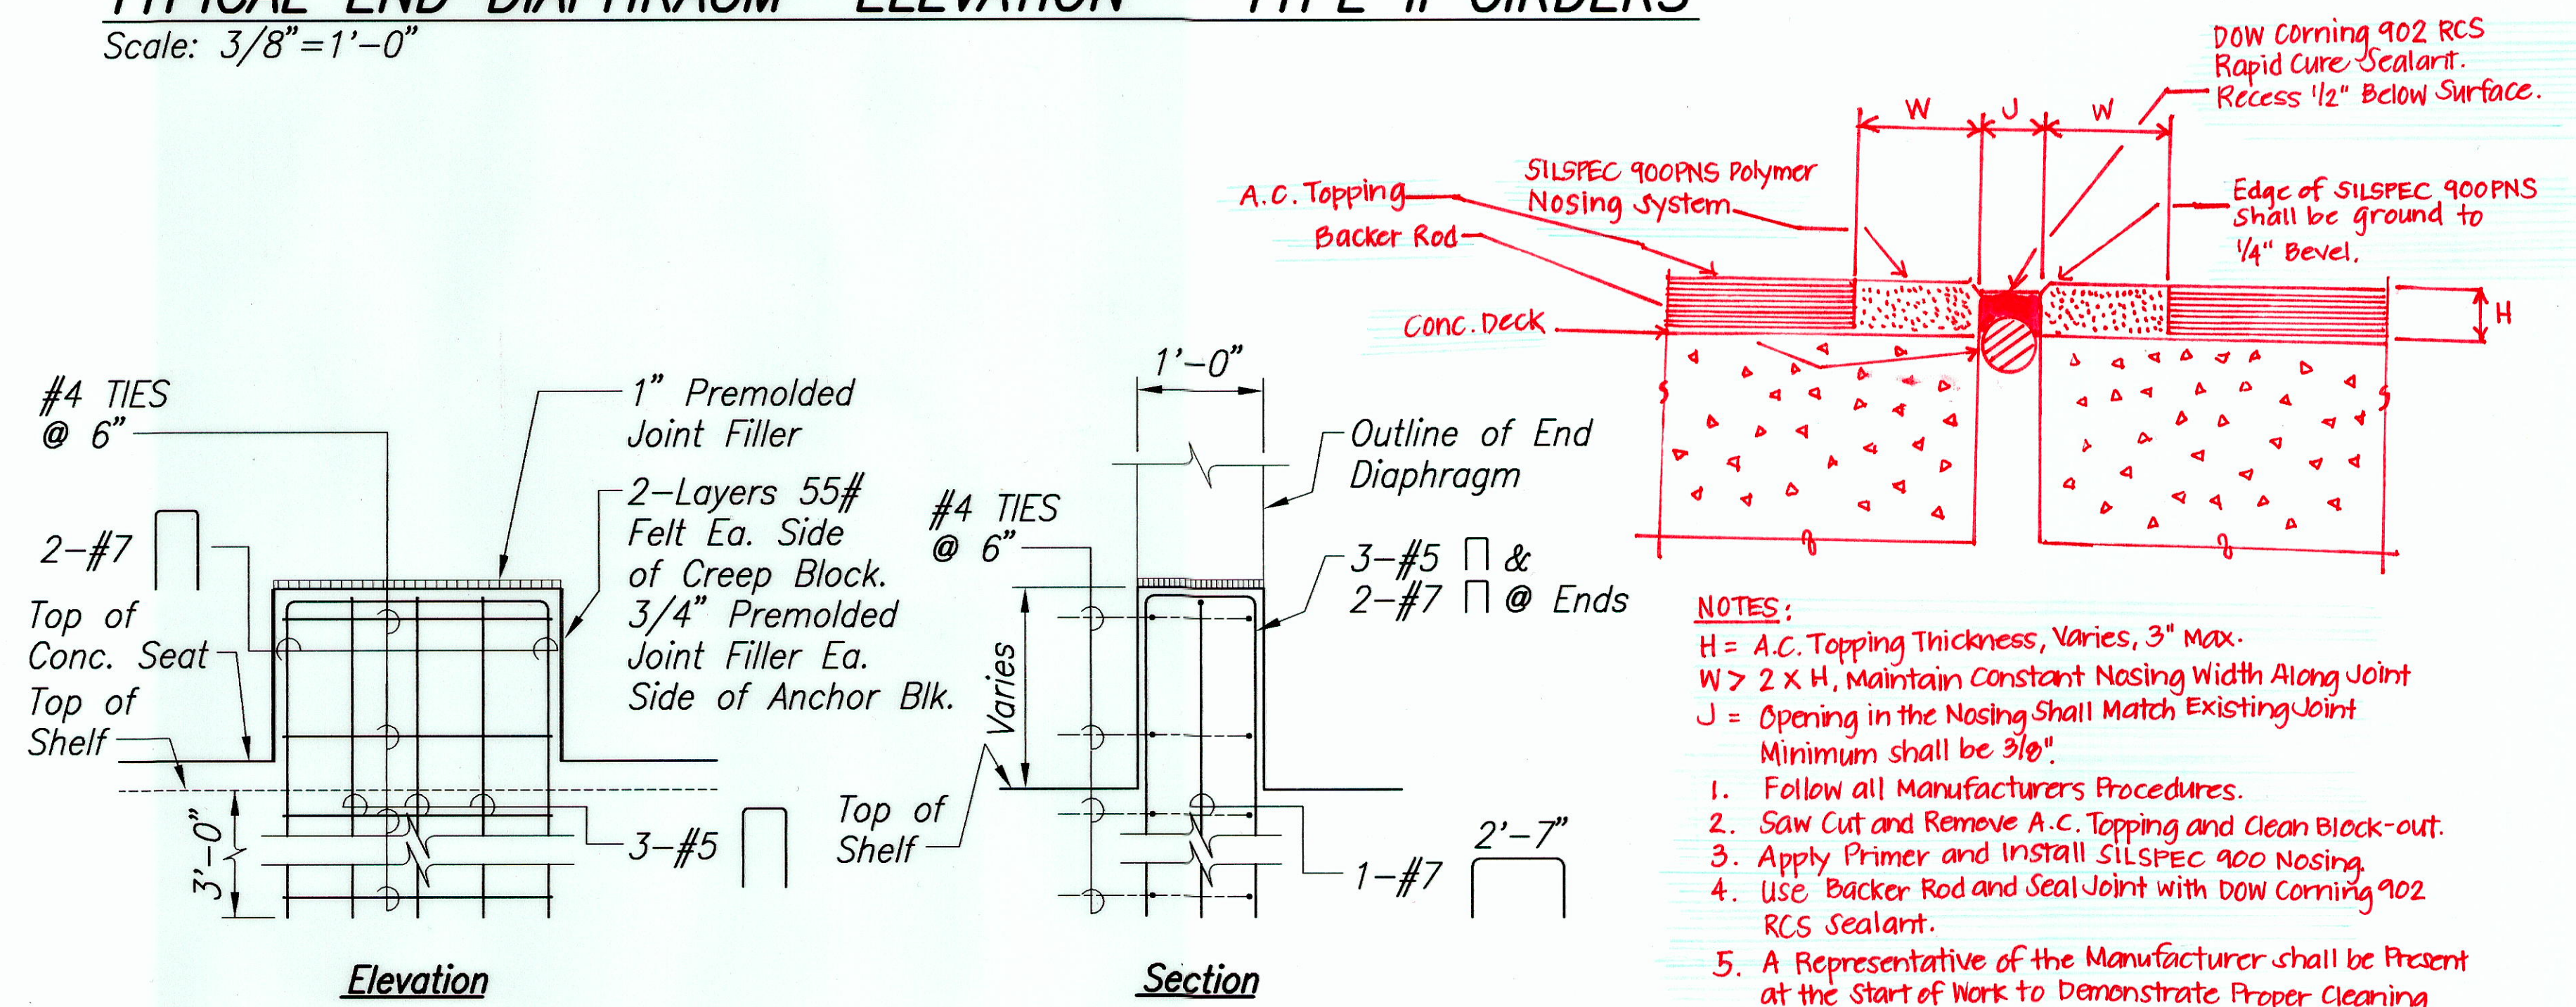

- NOTES:
1. Follow all Manufacturers Procedures.
 2. Saw Cut and Remove A.C. Topping and Clean Block-out.
 3. Apply Primer and Install SILSPEC 900 Nosing.
 4. Use Backer Rod and Seal Joint with DOW CORNING 902 RCS Sealant.
 5. A Representative of the Manufacturer shall be Present at the Start of Work to Demonstrate Proper Cleaning and Installation Techniques.

JOINT DETAIL
Scale: NTS

SECTION A
Scale: 1/2"=1'-0"

3/13/03	ADDENDUM NO. 1 REVISED DOWEL NOTE
DATE	REVISION
STATE OF HAWAII DEPARTMENT OF TRANSPORTATION HIGHWAYS DIVISION ABUTMENT DETAILS KAMEHAMEHA V HIGHWAY EMERGENCY REPLACEMENT OF KAWAIKAPU BRIDGE FEDERAL AID PROJECT NO. ER-12(4) Scale: As Noted Date: Nov. 25, 2002	
SHEET No. S-7 OF 16 SHEETS	

MYRON G. OKUBO
LICENSED PROFESSIONAL ENGINEER
No. 4320-S
HAWAII, U.S.A.

THIS WORK WAS PREPARED BY ME OR UNDER MY SUPERVISION

Myron Okubo
Signature
April 30, 2004
Expiration Date of the License


SURVEY PLOTTED BY	DATE
DRAWN BY	
DESIGNED BY	
CHECKED BY	
ORIGINAL PLAN	
NOTEBOOK	
No.	

Path: L:\Wood\6465-01\STR File: 57 Plot date: Mar 14, 2003-09:58:58am CAD User: cnoimato. Xref Filename: ? Border ?


FED. ROAD DIST. NO.	STATE	FED. AID PROJ. NO.	FISCAL YEAR	SHEET NO.	TOTAL SHEETS
HAWAII	HAW.	ER-12(4)	2003	58	76

NOTES:


1. Drilled Shaft Concrete Shall be $f'c=4500$ P.S.I. Minimum. Strength at 28 Days.
2. Concrete Spacers Shall be Used to Maintain the Reinforcement Cage in Position within the Shaft.
3. Spirals May be Discontinuous at Footing Reinforcing to Allow for Placement of Reinforcing for Footing. The Discontinuous Spirals Shall be Terminated with a 135° Hook Around Vertical Reinforcing.
4. Bars with Hooked Ends to be Provided at all Drilled Shaft Abutments.
5. Reinforcing Steel for Drilled Shafts to Extend to Top of Footings with 1 1/2" Clear Space Between Footing Top Reinforcing. Drilled Shaft Reinforcing to be Enclosed by Spirals for Full Depth of Embedment in Footings.

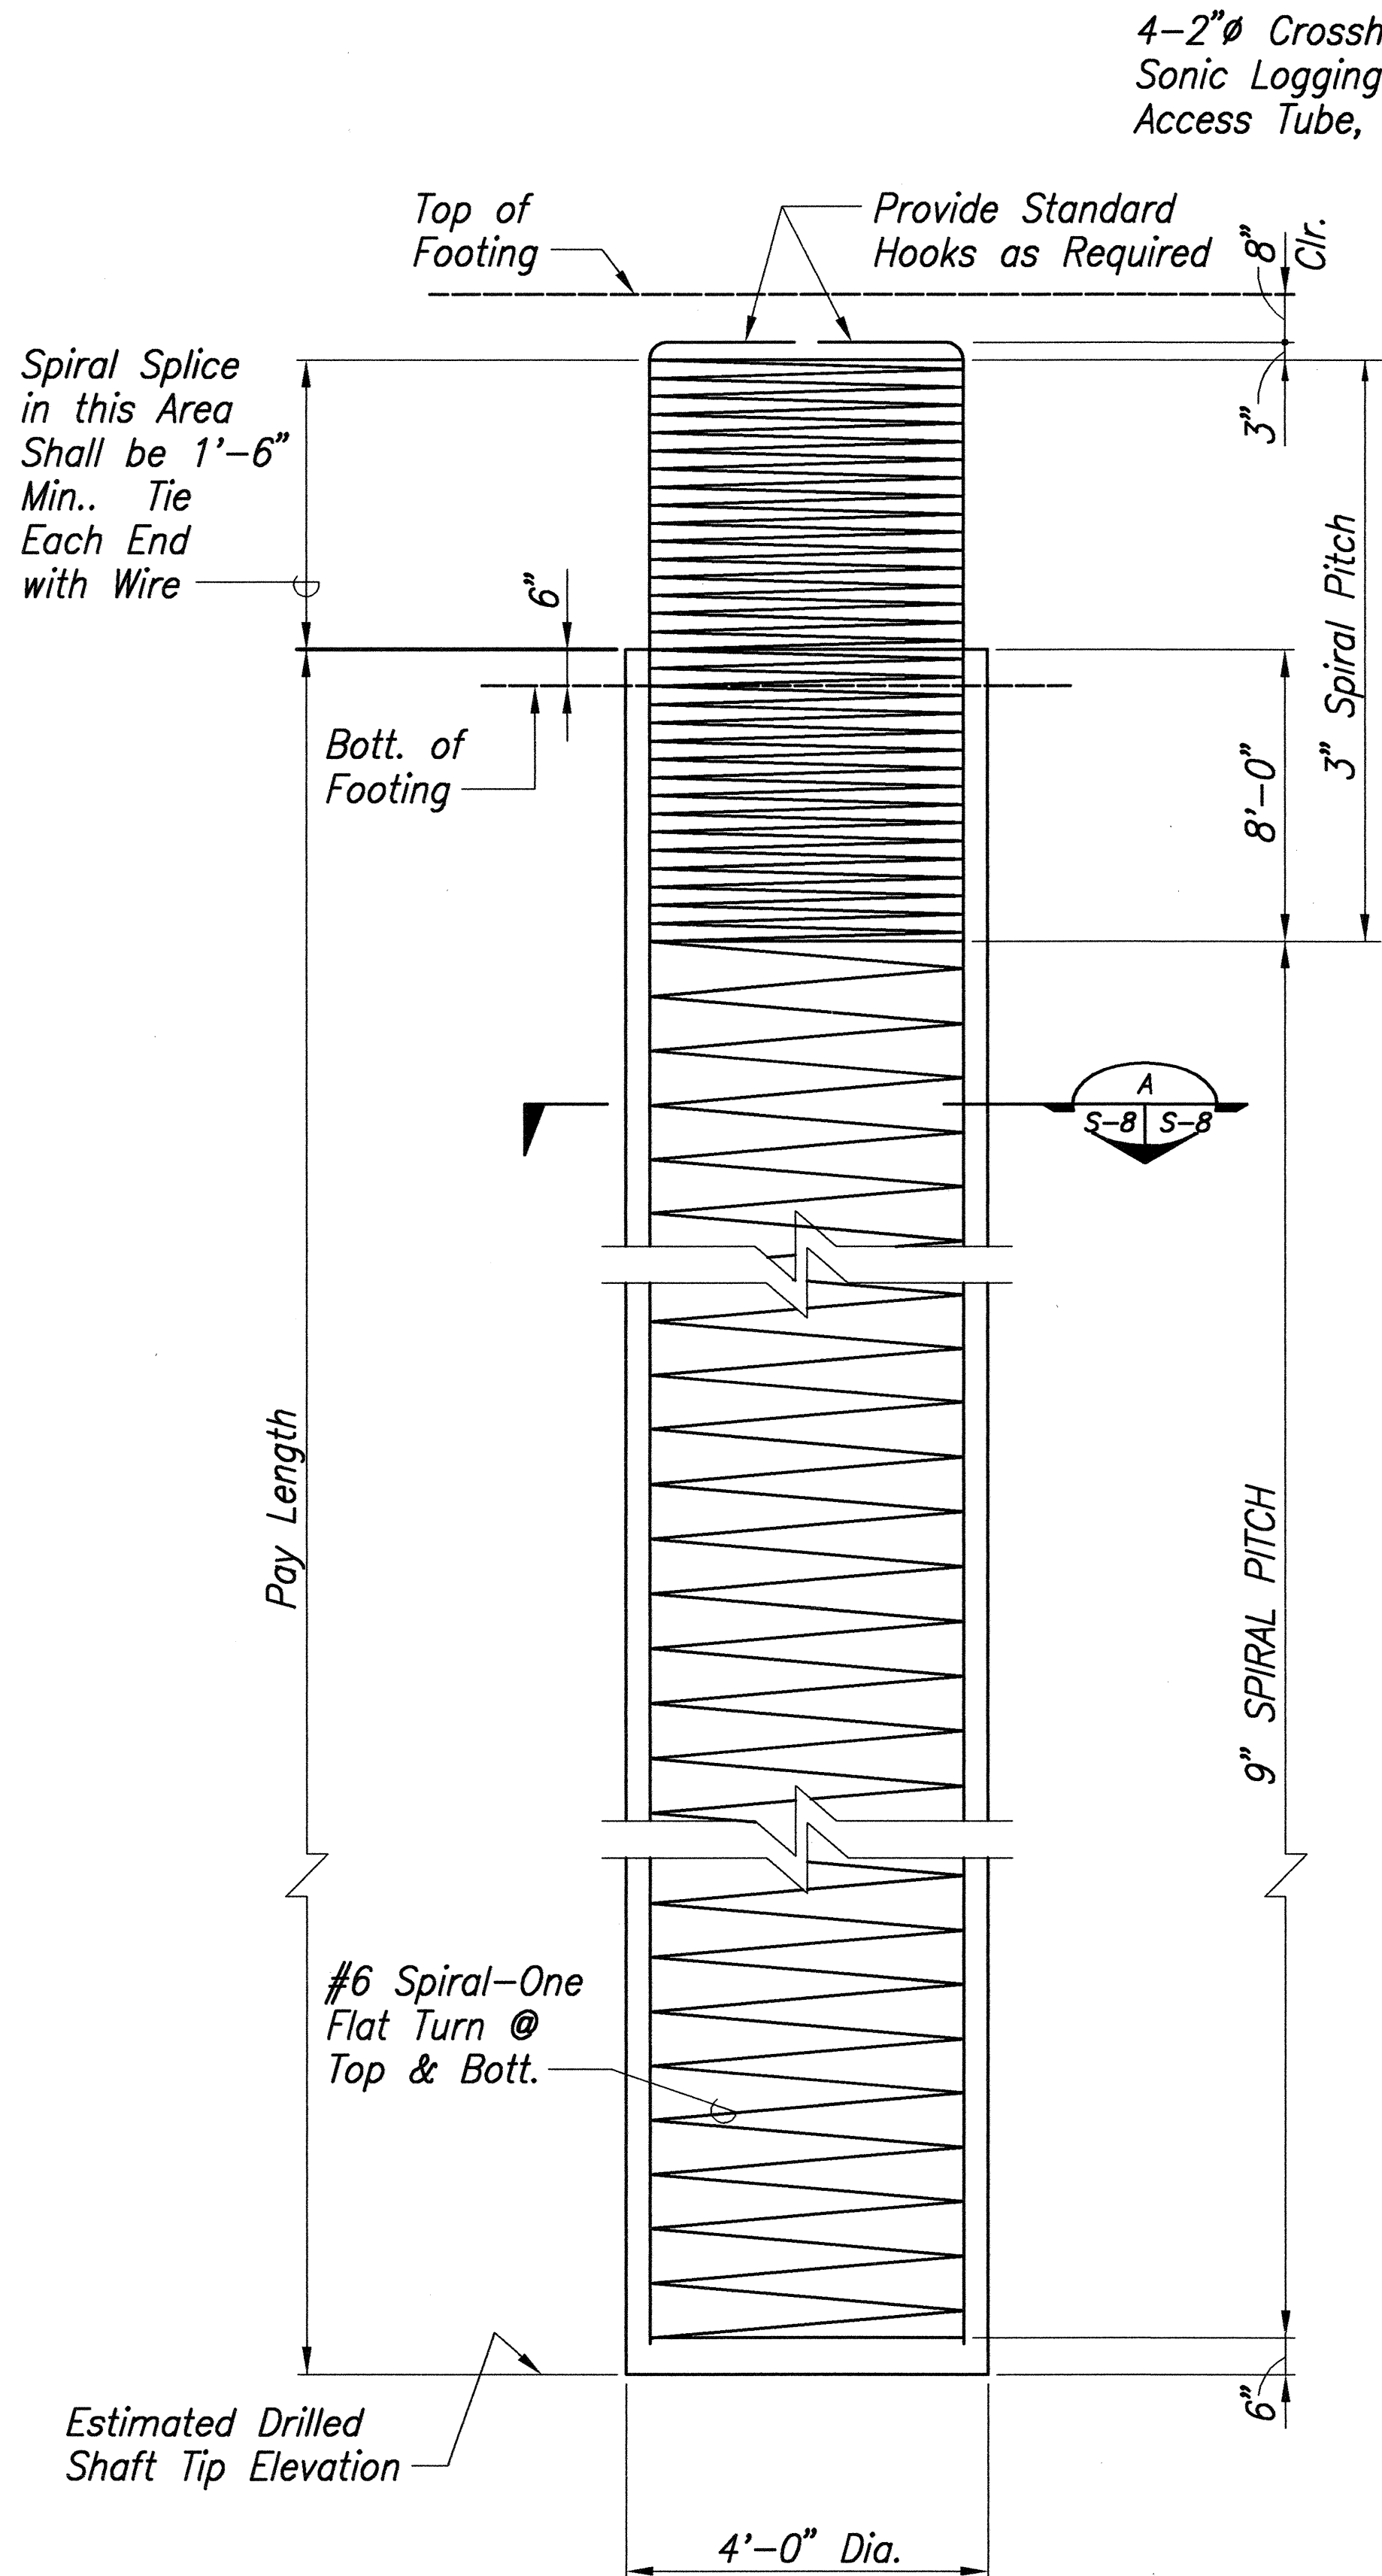


TYP. DRILLED SHAFT ELEVATION
Scale: None

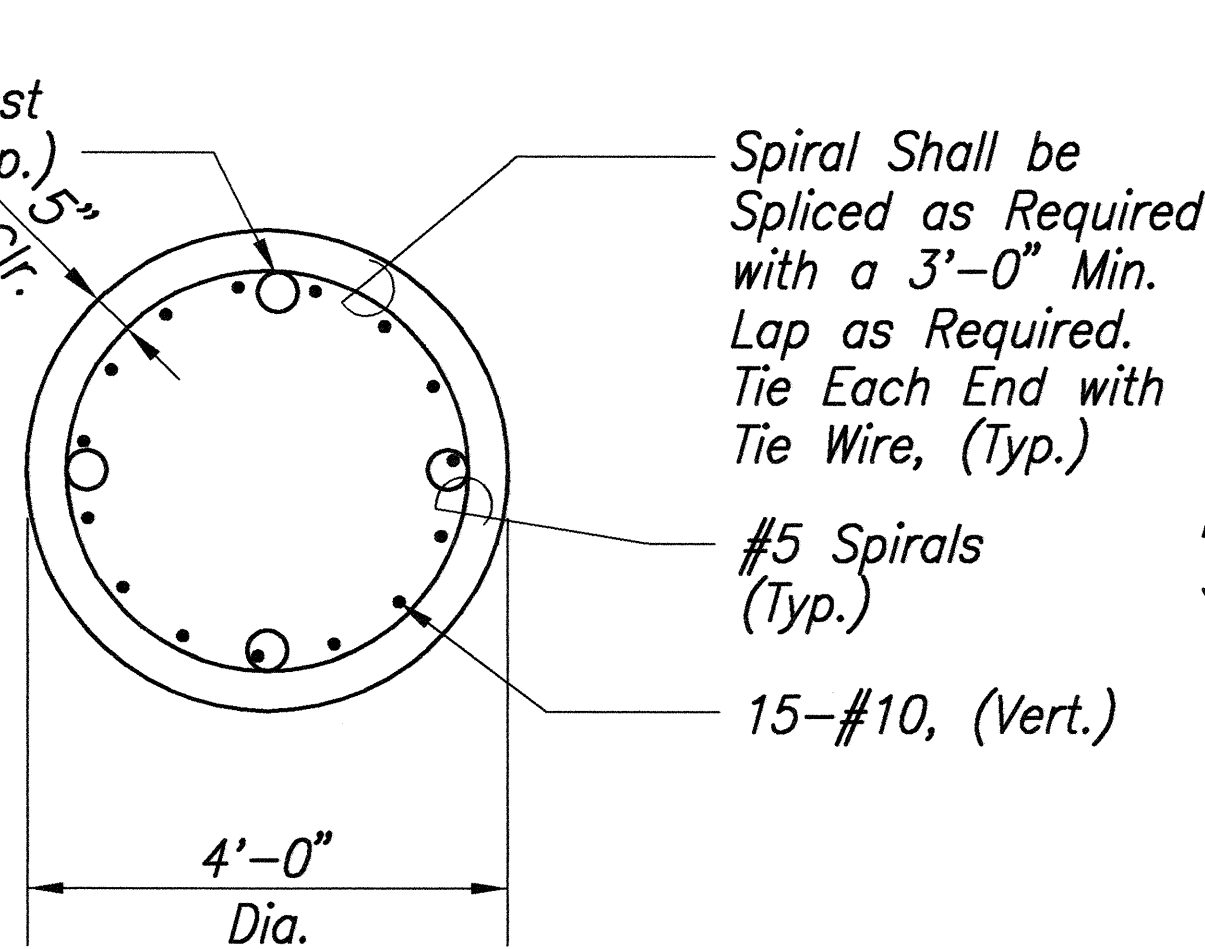


SECTION A
Scale: None
S-8 S-8

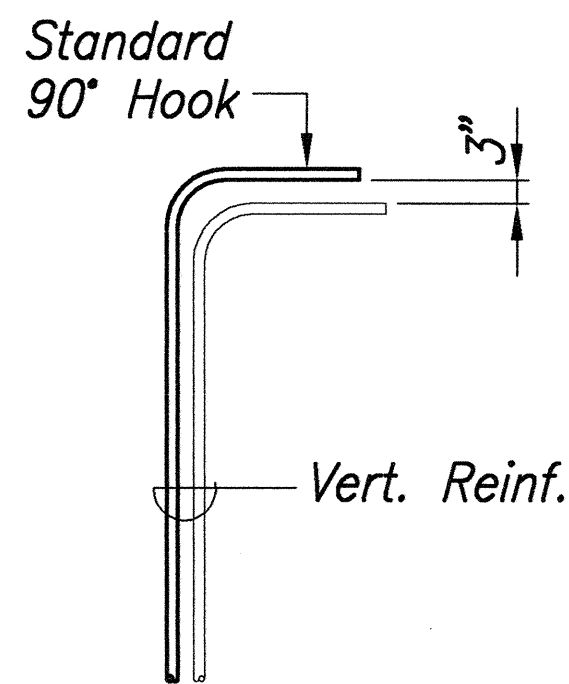


TYPICAL ELEVATION

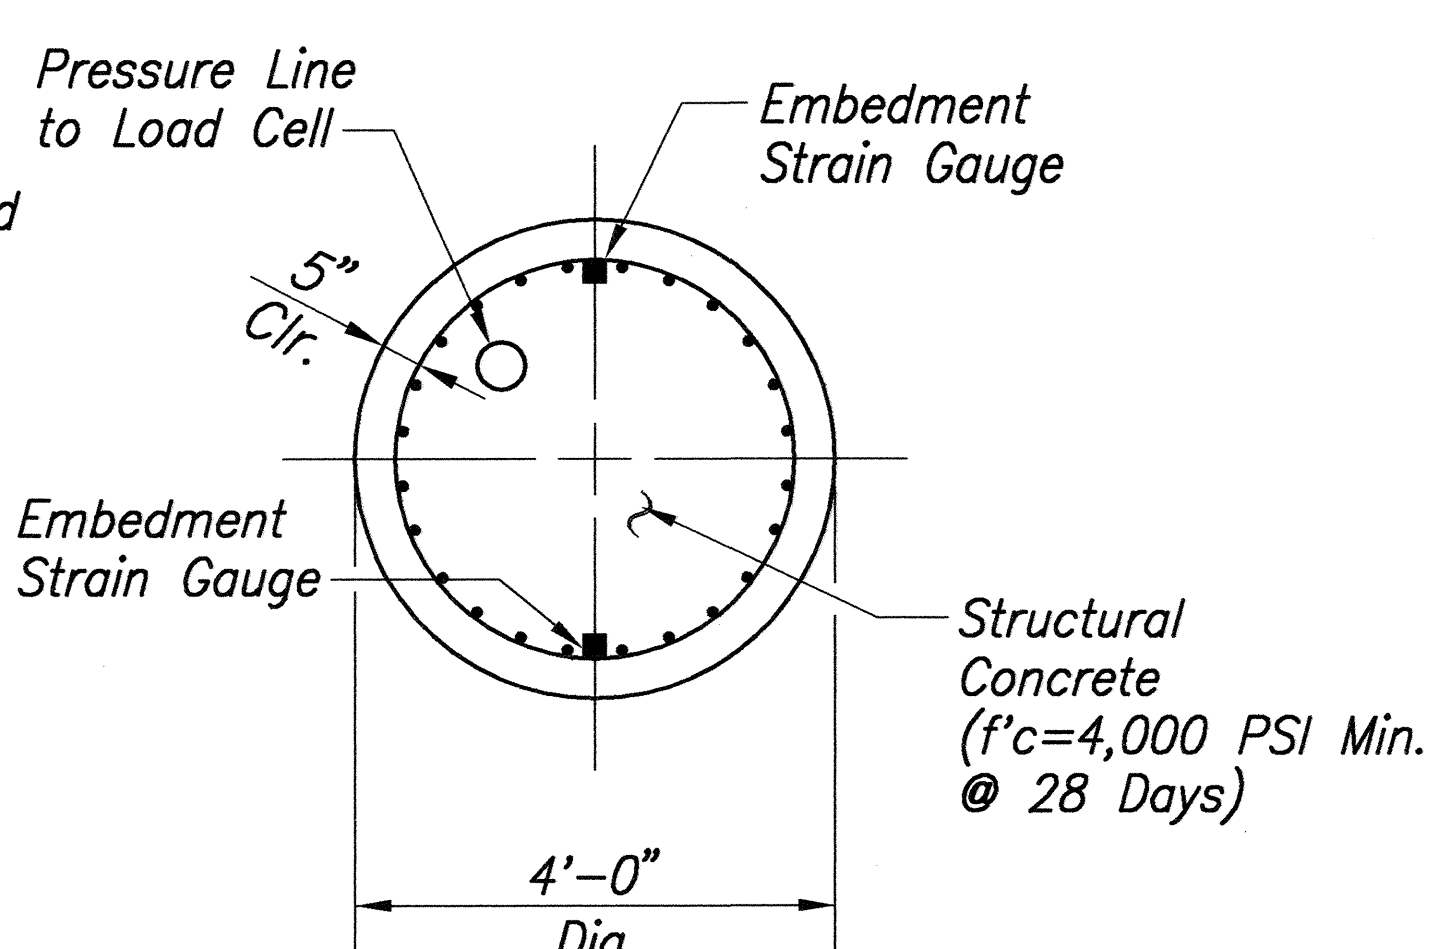

SECTION B
Scale: None
S-8 S-8

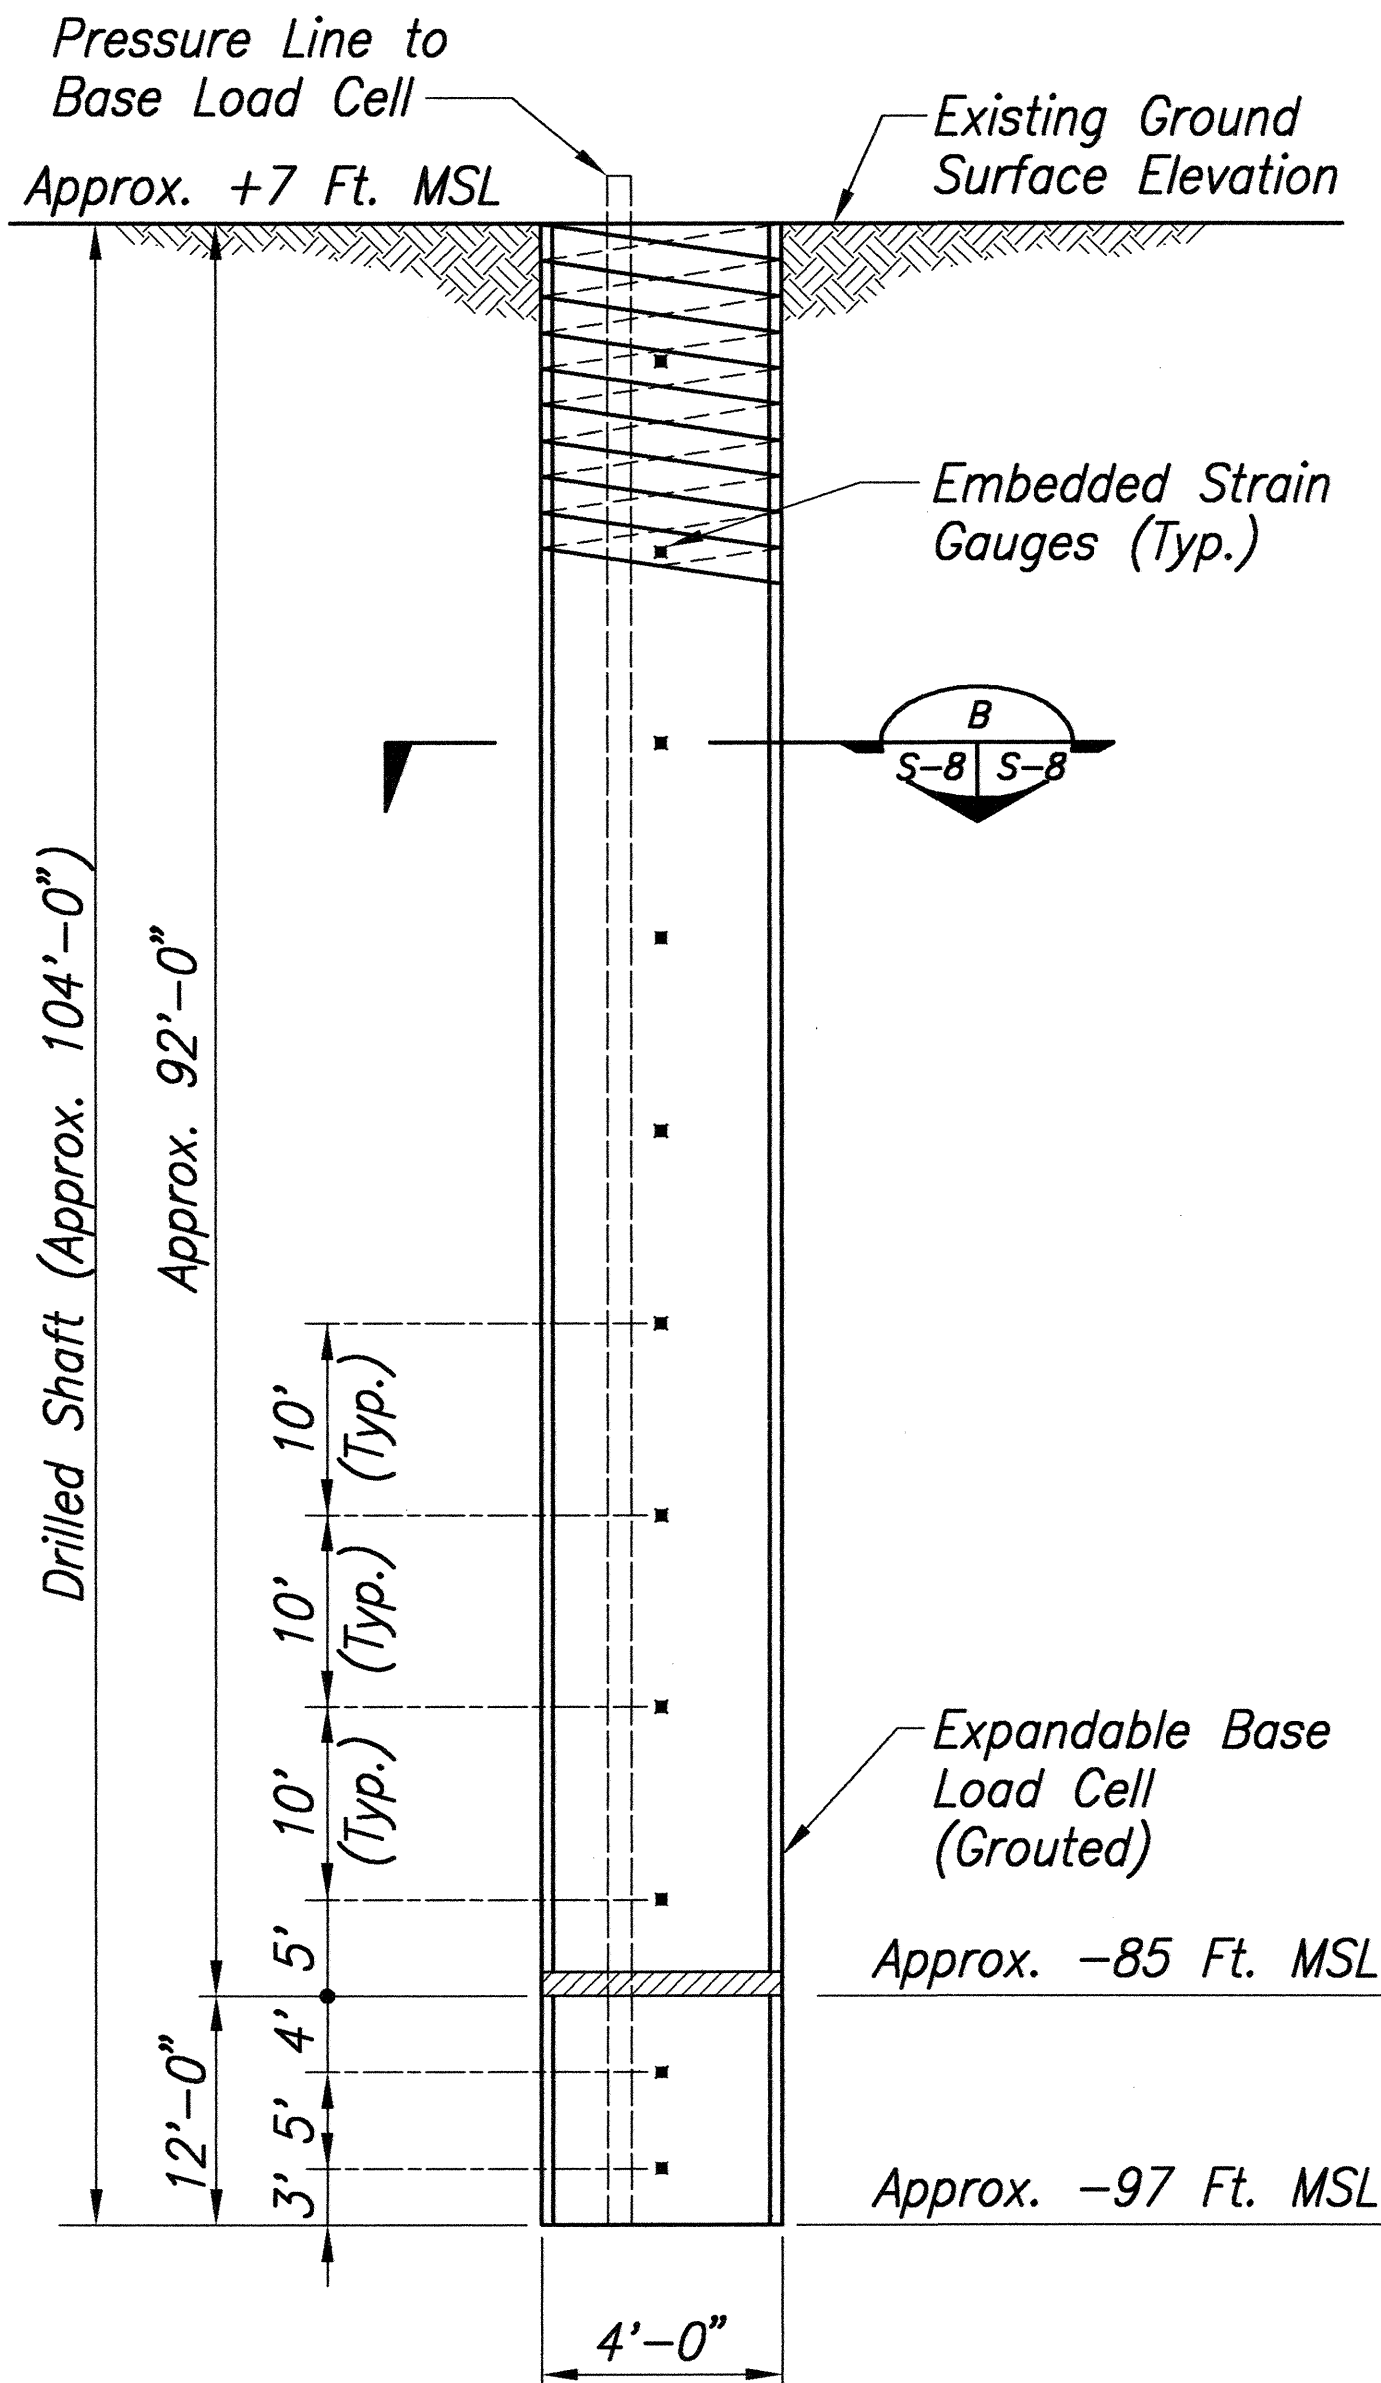

TYP. TEST SHAFT ELEVATION
Scale: none

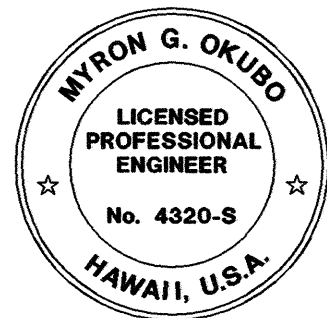

THIS WORK WAS PREPARED BY
ME OR UNDER MY SUPERVISION
Myron G. Okubo
Signature
April 30, 2004
Expiration Date of the License


DATE	REVISION
<p>STATE OF HAWAII DEPARTMENT OF TRANSPORTATION HIGHWAYS DIVISION</p> <p>DRILLED SHAFT DETAILS</p> <p>KAMEHAMEHA V HIGHWAY EMERGENCY REPLACEMENT OF KAWAIKAPU BRIDGE FEDERAL AID PROJECT NO. ER-12(4)</p> <p>Scale: As Noted Date: Nov. 25, 2002</p>	

PRESTRESSED GIRDER NOTES:

- Concrete Shall Have a Minimum Ultimate 28 Day Compressive Strength of 6500 PSI. Minimum Compressive Strength Before Release of Strands is 5000 PSI.
- Prestressing Stands are One-half Inch Diameter, 7 Wire Low-Relaxation Steel Strands (Area = 0.1531 in²) with an Ultimate Strength of 270 KSI, and Shall Conform to ASTM A416.
- Total Long Term Losses Due to Creep, Shrinkage, Elastic Shortening and Relaxation of Steel Determined per AASHTO LRFD, Bridge Design Specifications, Second Edition, 1998, Section 5.9.5.
- Strands Shall be Released in Such a Manner as to Minimize Lateral Eccentricity.
- Care Shall be Taken During Curing, Transportation and Erection to Avoid Any Lateral Deflection of the Girder.
- Lifting Devices or Other Embedded Items Used to Lift and Transport the Girders Shall be Located as Close as Possible to the Girder Centerline of Bearing. The Girder Supplier Shall Submit Details Indicating the Adequate Type, and Location of Lifting Devices for Approval. Approval by the Engineer does not Relieve the Contractor of His Responsibilities if the Girder is Damaged Due to Failure of the Lifting Devices.
- Reinforcing to Conform to ASTM A615 Grade 60.
- Strand Pattern Shall be Symmetrical About the Longitudinal Centerline of the Girders.
- The Contractor Shall Submit His Proposed Strand Pattern and Releasing Sequence to the Engineer for Approval.
- The Contractor Shall Incorporate All Holes, Inserts, and Other Embedded Items Required in Girders During Fabrication of the Girders.
- End of Girder Shall be Plumb After Erection.
- Top of Concrete Seat Shall be Within One-sixteenth of an Inch of the Theoretical Elevation and Slope Indicated.
- For AASHTO Type II Girders, the Contractor Shall Measure and Record Slippage of Strands. Slippage is the Amount of Movement that a Point on the Strand at the End of the Girder Recedes into the Member after Detensioning. For Slippage Monitoring Purposes, Prior to Detensioning, Reference Marks Shall be Made on the Strands Not More than Two Inches from the Surface of the Member End. The Movement of the Reference Mark Shall be Measured to One-sixteenth of an Inch.
- After Detensioning, the Strand Reference Marks Shall be Preserved to Permit Measurements of Strand Movement to the Time the Strands are Made Flush with the Member. The Contractor Shall Submit His Proposed Method of Strand Slippage Measurement with the Shop Drawings. The Engineer will Monitor the Contractor's Method of Measurement and the Slippage Values Obtained.
- Measurement and Recording of Slippage of Strands Shall be Incidental to AASHTO Type II Girders.
- Contractor is Responsible to Provide Adequate Lateral Bracing of Girders During all Phases of Construction Including Transporting, Placing, Erecting and Casting of Other Members.


GIRDER CAMBER NOTES:

- The Calculated Camber Includes the Effect of the Initial Prestress Force and the Weight of the Girder After Removal from the Bed. Negative Values Shown for Calculated Camber Indicate a Net Upward Deflection. The Calculated Camber Value has been Multiplied by Applicable Factors Provided in PCI Handbook Table 4.6.2. to Approximate the Effect of Camber Growth and Concrete Creep. The Actual Camber Shall not Exceed the Calculated Camber by more than One-half inch.
- The Dead Load Deflection Includes the Combined Effects of the Weight of Slab, Haunches, and Diaphragms as Applicable. See Table this Sheet.
- Contractor Shall Camber the Deck Form work as Required to Account for the Calculated Dead Load Deflection in Order to Provide the Specified Finish Deck Elevations.
- All Cambers and Deflections are in Inches.

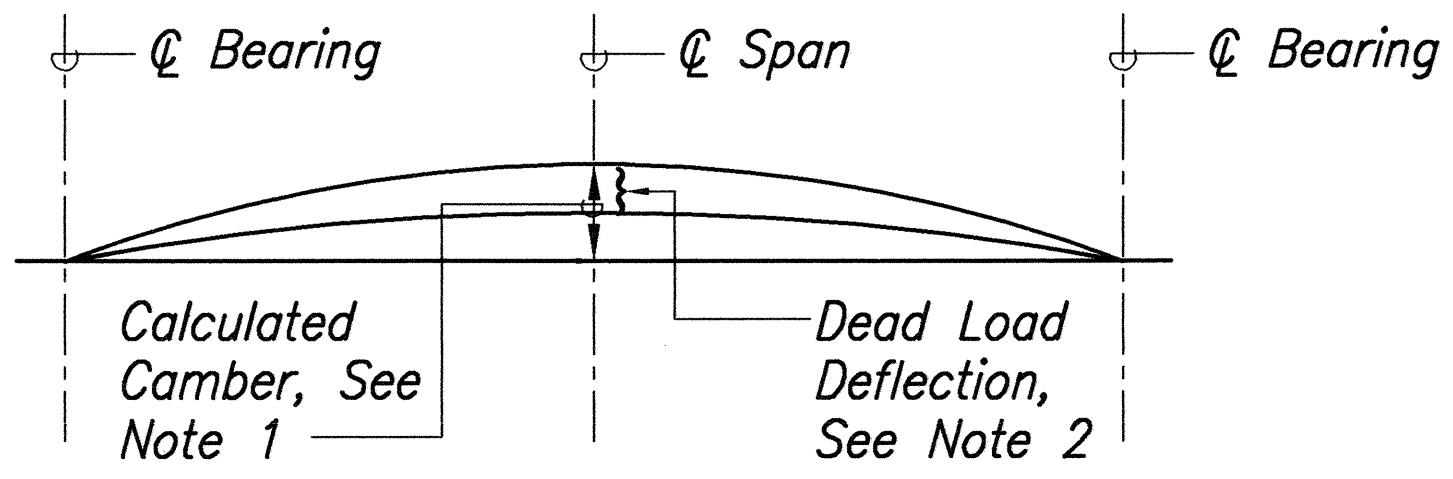

GIRDER CAMBER DIAGRAM

Scale: None

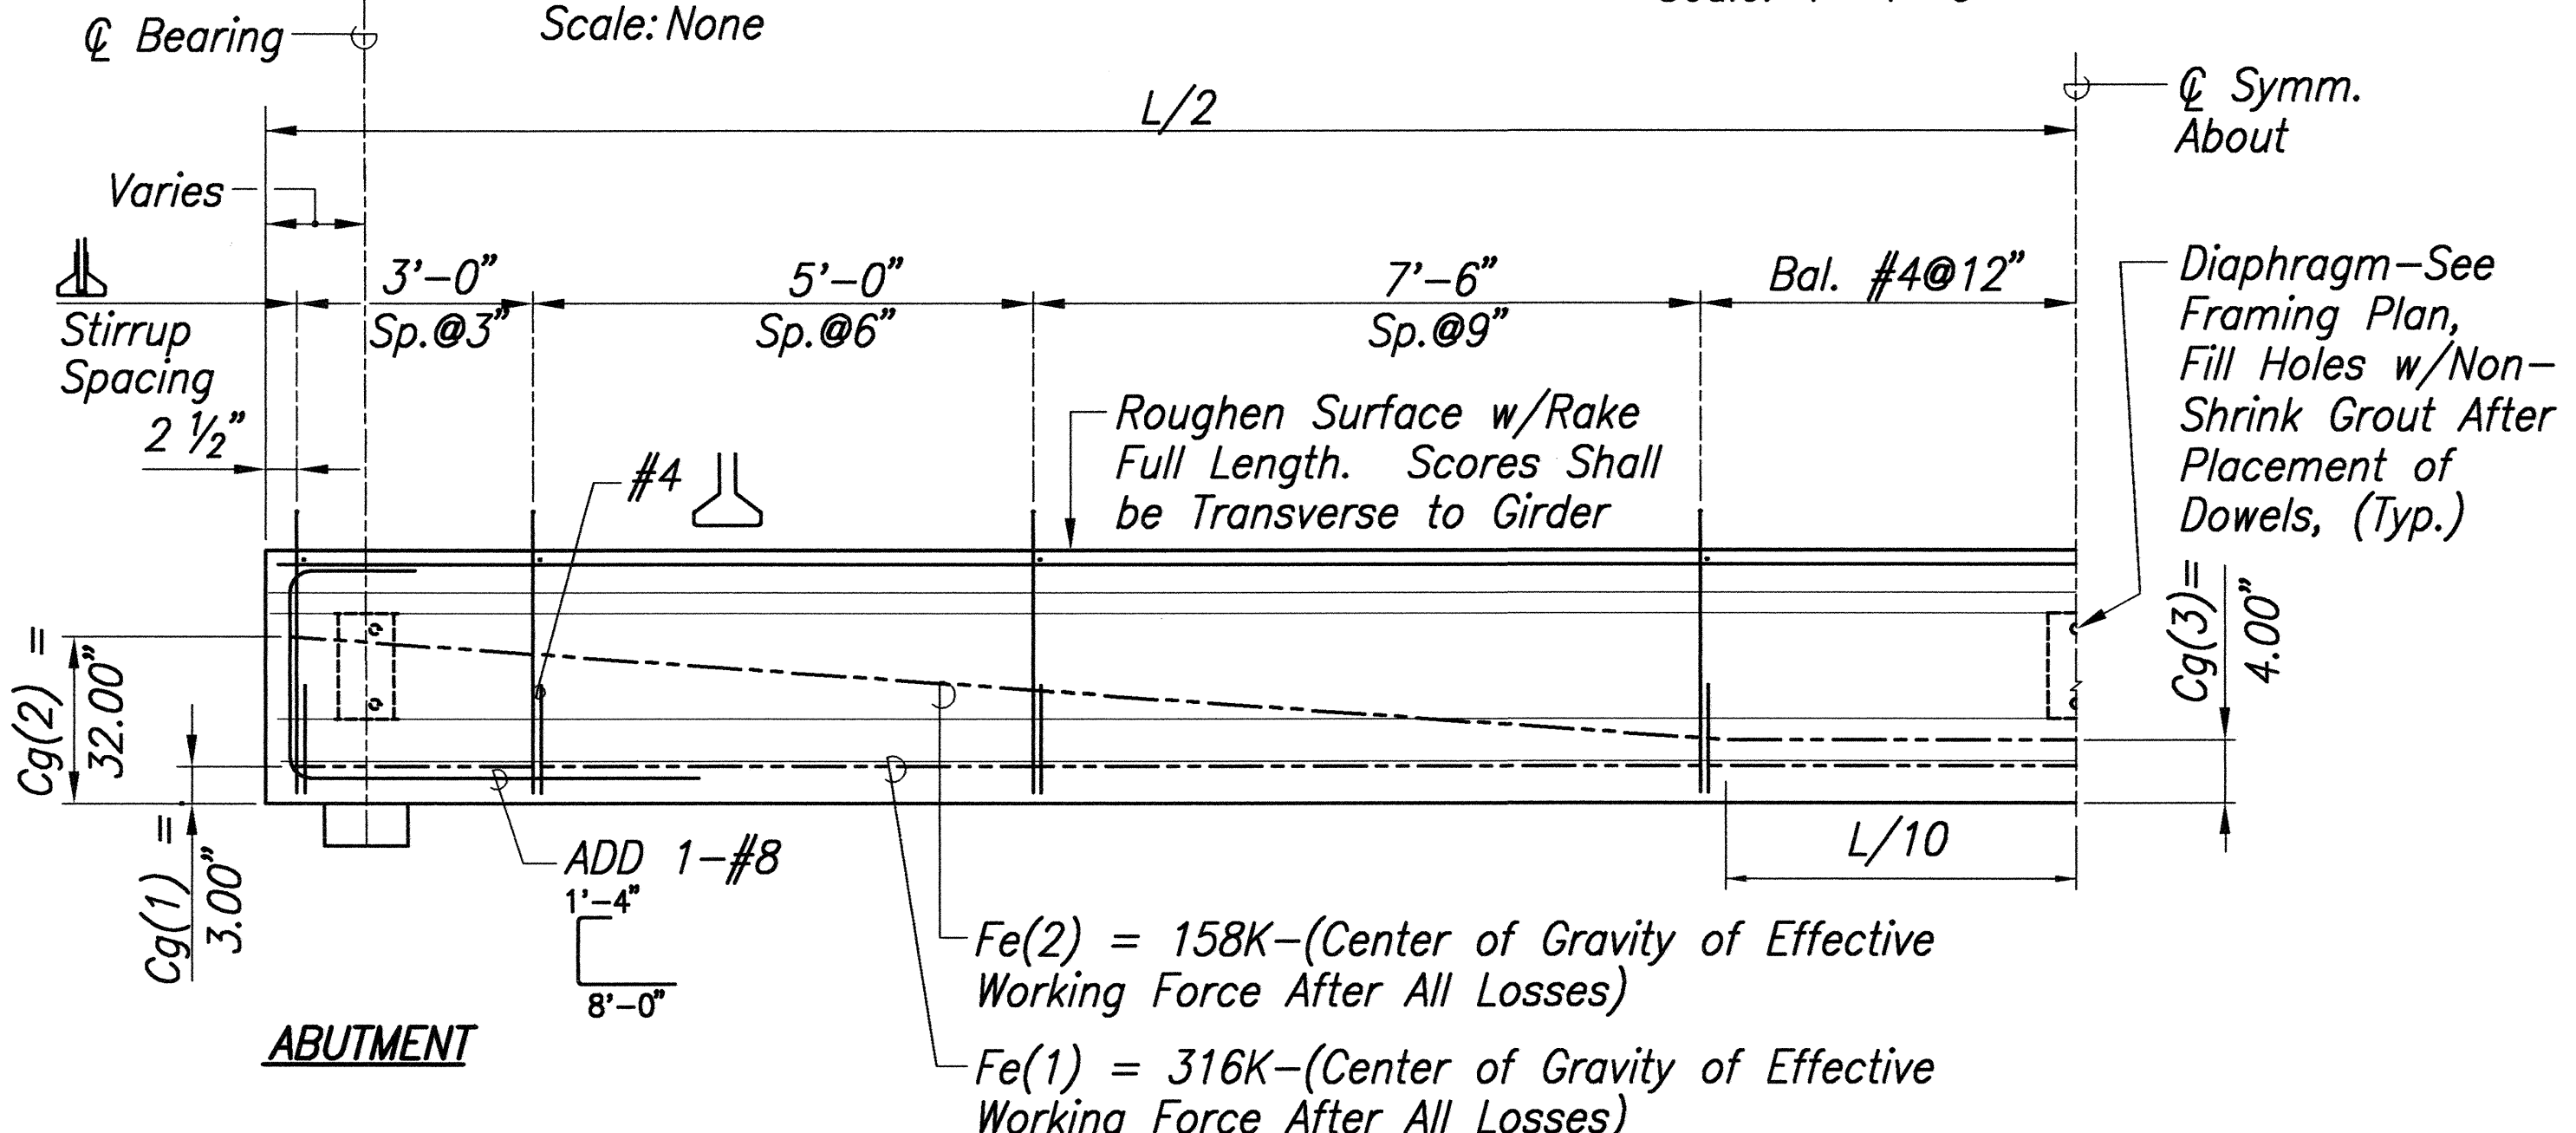


ABUTMENT

Note:
1. Prestressing Strands Not Shown for Clarity.

AASHTO TYPE II GIRDER LONGITUDINAL SECTION

Scale: None

FED. ROAD DIST. NO.	STATE	FED. AID PROJ. NO.	FISCAL YEAR	SHEET NO.	TOTAL SHEETS
HAWAII	HAW.	ER-12(4)	2003	59	76

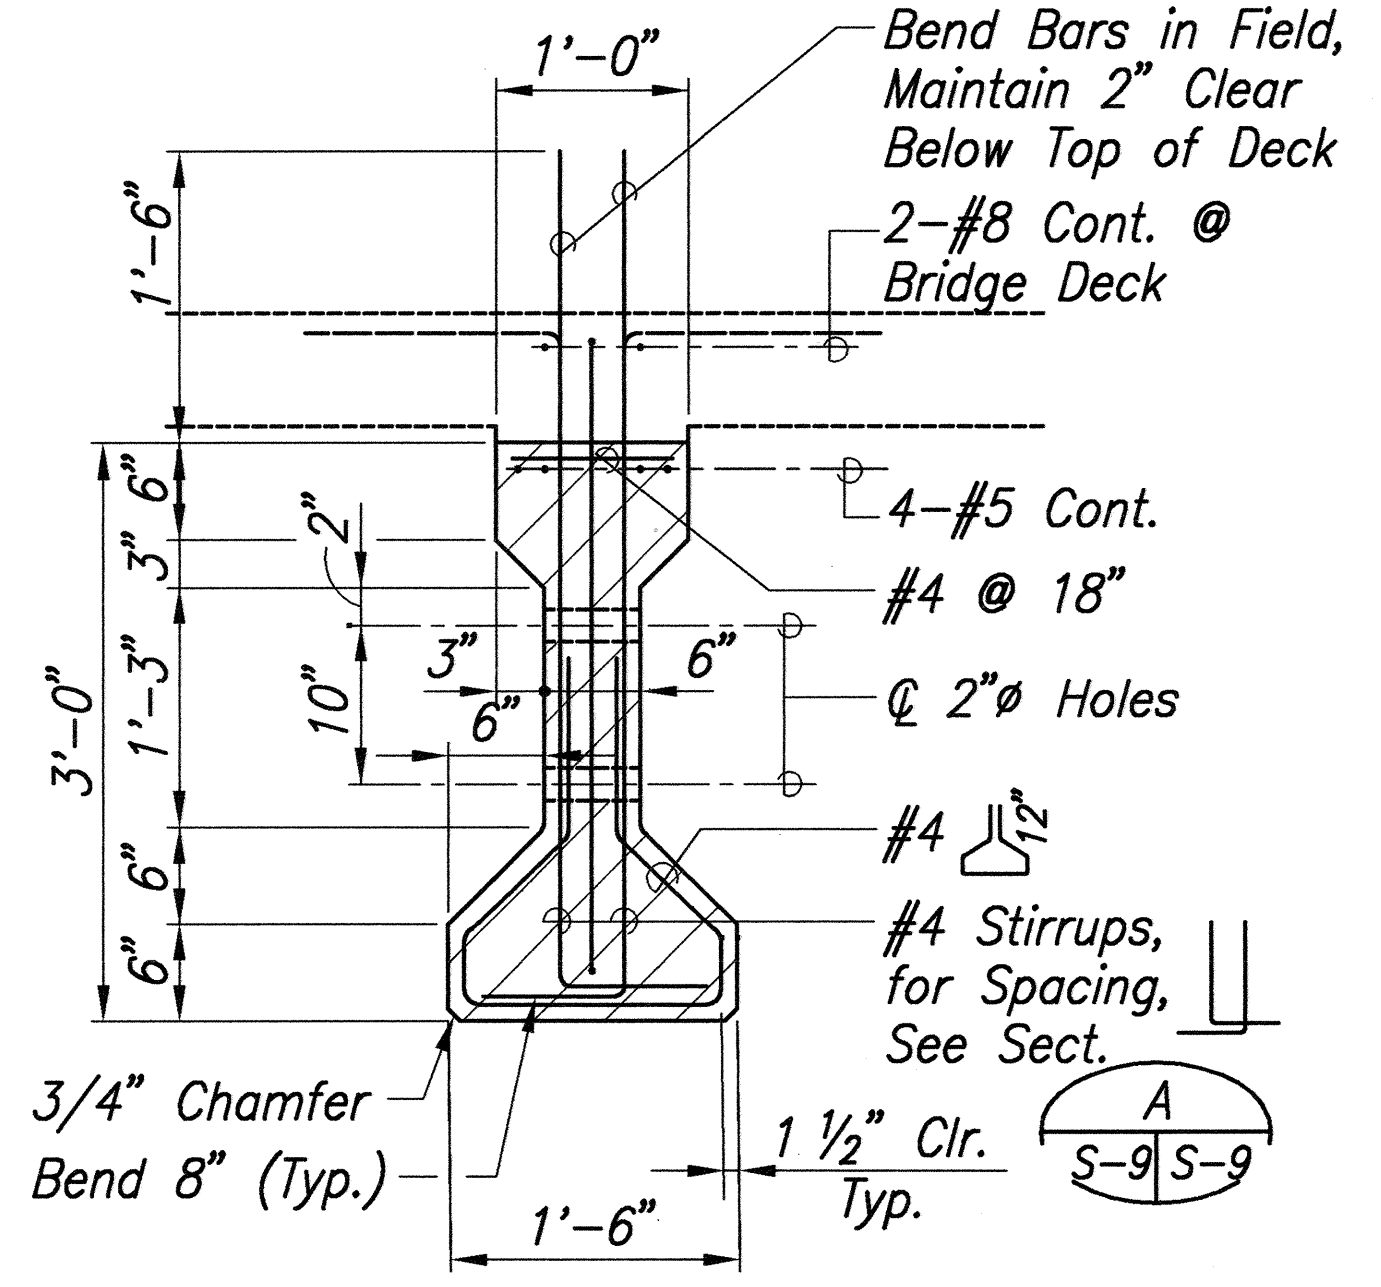

TYPICAL AASHTO TYPE II GIRDER SECTION

Scale: 1"=1'-0"

B
S-9 S-9

SURVEY PLOTTED BY	DATE
DRAWN BY	
DESIGNED BY	
CHECKED BY	
QUANTITIES BY	
NO.	

Path: L:\W04\6465-01\STR File Name: S9 Plot date: Jan 17, 2003-09:56:06am CAD User: deong. Xref File Name: Border

Girder Mark	Length ¢ Brg. to ¢ Brg.	Calculated Camber	Calculated Dead Load Deflection	Conc. Brg. Seat Slope	Remarks
G-1 Thru G-8	61.50'	-1.97"	1.25"	0" / 12"	

Professional Engineer Seal for WYRON G. OKUBO, No. 4320-S, HAWAII, U.S.A.

Signature: WYRON G. OKUBO
Date: April 30, 2004
Expiration Date of the License

STATE OF HAWAII
DEPARTMENT OF TRANSPORTATION
HIGHWAYS DIVISION


PRESTRESSED GIRDER DETAILS

KAMEHAMEHA V HIGHWAY
EMERGENCY REPLACEMENT OF KAWAIKAPU BRIDGE
FEDERAL AID PROJECT NO. ER-12(4)


Scale: As Noted Date: Nov. 25, 2002

SHEET No. S-9 OF 16 SHEETS

FED. ROAD DIST. NO.	STATE	FED. AID PROJ. NO.	FISCAL YEAR	SHEET NO.	TOTAL SHEETS
HAWAII	HAW.	ER-12(4)	2003	60	76

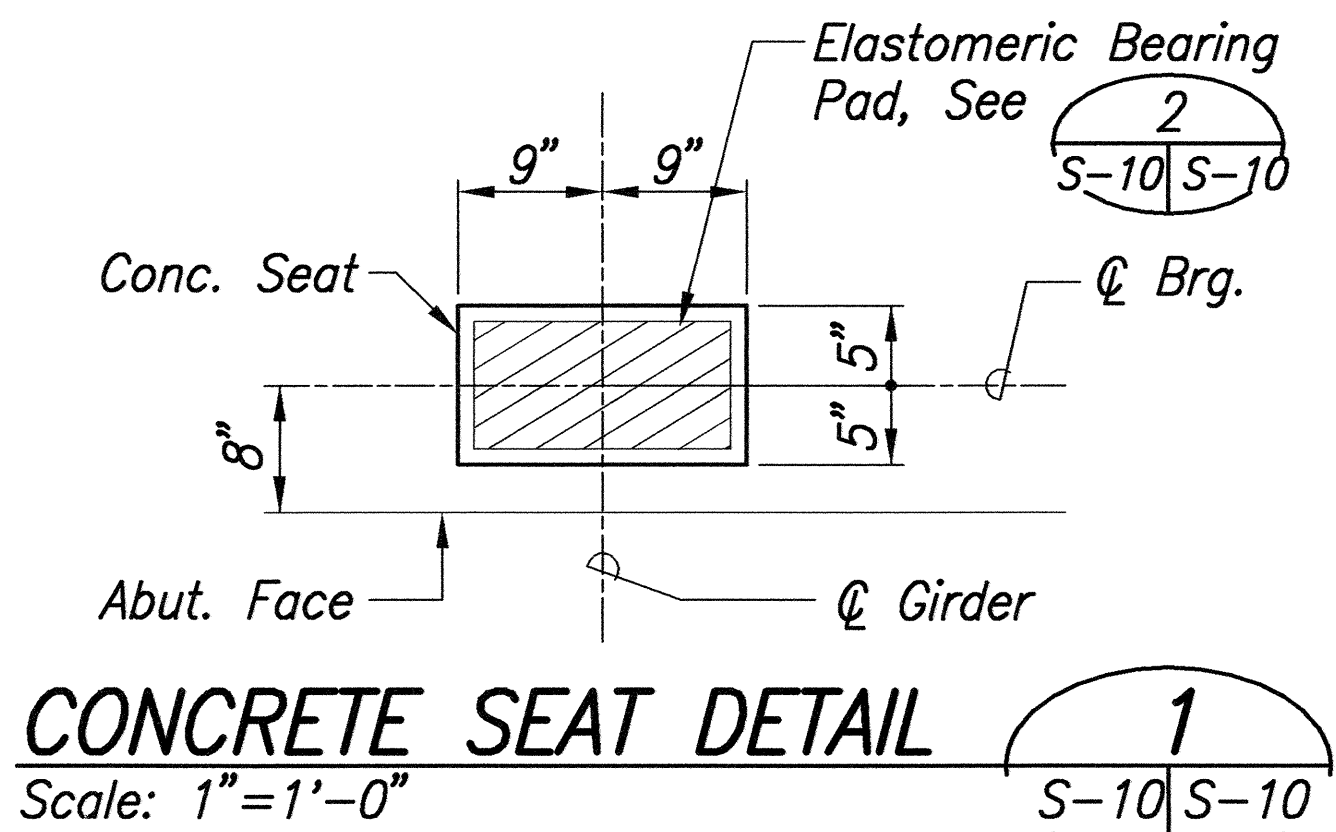


CONCRETE SEAT DETAIL
Scale: 1"=1'-0"
1
S-10 S-10

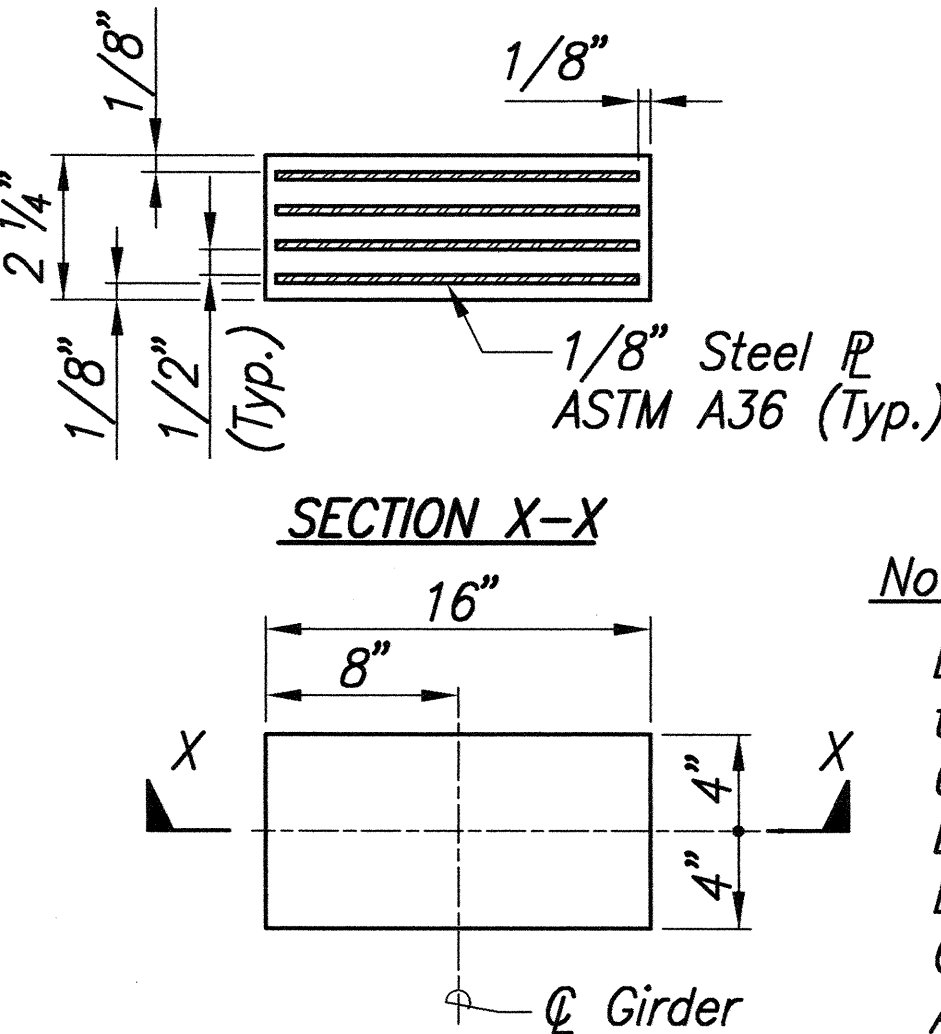


ELASTOMERIC BEARING PAD DETAILS
Scale: None
2
S-10 S-10

Note:
Elastomeric Bearing Pad to Consist of Neoprene, 60 Hardness with Steel Laminations. Elastomeric Bearing Pads Shall be Considered Incidental to AASHTO Type II Girders.

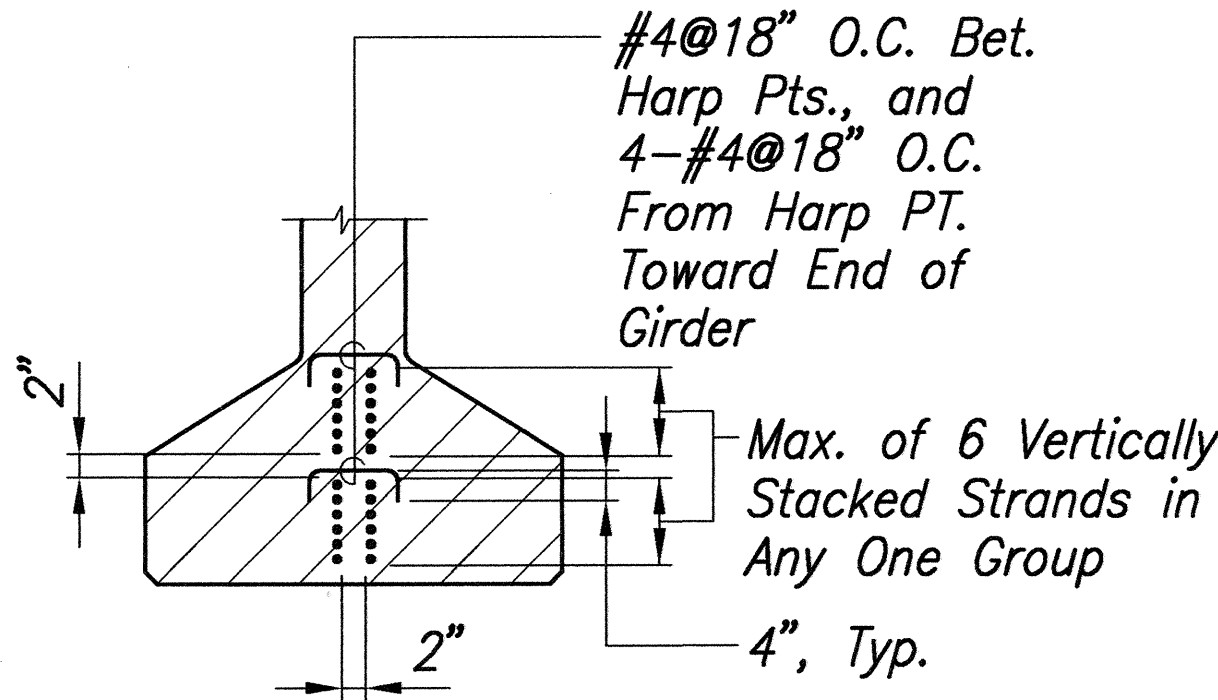


BUNDLED PRESTRESSING REINFORCEMENT DETAIL
Scale: 1"=1'-0"
3
S-10 S-10

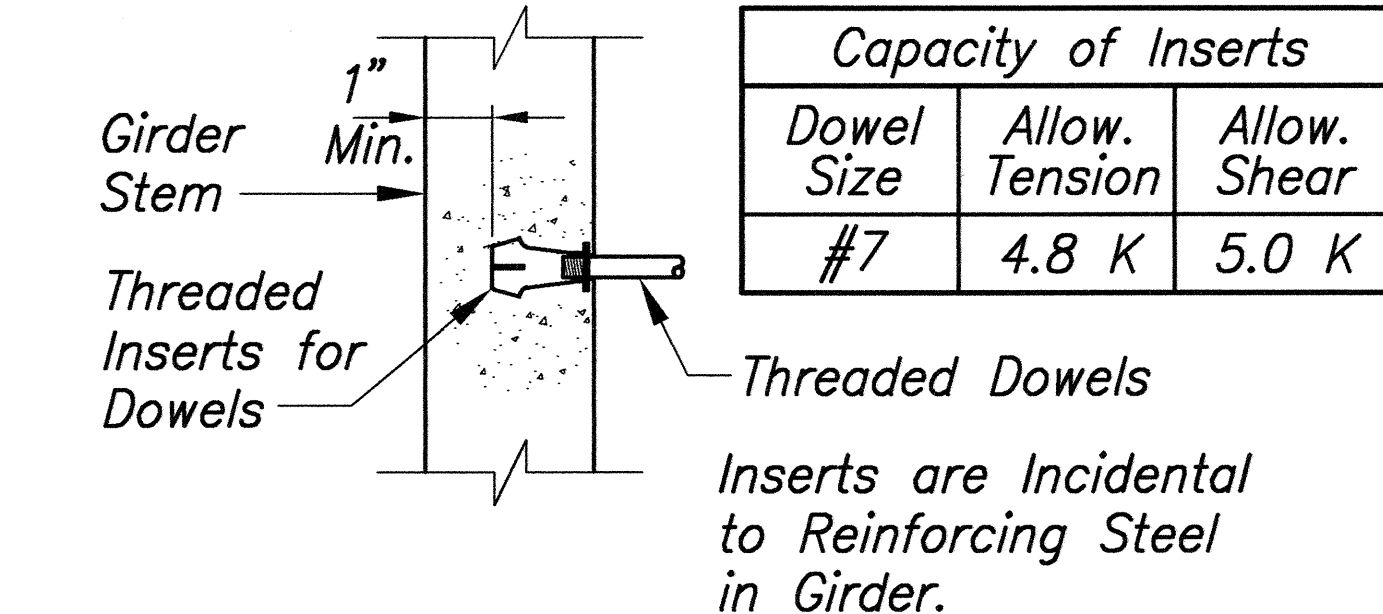

THREADED INSERT DETAIL
Scale: NONE
4
S-4 S-10

SURVEY PLOTTED BY	DATE
DRAWN BY	
DESIGNED BY	
CHECKED BY	
NO.	


Path: L:\W04\6465-01\STR File Name: S10 Plot Date: Jan 17, 2003-09:56:49am CAD User: eleong, Xref File Name: | Border |

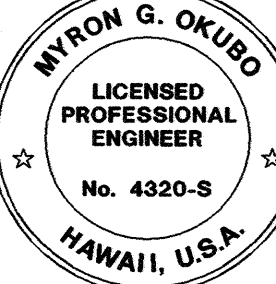

THIS WORK WAS PREPARED BY ME OR UNDER MY SUPERVISION
Signature
April 30, 2004
Expiration Date of the License


DATE	REVISION
	STATE OF HAWAII DEPARTMENT OF TRANSPORTATION HIGHWAYS DIVISION SECTIONS AND DETAILS KAMEHAMEHA V HIGHWAY EMERGENCY REPLACEMENT OF KAWAIKAPU BRIDGE FEDERAL AID PROJECT NO. ER-12(4) Scale: As Noted Date: Nov. 25, 2002 SHEET NO. S-10 OF 16 SHEETS

FED. ROAD DIST. NO.	STATE	FED. AID PROJ. NO.	FISCAL YEAR	SHEET NO.	TOTAL SHEETS
HAWAII	HAW.	ER-12(4)	2003	61	76

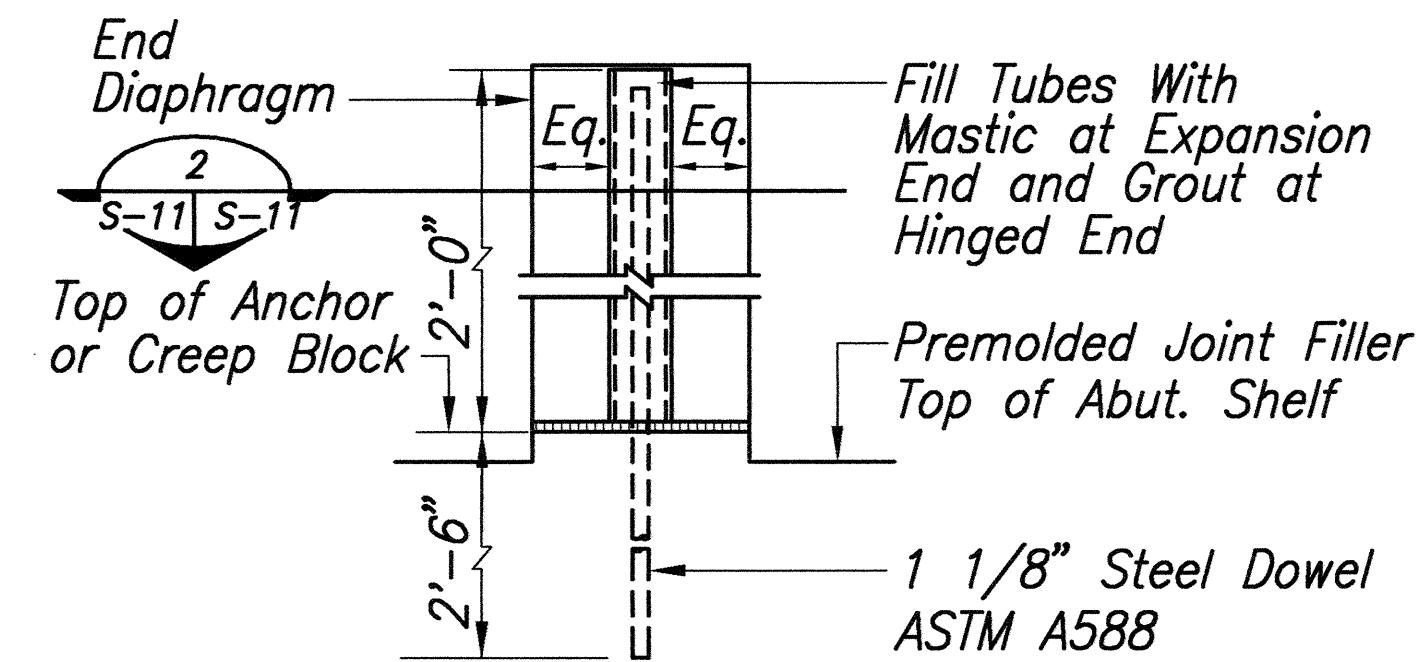


HINGE DOWEL 1
Scale: None S-6 S-11

1/8" Galvanized Steel Tube (ASTM A36). Fabricated From Flat Bars Welded Together. Assembly Shall be Incidental Reinforcing Steel in Bridge. Tubes Shall be Capped by Welding a Steel Plate Following Placement of End Diaphragm And After Inspection And Placement of Mastic or Grout. Provide 1/2" Gap Between Top or Dowel And Bottom of Steel Cap Plate.

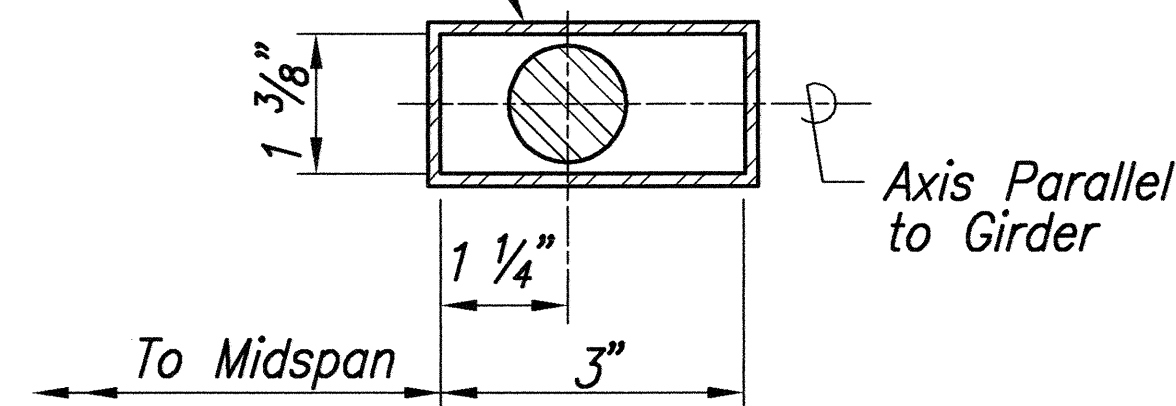


TUBE ASSEMBLY SECTION 2
Scale: None S-11 S-11

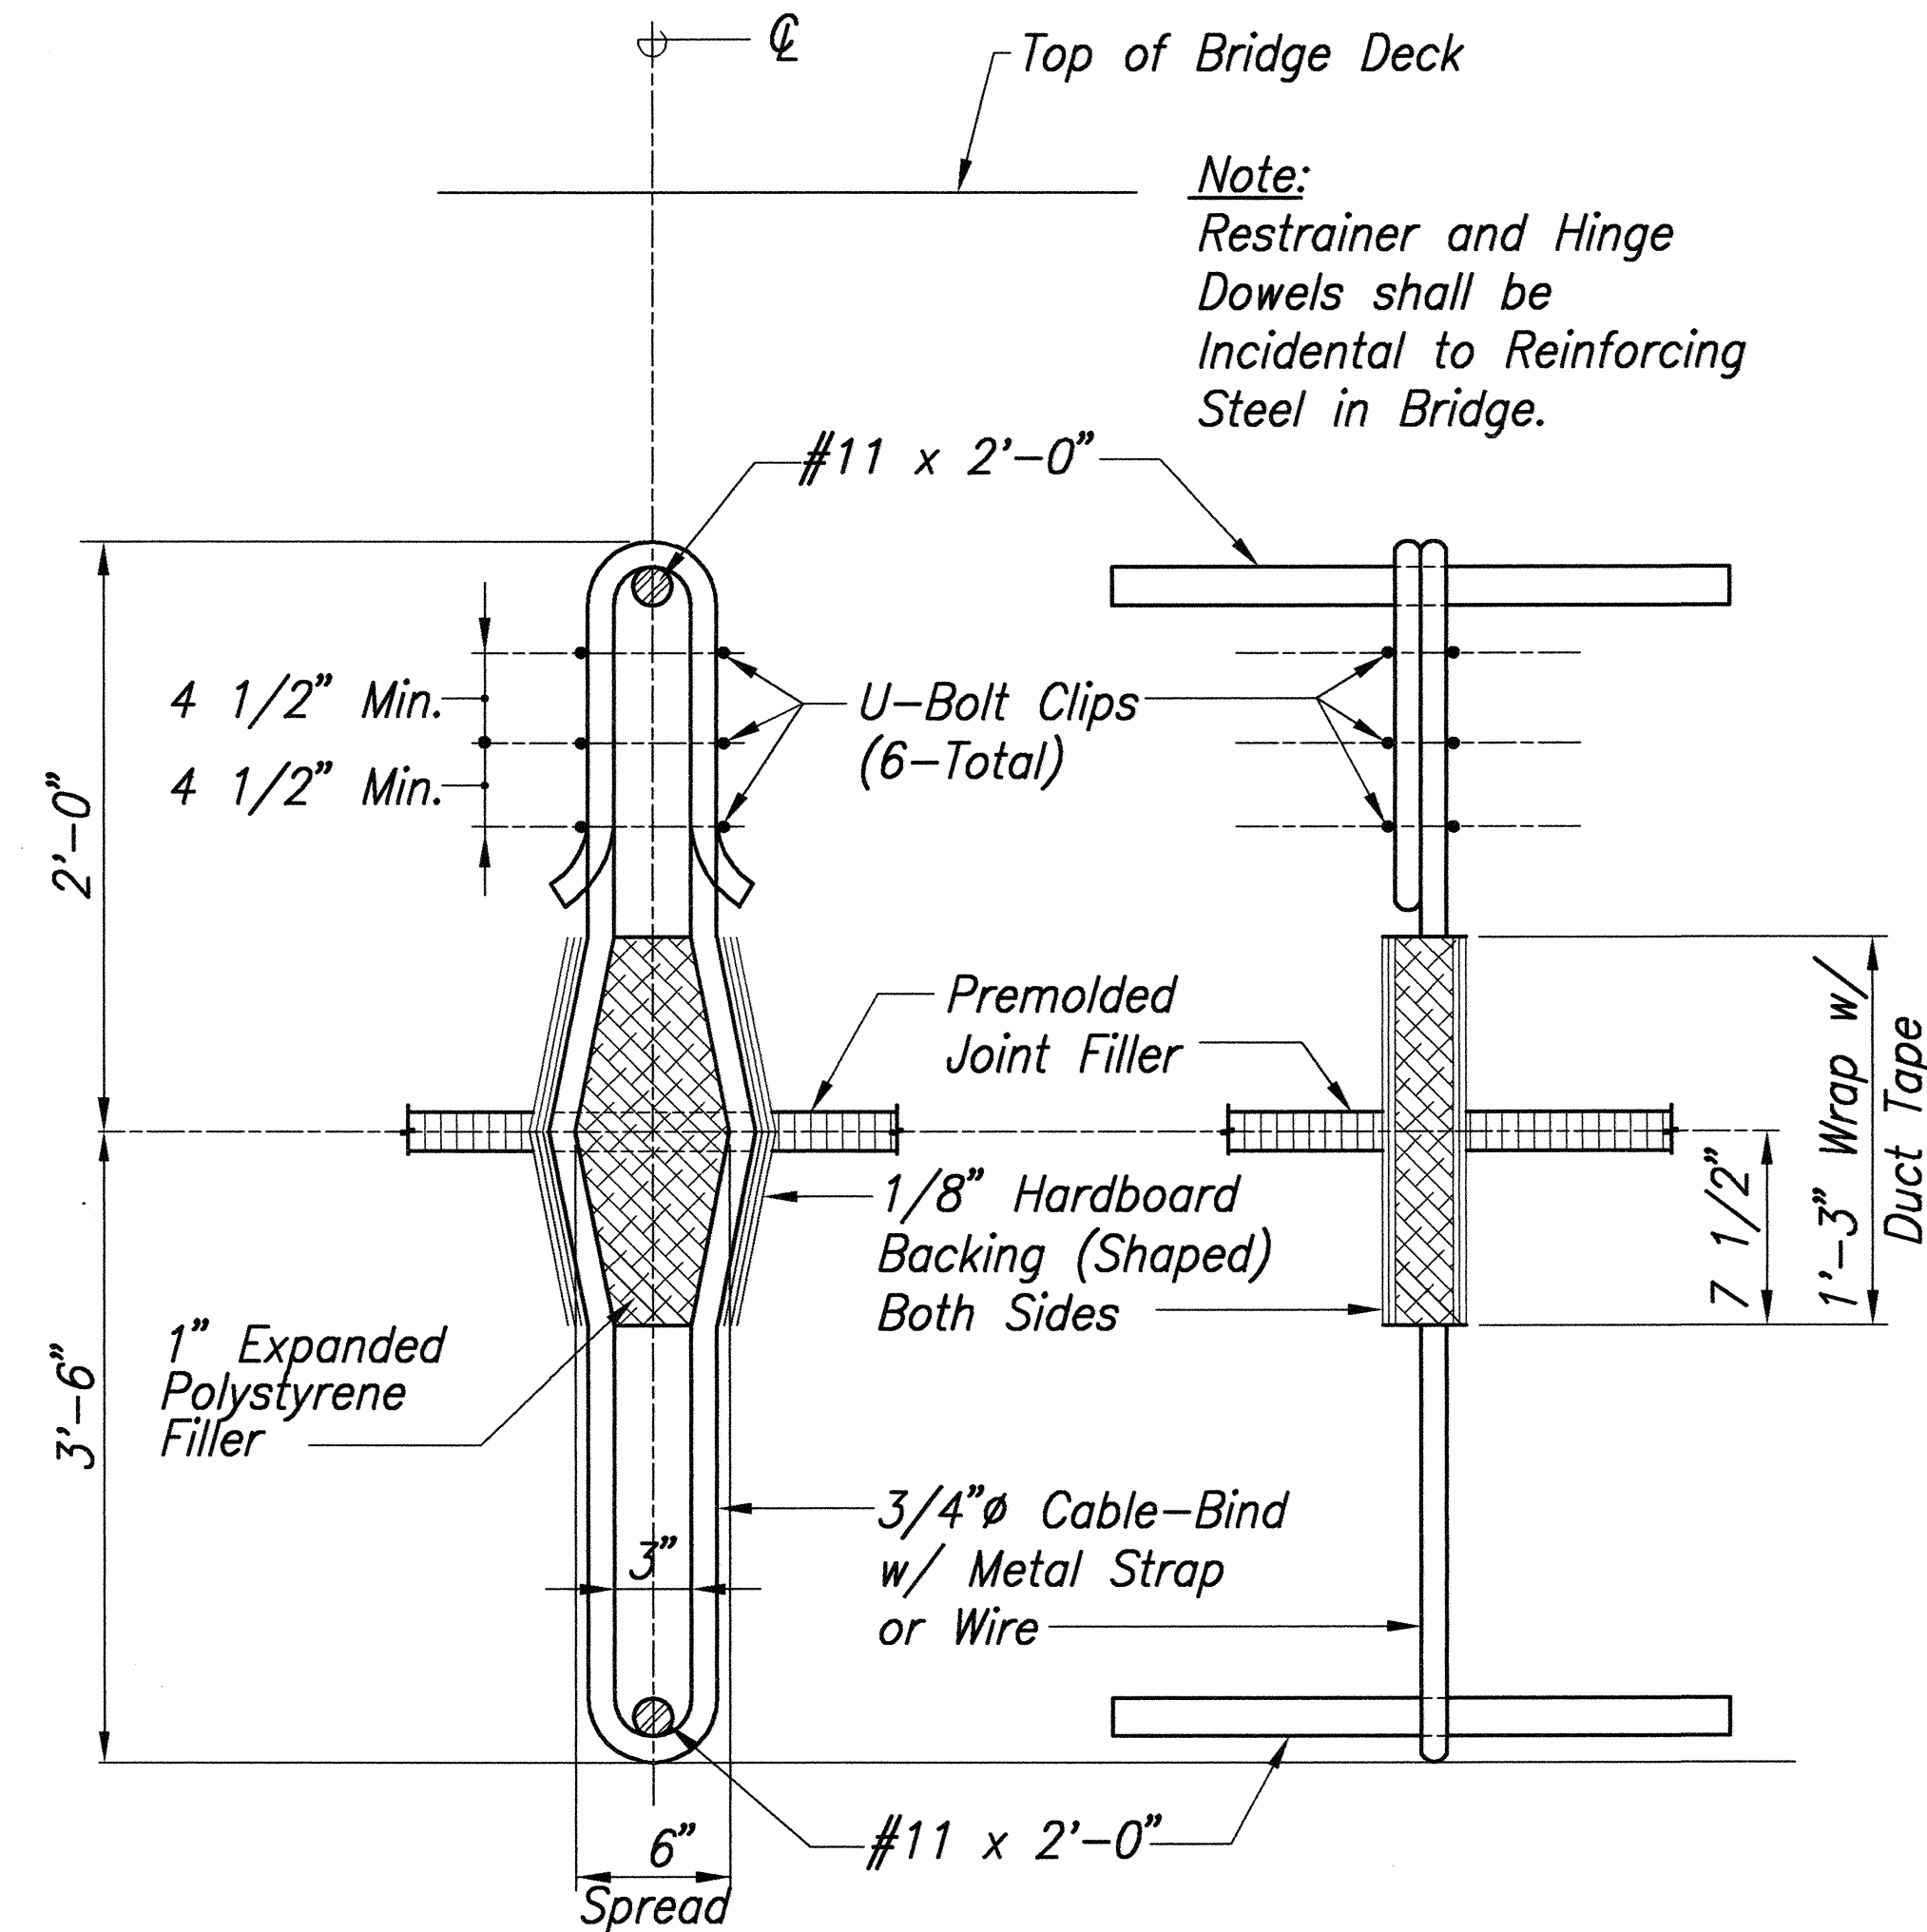

ELEVATION SECTION


VERTICAL RESTRAINER DETAIL 3
Scale: None S-4 S-11

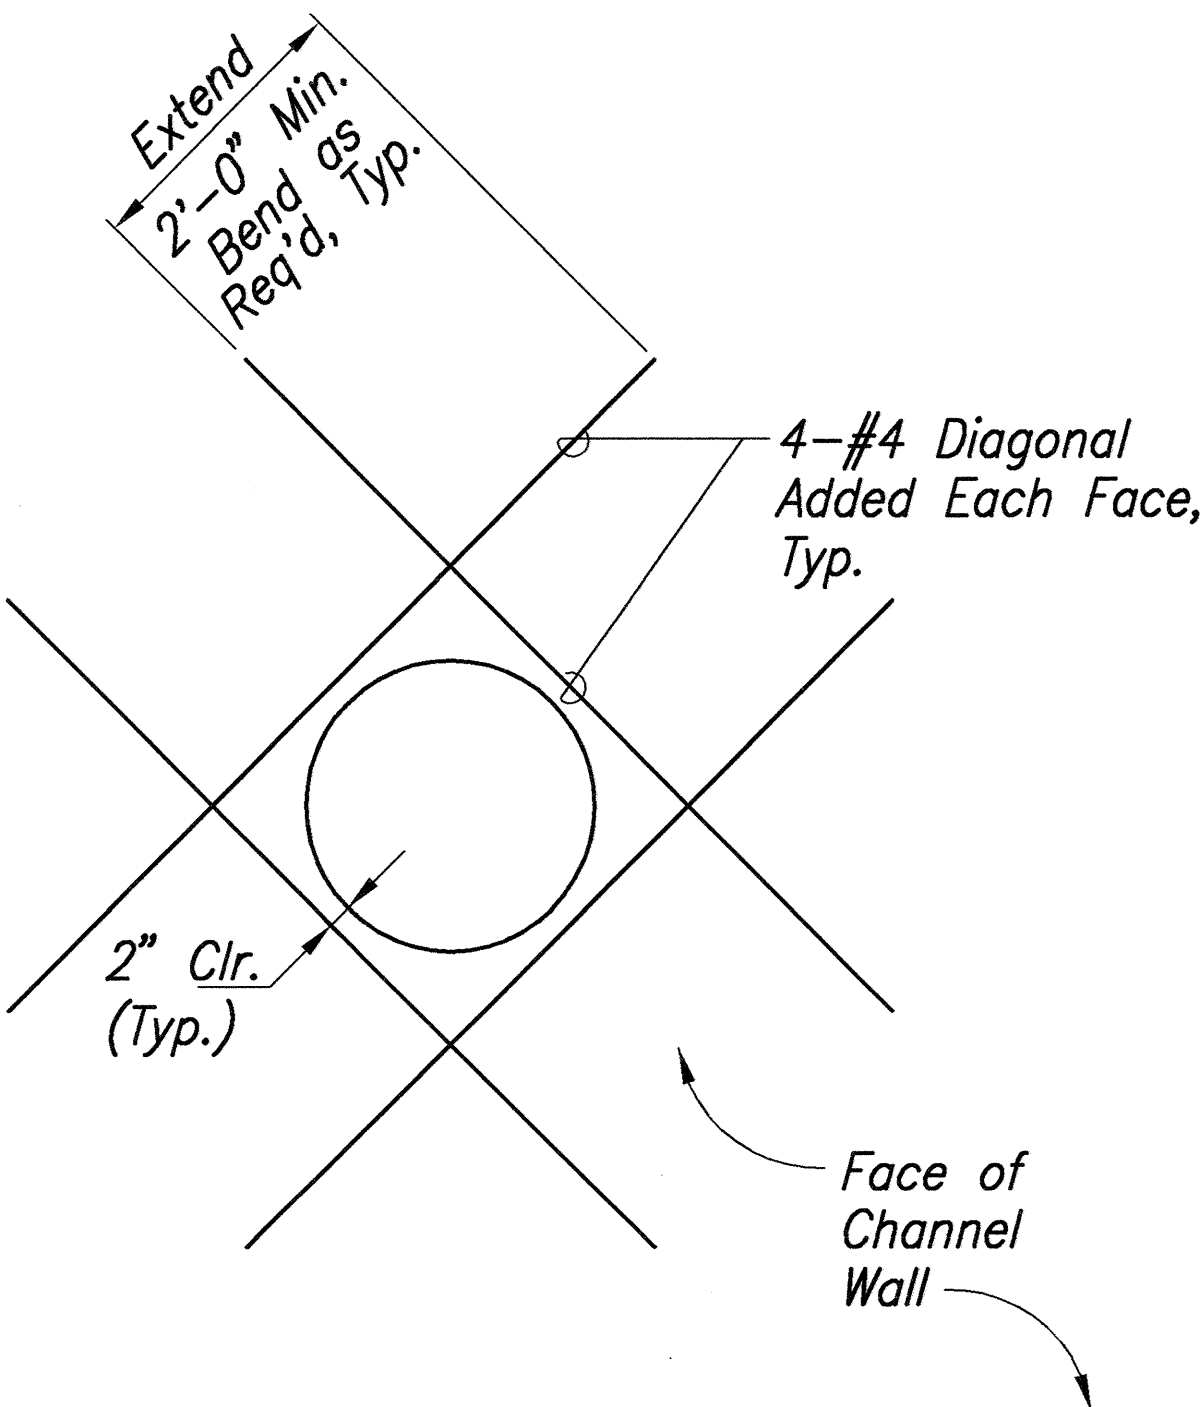

24" DRAINLINE PENETRATION THROUGH CONCRETE CHANNEL WALL 4
Scale: None S-11 S-11

SURVEY PLOTTED BY	DATE
DRAWN BY	
TRACED BY	
NOTED BY	
QUANTITIES BY	
CHECKED BY	
No.	



Path: L:\Work\6465-01\STR File\name. Sit Plot date: Jan 17, 2003-09:57:30am CAD User: elang. Xref Filename: 7 Border 1

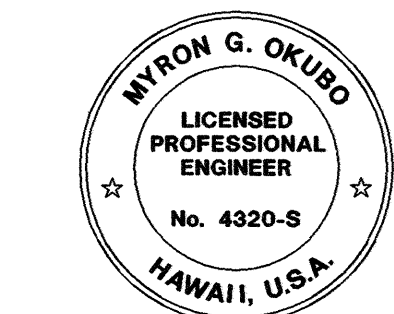

THIS WORK WAS PREPARED BY
ME OR UNDER MY SUPERVISION
Myron Okubo
Signature
April 30, 2004
Expiration Date of the License

DATE	REVISION
<p>STATE OF HAWAII DEPARTMENT OF TRANSPORTATION HIGHWAYS DIVISION</p> <p>MISCELLANEOUS SECTIONS AND DETAILS</p> <p>KAMEHAMEHA V HIGHWAY EMERGENCY REPLACEMENT OF KAWAIKAPU BRIDGE FEDERAL AID PROJECT NO. ER-12(4)</p> <p>Scale: As Noted Date: Nov. 25, 2002</p>	
SHEET NO. S-11 OF 16 SHEETS	

FED. ROAD DIST. NO.	STATE	FED. AID PROJ. NO.	FISCAL YEAR	SHEET NO.	TOTAL SHEETS
HAWAII	HAW.	ER-12(4)	2003	62	76

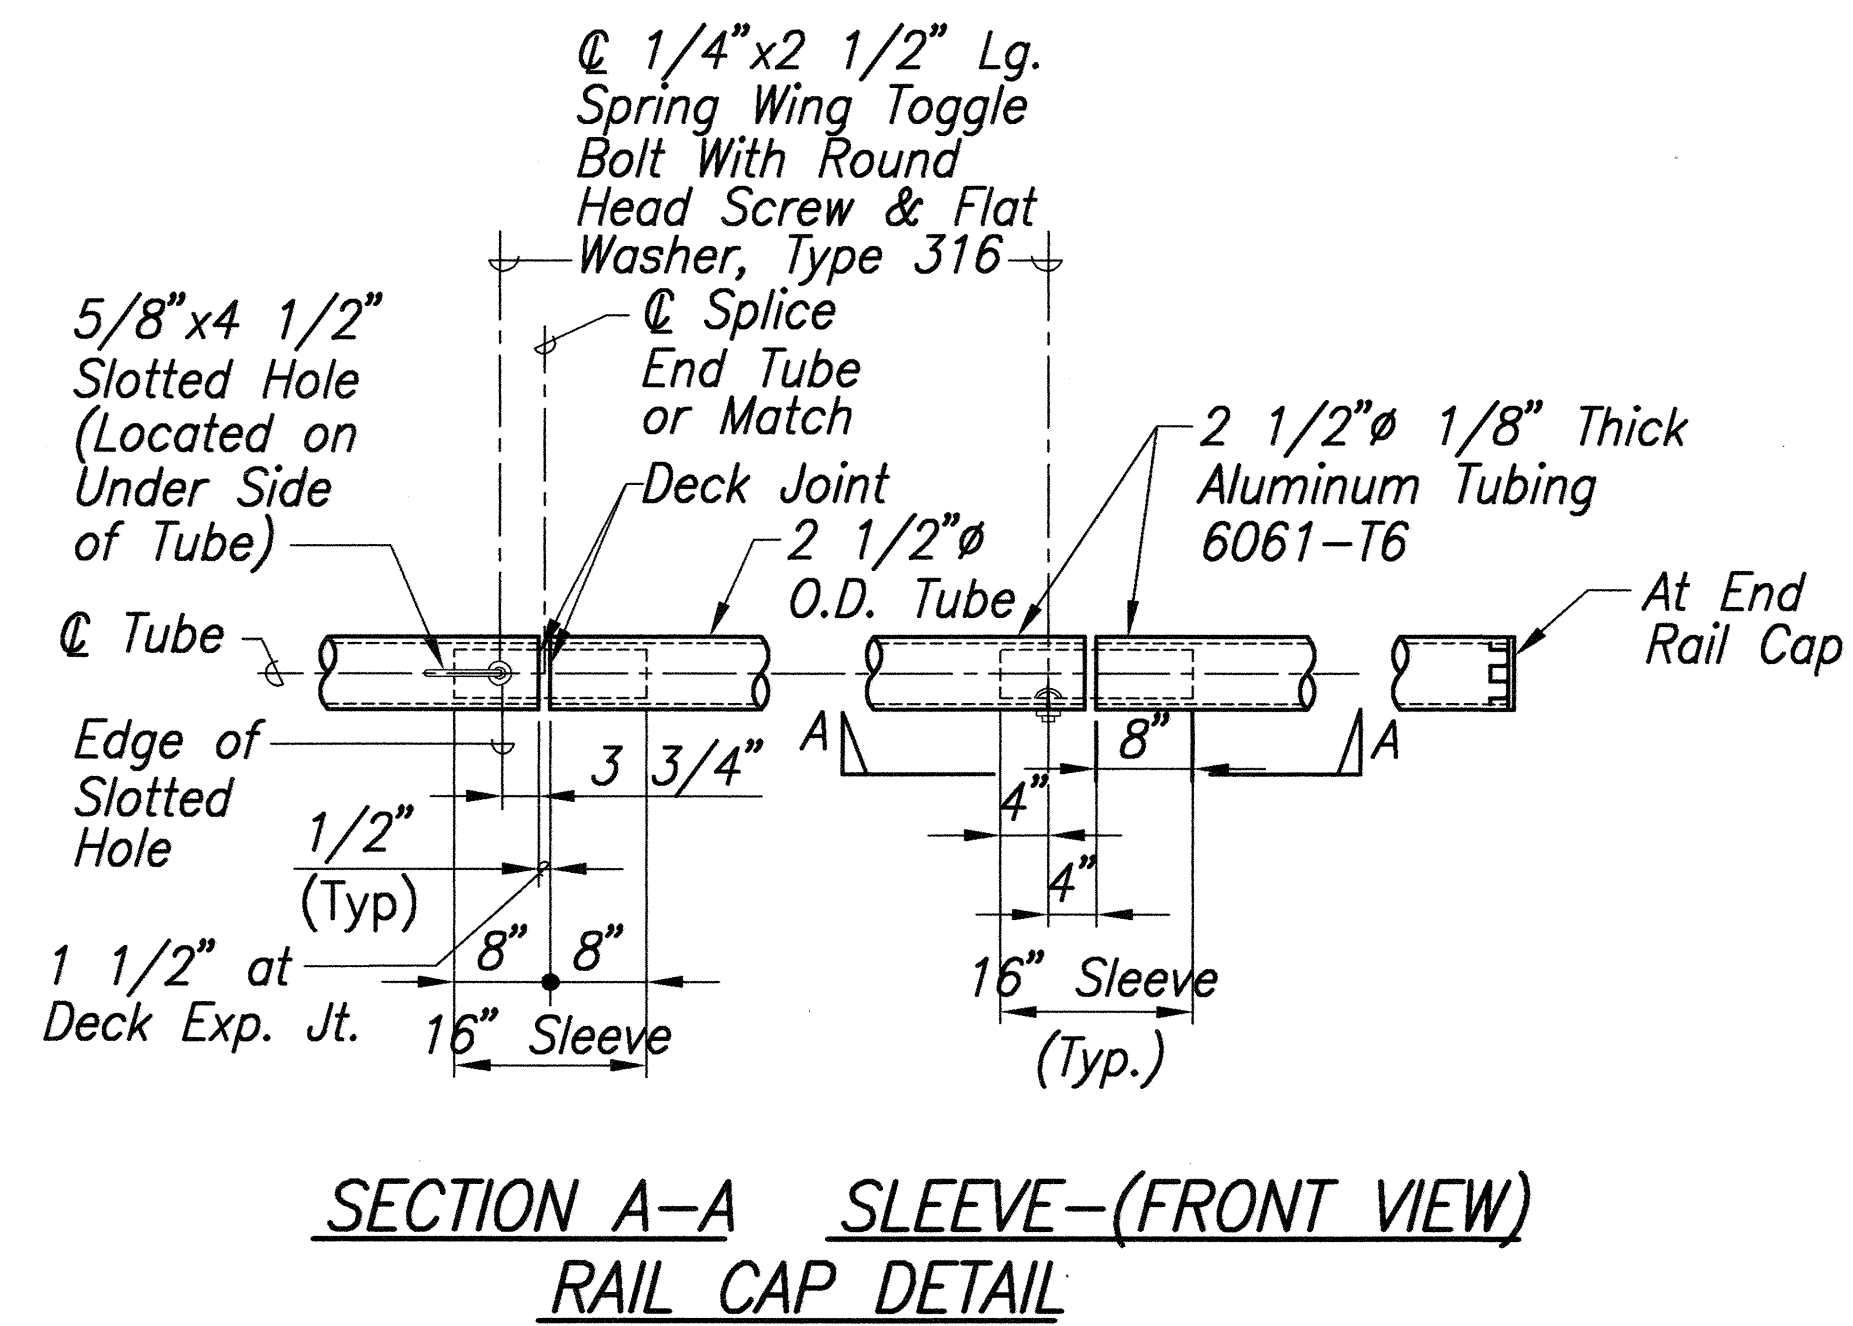
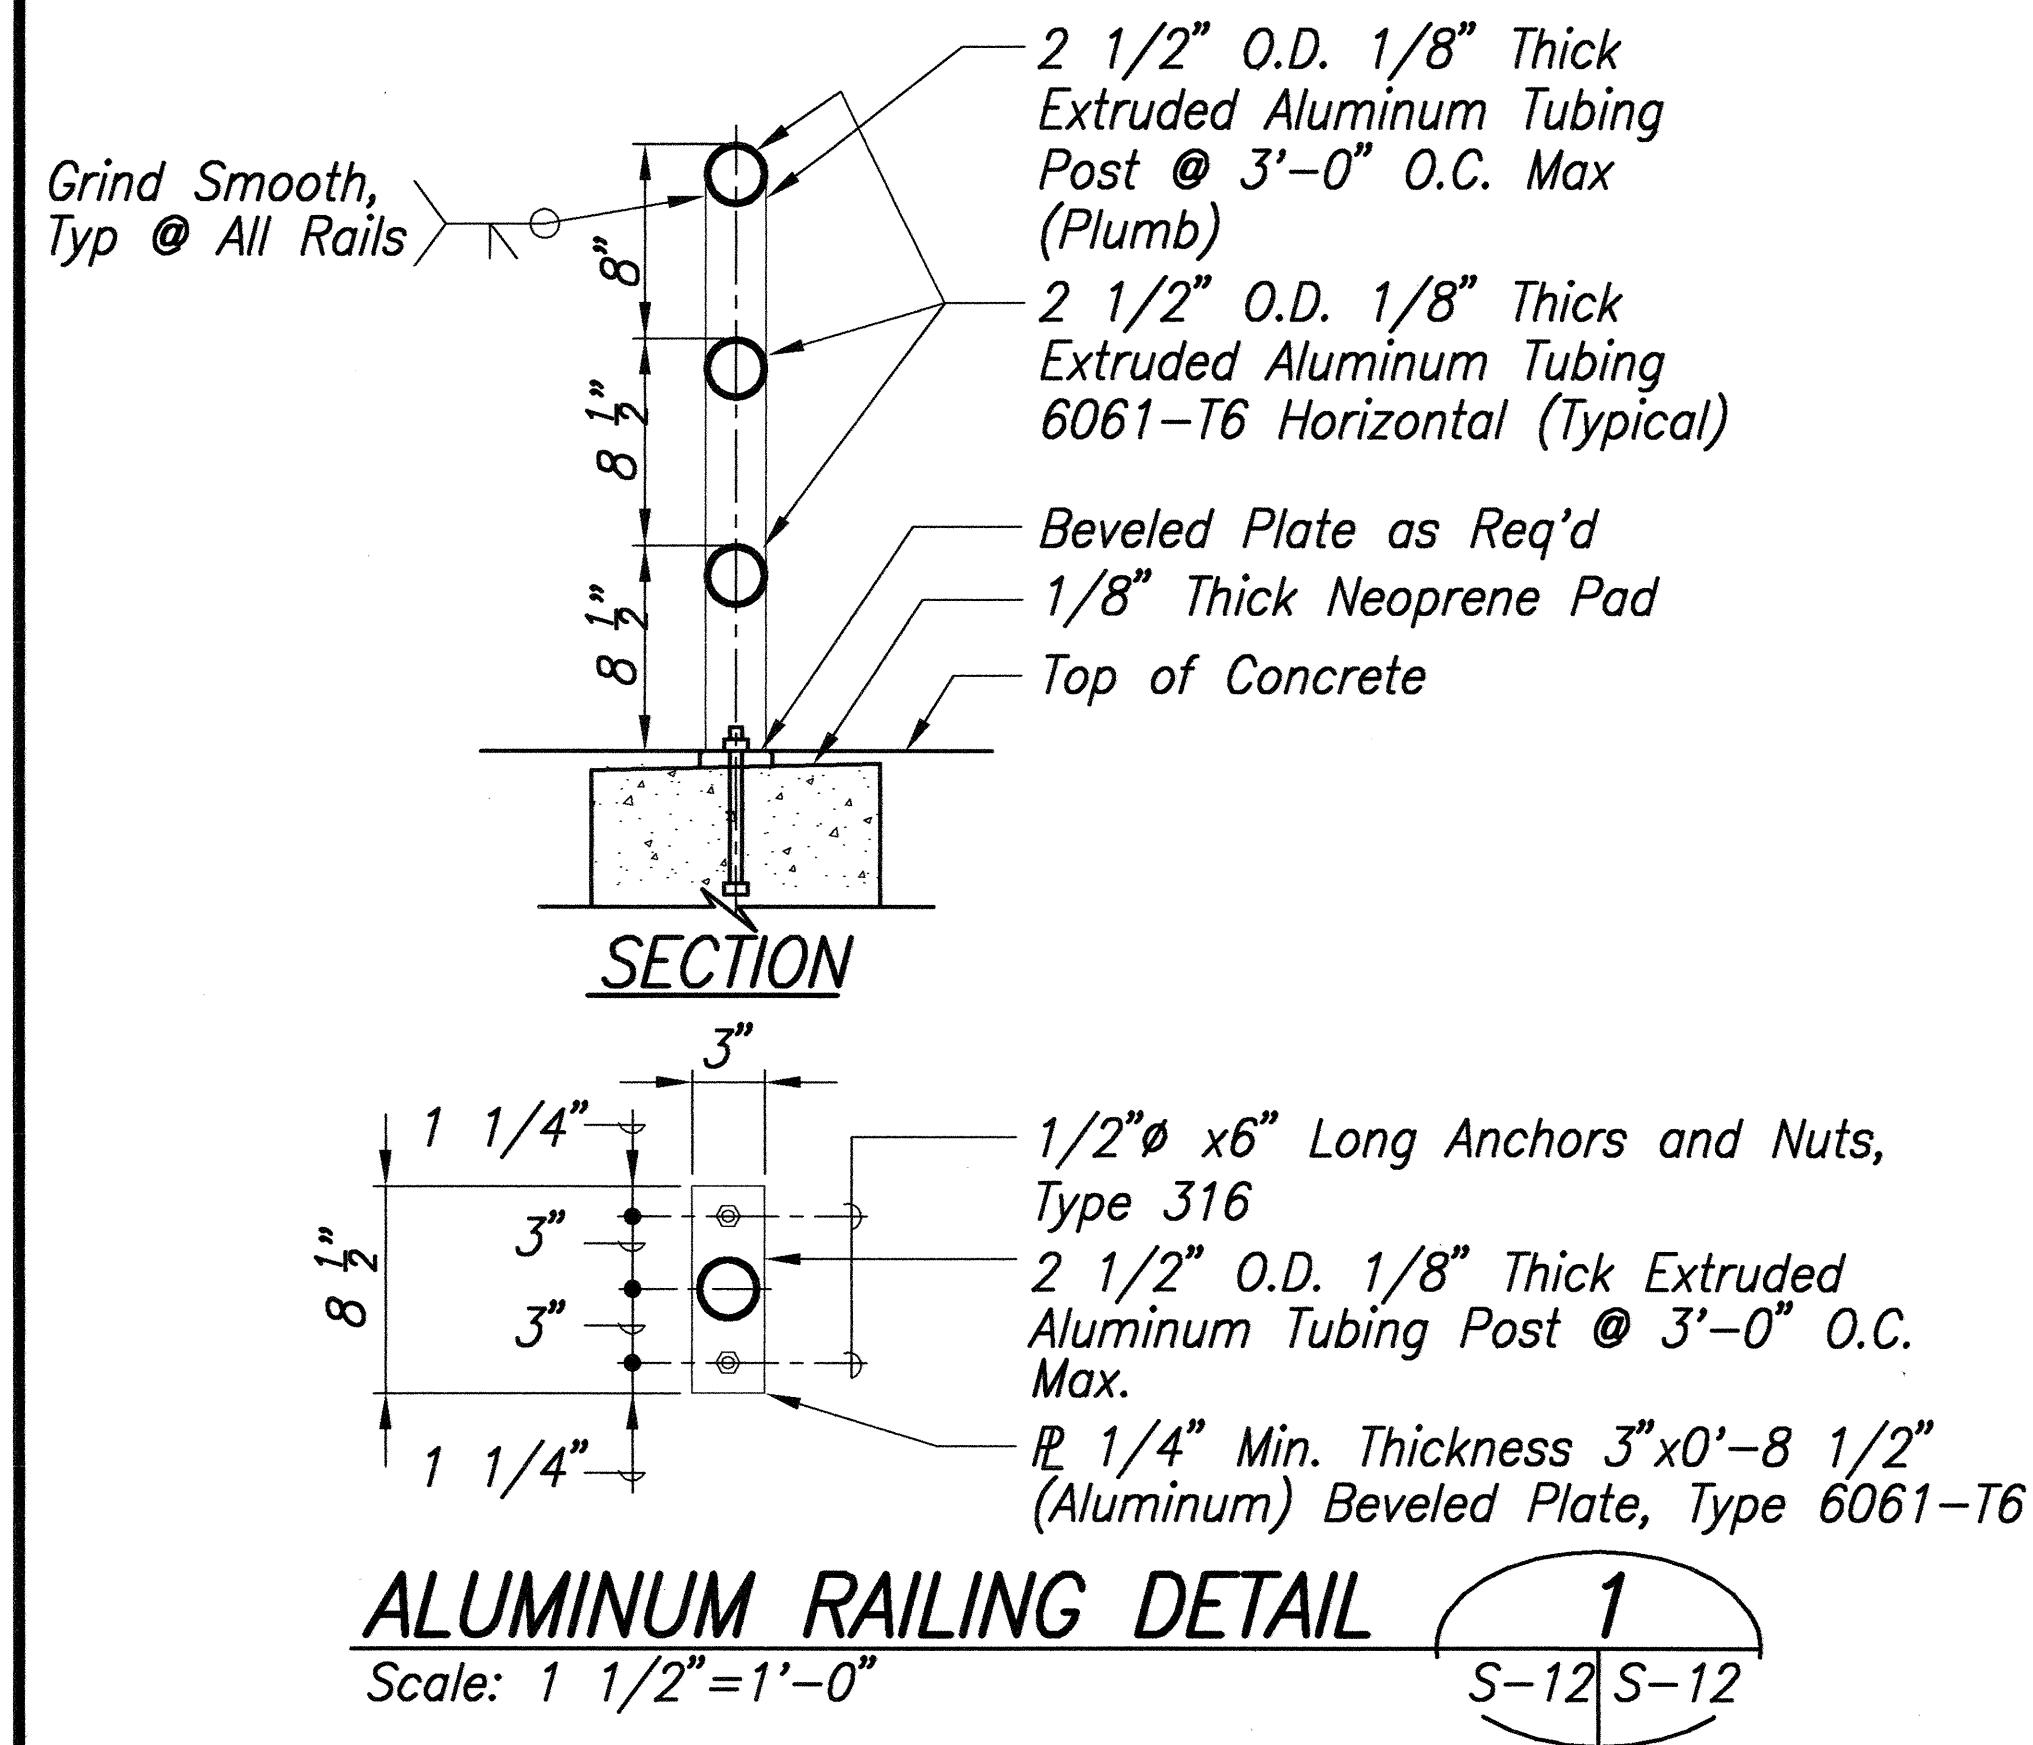


TUBE SPLICE DETAIL

Scale: None

Notes

1. Slotted Hole & Toggle Bolts Shall Be Located On Underside of Tube.
2. Aluminum Railing To Be Considered Incidental to Bridge Railing.
3. Bolts, Nuts, & Washers for Aluminum Railing to be Type 316 Stainless Steel.

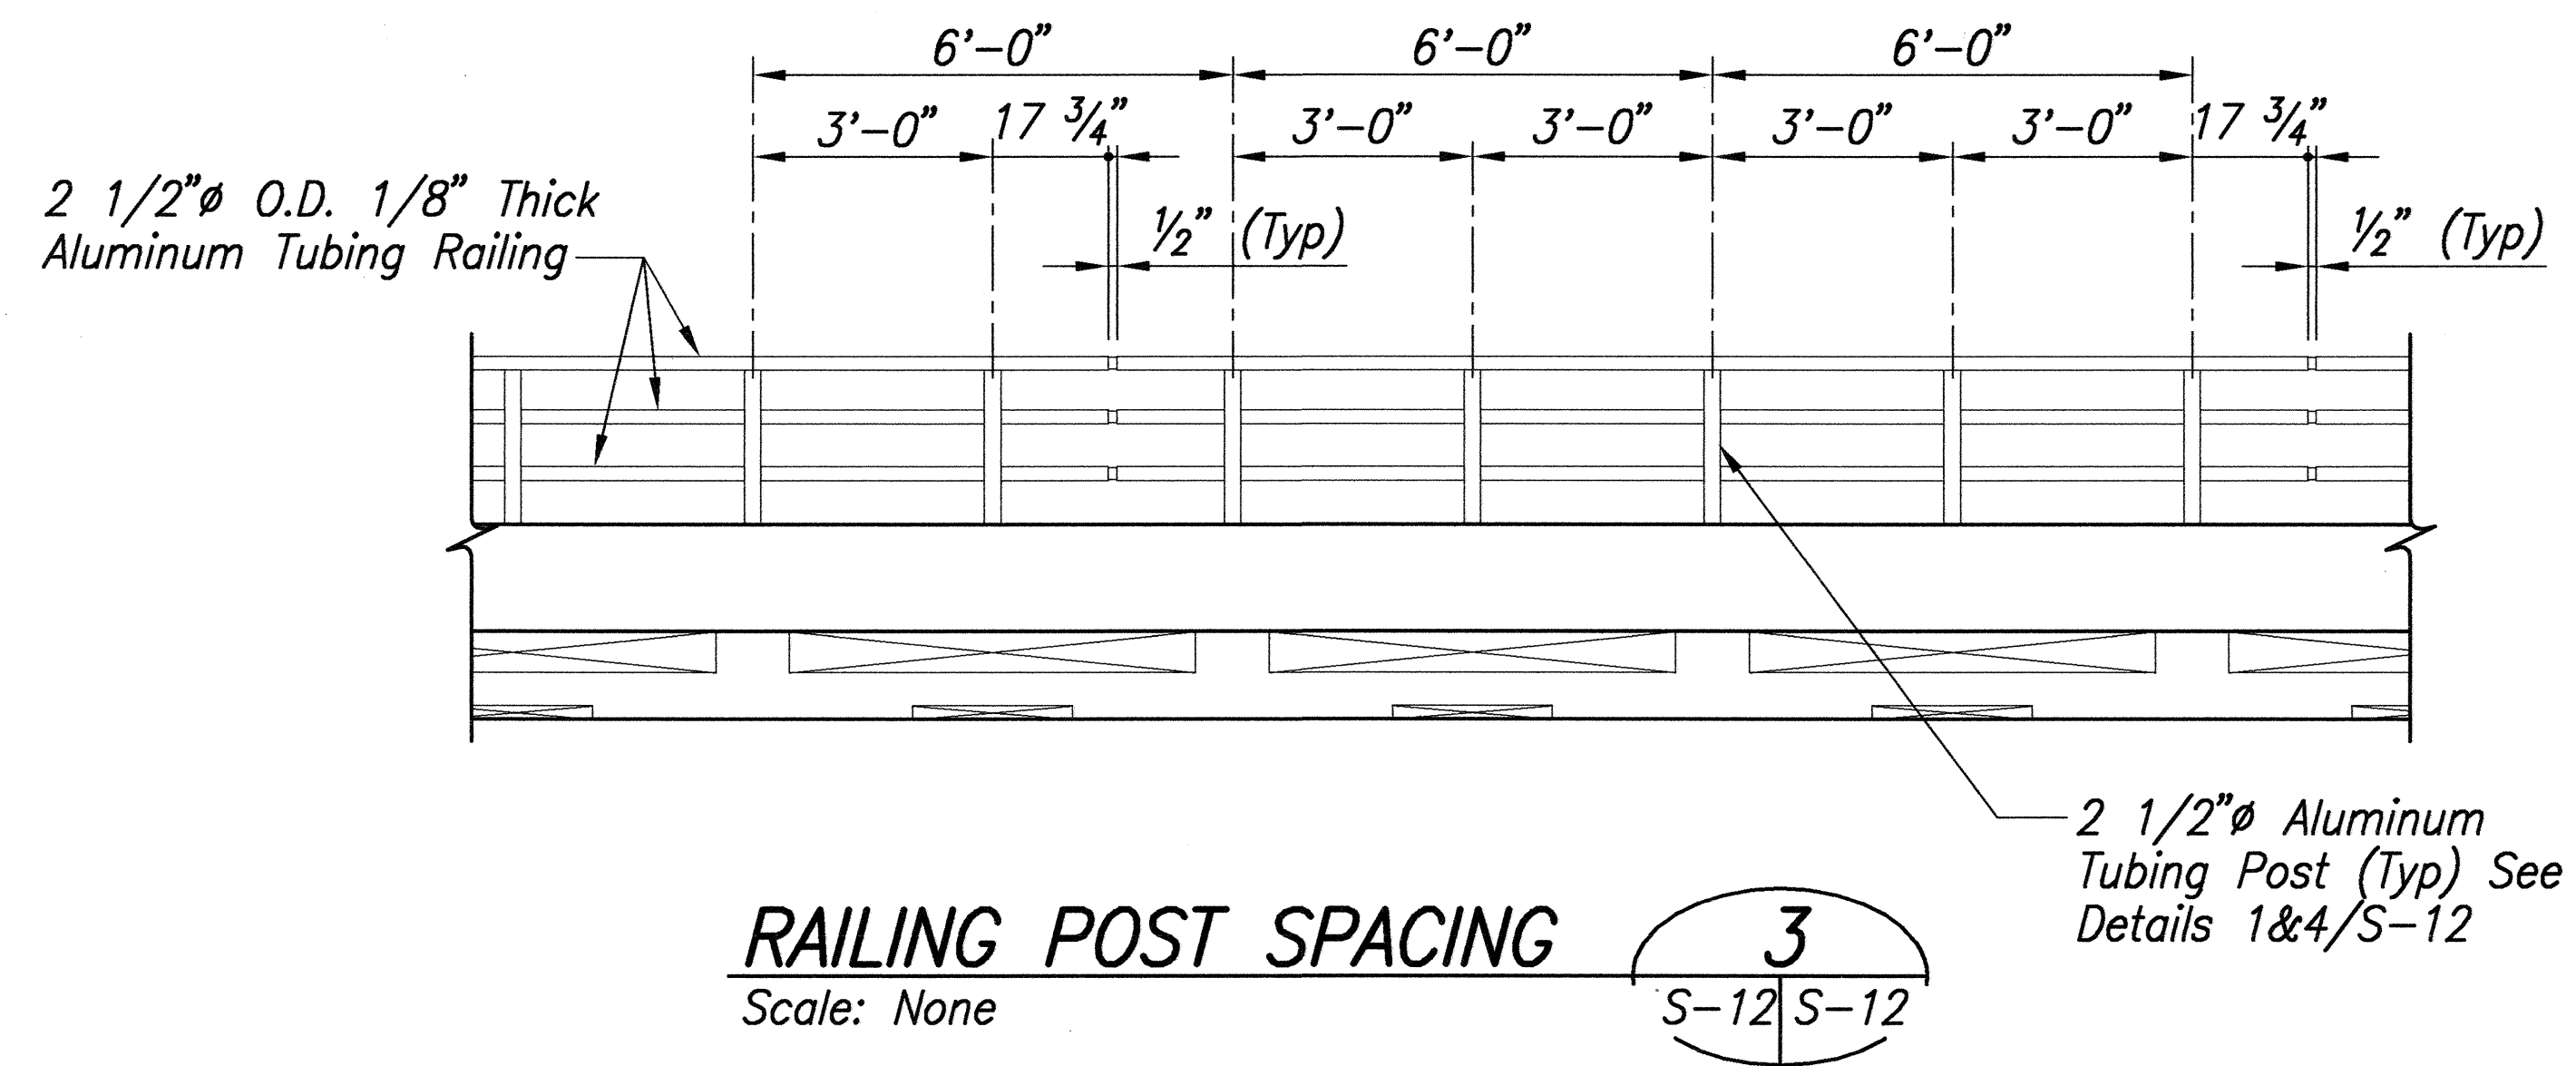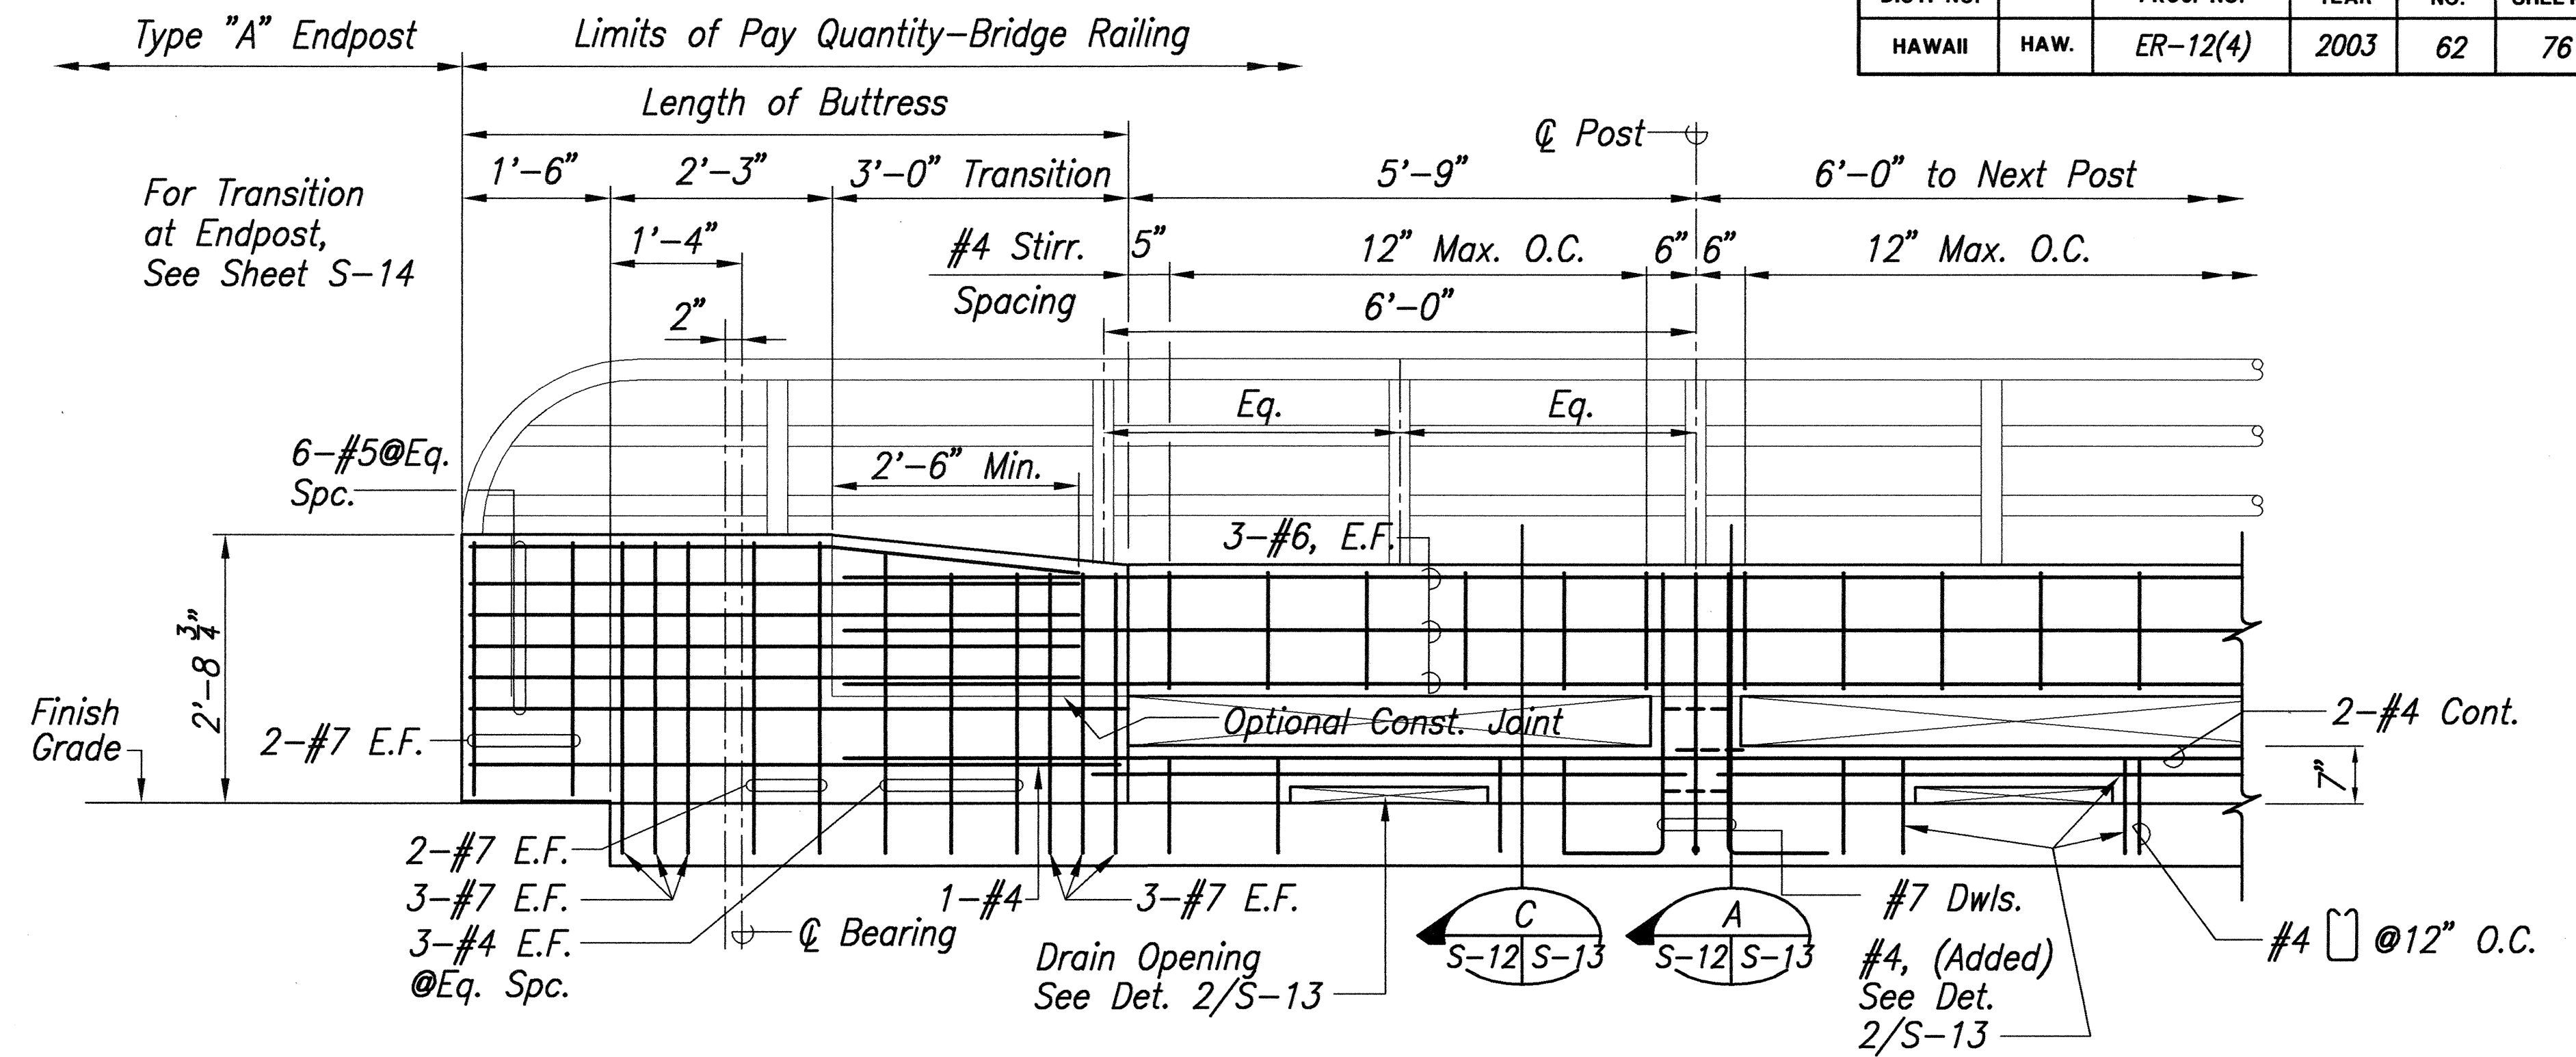

THIS WORK WAS PREPARED BY ME OR UNDER MY SUPERVISION




Signature

April 30, 2004



Expiration Date of the License

DATE	REVISION
STATE OF HAWAII DEPARTMENT OF TRANSPORTATION HIGHWAYS DIVISION	
RAILING DETAILS	
KAMEHAMEHA V HIGHWAY EMERGENCY REPLACEMENT OF KAWAIKAPU BRIDGE FEDERAL AID PROJECT NO. ER-12(4)	
Scale: As Noted	Date: Nov. 25, 2002
SHEET No. S-12 OF 16 SHEETS	

FED. ROAD DIST. NO.	STATE	FED. AID PROJ. NO.	FISCAL YEAR	SHEET NO.	TOTAL SHEETS
HAWAII	HAW.	ER-12(4)	2003	63	76

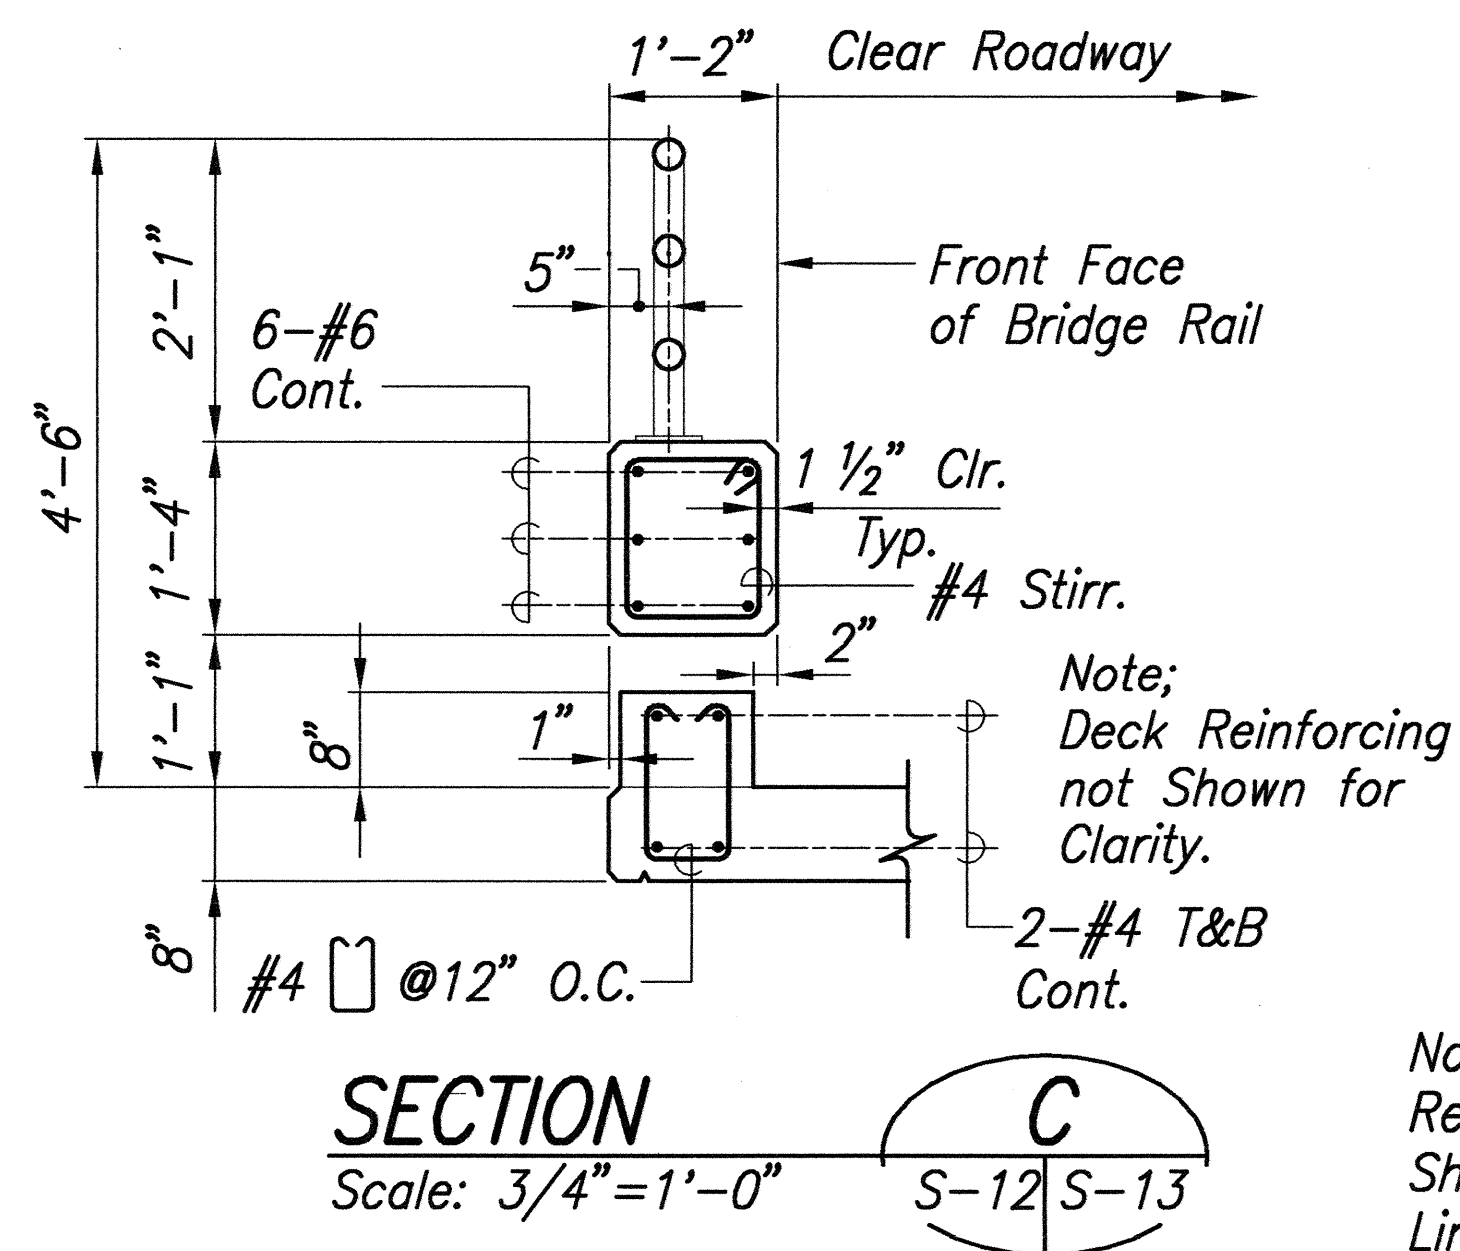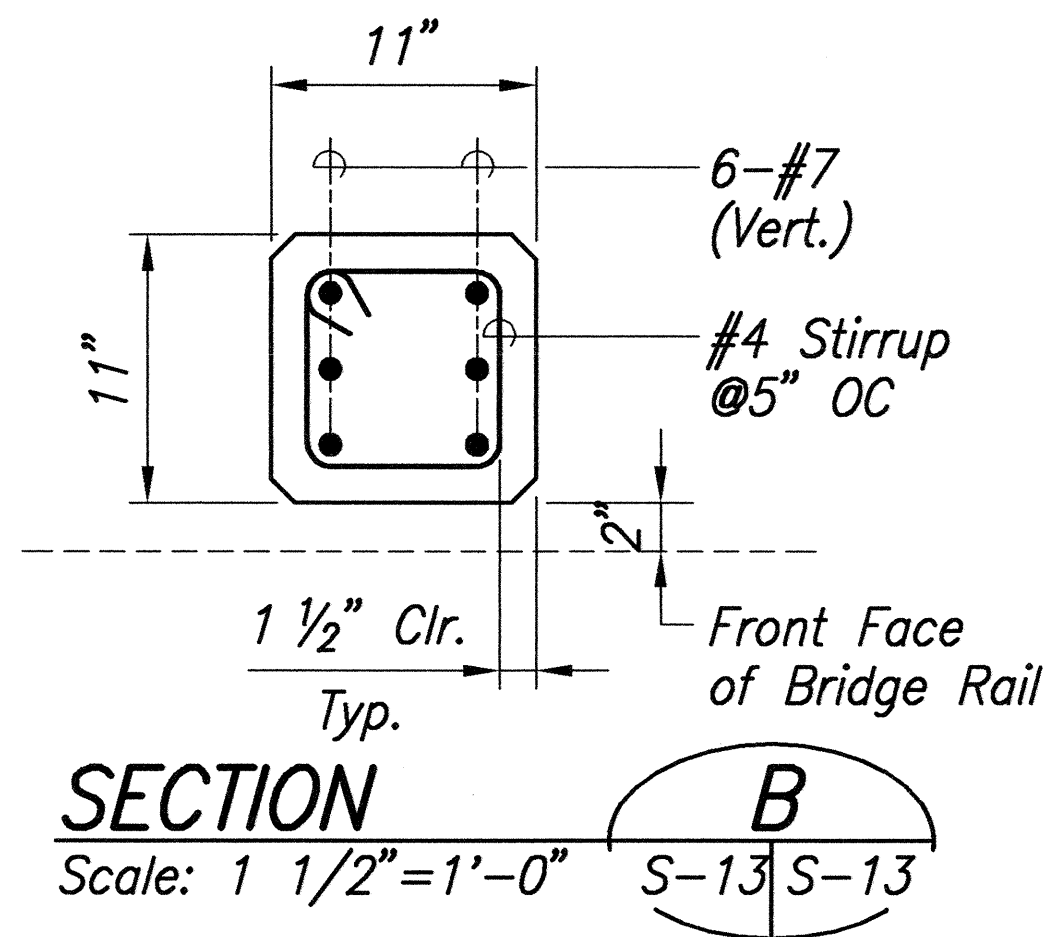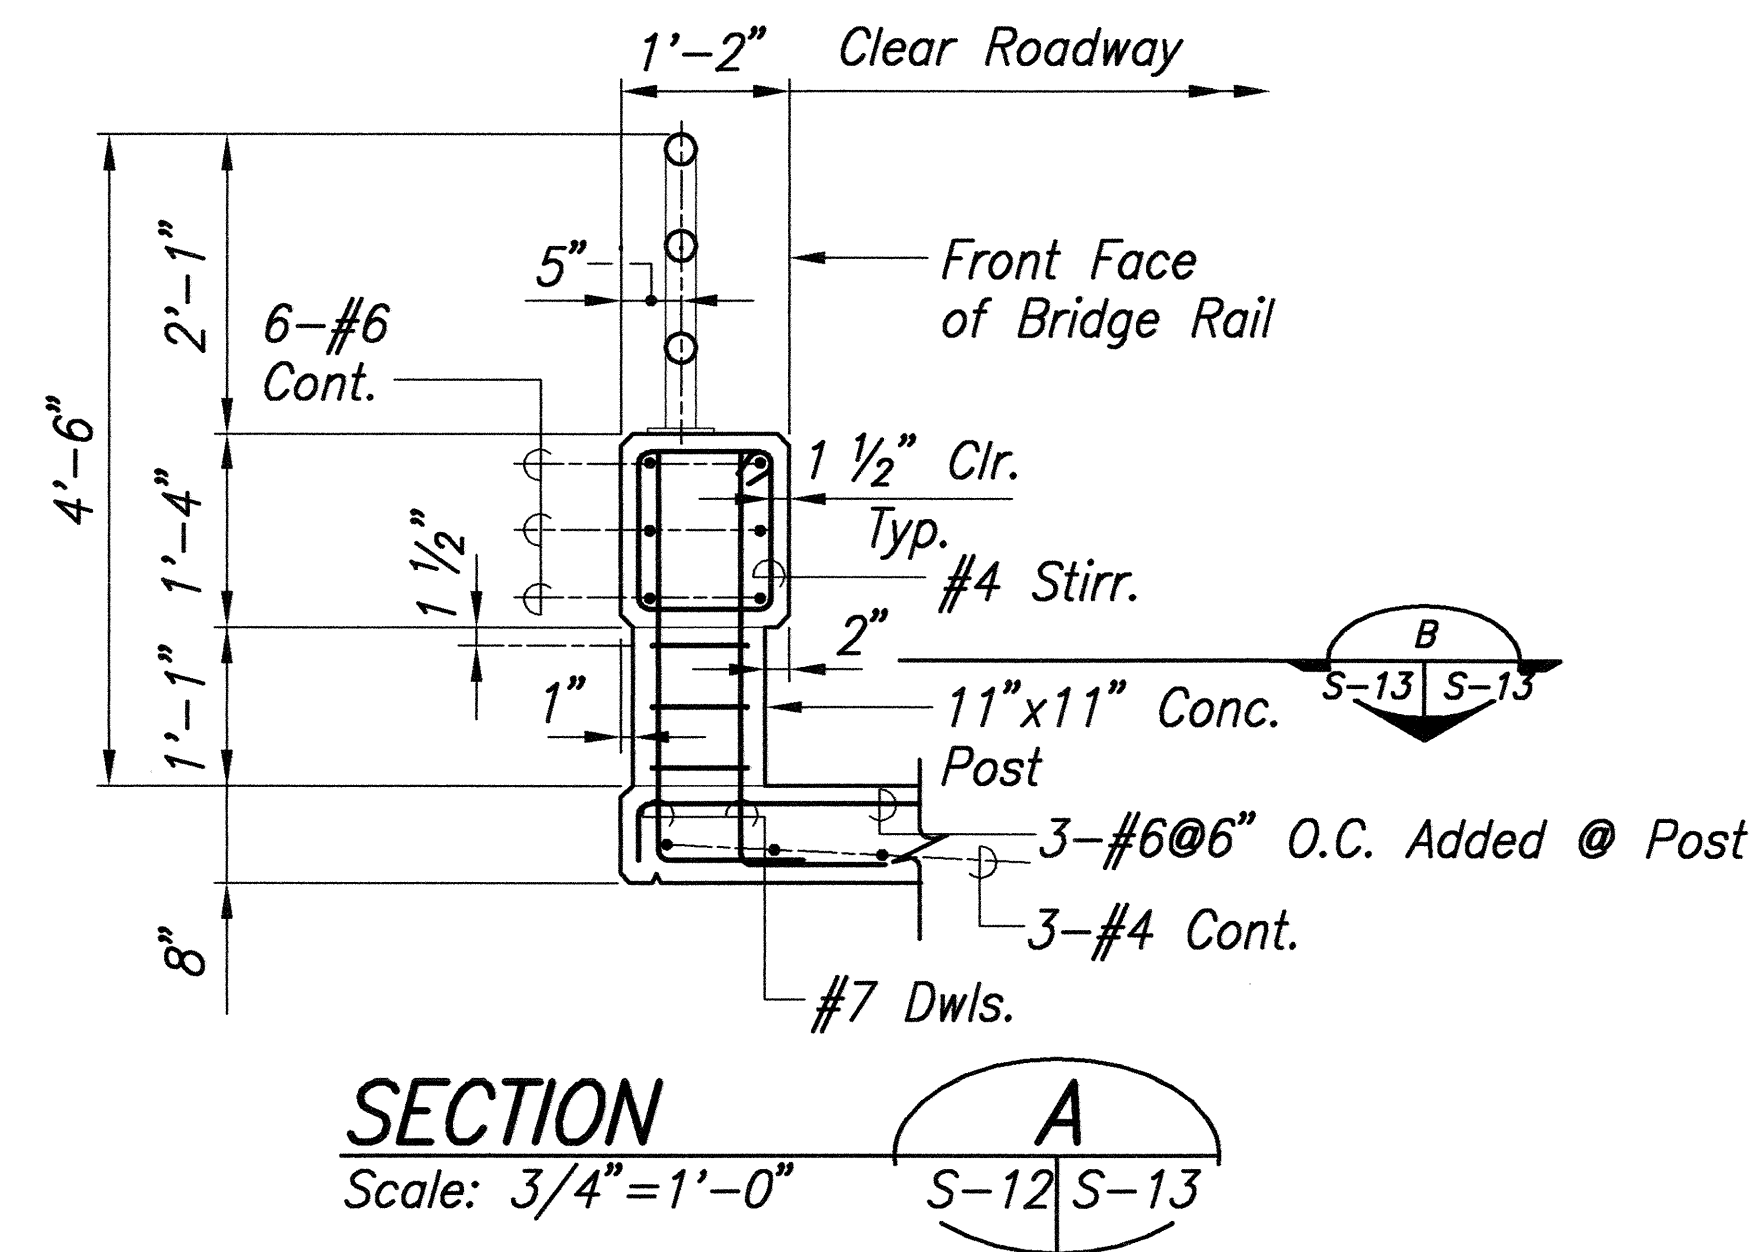

Note:
Reinforcing Steel in Bridge Rail
Shall be Included in Price Per
Lineal Foot of Bridge Railing.

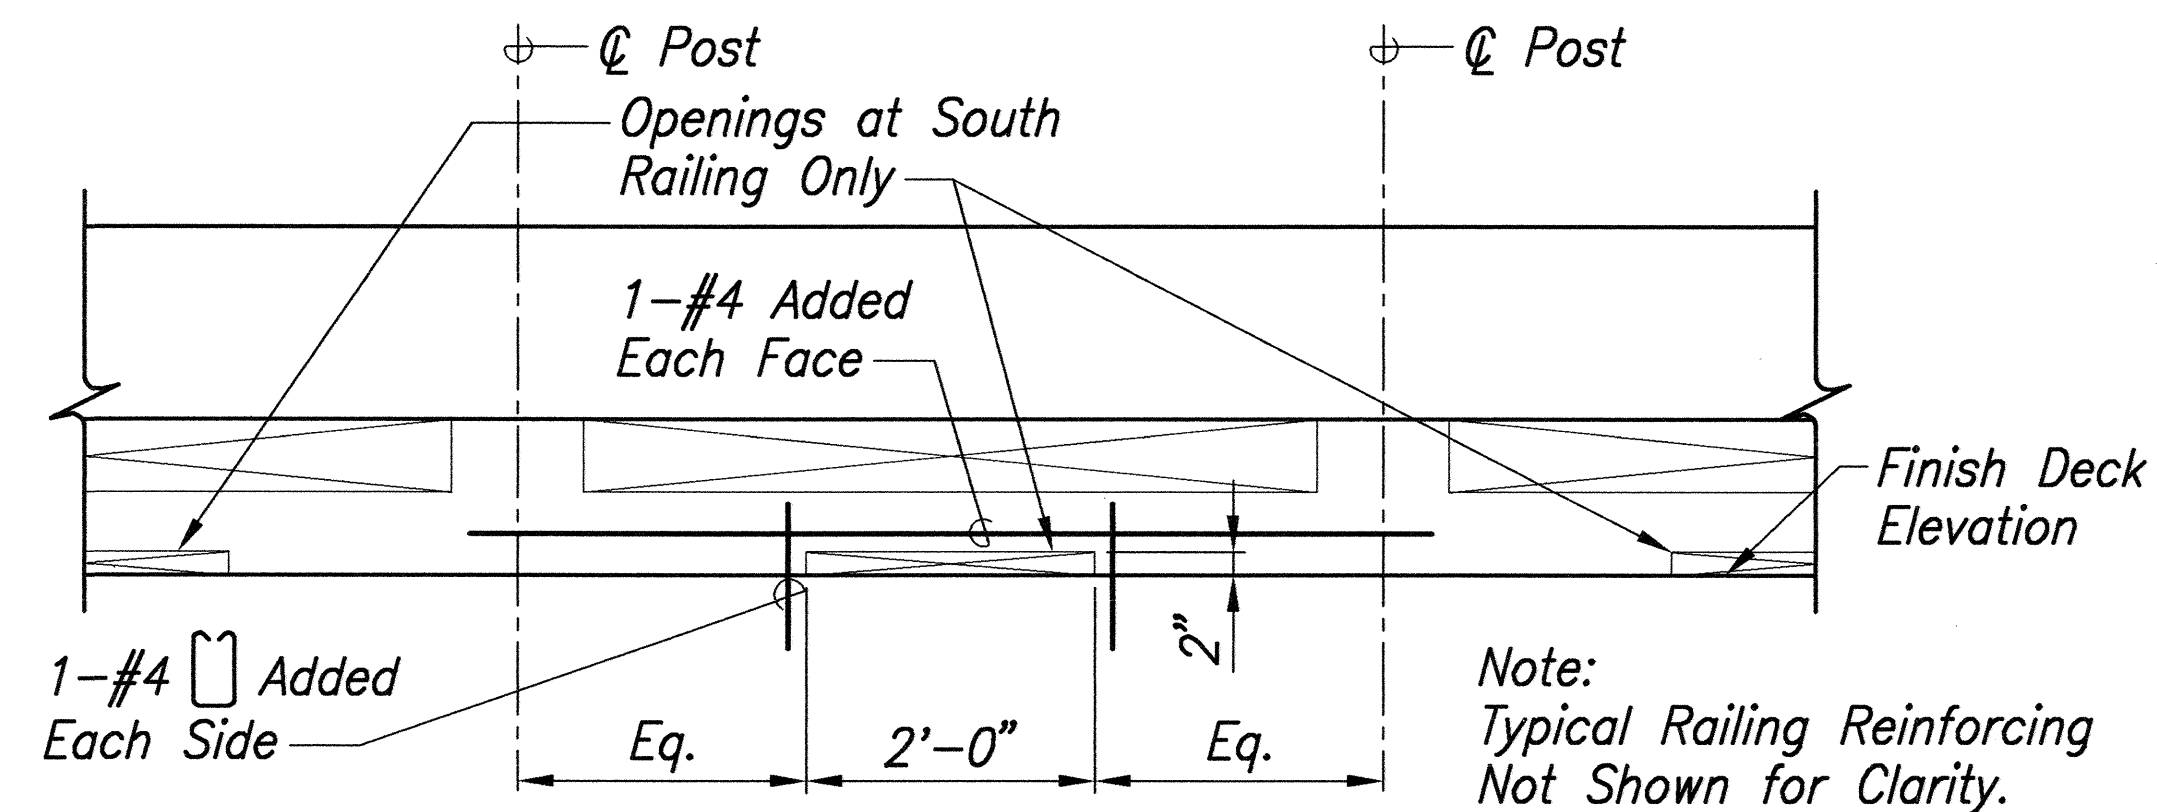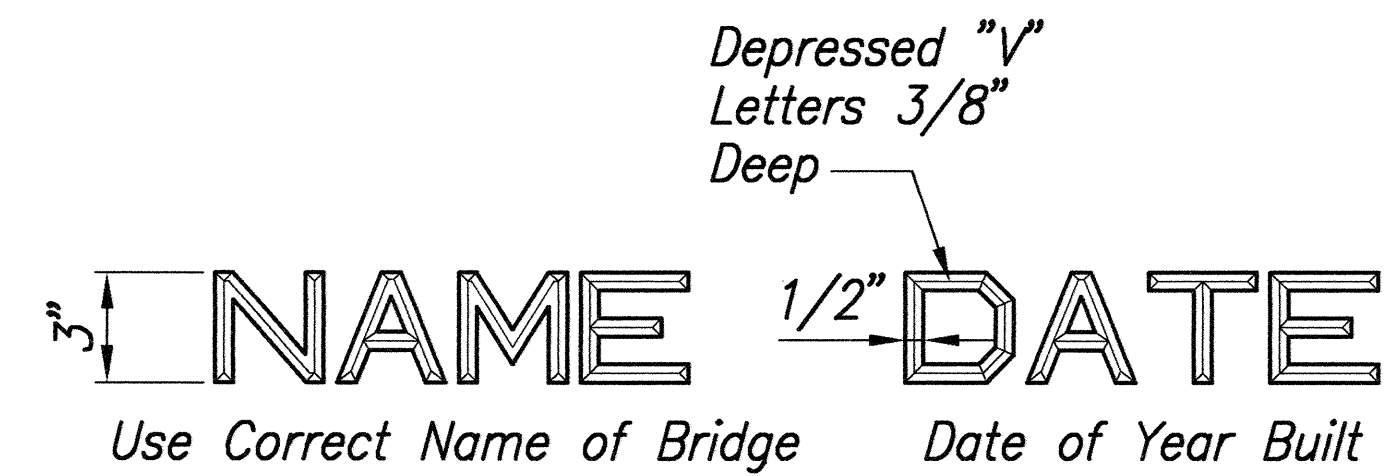

SURVEY PLOTTED BY	DATE
DRAWN BY	
DESIGNED BY	
QUANTITIES BY	
CHECKED BY	
No.	


Path: L:\Work\6465-0\NSTR File: S13 Plot date: Jan 17, 2003 09:58:55am CAD User: eleong. Xref Filename: 1 Border 2



THIS WORK WAS PREPARED BY
ME OR UNDER MY SUPERVISION
Myron Okubo
Signature
April 30, 2004
Expiration Date of the License

DATE	REVISION
<p>STATE OF HAWAII DEPARTMENT OF TRANSPORTATION HIGHWAYS DIVISION</p> <p>RAILING SECTIONS, DETAILS AND MISC. DETAILS</p> <p>KAMEHAMEHA V HIGHWAY EMERGENCY REPLACEMENT OF KAWAIKAPU BRIDGE FEDERAL AID PROJECT NO. ER-12(4)</p> <p>Scale: As Noted Date: Nov. 25, 2002</p>	
SHEET No. S-13 OF 16 SHEETS	

Path: L:\Wod\6465-01\STR Filename: S14 Plot date: Jan 17, 2003-09:59:51am CAD User: eleong. Xref Filename: | Border

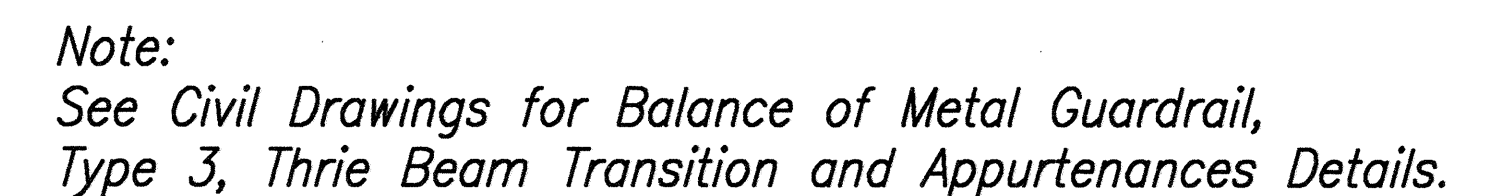

Technical drawing of a Type "A" End Post Upgrade, showing both Plan and Elevation views.

Plan View Details:

- Exist. bridge railing** on the left.
- 14'-4" Transition** zone.
- 25'-0" Guardrail Type 3 Thrie Beam Transition pay limits** zone.
- Balance** area on the right, with a note "See Hwy. Plan".
- Top of new conc. end post upgrade** indicated.
- Ref. guardrail connection line and ϕ 2-7/8" dia. thru holes for 2-5/8" dia. x 1'-4" lg. anchor bolts w/cap PL, nut and washer.**
- ϕ Thrie bm.** (centerline of thrie beam)
- ϕ "W" bm.** (centerline of W-beam)
- Fin. grade** indicated.
- 4-spcs. @ 1'-6 3/4" = 6'-3"** and **4-spcs. @ 3'-1 1/2" = 12'-6"** dimensions for the post and spacer.
- 6'-3" Transition** zone at the end.
- 12'-6" Double (nested) rail element** dimension.
- Limits of W6x15 Post & Spacer** indicated.
- 18'-0"** total length dimension.

Elevation View Details:

- 5-1" dia. thru holes for 5-7/8" dia. x 1'-4 3/4" lg. anchor bolts w/cap PL, nut & washer.**
- Connector** and **8"** dimension.
- 12 3/4"** and **7 1/4"** dimensions.
- 2'-8 3/4"** and **7 5/8"** dimensions.
- 12"** and **1"** dimensions.
- 12"**, **7"**, **16"**, and **8"** dimensions.
- Taper** dimension.
- 4'-10"**, **1'-6"**, **1'-4"**, **2'-0"**, **Cover**, **Key**, and **Ftg.** dimensions.
- 2'-8 3/4"** dimension.
- 1'-10"** dimension.
- 1'-9"** dimension.

Scale: 1/2" = 1'-0"


Professional Engineer Seal: MYRON G. OKURO, LICENSED PROFESSIONAL ENGINEER, No. 4320-S, HAWAII, U.S.A.

Revision Table:

DATE	REVISION
	STATE OF HAWAII DEPARTMENT OF TRANSPORTATION HIGHWAYS DIVISION TYPE "A" ENDPST UPGRADE DETAIL-PLAN AND ELEVATION


MYRON G. OKUBO
 LICENSED
 PROFESSIONAL
 ENGINEER
 No. 4320-S
 HAWAII, U.S.A.

THIS WORK WAS PREPARED BY
ME OR UNDER MY SUPERVISION





Signature
April 30, 2004
Expiration Date of the License

64

FED. ROAD DIST. NO.	STATE	FED. AID PROJ. NO.	FISCAL YEAR	SHEET NO.	TOTAL SHEETS
HAWAII	HAW.	ER-12(4)	2003	65	76

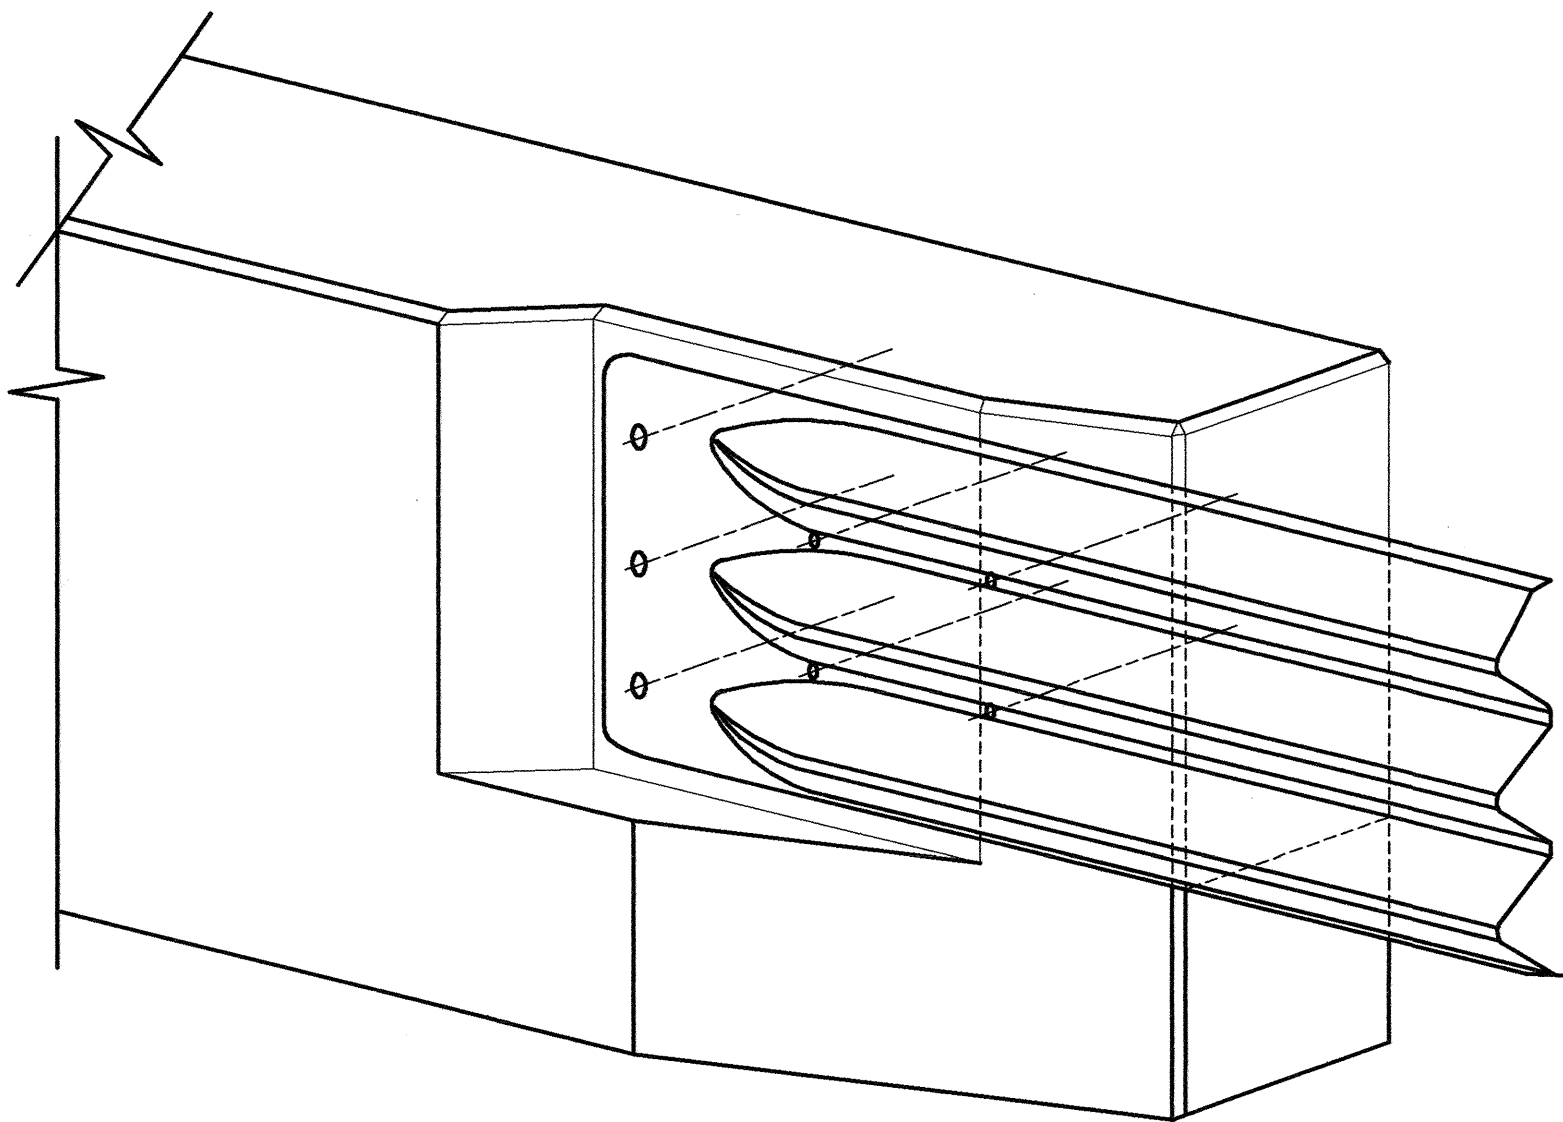


**PARTIAL ISOMETRIC VIEW –
TYPE "A" ENDPOST UPGRADE**
Not to Scale

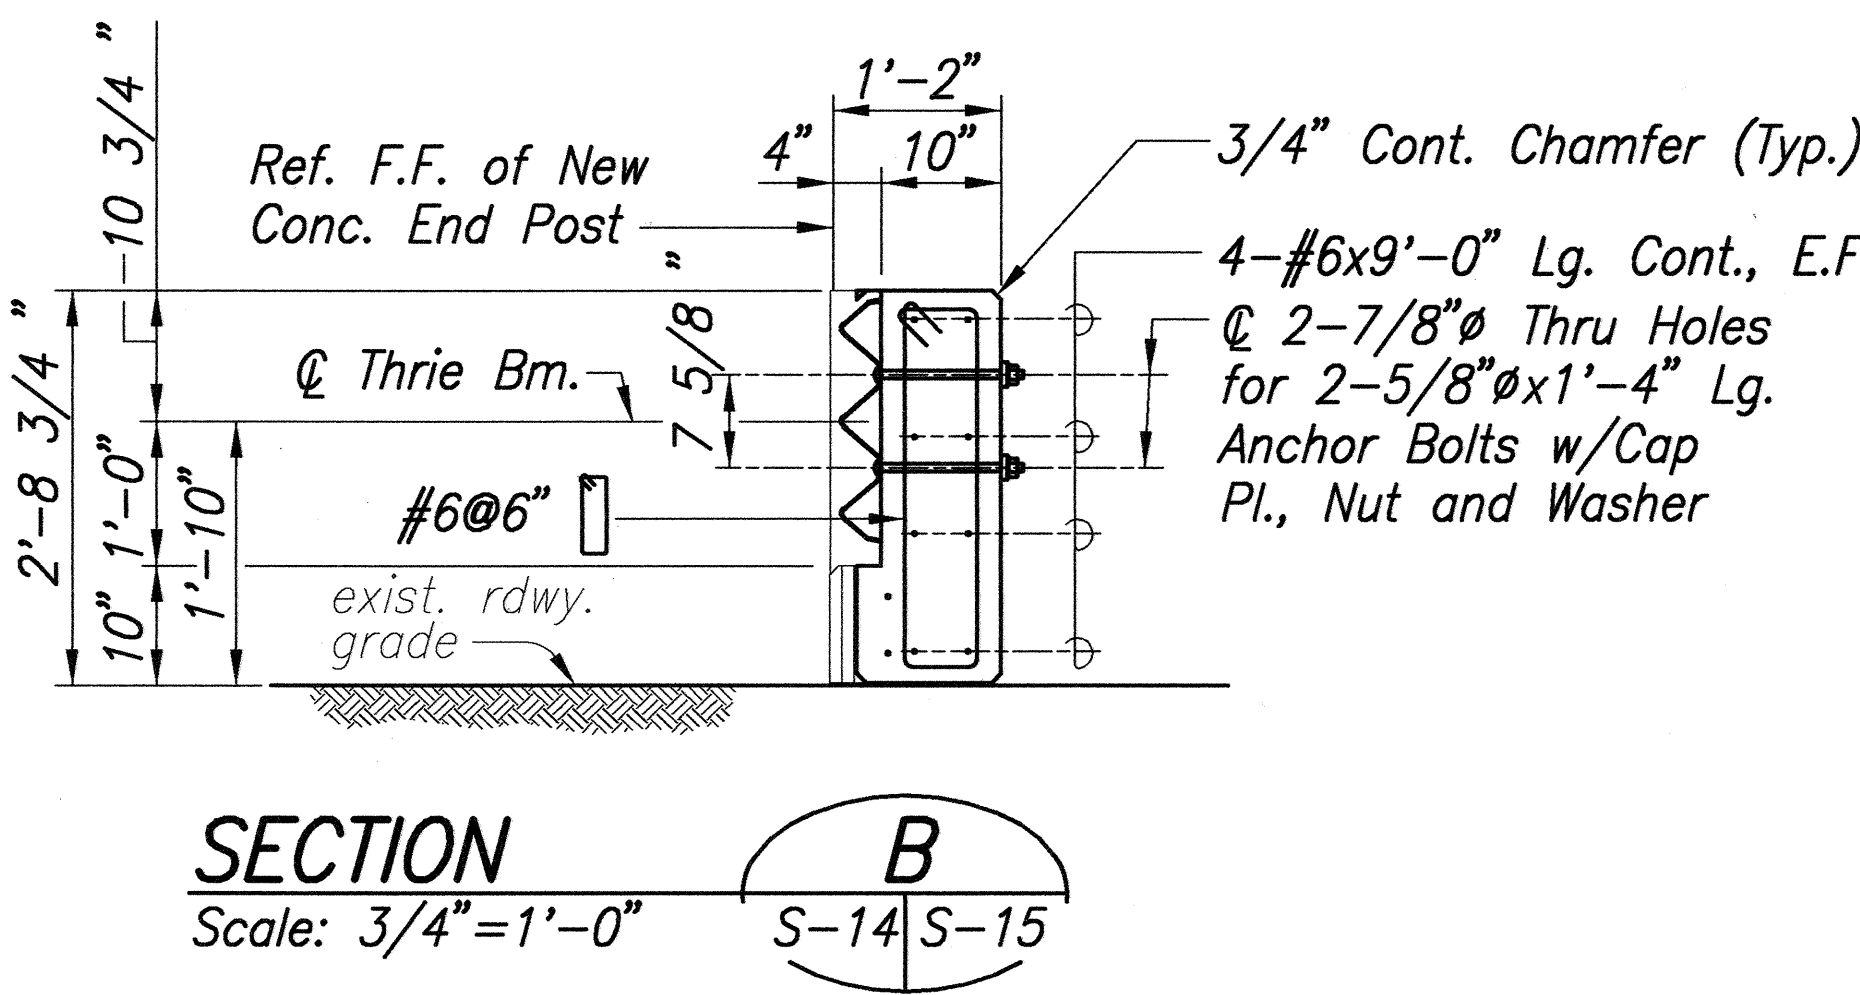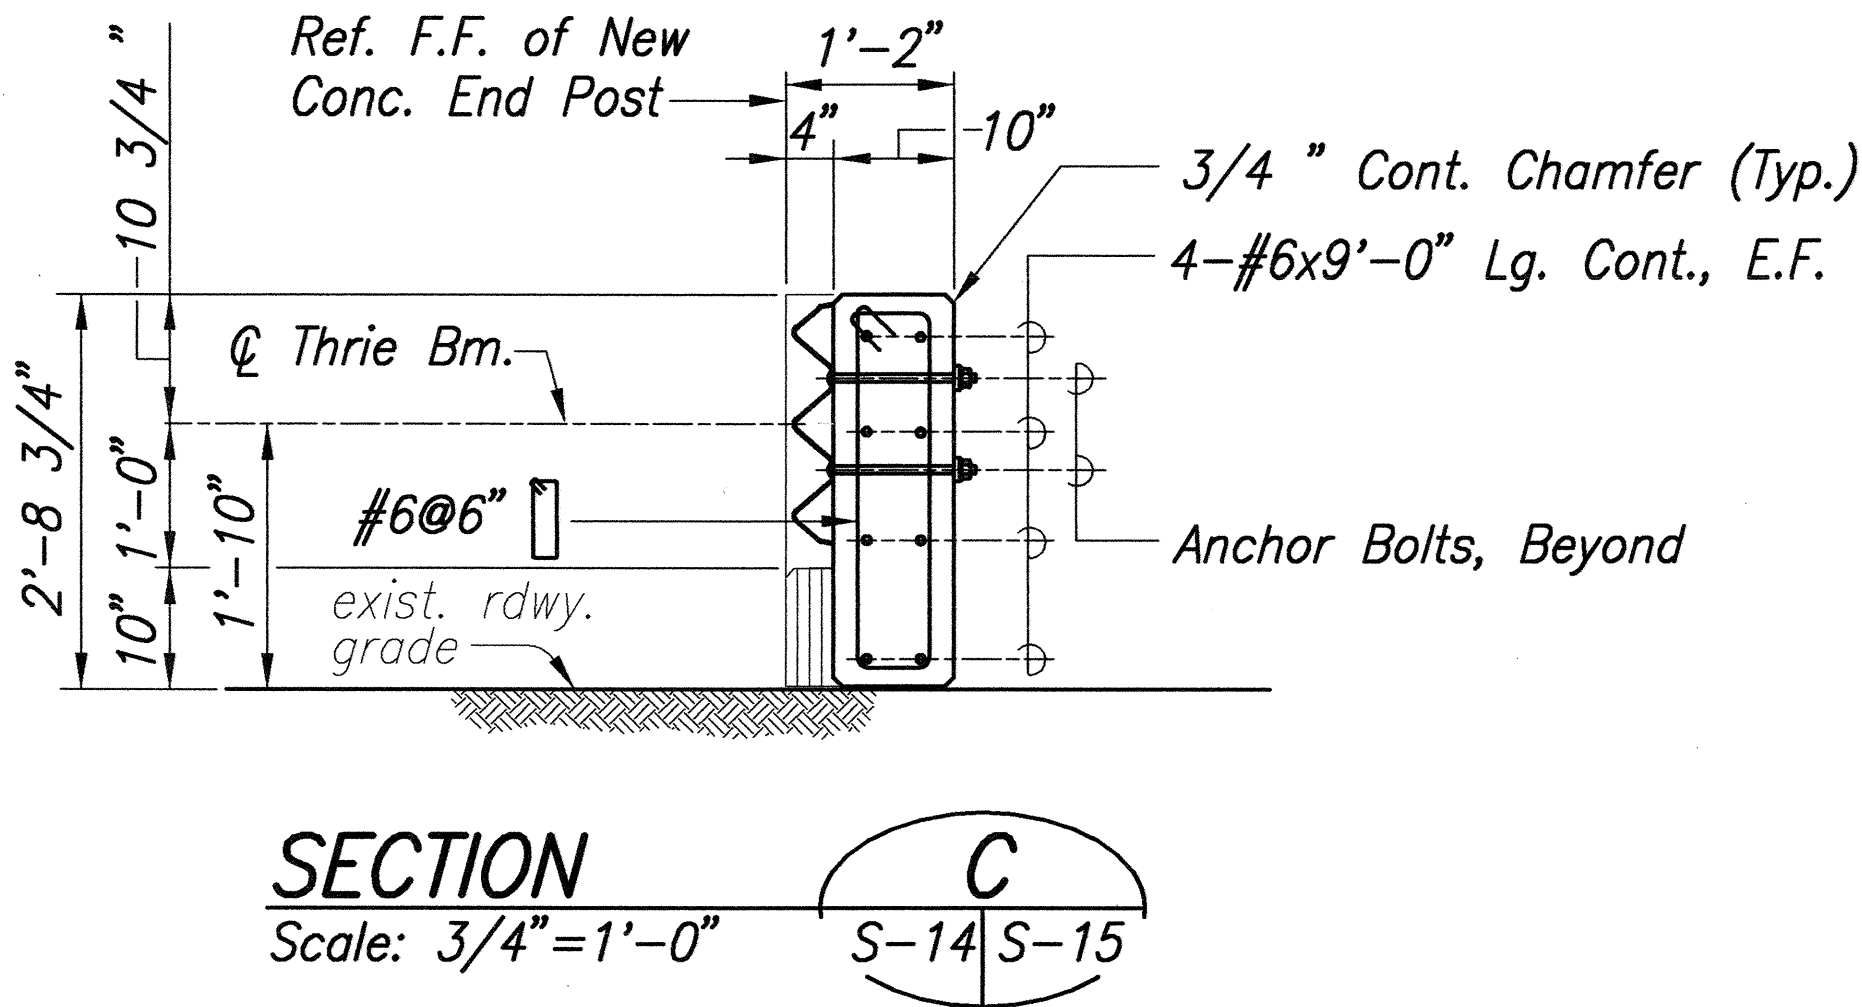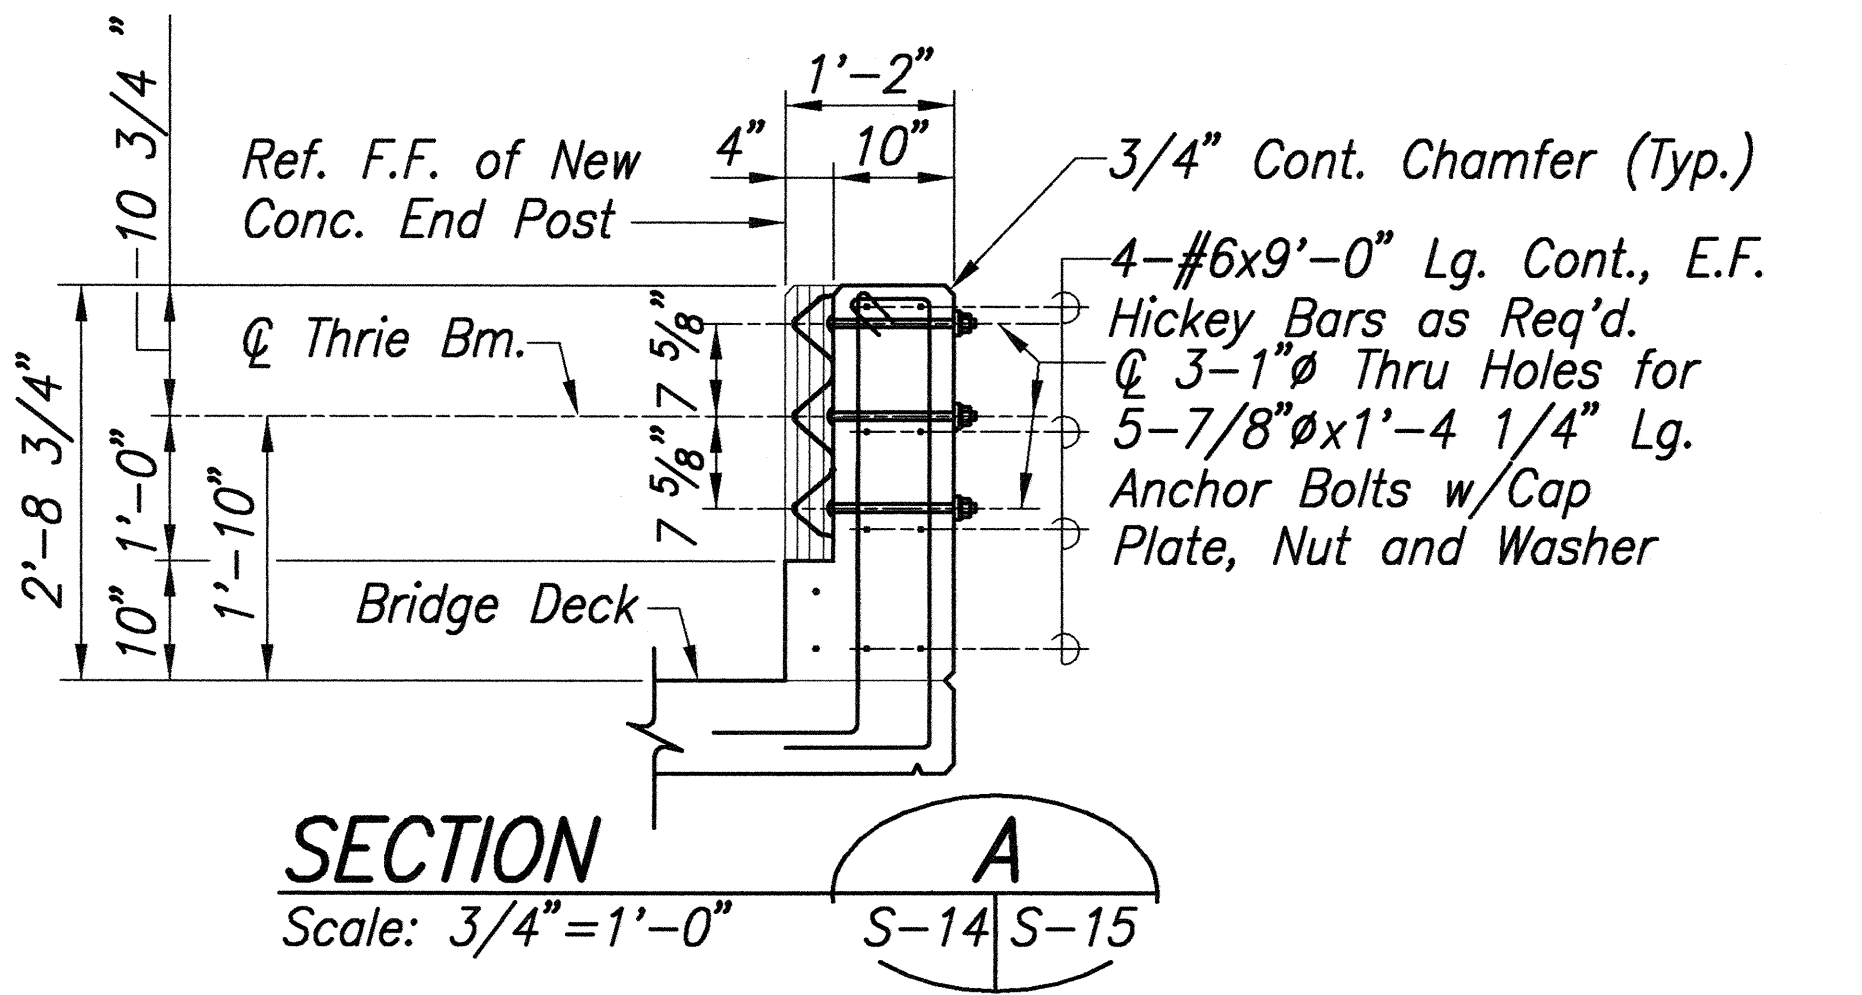

SURVEY PLOTTED BY	DATE
DRAWN BY	"
DESIGNED BY	"
NOTED BY	"
CHECKED BY	"
No.	"


Path: L:\Woa\6465-01\STR File Name: S15 Plot date: Jan 17, 2003-10:00:31am CAD User: eleong, Xref File Name: I Border I

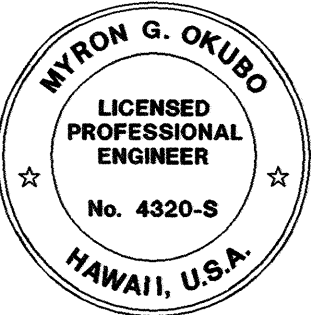

THIS WORK WAS PREPARED BY
ME OR UNDER MY SUPERVISION
Myron Okubo
Signature
April 30, 2004
Expiration Date of the License


DATE	REVISION
	<p>STATE OF HAWAII DEPARTMENT OF TRANSPORTATION HIGHWAYS DIVISION</p> <p>END POST DETAILS</p> <p>KAMEHAMEHA V HIGHWAY EMERGENCY REPLACEMENT OF KAWAIKAPU BRIDGE FEDERAL AID PROJECT NO. ER-12(4)</p> <p>Scale: As Noted Date: Nov. 25, 2002</p>
SHEET No. S-15 OF 16 SHEETS	

FED. ROAD DIST. NO.	STATE	FED. AID PROJ. NO.	FISCAL YEAR	SHEET NO.	TOTAL SHEETS
HAWAII	HAW.	ER-12(4)	2003	66	76

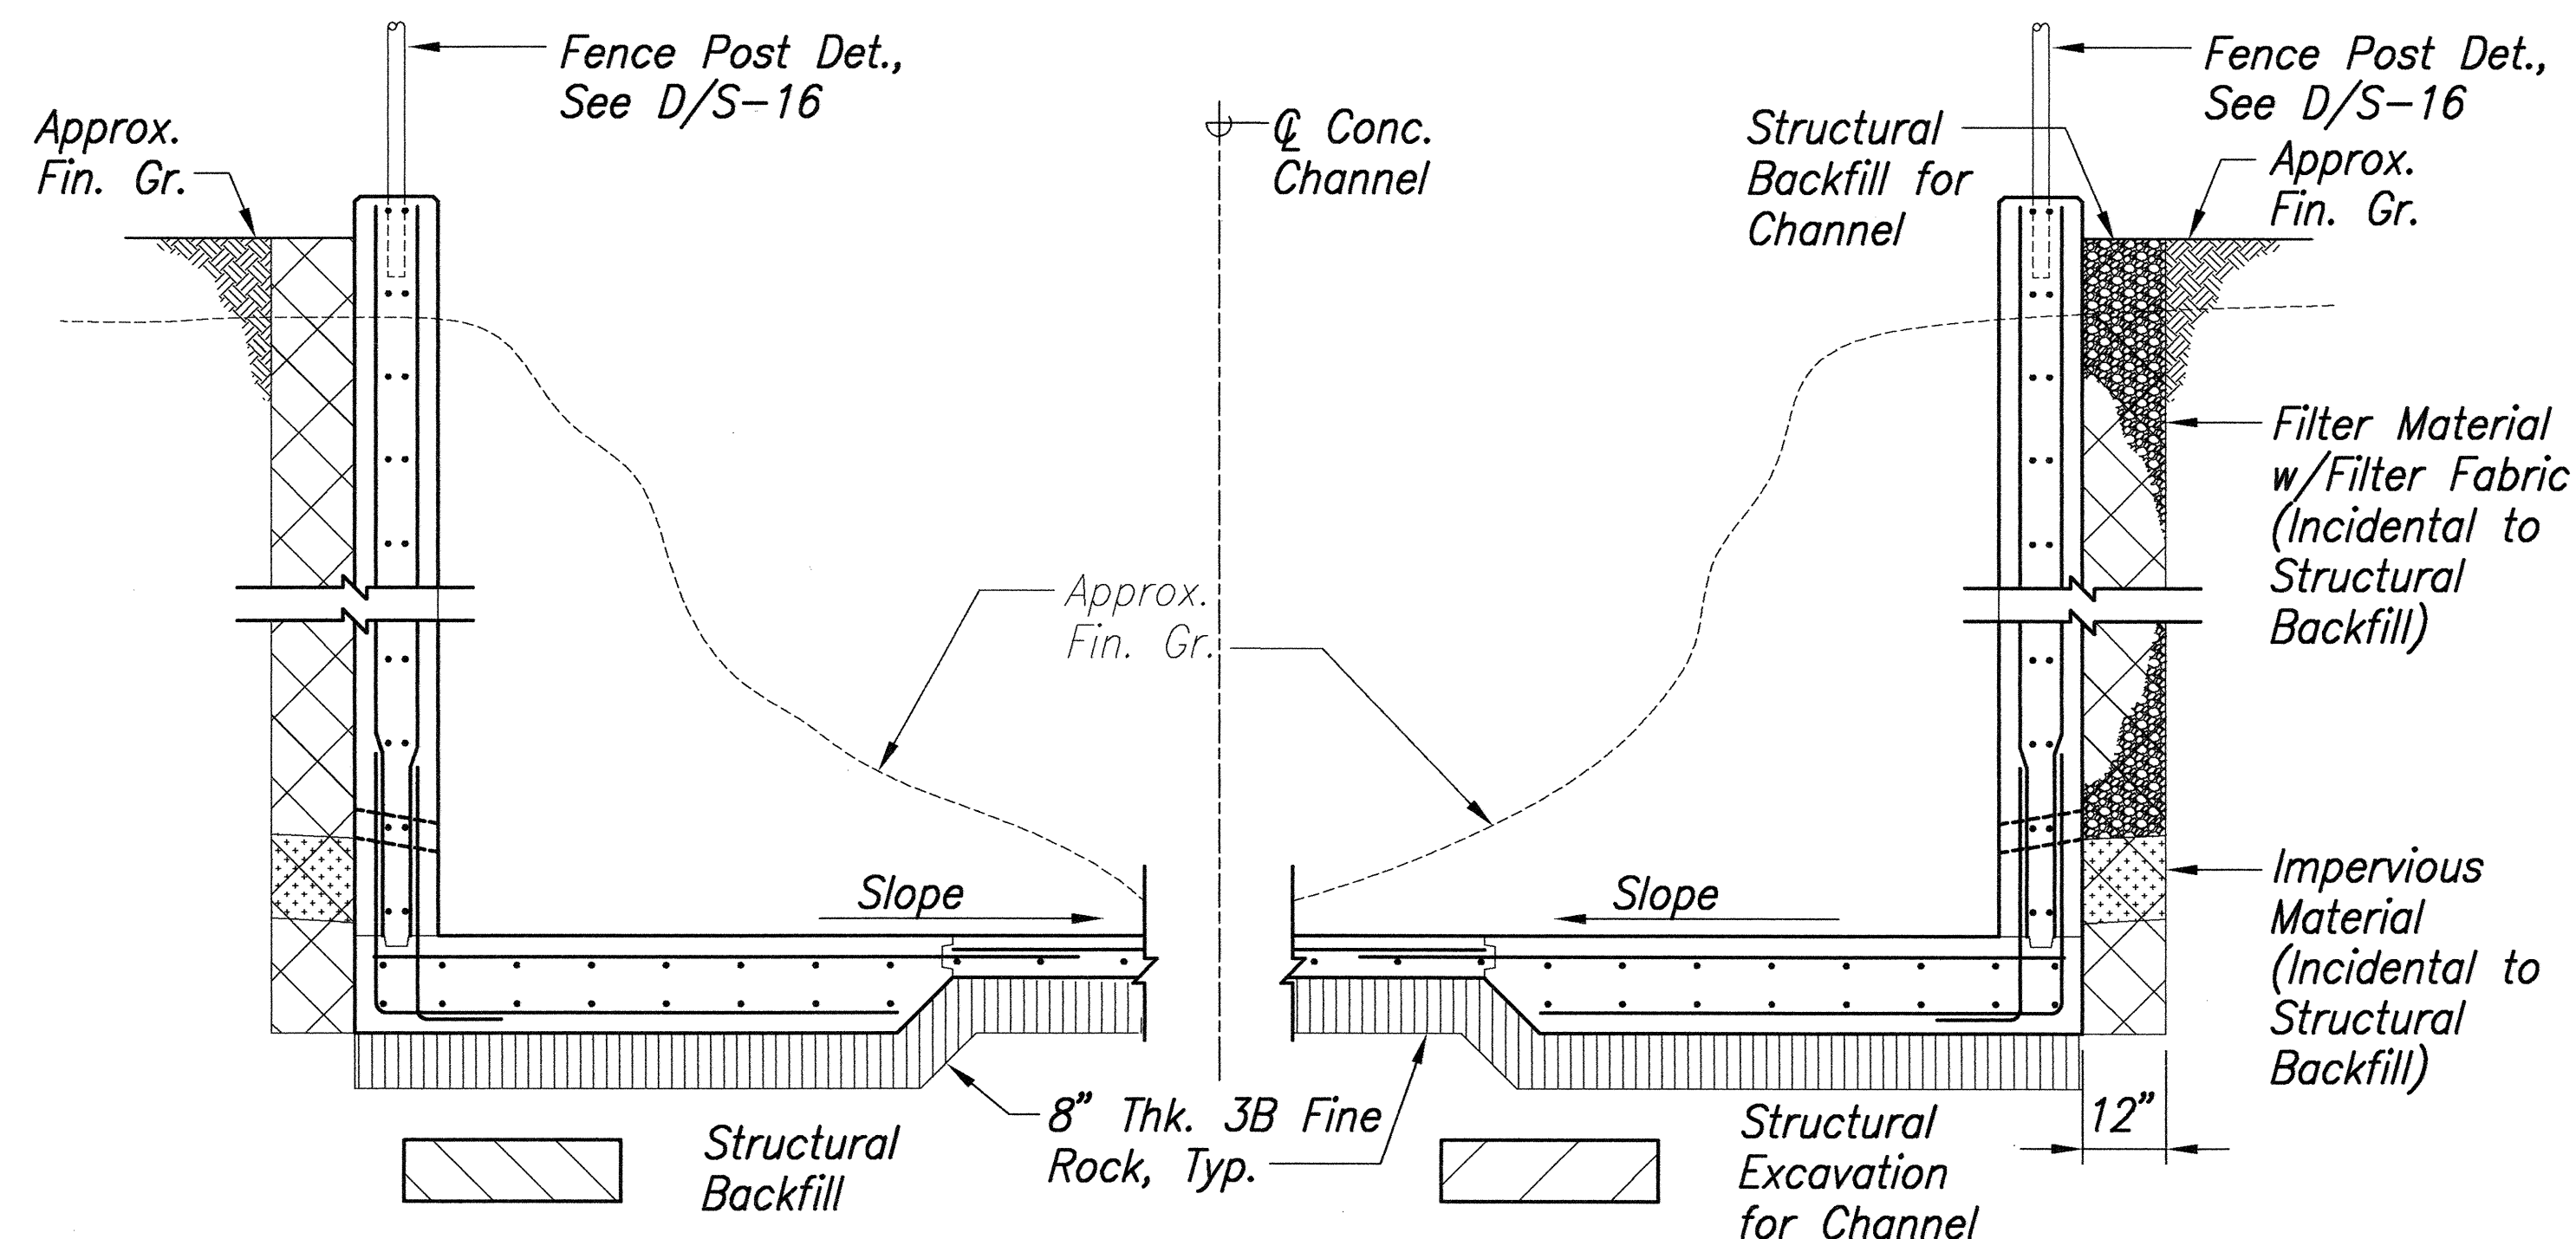


CONCRETE CHANNEL PAYLIMITS
Scale: 1/2"=1'-0"

Note:
See Civil Drawings for Concrete
Channel Wall Elevations.

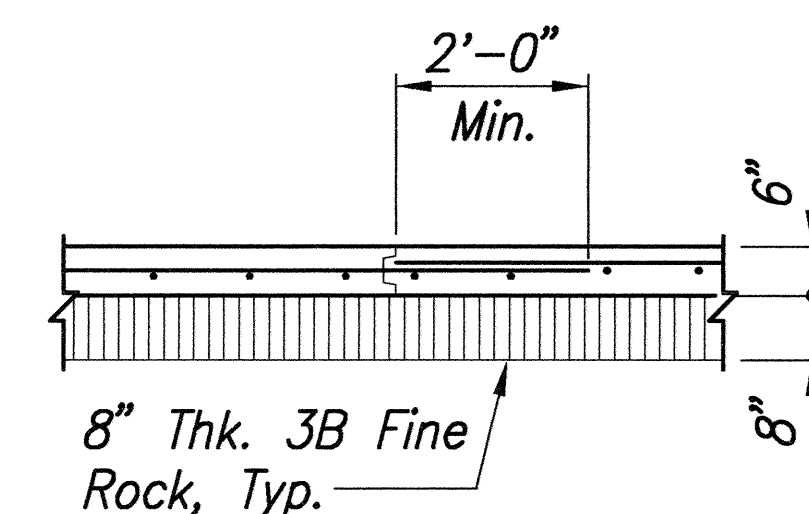


SLAB JOINT DET. 1
Scale: 1/2"=1'-0" S-16 S-16

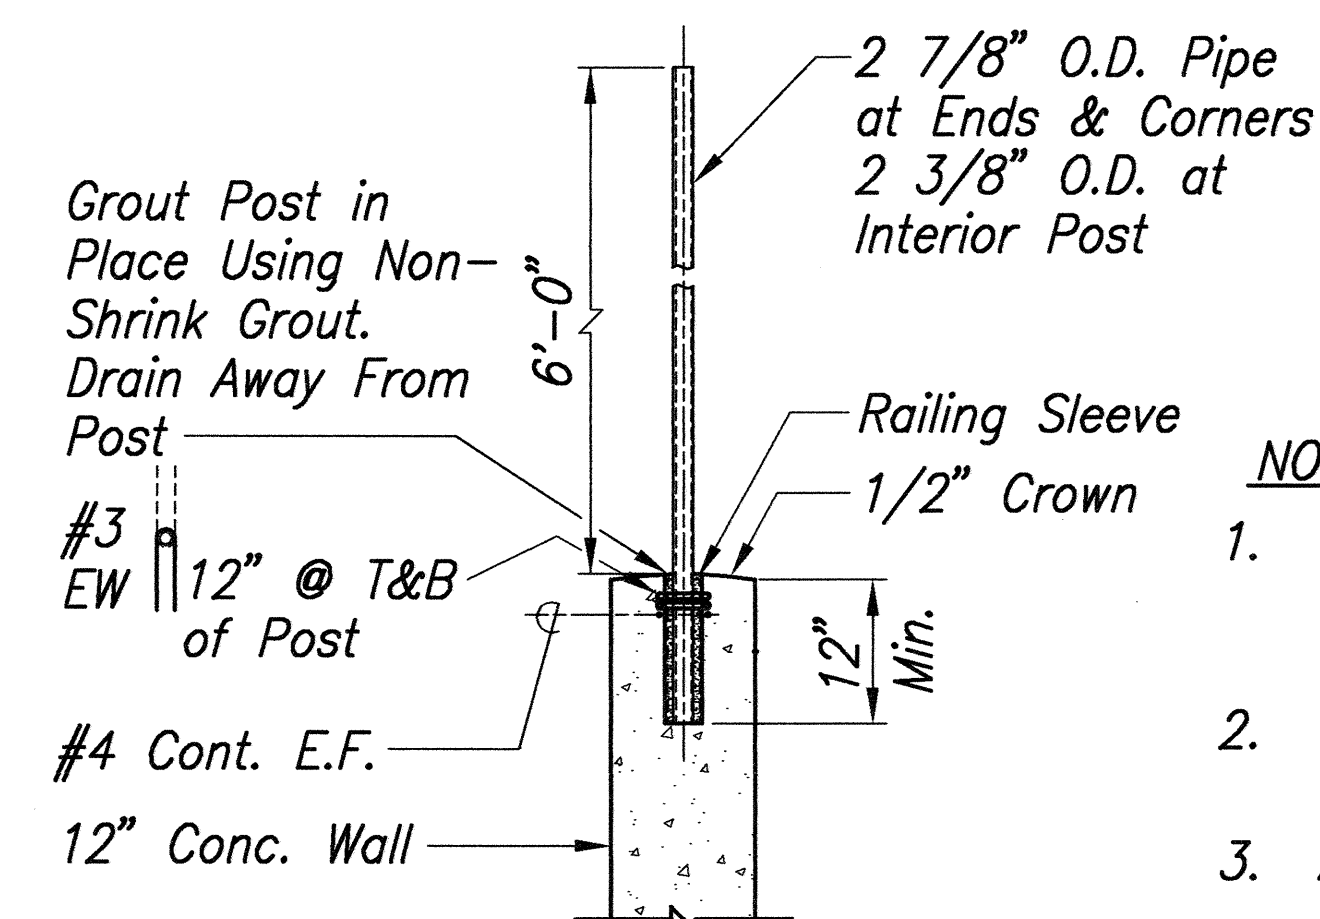


- NOTES:**
1. See Standard Plan D-02 for Balance of Details & Footing at GRP Wall.
 2. Post & Braces Shall be Schedule 40 Pipe.
 3. All Fencing Material Shall be Galvanized Steel.
 4. Interior Pipe Braces Shall be 1 5/8" O.D. Pipe.

FENCE POST DETAIL 2
Scale: 3/4"=1'-0" S-16 S-16

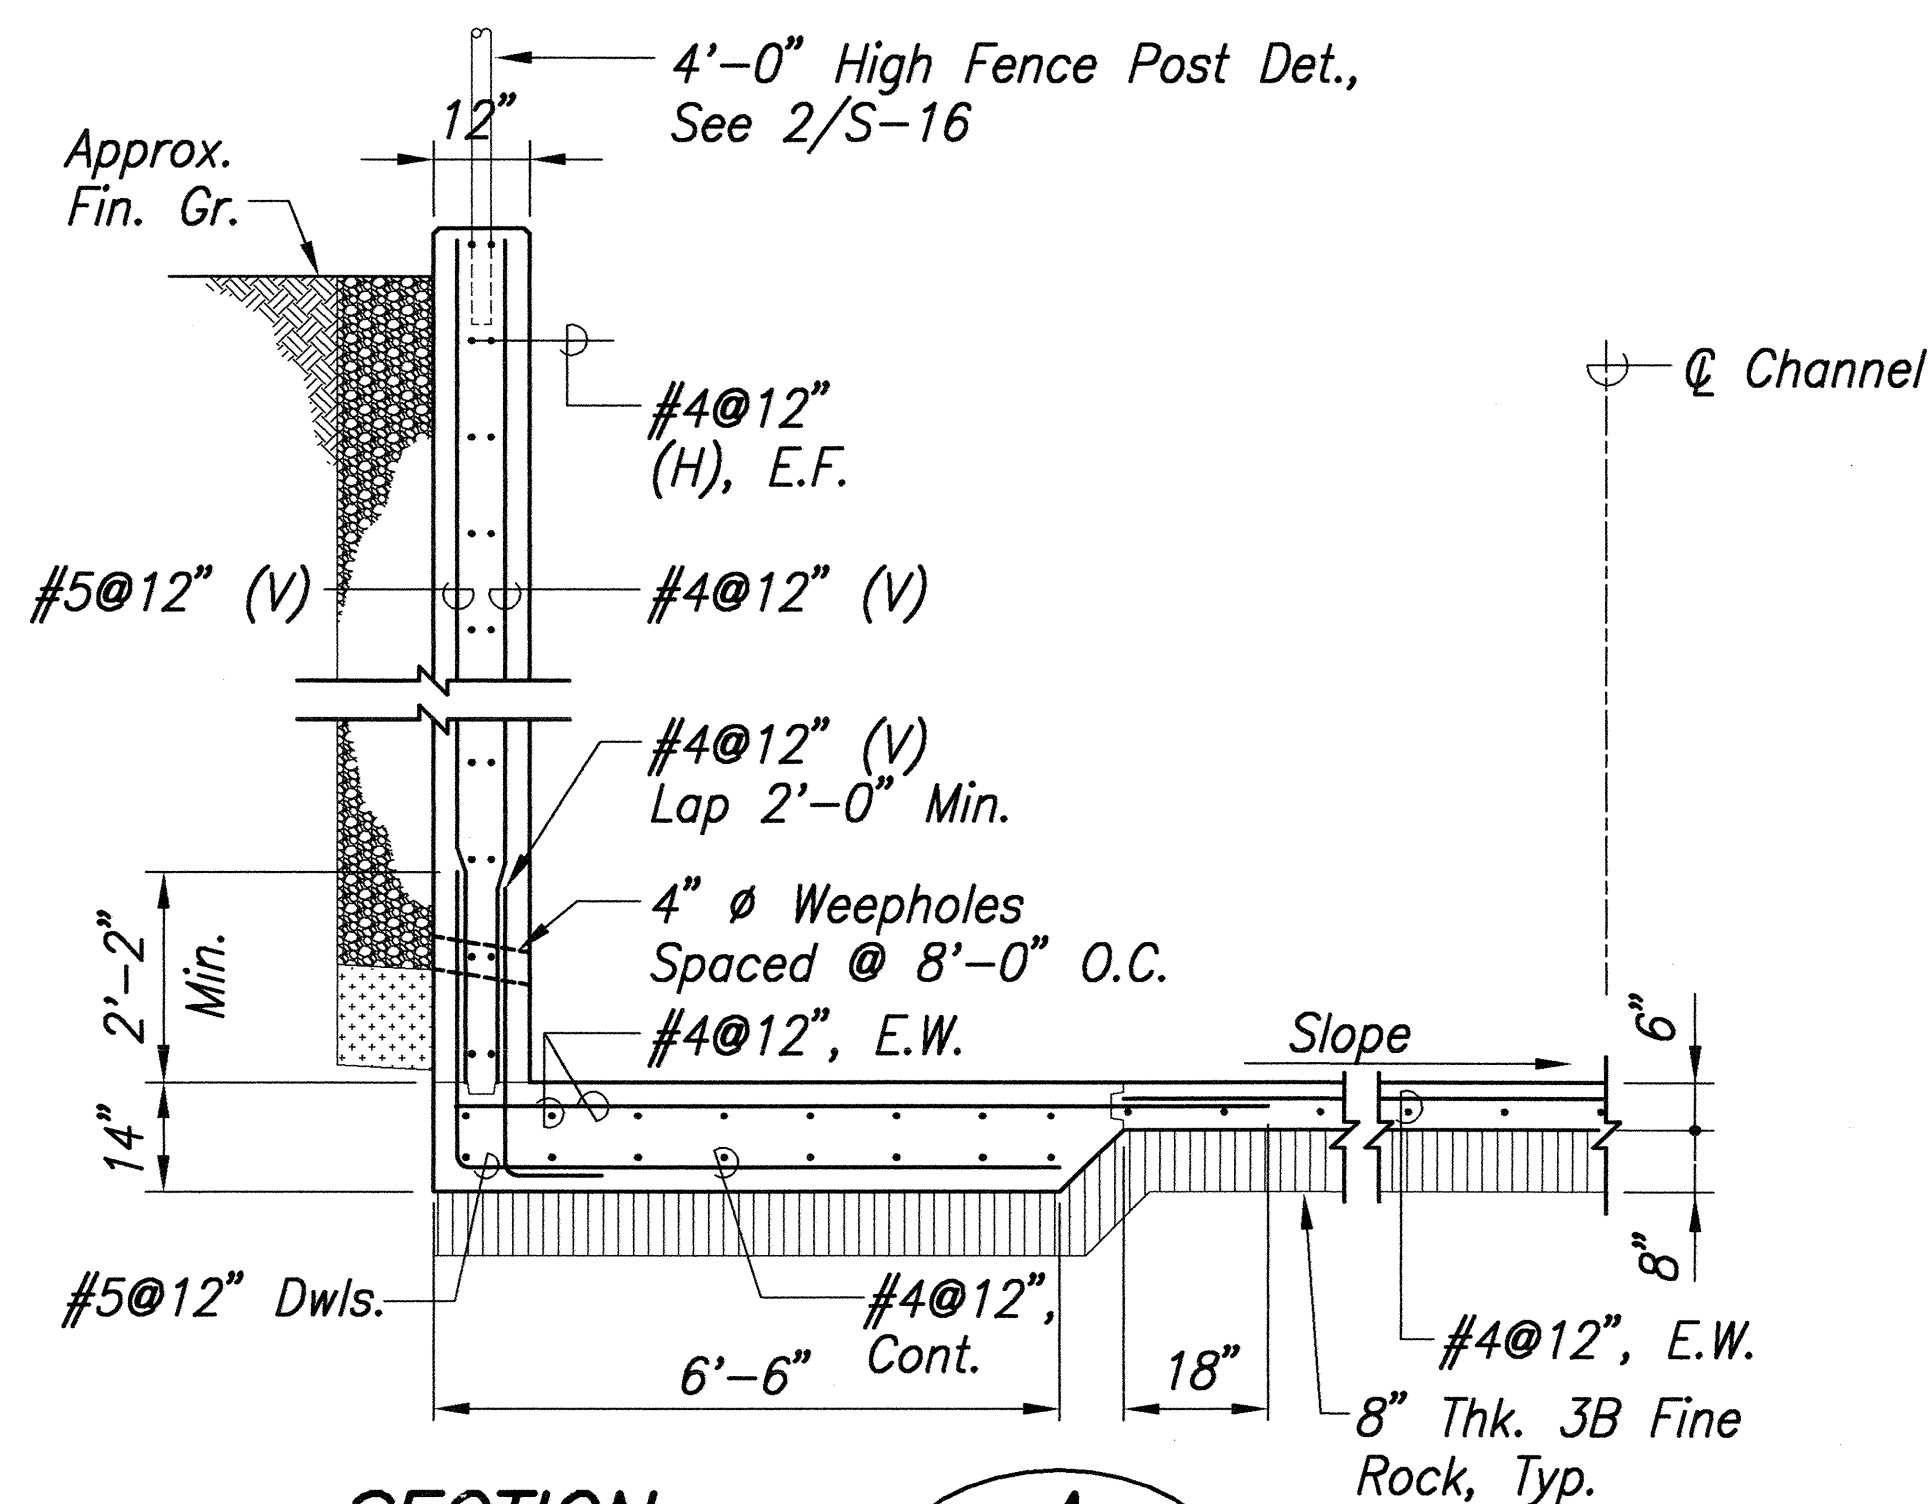

SECTION A
Scale: 1/2"=1'-0" S-16 S-16

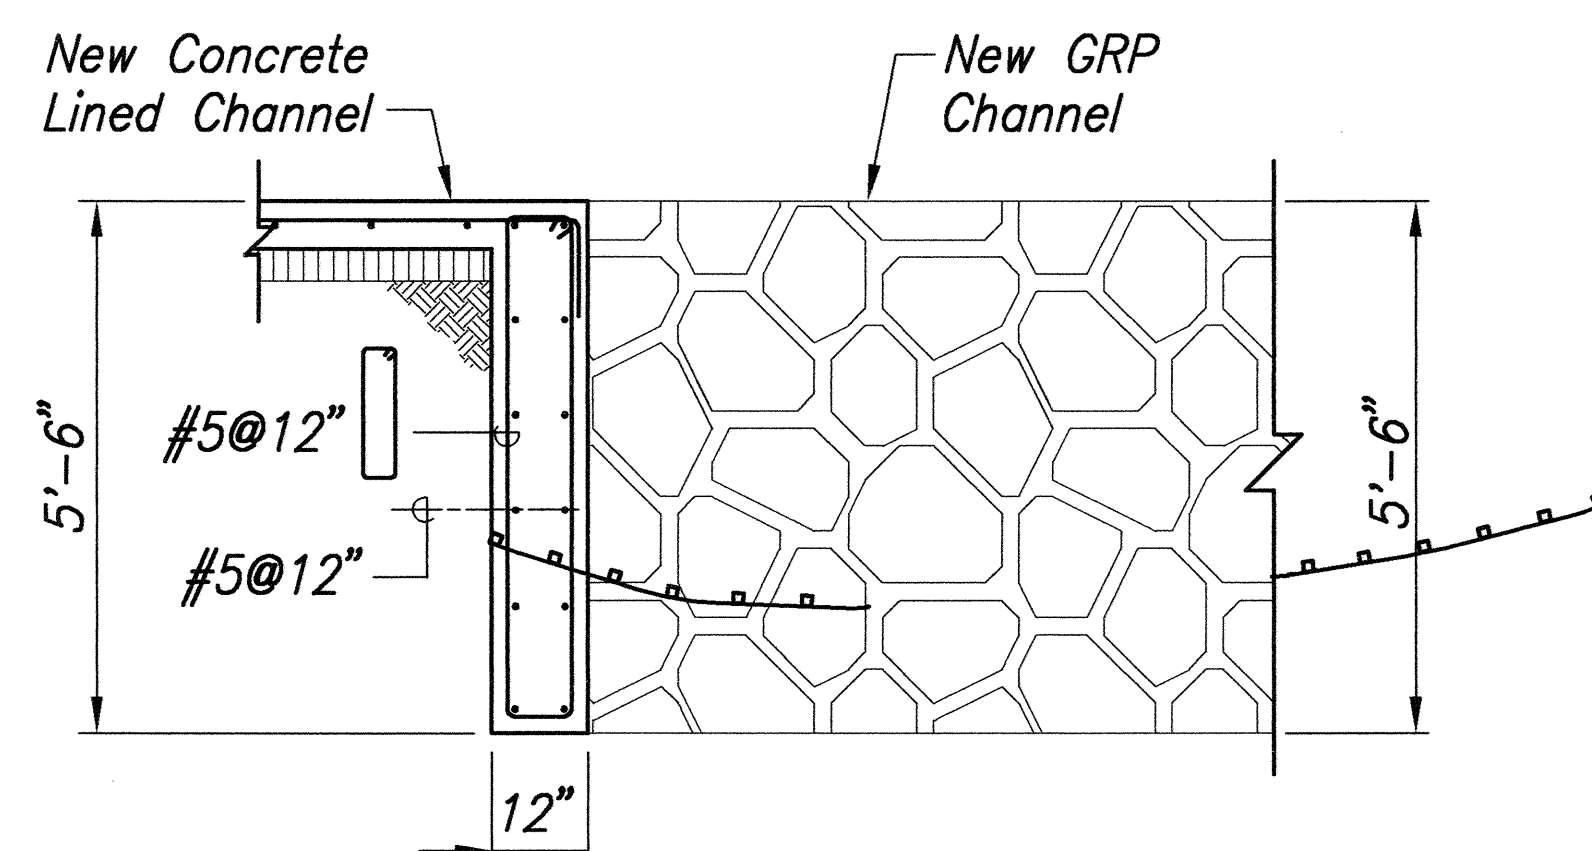

SECTION B
Scale: 1/2"=1'-0" S-16 S-16



THIS WORK WAS PREPARED BY
ME OR UNDER MY SUPERVISION
Myron Okubo
Signature
April 30, 2004
Expiration Date of the License

DATE	REVISION
	STATE OF HAWAII DEPARTMENT OF TRANSPORTATION HIGHWAYS DIVISION CHANNEL DETAILS KAMEHAMEHA V HIGHWAY EMERGENCY REPLACEMENT OF KAWAIKAPU BRIDGE FEDERAL AID PROJECT NO. ER-12(4) Scale: As Noted Date: Nov. 25, 2002 SHEET No. S-16 OF 16 SHEETS

ORIGINAL PLAN	DATE
DRAWN BY	
TRACED BY	
DESIGNED BY	
QUANTITIES BY	
CHECKED BY	
No.	

Path: L:\Voa\6465-01\STR File Name: S16 Plot date: Jan 17, 2003-100116am CAD User: eleong. Xref File Name: I Border 1