FED. ROAD	STATE	FED. AID	FISCAL	SHEET	TOTAL
DIST. NO.		PROJ. NO.	YEAR	NO.	SHEETS
HAWAII	HAW.	ER-12(4)	2003	35	76

CONSTRUCTION SIGN SUMMARY						
SIGN NO.	MESSAGE	W/POSTS	W/O POSTS			
CW13-1(XX)-A	15 M.P.H.	2				
CW20-1Ad	ROAD WORK AHEAD	2				
CW20-1A(3d)	ROAD WORK 750 FT	2				
CW20-4(2d)	ONE LANE BRIDGE 500 FT	2				
CW20-7(d)-A	ROAD WORK 250 FT	2	***************************************			
CG20-2A	END ROAD WORK	2	***************************************			
R1-2	YIELD TO ONCOMING TRAFFIC	1				
W3-2a	YIELD AHEAD	1	-			
	TOTAL	14				


		REF	ELECTOR	MARKER	SUMMAR	/	
		QUANTITY					
	TYPE	W/O POST		W/FLEXIBLE POST		W/STEEL POST	
		YELLOW	WHITE	YELLOW	WHITE	YELLOW	WHITE
	RM-2						
*	RM-3		***************************************	-	-		***************************************
	RM-4	***********************				4	***************************************
	RM-5	***************************************		***************************************			
**	OM, Type II		***************************************	***************************************	-	-	


NOTES:

- * Install RM-3 w/o steel post on new and relocated permanent signs and on construction warning signs (to be installed on all posts of signs).
- ** Install Object Marker (OM-II) w/o steel post on all utility poles that are located within 30 feet of the edge of paved shoulder.

PAVEMENT MARKING SUMMARY		
DESCRIPTION	QUANTITY	
PAVEMENT MARKERS TYPE A TYPE C TYPE D TYPE H TYPE J	0 38 30 33 16	EA. EA.
*TAPE - TYPE I OR THERMOPLASTIC EXTRUSION 4-INCH PAVEMENT STRIPE (YELLOW) 8-INCH PAVEMENT STRIPE (WHITE) DOUBLE 4-INCH PAVEMENT STRIPE (YELLOW)		L.F. L.F. L.F.
**TAPE - TYPE II OR THERMOPLASTIC EXTRUSION 8-INCH PAVEMENT STRIPE (WHITE) 12-INCH PAVEMENT STRIPE (WHITE) 12-INCH PAVEMENT STRIPE (YELLOW) DOUBLE 4-INCH PAVEMENT STRIPE (YELLOW)	1442 0 0 0 1060	L.F. L.F. L.F.
***TAPE - TYPE III OR THERMOPLASTIC EXTRUSION 4-INCH PAVEMENT STRIPE (WHITE) 4-INCH PAVEMENT STRIPE (YELLOW) 12-INCH PAVEMENT STRIPE (WHITE) PAVEMENT ARROW		L.F. L.F. L.F. EA.

- * Tape, Type I or Thermoplastic Extrusion (No Passing Zones, Channelizing Lines or Solid Lines)
- ** Tape, Type II or Thermoplastic Extrusion (Transverse Median Markings, Transverse Shoulder Markings, Channelizing Islands or Edge Striping)
- *** Tape, Type III, or Thermoplastic Extrusion (Guide Lines, Stop Lines, Extension of Edge Lines, Crosswalk Markings, Pavement Words or Pavement Arrows)

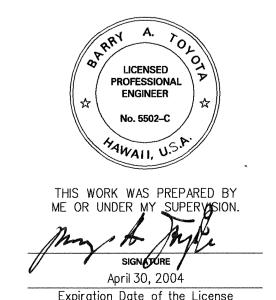

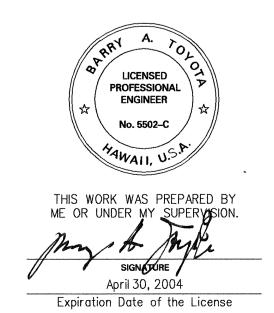

REVISION STATE OF HAWAII DEPARTMENT OF TRANSPORTATION
HIGHWAYS DIVISION TRAFFIC SIGN SUMMARY \$ PAVEMENT MARKING SUMMARY KAMEHAMEHA V HIGHWAY
EMERGENCY REPLACEMENT OF KAWAIKAPU BRIDGE
FEDERAL AID PROJECT NO. ER-12(4)

Scale: None

Date: November 25, 2002 SHEET No. C32 OF 46 SHEETS

35

