



FED. ROAD DIST. NO.	STATE	PROJ. NO.	FISCAL YEAR	SHEET NO.	TOTAL SHEETS
HAWAII	HAW.	450B-01-05M	2005	6	35

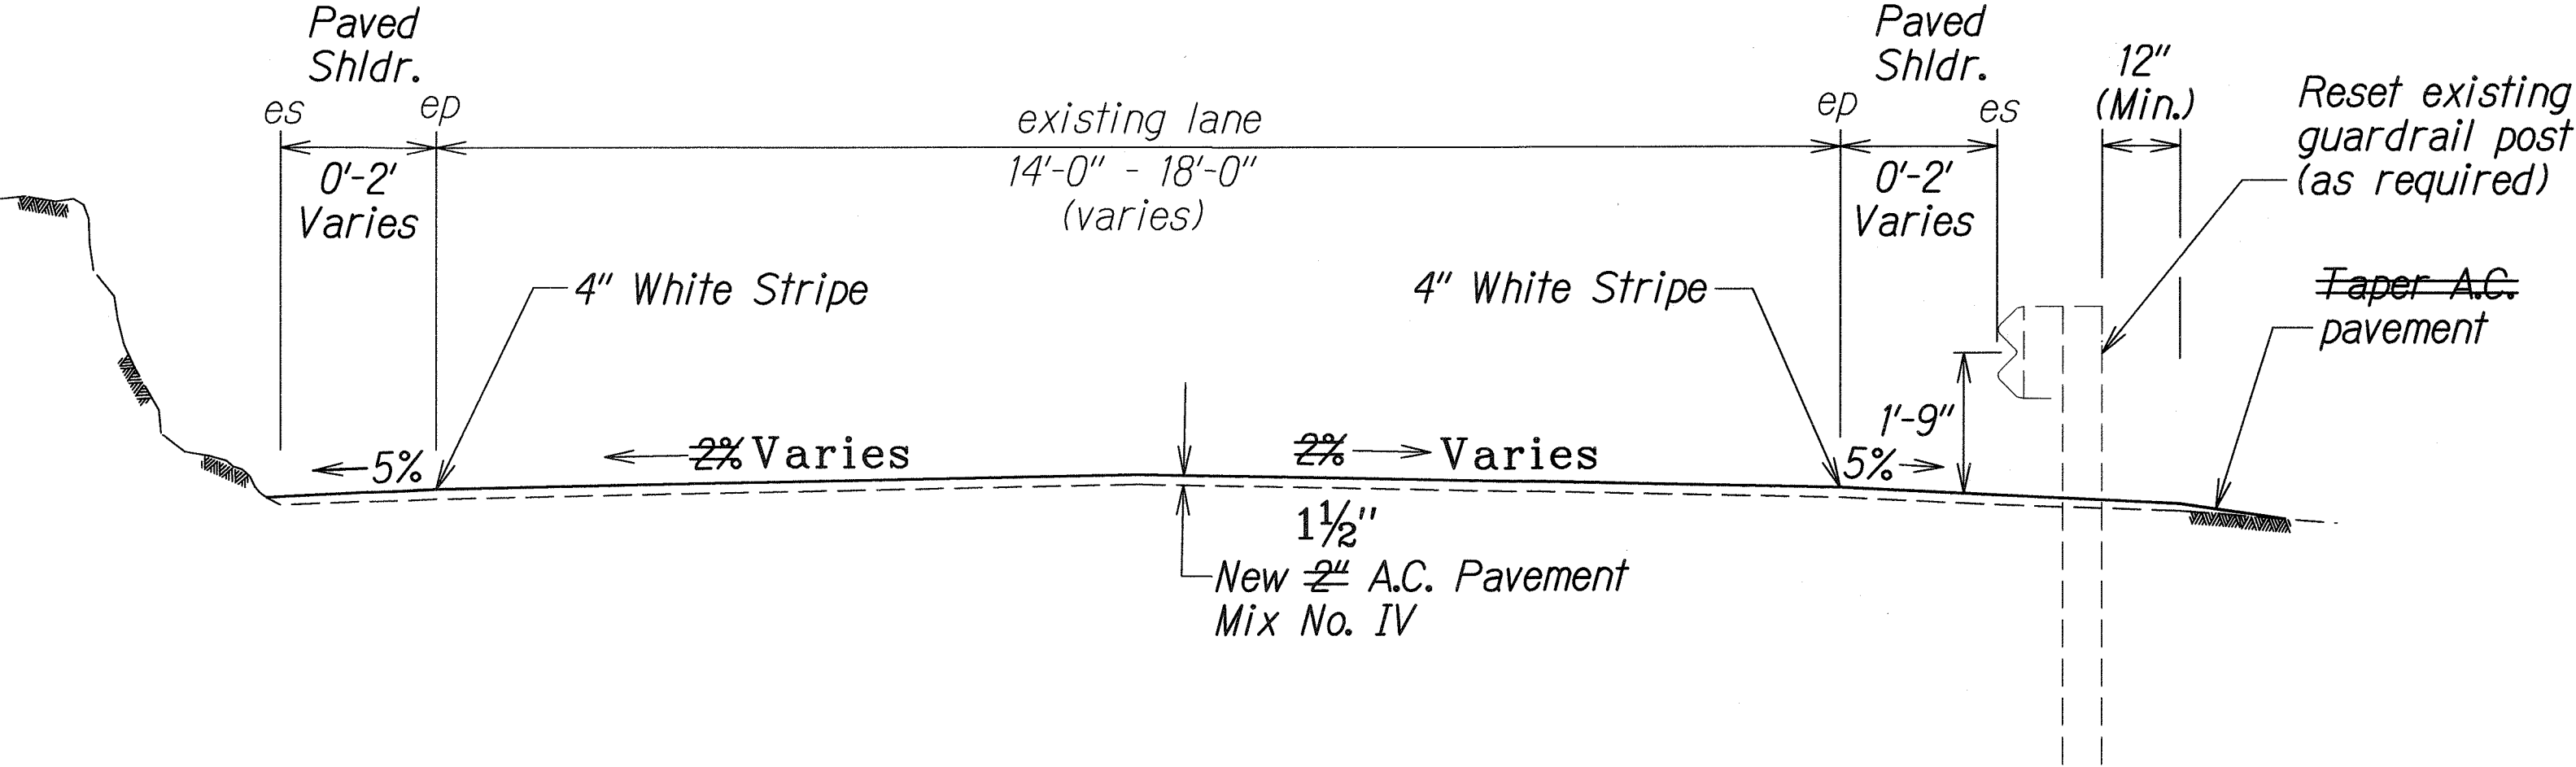


TYPICAL SECTION
STA. 140+00± - STA. 275+00±
Scale: 1/2" = 1'-0"

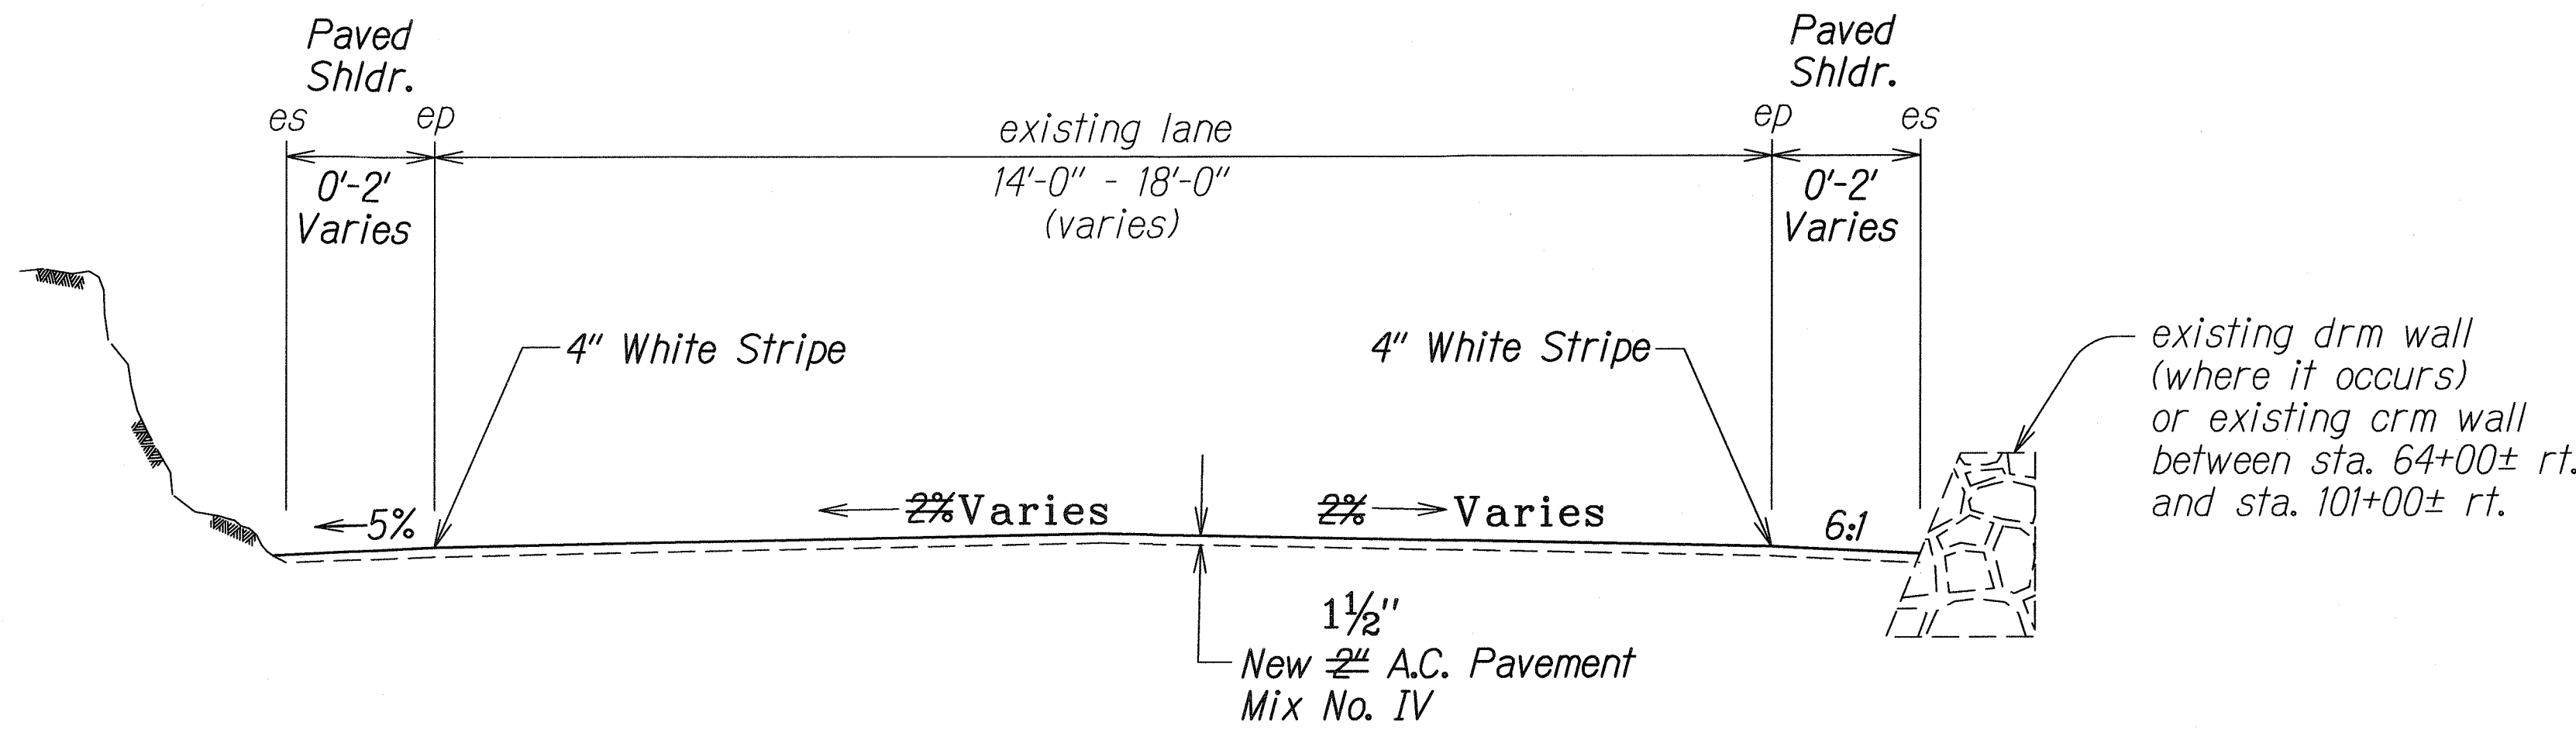


TYPICAL SECTION
STA. 206+00± - STA. 241+00±
Scale: 1/2" = 1'-0"

NOTE:
Prior to resurfacing eradicate vegetation at the face of existing dry rock masonry and concrete masonry walls.

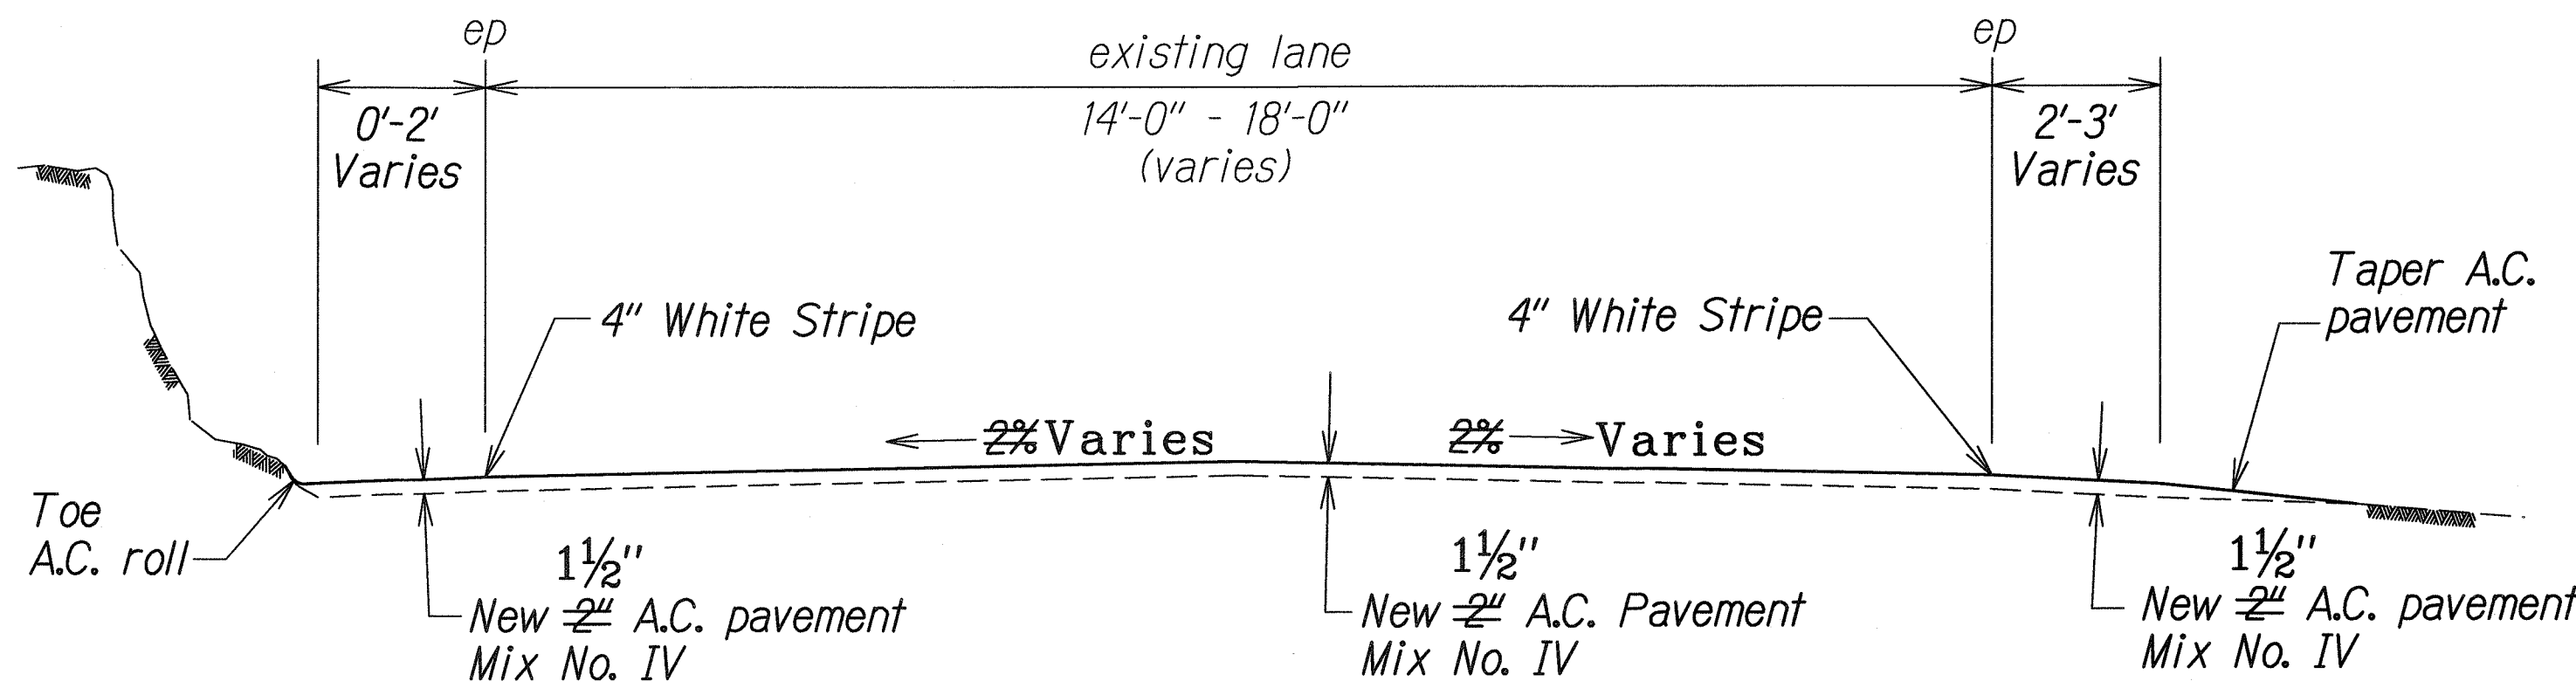

TYPICAL SECTION
STA. 0+00± - STA. 140+00±
Scale: 1/2" = 1'-0"

BEGIN STA	END STA
21+16	21+33
28+49	28+65
63+07	63+21
63+44	65+49
75+15	75+73
80+49	80+60
95+97	96+71
96+77	98+10
122+19	122+48
122+53	122+69
132+31	137+16
244+29	248+98
258+94	263+47
267+16	275+62
154+80	158+05

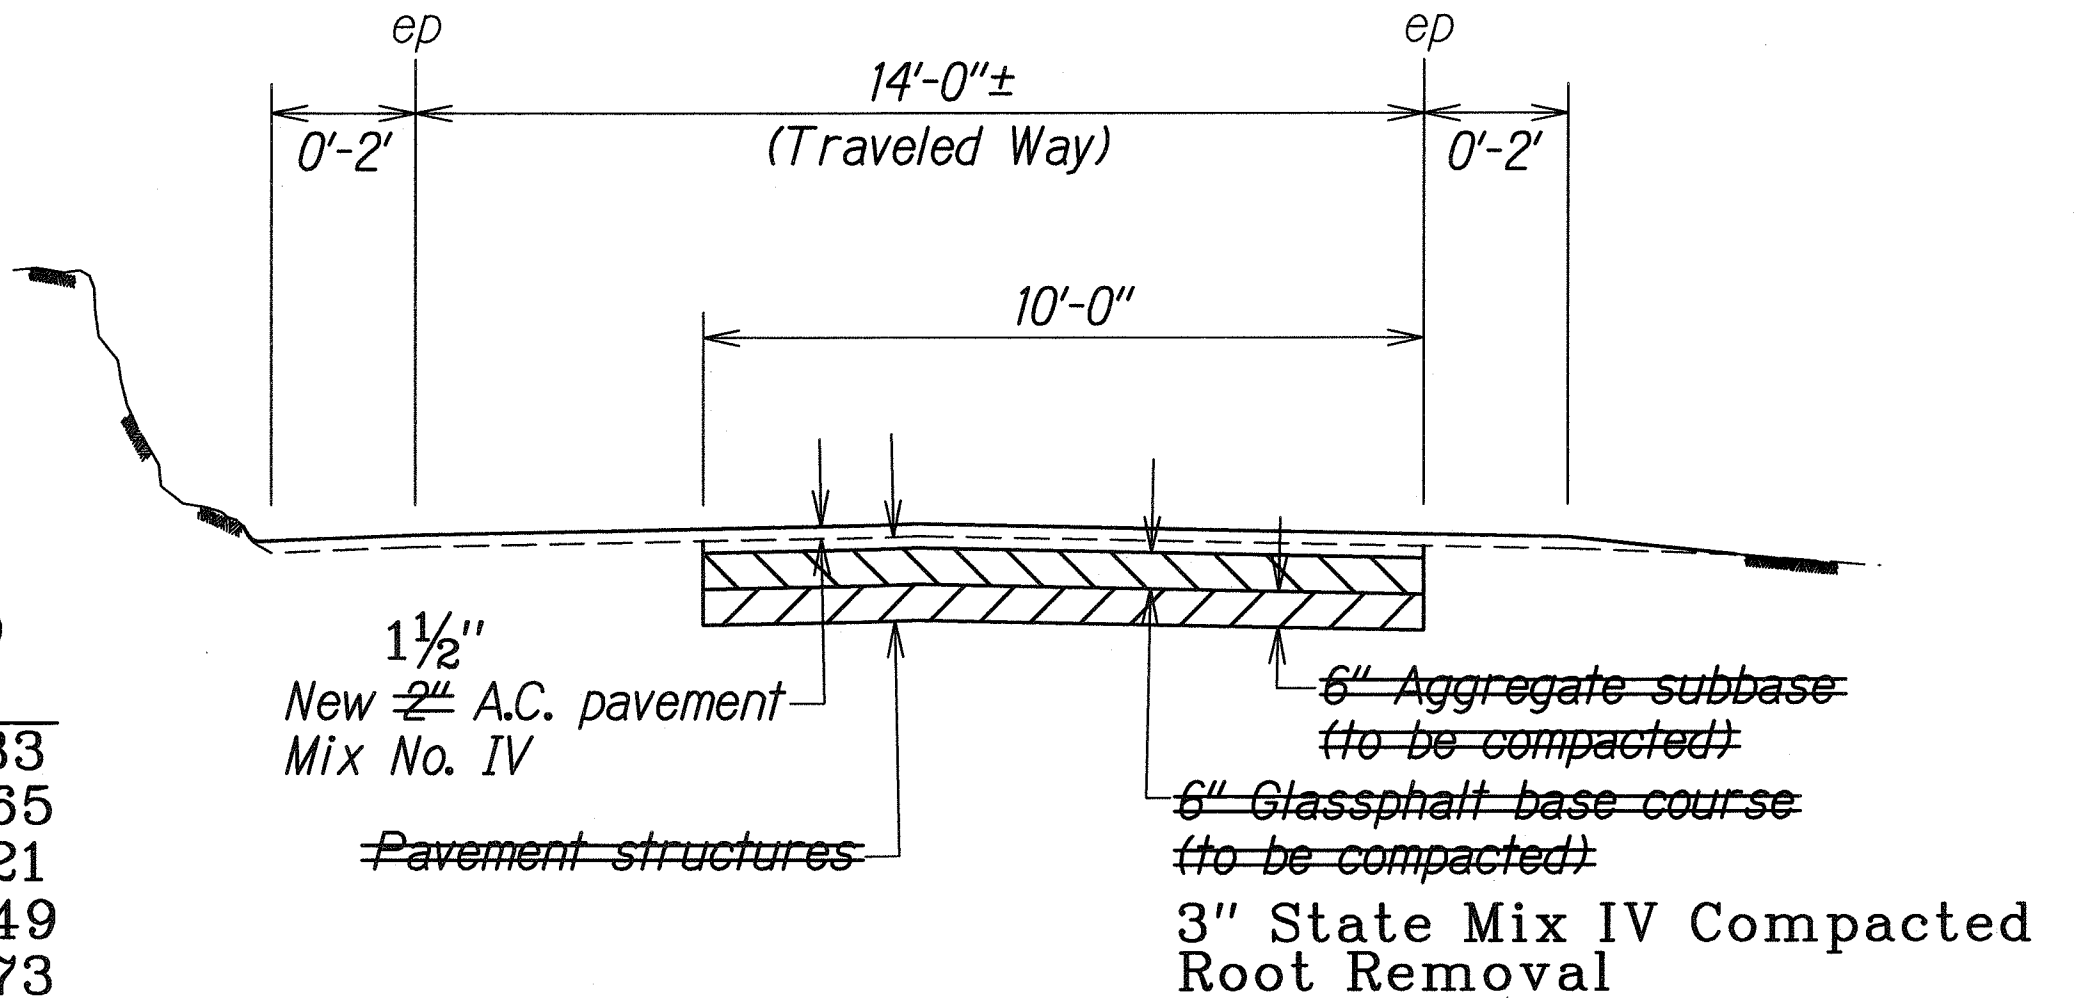


TYPICAL SECTION FOR RESTORATION AREAS

~~STA. 79+20± - STA. 80+40±~~


~~STA. 177+50± - STA. 179+00±~~

See table on left Scale: 3/8" = 1'-0"

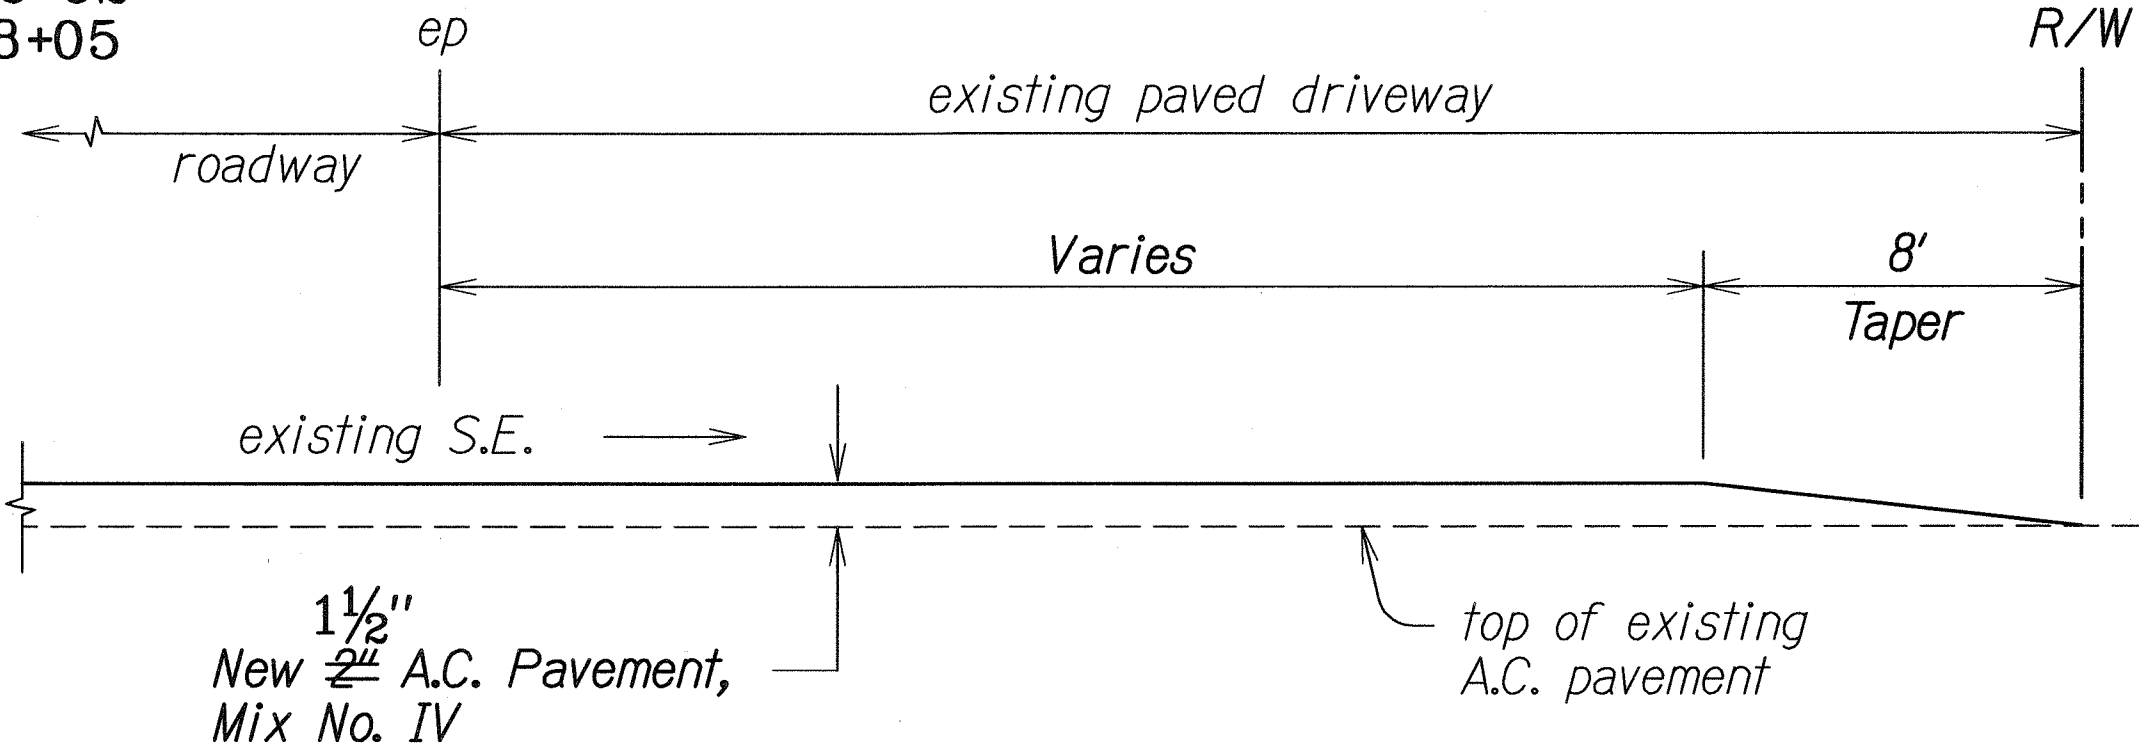

PAVED DRIVEWAY DETAIL
Not To Scale


LEGEND FOR AS-BUILT POSTINGS	
	Squiggly line for as-built deletion
	Double line for as-built deletion
	Text for as-built posting

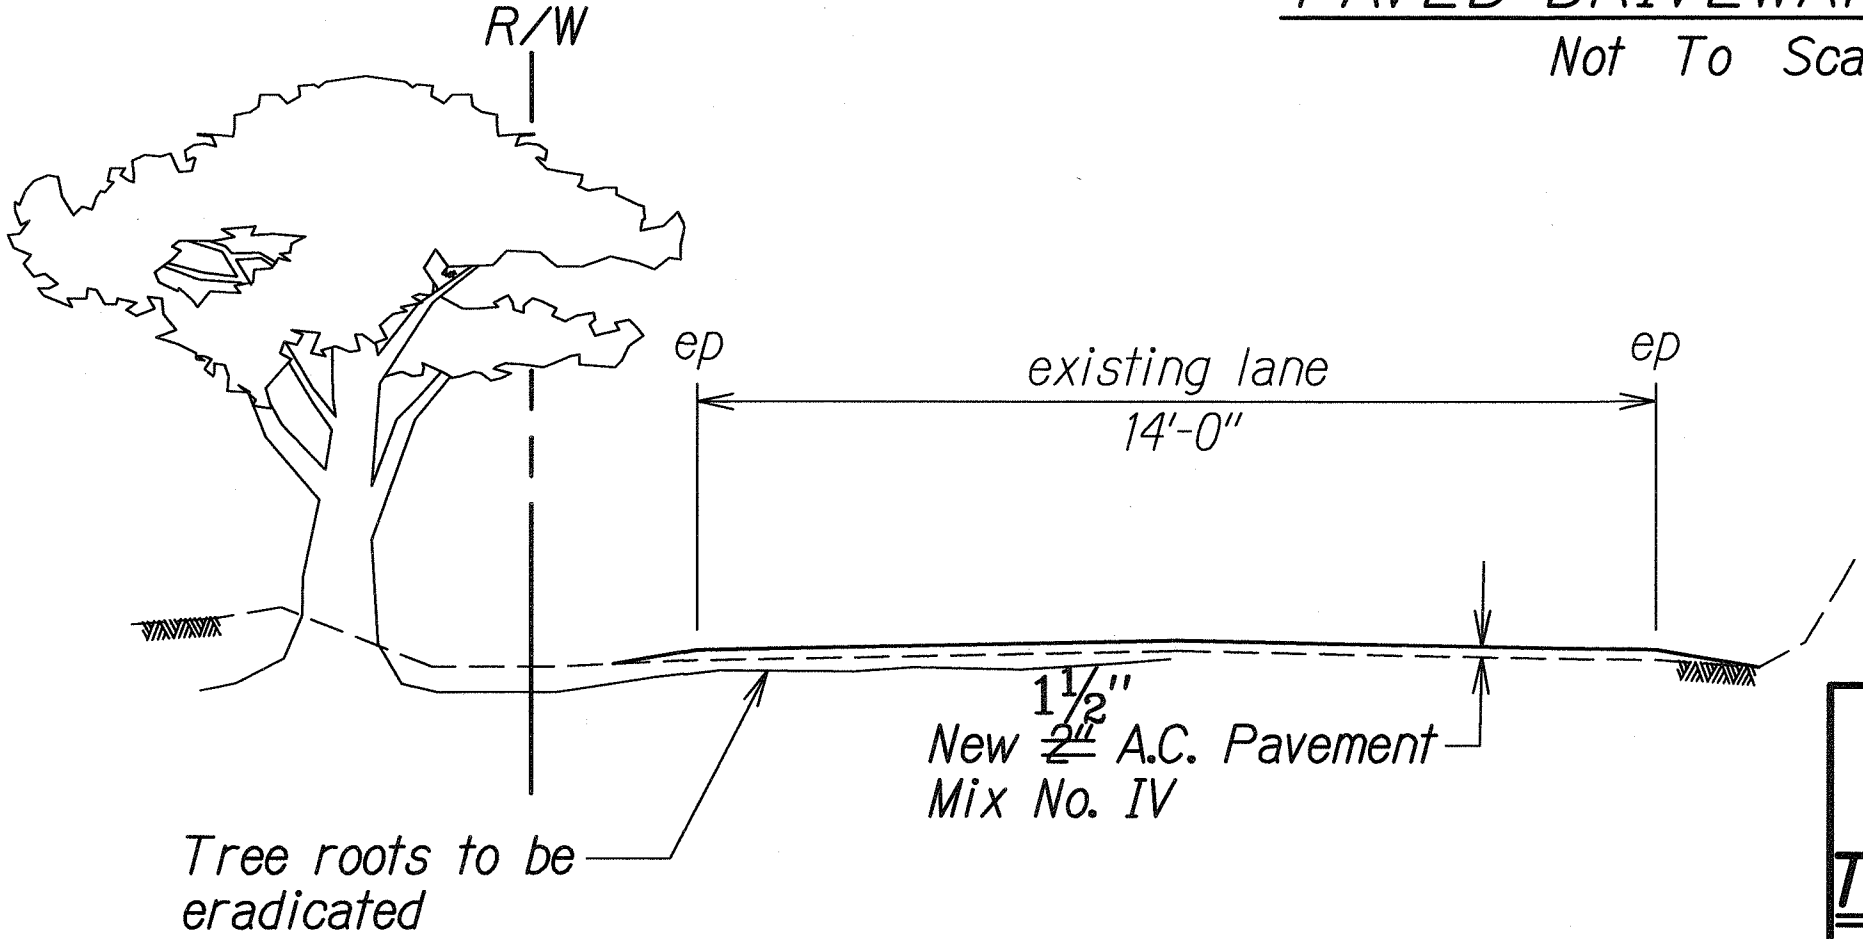


TYPICAL SECTION
TREE ROOTS LOCATION
STA. 132+00± - STA. 136+00±
Not To Scale

STATE OF HAWAII DEPARTMENT OF TRANSPORTATION HIGHWAYS DIVISION	
TYPICAL SECTIONS & DETAILS	
KAMEHAMEHA V HIGHWAY RESURFACING	
Waialua to Halawa Bay	
Project No. 450B-01-05M	
Scale: As Shown	Date: February, 2005
SHEET No. 1 OF 2 SHEETS	


FED. ROAD DIST. NO.	STATE	PROJ. NO.	FISCAL YEAR	SHEET NO.	TOTAL SHEETS
HAWAII	HAW.	450B-01-05M	2005	7	35

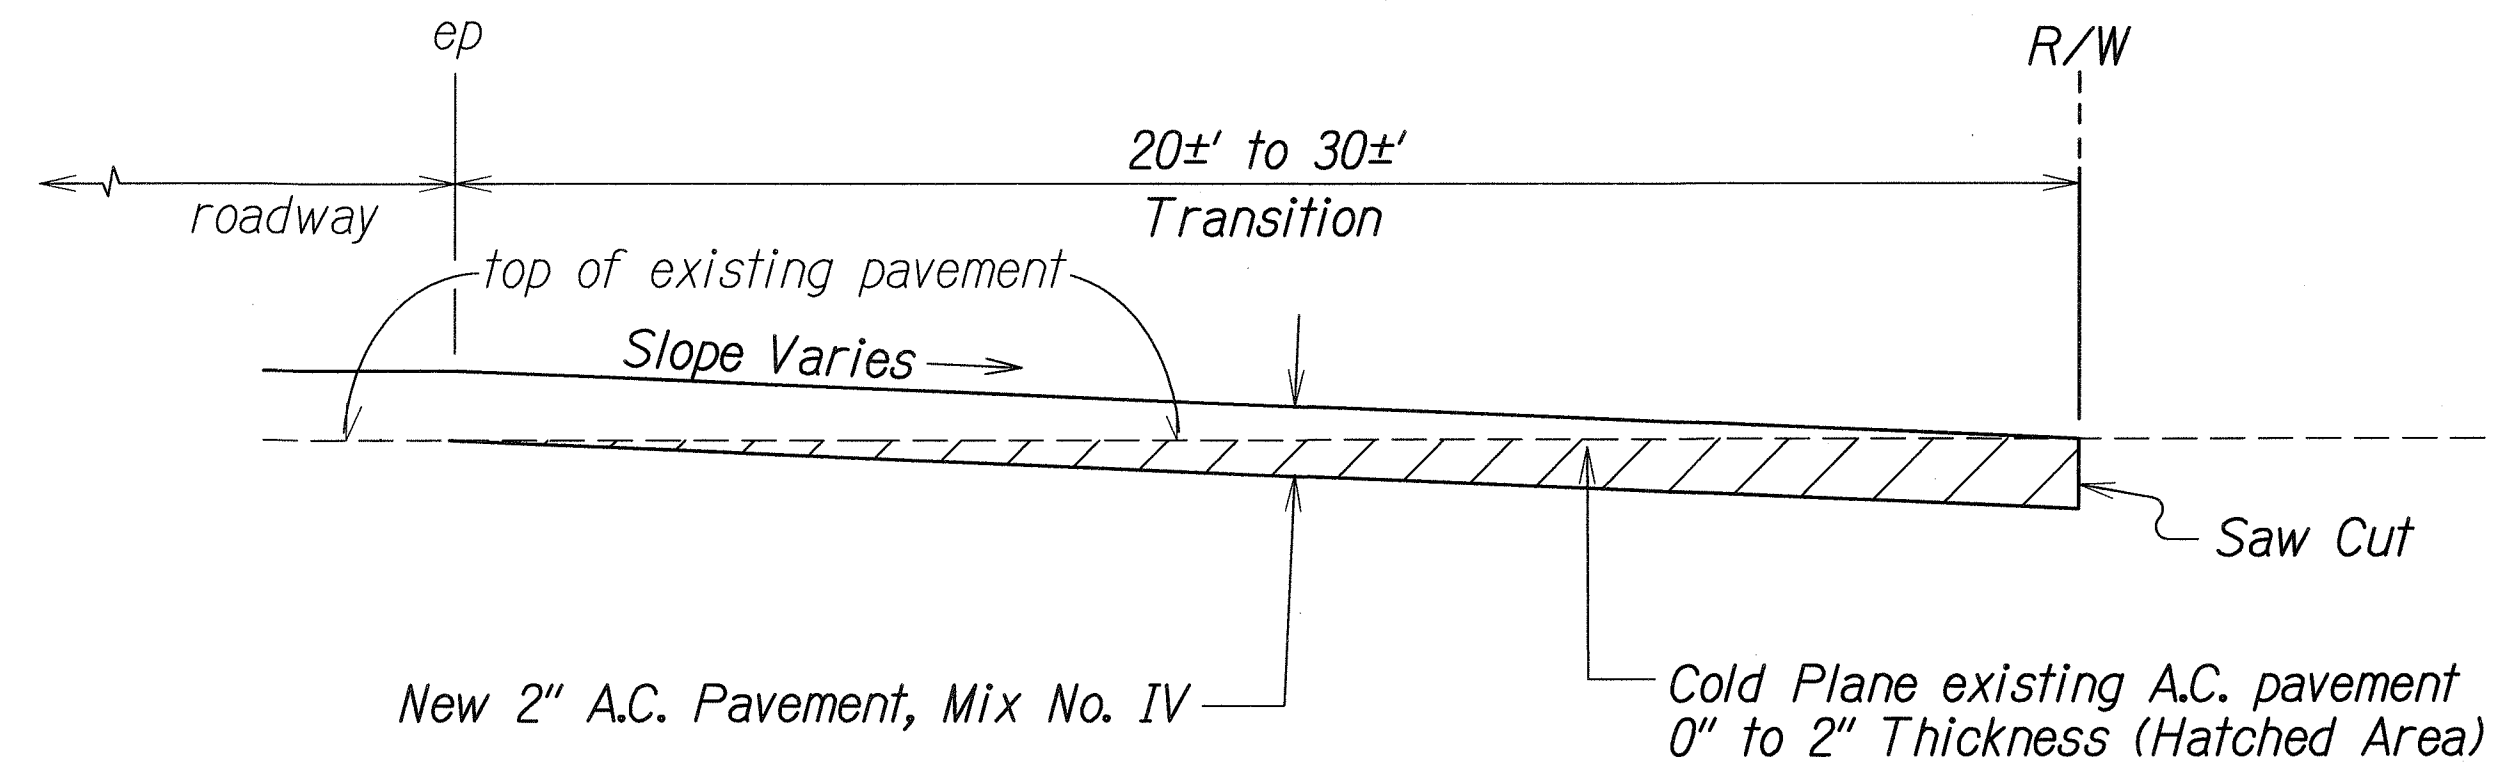


PAVED SIDE ROAD DETAIL
Not To Scale

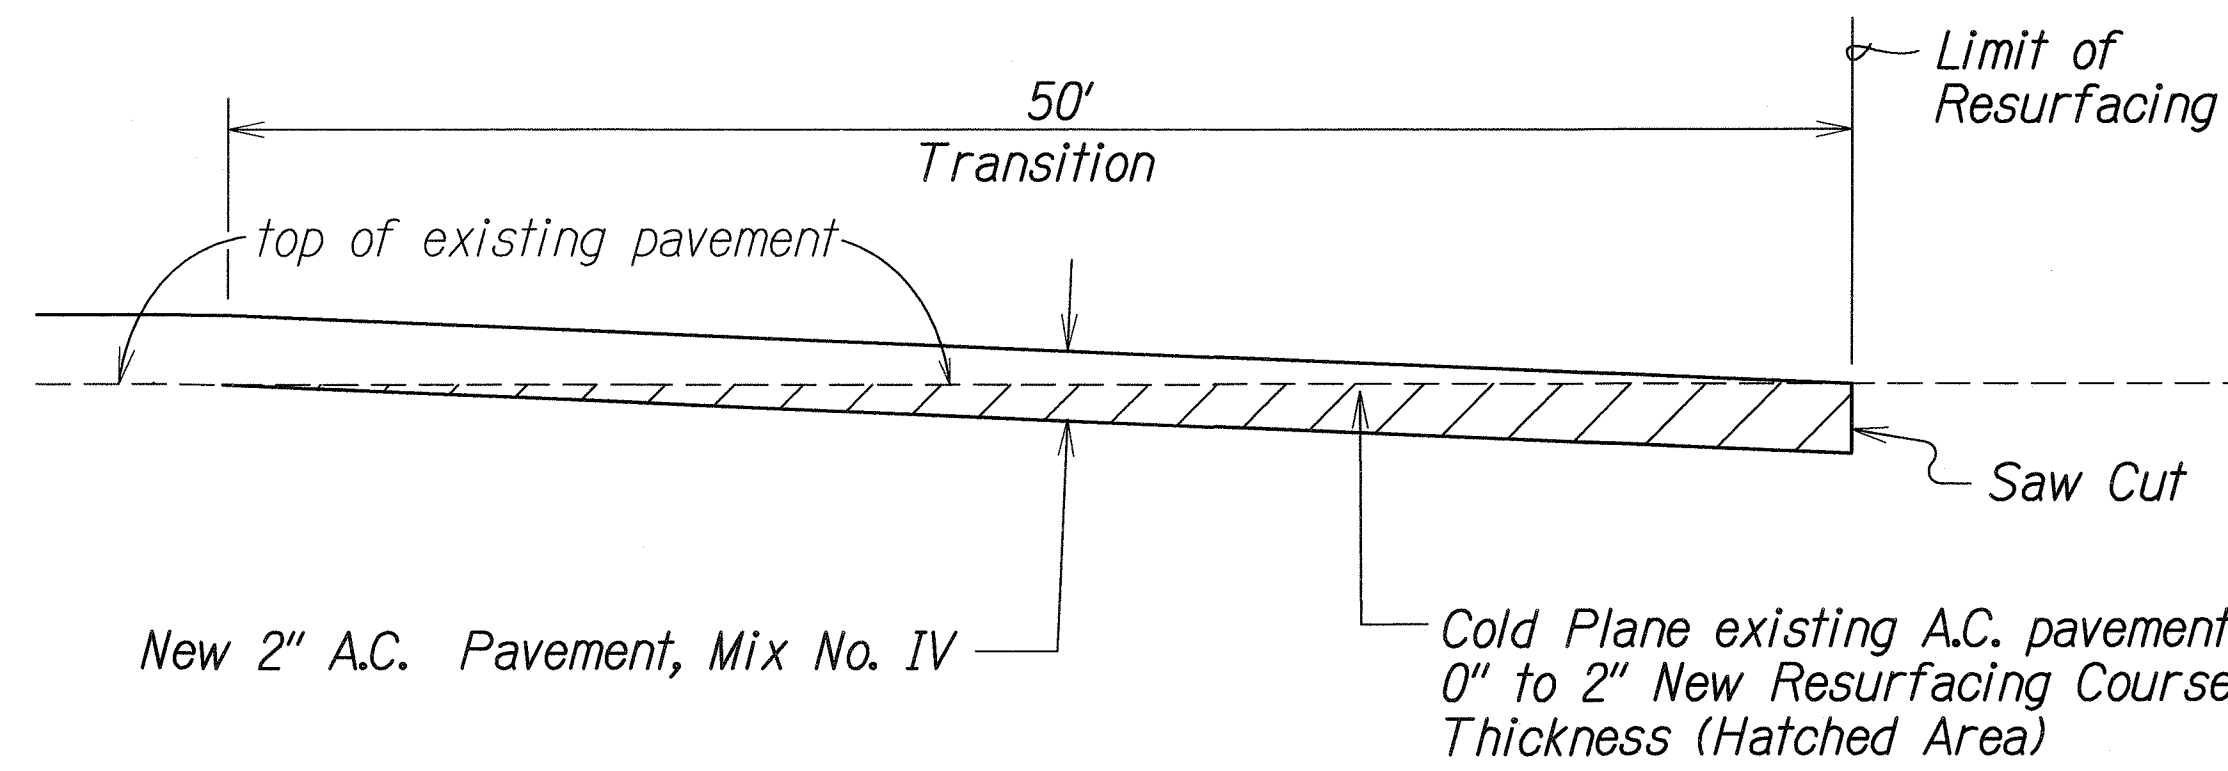


COLD PLANED TRANSITION
TO EXISTING A.C. PAVEMENT
Not To Scale

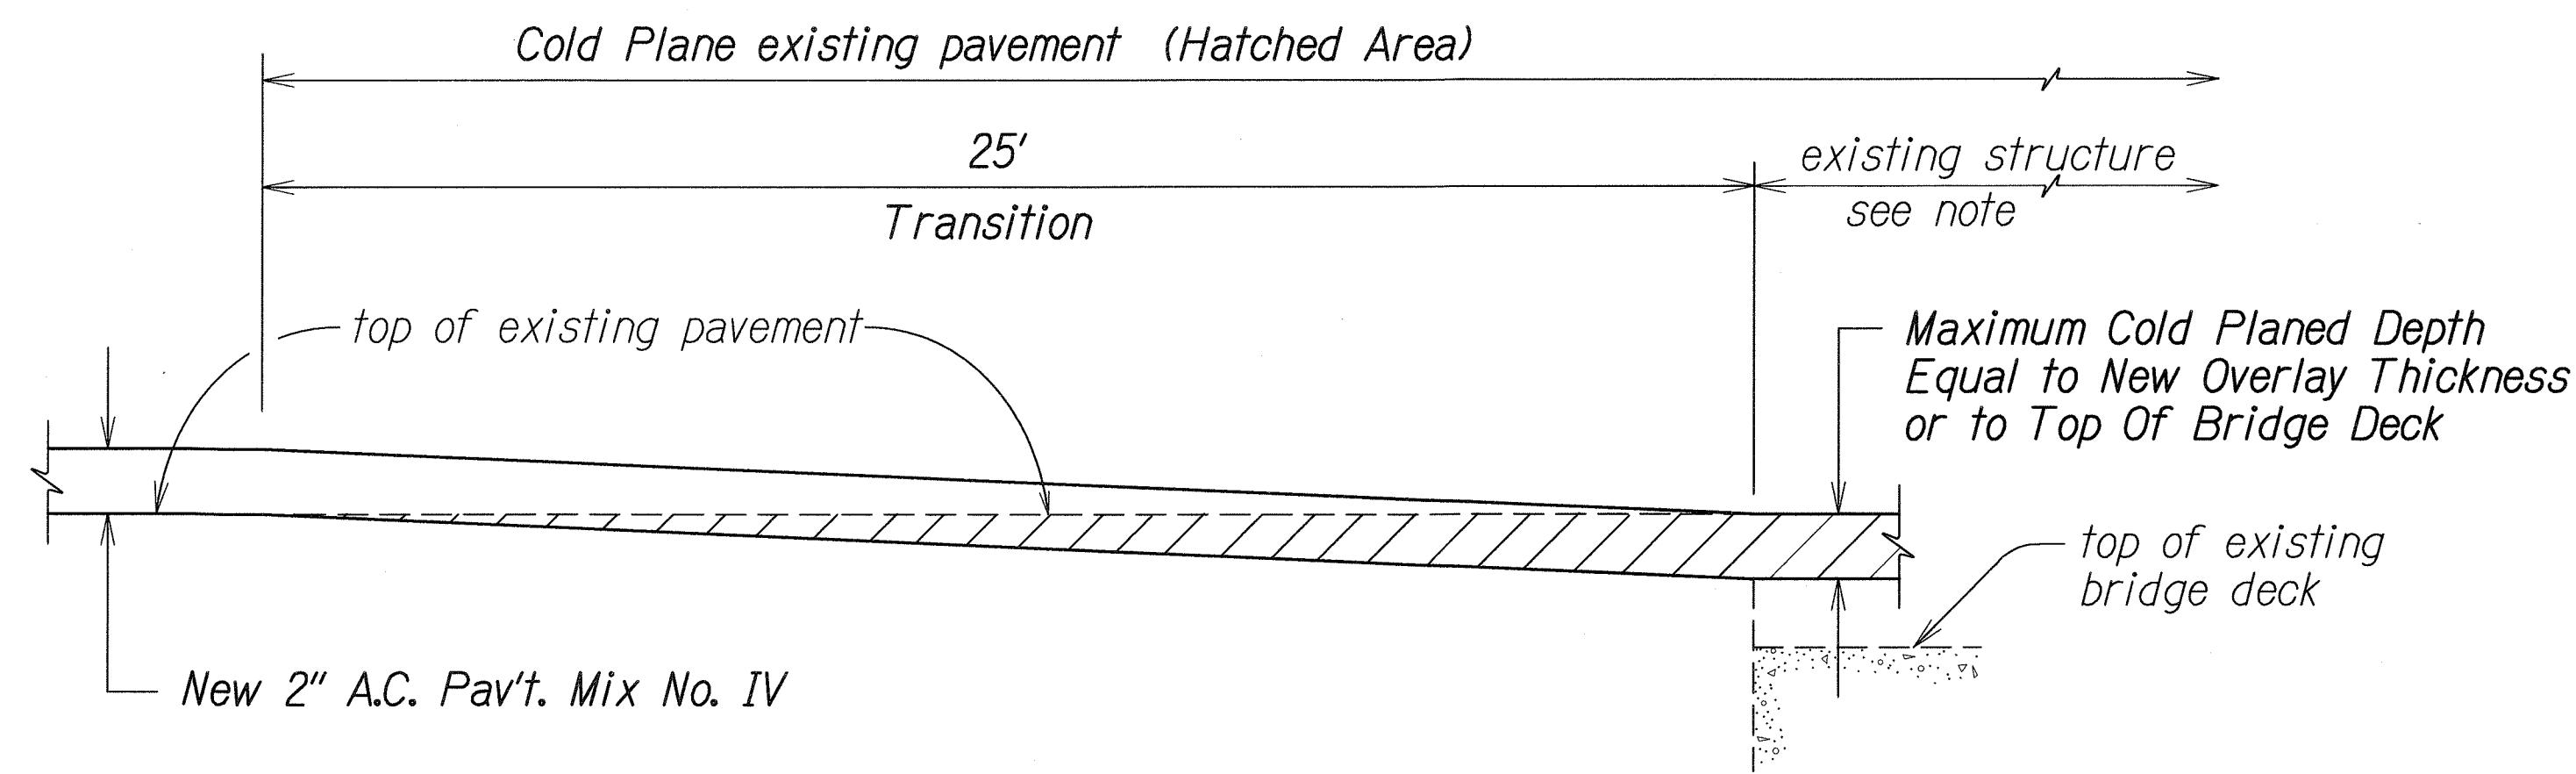

COLD PLANED TRANSITION AND RESURFACING
OVER EXISTING STRUCTURE
Not to Scale

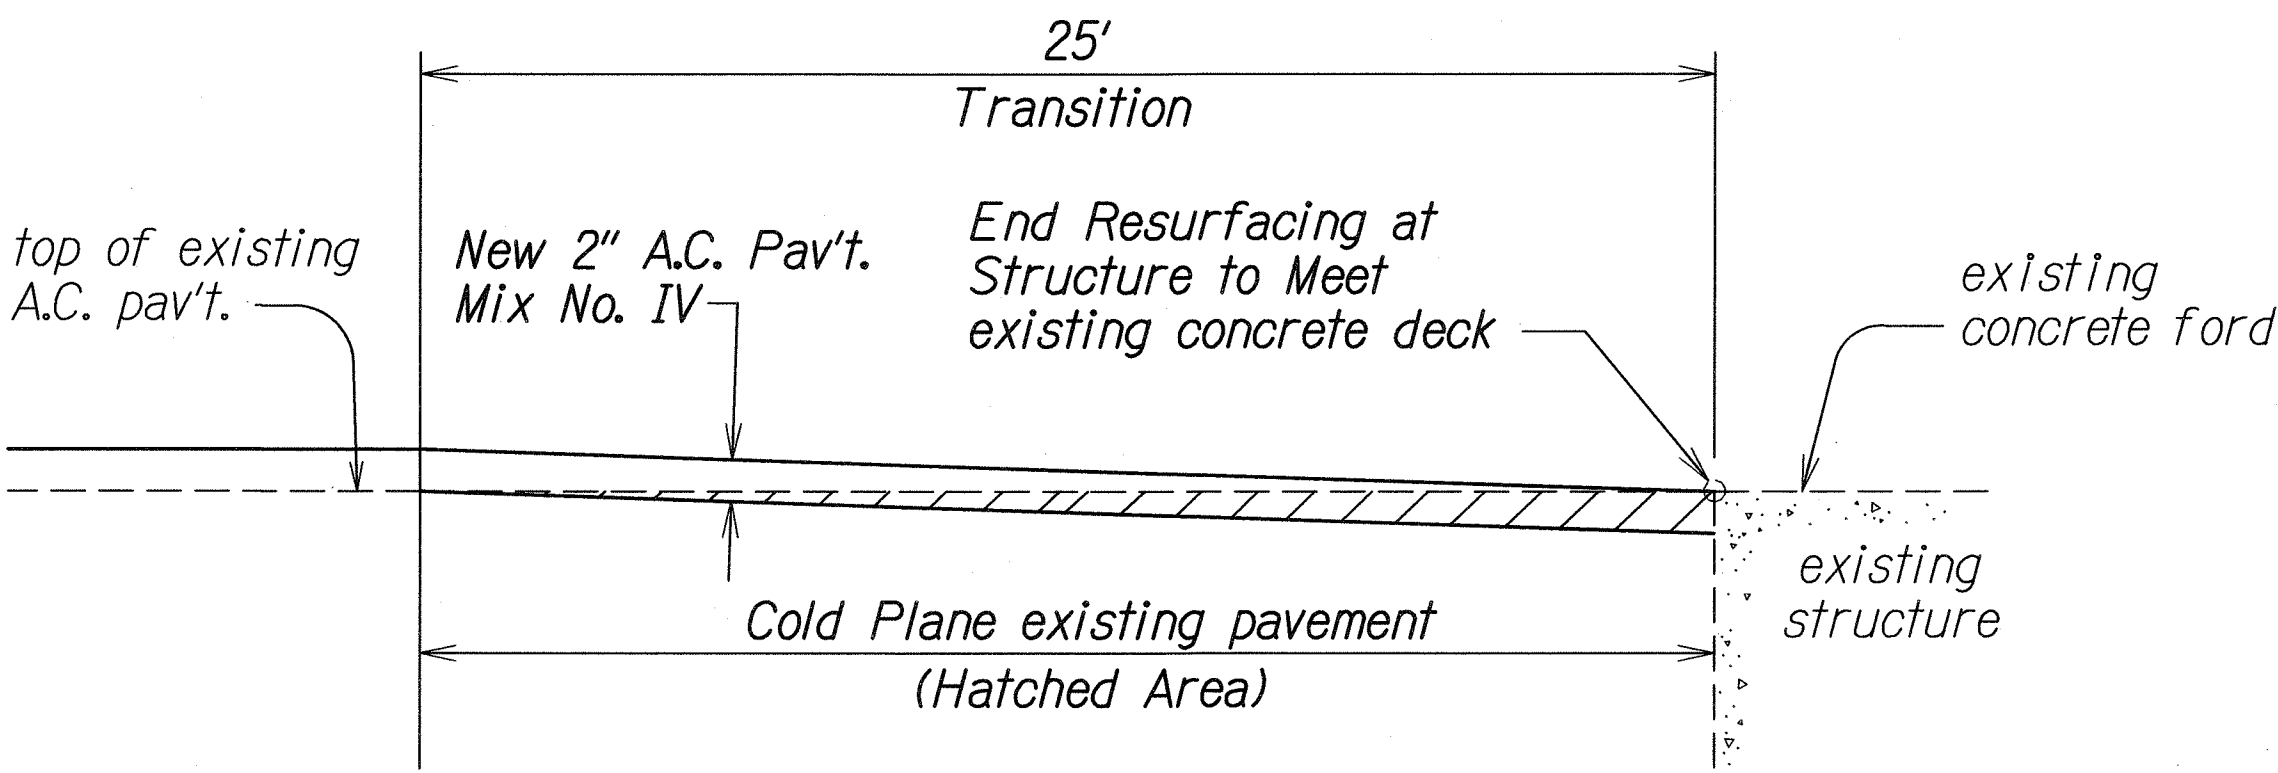

COLD PLANED TRANSITION AT CONCRETE FORD
Not to Scale

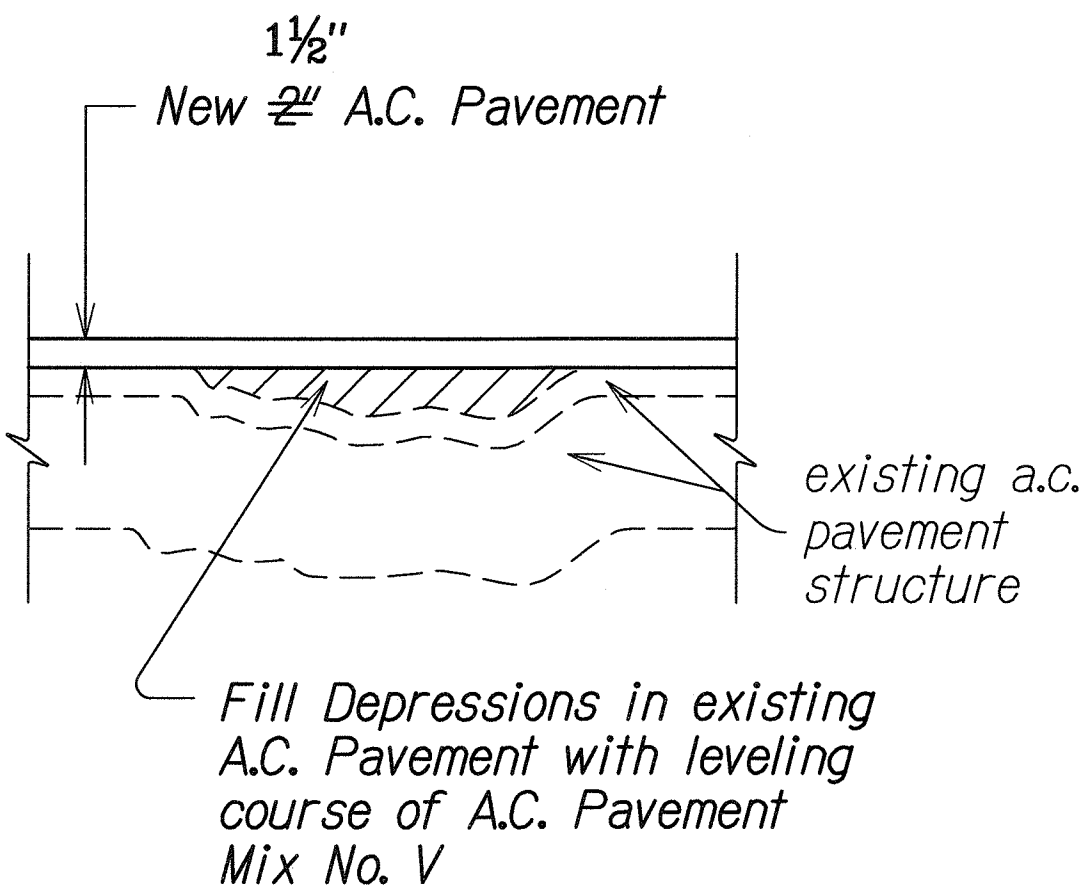

LEVELING COURSE DETAIL
Not To Scale

ORIGINAL PLAN	SURVEY PLOTTED BY	DATE
NOTED	DRAWN BY	1/05
WORK	DESIGNED BY	
BY	CHECKED BY	
1/05		

LEGEND FOR AS-BUILT POSTINGS	
	Squiggly line for as-built deletion
	Double line for as-built deletion
Roadway	Text for as-built posting

STATE OF HAWAII
DEPARTMENT OF TRANSPORTATION
HIGHWAYS DIVISION

TYPICAL SECTIONS & DETAILS

KAMEHAMEHA V HIGHWAY RESURFACING
Waialua to Halawa Bay
Project No. 450B-01-05M

Scale: As Shown Date: February, 2005
SHEET No. 2 OF 2 SHEETS